

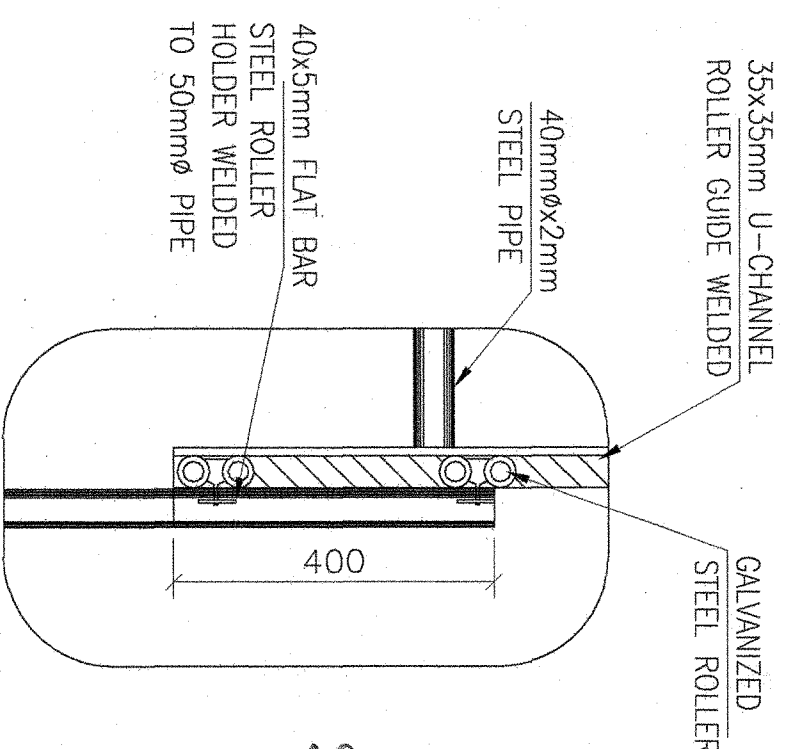
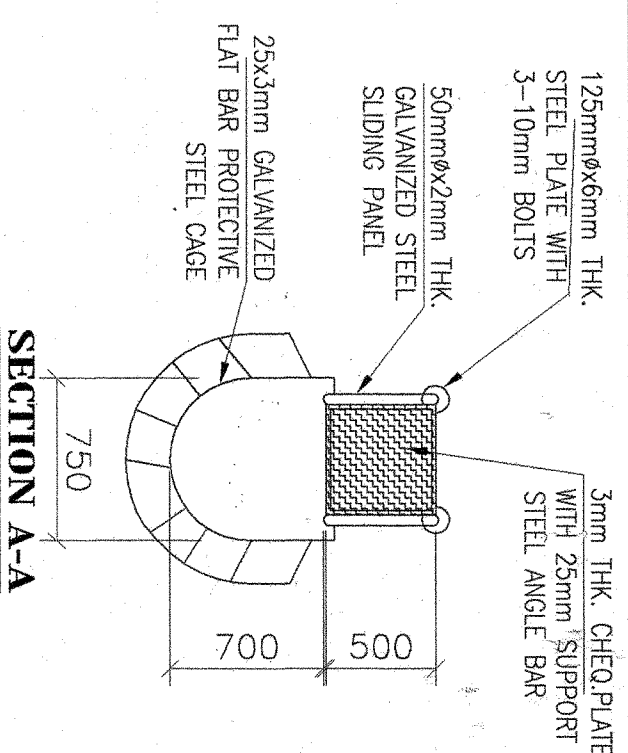


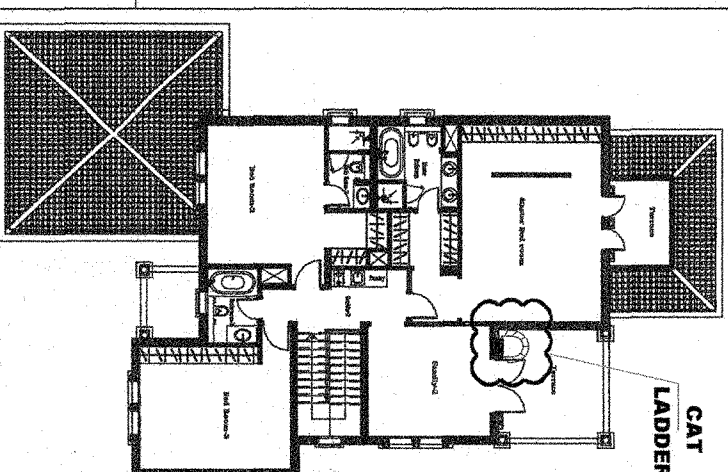


AB - 130 rev.1

NOTE:
1. ALL DIMENSIONS ARE IN MM

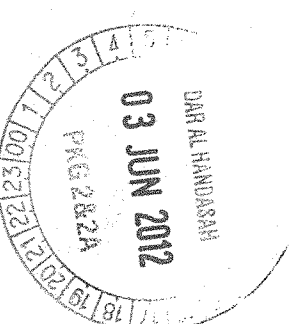

AS BUILT DRAWING

JUMAIRAH PARK

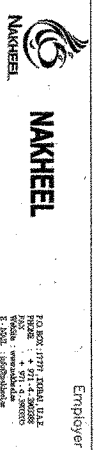


PACKAGE - 2

ACCESS CAT LADDER DETAILS

TYPE - LEGACY

Drawing No. **PME / JP / AB / AL-01**

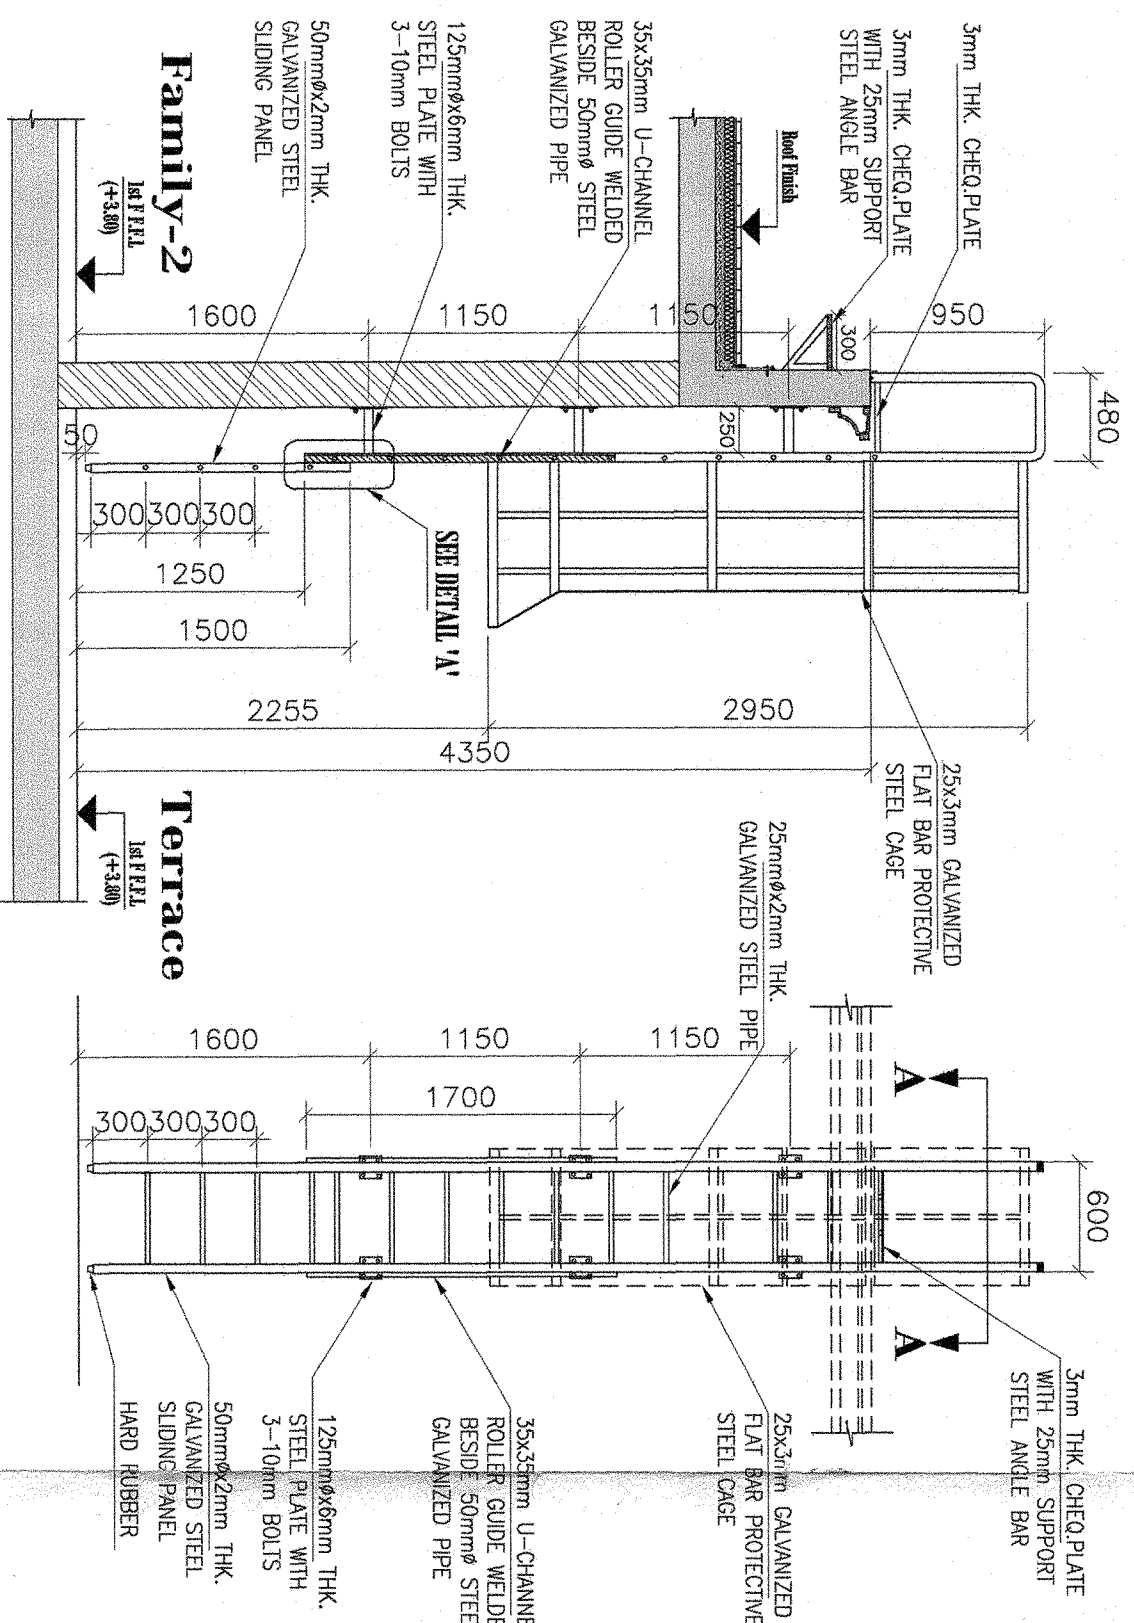

SIDE ELEVATION

FRONT ELEVATION

dar al-handasah

Client and Partners

☒ CODE 1 APPROVED

☐ CODE 2 APPROVED AS NOTED

☐ CODE 3 RESUBMIT FOR APPROVAL

☐ CODE 4 REJECTED

BY: **DATE:**

Approval shall not relieve the contractor of any of his obligations under the Contract or constitute authorization of any change to Contract Documents or variation to the work. Contractor is responsible for dimensions, quantities and coordination with other trades.

Handwritten signature and date: 06/12/12