


LIST OF FINISH MATERIALS

CODE	ITEM	AREA	APPLICATION	TRADITIONAL	
				BRAND NAME	MODEL NO.
CT-001	Ceramic Tile	Kitchen	Floor (Contemporary only) wall Traditional only)	Pamesa	Saturani Beige
CT-001b	Ceramic Tile	Kitchen	Floor (Traditional only	Pamesa	Alfa Beige
CT-002	Ceramic Tile	Kitchen	Skirting	Pamesa	Alfa Beige
CT-003	Ceramic Tile	Kitchen - Pantry	Wall(Contemporary only) SplashBack+Breakfast Bar Mosaic(Traditional only)	Pamesa	Saturani Beige
CT-004	Ceramic Tile	Main Ent,Living,Dining & Family	Floor	Pamesa	Alfa Beige
CT-005	Ceramic Tile	Main Ent,Living,Dining & Family	Skirting	Pamesa	Alfa Beige
CT-006	Ceramic Tile	Master,Genaral Bedroom,dressing, Corridor 1 & 2	Floors	Pamesa	Alfa Beige
CT-007	Ceramic Tile	Master,Genaral Bedroom,dressing, Corridor 1 & 2	Skirtings	Pamesa	Alfa Beige
CT-008	Ceramic Tile	Master Bathroom & Powder Room	Floors	Azulibur	JV 303
CT-009	Ceramic Tile	Master Bathroom & Powder Room	Walls	Azulibur	JV 302
CT-010	Mosaic Tile	Master Bathroom & Powder Room	Wall Mosaic	Azulibur	JV 302
CT-011	Ceramic Tile	General Bathroom 2,3&4	Floors	Pamesa	Timbet Marfil
CT-012	Ceramic Tile	General Bathroom 2,3&4	Walls	Pamesa	Ikoni Blanco
CT-013	Mosaic Tile	General Bathroom 2,3&4	Wall Mosaic	Pamesa	Timbet Marfil
CT-014	Ceramic Tile	Maids Room, Maids Bathroom, Laundry & Store	Floors	Guocera	E827B
CT-015	Ceramic Tile	Maids Room, Laundry, Storage & Store	Skirting	Guocera	E827B
CT-016	Ceramic Tile	Maids Bathroom	Walls	Guocera	F227A
CT-017	Terracota Tile	Terrace & Loggia	Floors	Esma	Talavera Marron
CT-018	Ceramic Tile	Terrace & Loggia	Skirting	Esma	Talavera Marron
CT-019	Border	Main Entry	Mosaic	Marble	Mix(EM+C.M)
ST-001	Work top	Kitchen & Pantry	Work top	Mistry Yellow Granite	Mistry Yellow Granite
ST-001a	Work top	Breakfast bar	Work top	Mistry Yellow Granite	Mistry Yellow Granite
ST-002a	Stone	Master Bathroom	Vanity Top	Marble	Crema Marfil
ST-002b	Stone	Master Bathroom	Cistern Top	Marble	Crema Marfil
ST-002c	Stone	Master Bathroom	Bathtub Top	Marble	Crema Marfil
ST-002d	Stone	Powder Room	Vanity Top	Marble	Crema Marfil
ST-002e	Stone	Powder Room	Cistern Top	Marble	Crema Marfil
ST-003a	Stone	General Bathroom	Vanity Top	Marble	Crema Marfil
ST-003b	Stone	General Bathroom	Cistern Top	Marble	Crema Marfil
ST-003c	Stone	General Bathroom 1	Bathtub Top	Marble	Crema Marfil
ST-004a	Stone	All Areas including Bathrooms	Thresholds & Window Surround	Marble	Crema Marfil
ST-004b	Stone	Staircase	Staircase Treads & Risers	Marble	Crema Marfil
ST-004c	Stone	Staircase	Staircase Landing	Marble	Crema Marfil
ST-004d	Stone	Staircase	Staircase Skirting	Marble	Crema Marfil
T-001	Vanity Cabinet	Master Bath - General Bath	Vanity Cabinet	Carcass 18mm moisture resistant MDF - shutter pressed in Veneer Mahogany finish	
T-002	Wardrobe	Bedrooms	Wardrobes - Dressing	18mm MDF carcass-22mm MDF shutter pressed oak - Mahogany Finish	
T-003	Doors	All Areas	Doors	Leaf - 43mm thick Semi solidwood door - Mahogany Finish	
T-004	Doors	External Door	Doors	Leaf - 55mm thick solid core - Mahogany Finish	
T-005	Cabinet	Kitchen - Pantry	Kitchen Cabinet	Carcass-18mm MDF Melamine-Shutter 18mm painted - Mahogany Finish	
T-006	Handrail	Staircase	Handrail	Oak wood - Mahogany Finish	
T-007	Doors	All Bathrooms	Doors	Leaf - 43mm thick Semi solidwood door - Mahogany Finish	
T-008	Doors	Laundry , DU		44mm THK MahoganyWOOD FRAME - 18mm MDF door	

SUSPENDED CEILING TYPE		
LOCATION	LEGACY	REGIONAL
Family, Living / Dining, Main Entrance Corridor-1, Office/Bedroom-4	12.5MM THICK REGULAR GYPSUM BOARD.	12.5MM THICK REGULAR GYPSUM BOARD.
Bedroom-1, Bedroom-2, Bedroom-3 Family-2 & Corridor-2	12.5MM THICK MOISTURE RESISTANT GYPSUM BOARD.	12.5MM THICK MOISTURE RESISTANT GYPSUM BOARD.
Kitchen, Maid's Room And All Bathrooms	TILES 600 X 600	TILES 600 X 600

INTERNAL PAINT - TRADITIONAL THEME		EXTERNAL PAINT		
Internal Walls	GULF PAINT FALCO EMALUX (Color Code=08B 15)		LEGACY VILLAS	REGIONAL VILLAS
False Ceiling	GULF PAINT FALCO EMALUX (Color Code=WHITE 011)	VILLA BODY	HERITAGE GLAZE 1109	HERITAGE GLAZE 1117
		SKIRTING	T/C SILK 1113	T/C SILK WHITE 8046
Garage Parking Floor	Epoxy FC 150 Epoxy Coating	GRC	T/C SILK WHITE	T/C SILK WHITE 8046

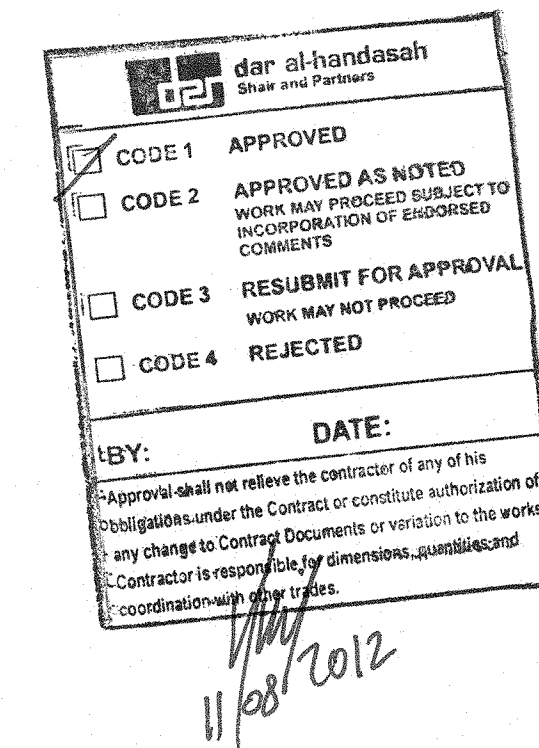

AS BUILT DRAWING

Project

JUMAIRAH PARK

Employer



NAKHEEL

P.O. BOX : 17777, DUBAI, U.A.E.
PHONE : + 971 - 4 - 3903388
FAX : + 971 - 4 - 3903335
WebSite : www.nakheel.ae
E - MAIL : info@nakheel.ae



dar al-handasah
shair and partners

Consultant

P.O. BOX : 55624, DUBAI, U.A.E.
PHONE : + 971 - 4 - 335502
FAX : + 971 - 4 - 33353121



Pauling Middle East

Main Contractor

P.O. BOX : 45176, ABU DHABI, U.A.E.
PHONE : + 971 - 2 - 6329922
FAX : + 971 - 2 - 6325553
E - MAIL : romingl@emirates.net.ae

Package

PACKAGE - 2 & 2A

Drawing Title

FINISHING SCHEDULE (TRADITIONAL)

Drawn T.Murugan	Review Eng. Ziad	Checked: Eng.Ghassan Zeitouni
--------------------	---------------------	----------------------------------

Drawing No.

PME / JP / AB / FS- 002