

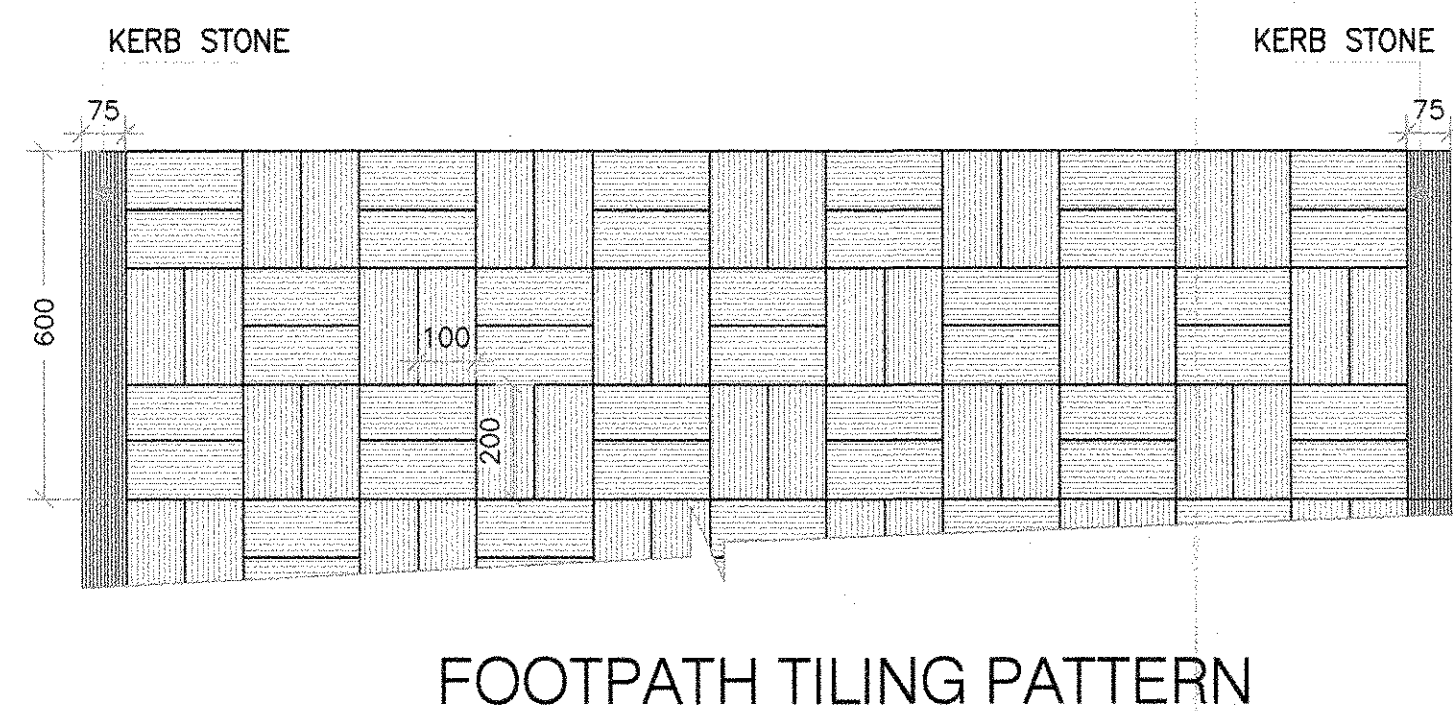
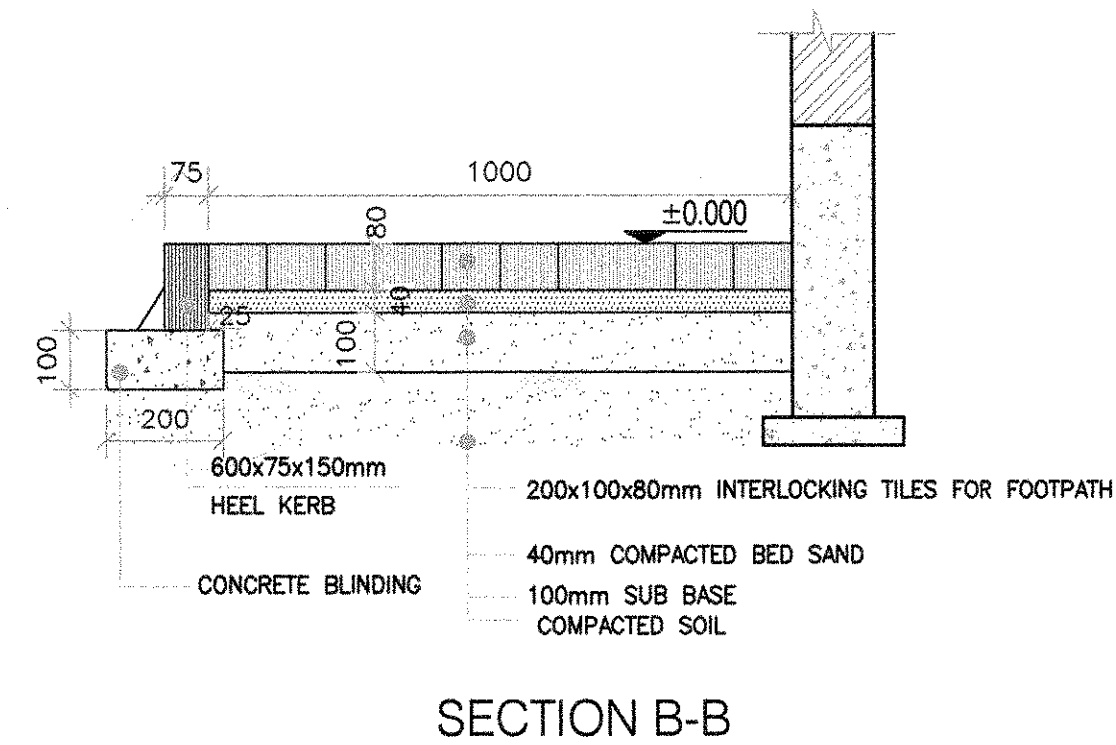


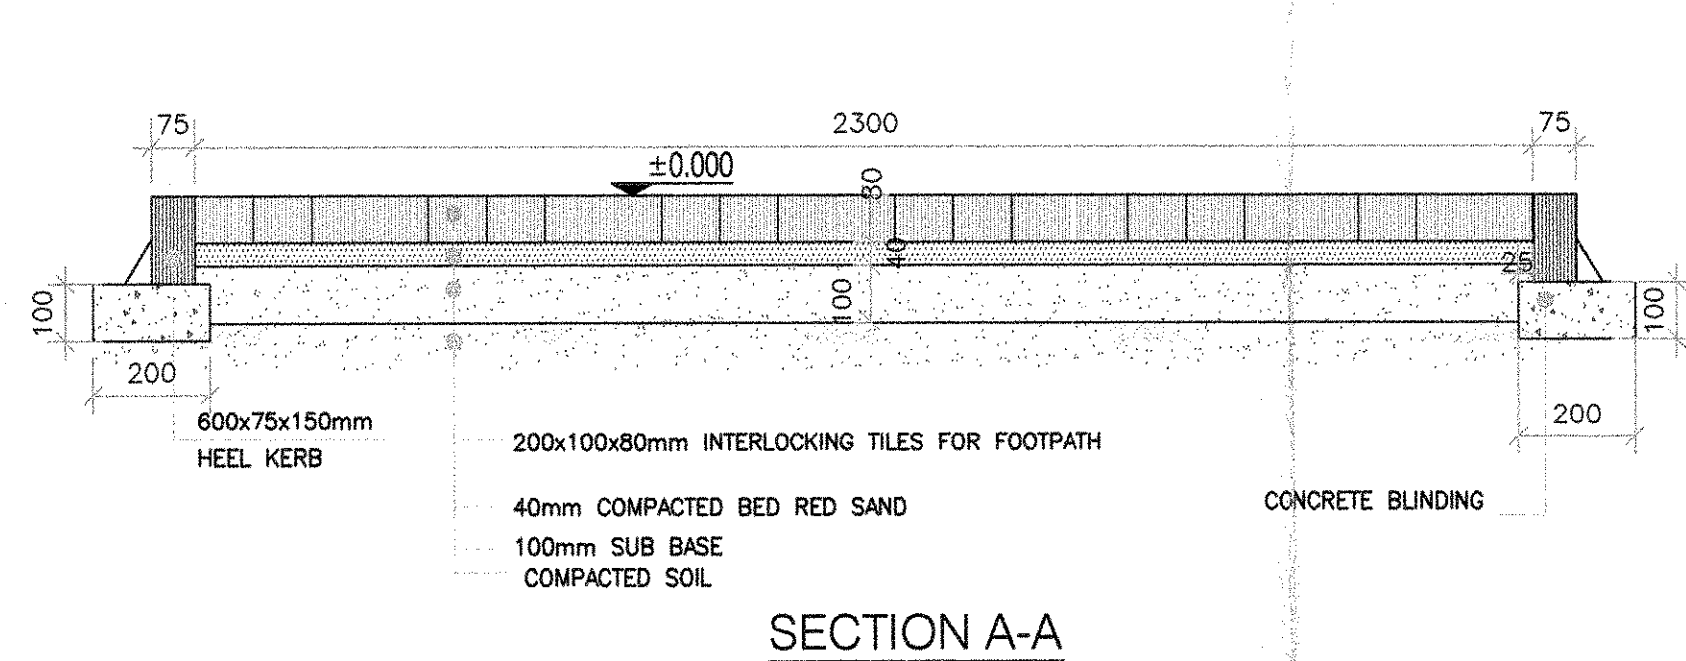


Key plan

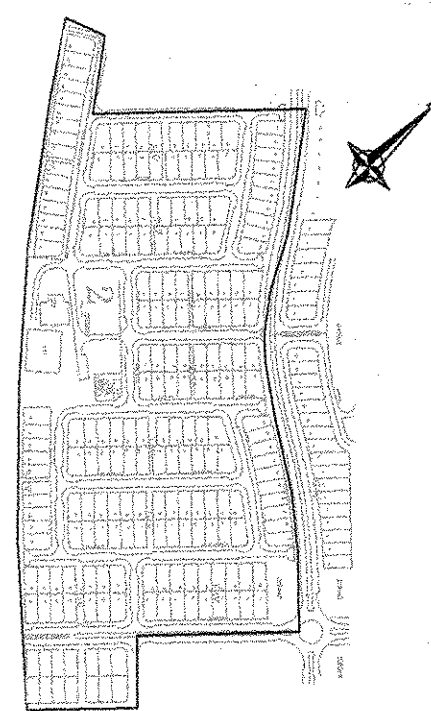

NOTE:

•ALL DIM ARE IN MM UNLESS OTHERWISE NOTED

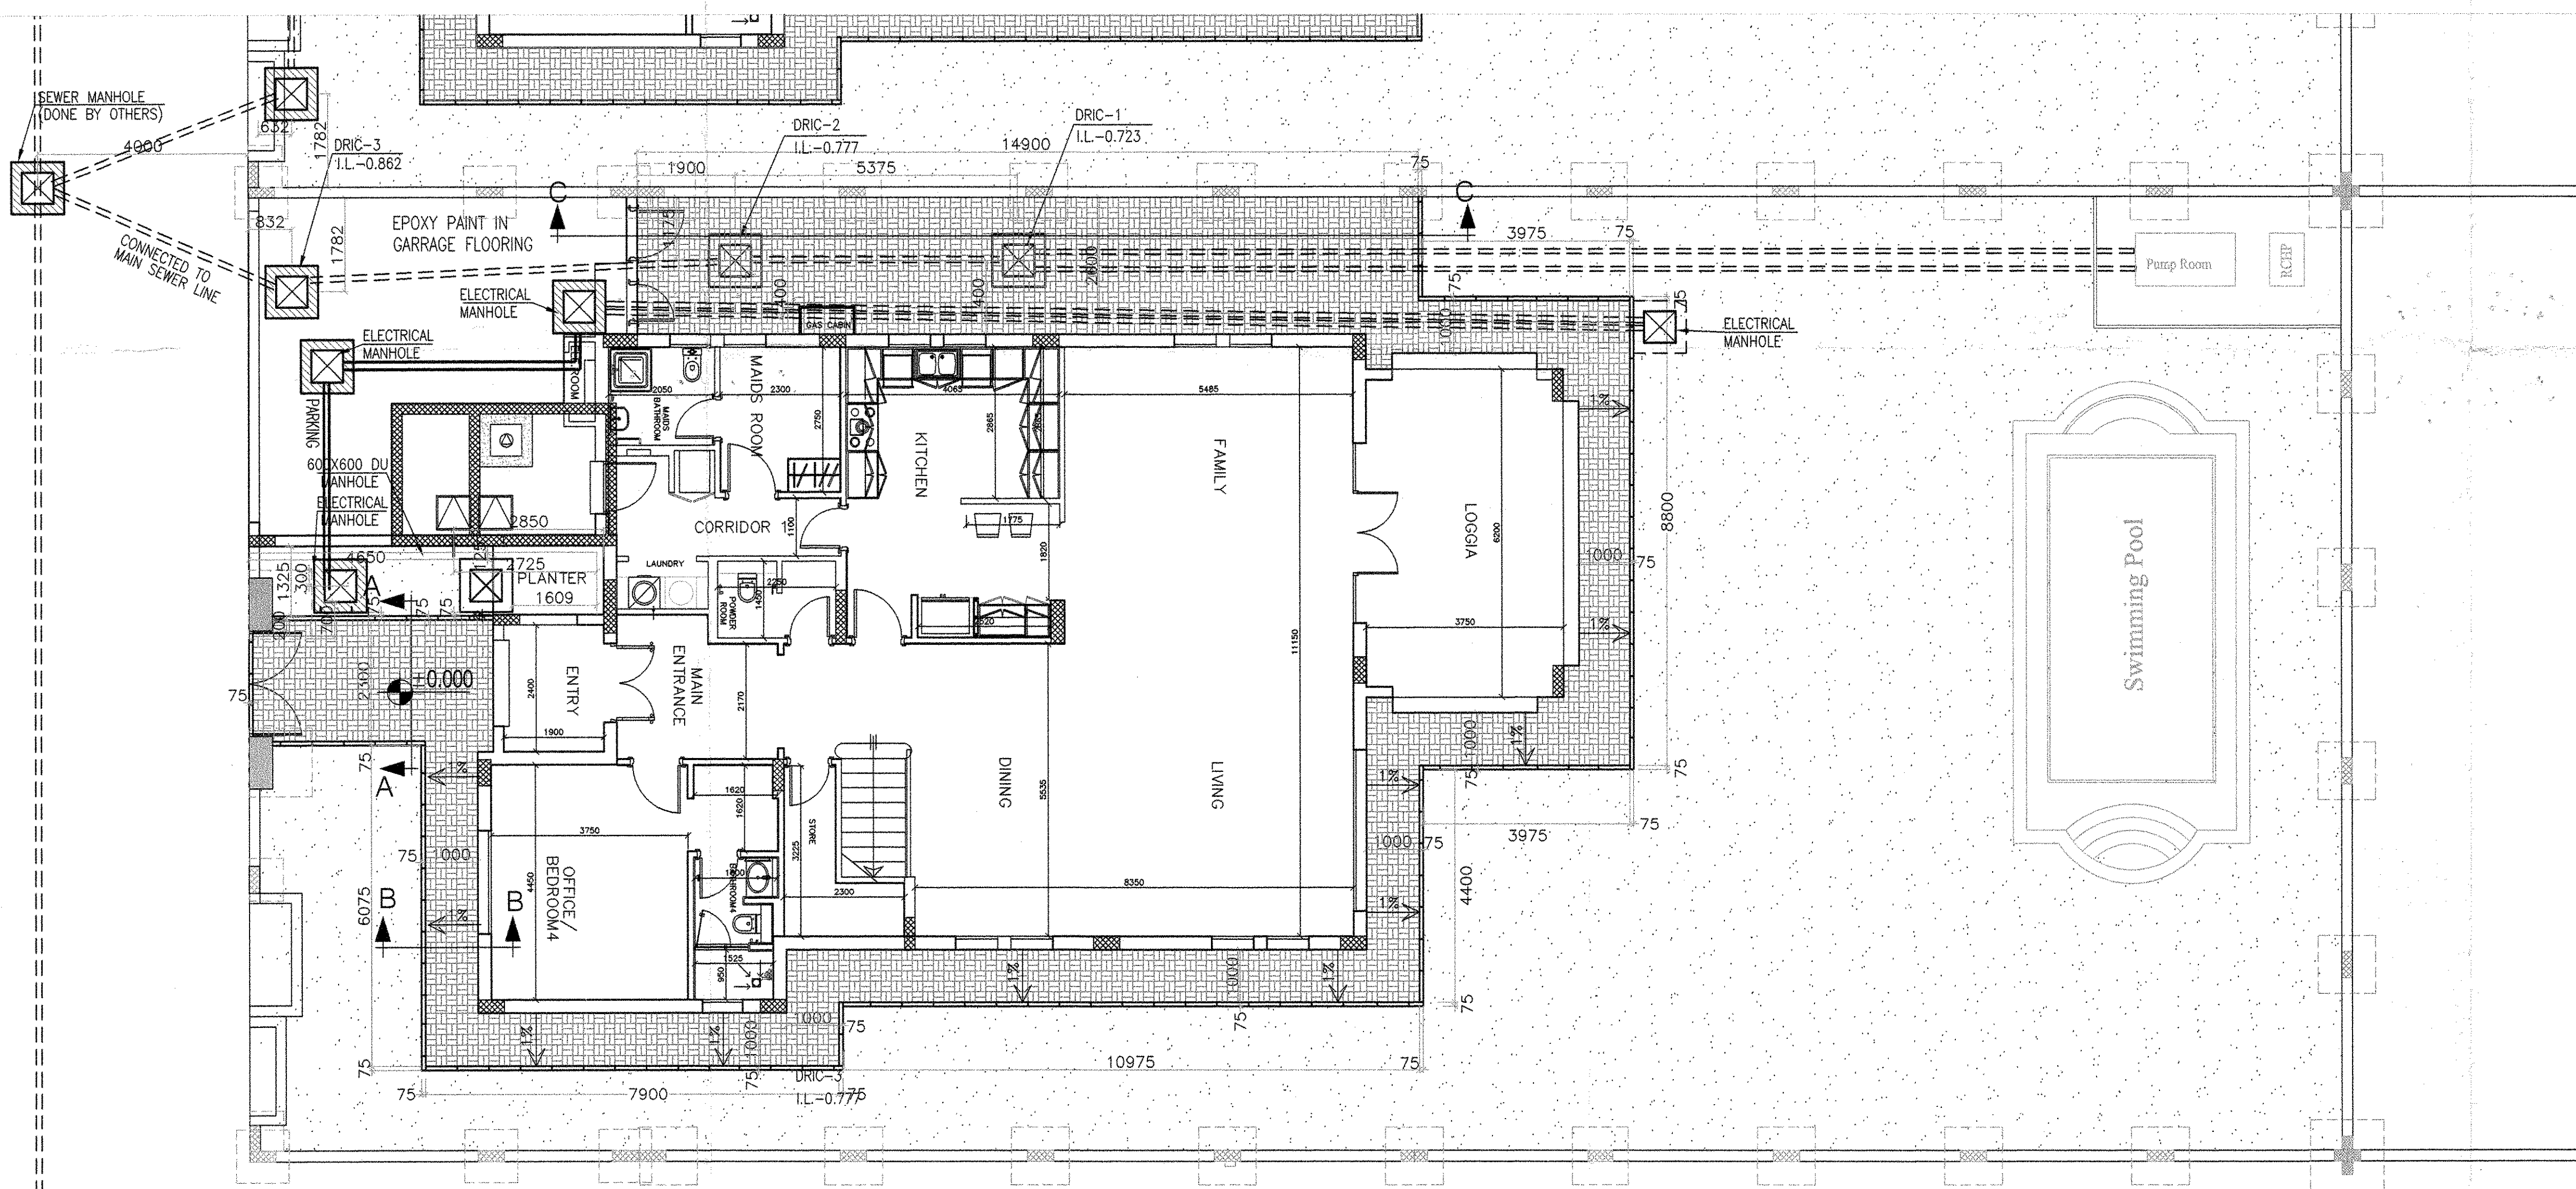


dar al-handasah
Civil and Structural

☒ CODE 1 APPROVED
☐ CODE 2 APPROVED AS NOTED
 WORK MAY PROCEED SUBJECT TO
 INCORPORATION OF ENDORSED
 COMMENTS
☐ CODE 3 RESUBMIT FOR APPROVAL
 WORK MAY NOT PROCEED
☐ CODE 4 REJECTED

BY: DATE:

Approval shall not relieve the contractor of any of his
 obligations under the Contract or constitute satisfaction of
 any obligations of the Engineer or verification of his works.
 Contractor is responsible for discrepancies, quantities and
 coordination with other trades.

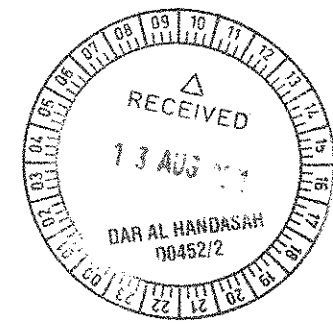

AS BUILT DRAWING

JUMAIRAH PARK



Pauling Middle East

PACKAGE - 2 & 2A

INTERLOCKING TILES DETAILS
LEGACY.

Drawn: T.Murugan	Review: Eng. Ziyad	Checked: Eng.Ghassan Zeitouni
Scale: 1:75	Date: 08-08-2011	

Drawing No. PME / JP / AB / LE / ILT -001