

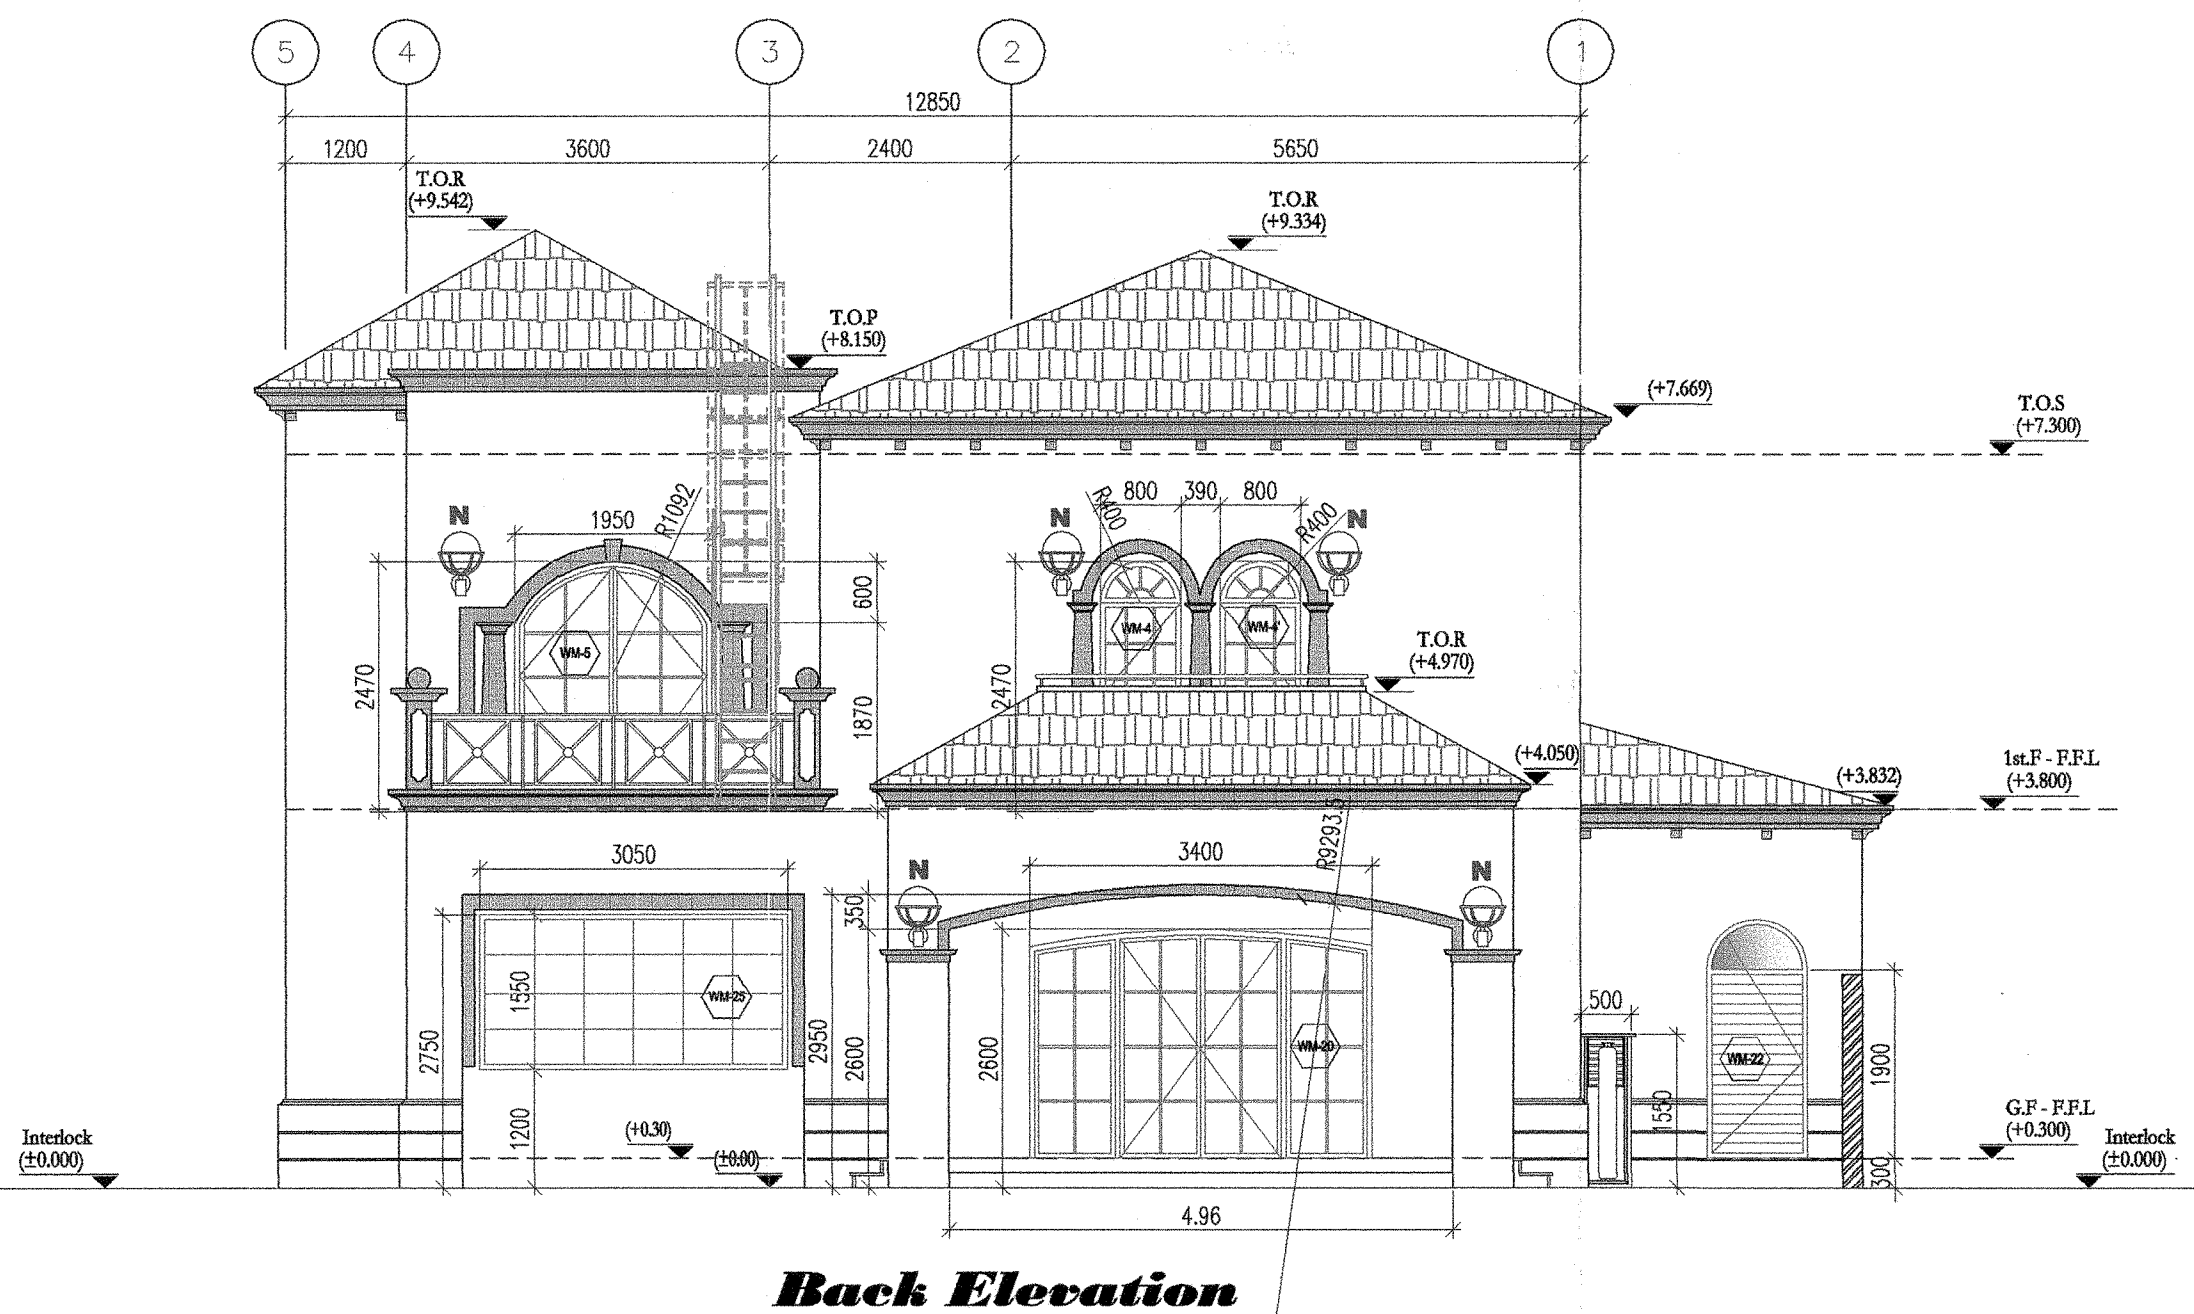


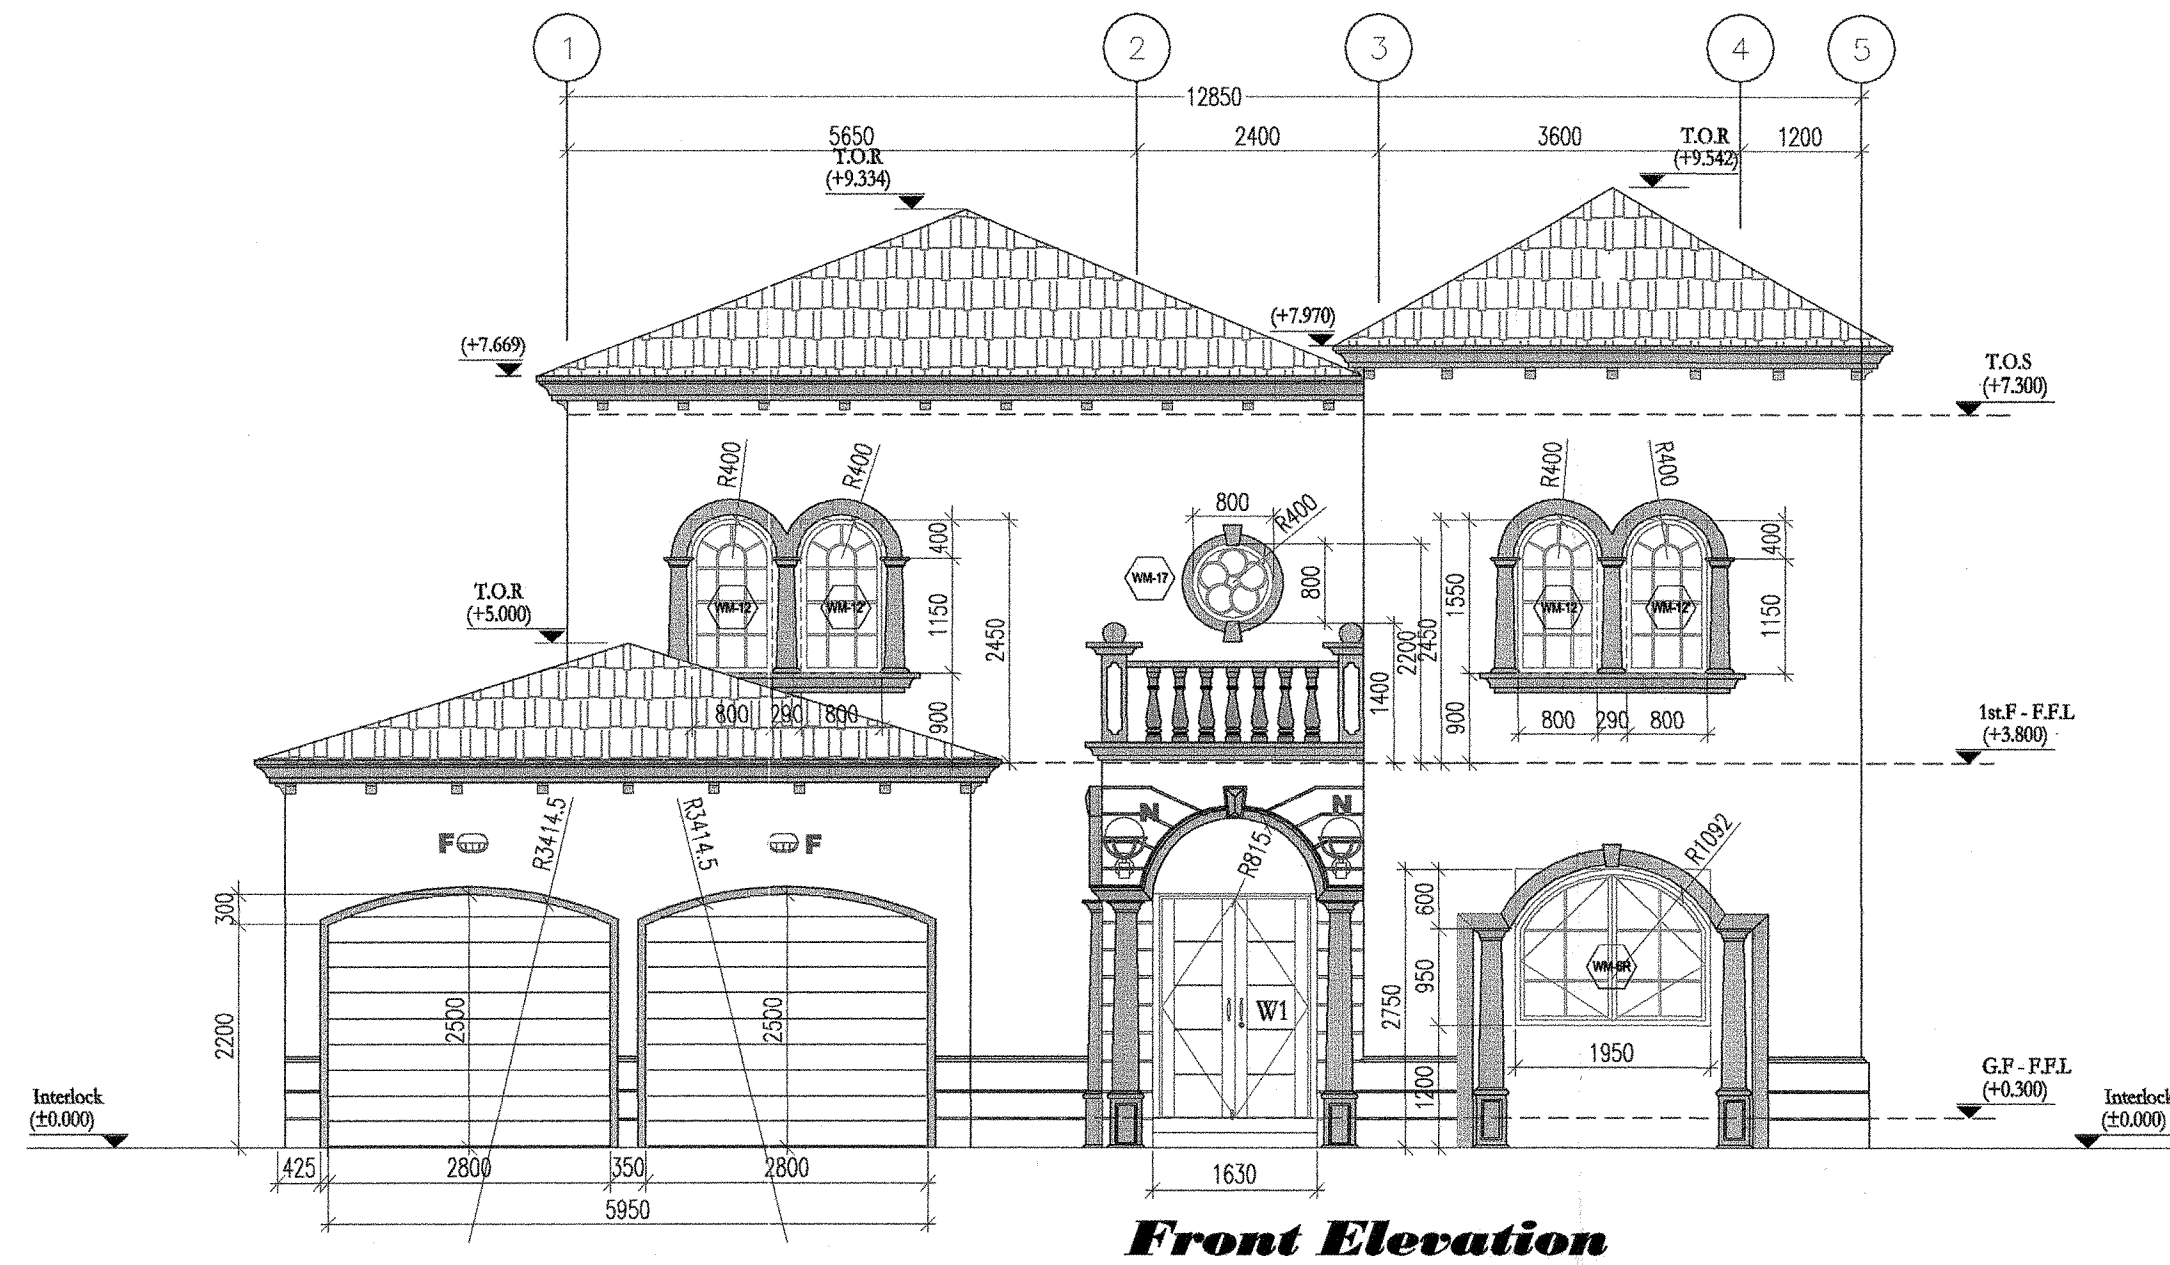

Note:

1. All the dimensions are in mm

LEGEND

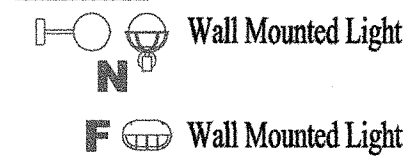

Applicable for the Below Listed Villas			
Package	Cluster #	Plot #	Total # of Villas
2	1	J4V042 to J4V055	14
2A	1	F4V002 to F4V005	20
		F4V008 to F4V013	
		F4V016 to F4V021	
		F4V024 to F4V027	
	3	E4V052 to E4V061	10
	4	E4V028 to E4V036	20
		E4V039 to E4V049	
	5	H4V002 to H4V016	15
	7	D4V034 to D4V040	7
	8	D4V020	6
		D4V023 & D4V024	
		D4V027 & D4V028	
		D4V031	
	9	A4V013 to A4V028	16
	10	A4V031 & A4V032	9
		A4V035 to A4V038	
11	A4V041 to A4V043	14	
	D4V002 to D4V008		
12	D4V011 to D4V017	8	
	C4V048 & C4V049		
	C4V052 & C4V053		
	C4V056 & C4V057		
13	C4V060 & C4V061	20	
	C4V002 to C4V012		
14	C4V037 to C4V045	18	
	C4V015 to C4V024		
15	C4V027 to C4V034	10	
	B4V002 to B4V006		
16	B4V009 to B4V013	15	
	G4V002 to G4V016		
Total Villas			202 Villas



AS BUILT DRAWING

Project

JUMAIRAH PARK

Employer



NAKHEEL

P.O. BOX: 17777, DUBAI, U.A.E.
PHONE: +971-4-3500286
FAX: +971-4-3500333
Website: www.nakheel.ae
E-MAIL: info@nakheel.ae

Consultant



dar al-handasah
shair and partners

P.O. BOX: 50424, DUBAI, U.A.E.
PHONE: +971-4-3300282
FAX: +971-4-3300333
Website: www.daralhandasah.com

Main Contractor



Pauling Middle East

P.O. BOX: 40176, ABU DHABI, U.A.E.
PHONE: +971-2-4520052
FAX: +971-2-4520053
E-MAIL: pauling@middleeast.ae

Package

PACKAGE - 2 & 2A

Drawing Title

LEGACY ELEVATIONS

(1 OF 2)


Drawn: T.Murugan	Review: Eng. Ziad	Checked: Eng.Ghassan Zeitouni
Scale: 1:50	Date: 12-07-2011	
Drawing No.	PME / JP / AB / ELE / LE-001	

dar al-handasah Shair and Partners	
☒	CODE 1 APPROVED
☐	CODE 2 APPROVED AS NOTED WORK MAY PROCEED SUBJECT TO INCORPORATION OF ENDORSED COMMENTS
☐	CODE 3 RESUBMIT FOR APPROVAL WORK MAY NOT PROCEED
☐	CODE 4 REJECTED
BY: _____ DATE: _____ Approval shall not relieve the contractor of any of his obligations under the Contract or constitute authorization of any change to Contract Documents or variation to the works. Contractor is responsible for dimensions, quantities and coordination with other trades.	



AB-148

Note:

1. All the dimensions are in mm

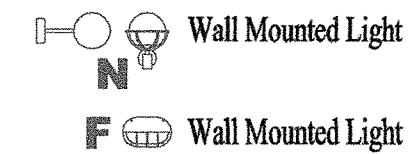LEGEND

Applicable for the Below Listed Villas			
Package	Cluster #	Plot #	Total # of Villas
2A	1	J4V042 to J4V055	14
	1	F4V002 to F4V005	20
		F4V008 to F4V013	
		F4V016 to F4V021	
		F4V024 to F4V027	
	3	E4V052 to E4V061	10
	4	E4V028 to E4V036	20
		E4V039 to E4V049	
	5	H4V002 to H4V016	15
	7	D4V034 to D4V040	7
	8	D4V020	6
		D4V023 & D4V024	
		D4V027 & D4V028	
		D4V031	
	9	A4V013 to A4V028	16
	10	A4V031 & A4V032	9
		A4V035 to A4V038	
		A4V041 to A4V043	
	11	D4V002 to D4V008	14
	D4V011 to D4V017		
12	C4V048 & C4V049	8	
	C4V052 & C4V053		
	C4V056 & C4V057		
13	C4V060 & C4V061	20	
	C4V002 to C4V012		
	C4V037 to C4V045		
14	C4V015 to C4V024	18	
	C4V027 to C4V034		
15	B4V002 to B4V006	10	
	B4V009 to B4V013		
16	G4V002 to G4V016	15	
Total Villas			202 Villas

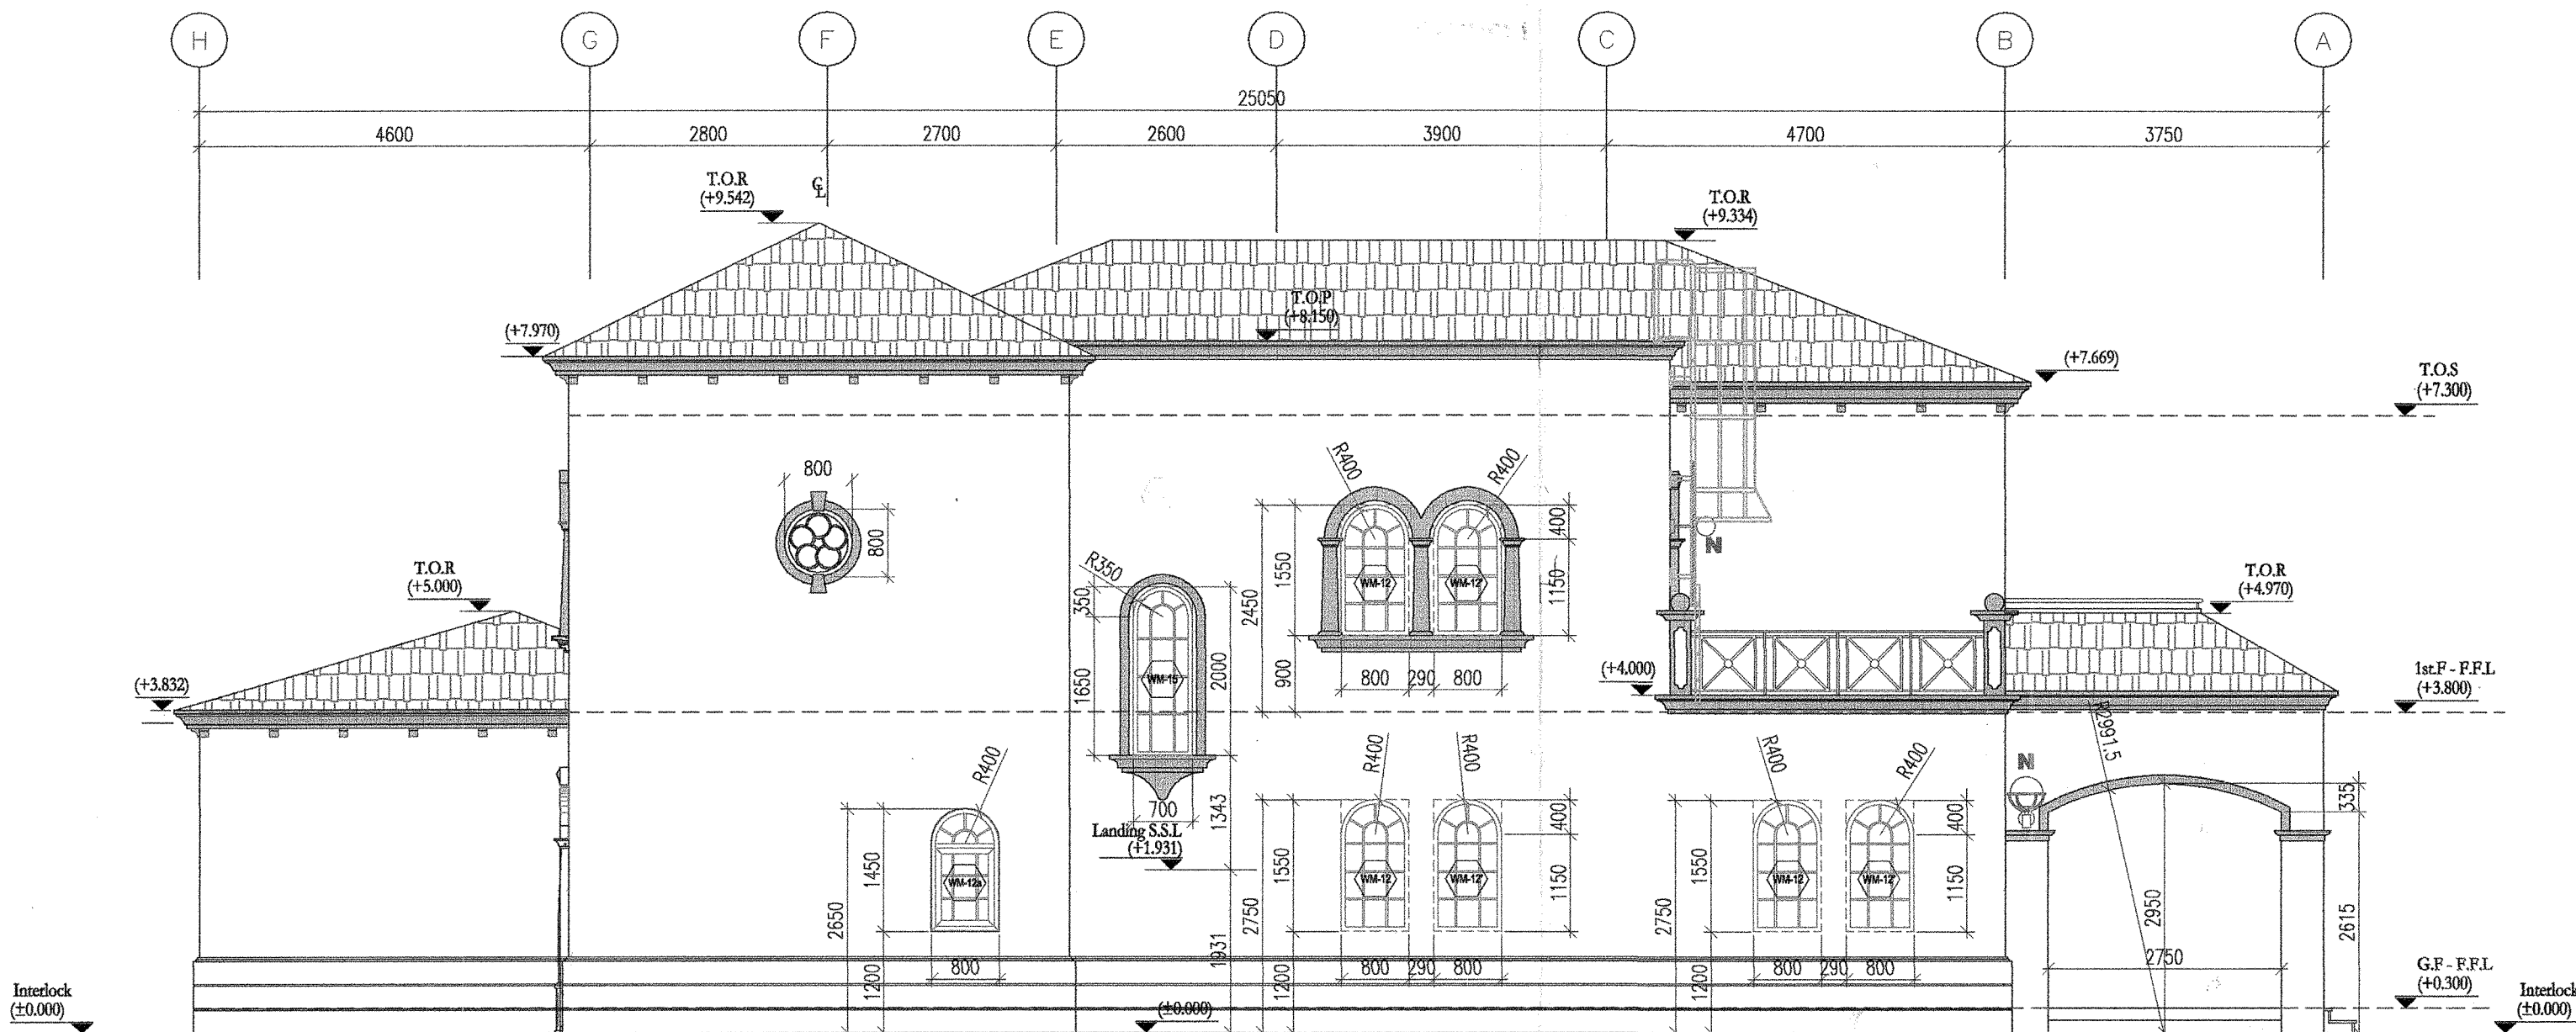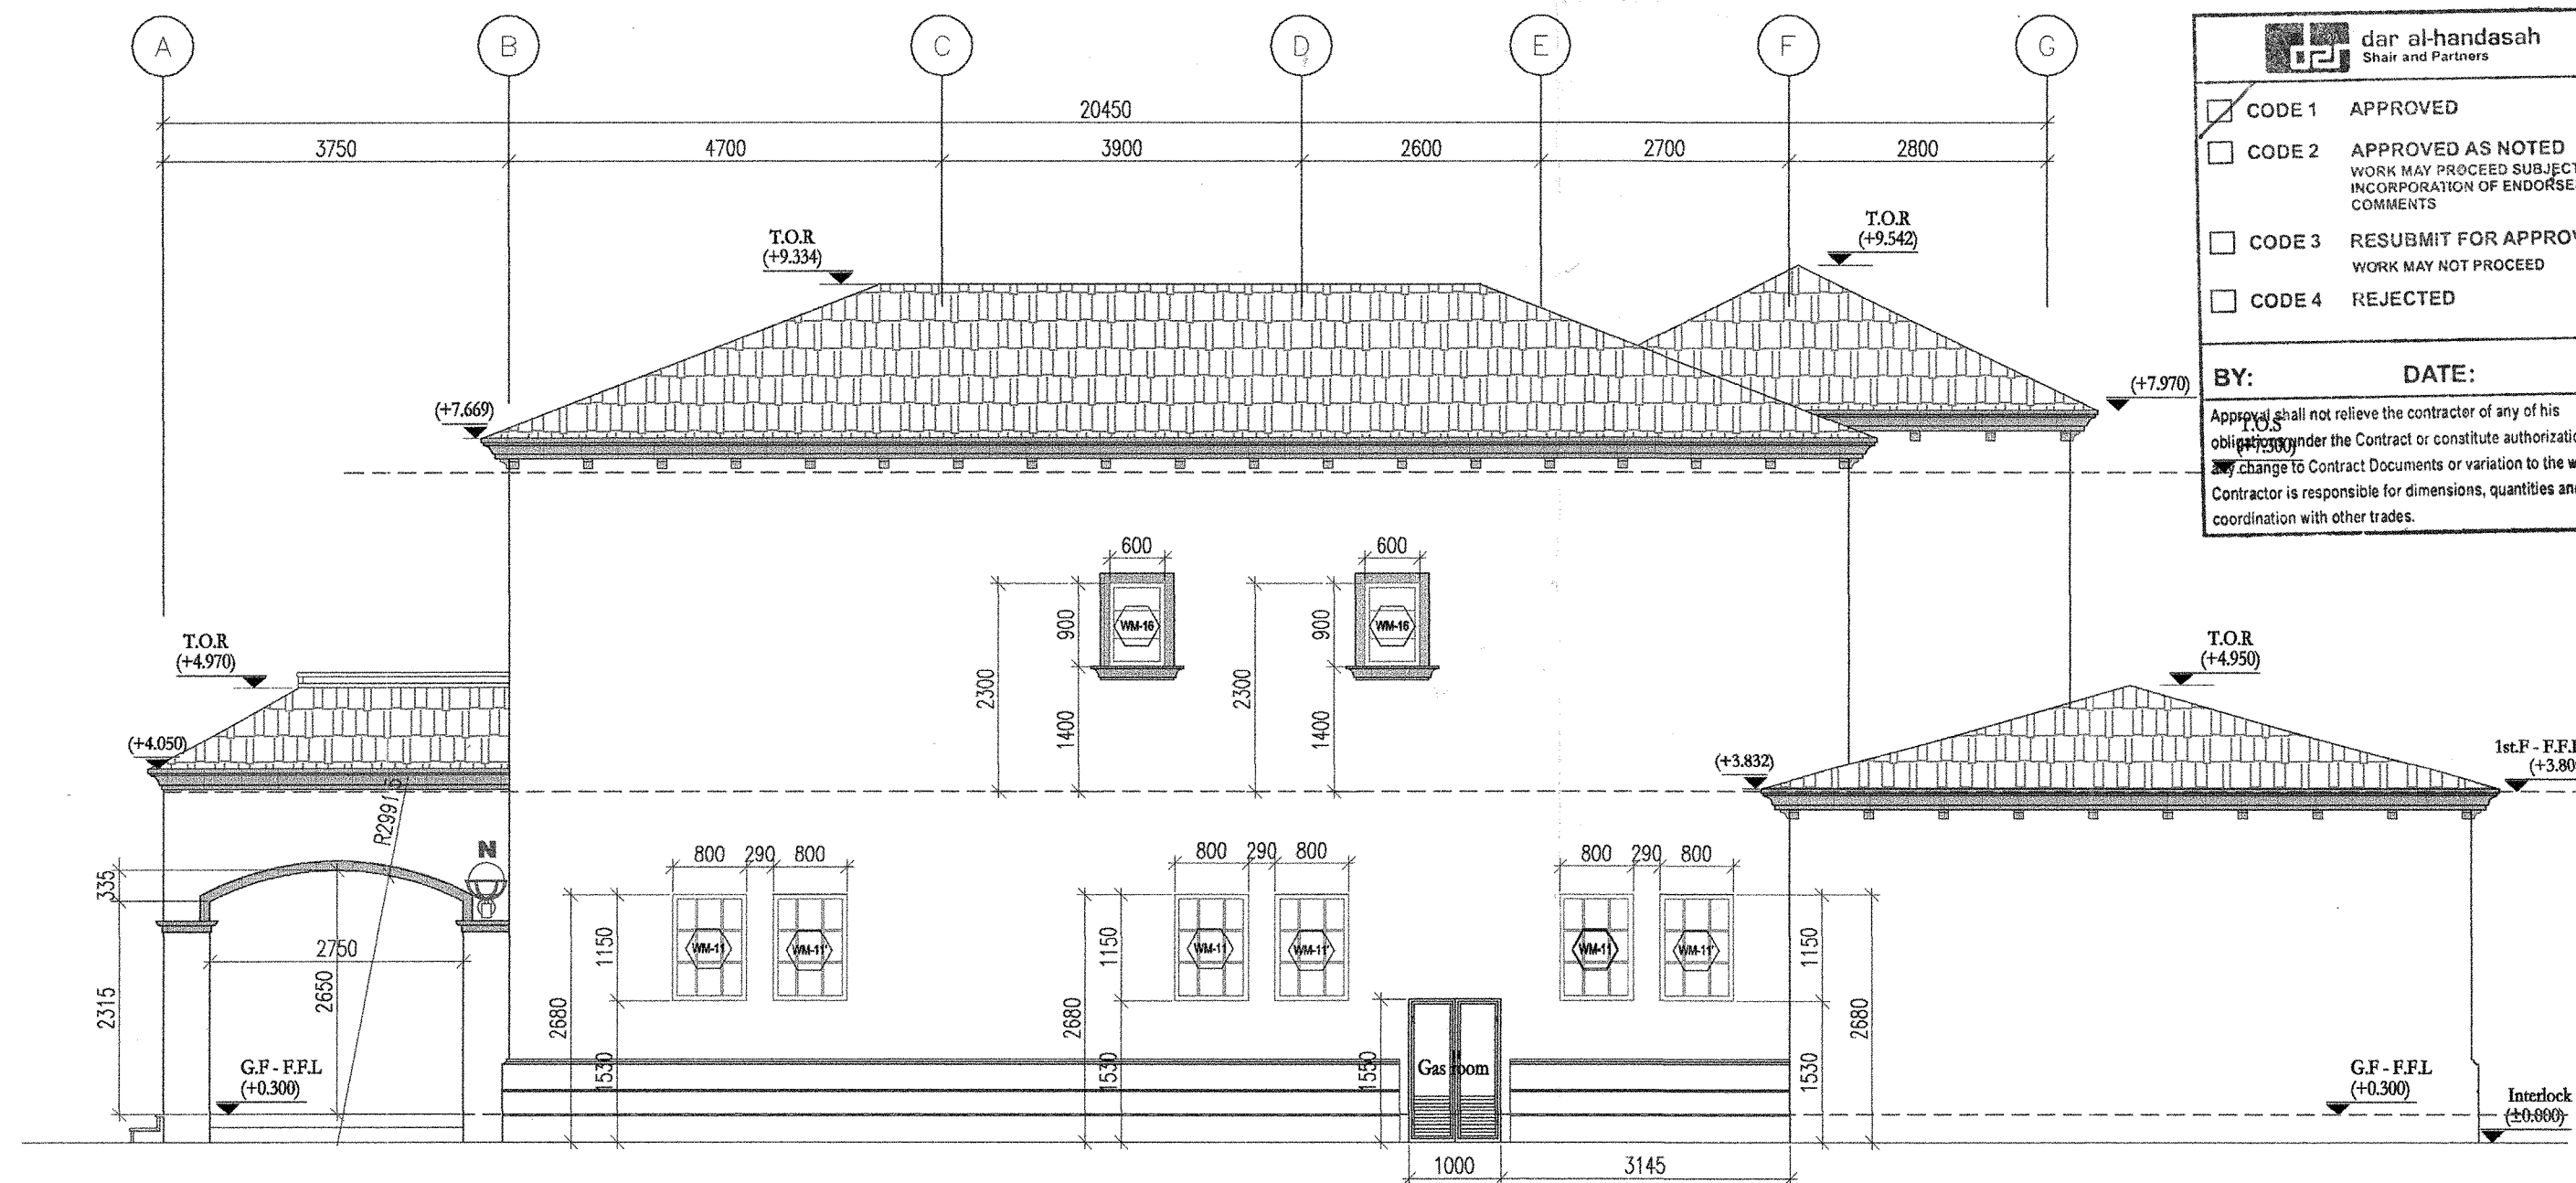**Right Elevation****Left Elevation**

dar al-handasah
Shair and Partners

☒ CODE 1 APPROVED
☐ CODE 2 APPROVED AS NOTED
WORK MAY PROCEED SUBJECT TO
INCORPORATION OF ENDORSED
COMMENTS
☐ CODE 3 RESUBMIT FOR APPROVAL
WORK MAY NOT PROCEED
☐ CODE 4 REJECTED

BY: _____ DATE: _____

Approval shall not relieve the contractor of any of his
obligations under the Contract or constitute authorization of
any change to Contract Documents or variation to the works.
Contractor is responsible for dimensions, quantities and
coordination with other trades.

**AS BUILT DRAWING**

Project		JUMAIRAH PARK
Employer		NAKHEEL
Consultant		dar al-handasah shair and partners
Main Contractor		Pauling Middle East
Package		PACKAGE - 2 & 2A
Drawing Title		LEGACY ELEVATIONS (2 OF 2)
Drawn	Review	Eng. /iad
Scale:	Date:	12-07-2011
Drawing No.		PME / JP / AB / ELE / LE-001