

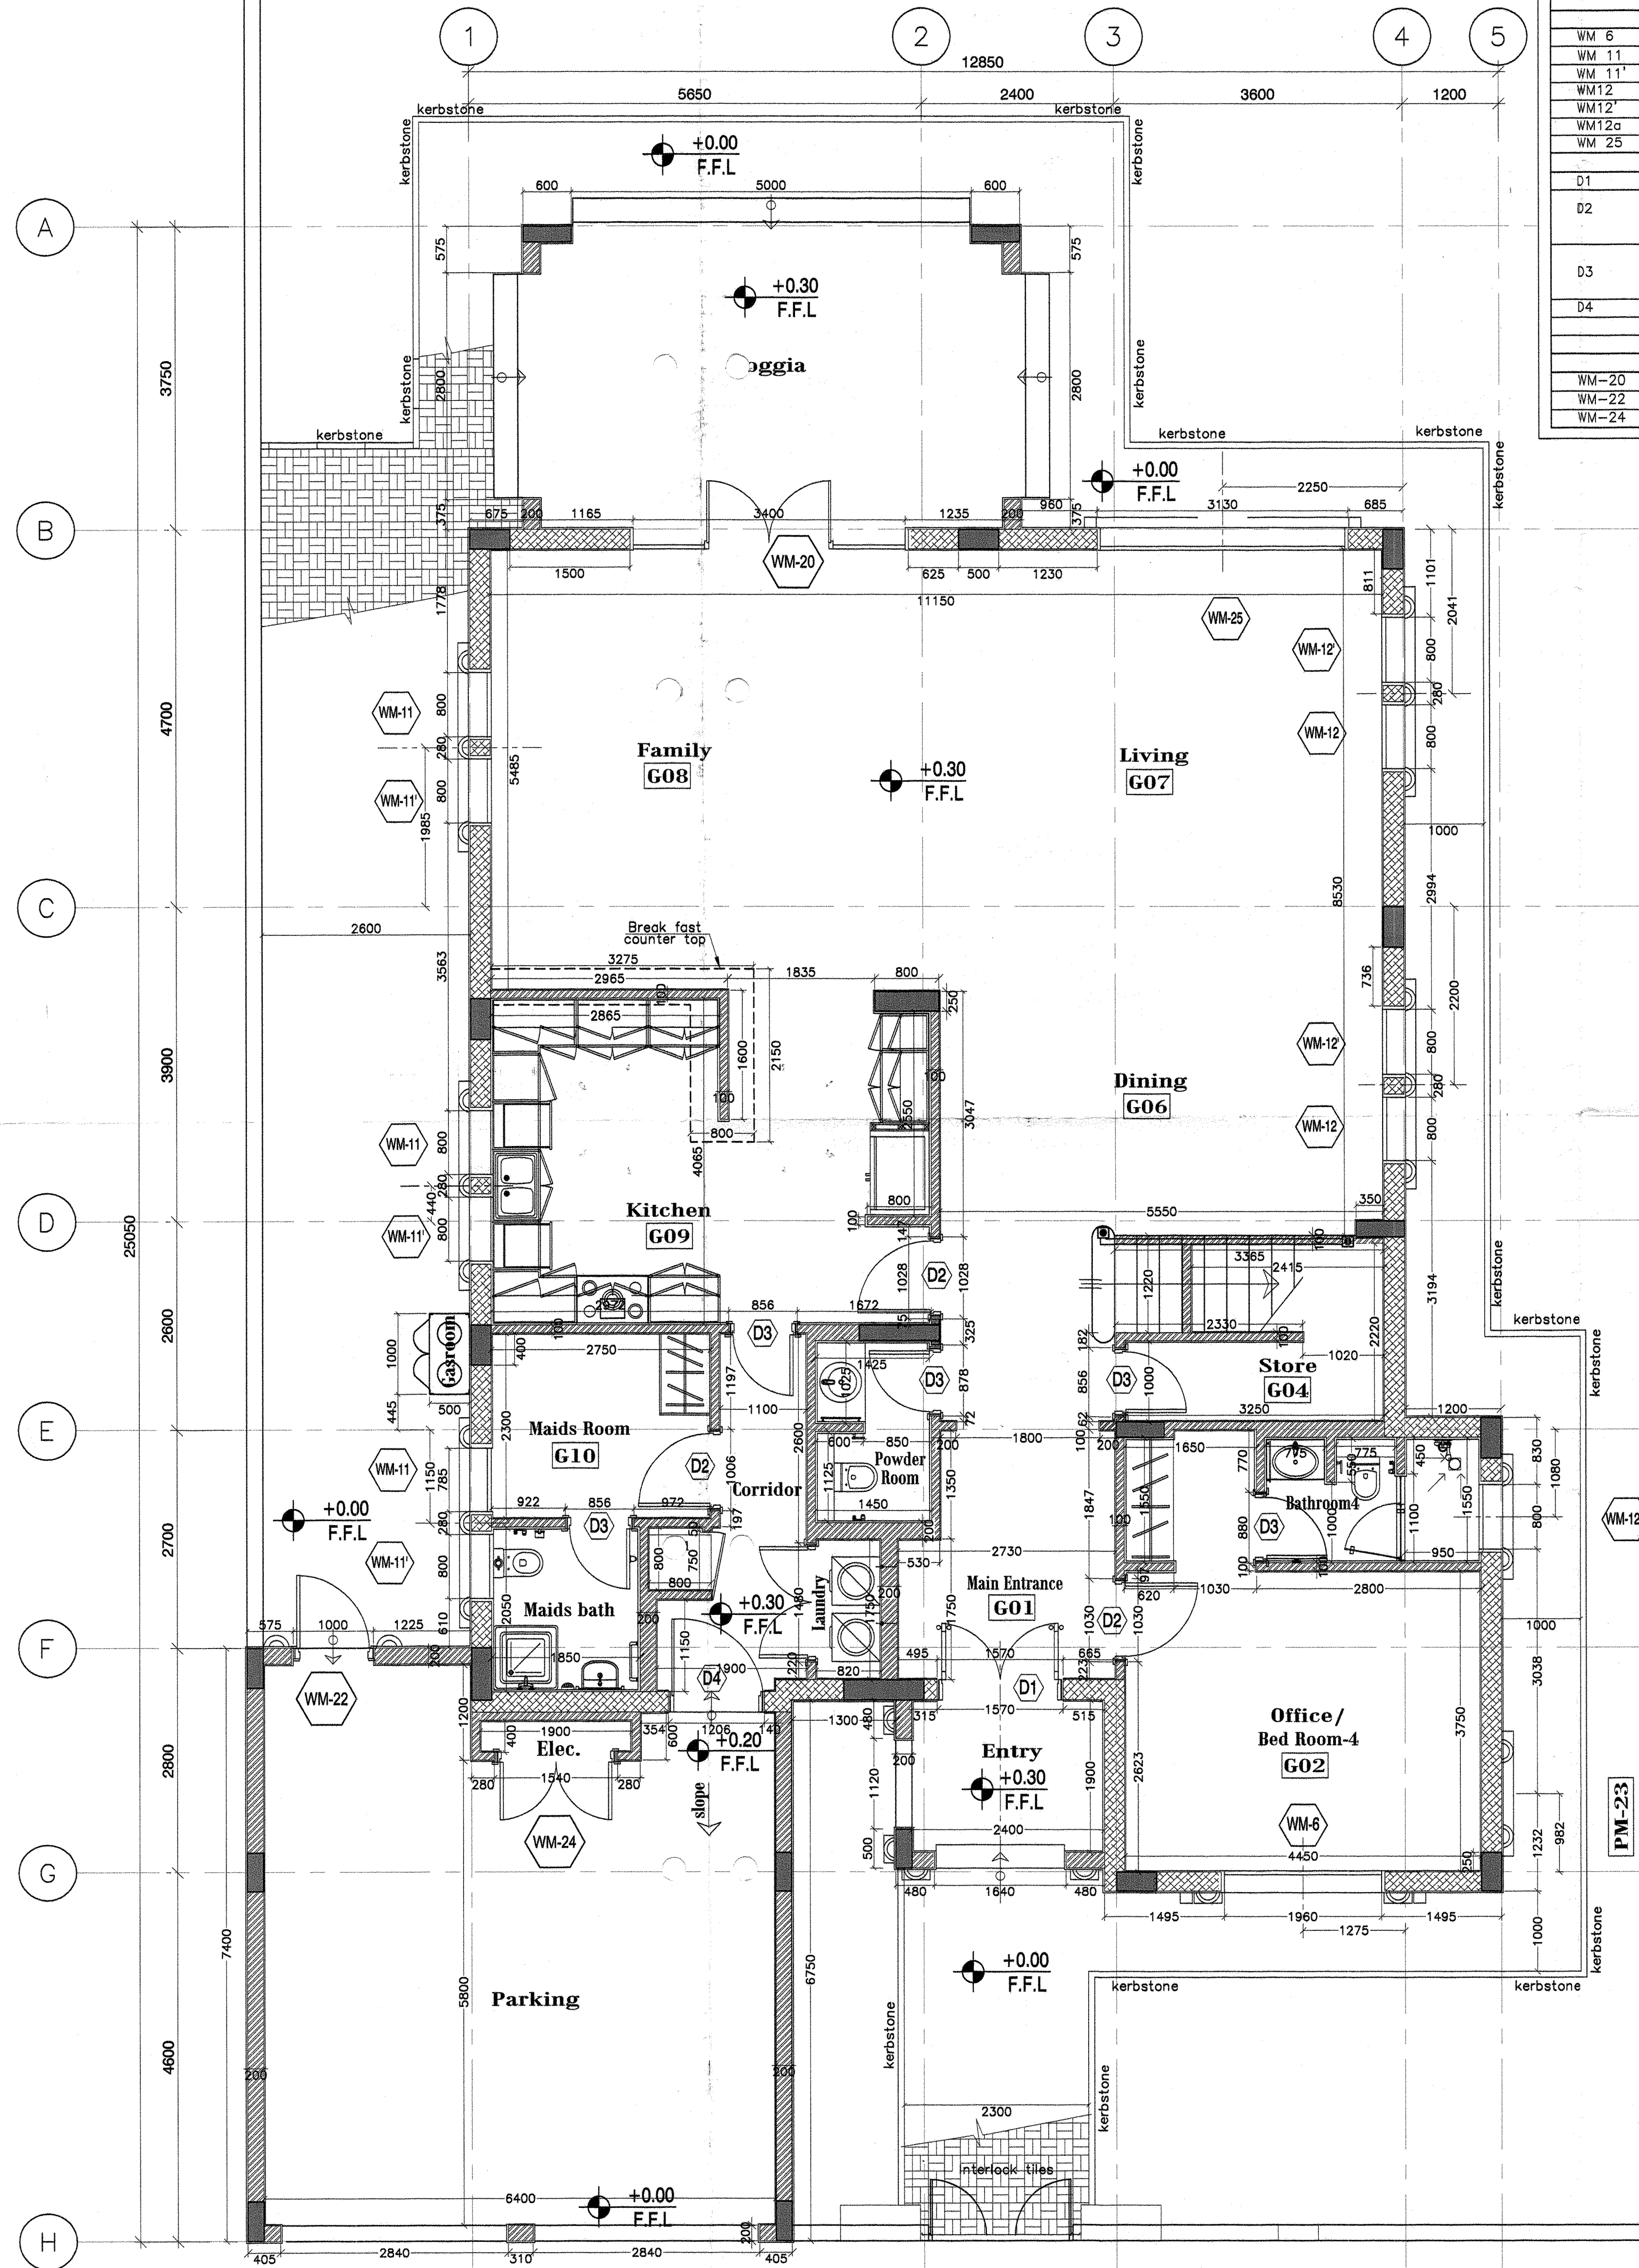


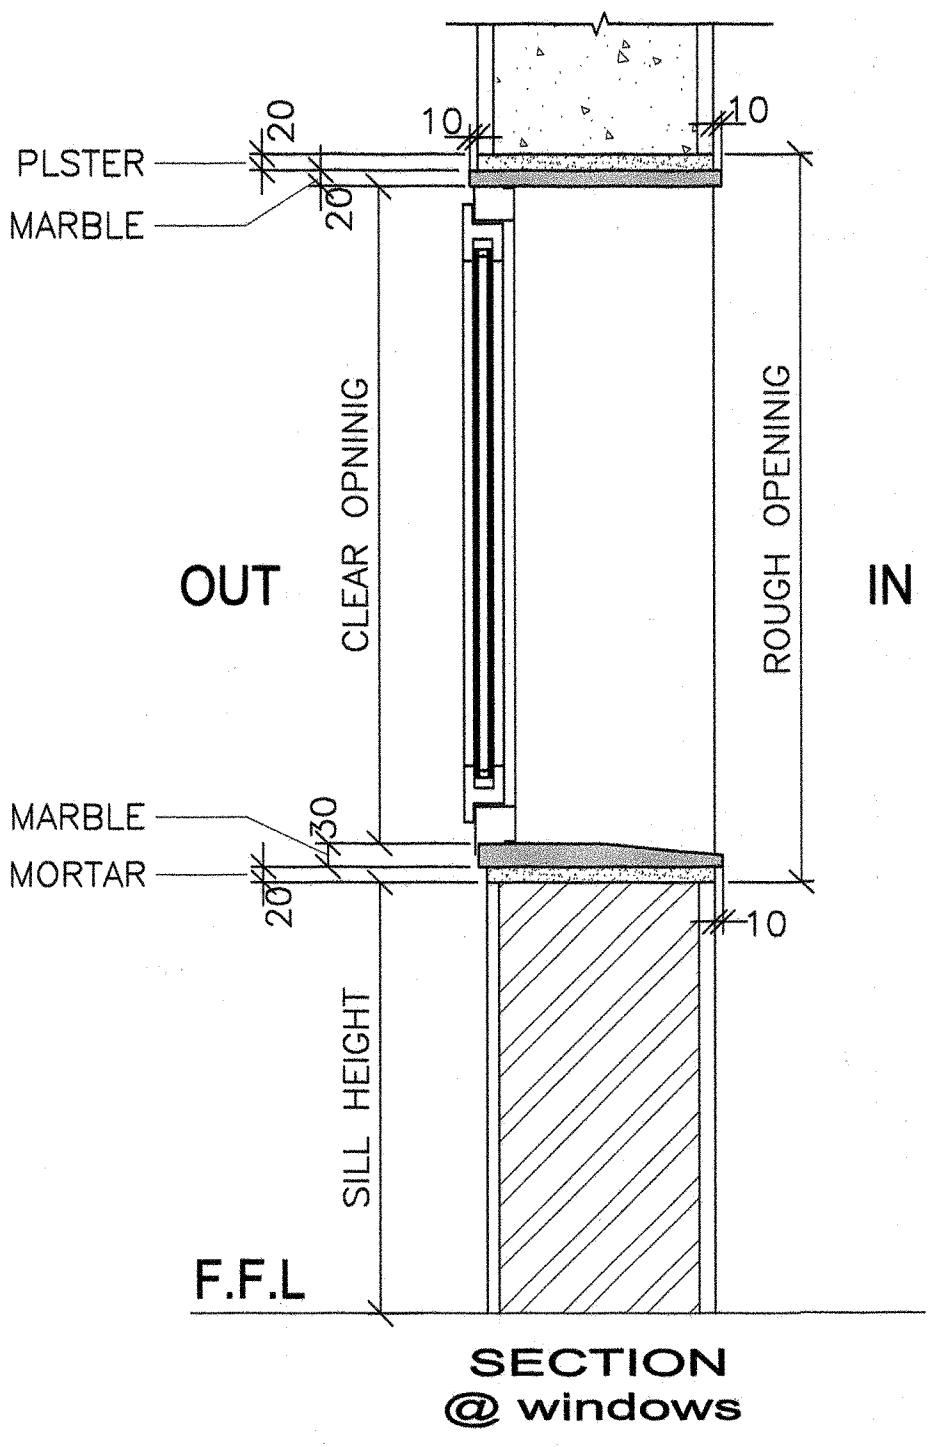

OPENING SCHEDULE (GROUND FLOOR)							
OPENING REF	LOCATION	QUANTITY	WIDTH (CLEAR OPENING)	WIDTH (ROUGH OPENING)	HEIGHT (CLEAR OPENING)	HEIGHT (ROUGH OPENING)	HEIGHT OF SILL FROM G.F. F.F.L.
ALUMINIUM WINDOWS							
WM 6	BED ROOM 4	1	1950	2030	1550	1640	850
WM 11	KITCHEN-FAMILY ROOM-MAID ROOM-MAID BATHROOM	3	800	880	1150	1240	1150
WM 11'	KITCHEN-FAMILY ROOM-MAID ROOM-MAID BATHROOM	3	800	880	1150	1250	1150
WM12	DINING-LIVING ROOM	2	800	880	1550	1640	850
WM12'	DINING-LIVING ROOM	2	800	880	1550	1640	850
WM12a	BATHROOM 4	1	800	880	1450	1540	850
WM 25	LIVING ROOM	1	3050	3130	1550	1640	850
WOODEN DOORS							
D1	MAIN DOOR	1	1400	1570	2135	2203	-
D2	OFFICE/BED ROOM-KITCHEN-MAID ROOM	3	870	1030	2135	2203	-
D3	BATH ROOM 4 STORE-POWDER ROOM-CORRIDORE-MAID ROOM	5	720	880	2135	2203	-
D4	PARKING LAUNDRY DU ROOM	1 1 1	1070 1400 700	1240 1480 740	2135 2150 2152	2203 2203 2203	- - -
ALUMINIUM DOORS							
WM-20	FAMILY ROOM	1	3400	3480	2300	2340	-
WM-22	PARKING	1	1000	1080	2400	2440	-
WM-24	ELEC. ROOM	1	1500	1540	2400	2440	-

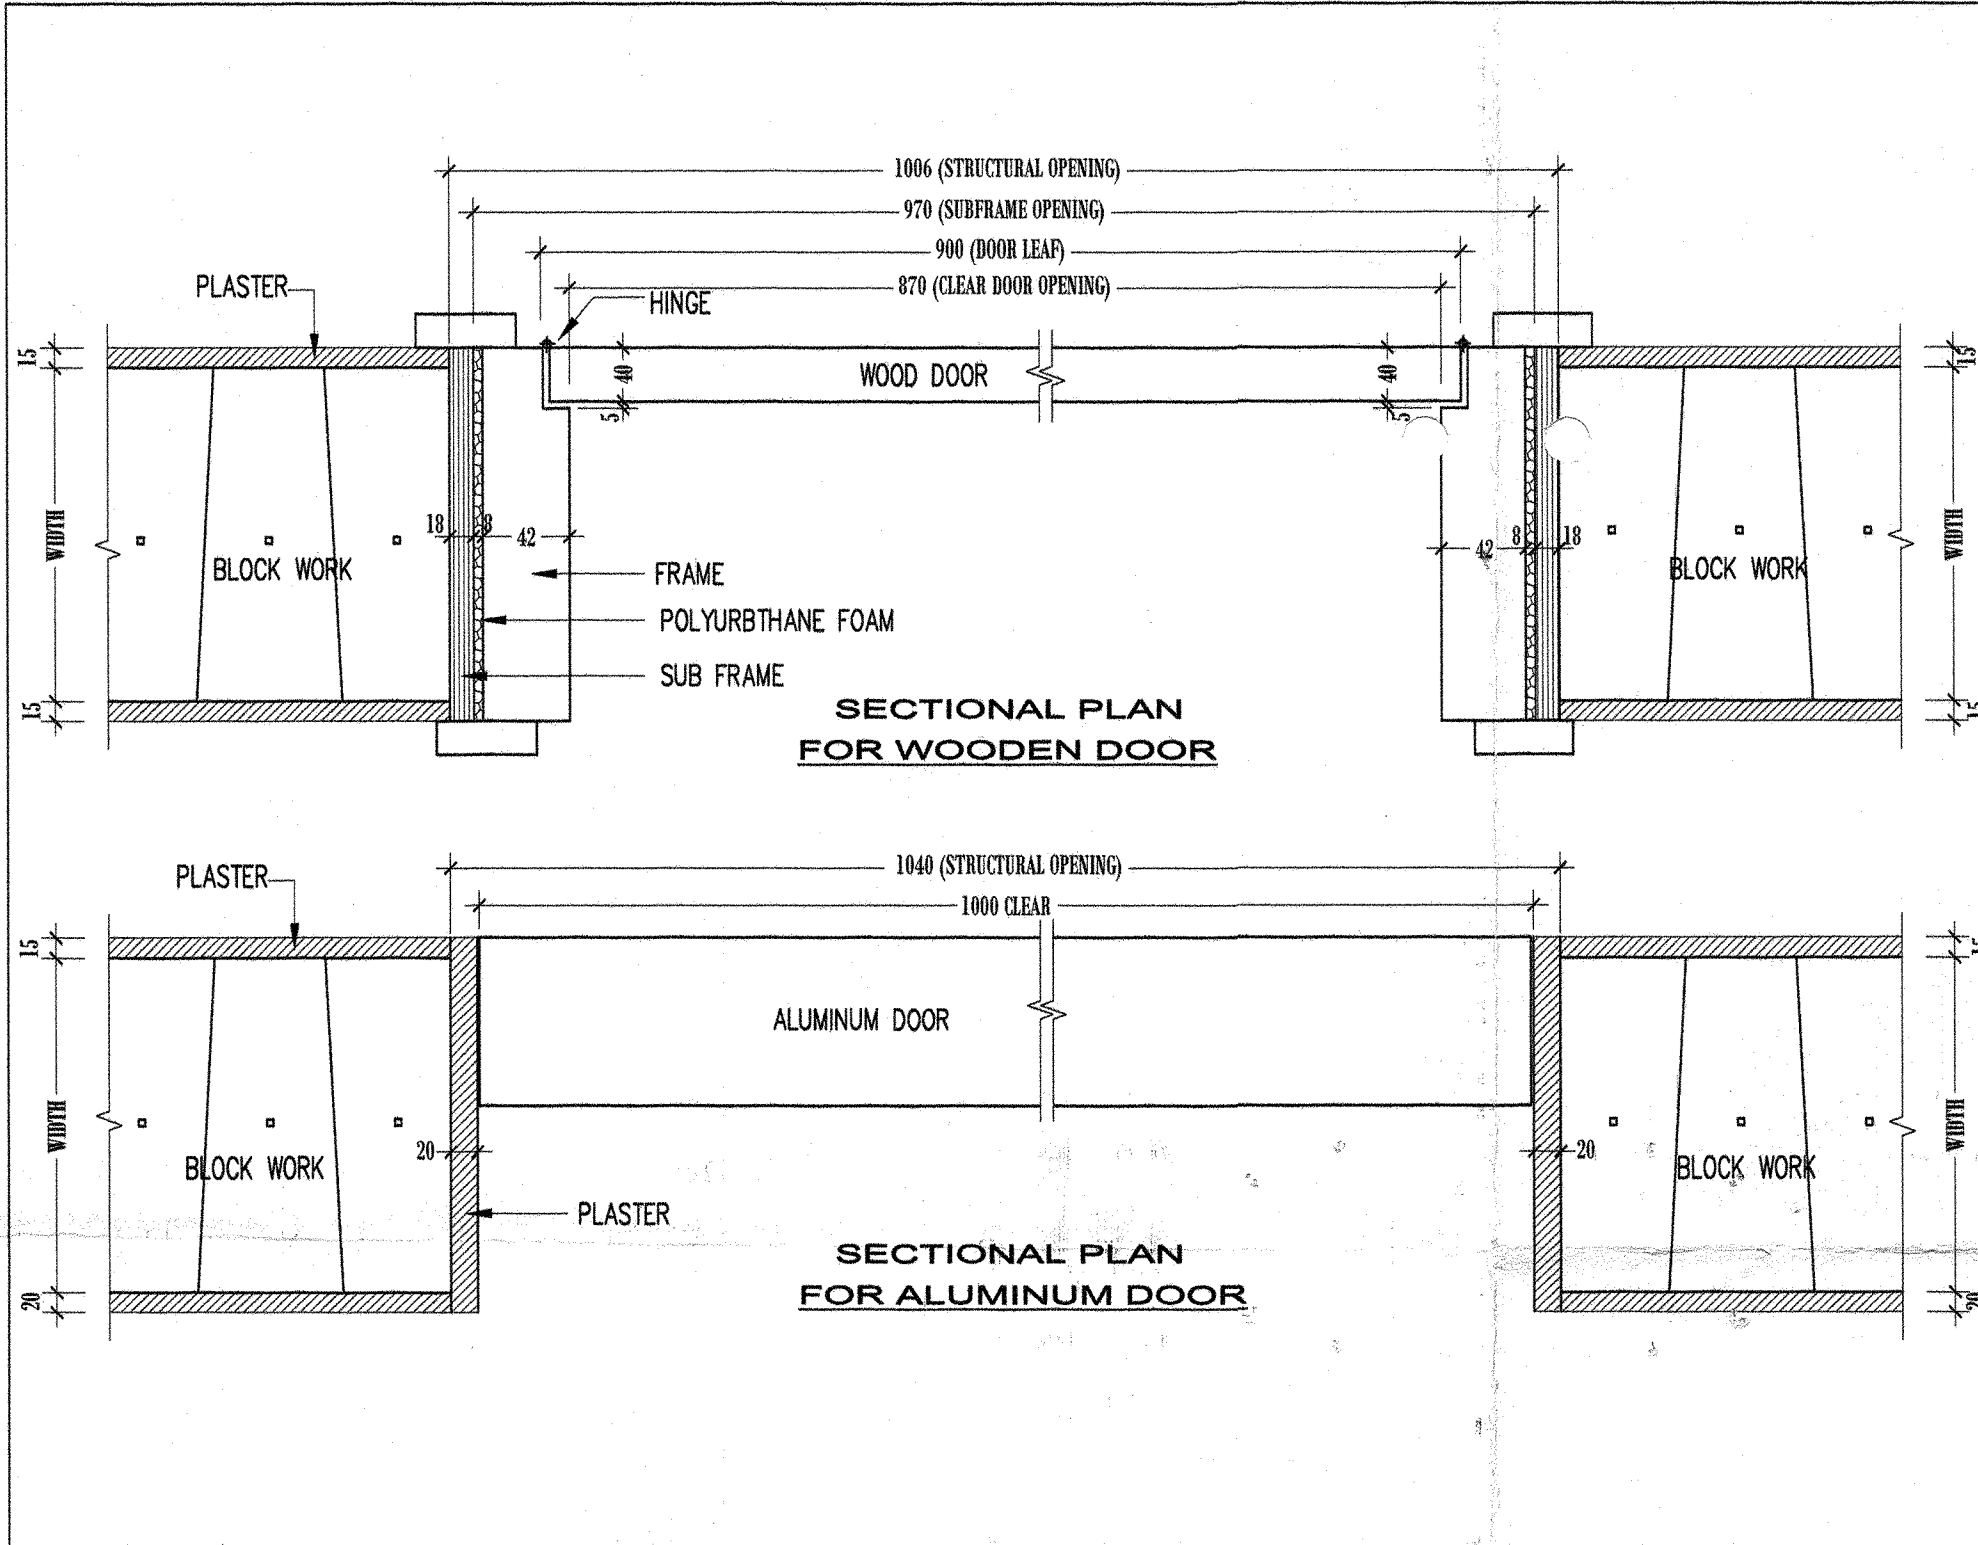

dar al-handasah shair and partners	
☒ CODE 1 APPROVED	
☐ CODE 2 APPROVED AS NOTED WORK MAY PROCEED SUBJECT TO INCORPORATION OF ENDORSED COMMENTS	
☐ CODE 3 RESUBMIT FOR APPROVAL WORK MAY NOT PROCEED	
☐ CODE 4 REJECTED	
BY: <i>SA</i> DATE: <i>11/05/2009</i>	
Approval shall not relieve the contractor of any of his obligations under the Contract or constitute authorization of any change to Contract Documents or variation to the works. Contractor is responsible for dimensions, quantities and coordination with other trades.	

Key plan

NOTE:

1. ALL DIMENSIONS ARE IN MILLIMETERS AND LEVELS ARE IN METERS

2. ALL EXTERNAL WALLS TO BE CONSTRUCTED WITH THERMAL BLOCKS

- ALL ROUGH OPENING ARE FROM BLOCK TO BLOCK
- CLEAR OPENING FOR ALUMINIUM DOORS & WINDOWS ARE FROM PLASTER TO PLASTER
- FOR MORE DETAILS REFER TO ATTACHED SECTION

LEGEND

- EXTERNAL BLOCK WALL(THERMAL BLOCK)
- HOLLOW BLOCK WALL
- R.C.COLUMN

1	30-05-09	REVISED AS PER CONSULTANT COMMENT		
0	03-05-09	SUBMITTED FOR APPROVAL	Eng.Siyad	Eng.Moh'd
Rev.	Date	Description	Drawn	Check

AS BUILT DWG

JUMAIRAH PARK

NAKHEEL

Bovis Lend Lease International Ltd.


dar al-handasah shair and partners

Pauling Middle East




PACKAGE - 2

LEGACY -TRADITIONAL GROUND FLOOR ARCHITECTURAL PLAN

Drawn Eng. Siyad	Review Eng. Moh'd Abdul Wahed	Checked: Eng.Charles Higgins
Scale: 1:50	Date: 03-05-09	
Drawing No.	PME/JP/AP-LE-001	REV 1

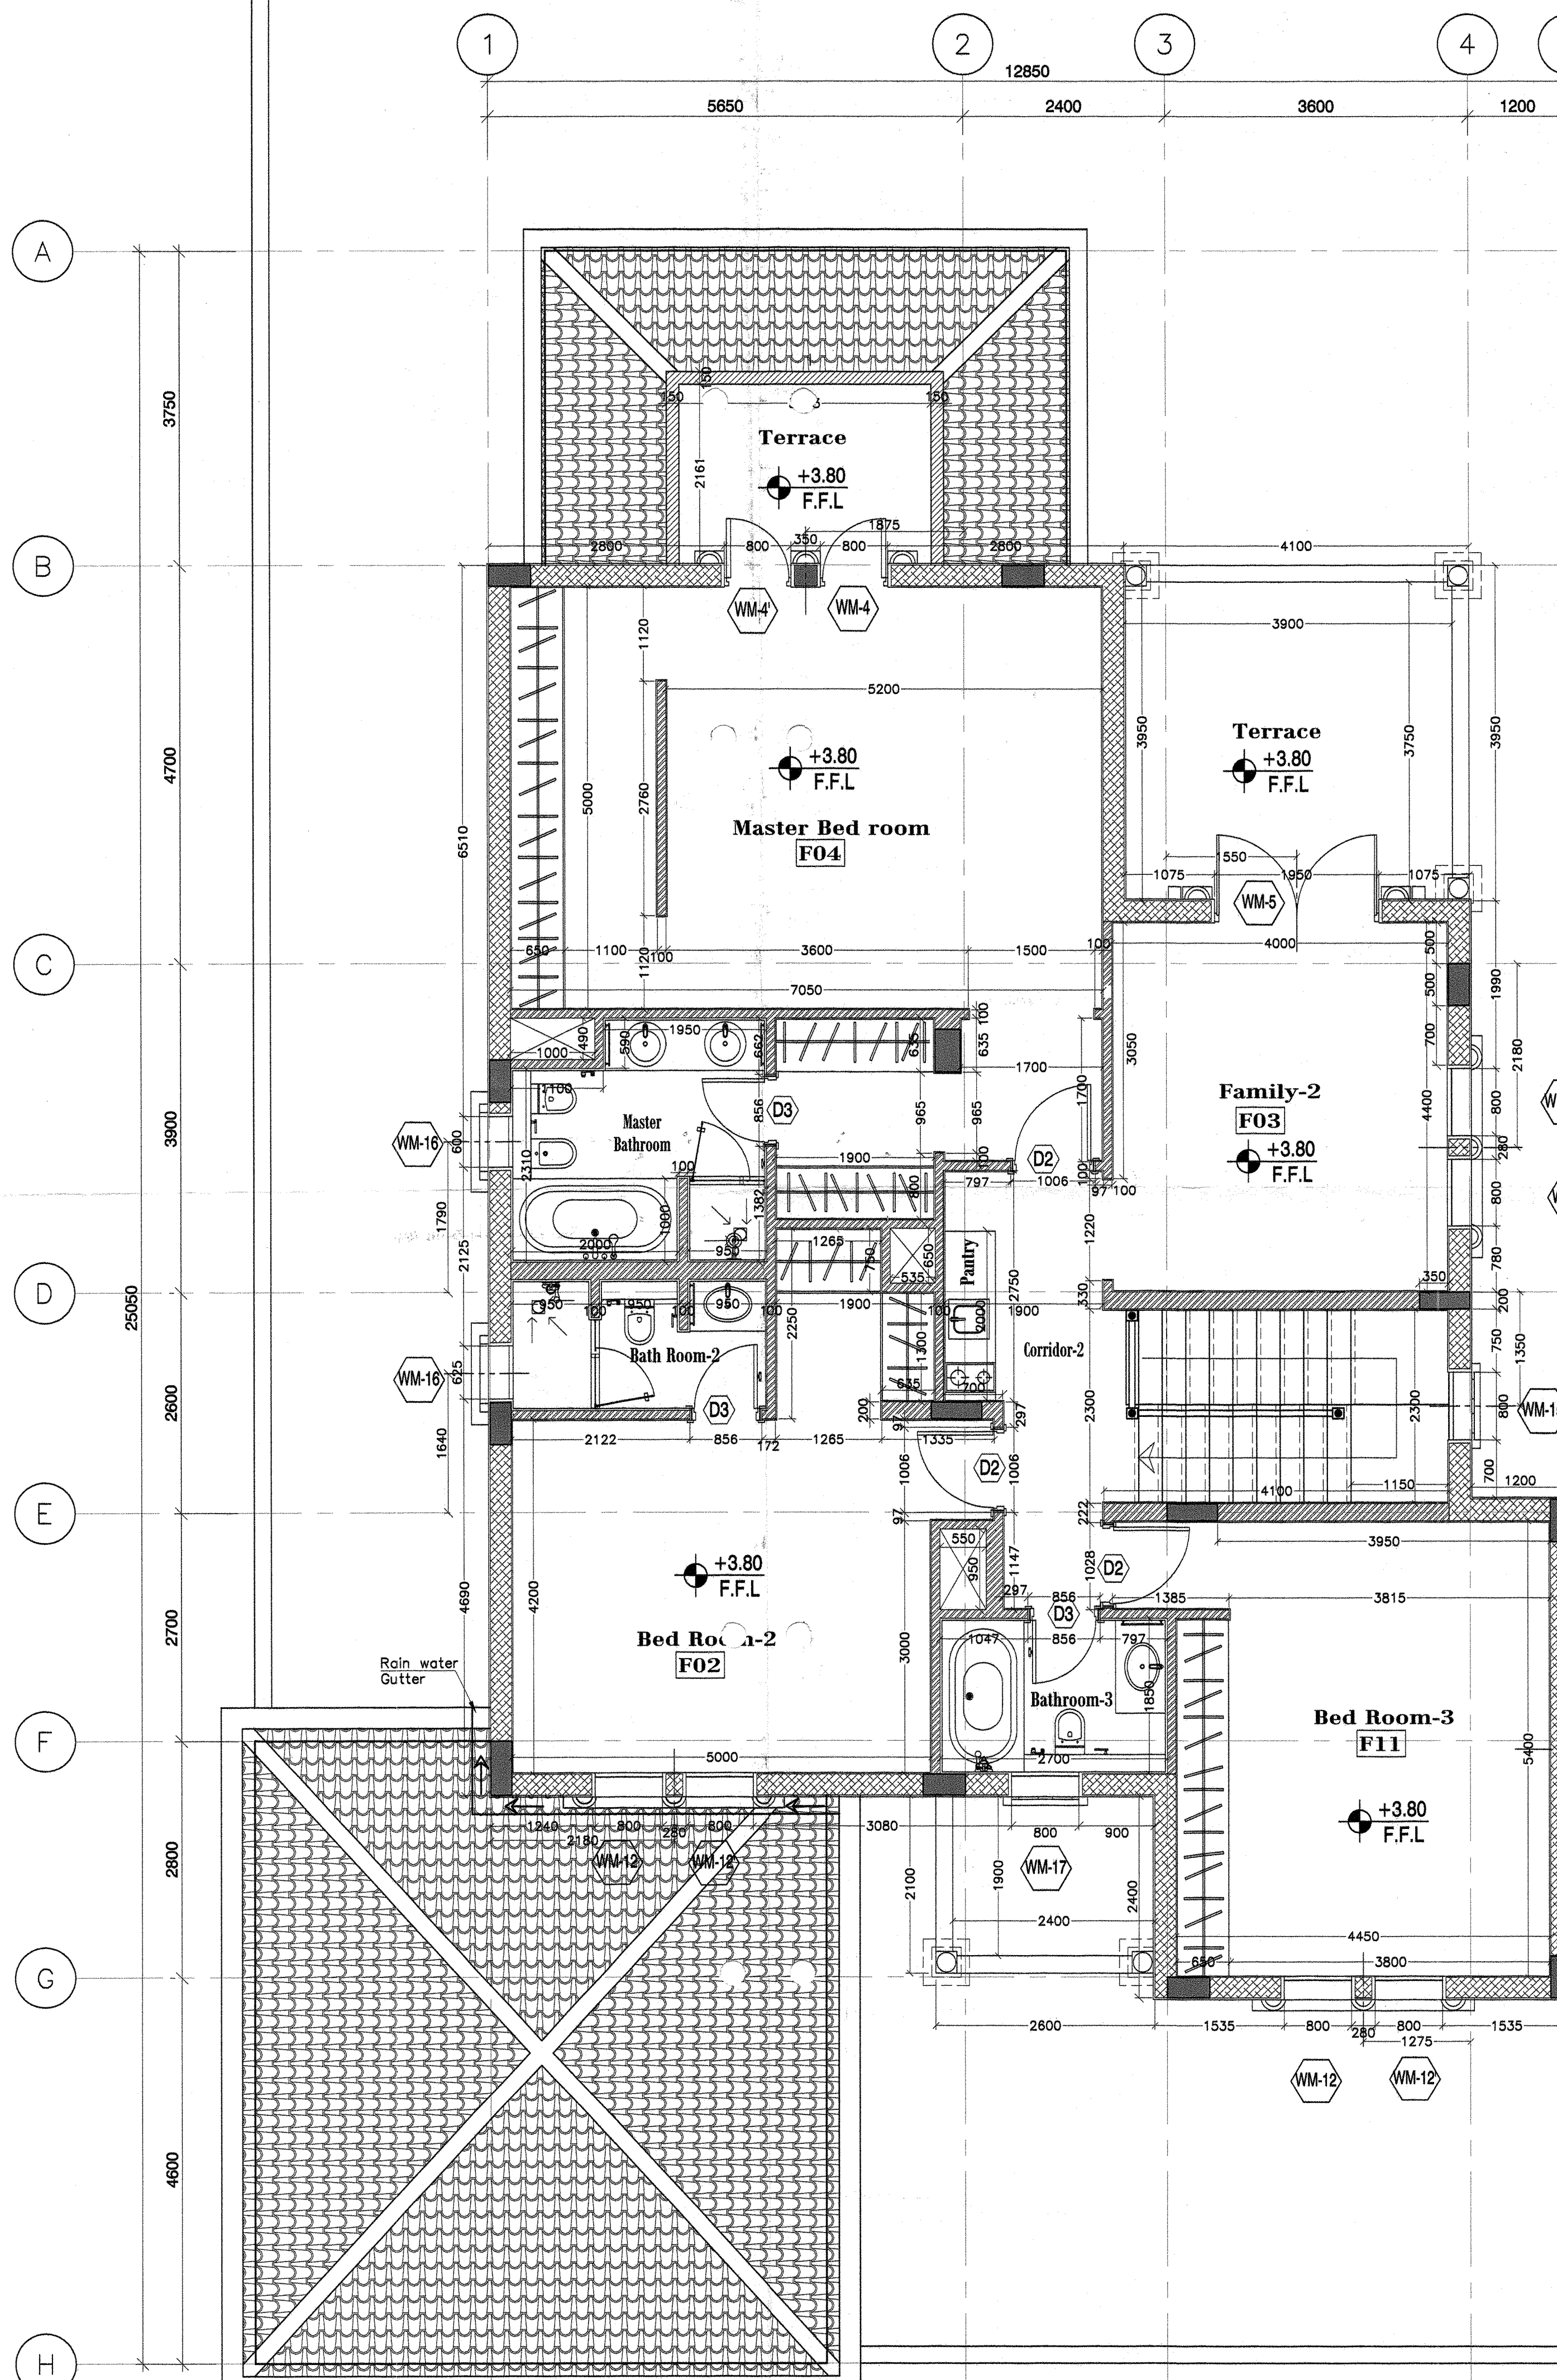

OPENING SCHEDULE (FIRST FLOOR)								
OPENING REF	LOCATION	QUANTITY	WIDTH (CLEAR OPENING)	WIDTH (ROUGH OPENING)	HEIGHT(CLEAR OPENING)	HEIGHT(ROUGH OPENING)	HEIGHT OF SILL FROM G.F.F.L	SHAPE
ALUMINIUM WINDOWS								
WM 12	FAMILY2-BEDROOM2-BEDROOM3	3	800	880	1550	1640	850	ARC
WM 12'	FAMILY2-BEDROOM2-BEDROOM3	3	800	880	1550	1640	850	ARC
WM 16	MASTER BATHROOM-BATHROOM2	2	600	680	900	990	1350	REC
WM 17	BATHROOM 3-STAIR CASE	2	R-400	R-440	R-400	R-440	1540 & 1580	CIRCULAR
WOODEN DOORS								
D2	MASTER BED ROOM BED ROOM 2 BED ROOM 3	3	870	1030	2135	2203	-	REC
D3	MASTER BATH ROOM BATH ROOM 2 BATH ROOM 3	3	720	880	2135	2203	-	REC
ALUMINIUM DOORS								
WM 4	MASTER BED ROOM	1	800	880	2450	2490	-	ARC
WM 4'	MASTER BED ROOM	1	800	880	2450	2490	-	ARC
WM 5	FAMILY 2	1	1950	2050	2450	2490	-	ARC

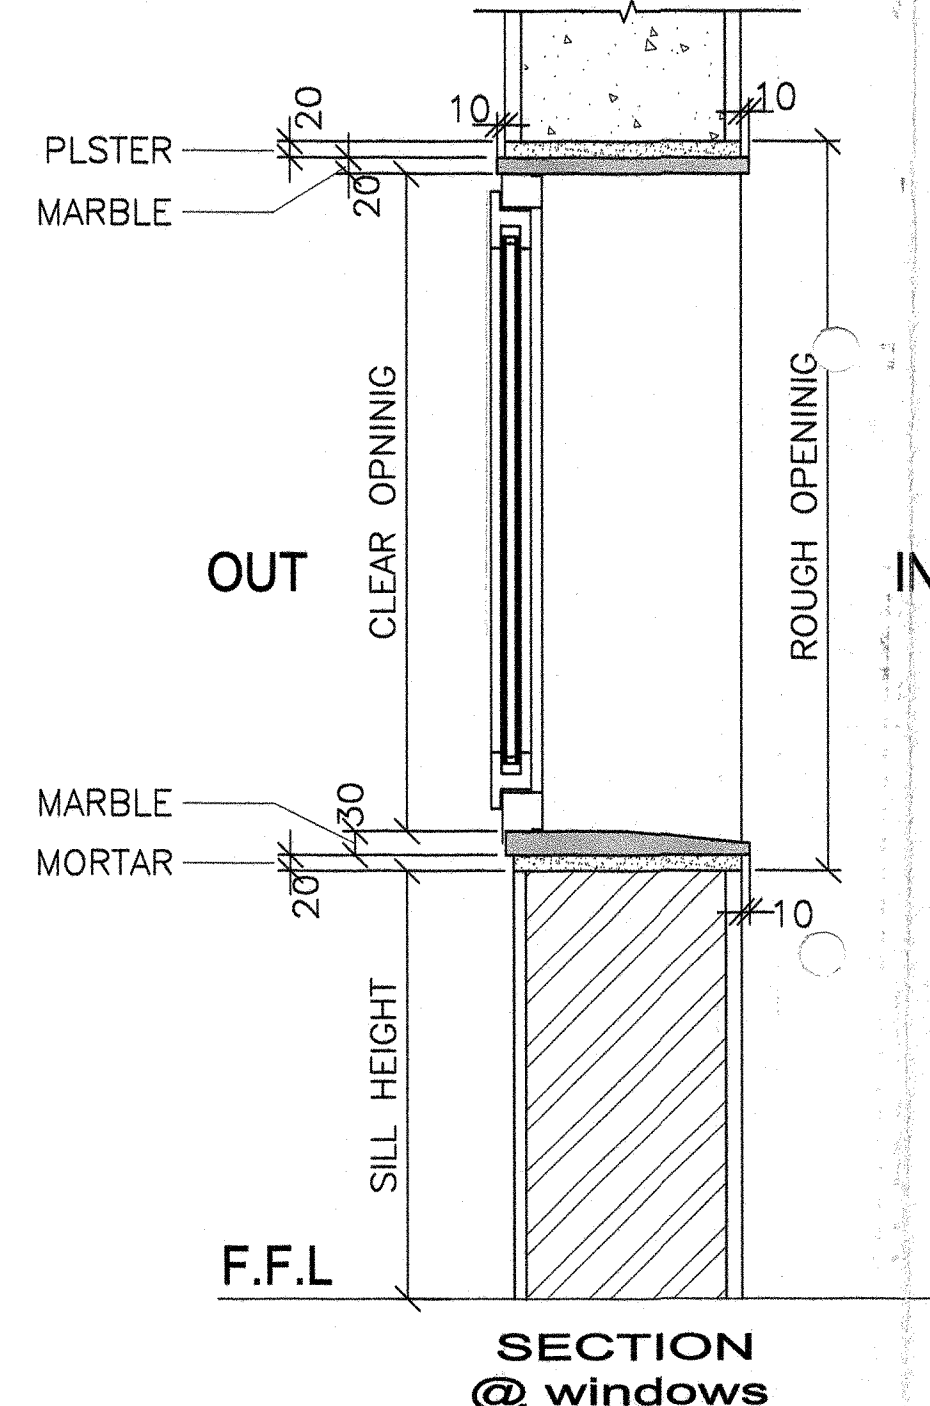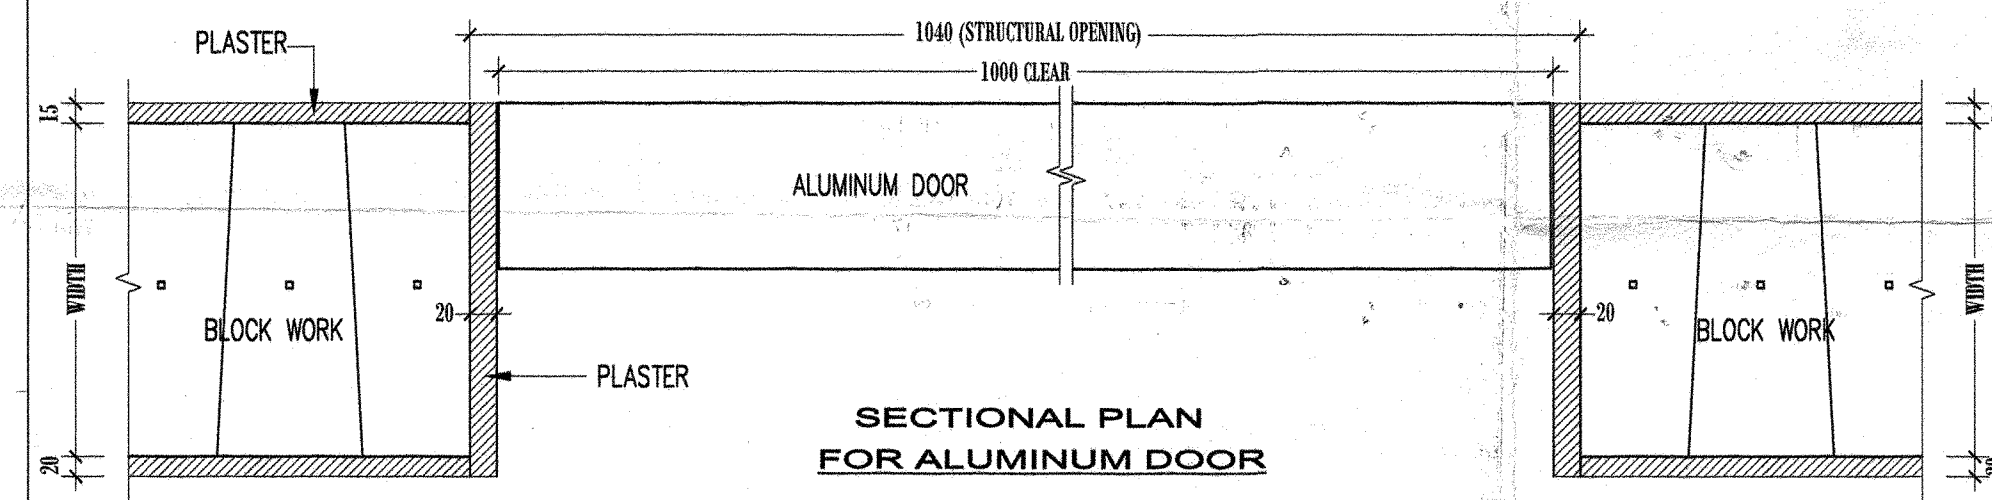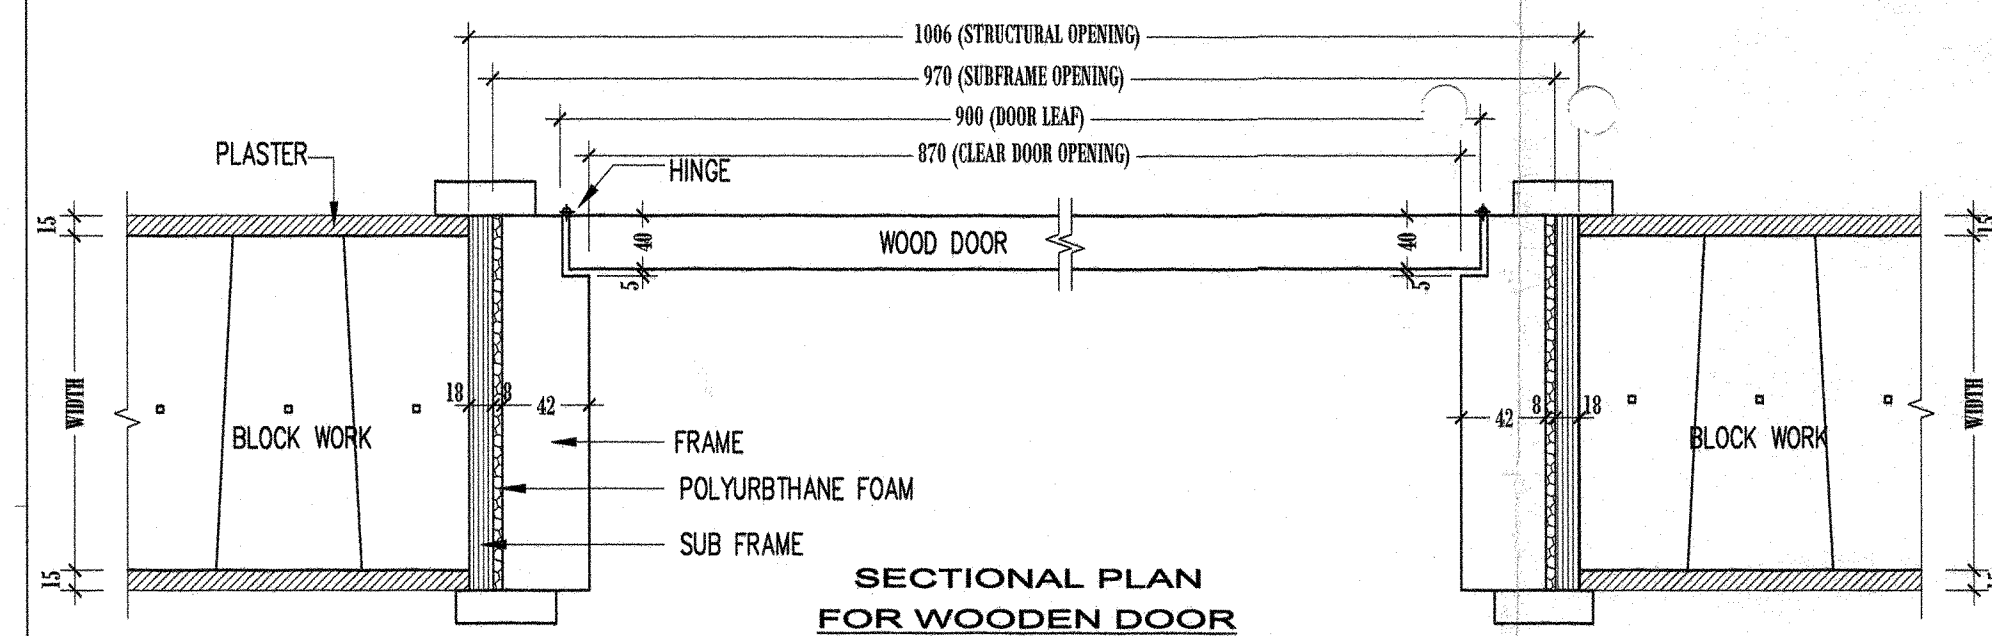

☒	CODE 1	APPROVED
☐	CODE 2	APPROVED AS NOTED WORK MAY PROCEED SUBJECT TO INCORPORATION OF ENDORSED COMMENTS
☐	CODE 3	RESUBMIT FOR APPROVAL WORK MAY NOT PROCEED
☐	CODE 4	REJECTED

BY: *[Signature]* DATE: 11/05/09

Approval shall not relieve the contractor of any of his obligations under the Contract or constitute authorization of any change to Contract Documents or variation to the work. Contractor is responsible for dimensions, quantities and coordination with other trades.

Key plan

NOTE:
1. ALL DIMENSIONS ARE IN MILLIMETERS AND LEVELS ARE IN METERS
2. ALL EXTERNAL WALLS TO BE CONSTRUCTED WITH THERMAL BLOCKS

◇ ALL ROUGH OPENING ARE FROM BLOCK TO BLOCK
◇ CLEAR OPENING FOR ALUMINIUM DOORS & WINDOWS ARE FROM PLASTER TO PLASTER
◇ FOR MORE DETAILS REFER TO ATTACHED SECTION

LEGEND

EXTERNAL BLOCK WALL(THERMAL BLOCK)
HOLLOW BLOCK WALL
R.C.COLUMN

Rev.	Date	Description	Drawn	Check
1	30-05-09	REVISED AS PER CONSULTANT COMMENT		
0	03-05-09	SUBMITTED FOR APPROVAL	Eng.Siyad	Eng.Moh'd

AS BUILT DWG
JUMAIRAH PARK

NAKHEEL
Employer

Bovis Lend Lease International Ltd.
Project Manager

dar al-handasah shair and partners
Consultant

Pauling Middle East
Main Contractor

PACKAGE - 2

LEGACY -TRADITIONAL
FIRST FLOOR ARCHITECTURAL PLAN

Drawn	Eng. Siyad	Review	Eng. Moh'd Abdul Wahed	Checked:	Eng.Charles Higgins
Scale:	1:50	Date:	03-05-09		

Drawing No.	PME/JP/AP-LE-002	REV	1
-------------	-------------------------	-----	----------