

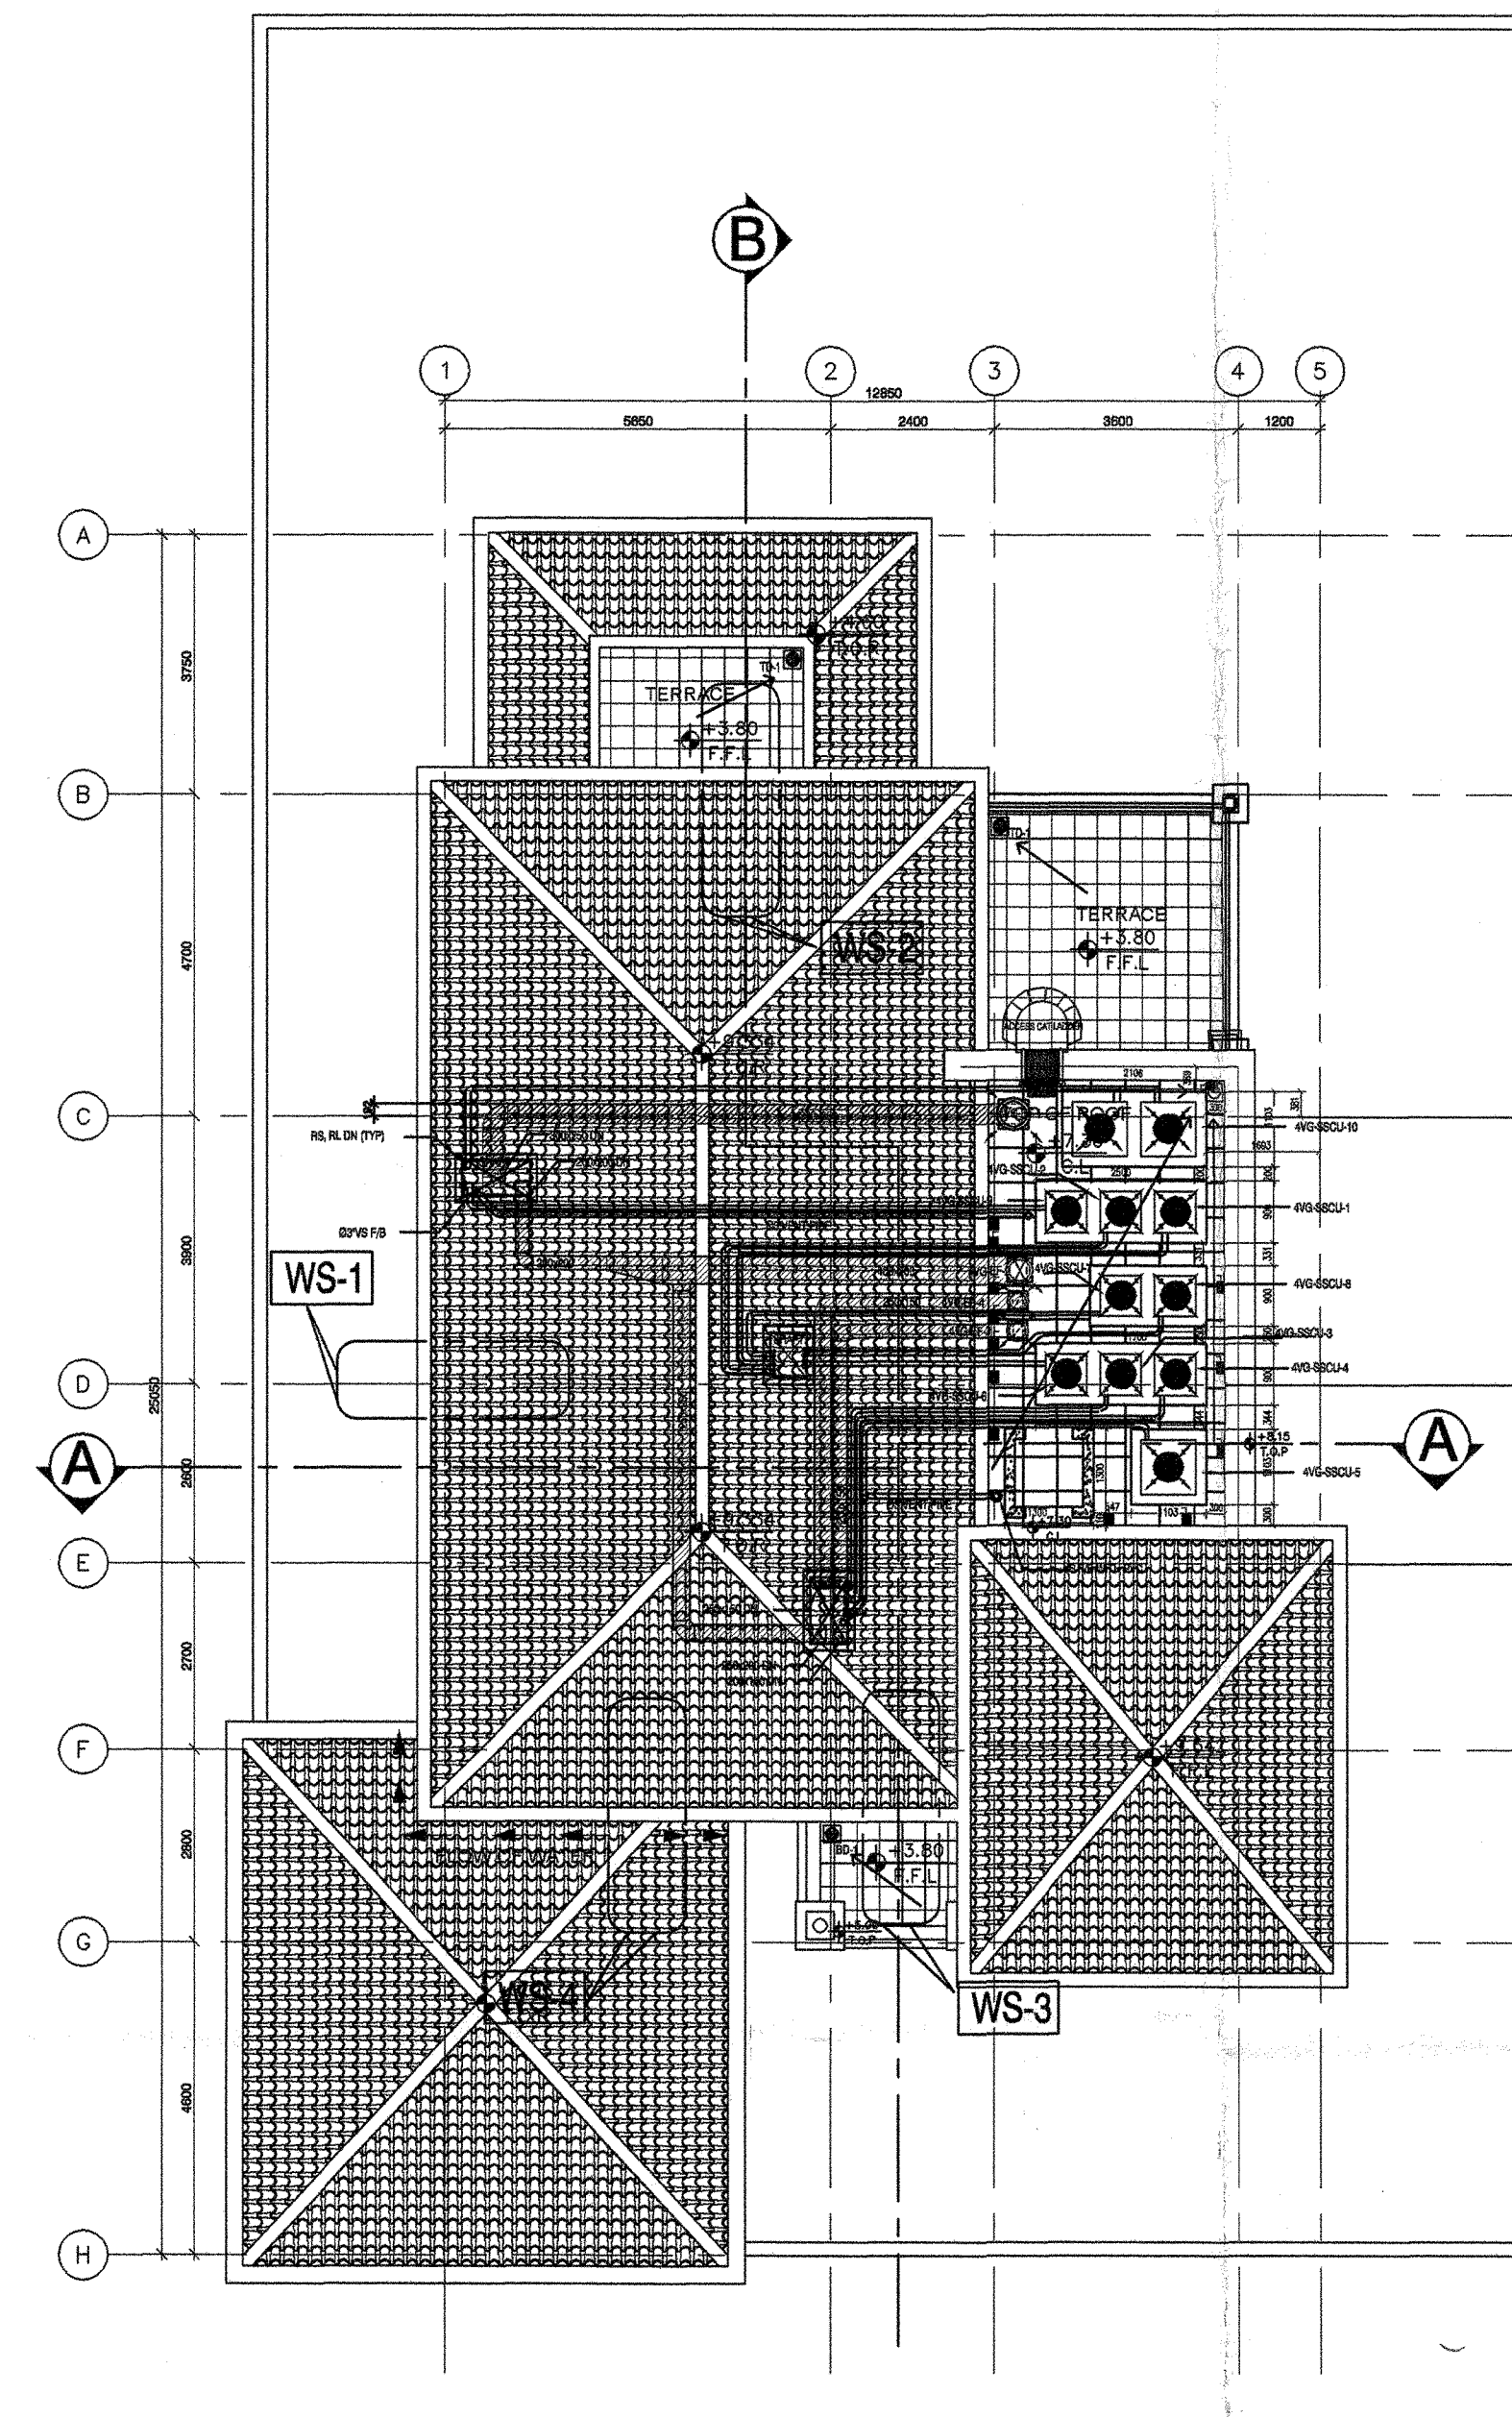
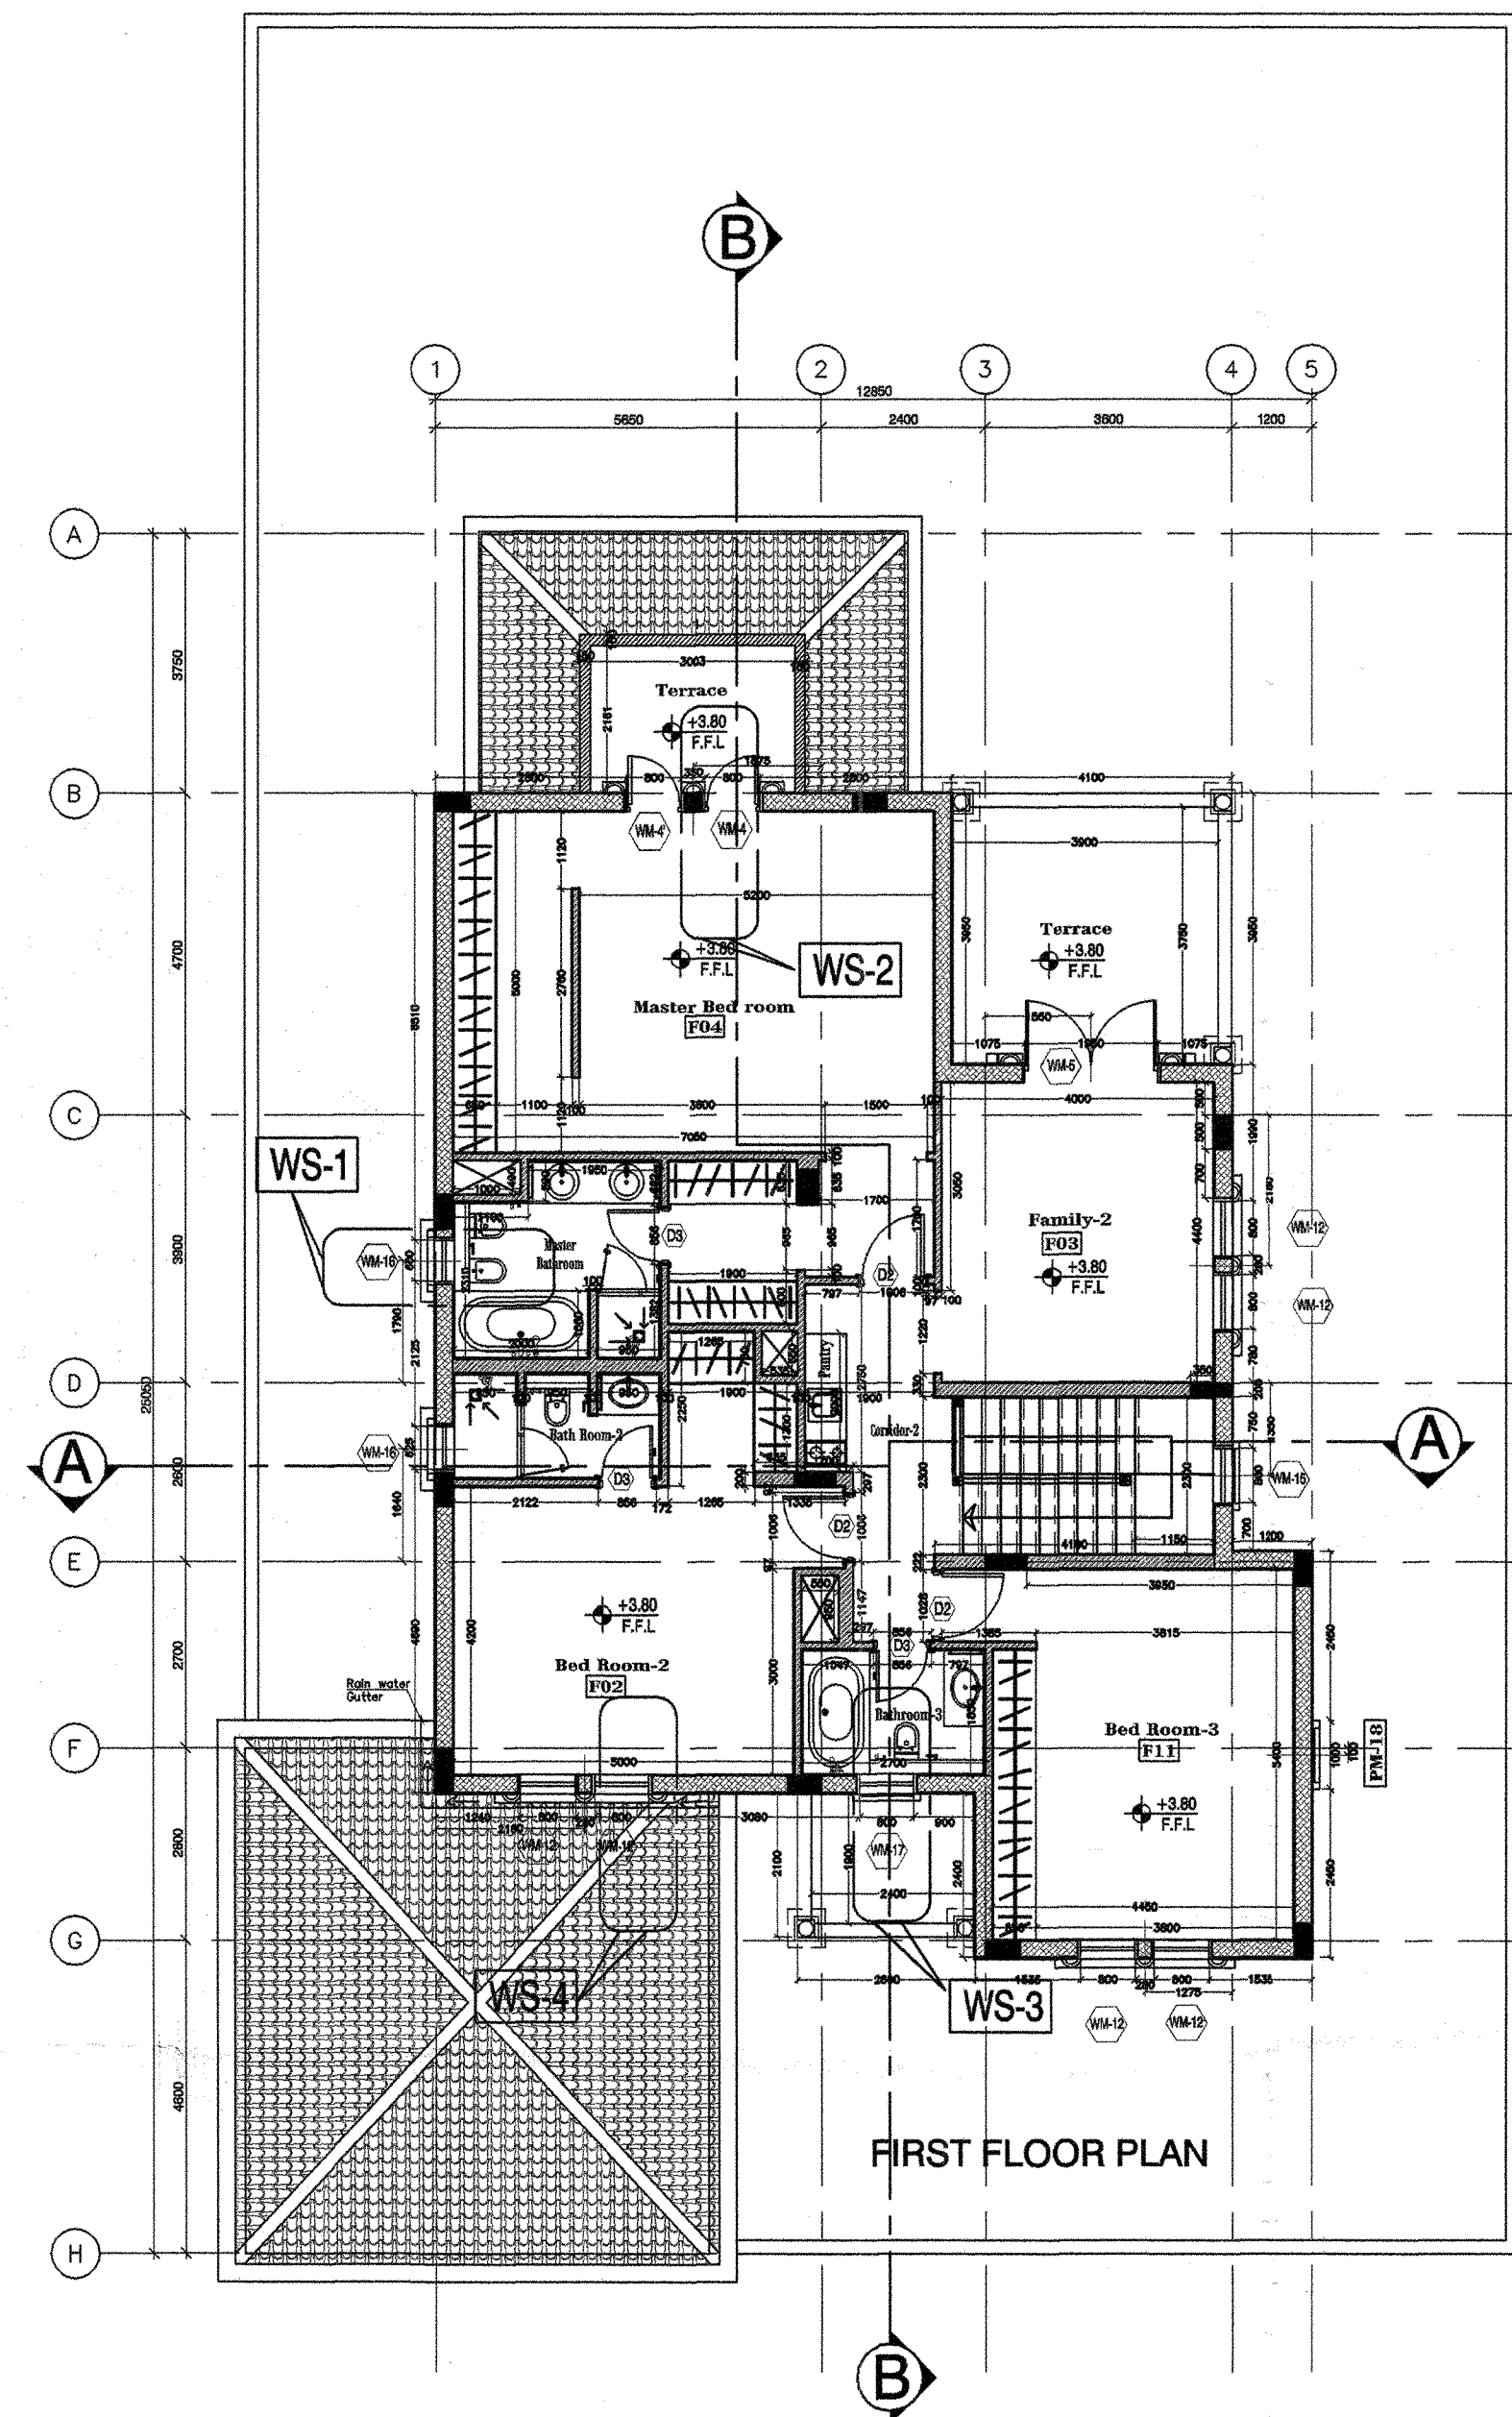
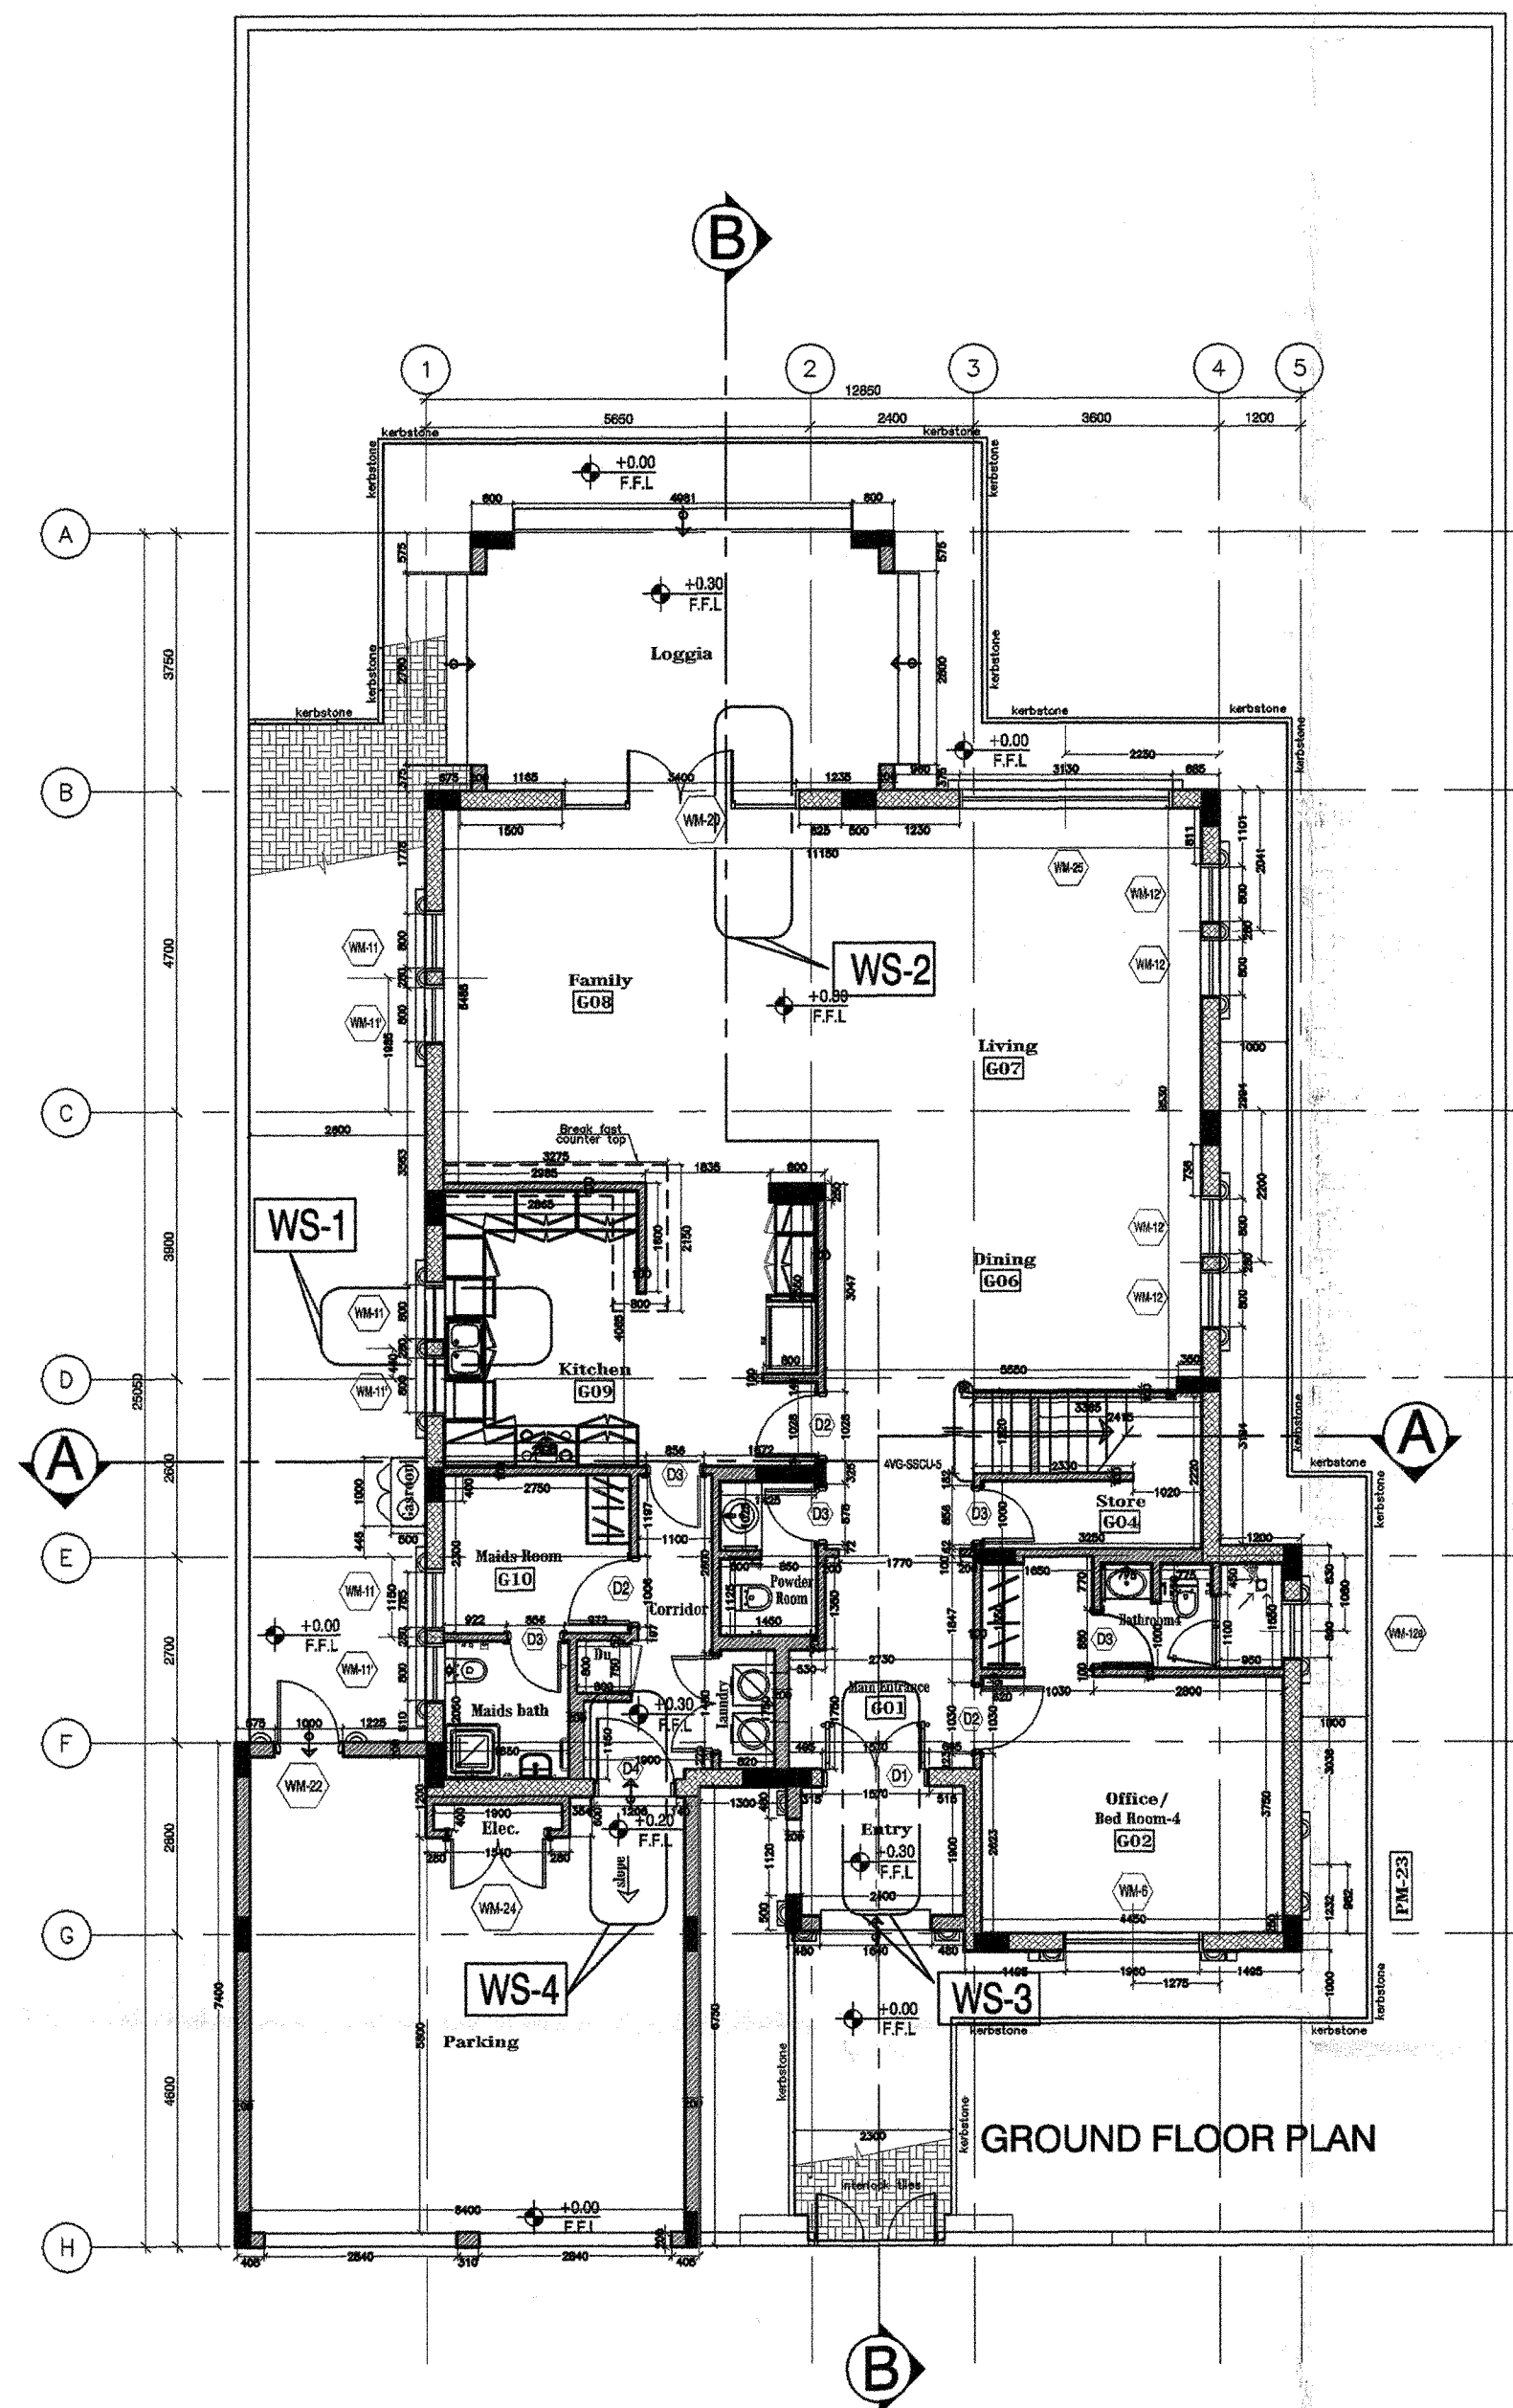


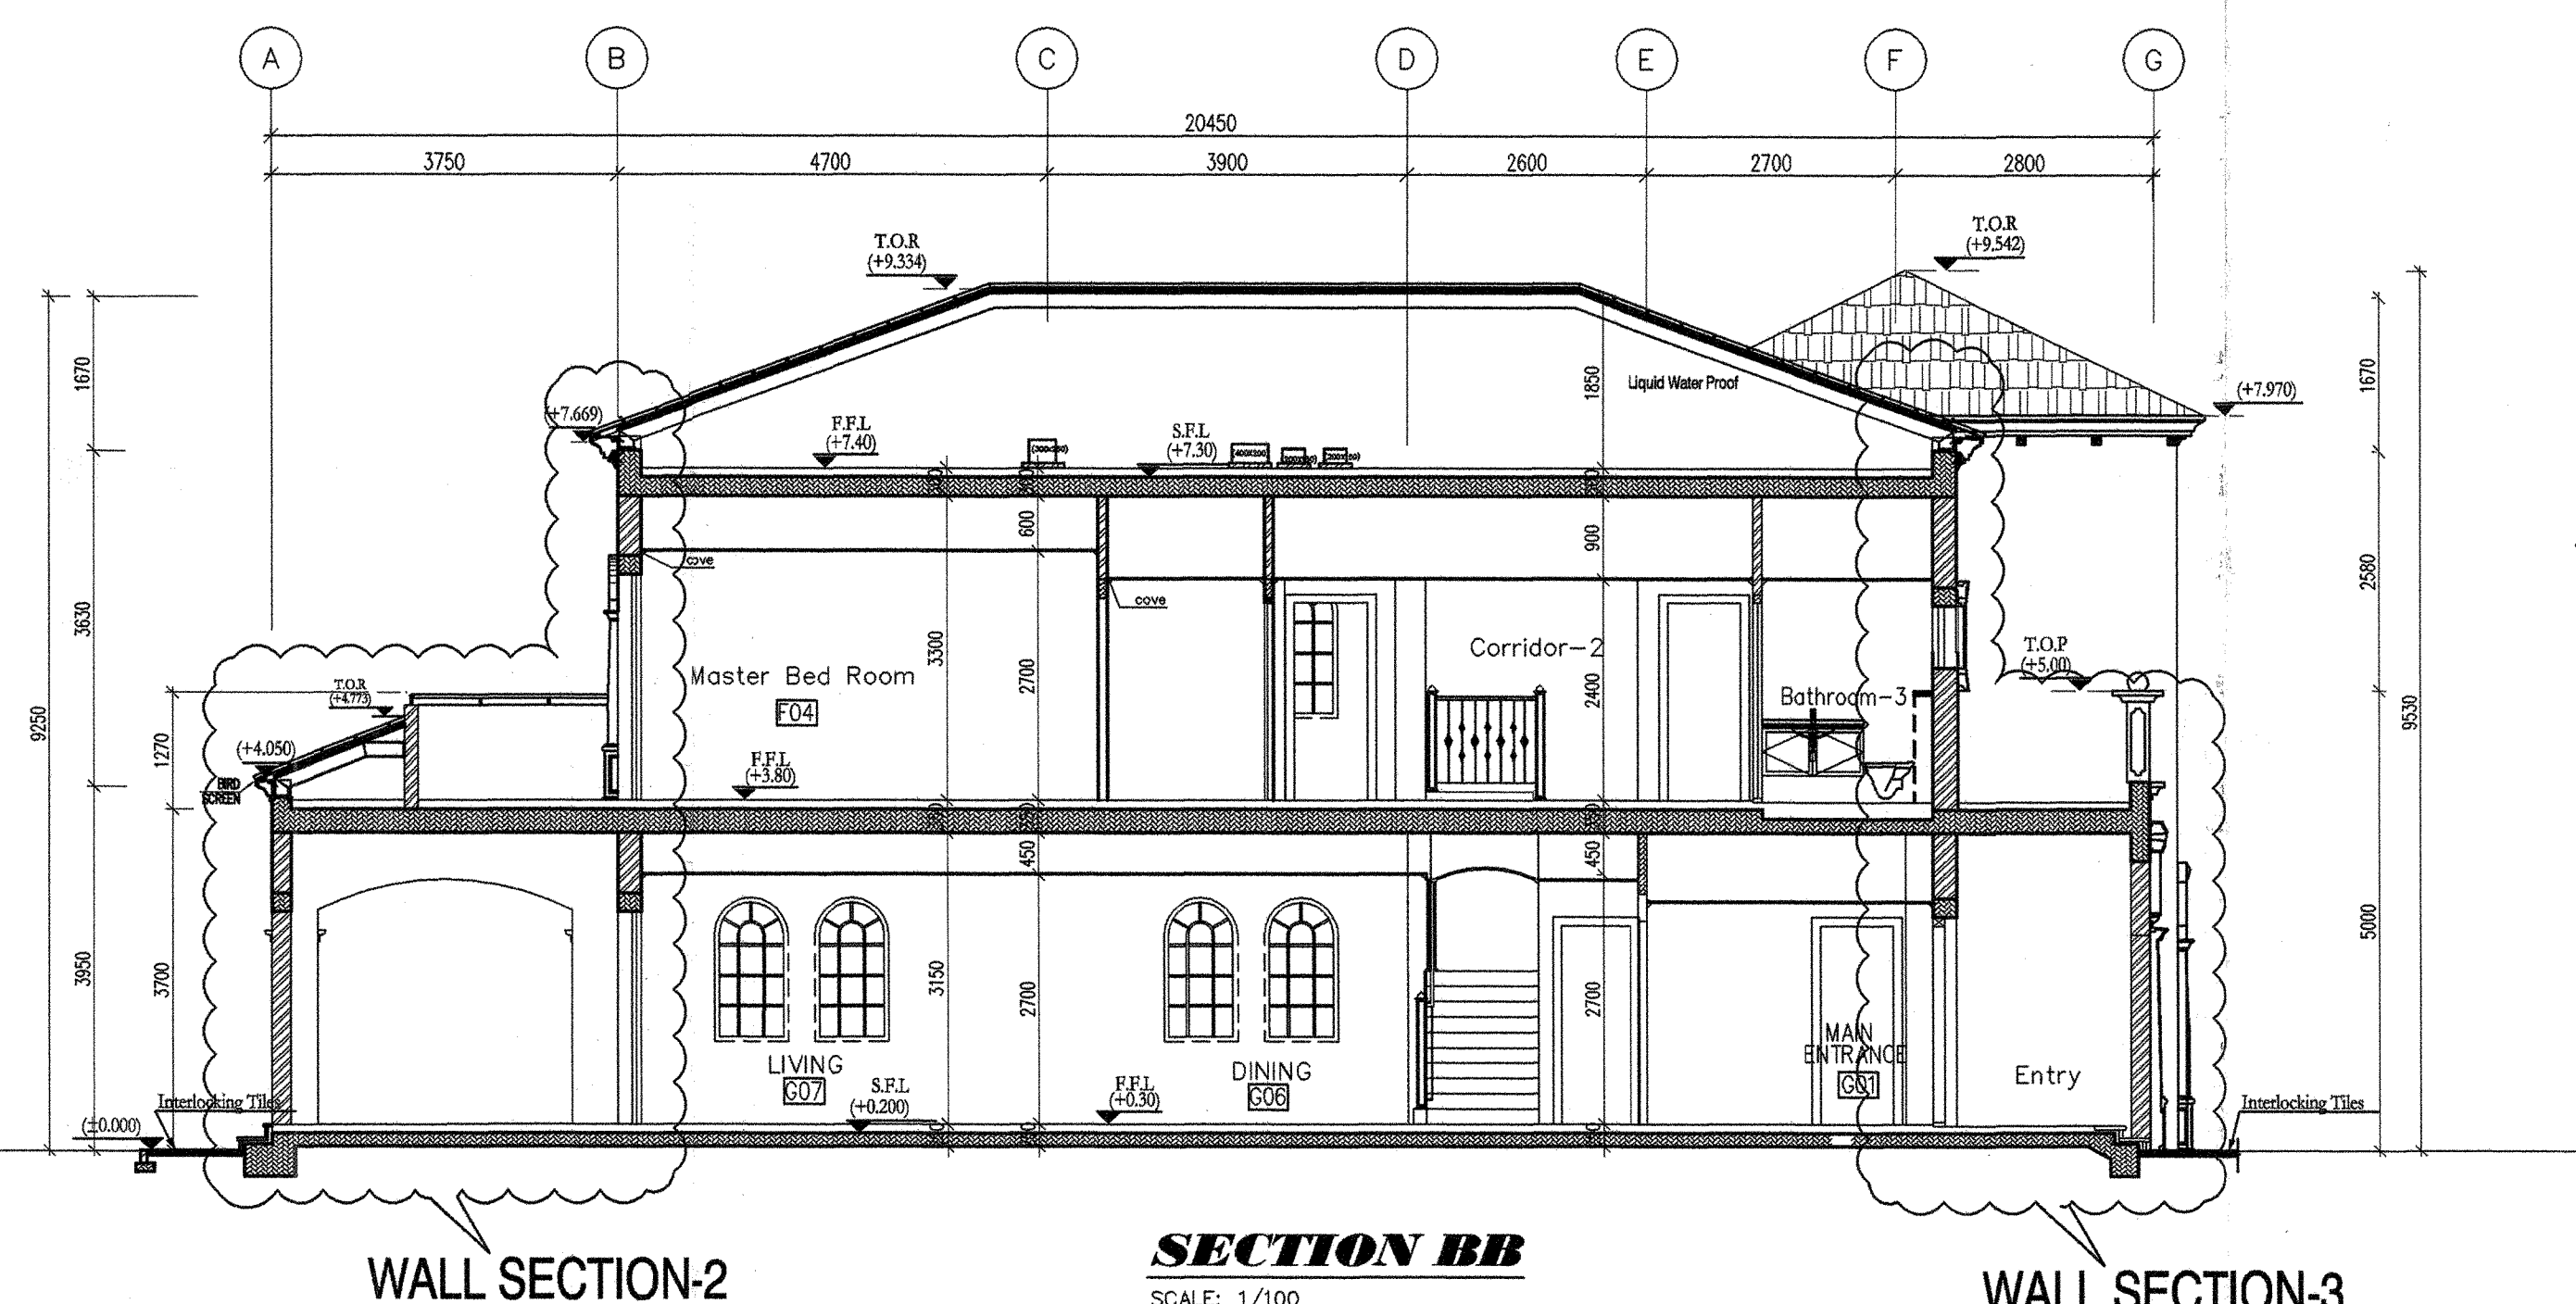

dar al-handasah Shair and Partners	
☒ CODE 1	APPROVED
☐ CODE 2	APPROVED AS NOTED WORK MAY PROCEED SUBJECT TO INCORPORATION OF ENDORSED COMMENTS
☐ CODE 3	RESUBMIT FOR APPROVAL WORK MAY NOT PROCEED
☐ CODE 4	REJECTED
BY:	DATE:
Approval shall not relieve the contractor of any of his obligations under the Contract or constitute authorization of any change to Contract Documents or variation to the works. Contractor is responsible for dimensions, quantities and coordination of all trades.	

12 of 2012

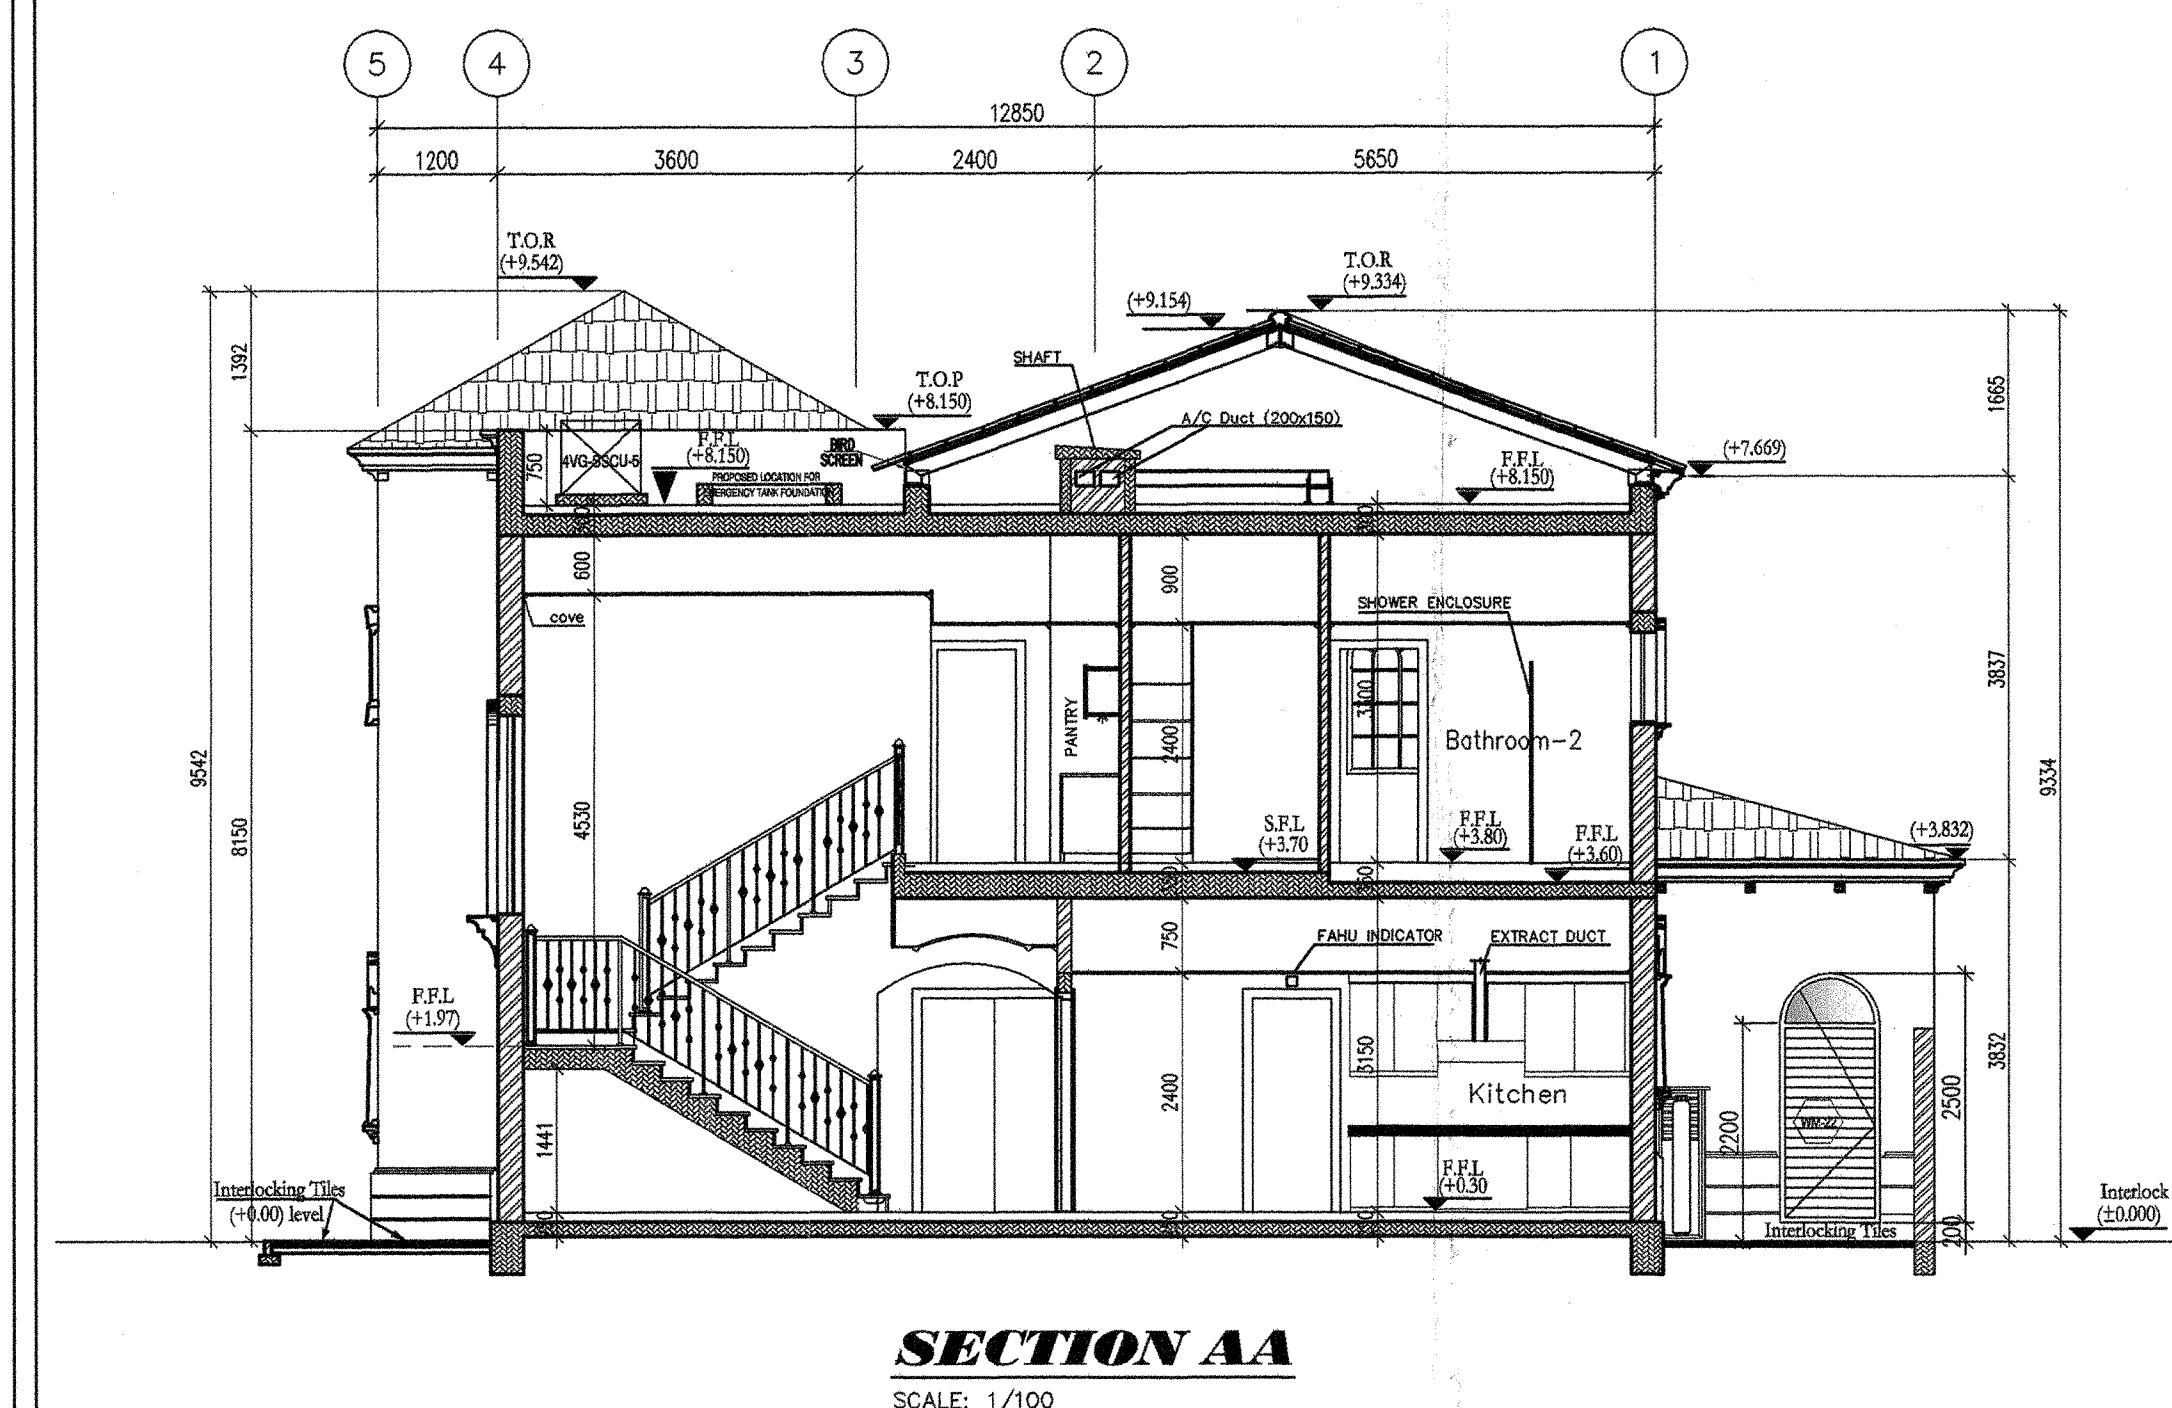

AS BUILT DRAWING

Project

JUMAIRAH PARK



Employer



Consultant



Pauling Middle East

Main Contractor

PACKAGE - 2 & 2A

SECTION & WALL SECTIONS
LEGACY TRADITIONAL 2 of 3

Drawn T.Murugan	Review Eng. Ziad	Checked: Eng.Ghassan Zeitouni
Scale: -	Date: 07-08-2012	

Drawing No.
PME / JP / AB / LT / SEC-001