

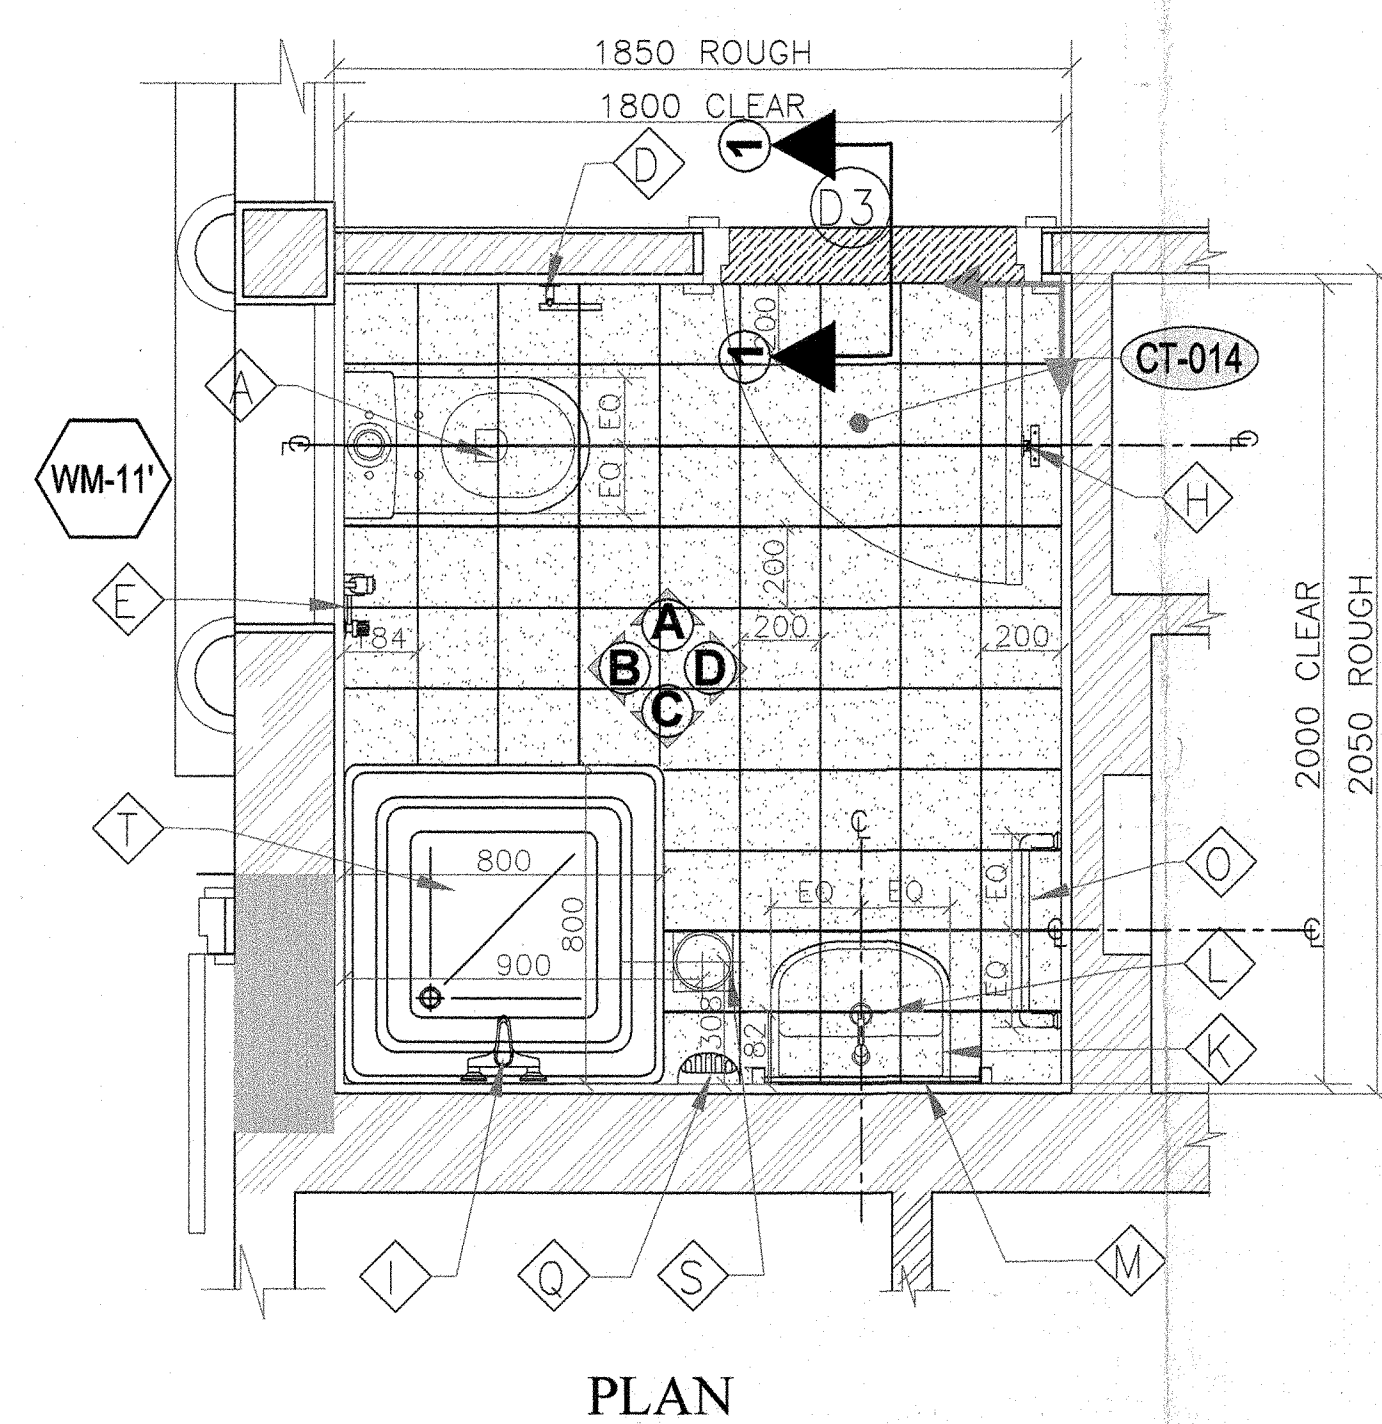
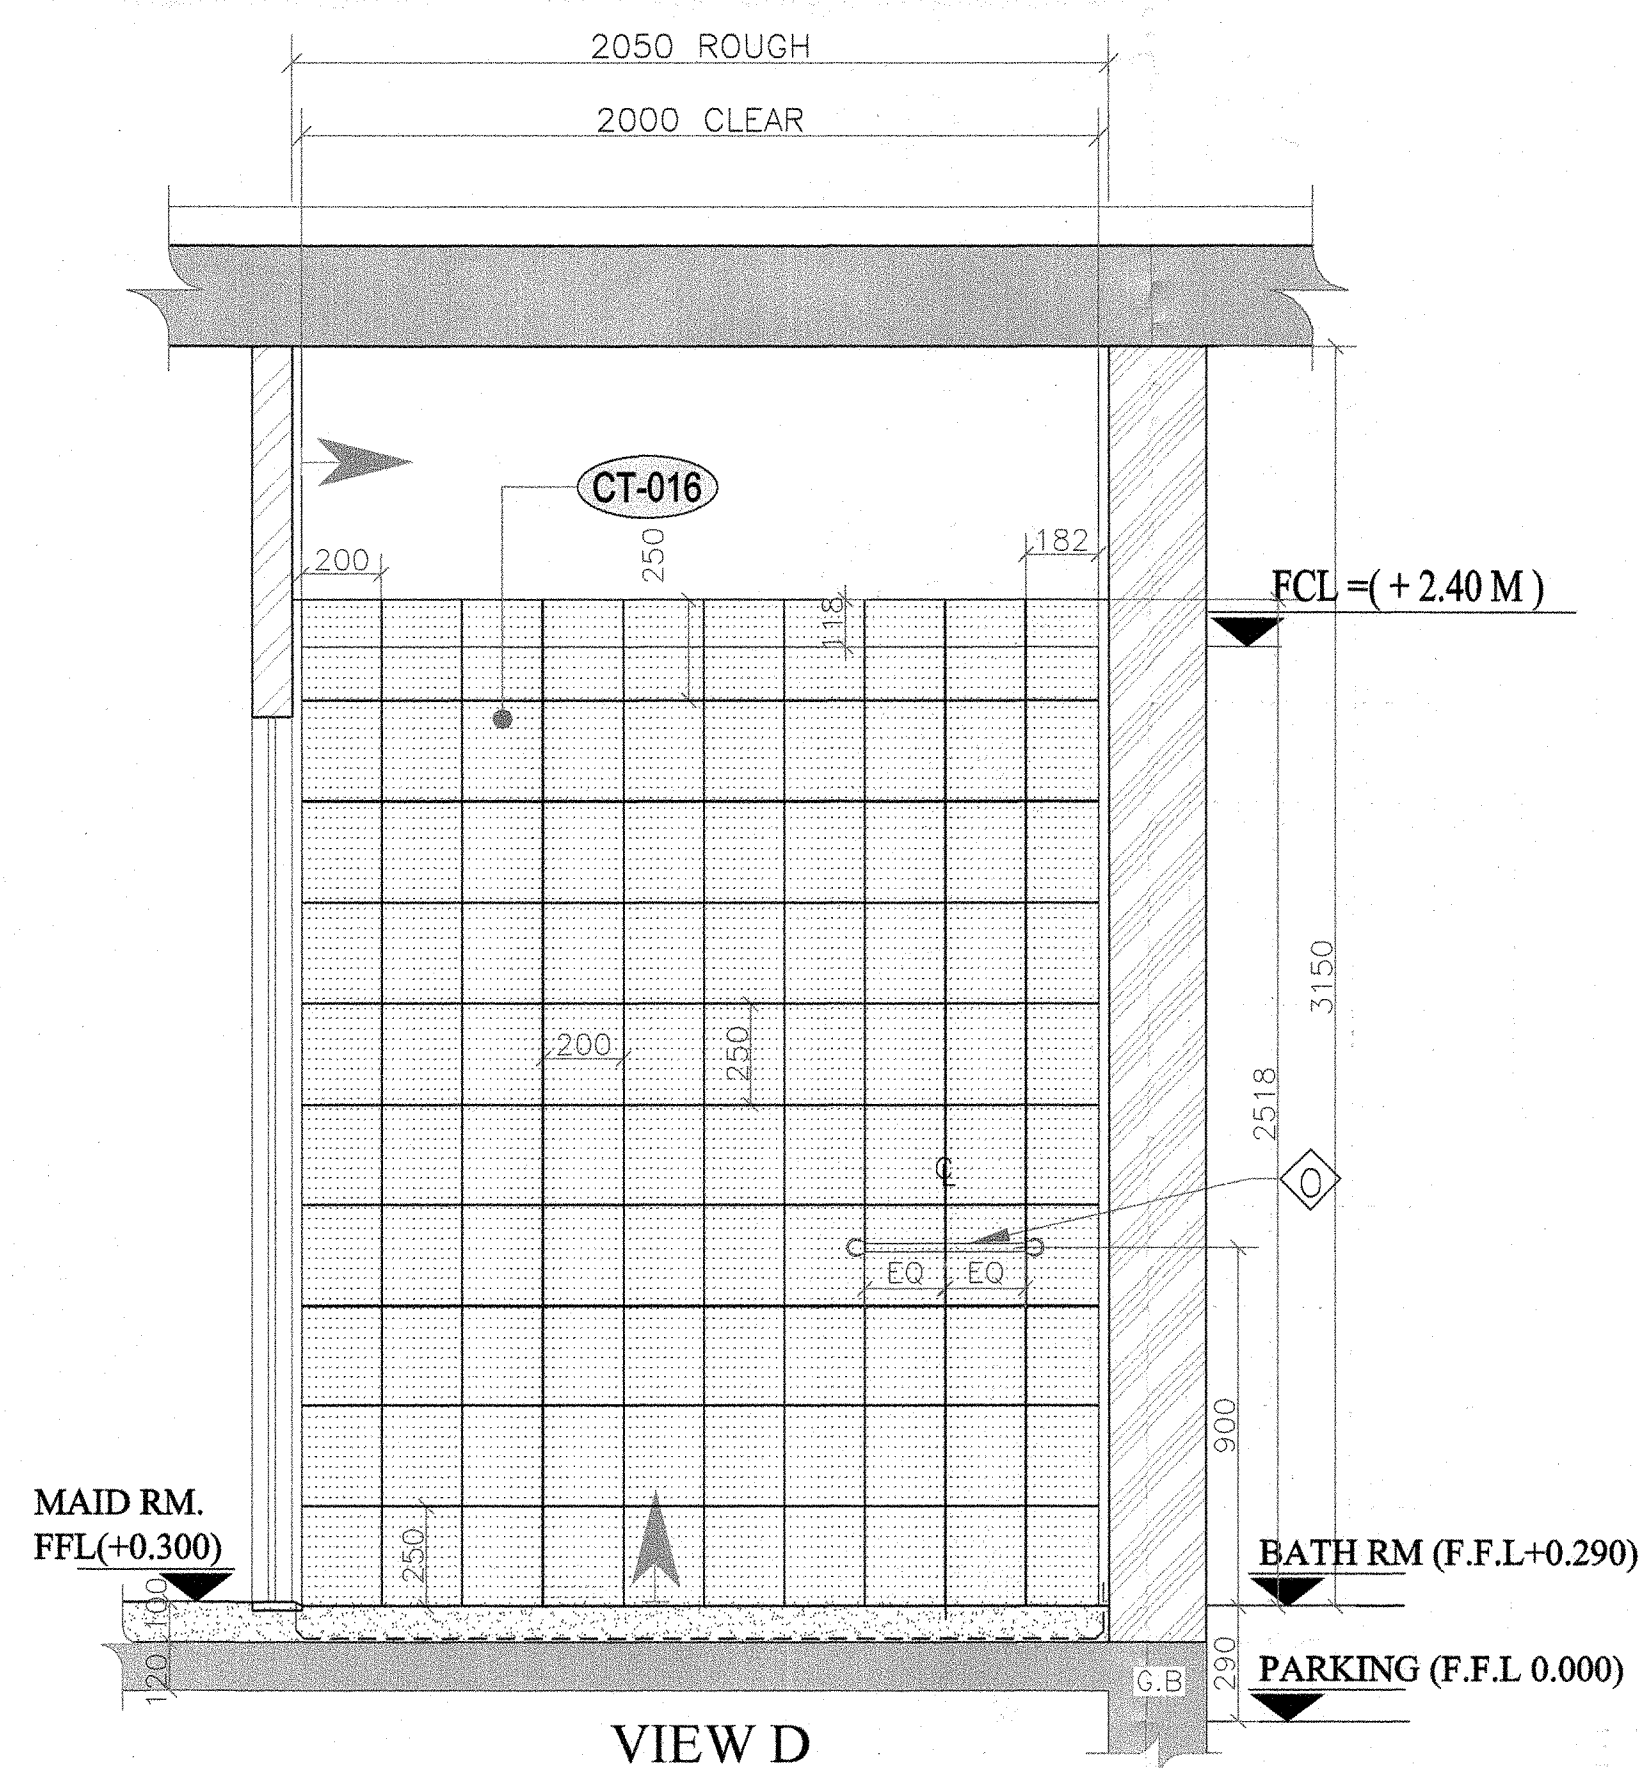


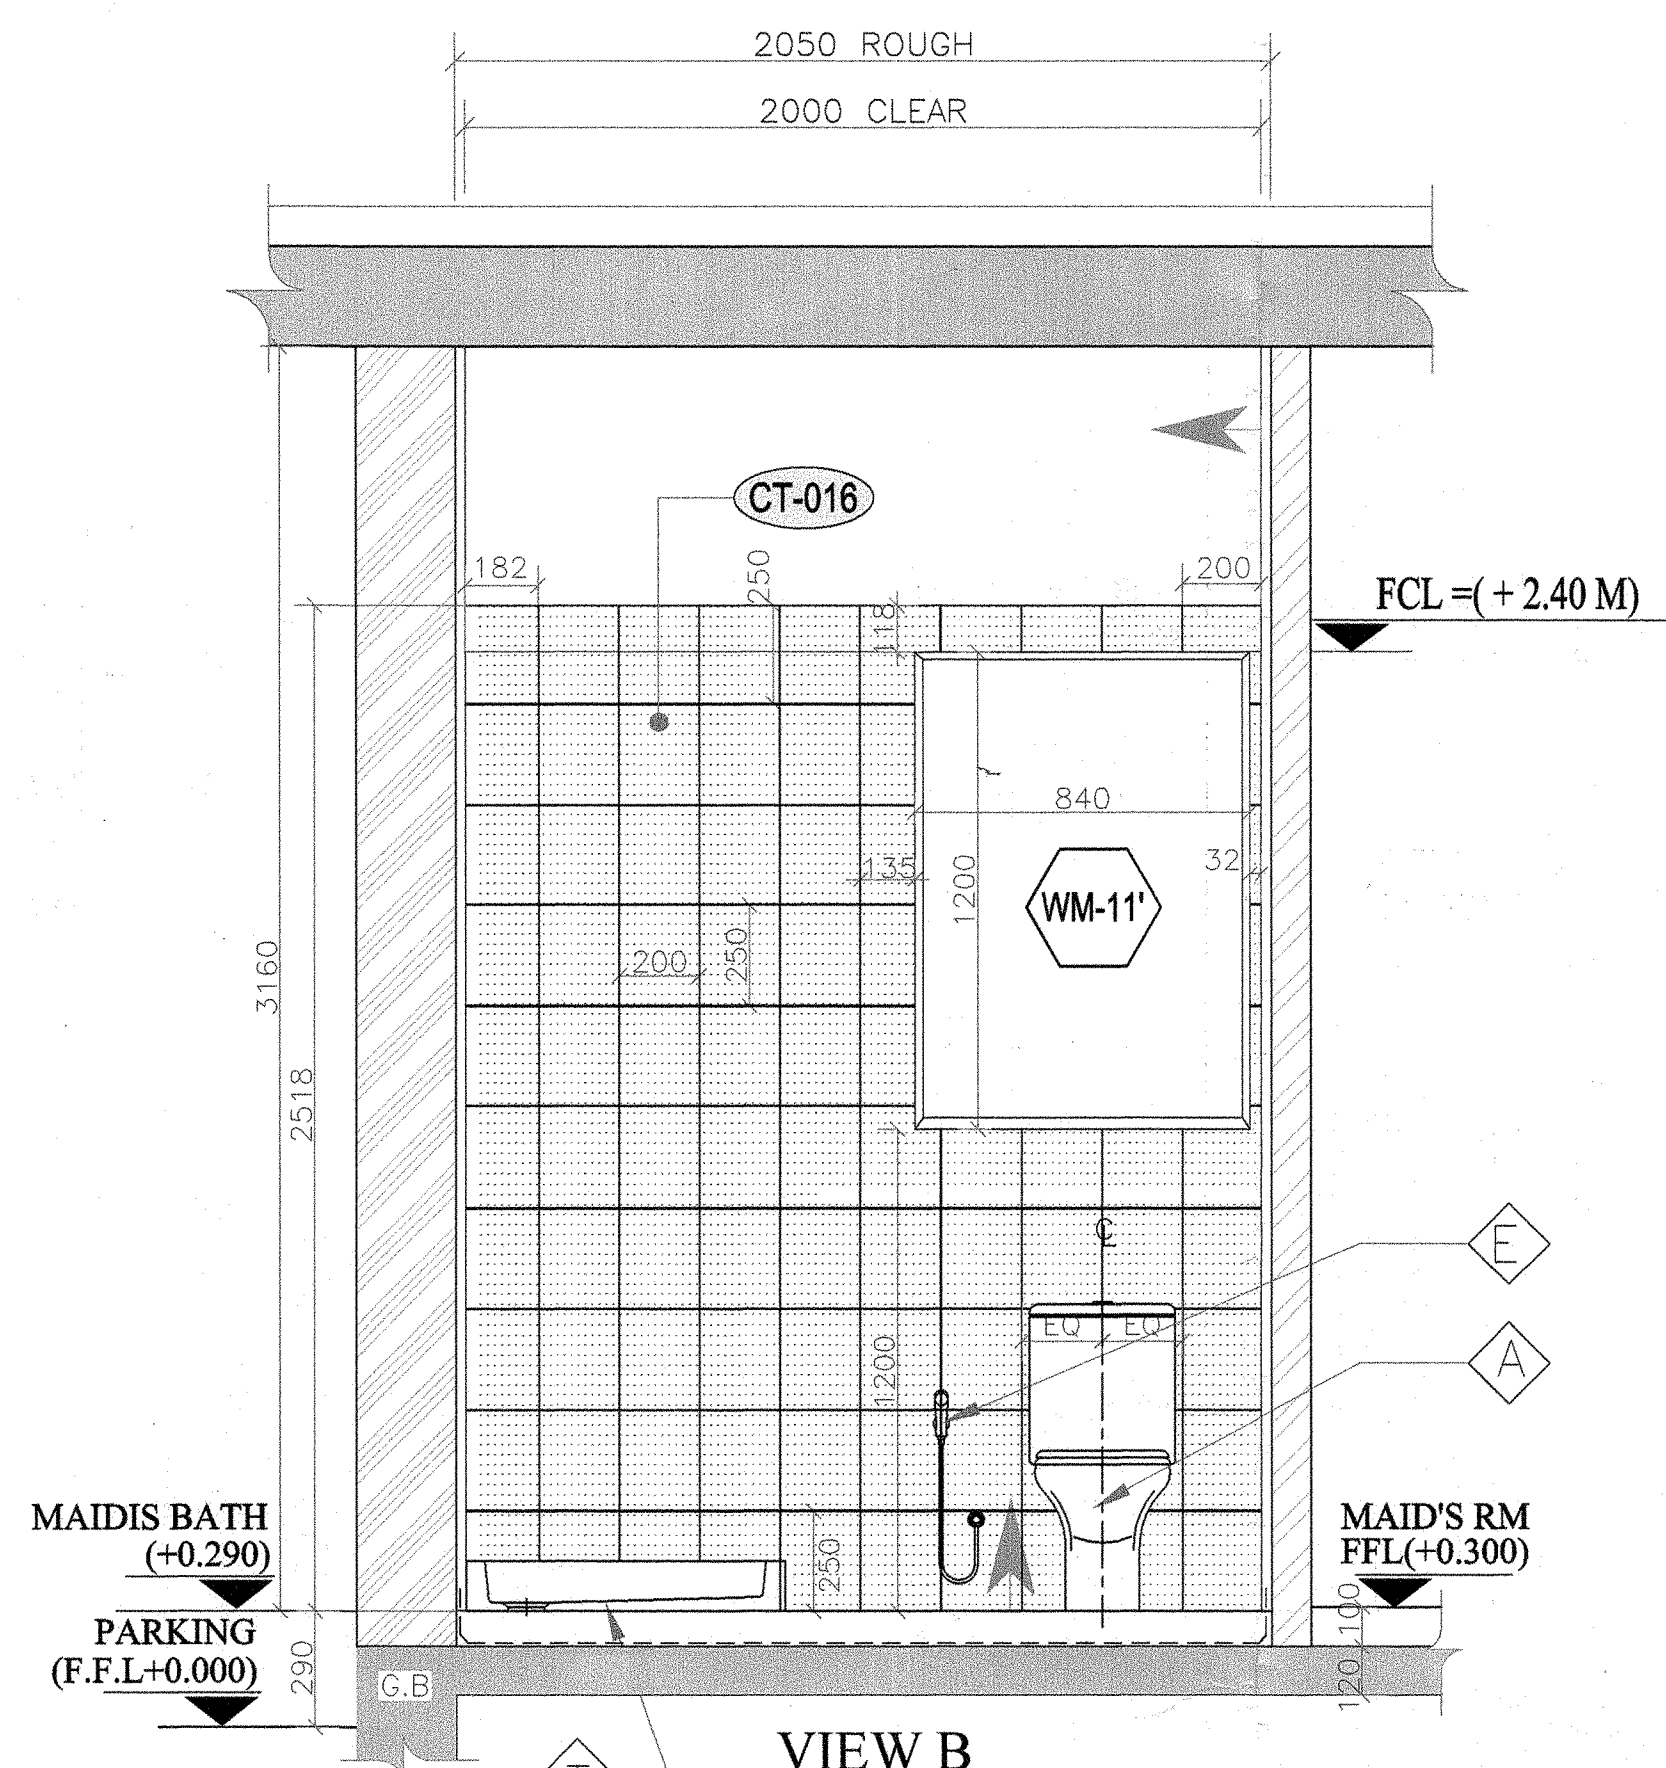

Cross-section diagram of a door threshold between a Maids Room and a Bathroom. The diagram shows the door, threshold, and floor construction layers. Labels include: TIMBER DOOR, MAIDS ROOM, BATHROOM, 20mm THK. THRESHOLD, 2 mm(Max), SILICON SEALANT, CERAMIC TILE, TILE ADHESIVE, SAND CEMENT MORTAR, 5mm ROUND EDGE, CERAMIC TILE AS SPECIFIED, WATERPROOFING, and dimensions 103, 140, 16, 28.

SECTION 1 - 1

Reference	Traditional		Dimension (mm)	Application	Area
	Brand Name	Model			
CT-014	Guocera	E827B	200 x 200	Floors	Maid's Room, Laundry, Store & Maid's Bathroom
CT-016	Guocera	F227A	200 x 250	Walls	Maid's Bathroom

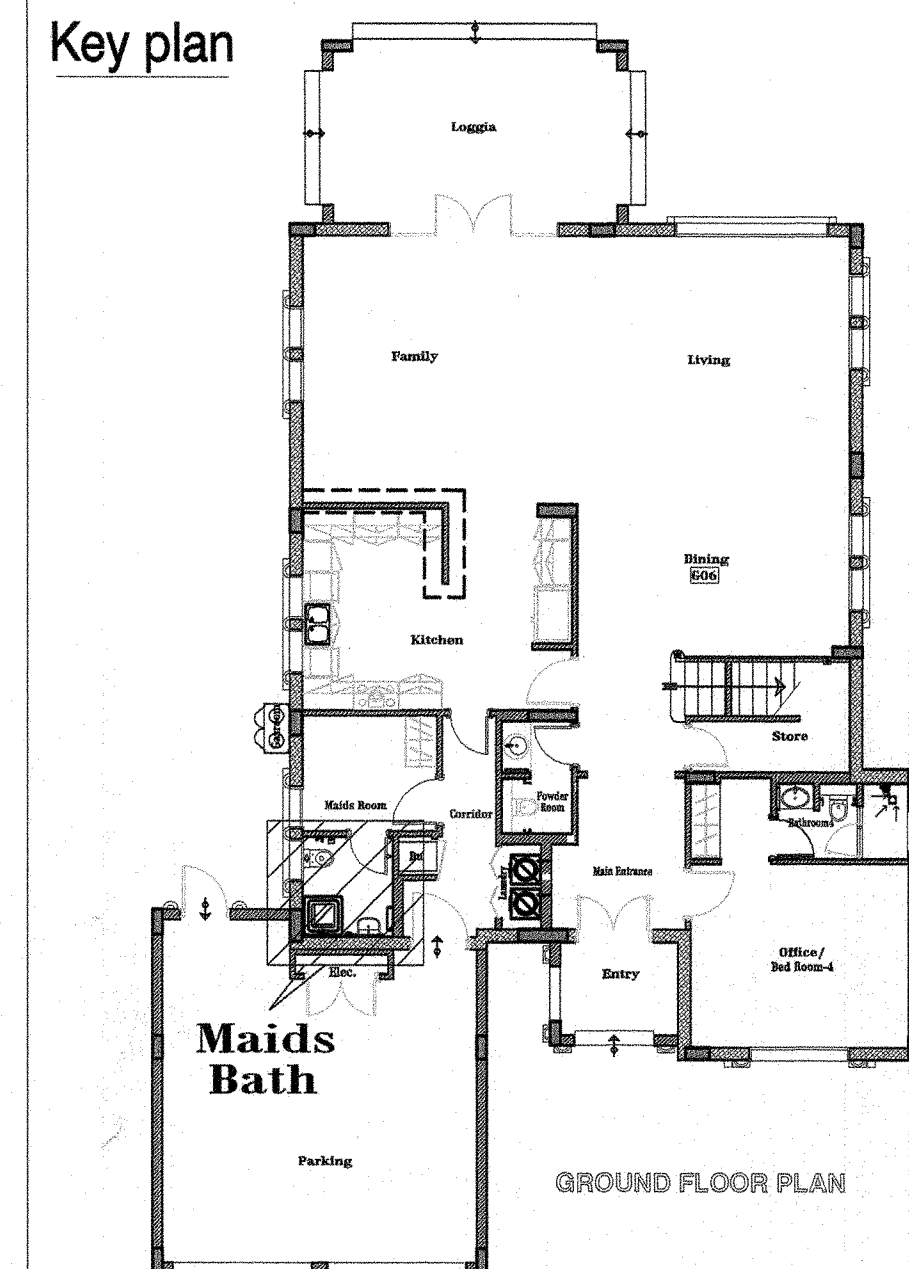

NOTE:
*ALL THE JOINTS BETWEEN CERAMICS ARE 2MM

* OPENING FOR WOODEN DOOR ARE ROUGH
(BLOCK TO BLOCK)


* OPENING FOR ALUMINIUM DOORS & WINDOWS
ARE CLEAR (PLASTER TO PLASTER)

▲ DIRECTION OF STARTING POINT

LEGEND FOR TOILET
ACCESSORIES :

- | | |
|---|---------------------|
|  | W C |
|  | TOILET ROLL HOLDER |
|  | ABLUTION SPRAY |
|  | SHOWER MIXER |
|  | WASH BASIN |
|  | WASH BASIN MIXER |
|  | MIRROR |
|  | TOWEL RAIL |
|  | ROBE HOOK (at door) |
|  | SOAP HOLDER |
|  | FLOOR TRAP |
|  | SHOWER TRAY |

 dar al-handasah Shaif and Partners		
☒	CODE 1	APPROVED
☐	CODE 2	APPROVED AS NOTED WORK MAY PROCEED SUBJECT TO INCORPORATION OF ENCLOSED COMMENTS
☐	CODE 3	RESUBMIT FOR APPROVAL WORK MAY NOT PROCEED
☐	CODE 4	REJECTED
BY:		DATE:
Approval shall not relieve the contractor of any of his obligations under the Contract or constitute authorization any changes to Contract Documents or variation to the contract. Contractor is responsible for dimensions, quantities and coordination with other trades.		

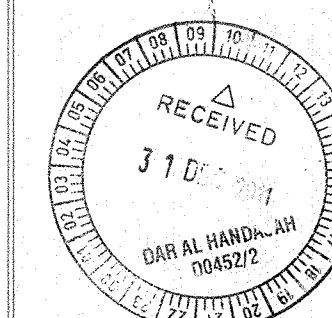

AS BUILT DRAWING

JUMAIRAH PARK

 **NAKHEER**



Pauling Middle East

PACKAGE - 2

Drawing Title


**LEGACY - TRADITIONAL
TILING - (FLOOR & WALL)
MAIDS BATH ROOM - IN GROUND FLOOR**

Drawn T.Murugan	Review Eng. Ziyad	Checked: Eng.Ghassan Zeitoun
--------------------	----------------------	---------------------------------


Drawing No. **PME/JP/ AB / LEGACY TRADITIONAL / CT-004**

AR
OFC
R.1

Finishes Legend					
Reference	Traditional		Dimension (mm)	Application	Area
	Brand Name	Model			
CT-008	Azulbur	JV 303	330 x 330	Floors	Master Bath & Powder Room
CT-009	Azulbur	JV 302	330 x 330	Walls	Master Bath & Powder Room
CT-009a			20 x 300	Wall corner & window surroundings	Master Bath & Powder Room
CT-010	Azulbur	JV 302	25 x 25	Wall Mosaic	Master Bath & Powder Room

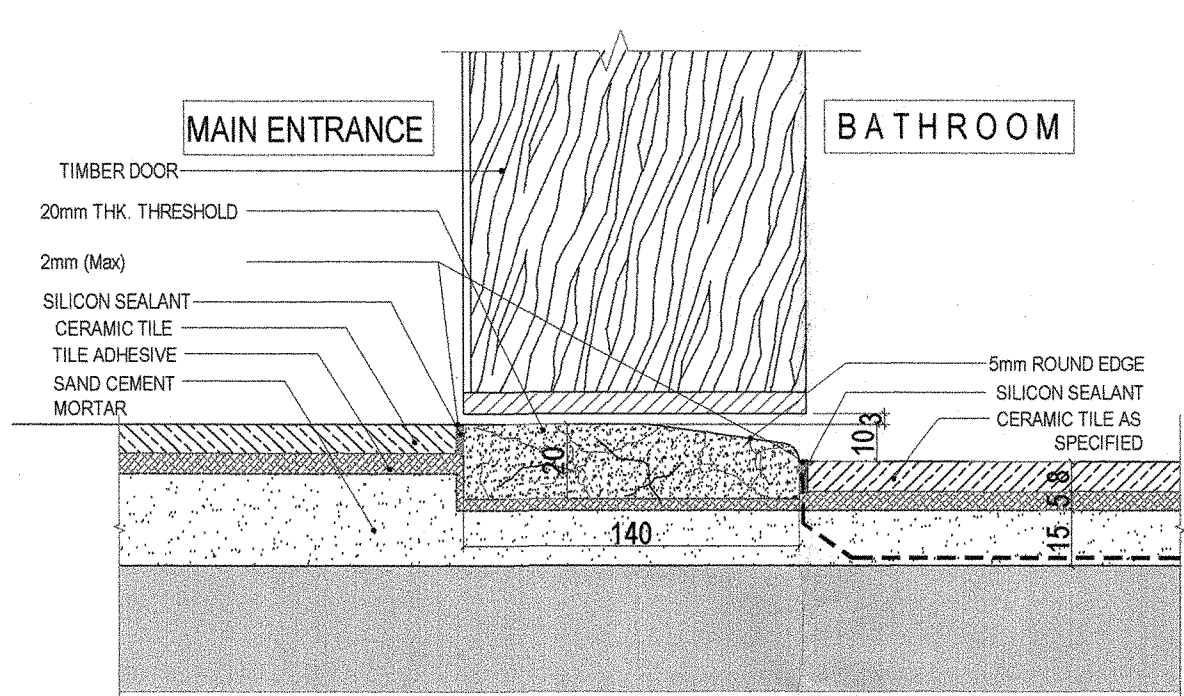

SECTION 1 - 1

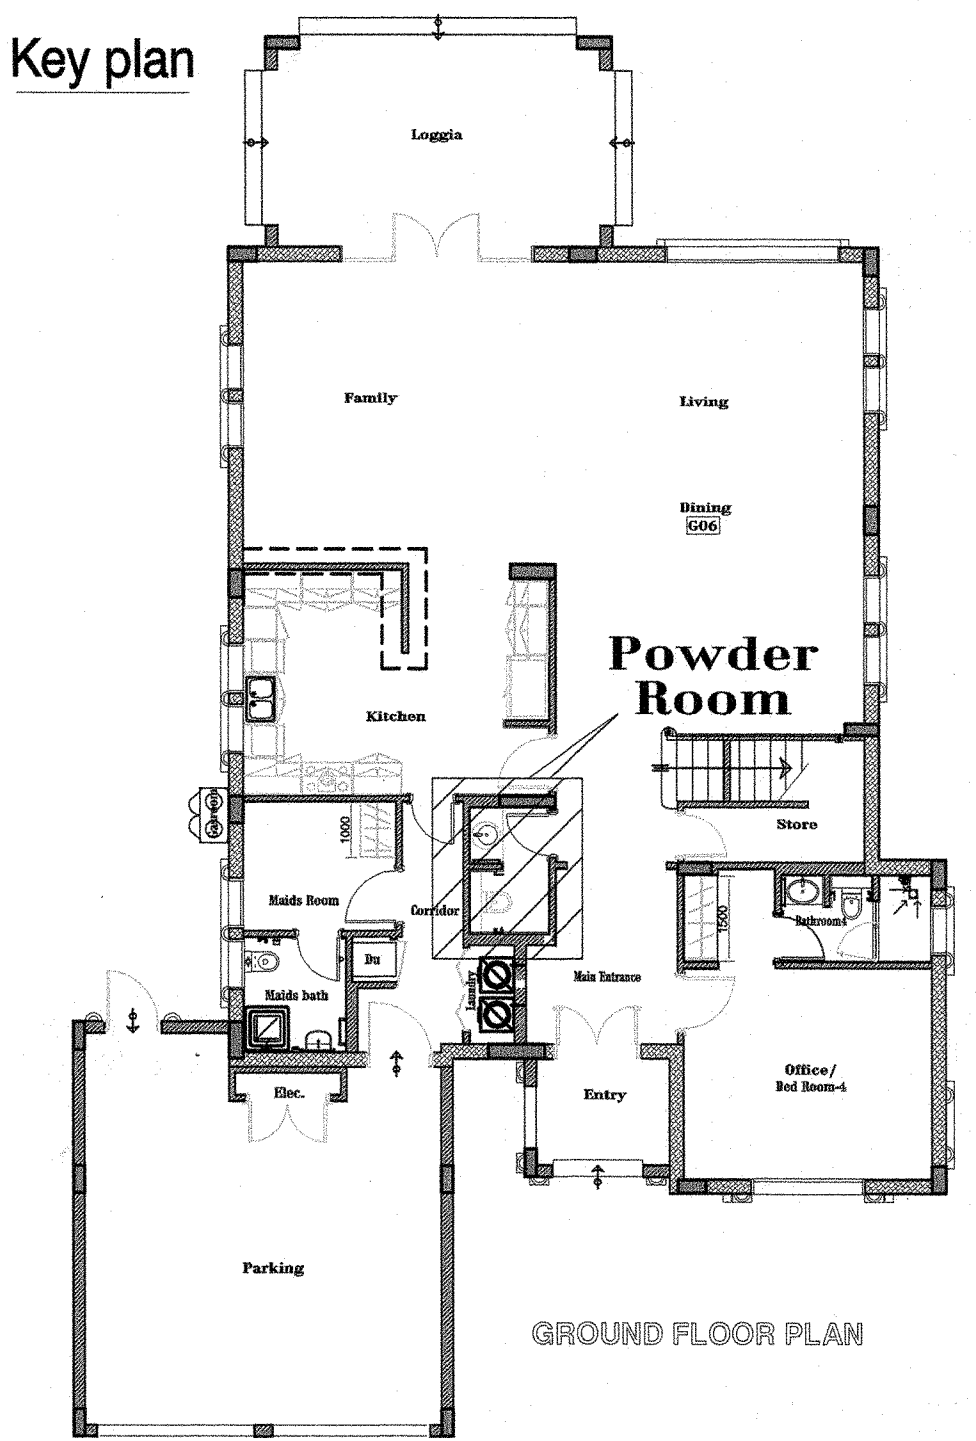

NOTE:
* ALL THE JOINTS BETWEEN CERAMICS ARE 2MM
* OPENING FOR WOODEN DOOR ARE ROUGH (BLOCK TO BLOCK)
* OPENING FOR ALUMINIUM DOORS & WINDOWS ARE CLEAR (PLASTER TO PLASTER)

LEGEND FOR TOILET ACCESSORIES	
W C	WC FLUSH BUTTON
TOILET ROLL HOLDER	ABLUTION SPRAY
WASH BASIN	WASH BASIN MIXER
MIRROR	TOWEL RAIL
WALL LIGHT	FLOOR TRAP
ELECTRICAL SOCKET	ROBE HOOK

BY: _____ DATE: _____

Approval shall not relieve the contractor of any of his obligations under the Contract or exempt him from any change to Contract Documents.

Contractor is responsible for maintaining quality and coordination with other trades.

RECEIVED
31 DEC 2011
DAR AL HANDASAH
DRAUGHT

AS BUILT DRAWING

JUMAIRAH PARK

Employer

NAKHEEL

Consultant

dar al-handasah
shair and partners

Main Contractor

Pauling Middle East

Package

PACKAGE - 2

Drawing Title

LEGACY - TRADITIONAL

TLING (FLOOR & WALL)





POWDER ROOM - IN GROUND FLOOR

Drawn: T.Murugan Review: Eng. Ziyad Checked: Eng.Ghassan Zeitouni


Scale: 1:20 Date: 24-12-2011

Drawing No. PME/JP/ AB / LEGACY TRADITIONAL / CT-005


CLUSTER # 3 (P2)
VILLA # 6

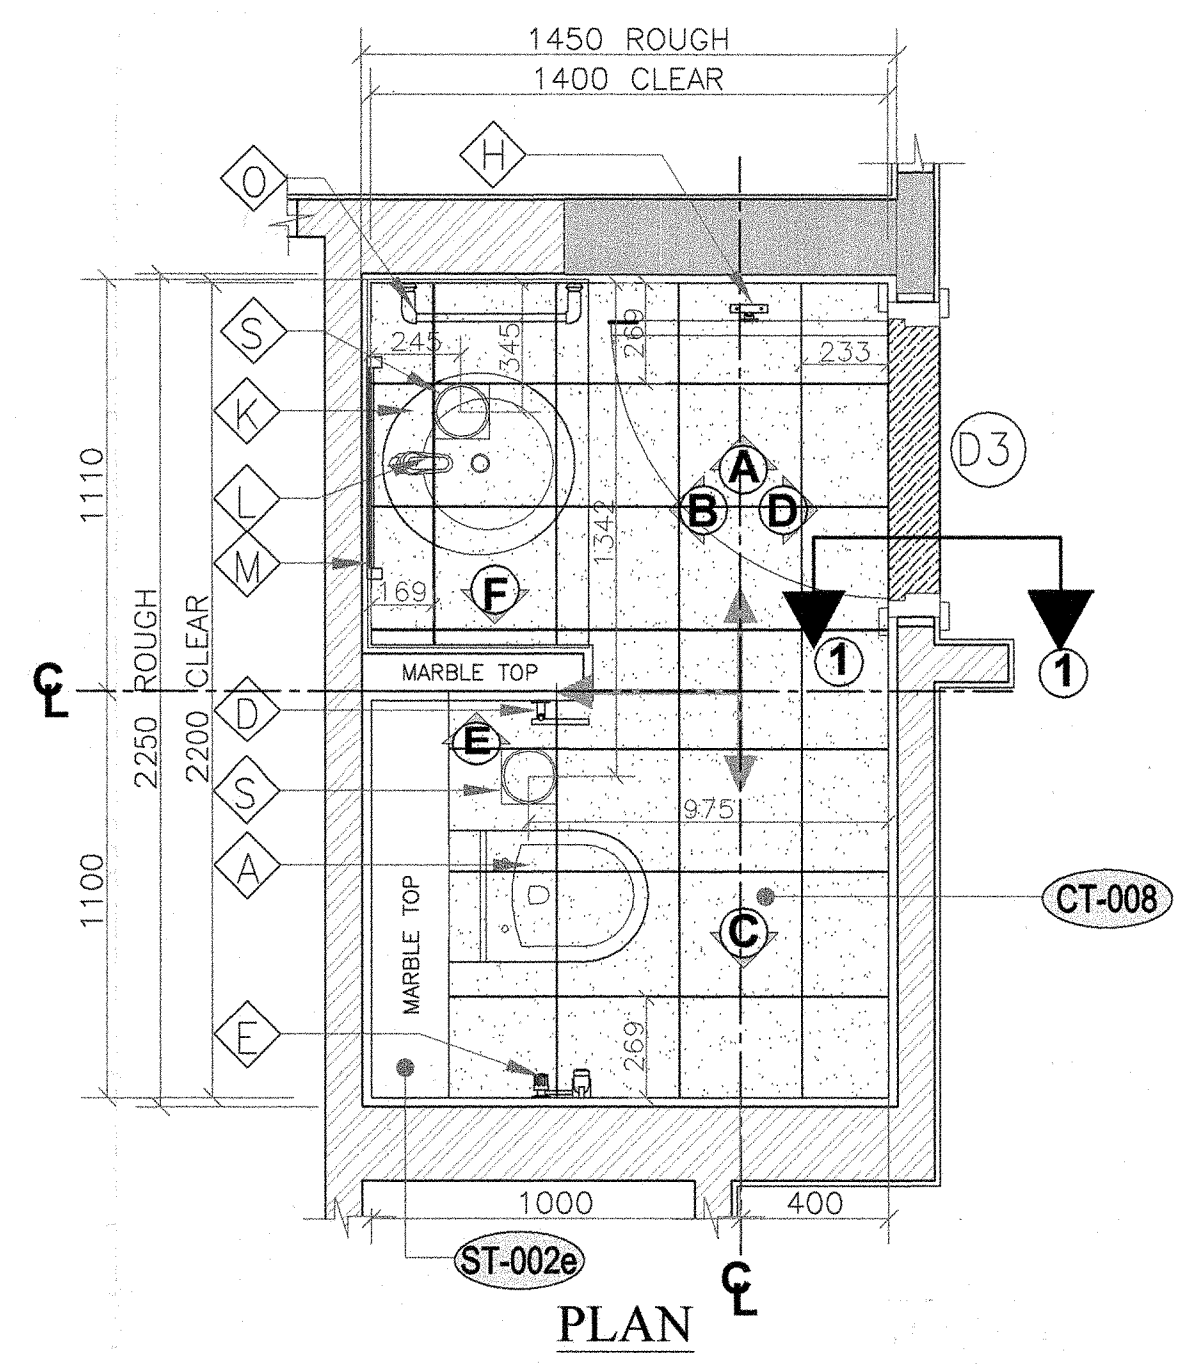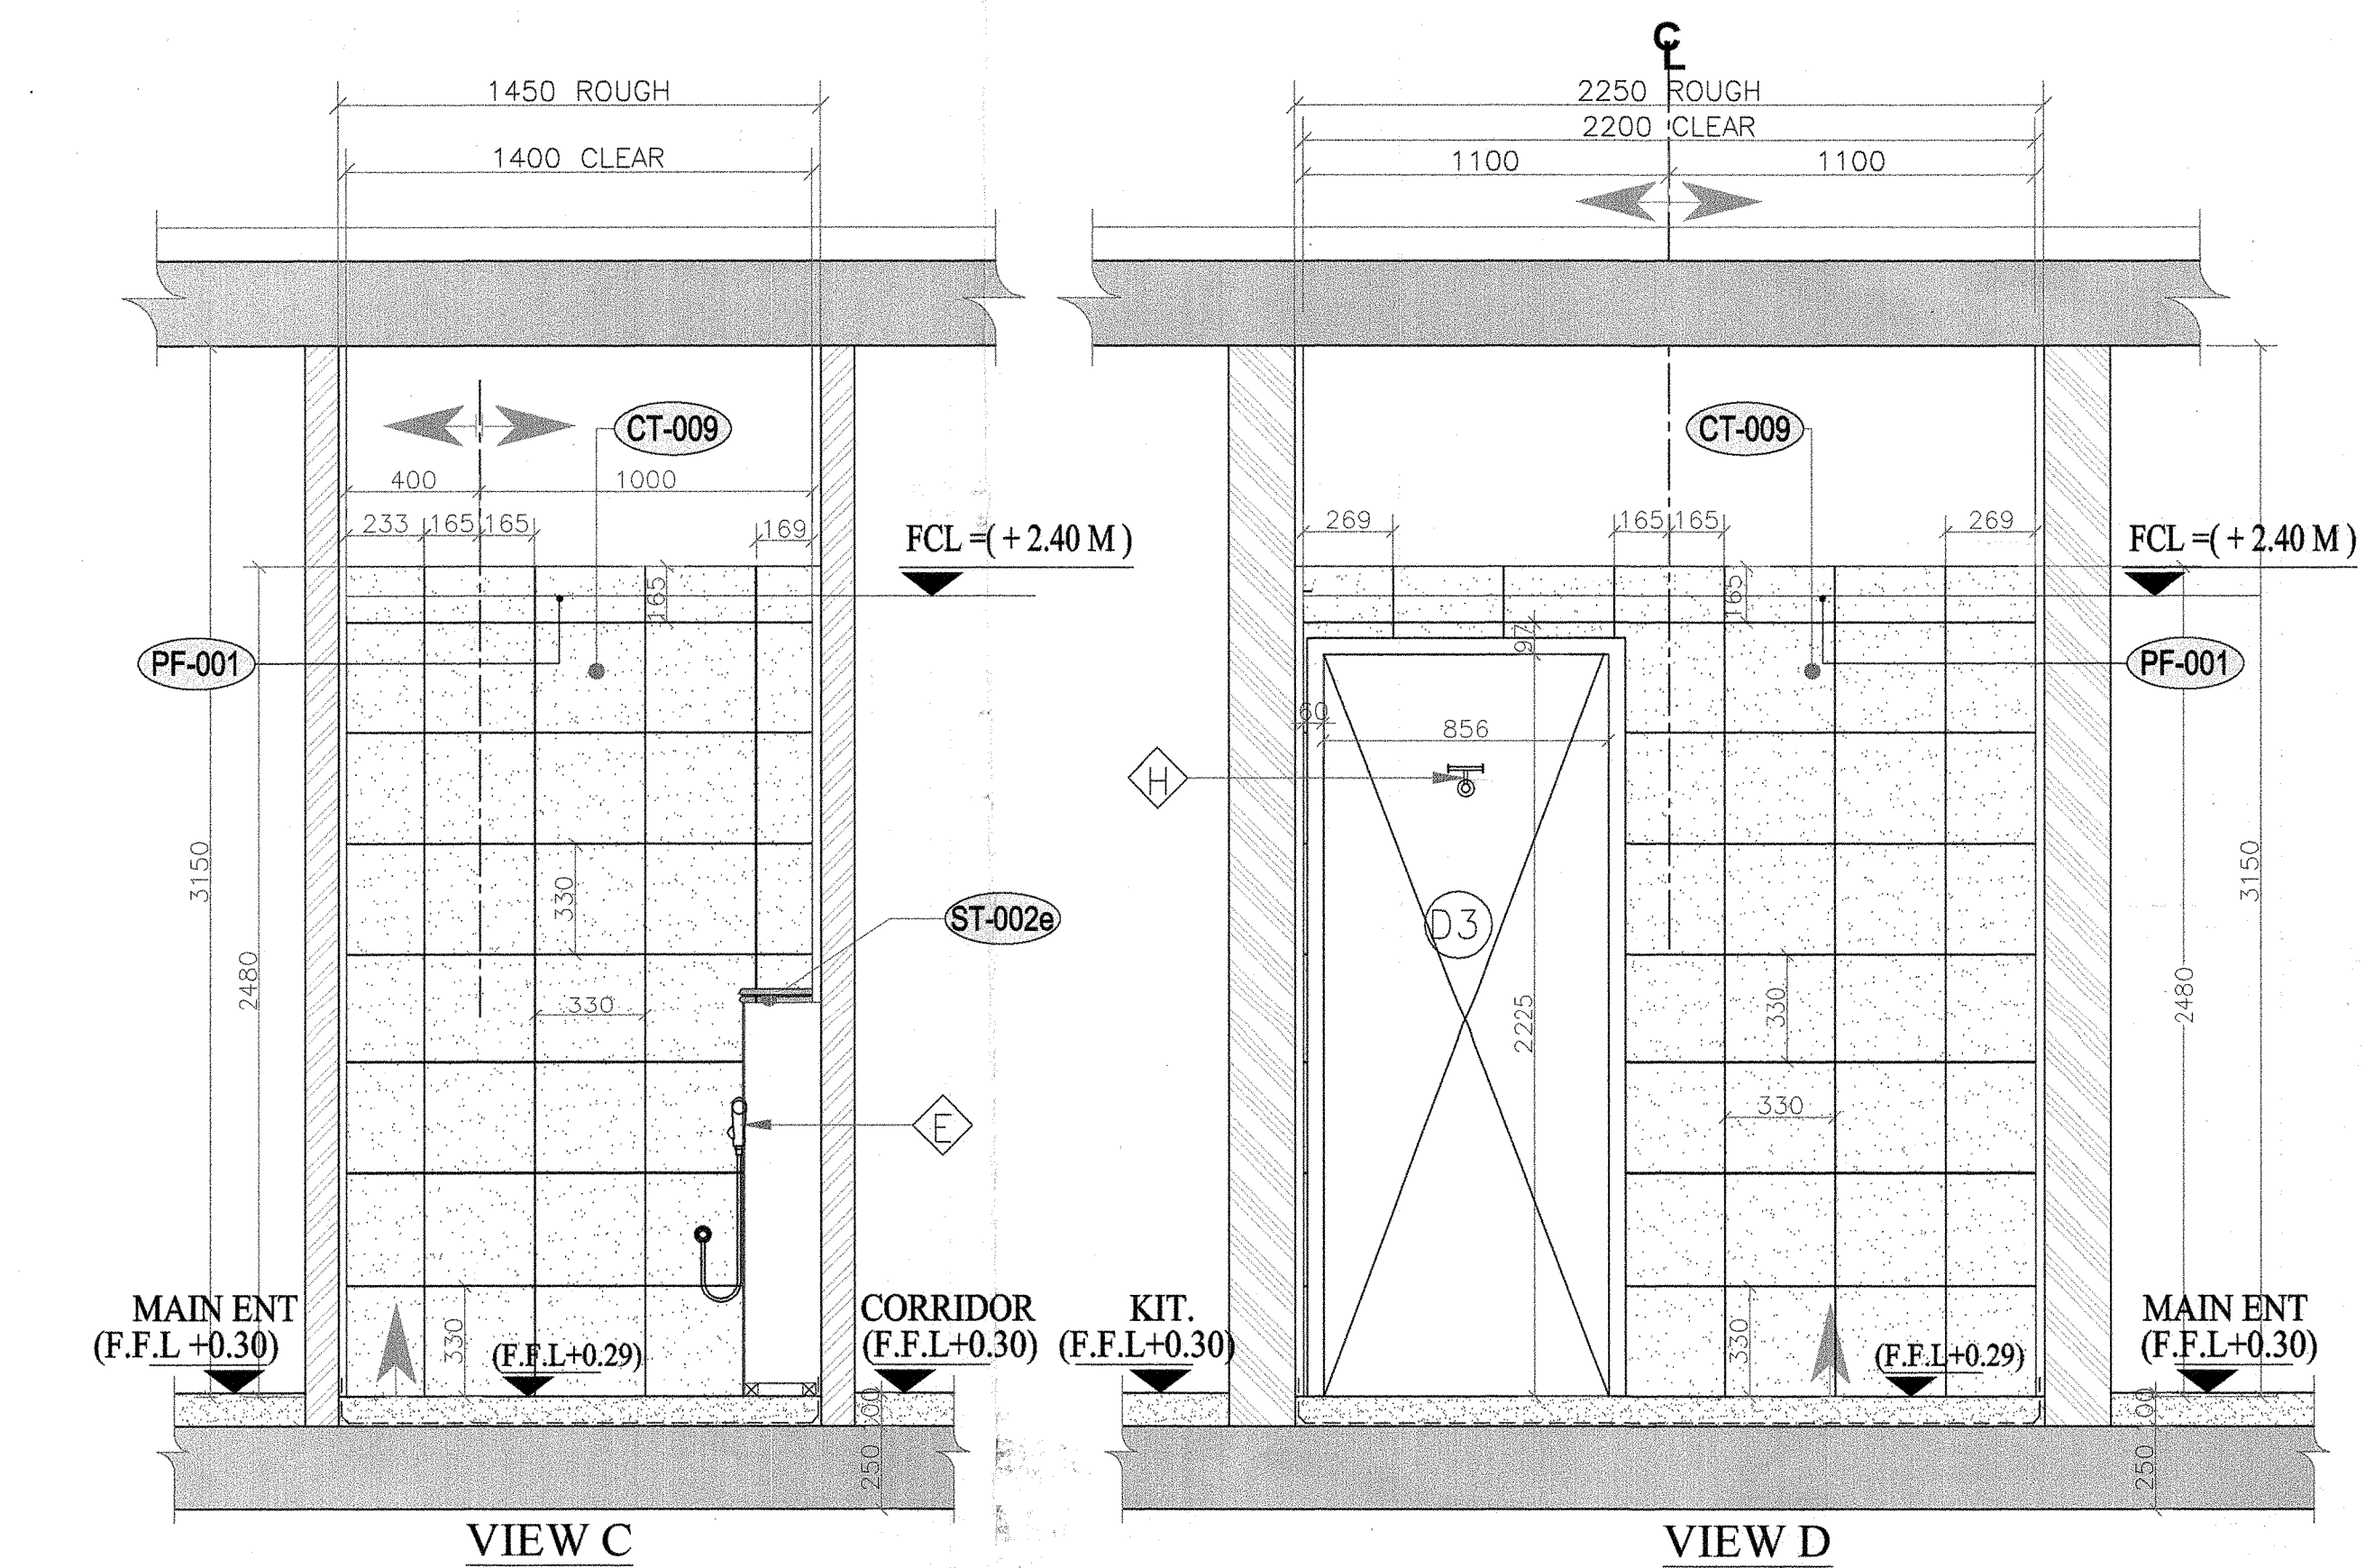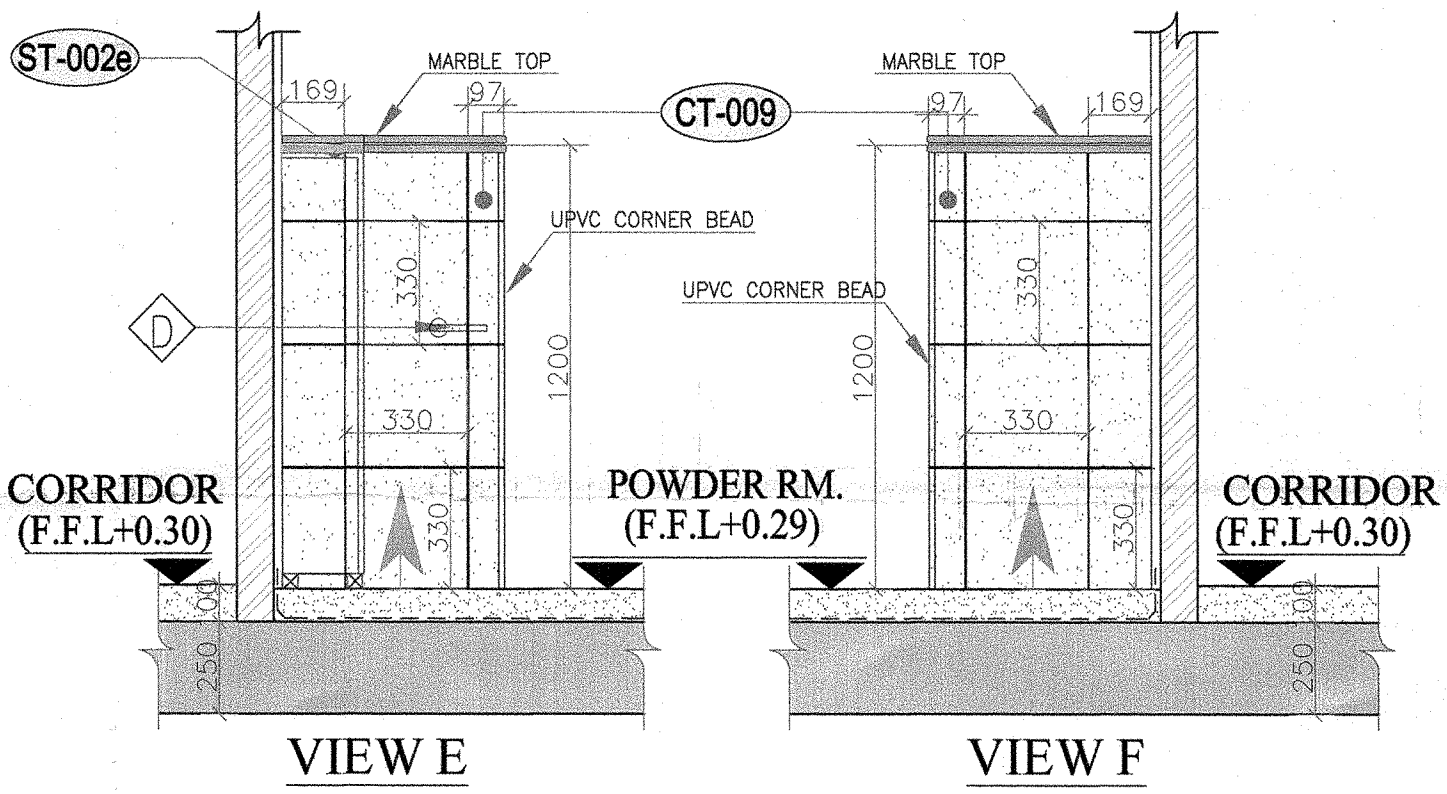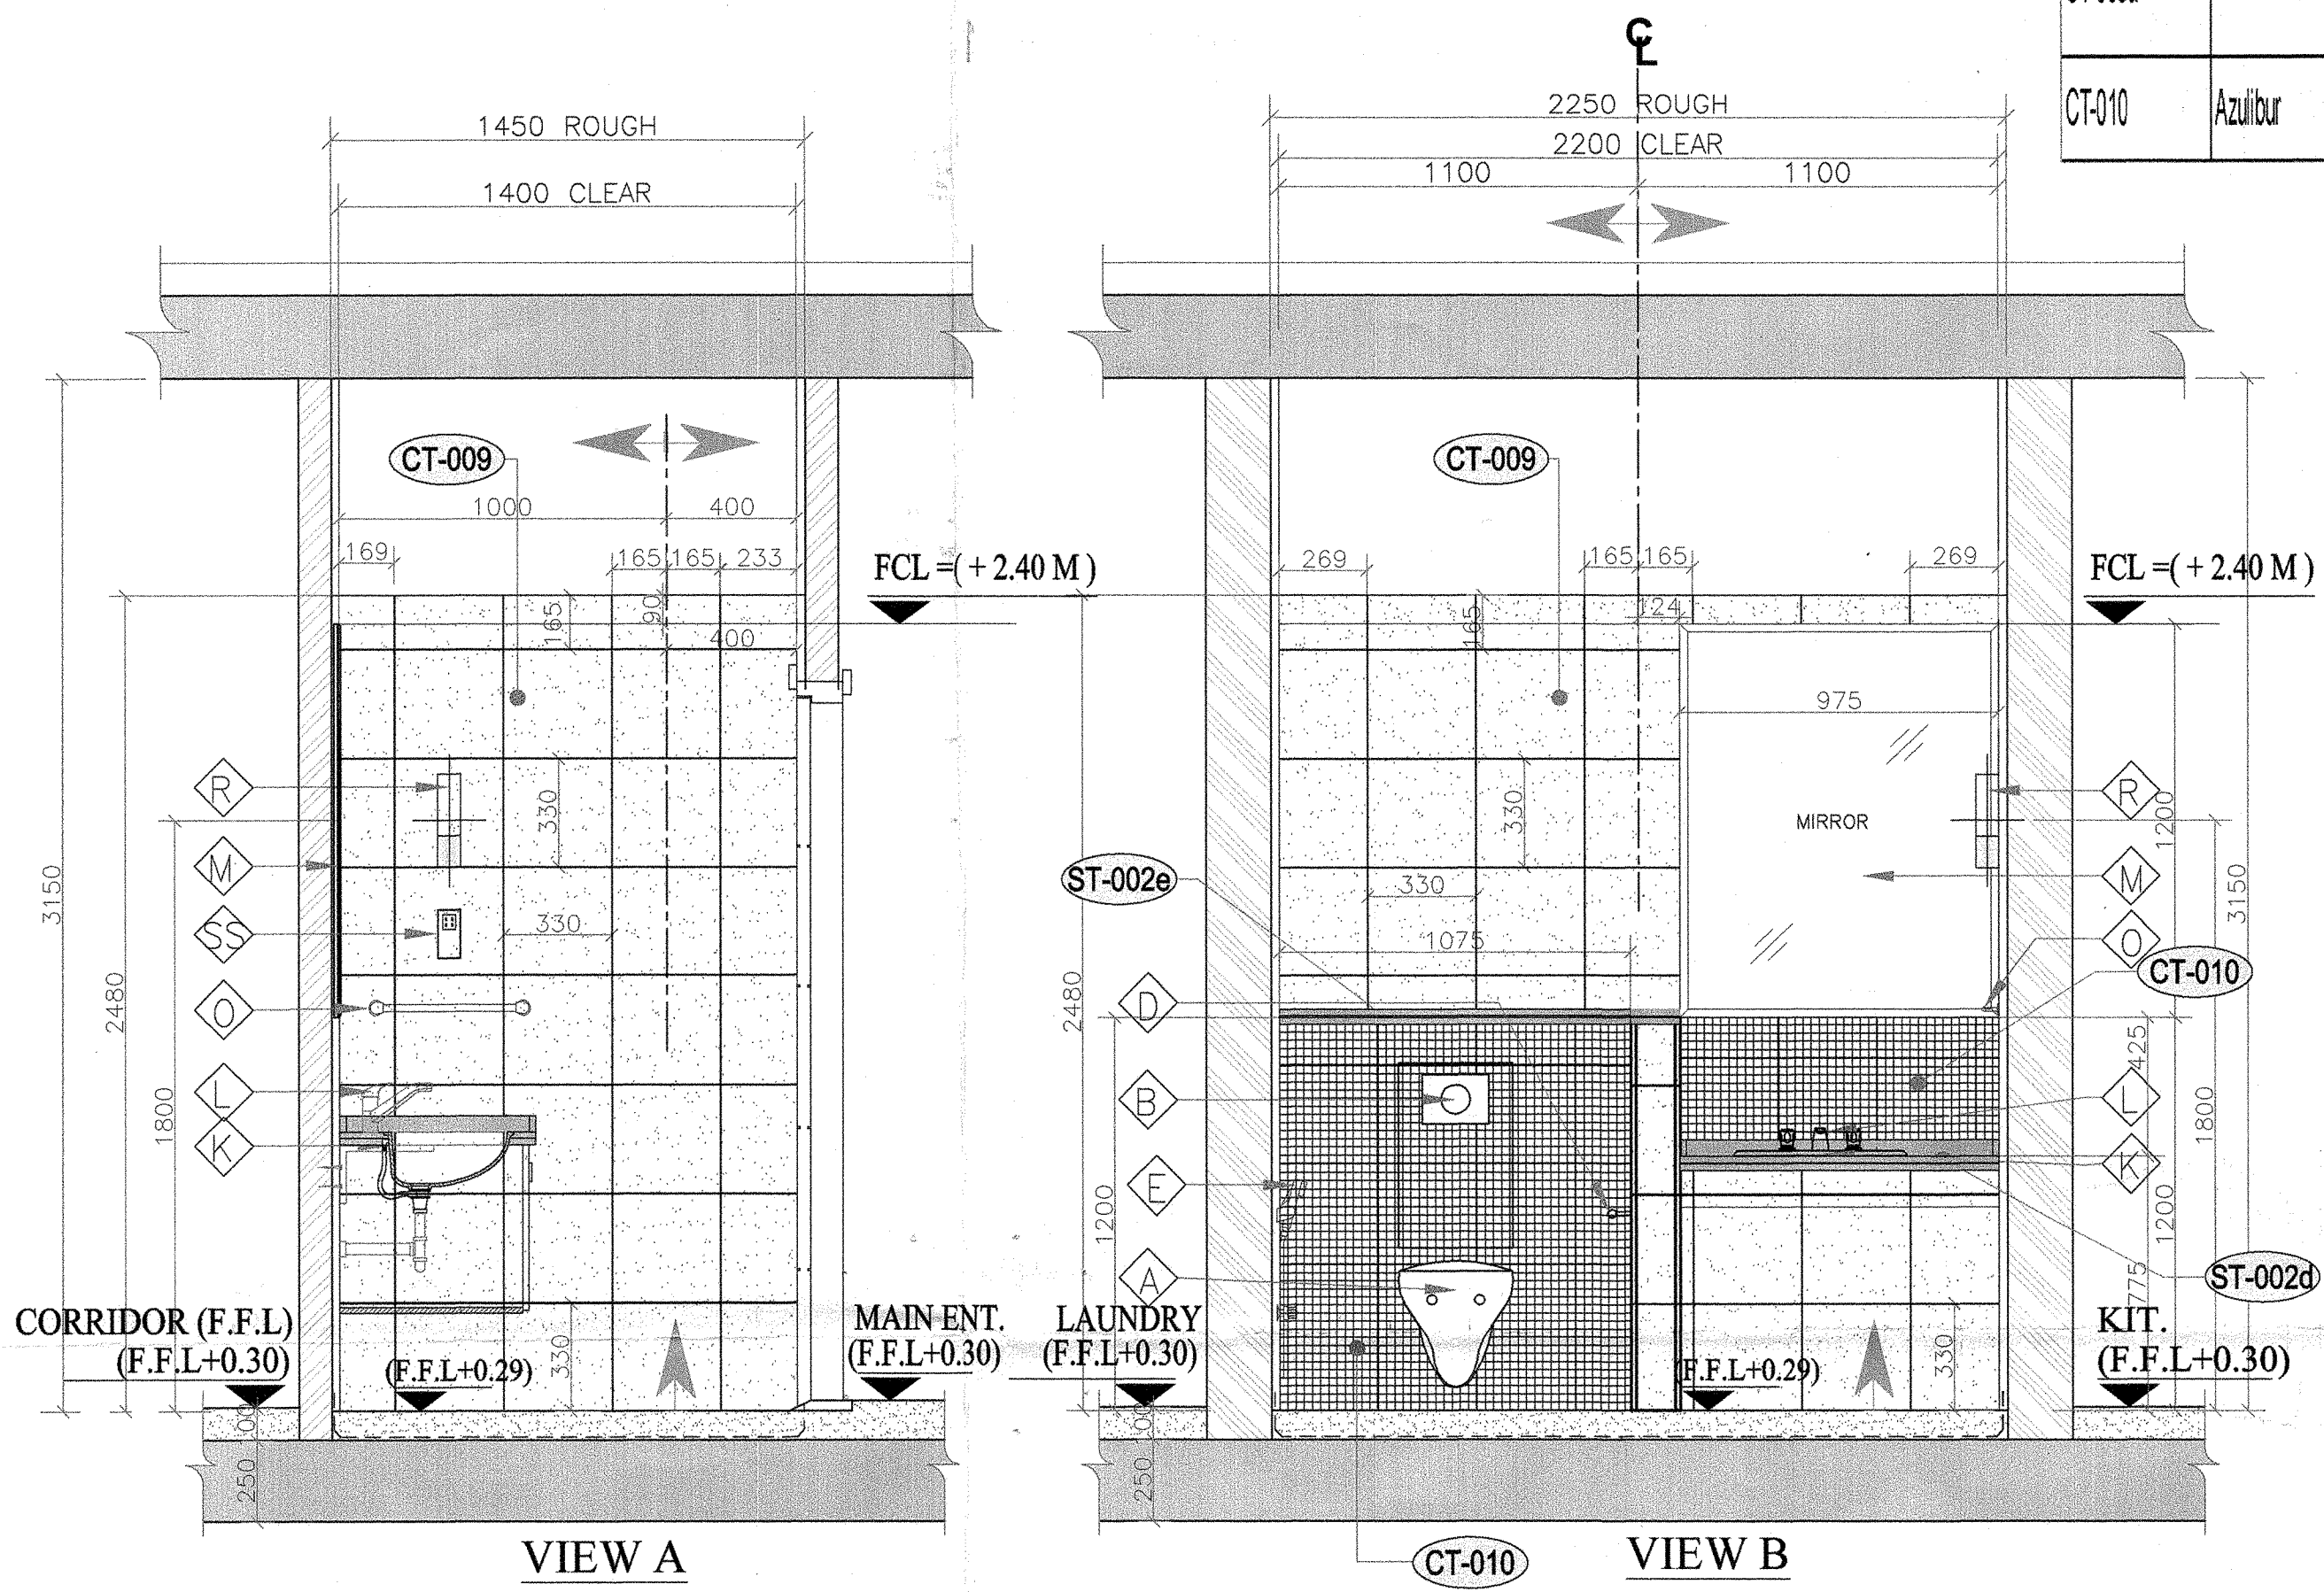

Finishes Legend					
Reference	Traditional		Dimension (mm)	Application	Area
	Brand Name	Model			
CT-011	Pamesa	Tibet Marfil	300 x 300	Floors	General Bathroom 2, 3 & 4
CT-012	Pamesa	Ikom Blanco	300 x 300	Walls	General Bathroom 2, 3 & 4
CT-012a			20 x 300	Wall corner & window surroundings	General Bathroom 2, 3 & 4
CT-013	Pamesa	Tibet Marfil	25 x 25	Wall Mosaic	General Bathroom 2, 3 & 4

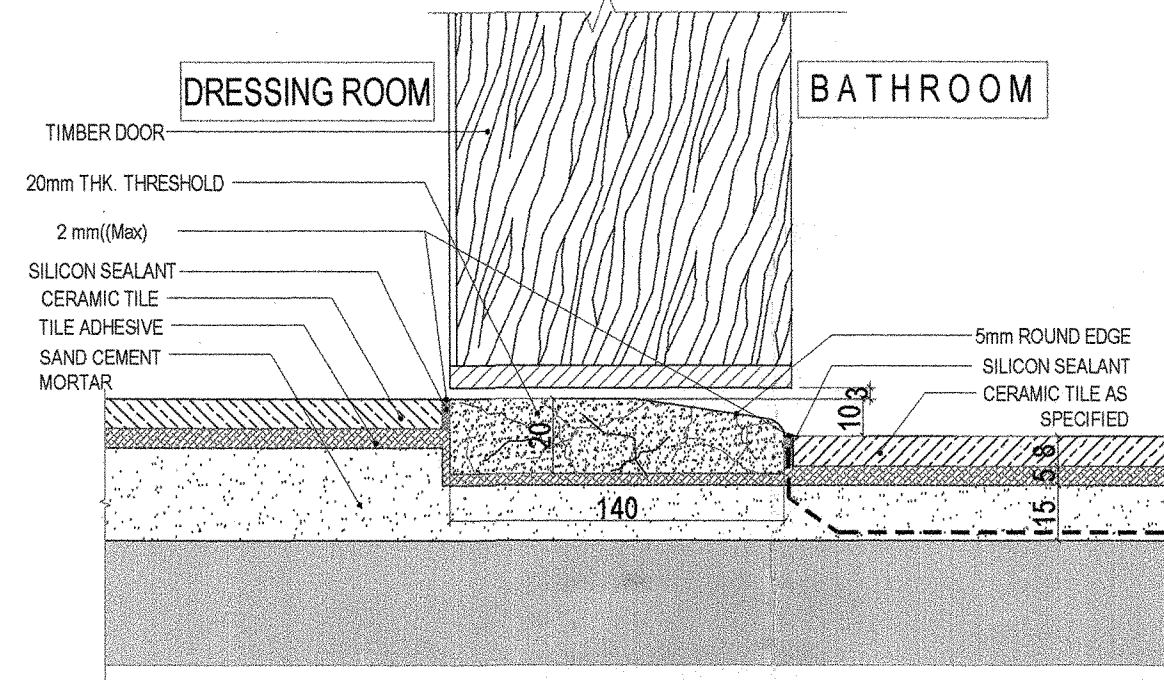


SECTION 1 - 1

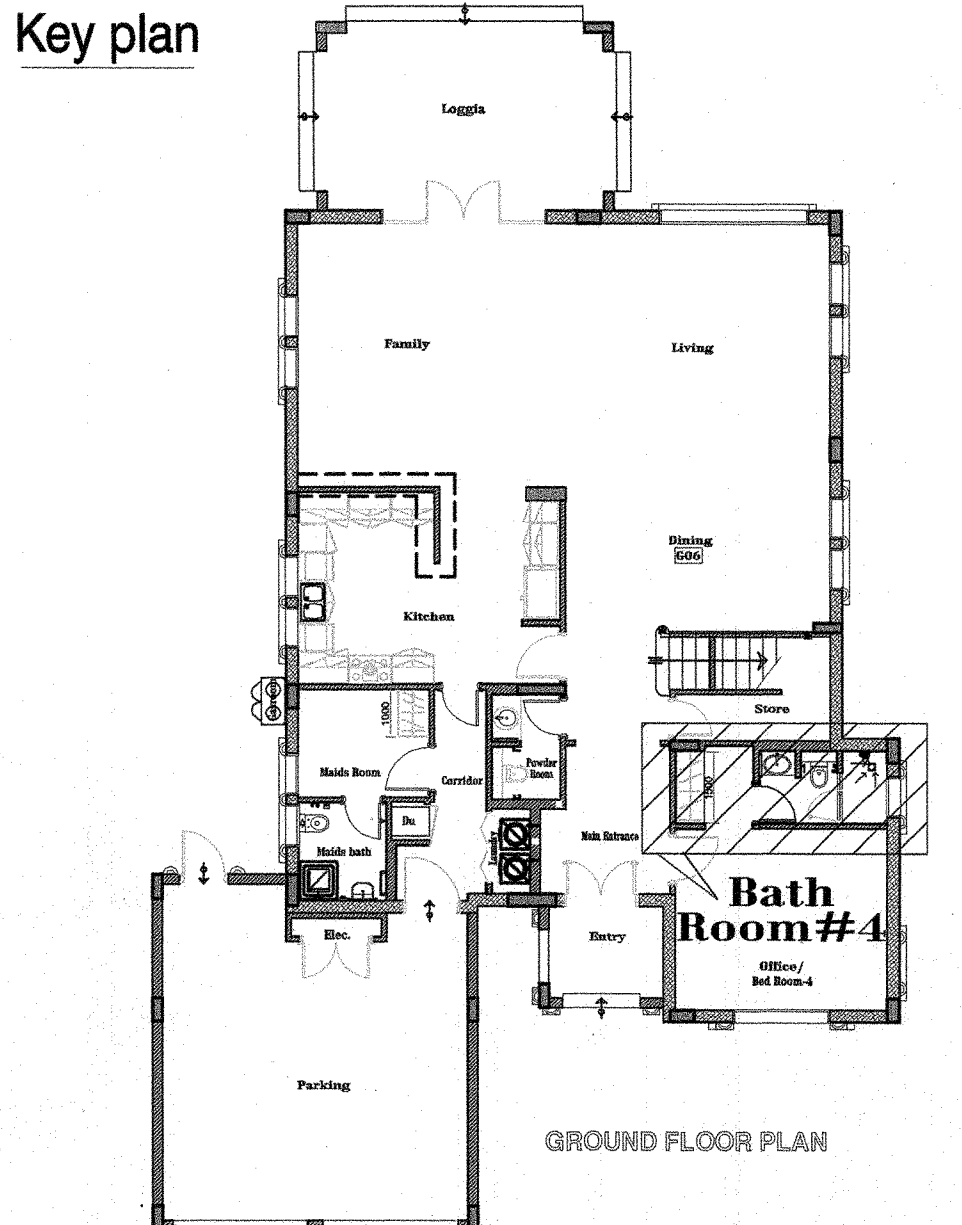

NOTE:
 *ALL THE JOINTS BETWEEN CERAMICS ARE 2MM
 * OPENING FOR WOODEN DOOR ARE ROUGH (BLOCK TO BLOCK)
 * OPENING FOR ALUMINIUM DOORS & WINDOWS ARE CLEAR (PLASTER TO PLASTER)
 ▲ DIRECTION OF STARTING POINT

- LEGEND FOR TOILET ACCESSORIES
- Ⓐ W C
 - Ⓑ WC FLUSH BUTTON
 - Ⓓ TOILET ROLL HOLDER
 - Ⓔ ABLUTION SPRAY
 - Ⓕ SHOWER
 - Ⓖ SHOWER MIXER
 - Ⓗ WASH BASIN
 - Ⓙ WASH BASIN MIXER
 - Ⓝ VANITY MIRROR
 - Ⓞ TOWEL RAIL
 - Ⓜ ROBE HOOK(at door)
 - Ⓢ FLOOR TRAP
 - ⓈⓈ ELECTRICAL SOCKET

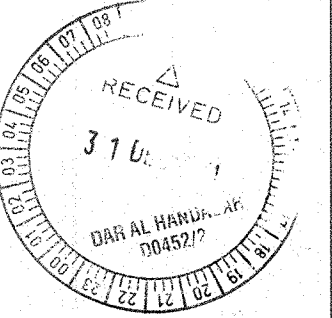








AS BUILT DRAWING

Project	JUMAIRAH PARK
Employer	NAKHEEL
Consultant	dar al-handasah shair and partners
Main Contractor	Pauling Middle East

PACKAGE - 2








LEGACY - TRADITIONAL
 TILING (FLOOR & WALL)
 BATH ROOM # 04 - IN GROUND FLOOR

Drawn: T.Murugan	Review: Eng. Ziyad	Checked: Eng.Ghassan Zeitouni
Scale: 1:20	Date: 24-12-2011	
Drawing No.	PME/JP/ AB /LEGACY TRADITIONAL / CT-006	

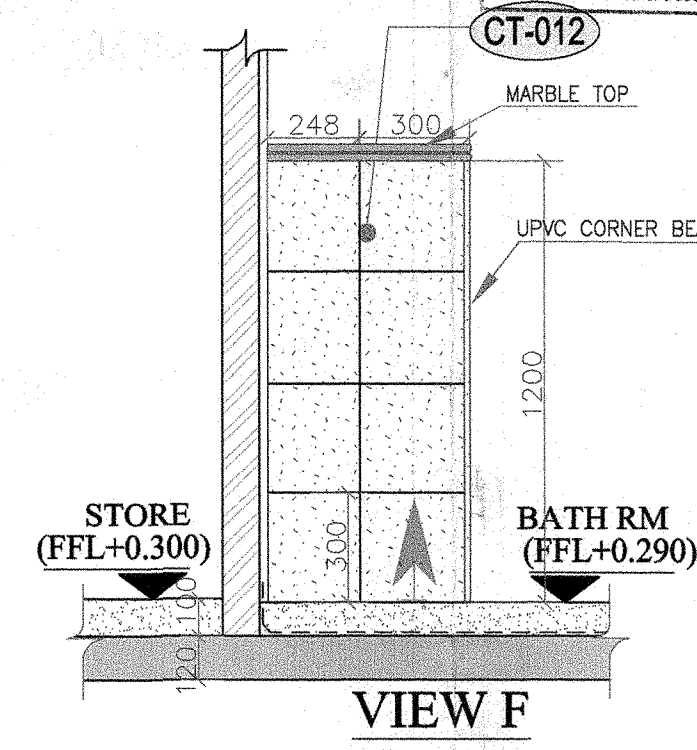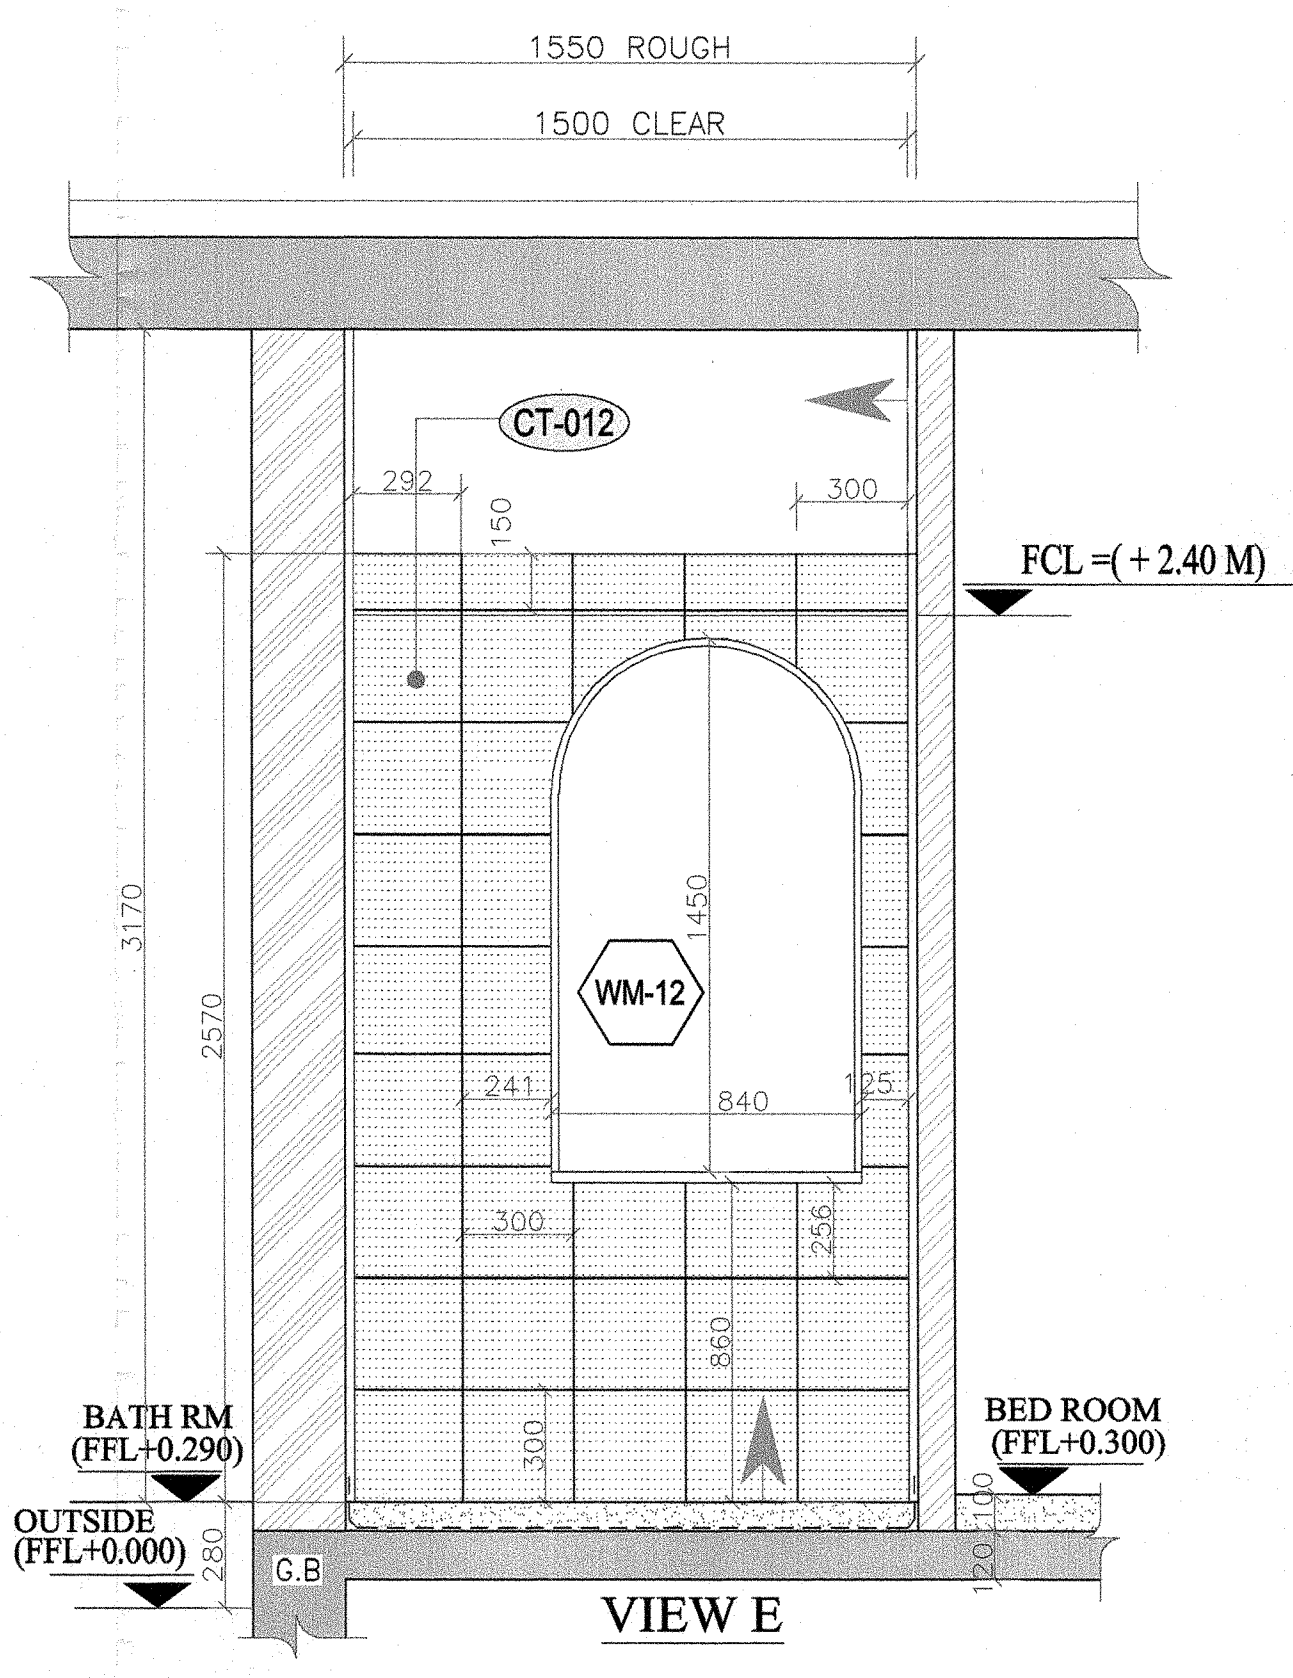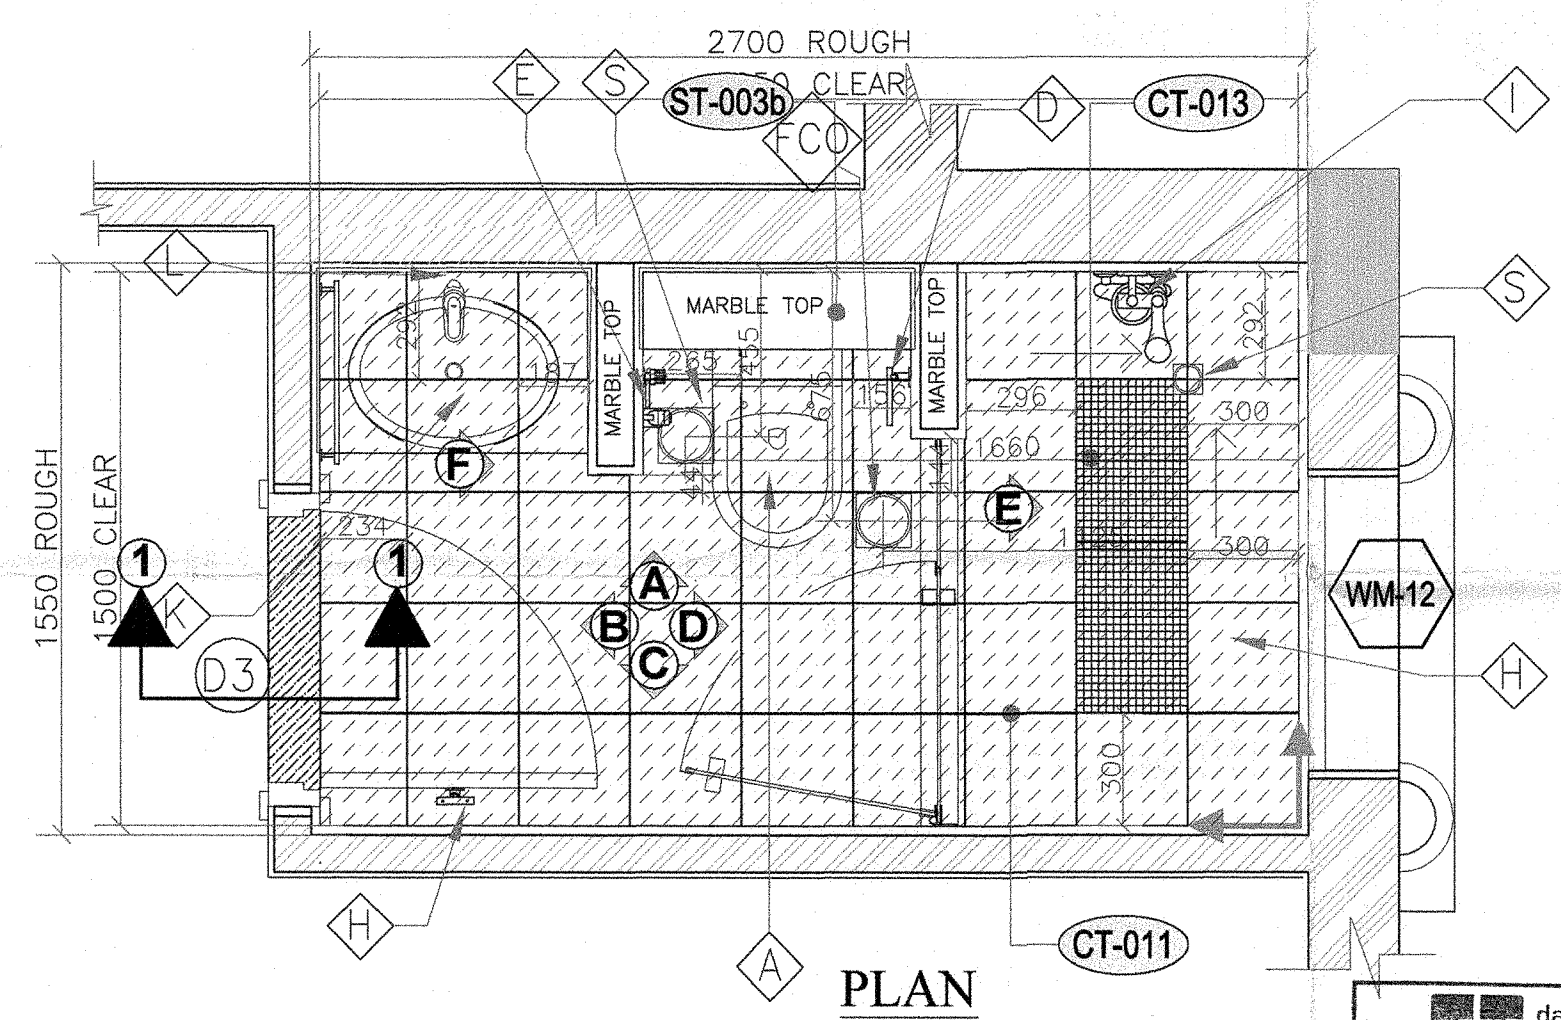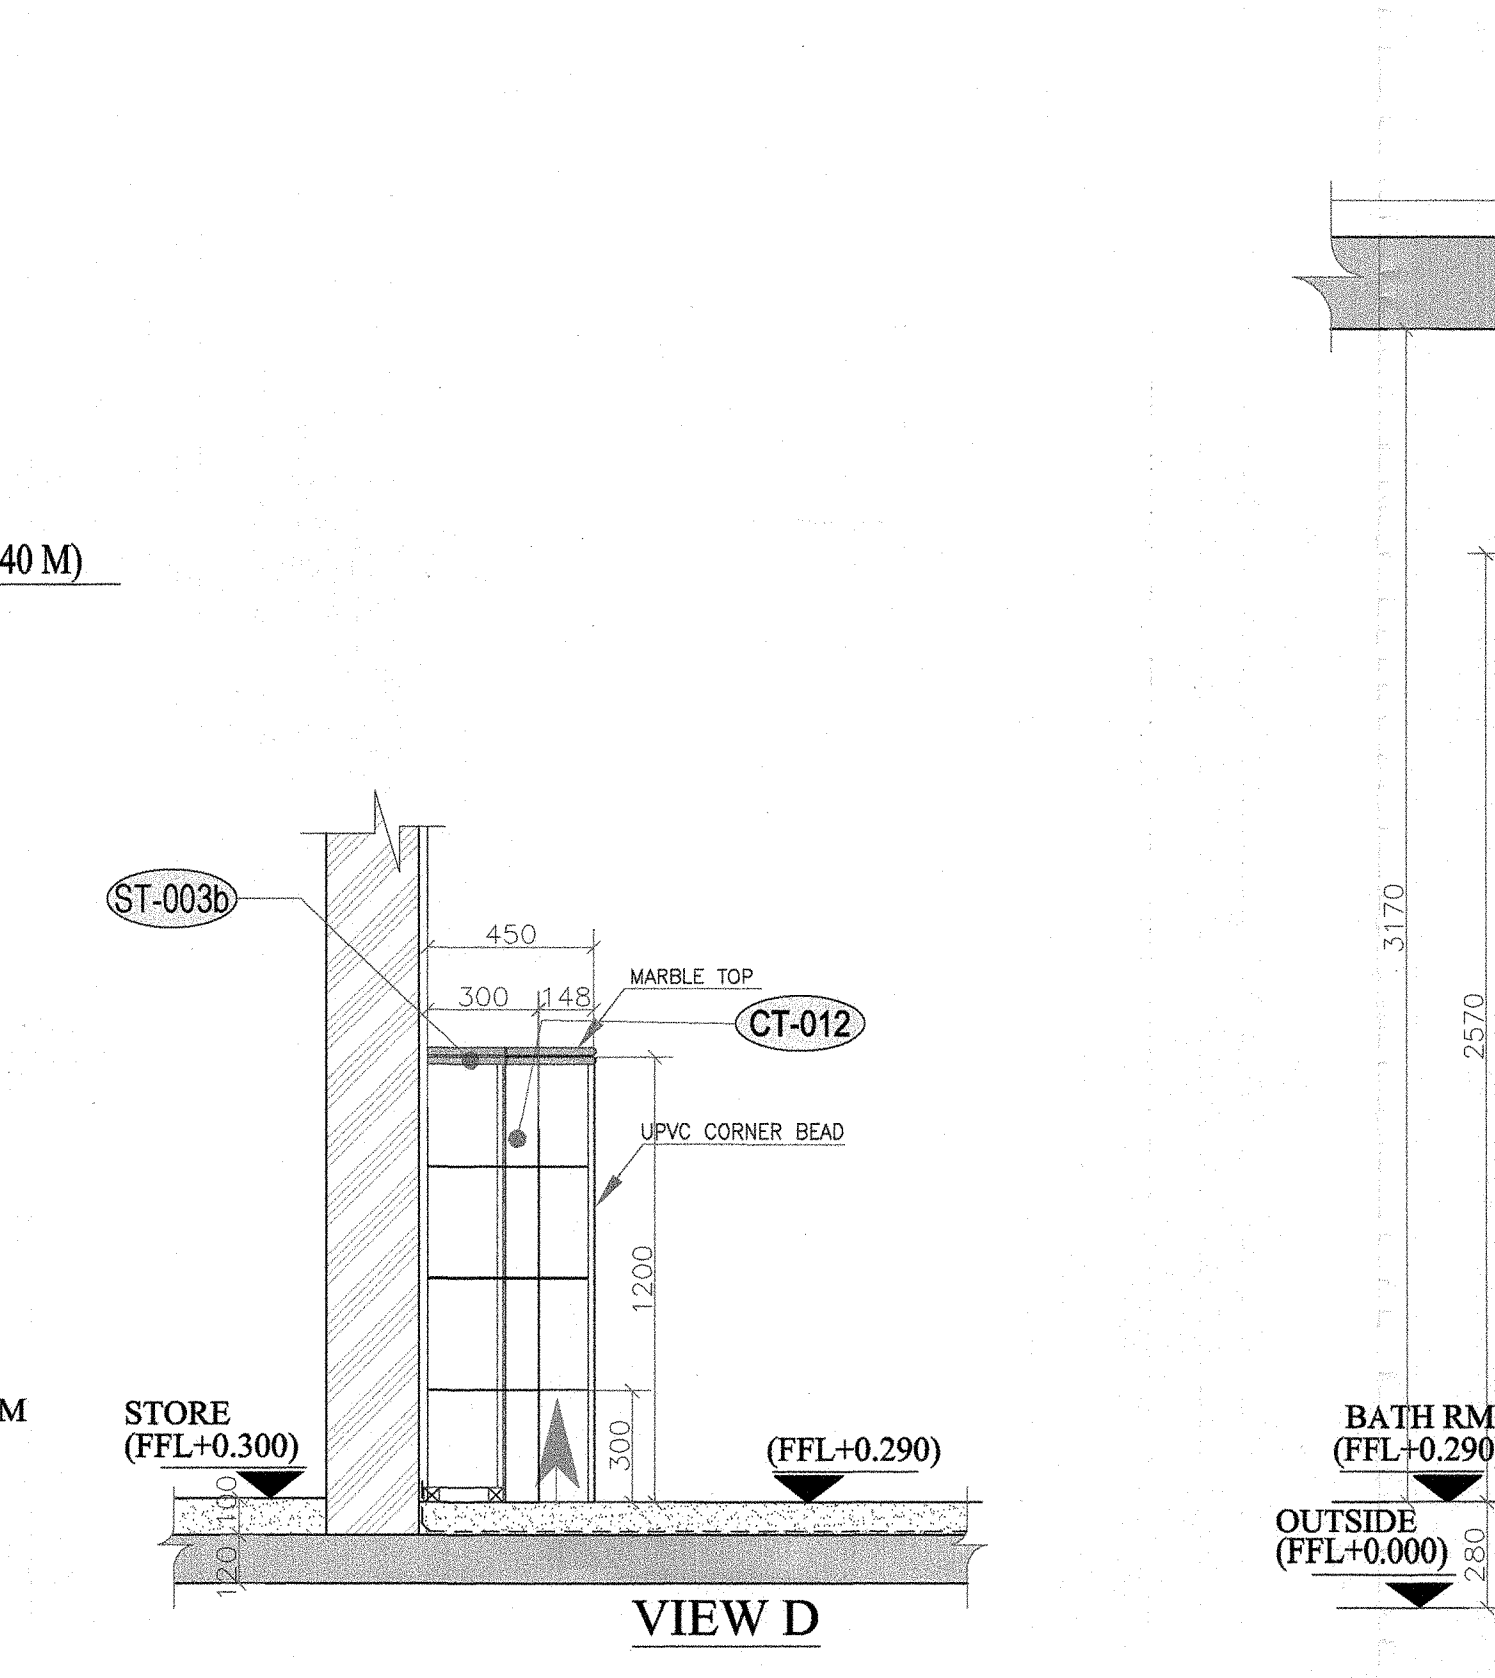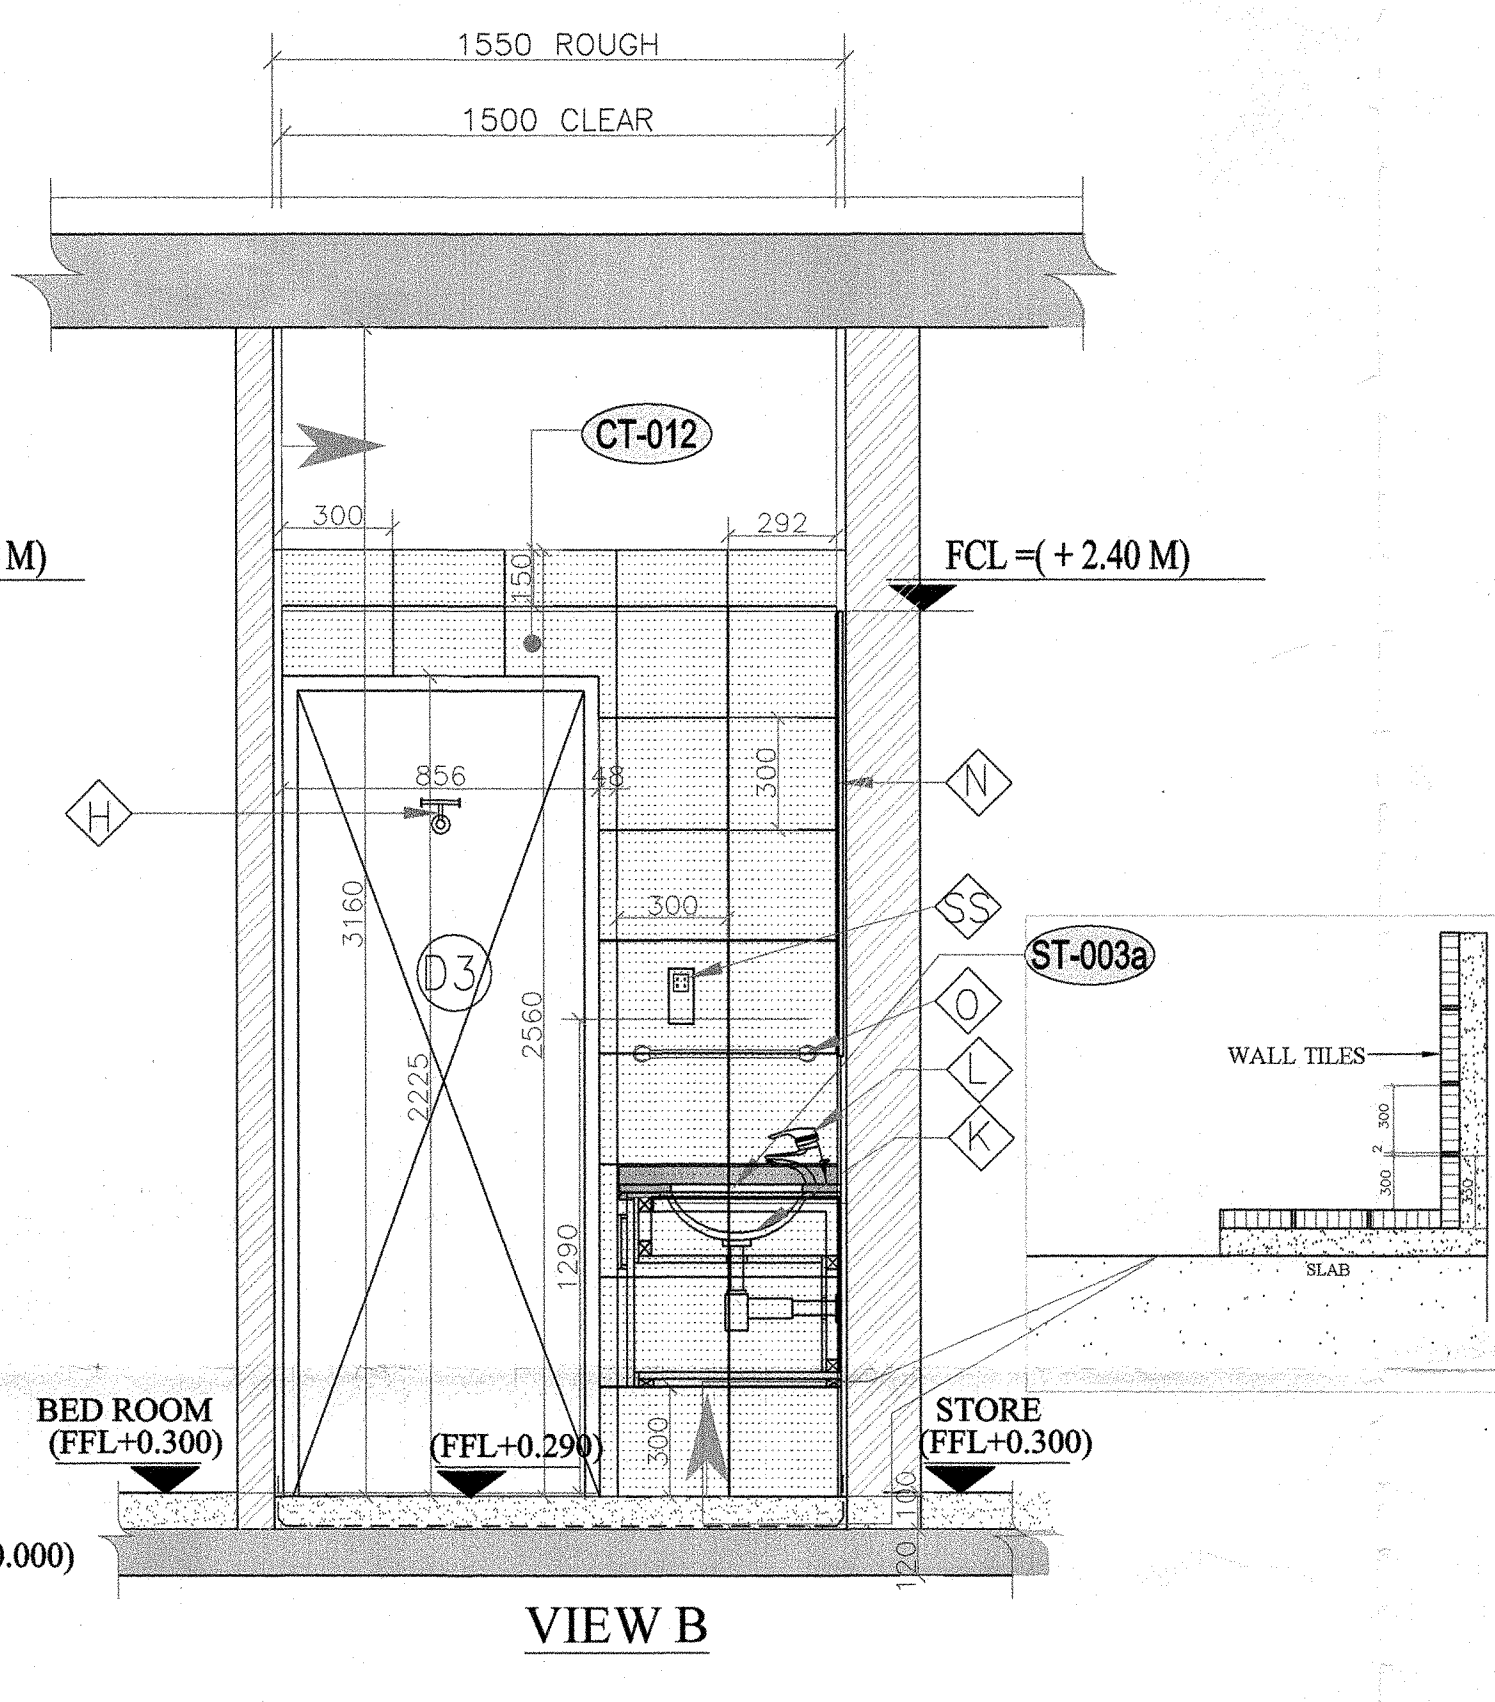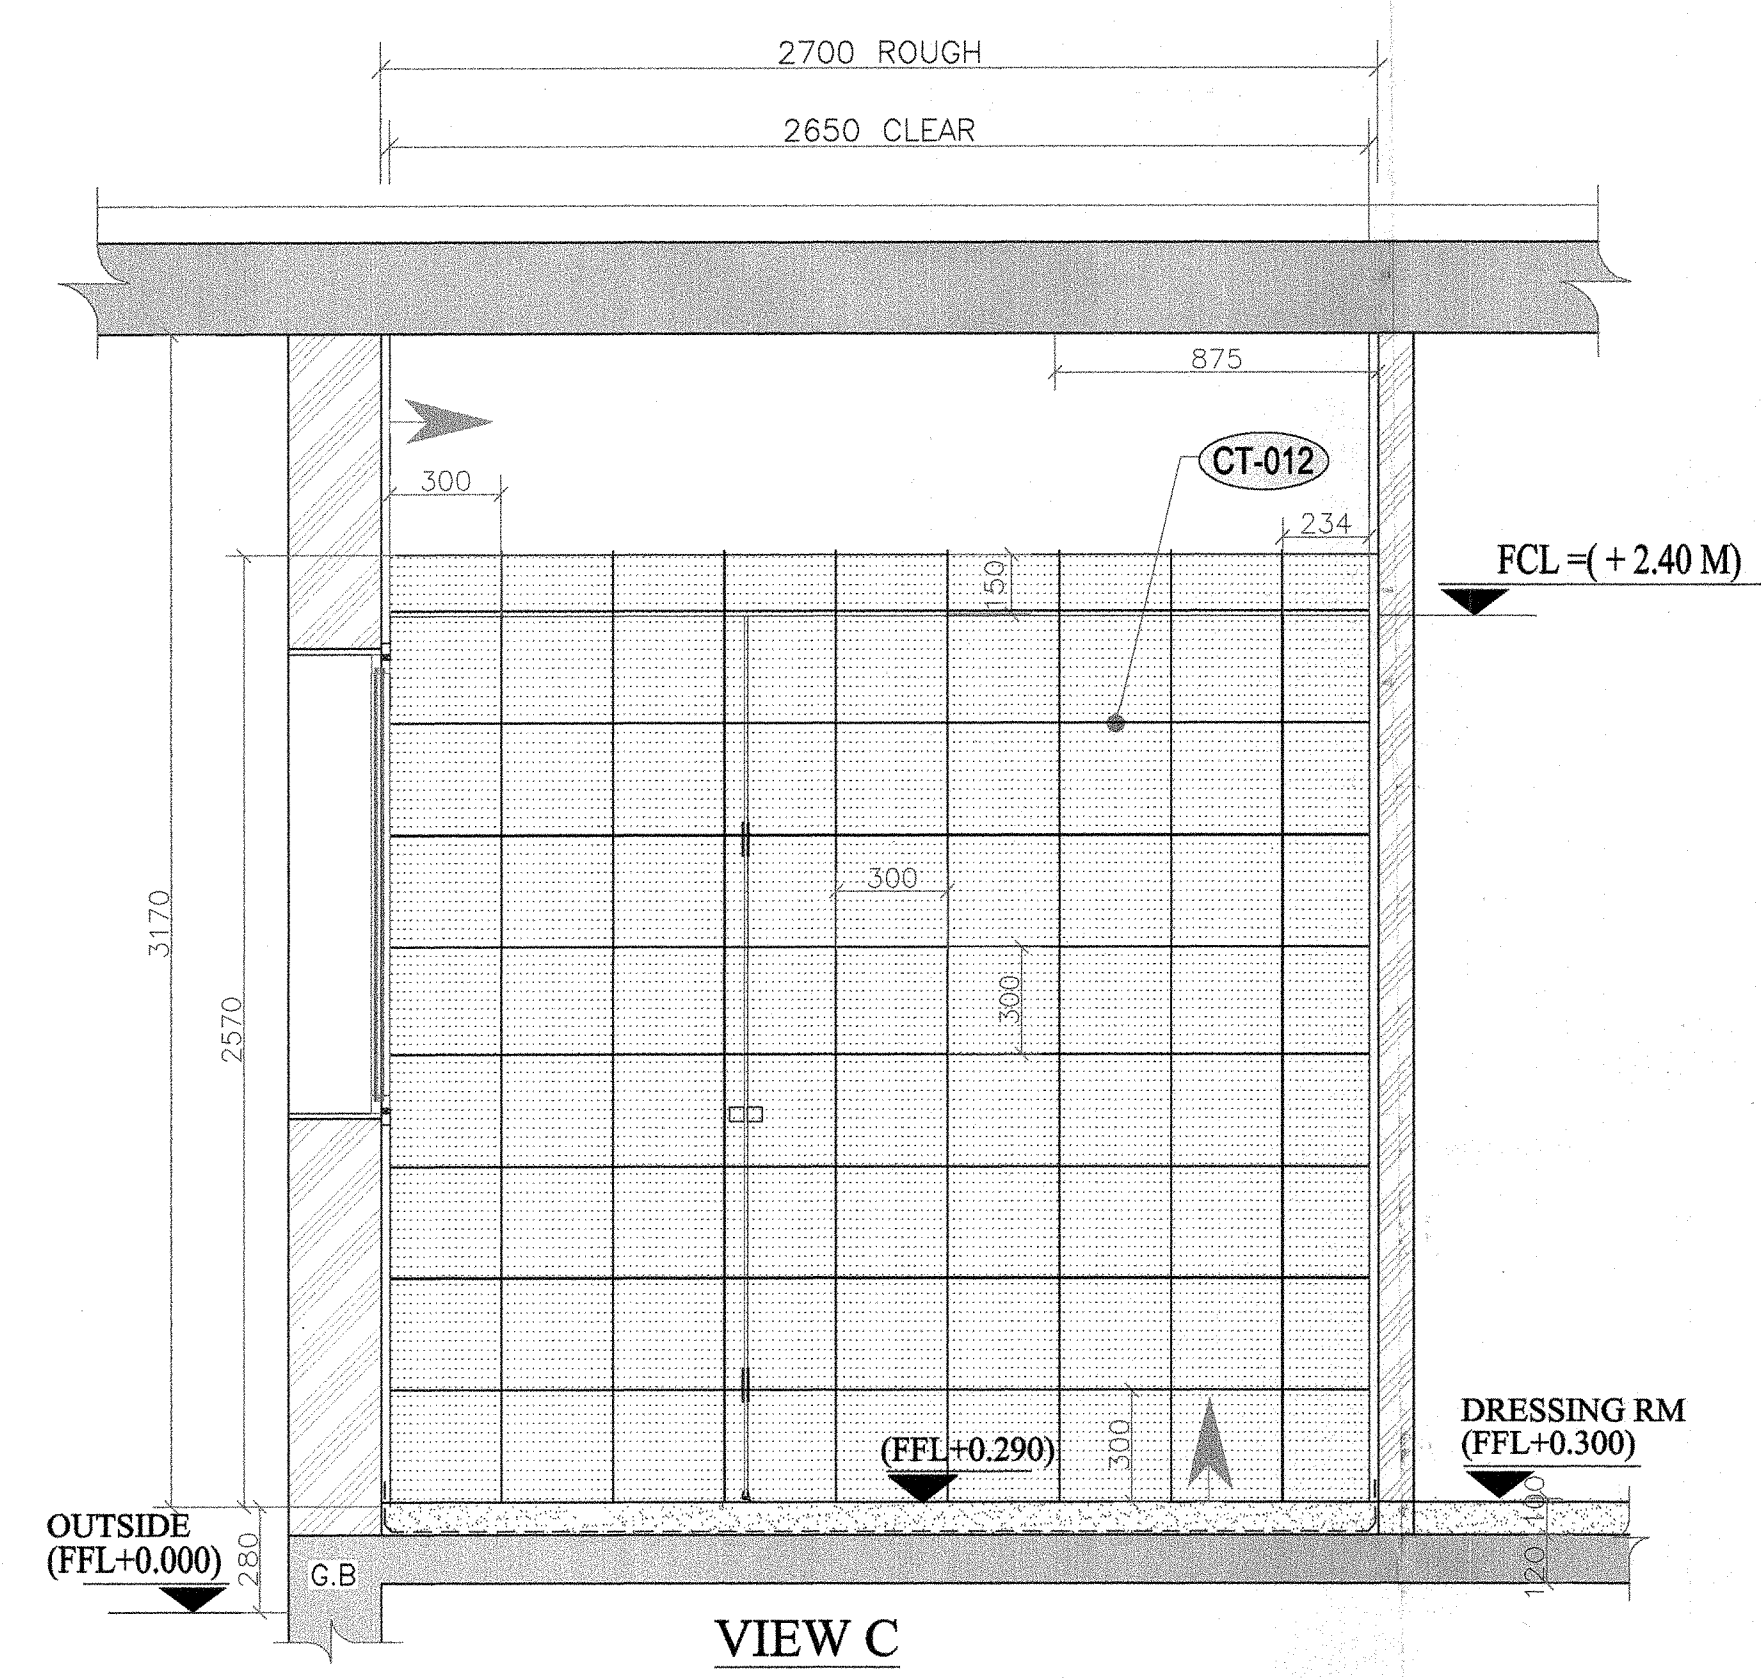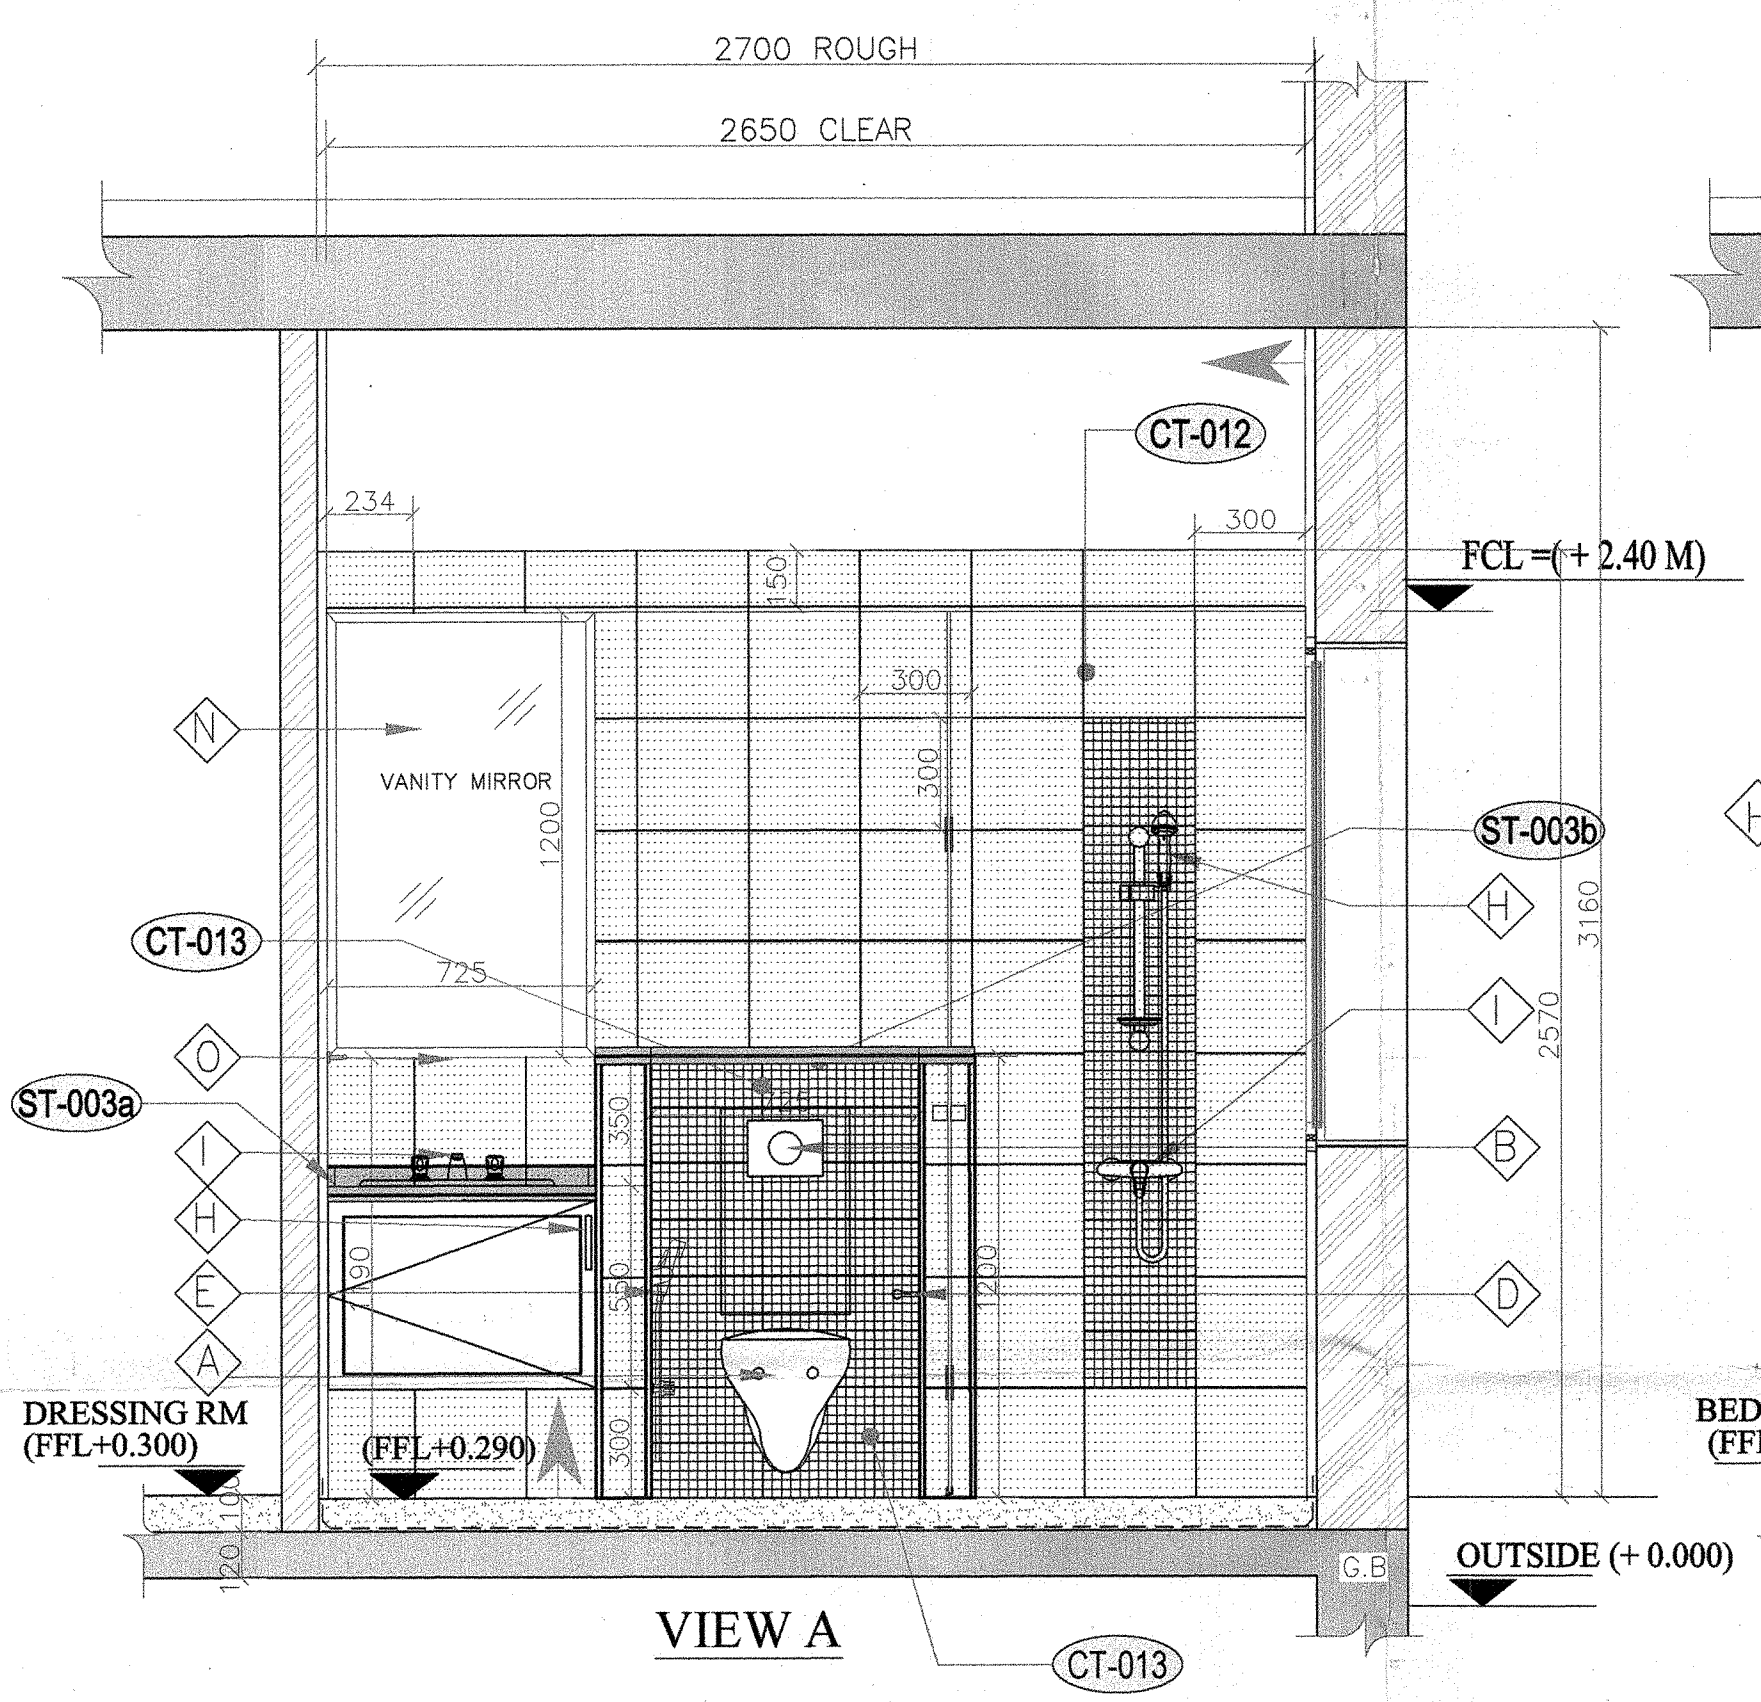


CLUSTER # 3 (P2)
 VILLA # 6


Reference	Traditional		Dimension (mm)	Application	Area
	Brand Name	Model			
CT-011	Pamesa	Tibet Marfil	300 x 300	Floors	General Bathroom 2, 3 & 4
CT-012	Pamesa	Ikom Blanco	300 x 300	Walls	General Bathroom 2, 3 & 4
CT-012a			20 x 300	Wall corner & window surroundings	General Bathroom 2, 3 & 4
CT-013	Pamesa	Tibet Marfil	25 x 25	Wall Mosaic	General Bathroom 2, 3 & 4

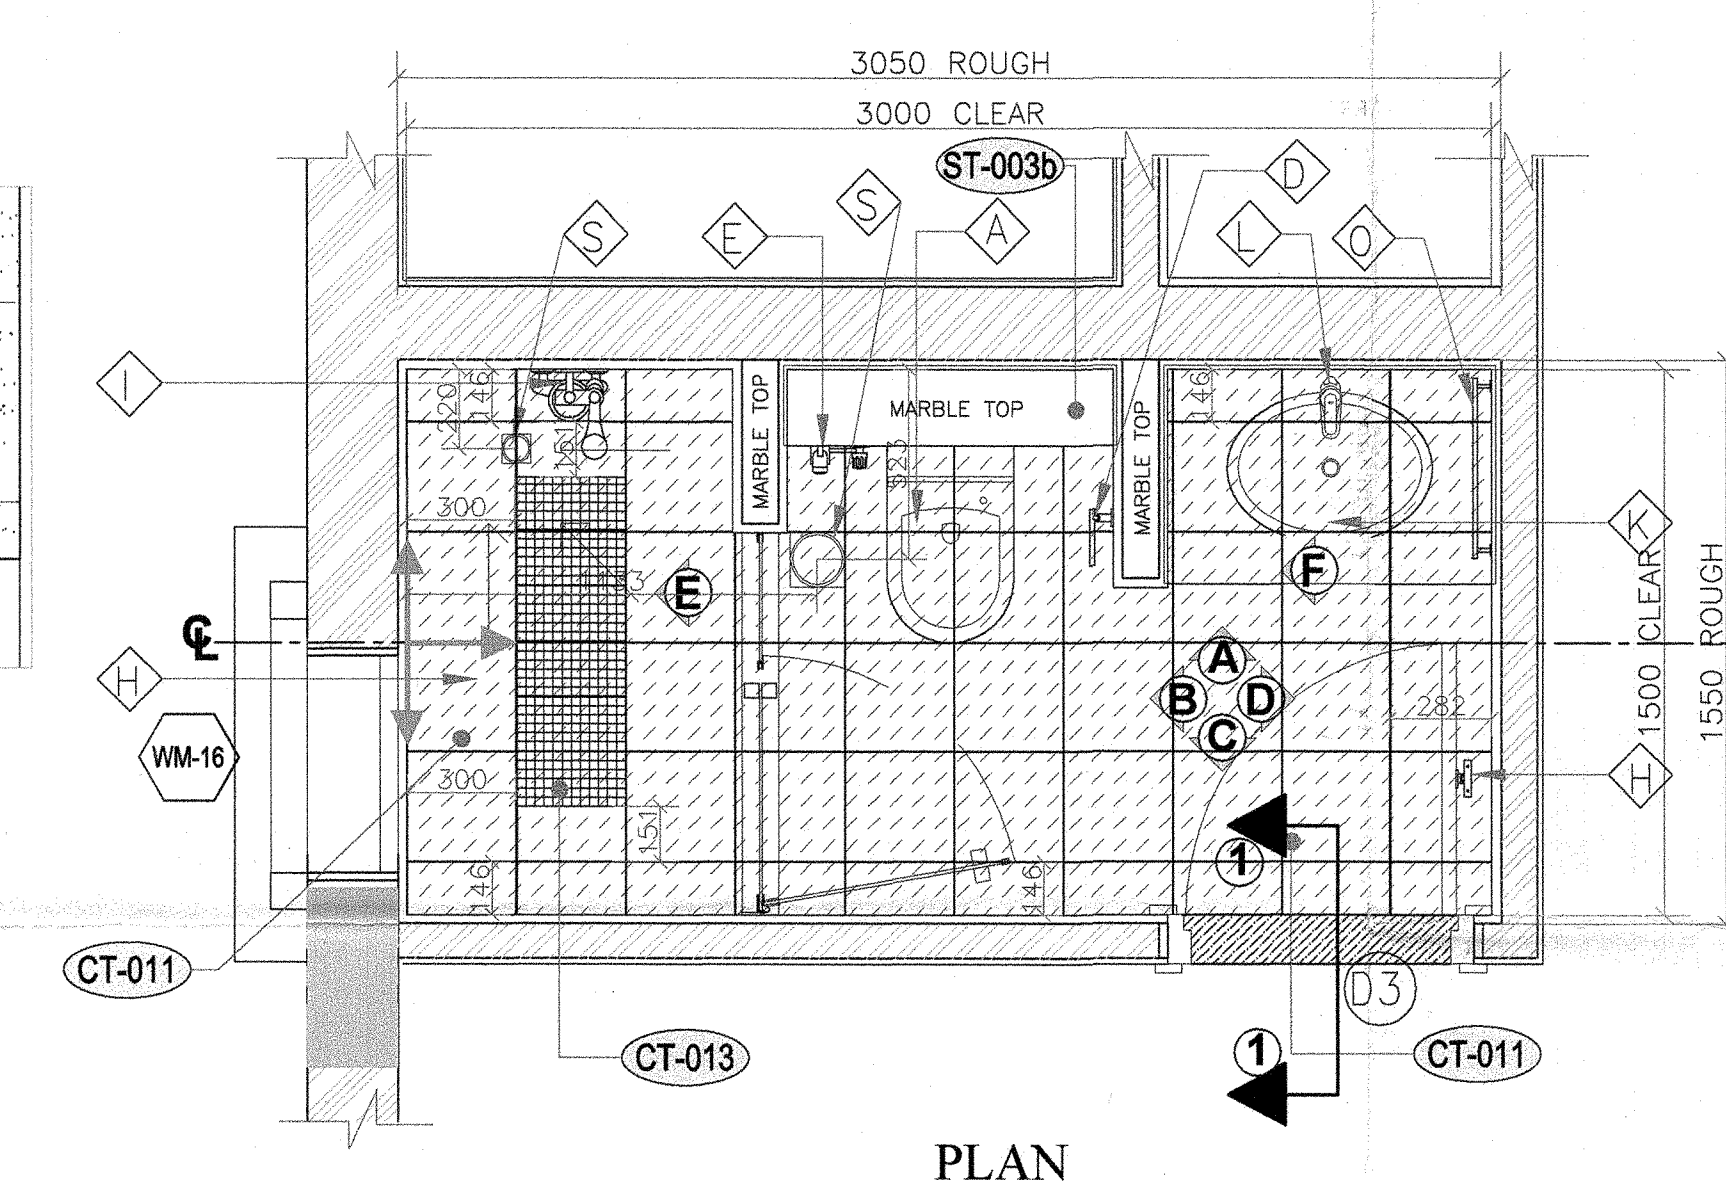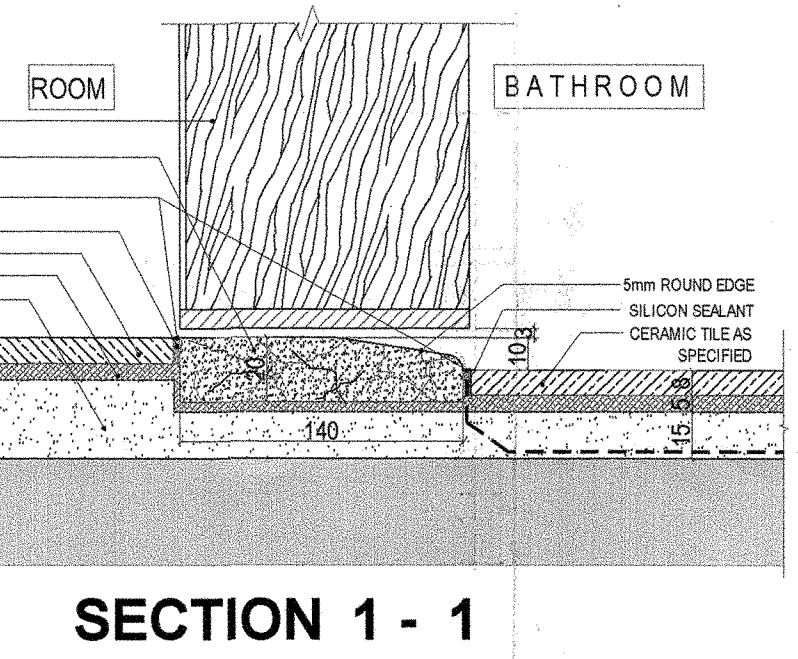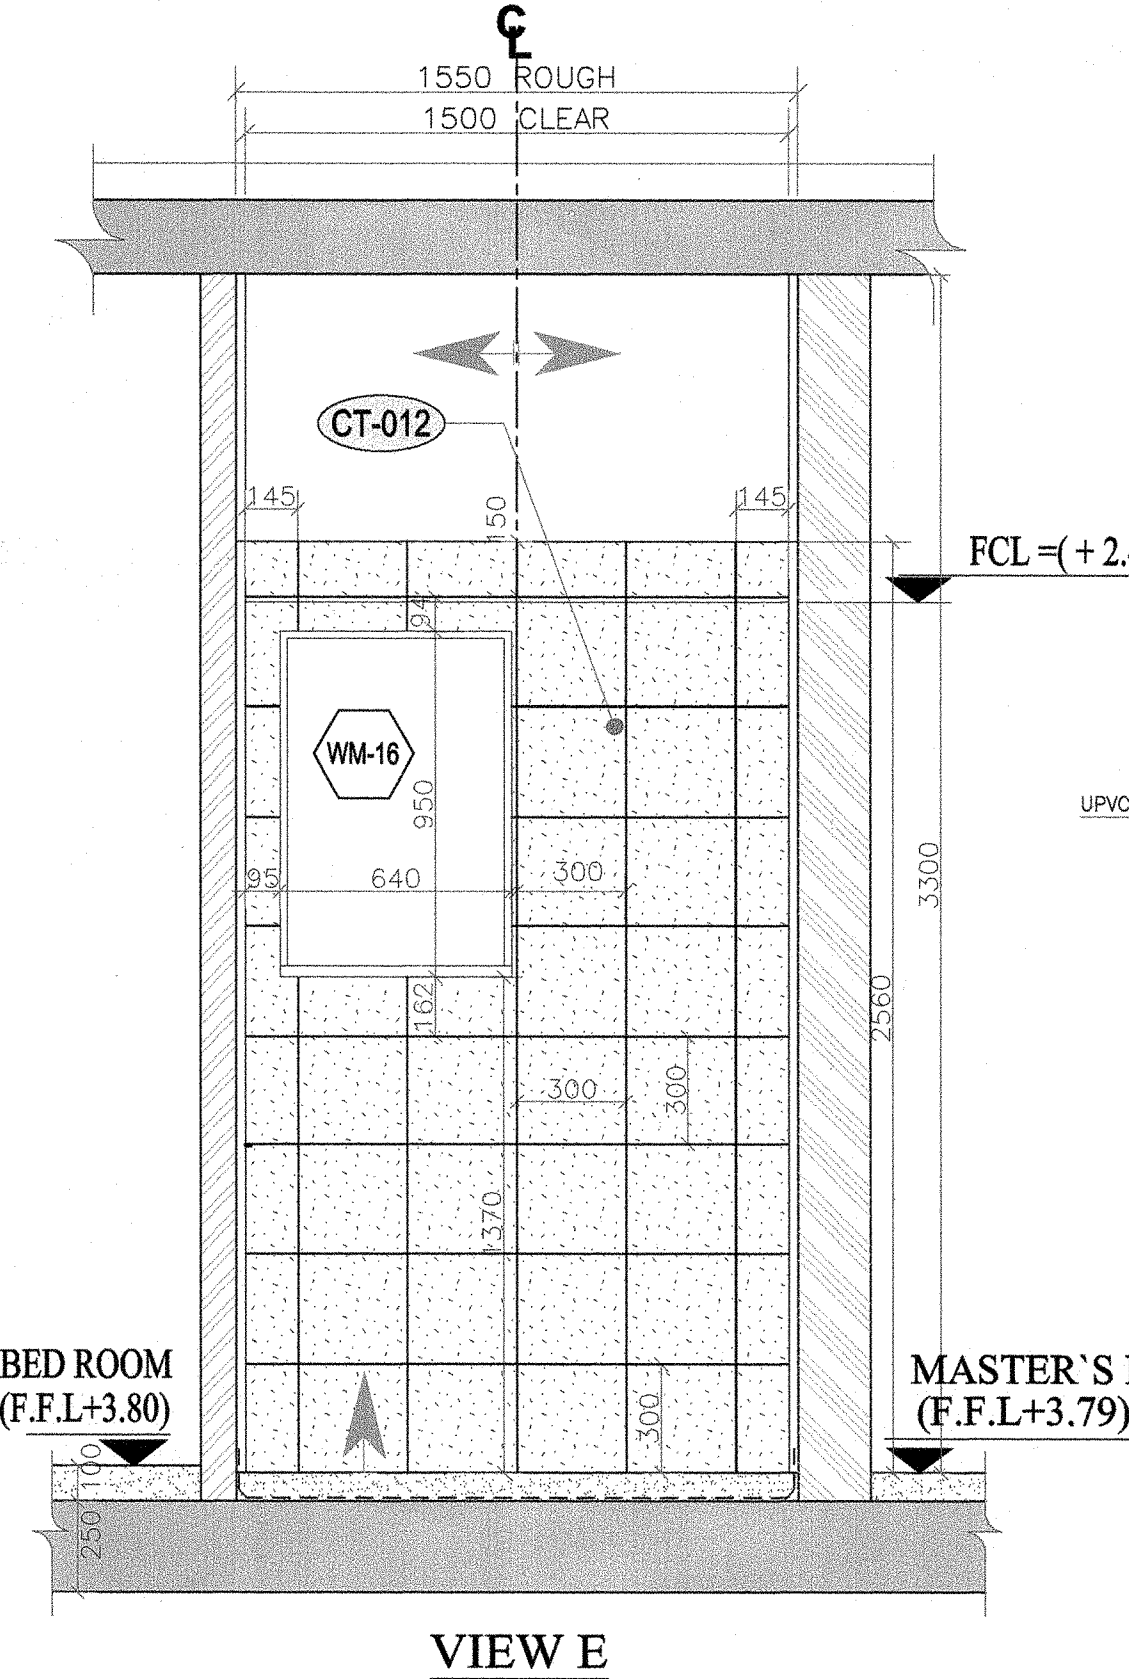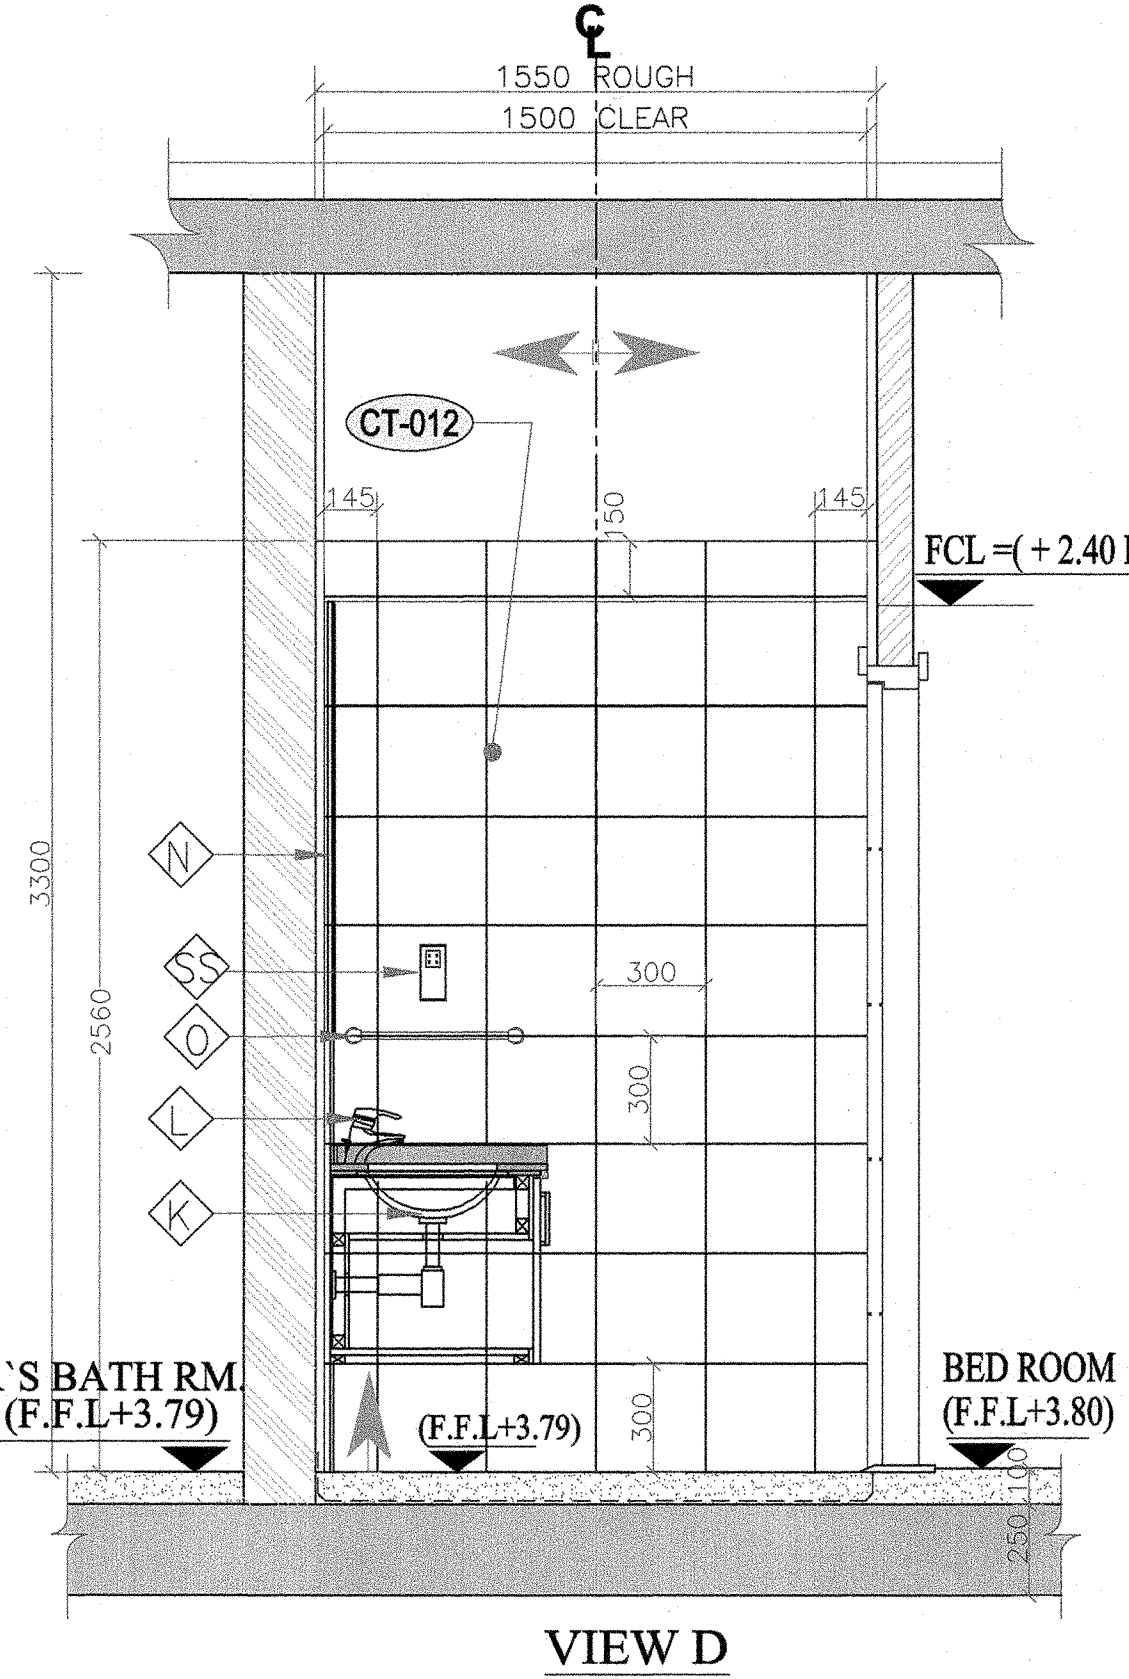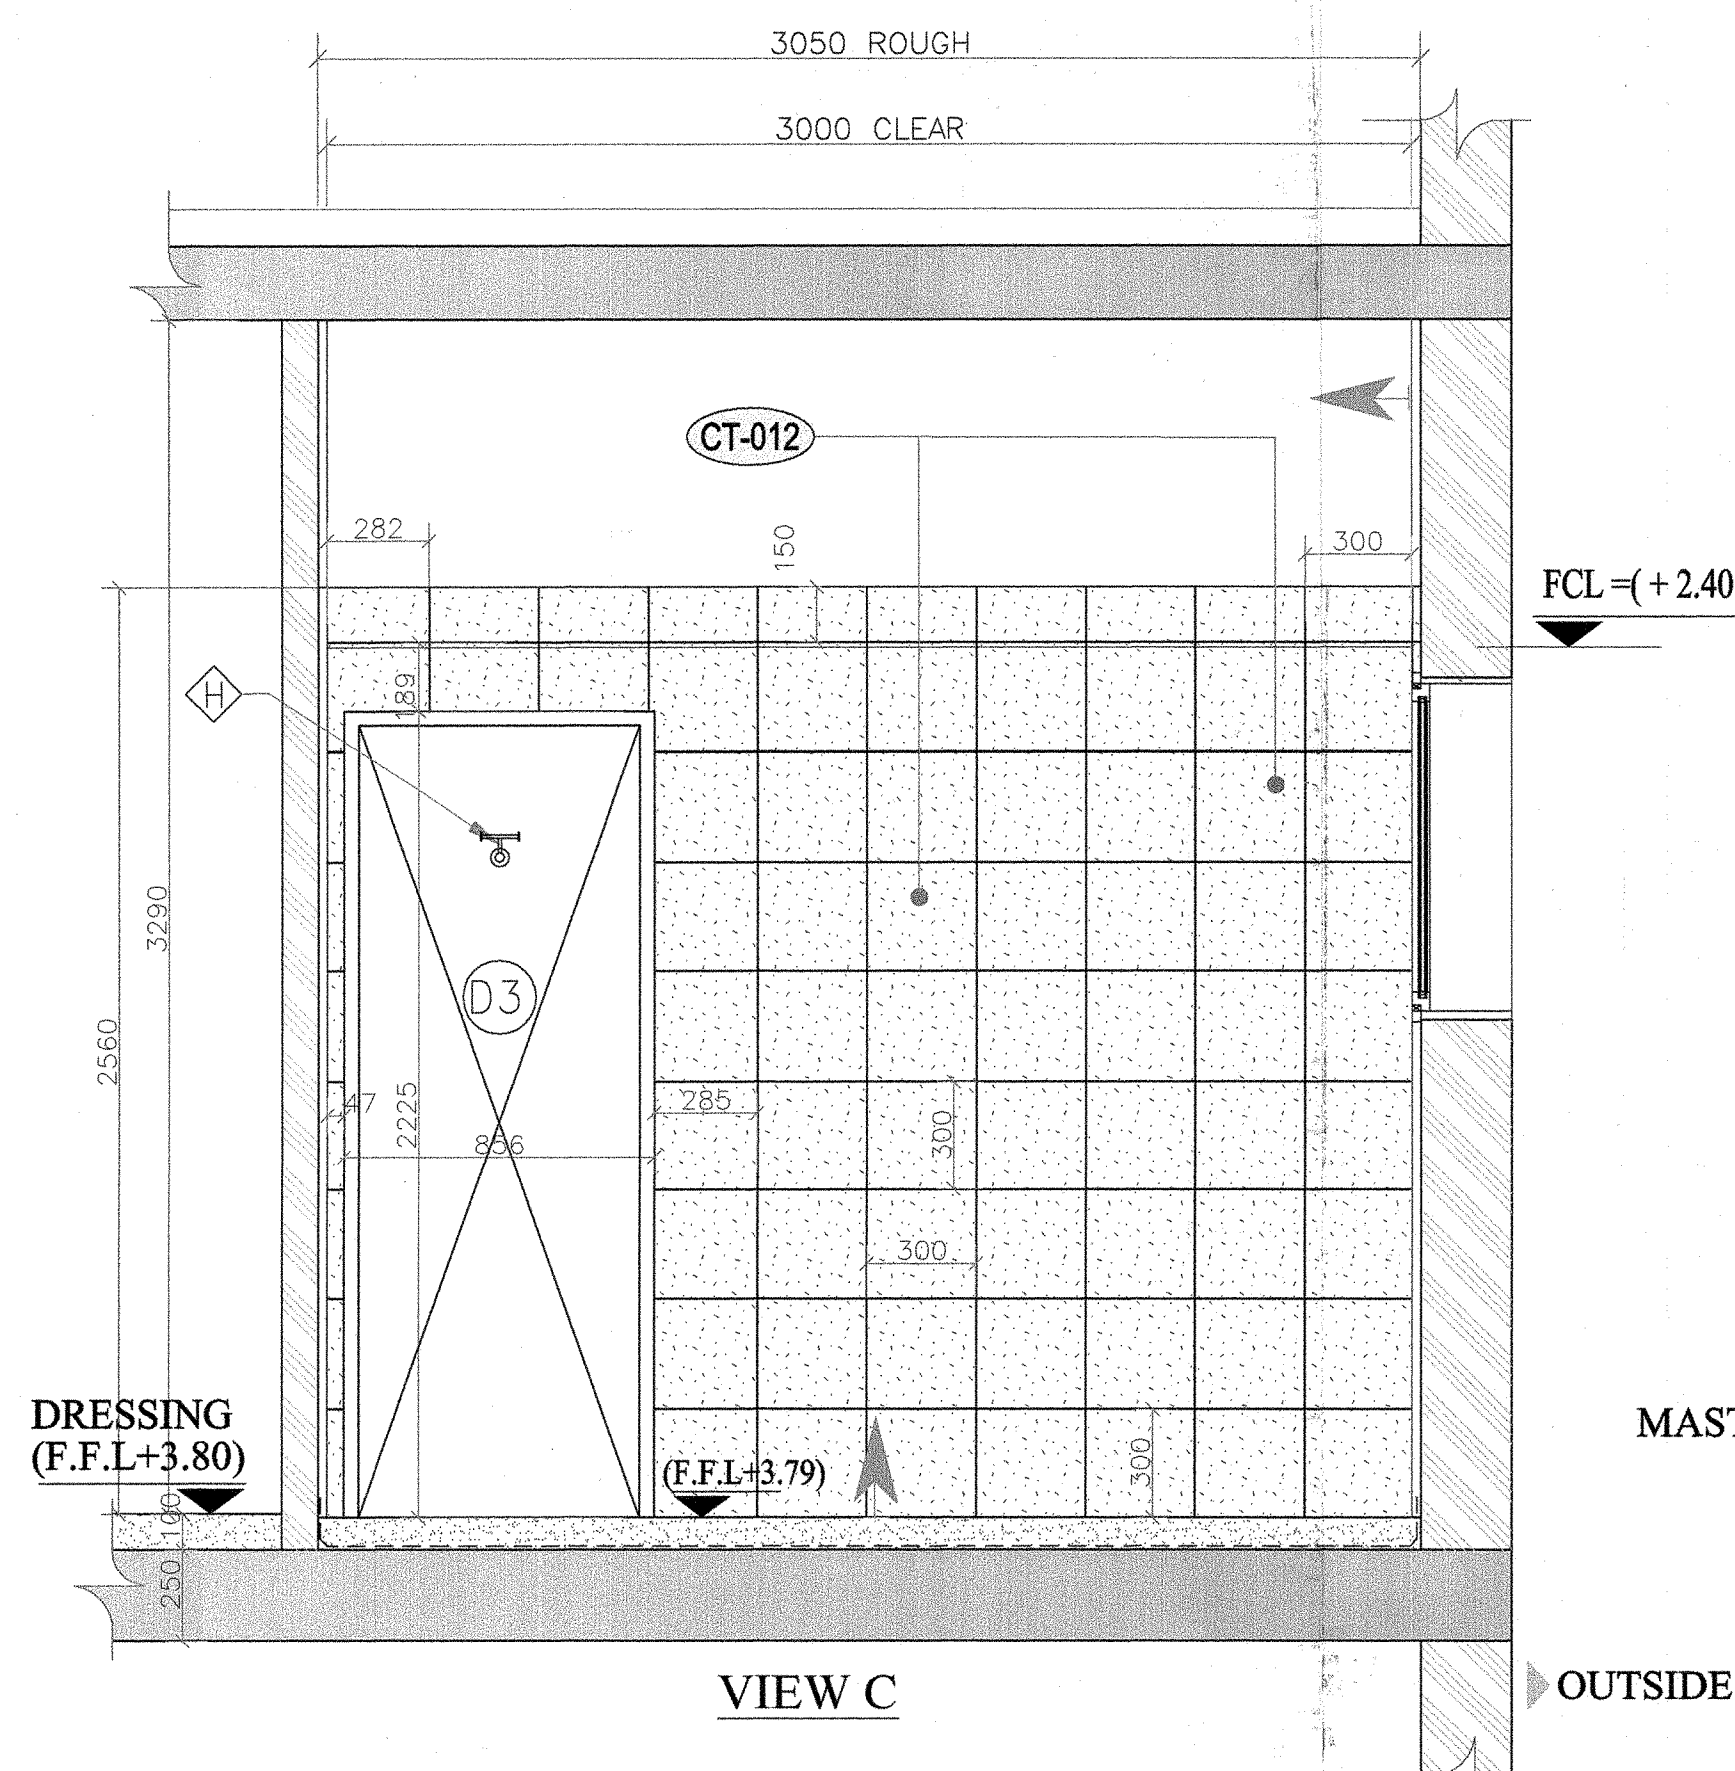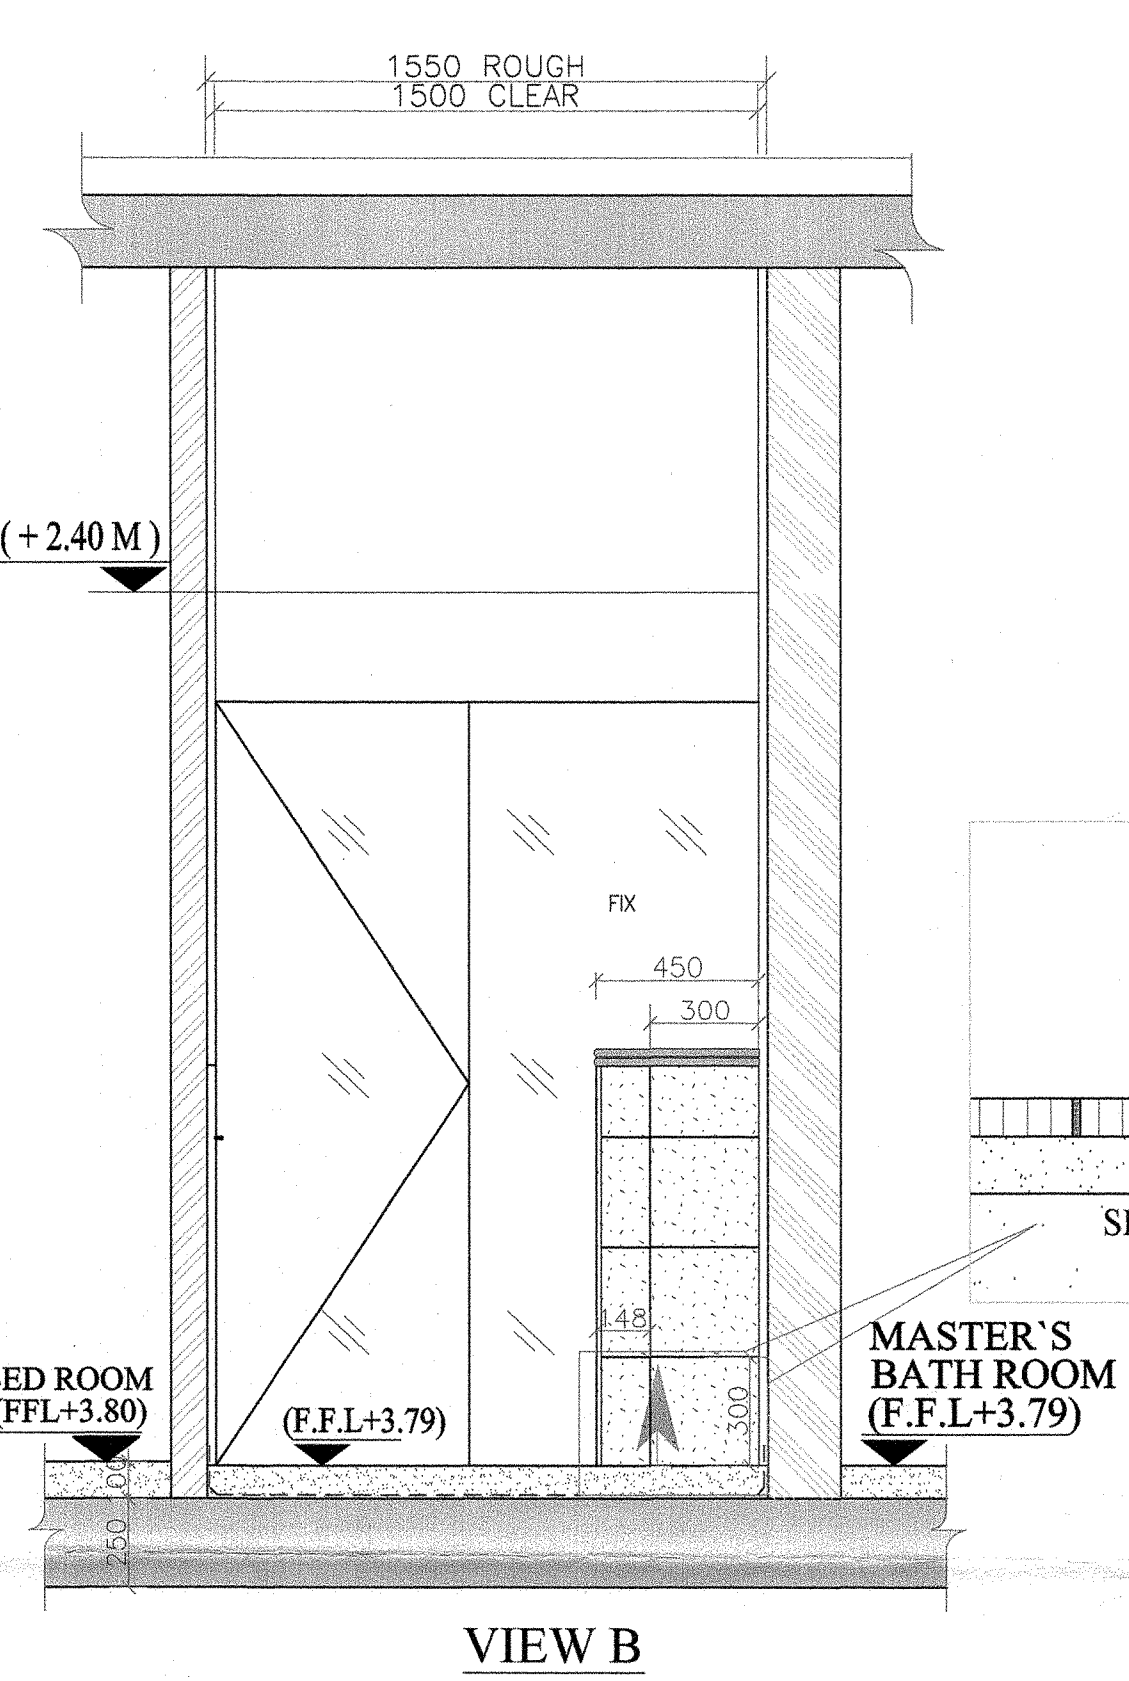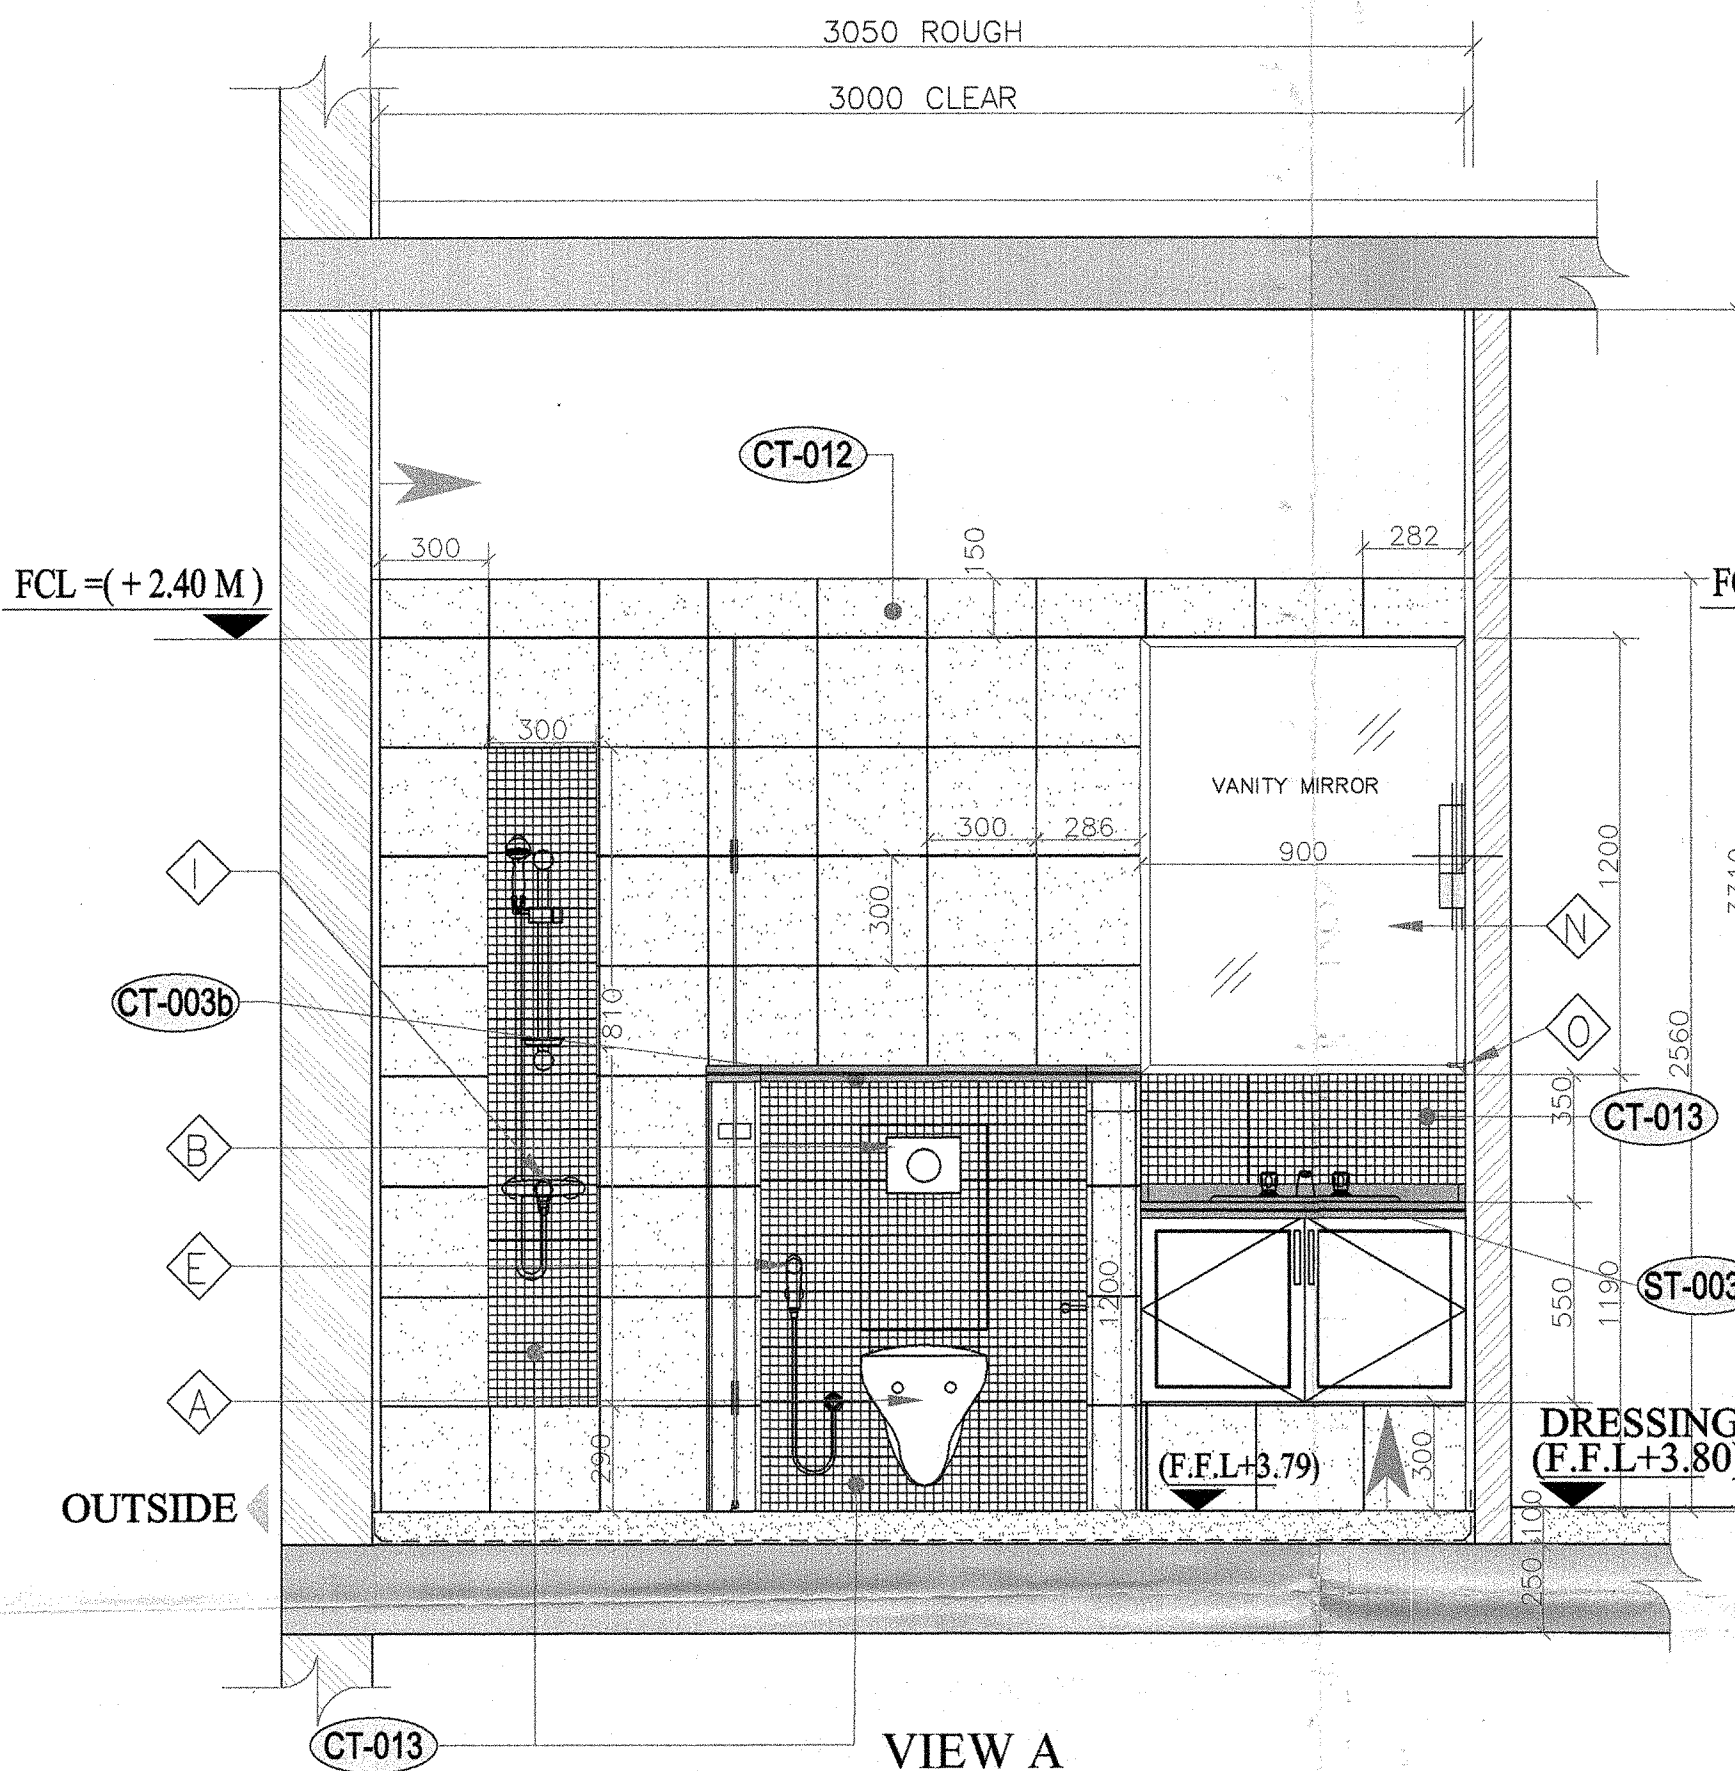

PLAN

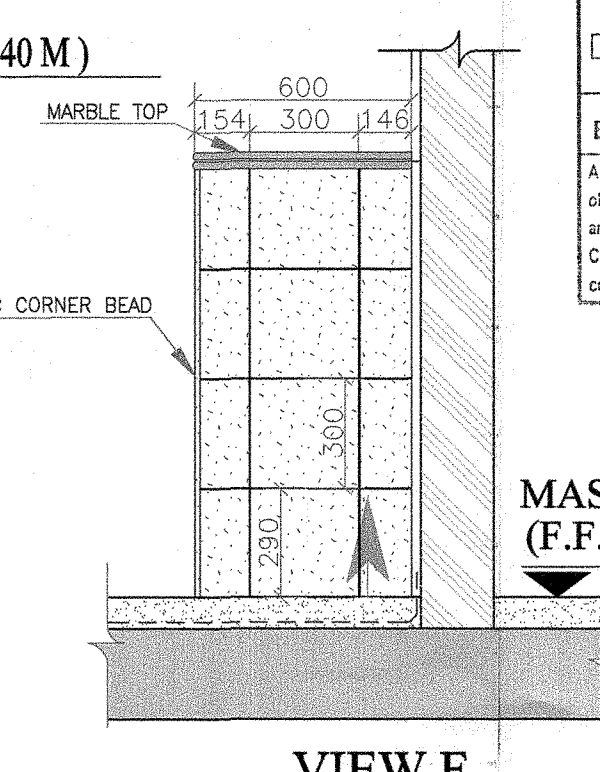

VIEW F

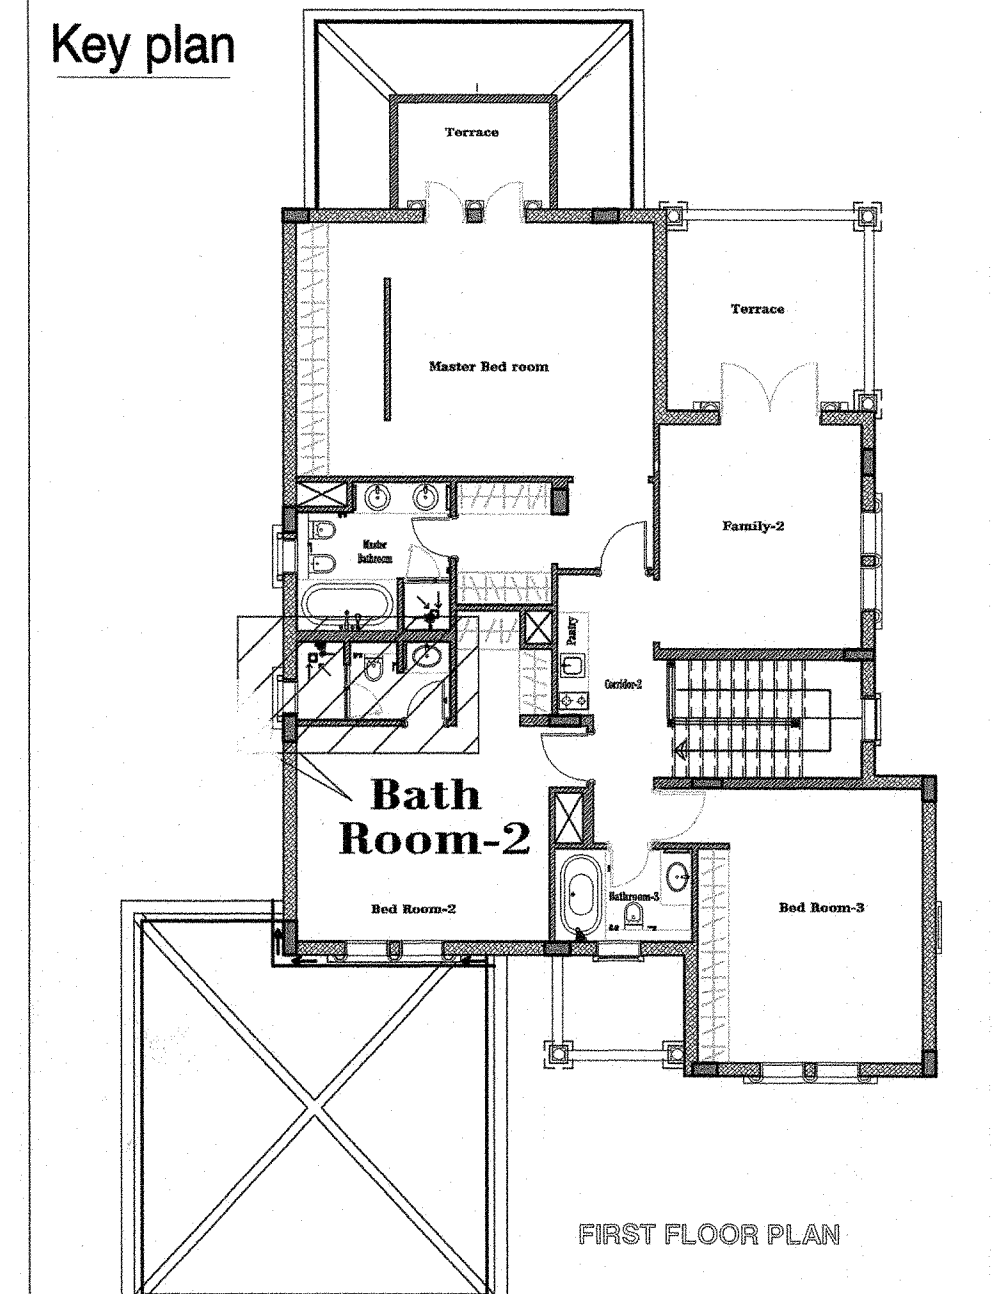

- NOTE:**
- *ALL THE JOINTS BETWEEN CERAMICS ARE 2MM
 - * OPENING FOR WOODEN DOOR ARE ROUGH (BLOCK TO BLOCK)
 - * OPENING FOR ALUMINIUM DOORS & WINDOWS ARE CLEAR (PLASTER TO PLASTER)
- LEGEND FOR TOILET ACCESSORIES**
- A - W C
 - B - WC FLUSH BUTTON
 - D - TOILET ROLL HOLDER
 - E - ABLUTION SPRAY
 - H - SHOWER
 - I - SHOWER MIXER
 - K - WASH BASIN
 - L - WASH BASIN MIXER
 - N - VANITY MIRROR
 - O - TOWEL RAIL
 - P - ROBE HOOK (at door)
 - S - FLOOR TRAP
 - SS - ELECTRICAL SOCKET

dar al-handasah

CODE 1 APPROVED

CODE 2 APPROVED AS NOTED
WORK MAY PROCEED SUBJECT TO
INCORPORATION OF ENDORSED
COMMENTS

CODE 3 RESUBMIT FOR APPROVAL
WORK MAY NOT PROCEED

CODE 4 REJECTED

BY: _____ DATE: _____

Approval shall not relieve the contractor of any of his
obligations under the Contract or constitute authorization of
any change to Contract Documents or variation to the works.
Contractor is responsible for dimensions, quantities and
coordination with other trades.

AS BUILT DRAWING

Project: **JUMAIRAH PARK**

Employer: **NAKHEEL**

Consultant: **dar al-handasah**
shair and partners

Main Contractor: **Pauling Middle East**

PACKAGE - 2


Drawing Title: **LEGACY - TRADITIONAL
TILING (FLOOR & WALL)
BATH ROOM # 02 - IN FIRST FLOOR**

Drawn: T.Murugan Review: Eng. Ziyad Checked: Eng.Ghassan Zeitouni


Scale: 1:20 Date: 24-12-2011

Drawing No. **PME/JP/ AB / LEGACY TRADITIONAL / CT-007**


**CLUSTER # 3 (P2)
VILLA # 6**

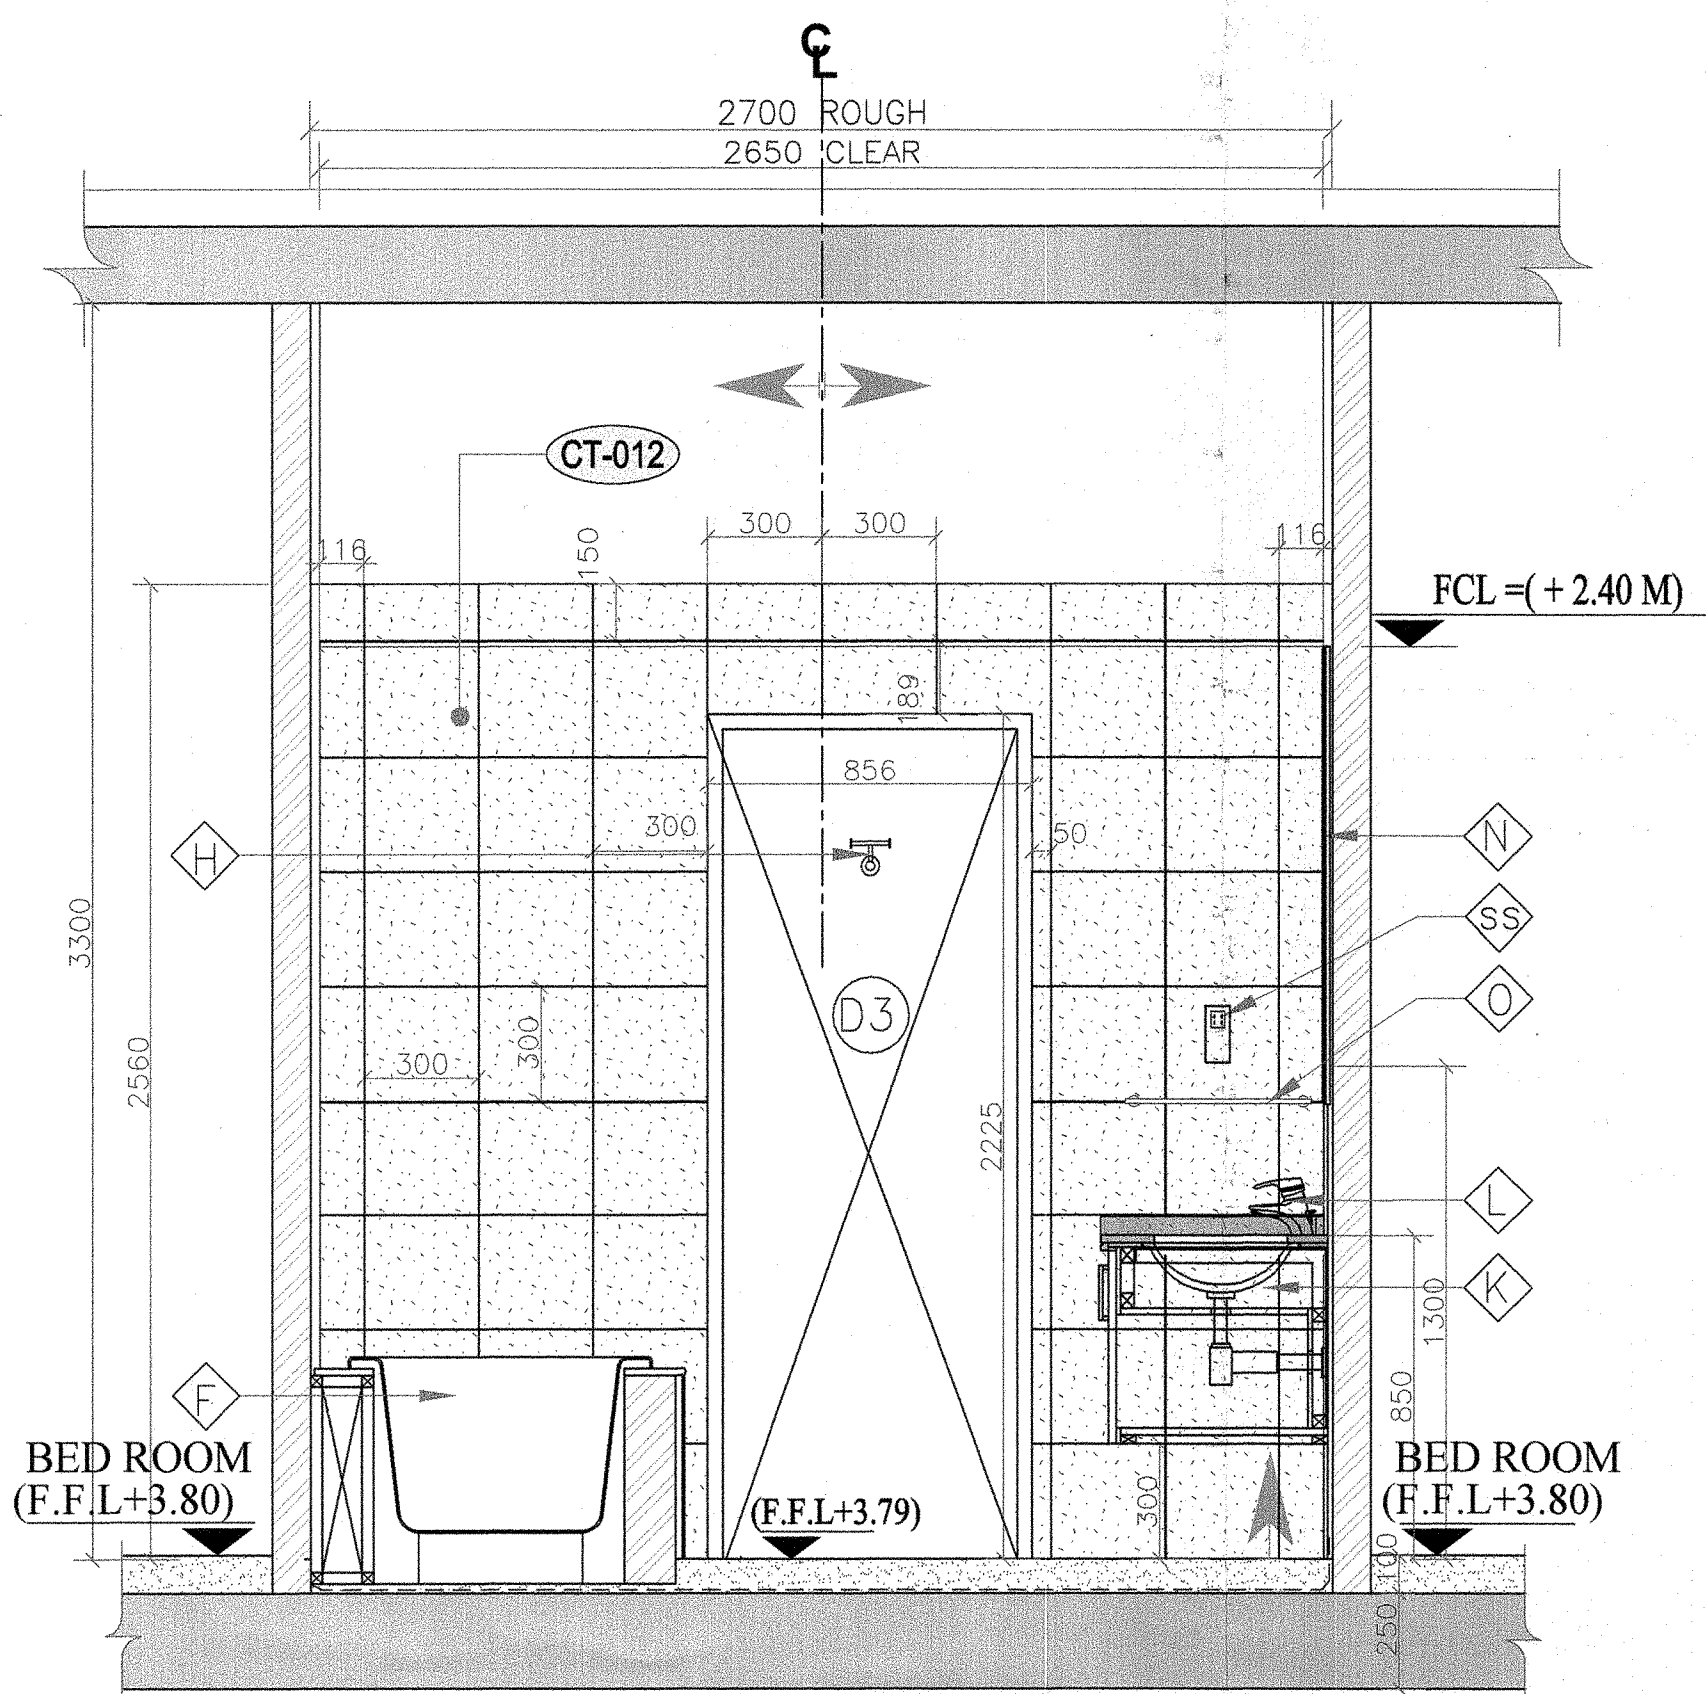


VIEW A

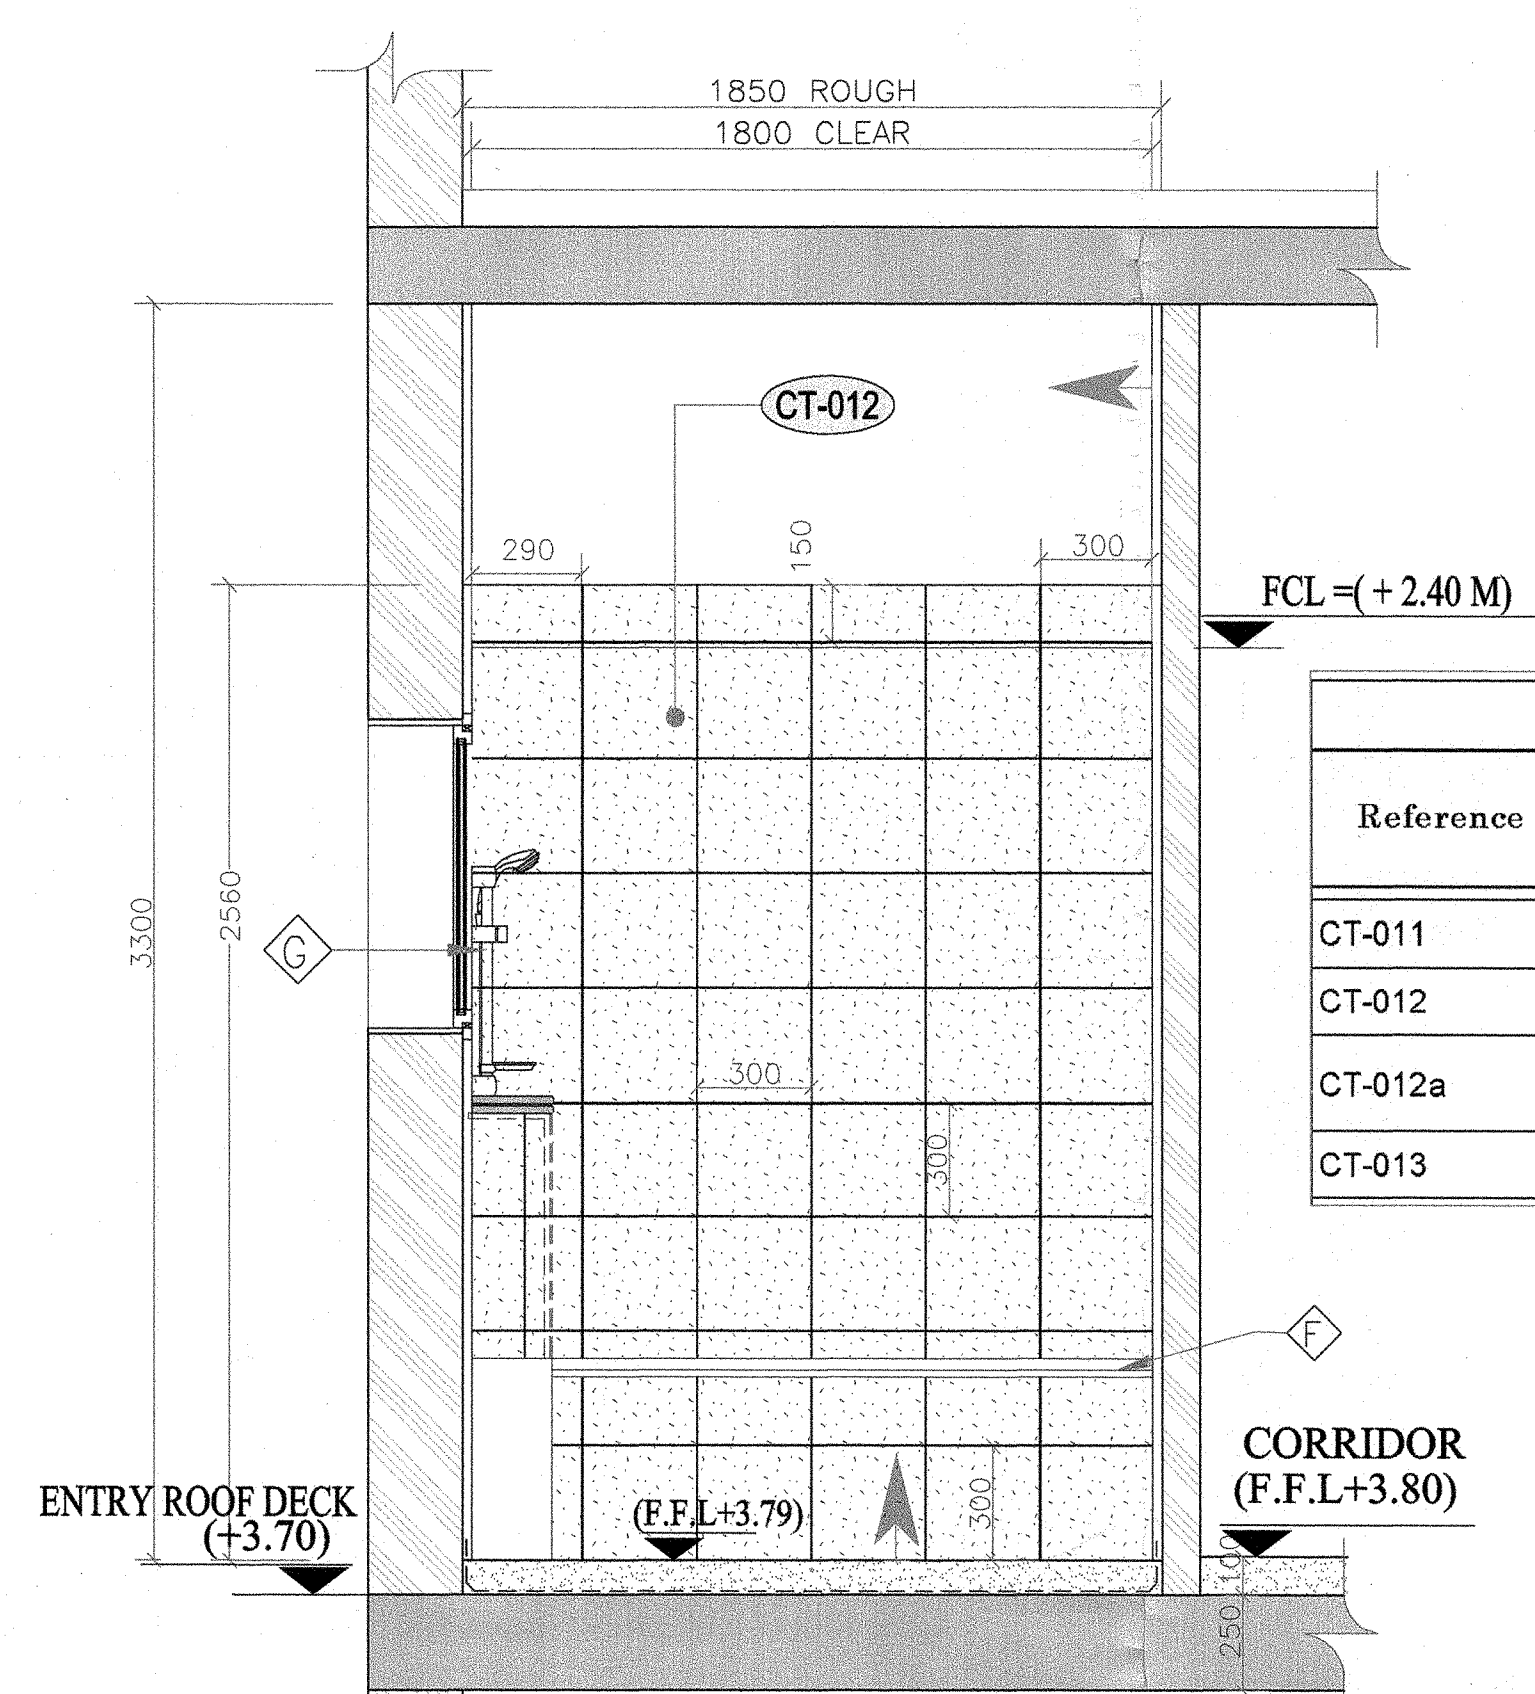


VIEW B

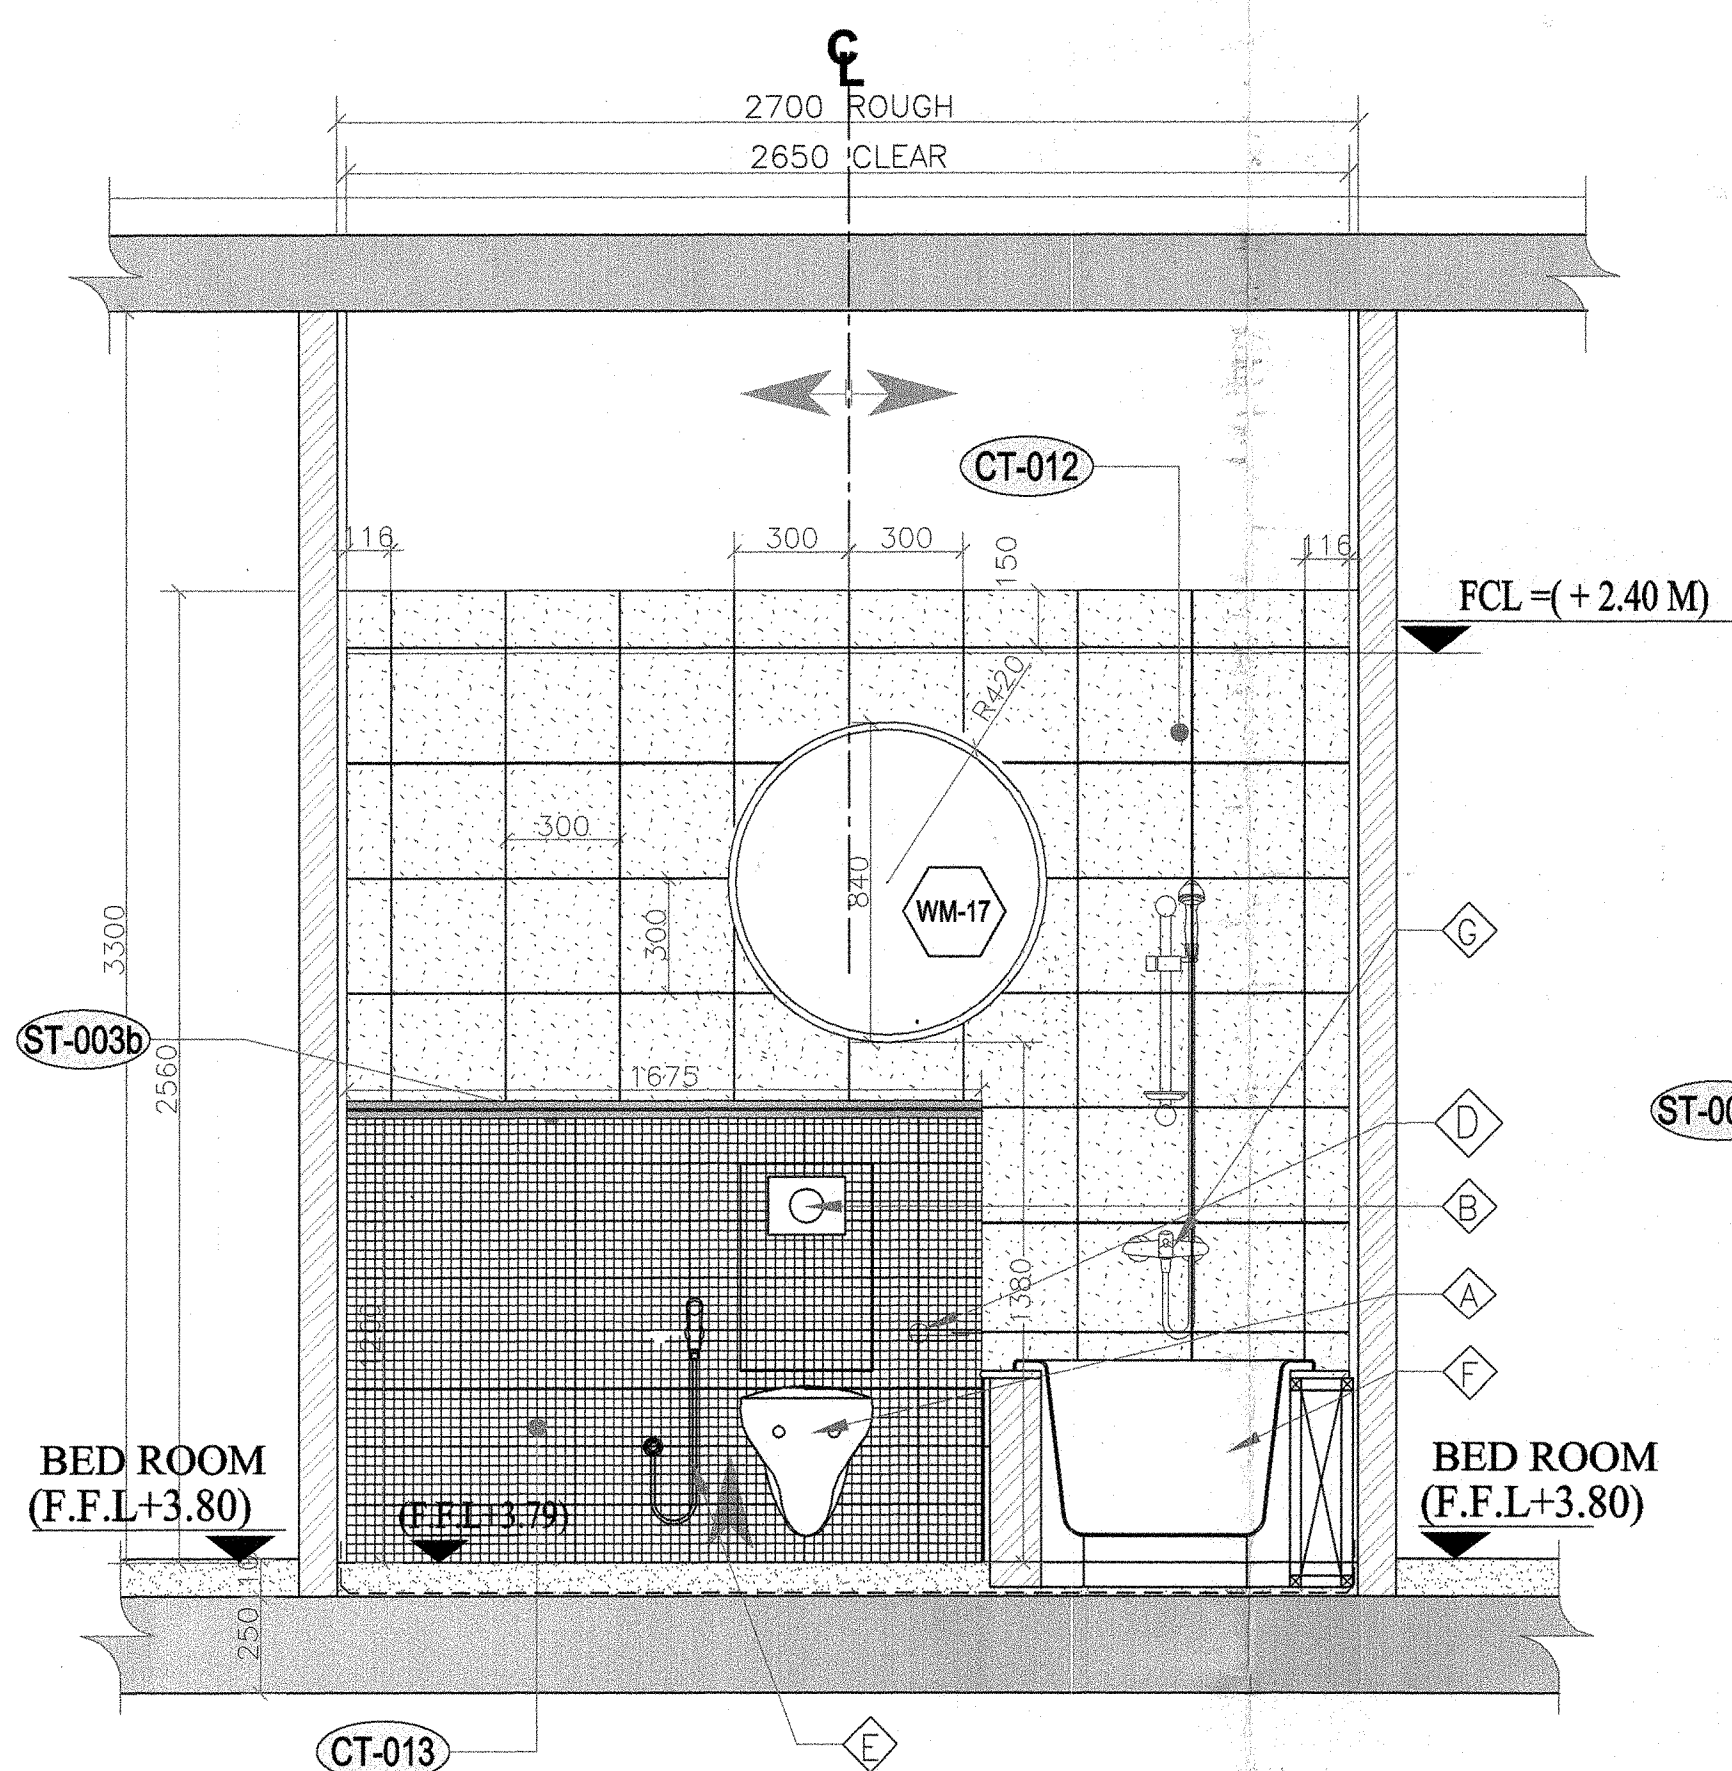


VIEW C

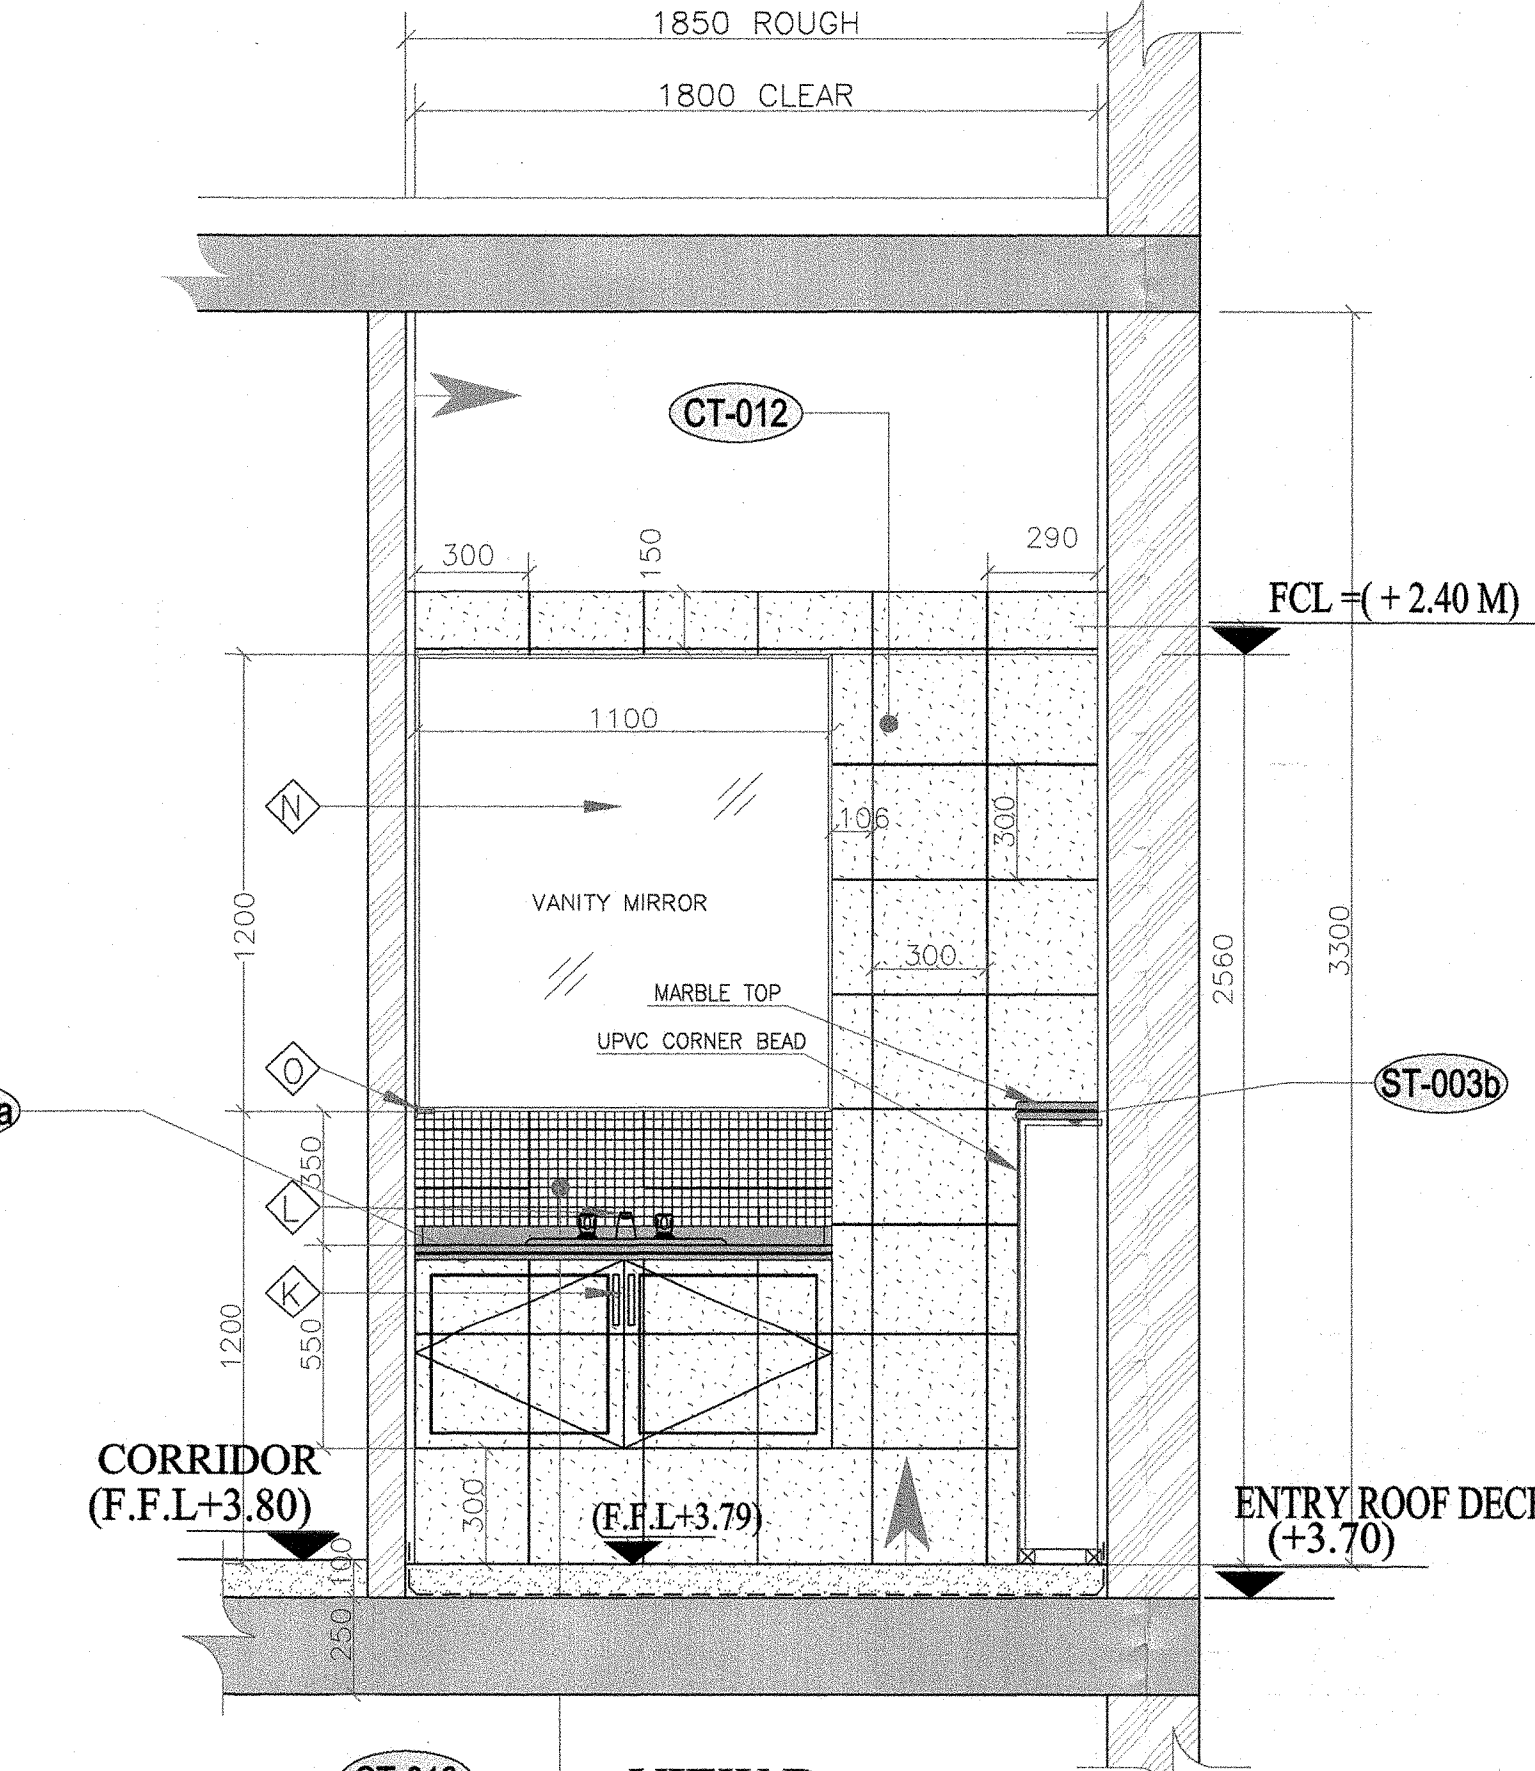

VIEW D

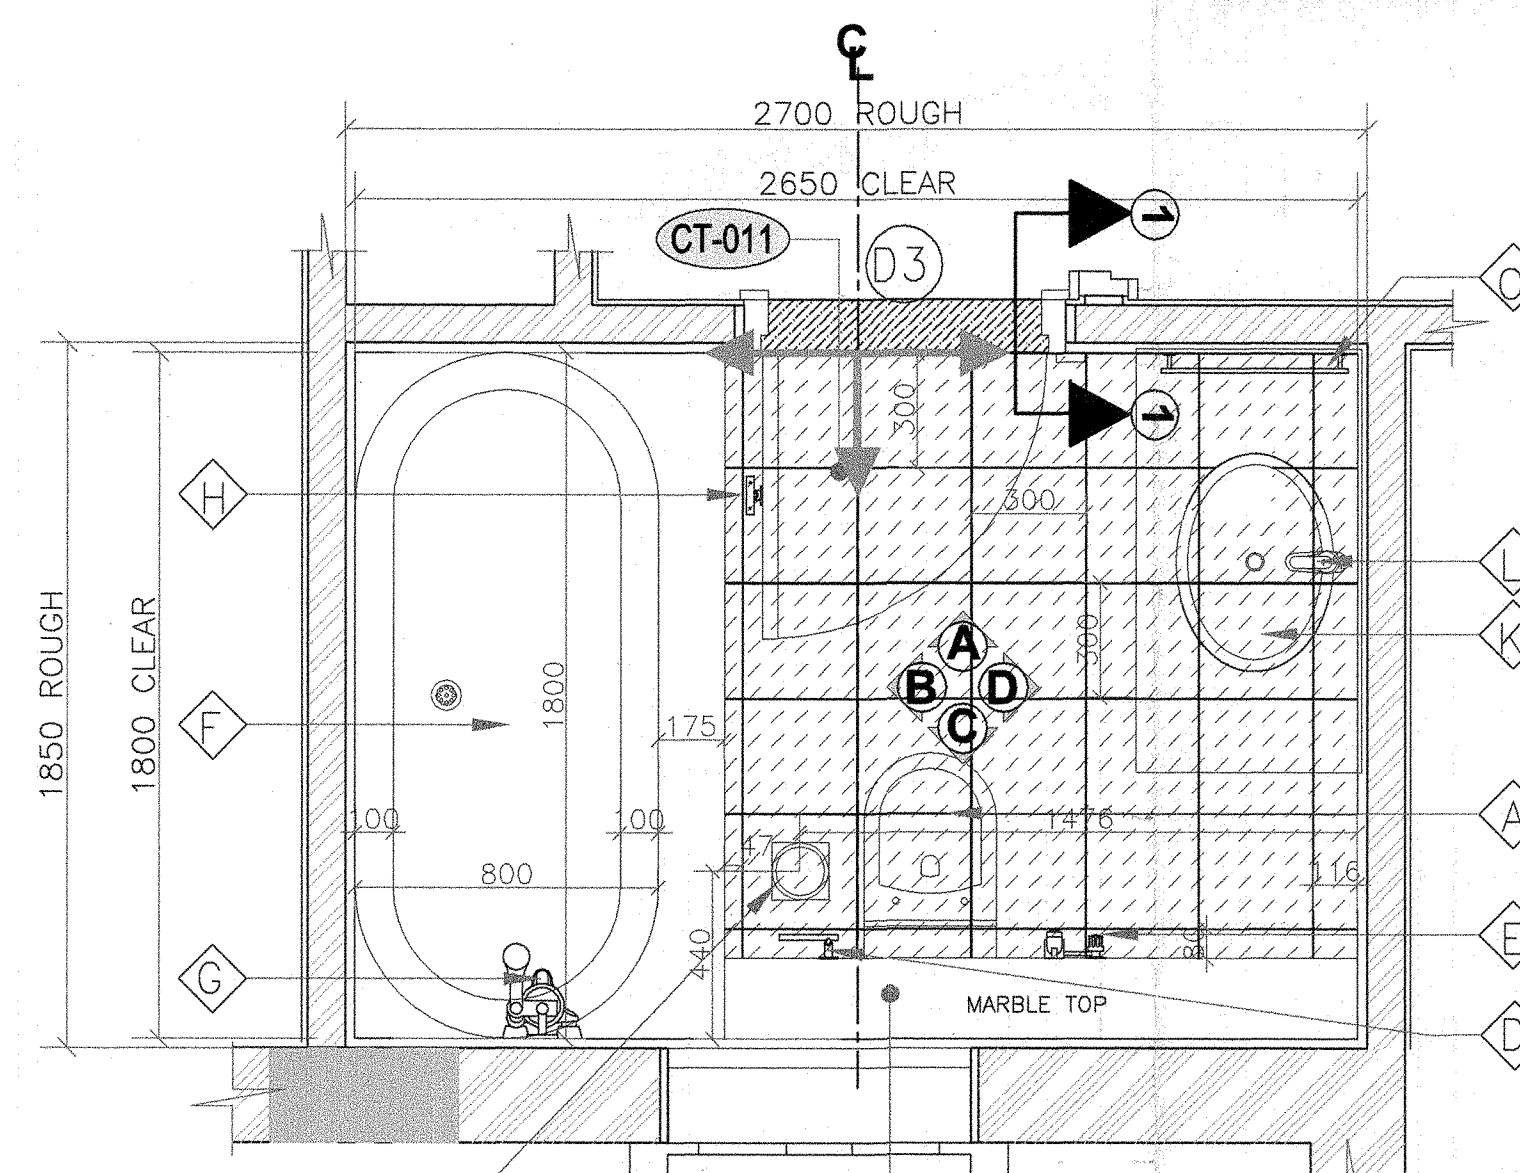


PLAN

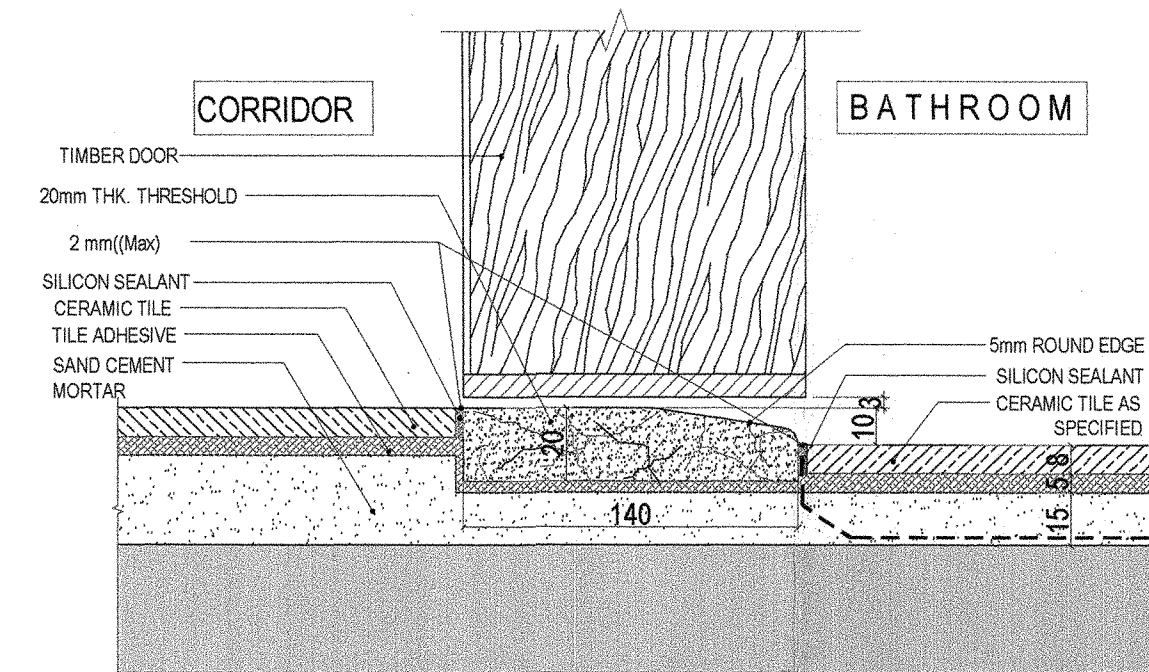

SECTION 1 - 1

Finishes Legend					
Reference	Traditional		Dimension (mm)	Application	Area
	Brand Name	Model			
CT-011	Pamesa	Tibet Marfil	300 x 300	Floors	General Bathroom 2, 3 & 4
CT-012	Pamesa	Ikorn Blanco	300 x 300	Walls	General Bathroom 2, 3 & 4
CT-012a			20 x 300	Wall corner & window surroundings	General Bathroom 2, 3 & 4
CT-013	Pamesa	Tibet Marfil	25 x 25	Wall Mosaic	General Bathroom 2, 3 & 4

Key plan

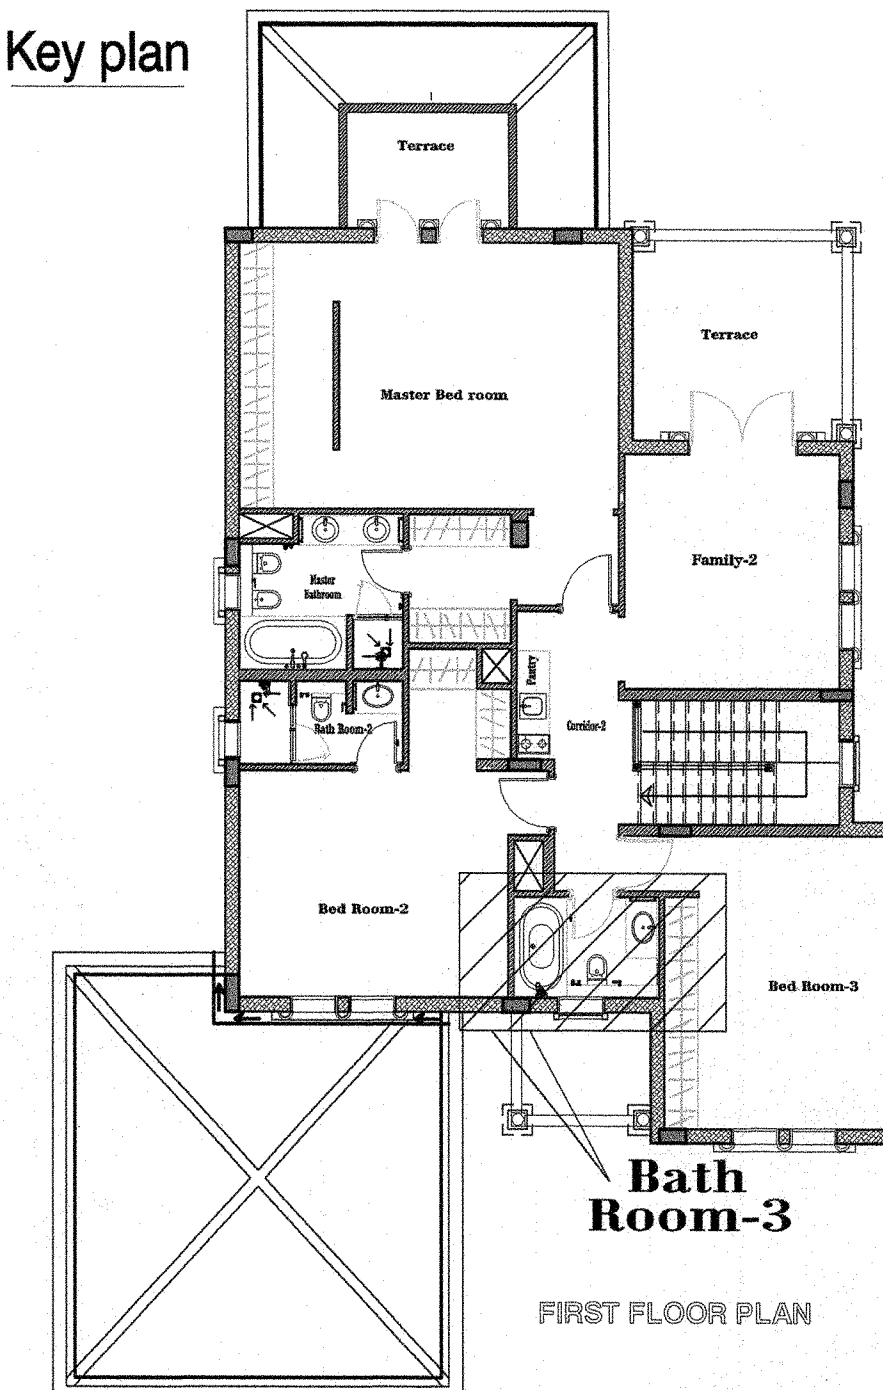

NOTE:

*ALL THE JOINTS BETWEEN CERAMICS ARE 2MM

* OPENING FOR WOODEN DOOR ARE ROUGH (BLOCK TO BLOCK)

* OPENING FOR ALUMINIUM DOORS & WINDOWS ARE CLEAR (PLASTER TO PLASTER)

▲ DIRECTION OF STARTING POINT

LEGEND FOR TOILET ACCESSORIES

- ⬢ A - W C
- ⬢ B - WC FLUSH BUTTON
- ⬢ C - TOILET ROLL HOLDER
- ⬢ D - ABLUTION SPRAY
- ⬢ E - BATH TUB
- ⬢ F - BATH TUB MIXER
- ⬢ G - WASH BASIN
- ⬢ H - WASH BASIN MIXER
- ⬢ I - VANITY MIRROR
- ⬢ J - TOWEL RAIL
- ⬢ K - ROBE HOOK (at door)
- ⬢ L - FLOOR TRAP
- ⬢ M - ELECTRICAL SOCKET

AS BUILT DRAWING

JUMAIRAH PARK



NAKHEEL



dar al-handasah
shair and partners

Pauling Middle East

PACKAGE - 2

LEGACY - TRADITIONAL
TILING (FLOOR & WALL)
BATH ROOM # 03 - IN FIRST FLOOR


Drawn: T.Murugan Review: Eng. Ziyad Checked: Eng.Ghassan Zeitouni

Scale: 1:20 Date: 24-12-2011

Drawing No. PME/JP/ AB /LEGACY TRADITIONAL / CT-008


CLUSTER # 3 (P2)
VILLA # 6

CT-008	Azulbur	JV 303	330 x 330	Floors	Master Bath & Powder Room
CT-009	Azulbur	JV 302	330 x 330	Walls	Master Bath & Powder Room
CT-009a			20 x 300	Wall corner & window surroundings	Master Bath & Powder Room
CT-010	Azulbur	JV 302	25 x 25	Wall Mosaic	Master Bath & Powder Room

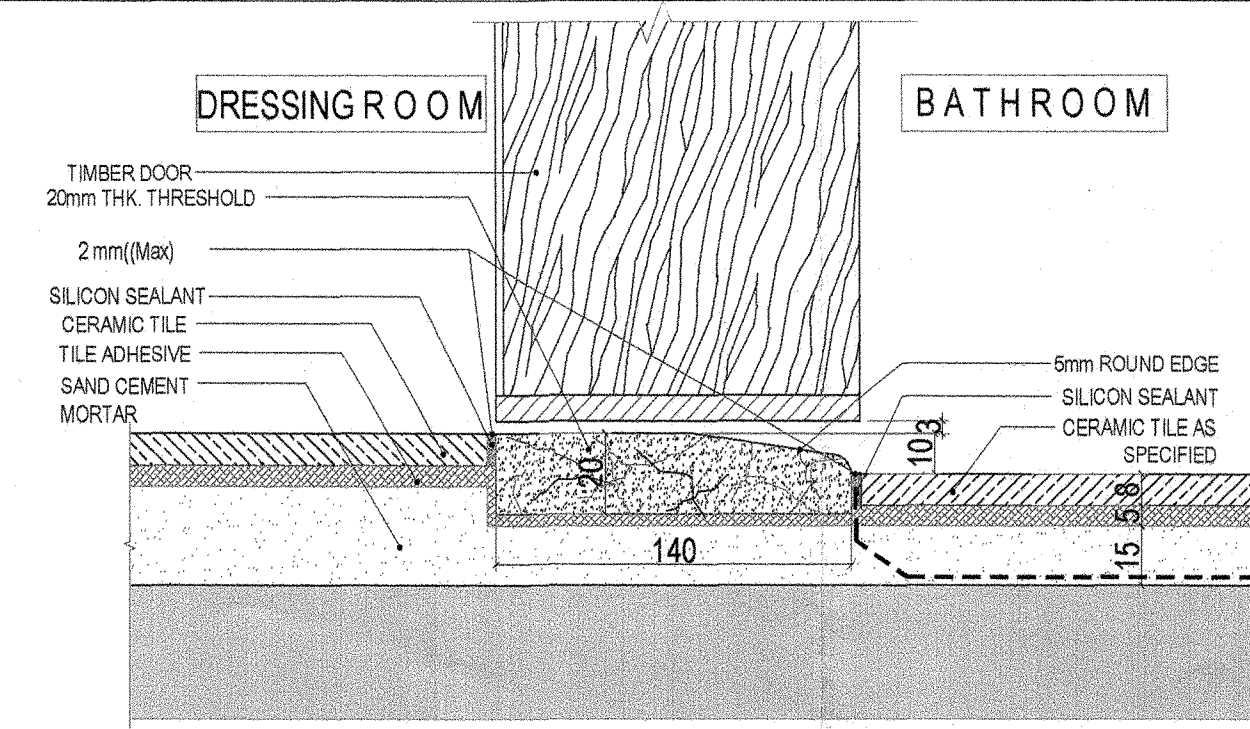

SECTION 1 - 1

Key plan

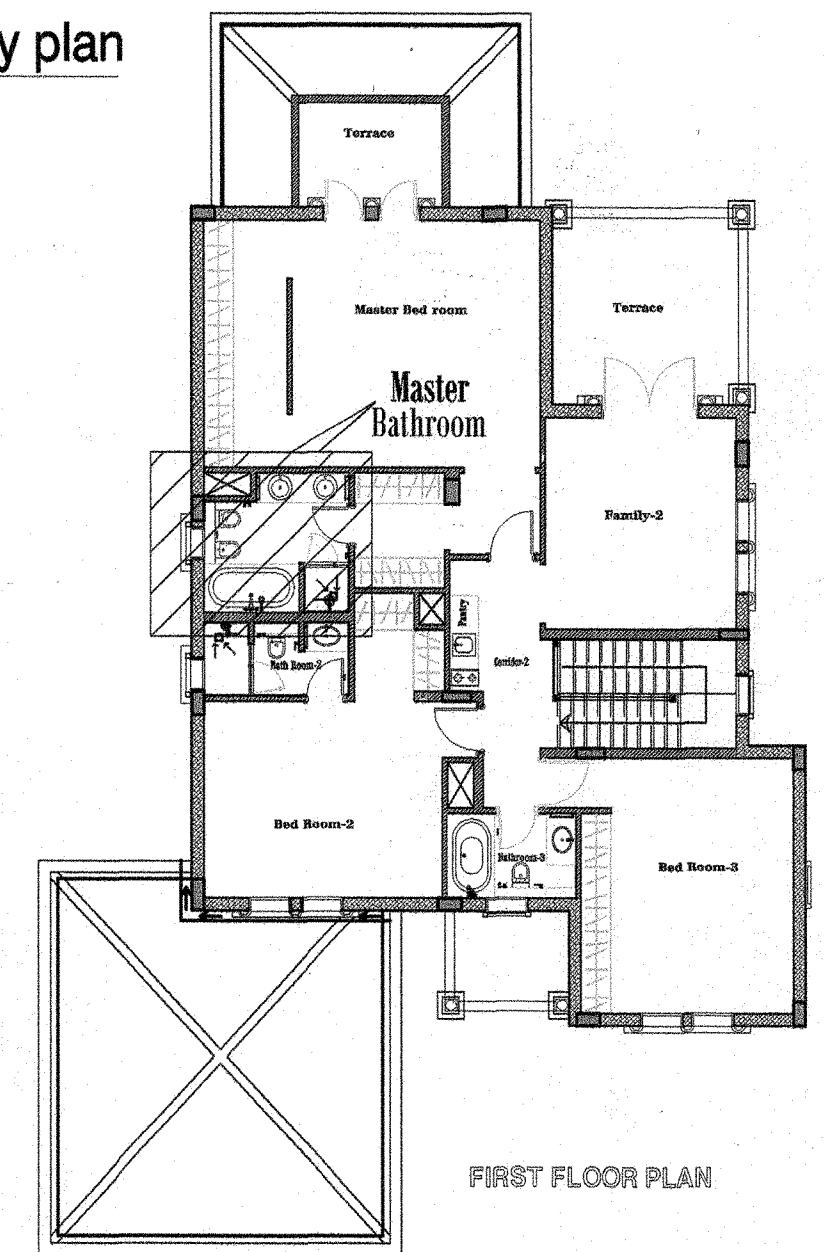

FIRST FLOOR PLAN

NOTE:

• ALL THE JOINTS BETWEEN CERAMICS ARE 2MM

• OPENING FOR WOODEN DOOR ARE ROUGH (BLOCK TO BLOCK)

• OPENING FOR ALUMINIUM DOORS & WINDOWS ARE CLEAR (PLASTER TO PLASTER)

DIRECTION OF STARTING POINT

LEGEND FOR TOILET ACCESSORIES

- ⬢ A WC
- ⬢ B WC FLUSH BUTTON
- ⬢ C BIDET
- ⬢ D TOILET ROLL HOLDER
- ⬢ E ABLUTION SPRAY
- ⬢ F BATH TUB
- ⬢ G BATH TUB MIXER
- ⬢ H MIRROR LIGHT
- ⬢ J RAIN SHOWER
- ⬢ K WASH BASIN
- ⬢ L WASH BASIN MIXER
- ⬢ M VANITY MIRROR
- ⬢ O TOWEL RAIL
- ⬢ S FLOOR TRAP
- ⬢ SS ELECTRICAL SOCKET
- ⬢ HC HOT&COLD ANGLE VALVE

dar al-handasah
Shair and Partners

CODE 1 APPROVED

CODE 2 APPROVED AS NOTED
WORK MAY PROCEED SUBJECT TO
INCORPORATION OF ENDORSED
COMMENTS

CODE 3 REQUEST FOR APPROVAL
WORK MAY NOT PROCEED

CODE 4 REJECTED

BY: DATE:

Approval shall not relieve the contractor of any of its
obligations under the Contract or constitute authorization
of any change in the design, documents or variation to the
Contract. The Contractor shall coordinate with the
coordination with other trades.



AS BUILT DRAWING

Project

JUMAIRAH PARK




NAKHEEL

Employer



dar al-handasah
shair and partners

Consultant

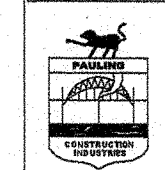

Pauling Middle East

Main Contractor

PACKAGE - 2

Package

LEGACY - TRADITIONAL
TILING (FLOOR & WALL)

Drawing Title

MASTER BATH ROOM - IN FIRST FLOOR

Drawn: T. Murugan Review: Eng. Ziad Checked: Eng. Ghassan Zeitouni

Scale: 1:20 Date: 28-04-2012

Drawing No. PME/JP/ AB / LEGACY TRADITIONAL / CT-009