


Finishes Legend					
Reference	Traditional		Dimension (mm)	Application	Area
	Brand Name	Model			
CT-001	Pamesa	Saturani Beige	300 x 300	Walls	Kitchen
CT-001a	Pamesa	Alfa Beige	450 x 450	Floors	Kitchen
CT-003	Pamesa	Saturani Beige	50 x 50	Splash Back and Breakfast bar Mosaic	Kitchen & Pantry

KEY PLAN

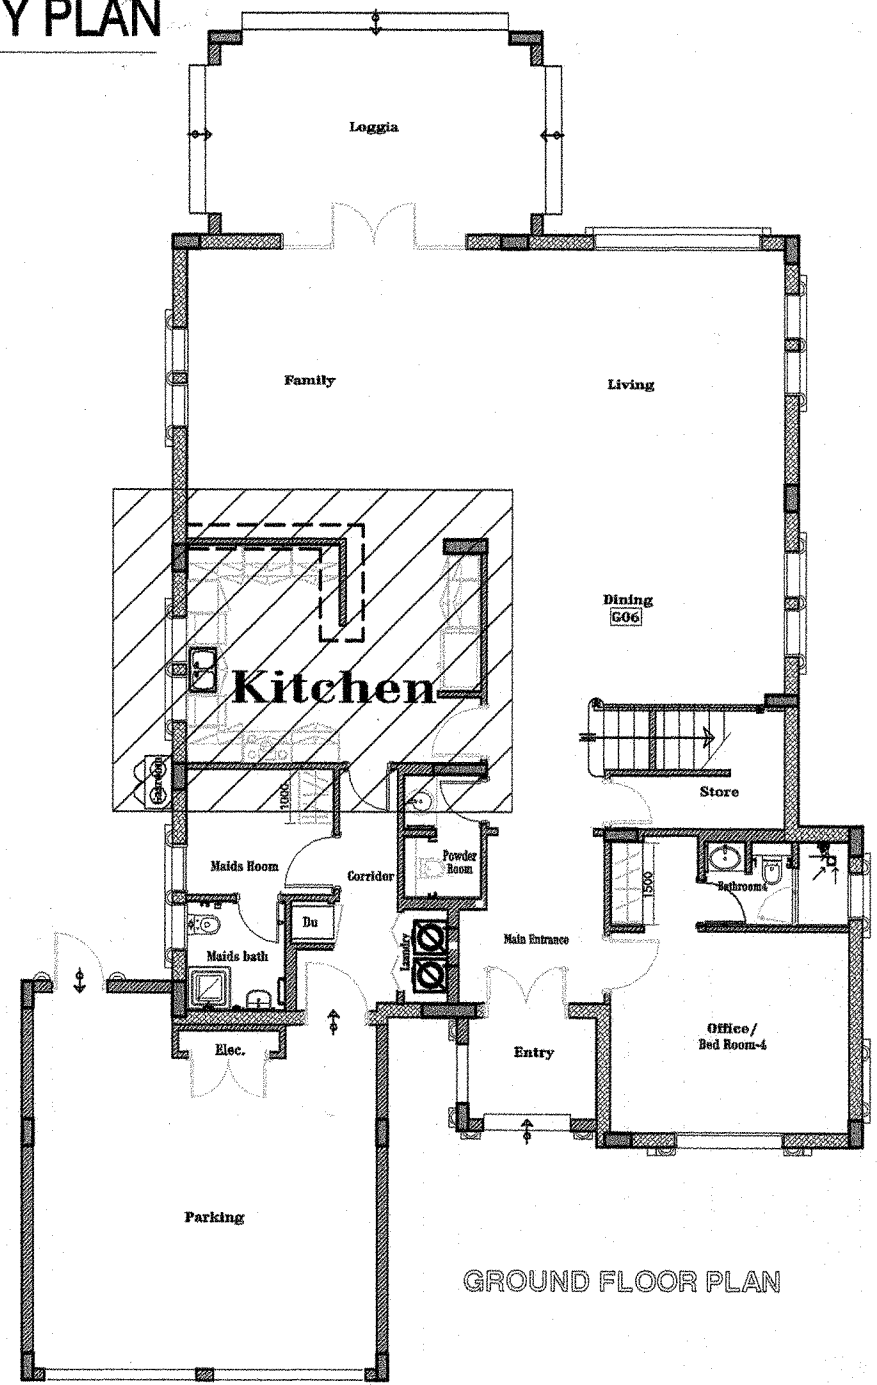

NOTE:
** JOINTS BETWEEN CERAMICS ARE 3 MM FOR FLOOR TILES
** JOINTS BETWEEN CERAMICS ARE 2 MM FOR WALL TILES
* OPENING FOR WOODEN DOOR ARE ROUGH (BLOCK TO BLOCK)
* OPENING FOR ALUMINIUM DOORS & WINDOWS ARE CLEAR (PLASTER TO PLASTER)
➔ DIRECTION OF STARTING POINT

LEGEND:-

SYMBOL	DESCRIPTION	MOUNTING HEIGHTS(mm)
D ₁	13A SINGLE SWITCH SOCKET FOR HOOD FAN	1100mm FROM F.F.L.
D ₂	13A TWIN SWITCH SOCKET	1200mm FROM F.F.L.
H1	HEIGHT OF SOCKET	1200mm FROM F.F.L.
H2	HEIGHT OF SOCKET	1200mm FROM F.F.L.
H3	HEIGHT OF SOCKET	1200mm FROM F.F.L.
D ₃	20A DP SWITCH WITH INDICATOR FOR W/H	1200mm FROM F.F.L.
D ₄	DOUBLE POLE SWITCH WITH INDICATOR FOR W/H	1200mm FROM F.F.L.
D ₅	OUTLET FOR ELECTRIC COOKER-45A, TYPE S20	1200mm FROM F.F.L.
D ₆	ONE-WAY SWITCHES	1200mm FROM F.F.L.
D ₇	ONE-WAY/TWO GANG SWITCHES	1200mm FROM F.F.L.
D ₈	TWO-WAY SWITCHES	1200mm FROM F.F.L.
D ₉	TWO-WAY/TWO GANG SWITCHES	1200mm FROM F.F.L.
D ₁₀	RJ45 OUTLET FOR VOICE	450mm FROM F.F.L.
D ₁₁	RJ45 OUTLET FOR DATA	ABOVE COUNTER
D ₁₂	RJ45 OUTLET FOR CATV	ABOVE COUNTER
D ₁₃	CWS OUTLET FOR DISH WASHER	600mm FROM F.F.L.
D ₁₄	HWS OUTLET FOR DISH WASHER	600mm FROM F.F.L.
D ₁₅	CWS OUTLET FOR SINK	600mm FROM F.F.L.
D ₁₆	HWS OUTLET FOR SINK	600mm FROM F.F.L.
D ₁₇	THERMOSTAT ELECTRIC	1200mm FROM F.F.L.

AS BUILT DRAWING

JUMAIRAH PARK



NAKHEEL



sheikh and partners







Pauling Middle East

PACKAGE - 2








LEGACY-TRADITIONAL
TILING (FLOOR & WALL) IN KITCHEN
(As per mock up villa) (Sheet No. 1 of 2)

Drawn	T.Murugan	Review	Eng. Ziyad	Checked:	Eng.Ghassan Zeitouni
Scale:	1:25	Date:	24-12-2011		


Drawing No. PME / JP / AB /LEGACY TRADITIONAL / CT- 03

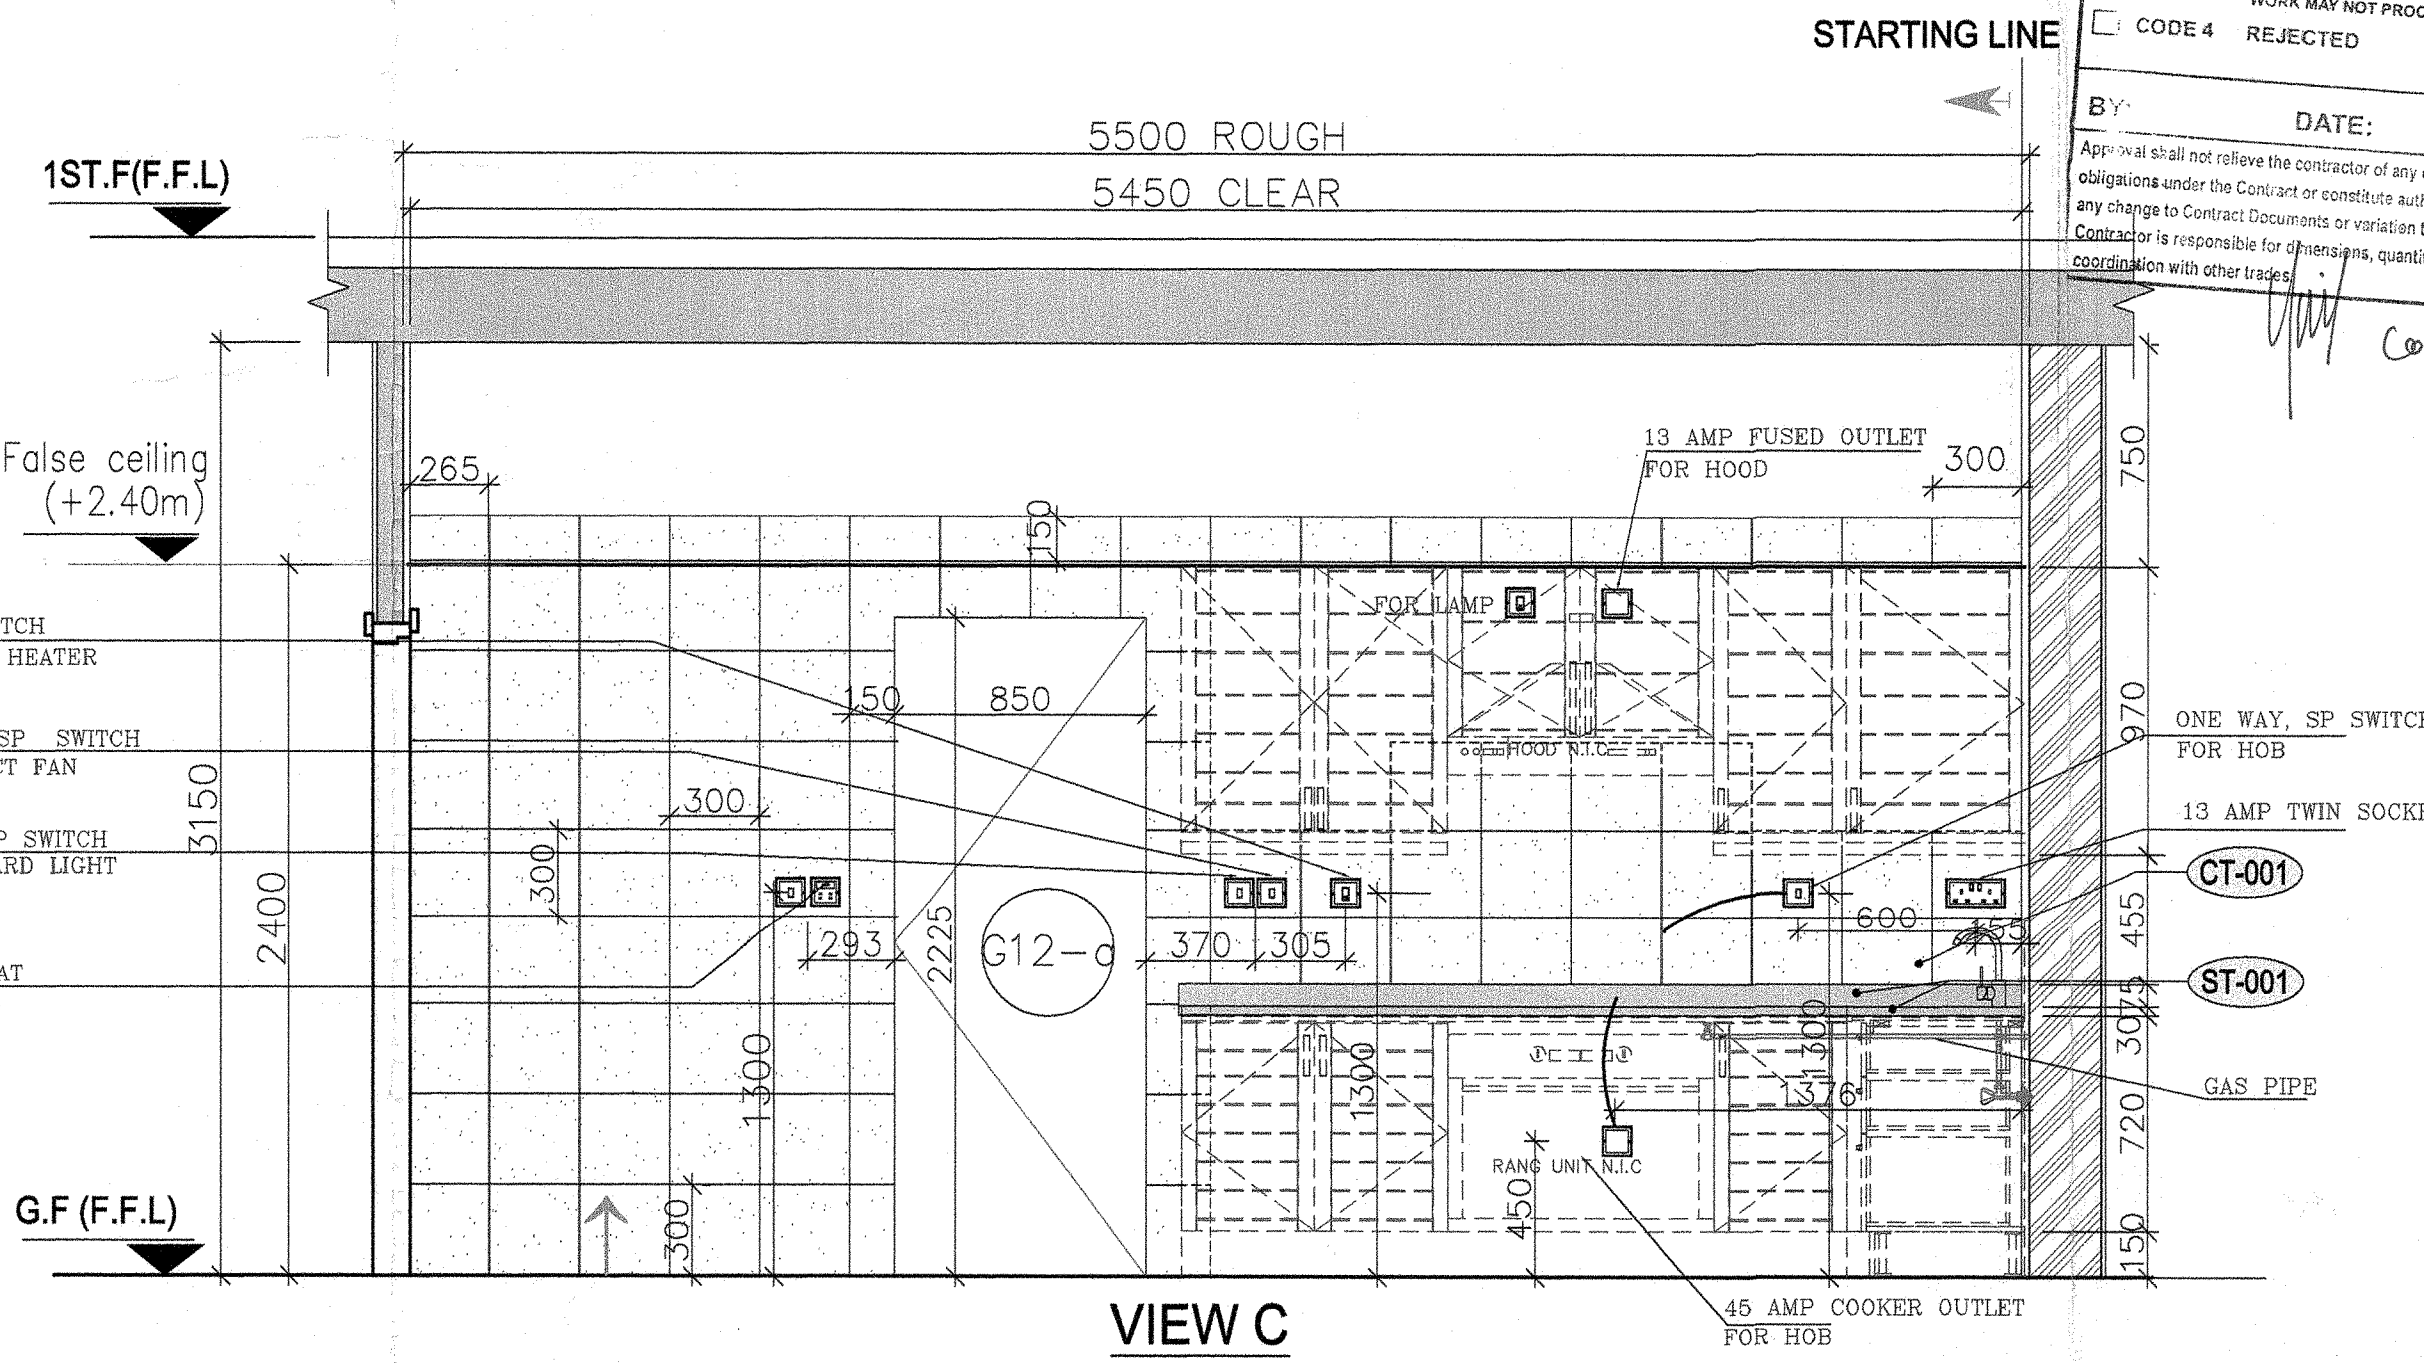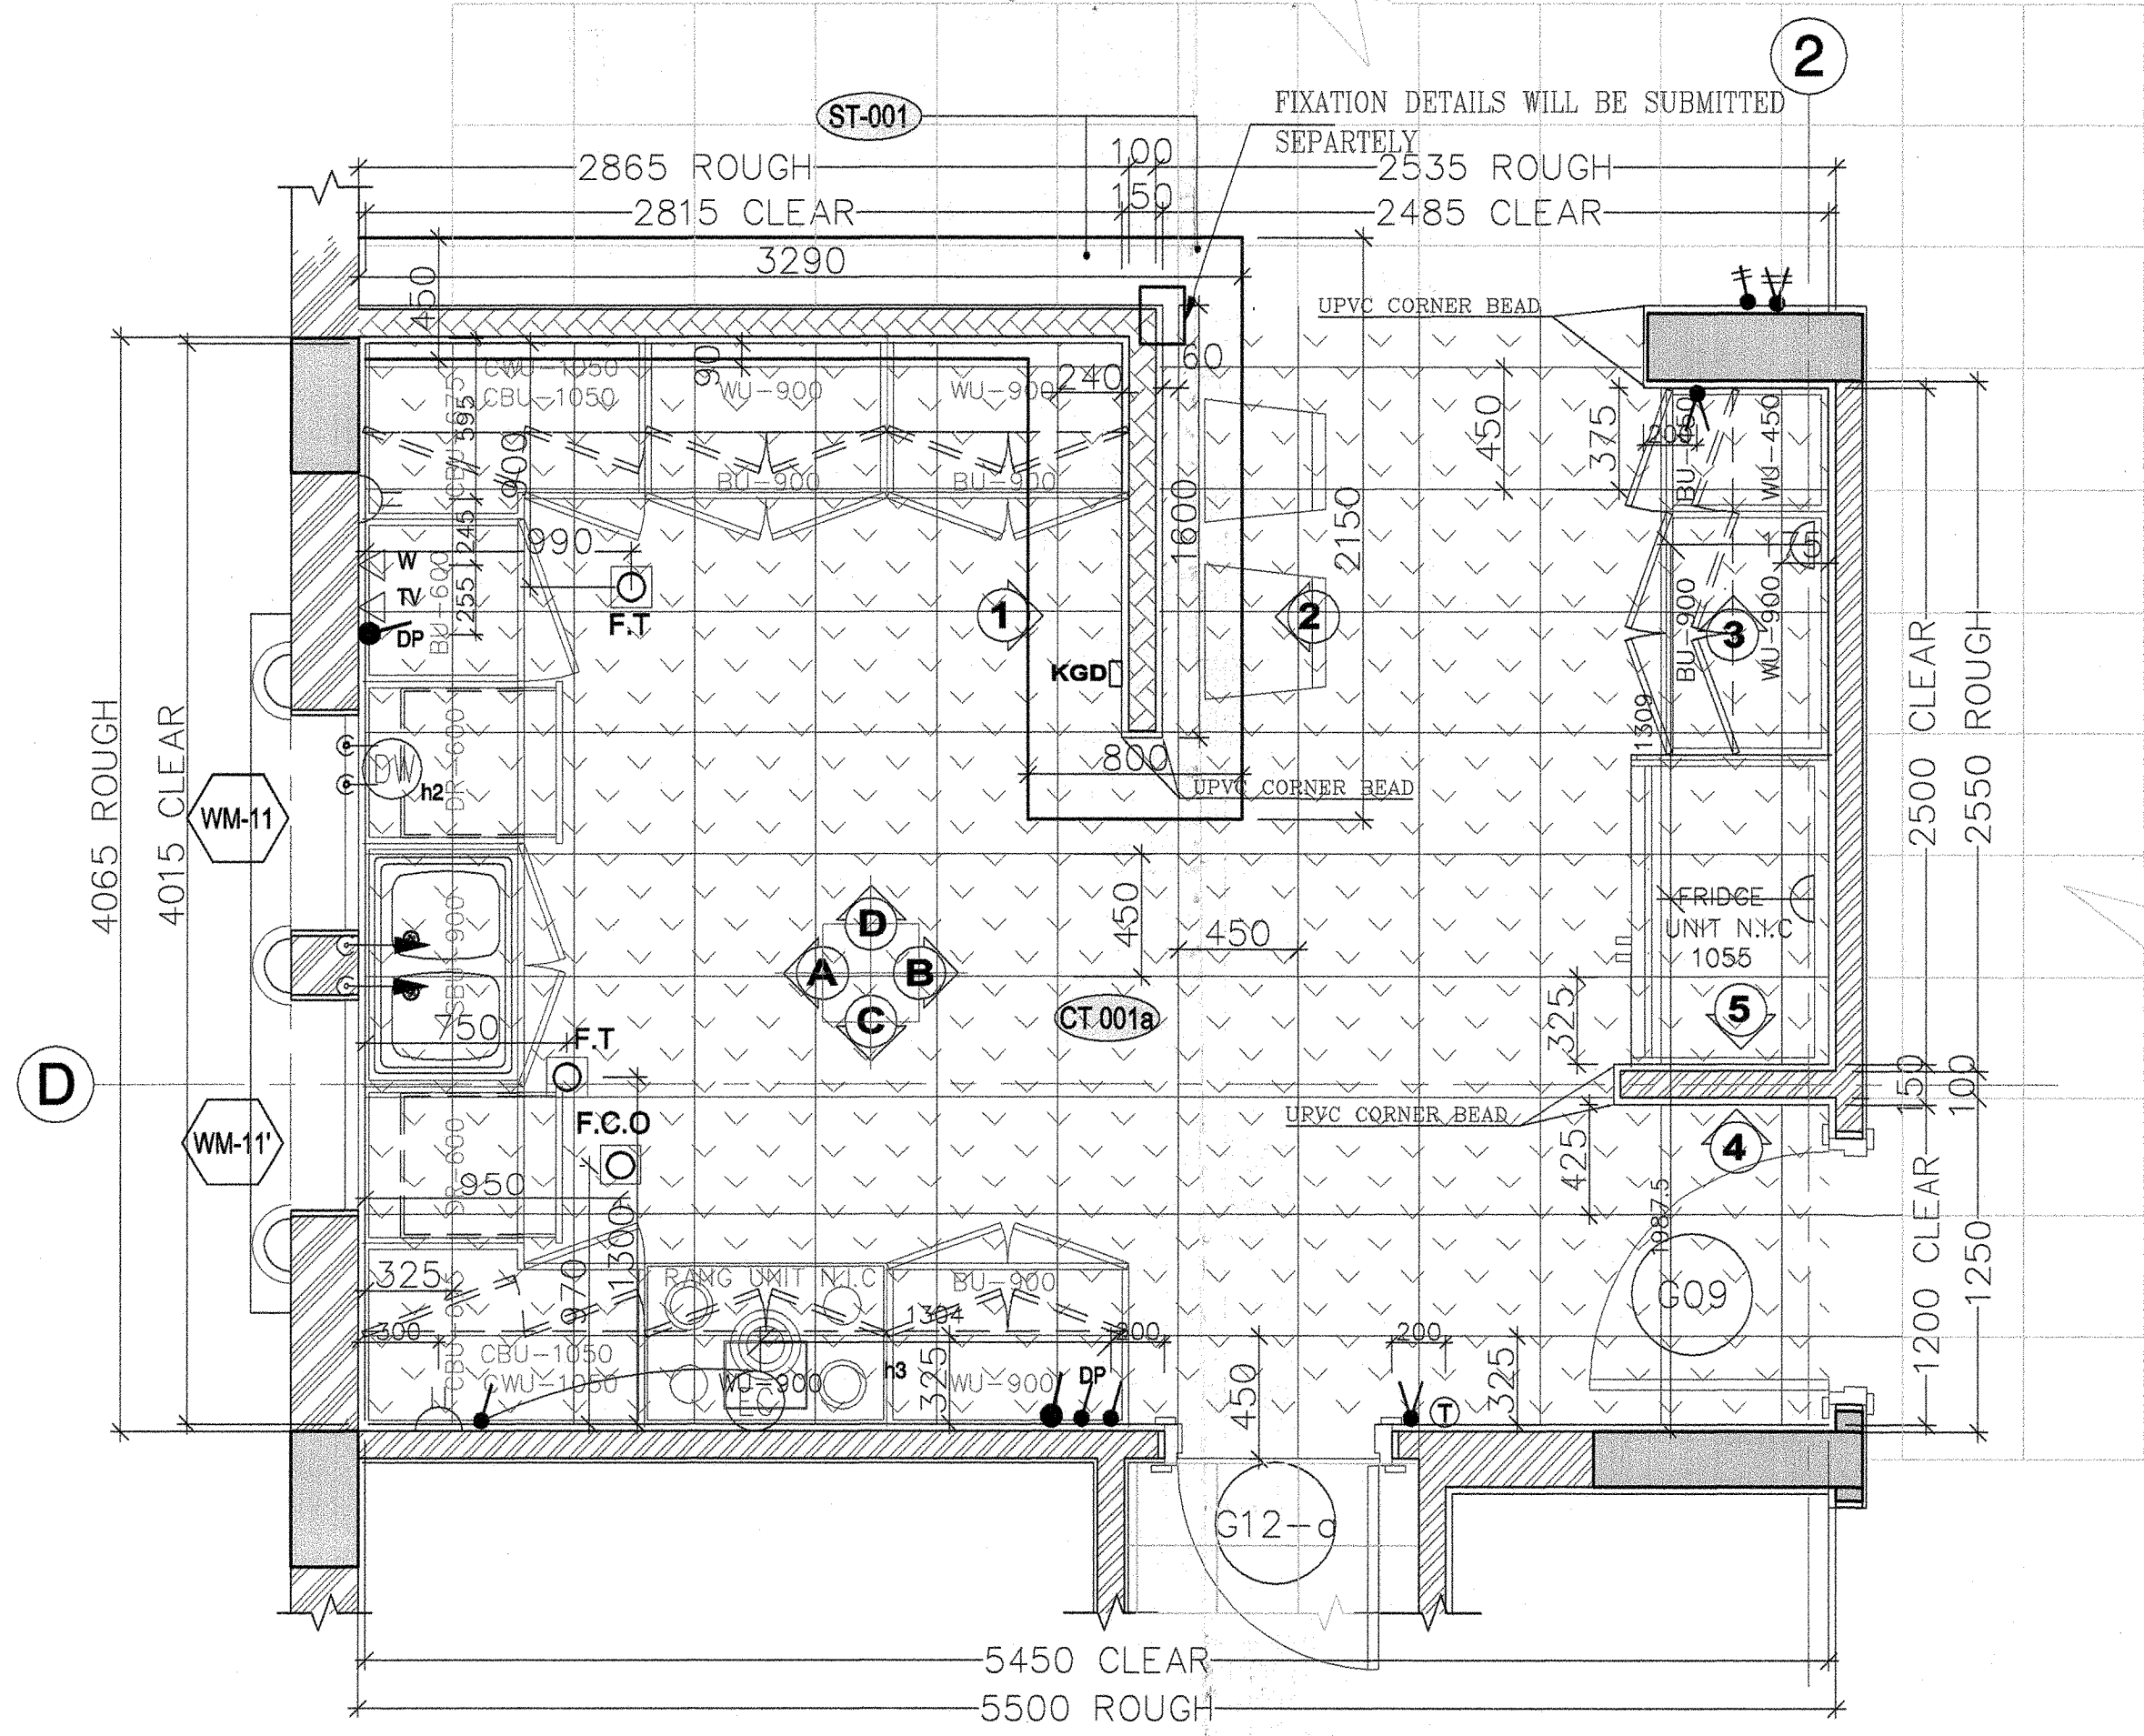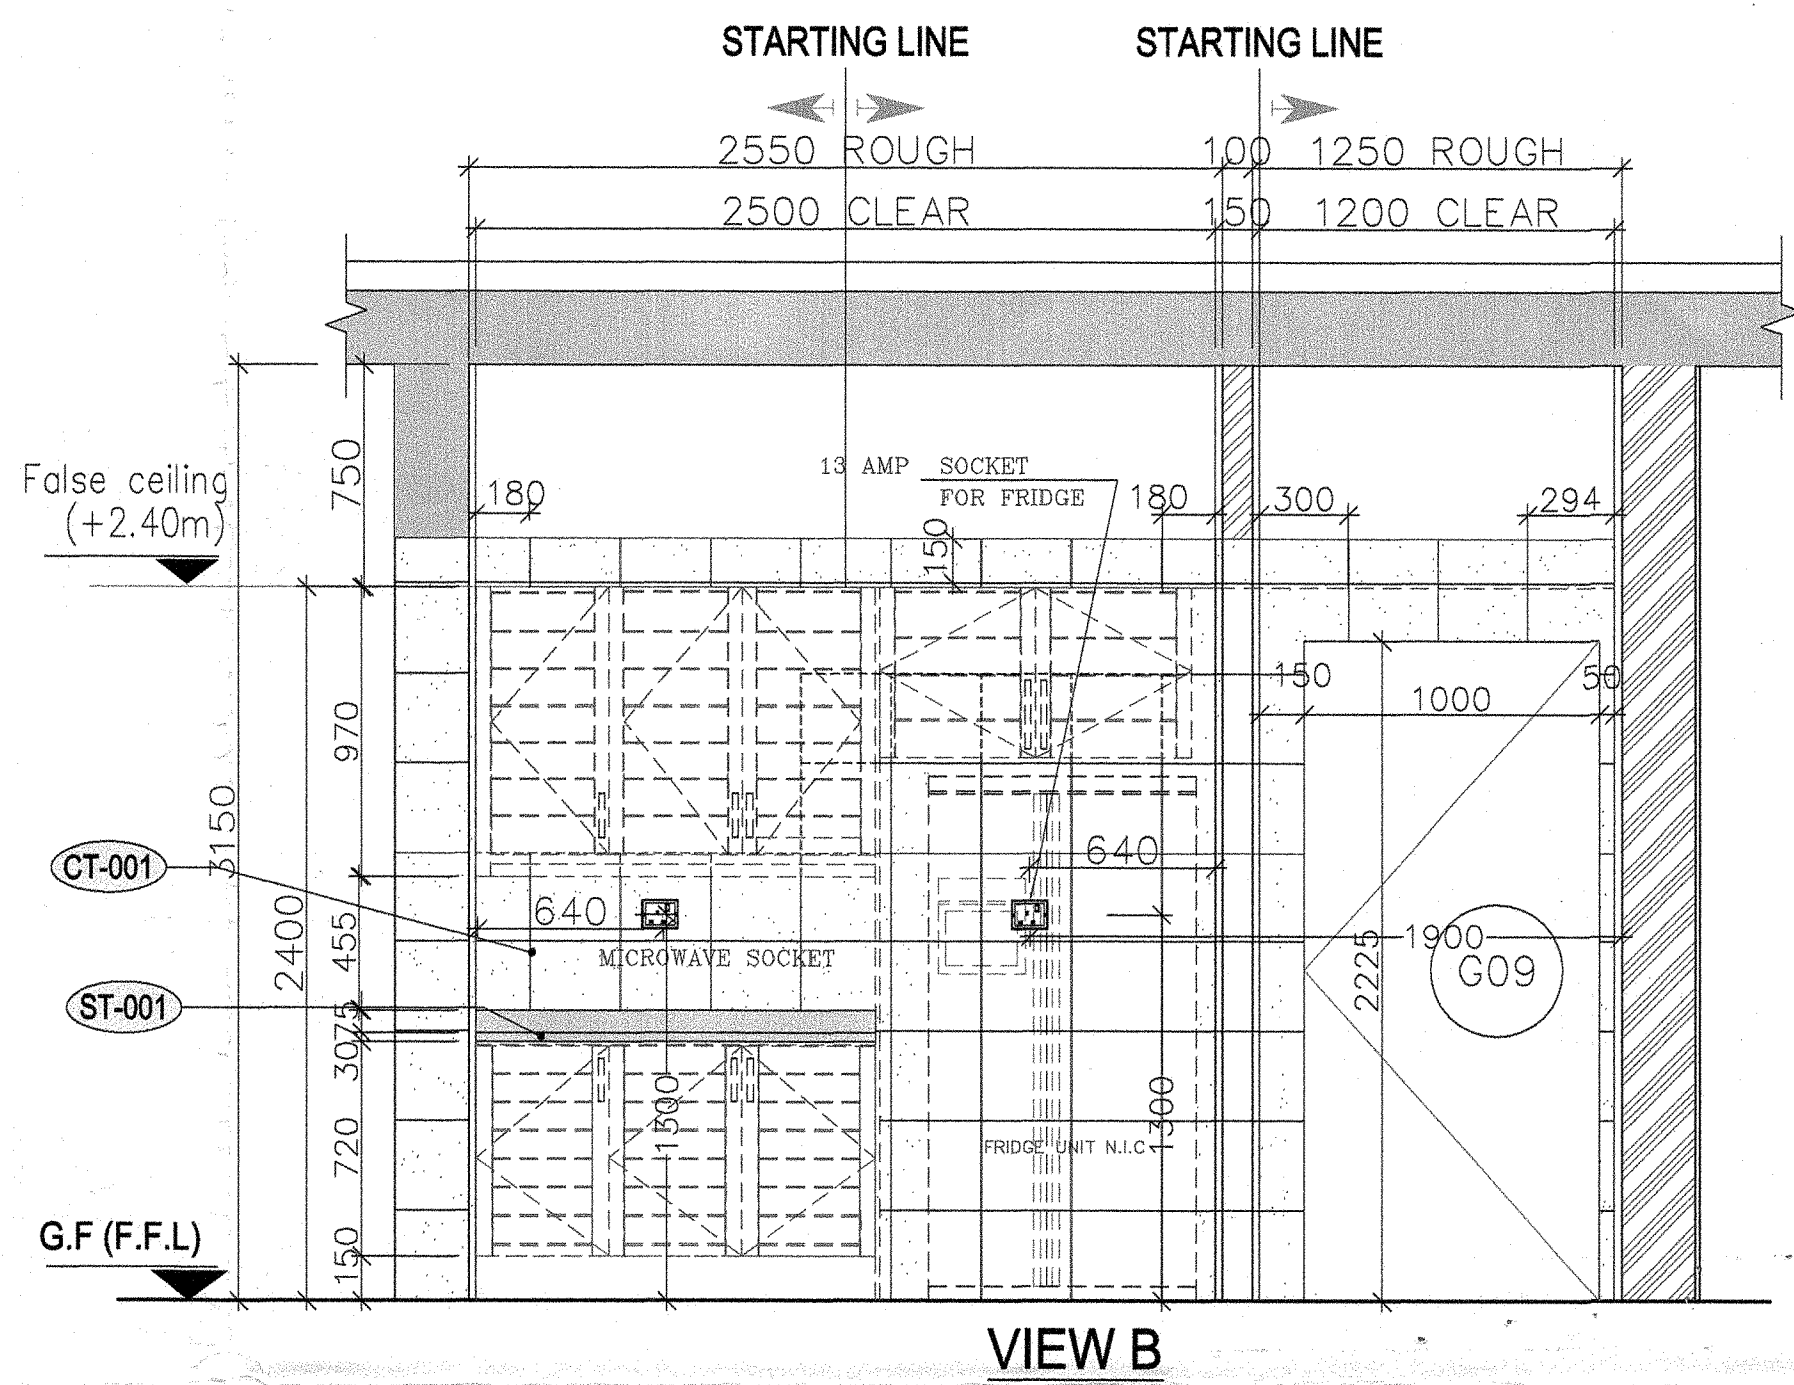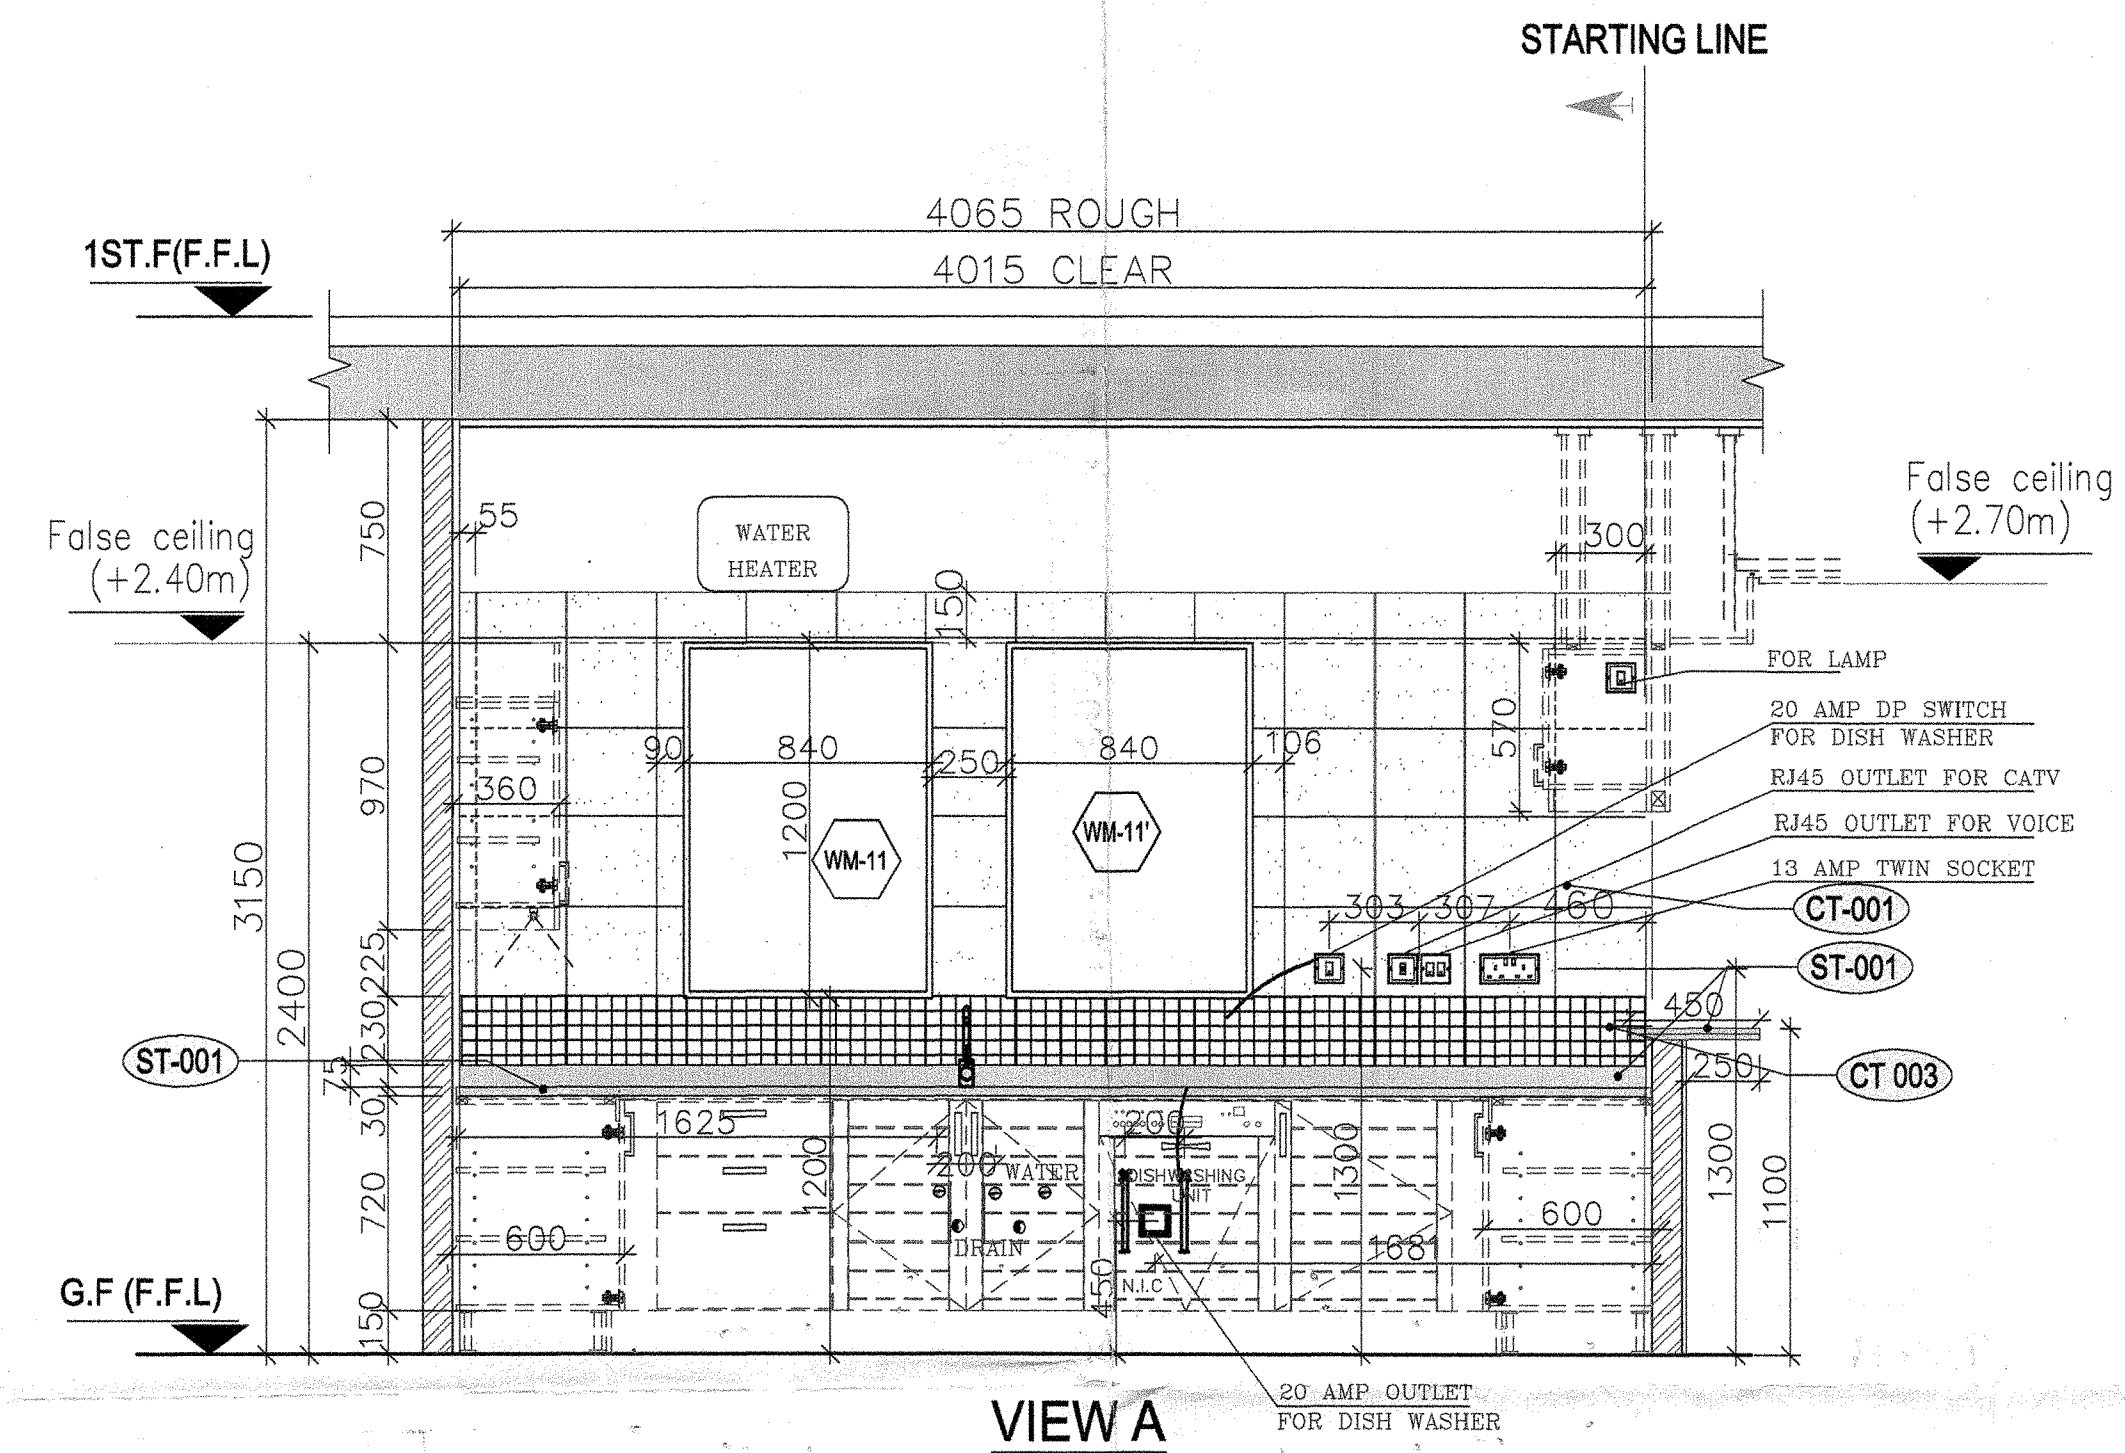

CLUSTER # 8 (P2)
VILLA # 49

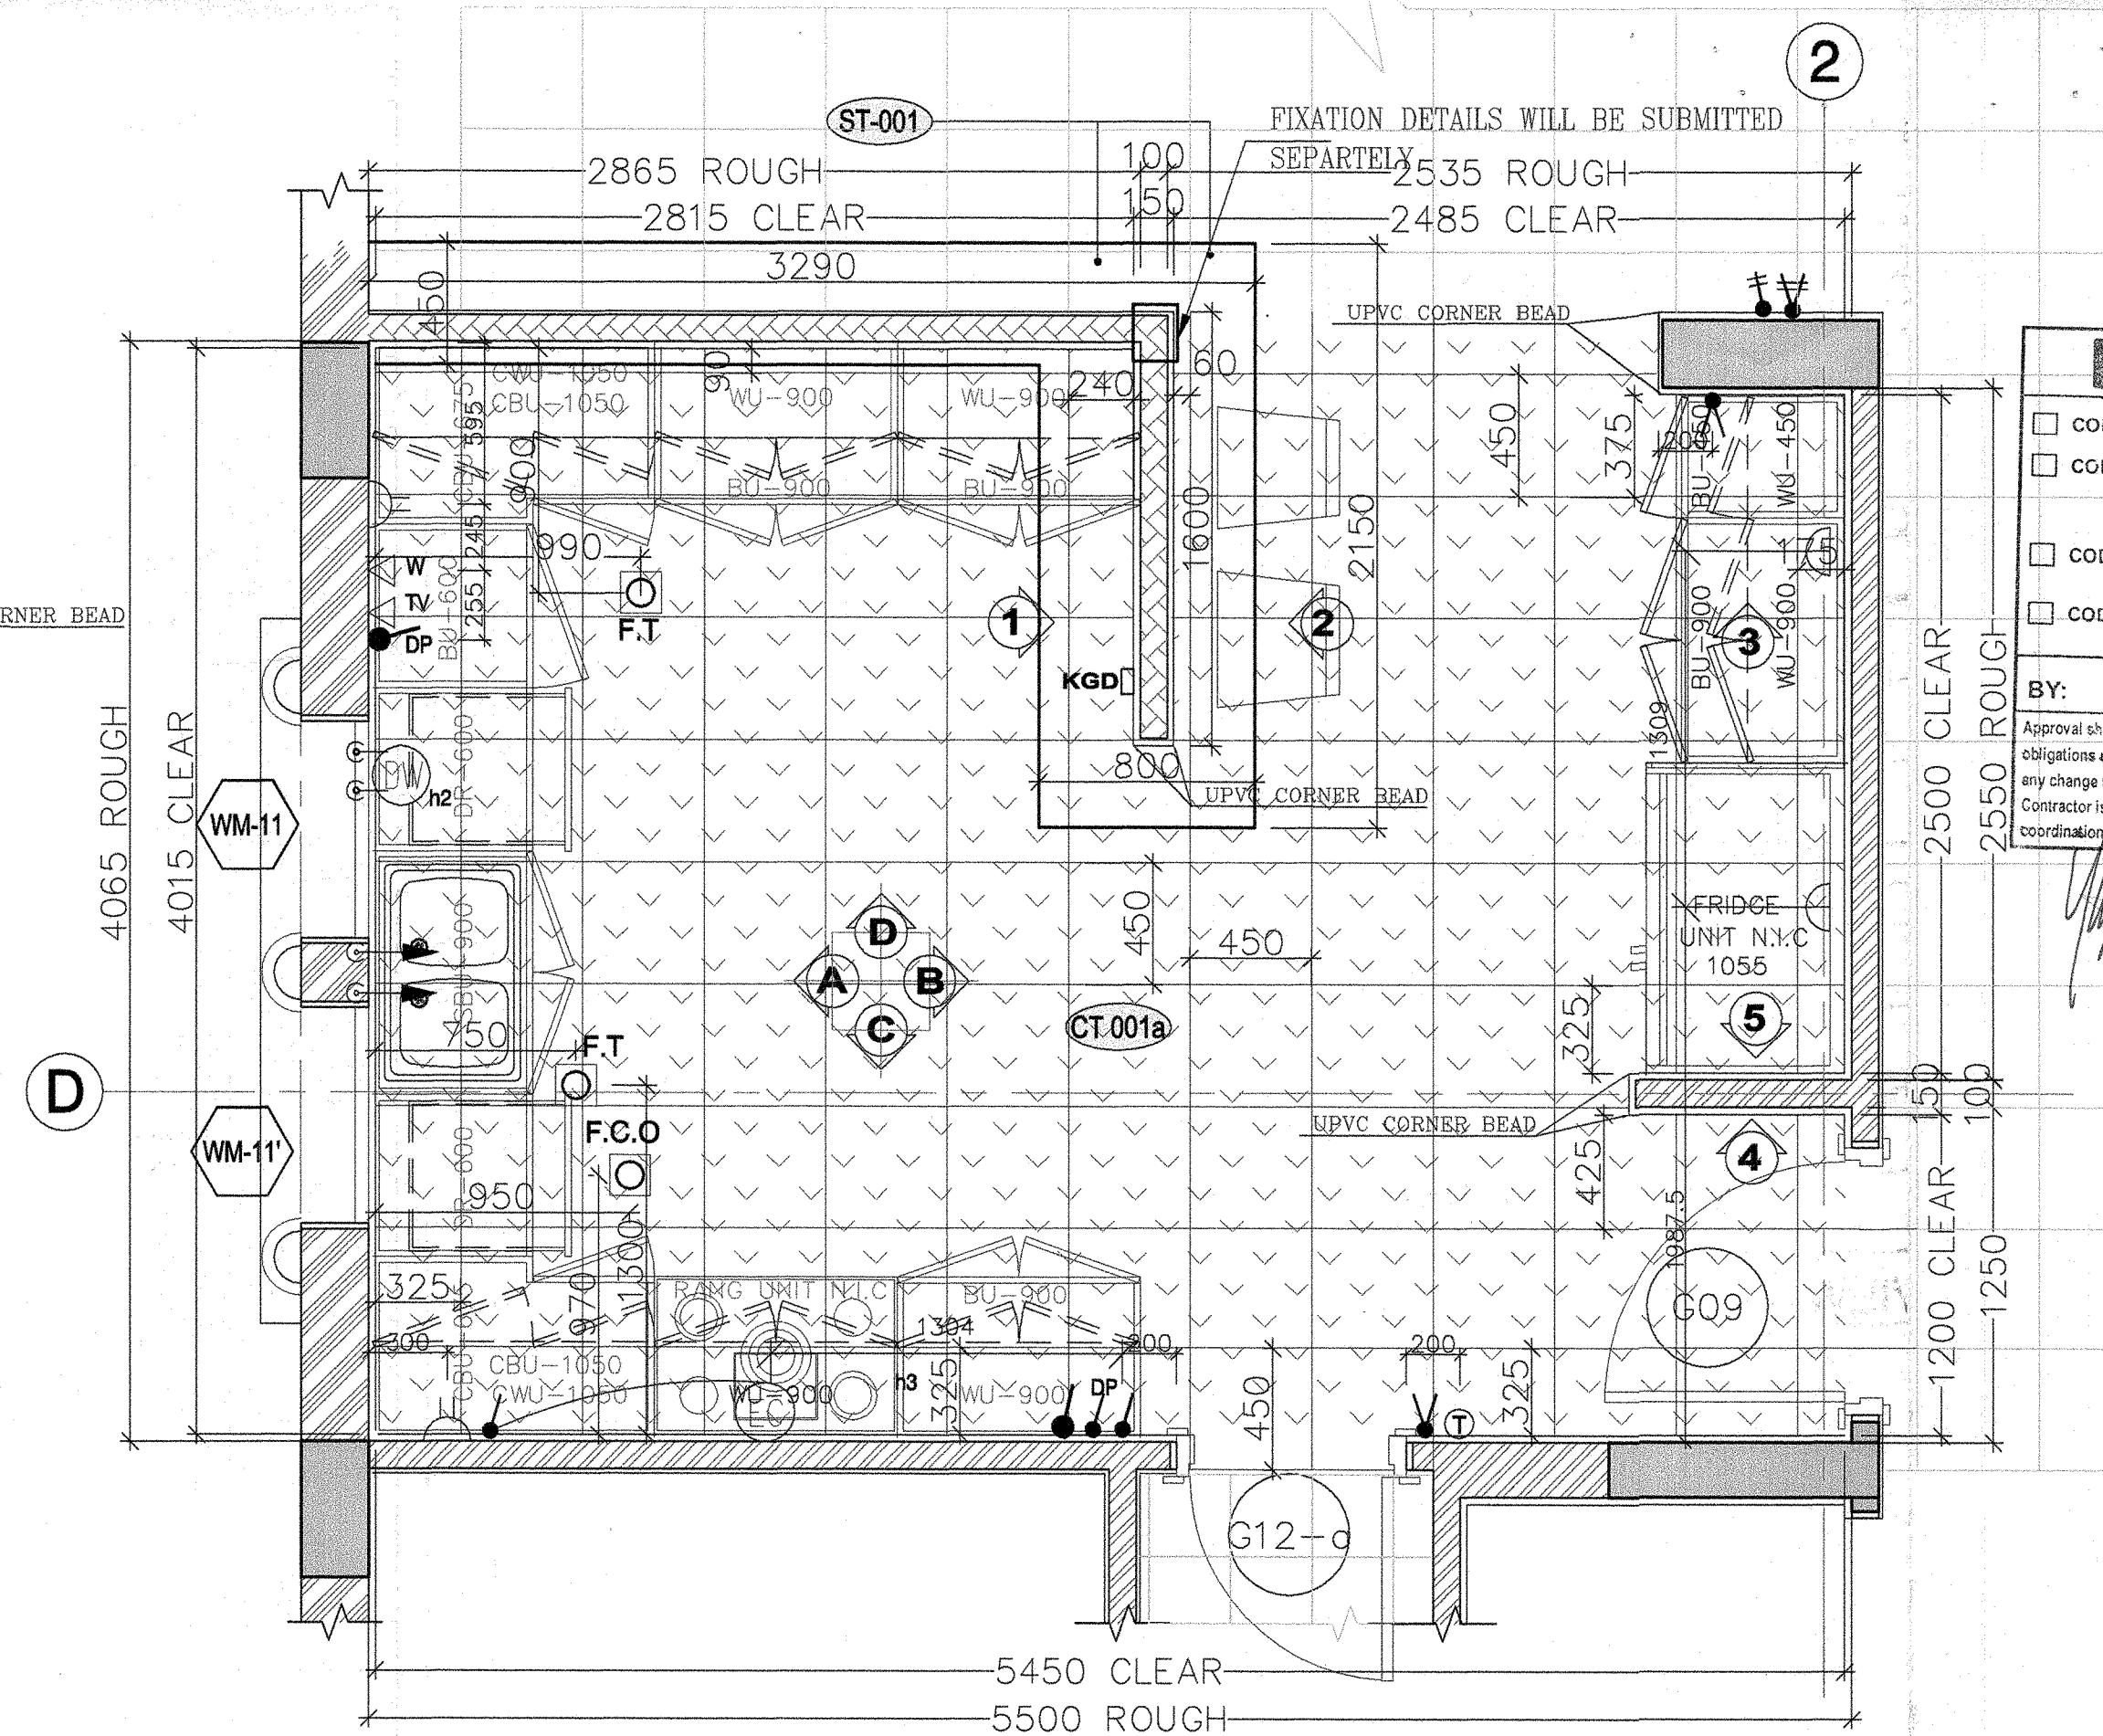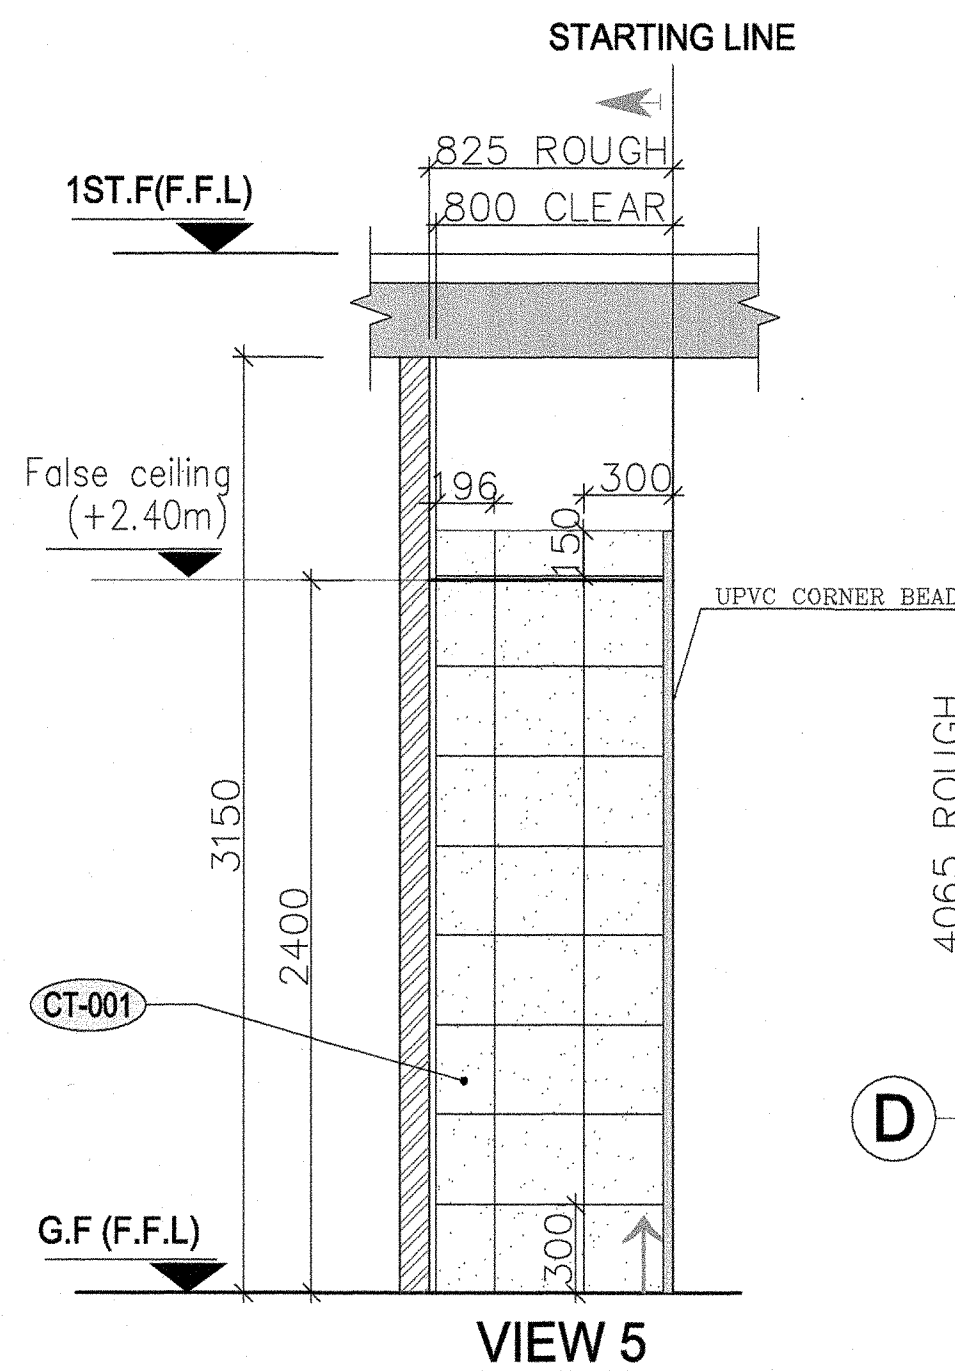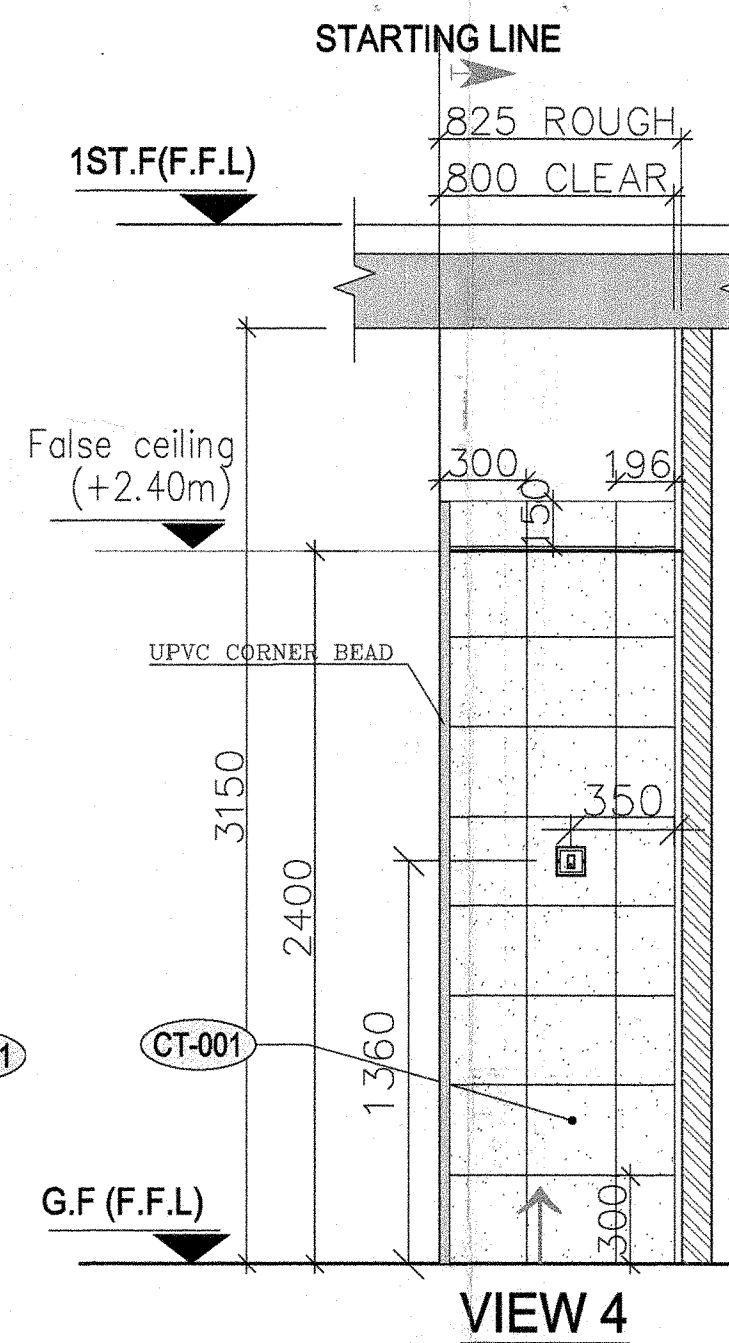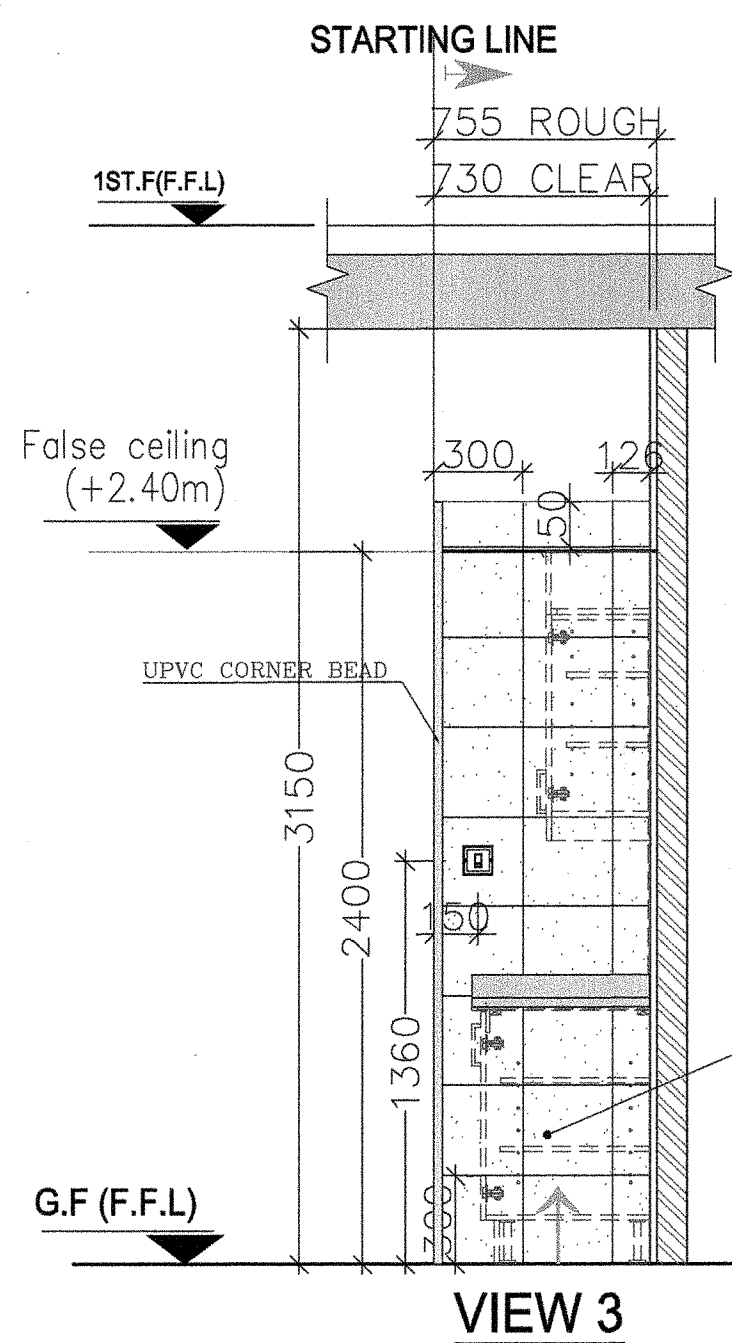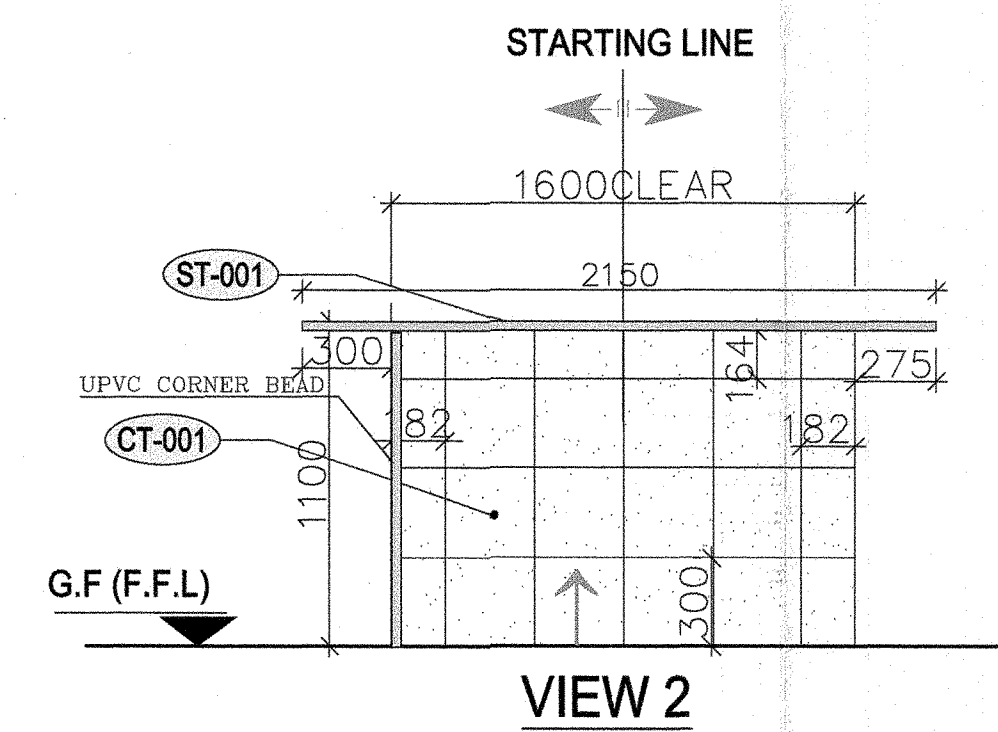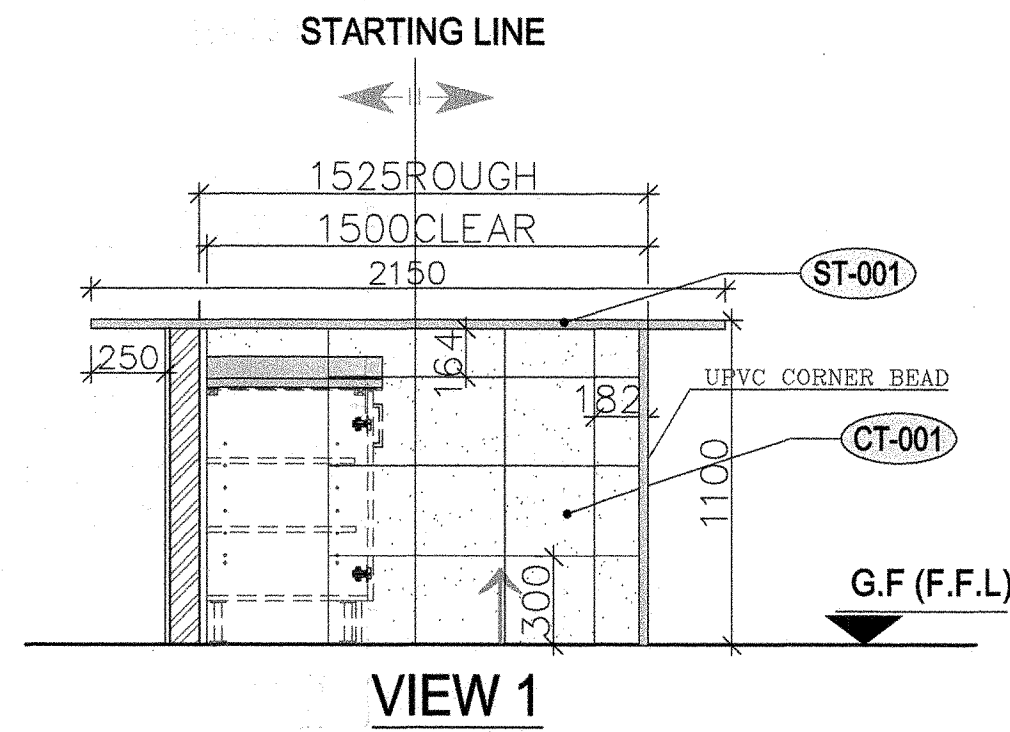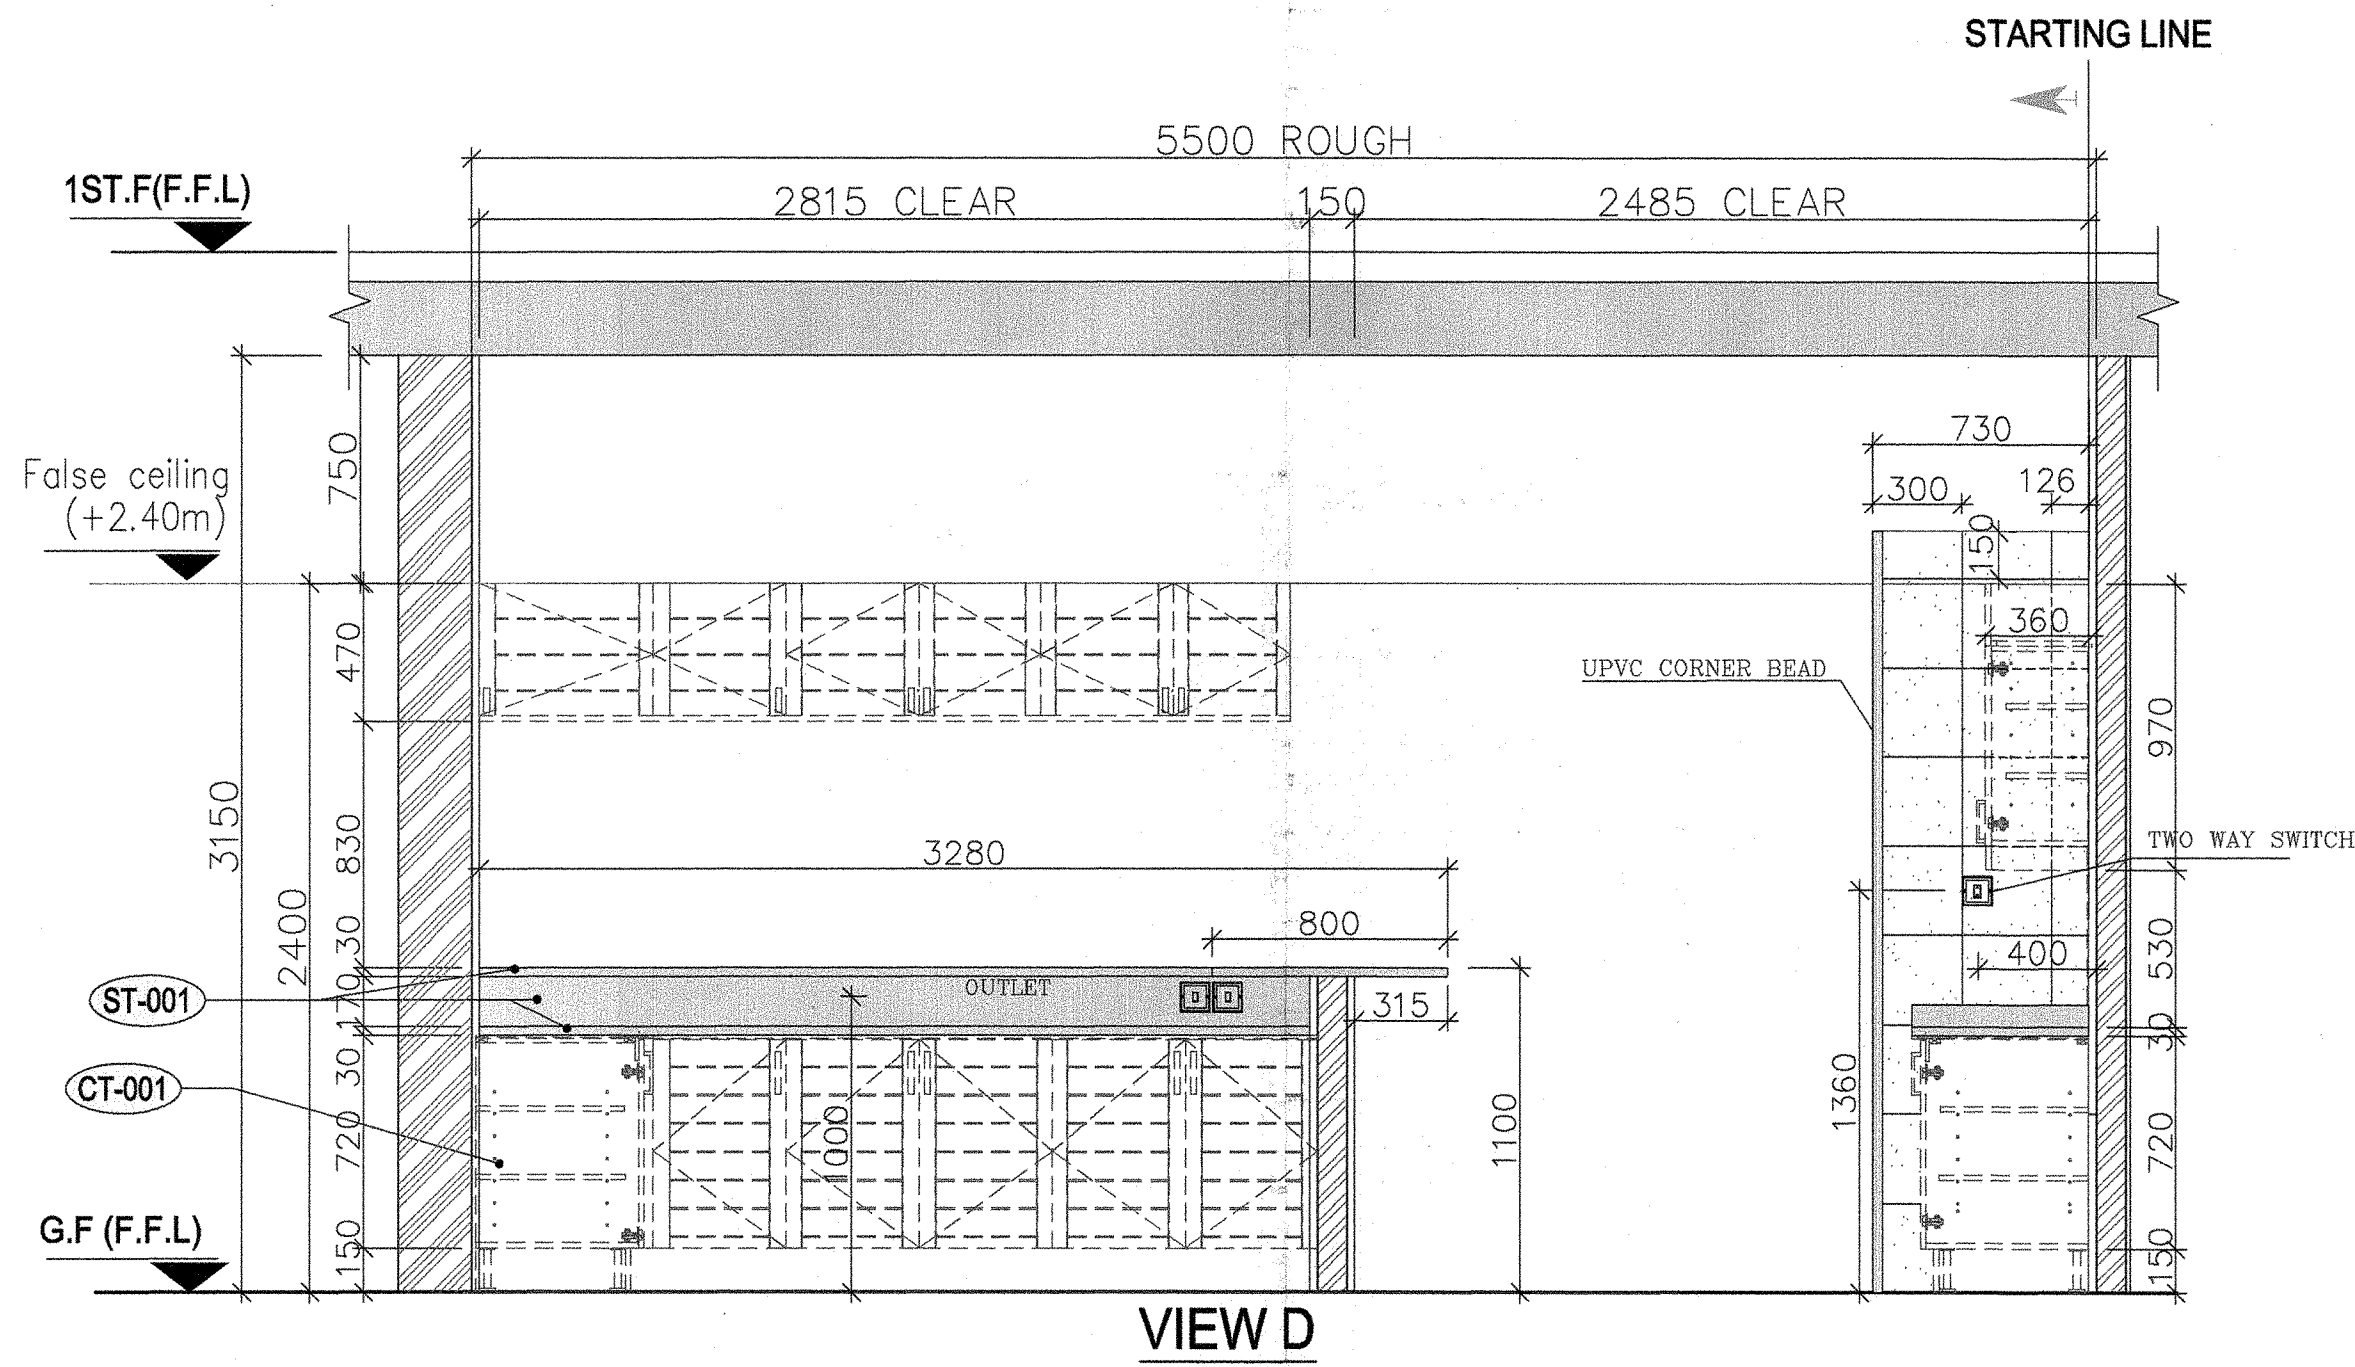

Reference	Traditional		Dimension (mm)	Application	Area
	Brand Name	Model			
CT-001	Pamesa	Saturani Beige	300 x 300	Walls	Kitchen
CT-001a	Pamesa	Alfa Beige	450 x 450	Floors	Kitchen
CT-003	Pamesa	Saturani Beige	50 x 50	Splash Back and Breakfast bar Mosaic	Kitchen & Pantry

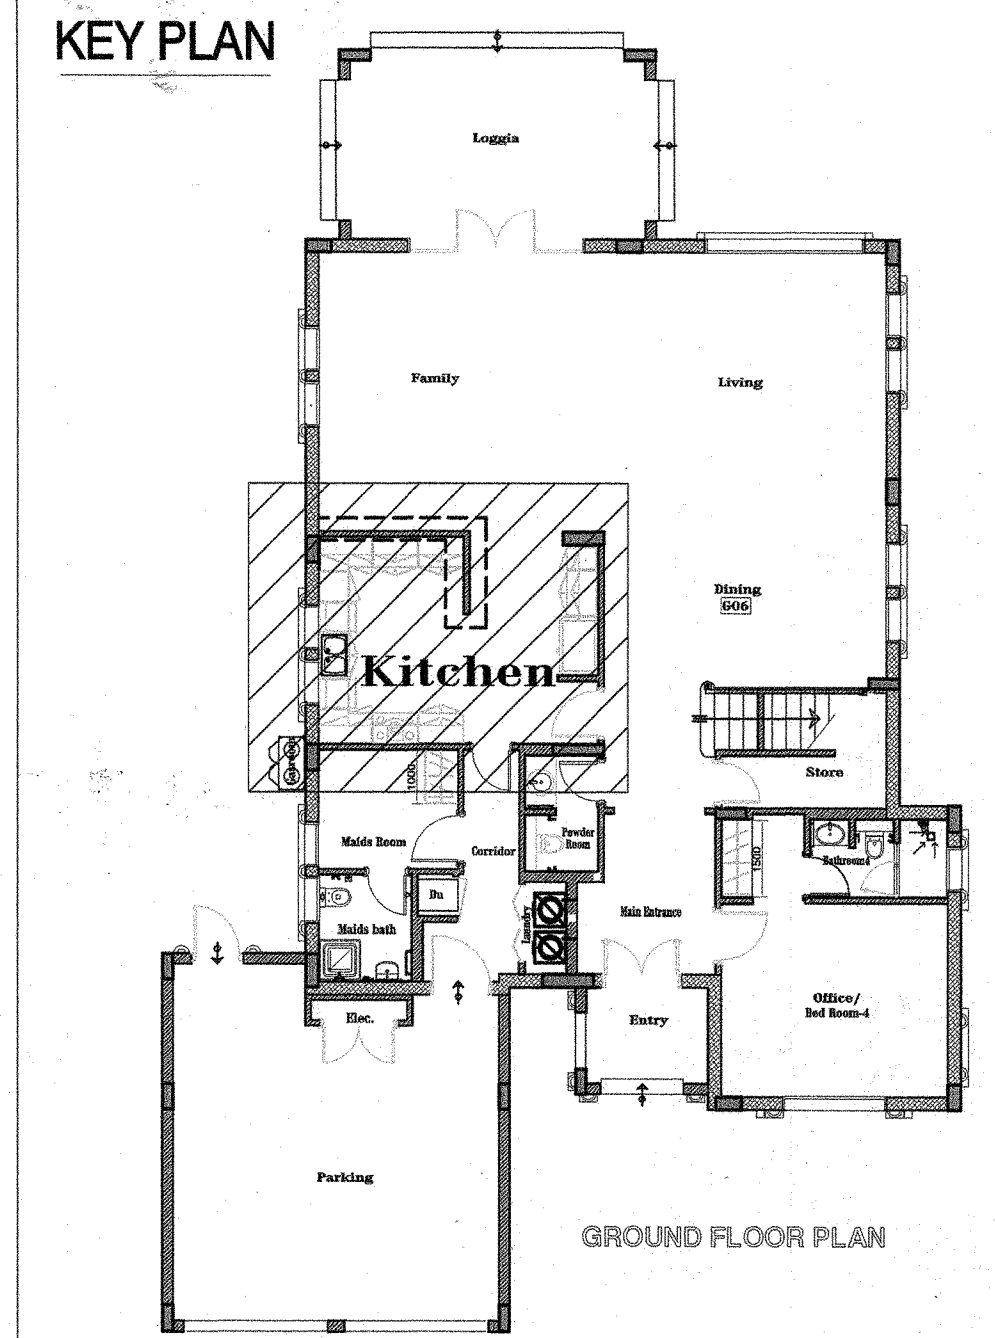

NOTE:
 ** JOINTS BETWEEN CERAMICS ARE 3 MM FOR FLOOR TILES
 ** JOINTS BETWEEN CERAMICS ARE 2 MM FOR WALL TILES
 * OPENING FOR WOODEN DOOR ARE ROUGH (BLOCK TO BLOCK)
 * OPENING FOR ALUMINIUM DOORS & WINDOWS ARE CLEAR (PLASTER TO PLASTER)
 ➔ DIRECTION OF STARTING POINT

SYMBOL	DESCRIPTION	MOUNTING HEIGHTS (mm)
DS	13A SINGLE SWITCH SOCKET FOR HOOD FAN	2150mm FROM F.F.L.
DS	13A TWIN SWITCH SOCKET	1500mm FROM F.F.L.
h1	HEIGHT OF SOCKET	1500mm FROM F.F.L.
h2	HEIGHT OF SOCKET	450mm FROM F.F.L.
h3	HEIGHT OF SOCKET	2150mm FROM F.F.L.
DS	20A DP SWITCH WITH INDICATOR FOR W/H	1500mm FROM F.F.L.
DS	DOUBLE POLE SWITCH, NEON INDICATOR, LABEL, CABLE, OUTLET FOR ELECTRIC COOKER-45A, TYPE 920	1500mm FROM F.F.L.
DS	ONE-WAY SWITCHES	1500mm FROM F.F.L.
DS	ONE-WAY/TWO GANG SWITCHES	1500mm FROM F.F.L.
DS	TWO-WAY SWITCHES	1500mm FROM F.F.L.
DS	TWO-WAY/TWO GANG SWITCHES	1500mm FROM F.F.L.
DS	R45 OUTLET FOR VOICE	450mm FROM F.F.L.
DS	R45 OUTLET FOR DATA	450mm FROM F.F.L.
DS	R45 OUTLET FOR CATV	450mm FROM F.F.L.
DS	CHWS OUTLET FOR DSH WASHER	600mm FROM F.F.L.
DS	HWS OUTLET FOR DSH WASHER	600mm FROM F.F.L.
DS	CHWS OUTLET FOR SINK	600mm FROM F.F.L.
DS	HWS OUTLET FOR SINK	600mm FROM F.F.L.
DS	THERMOSTAT ELECTRIC	1500mm FROM F.F.L.

AS BUILT DRAWING

JUMAIRAH PARK Project

Employer
NAKHEEL
 P.O. BOX: 17777, DUBAI, U.A.E.
 PHONE: + 971 - 4 - 3803388
 FAX: + 971 - 4 - 3803335
 Website: www.nakheel.ae
 E-MAIL: info@nakheel.ae

Project Manager
Bovis Lend Lease International Ltd.
 P.O. BOX: 71023, DUBAI, U.A.E.
 PHONE: + 971 - 4 - 3311430
 FAX: + 971 - 4 - 3214188
 www.bovislendlease.com

Consultant
dar al-handasah shair and partners
 P.O. BOX: 55624, DUBAI, U.A.E.
 PHONE: + 971 - 4 - 3355002
 FAX: + 971 - 4 - 3355032
 www.daralgroup.com

Main Contractor
Pauling Middle East
 P.O. BOX: 45174, ABU DHABI, U.A.E.
 PHONE: + 971 - 2 - 6309922
 FAX: + 971 - 2 - 6325555
 E-MAIL: pauling@paulingmiddleeast.ae

Package
LEGACY - TRADITIONAL
TLING (FLOOR & WALL) IN KITCHEN
(As per mock up villa) (Sheet No. 2 of 2)

Drawn: T. Murugan Review: Eng. Ziyad Checked: Eng. Ghassan Zeitouni
 Scale: 1:25 Date: 24-12-2011
 Drawing No. **PME / JP / AB / LEGACY TRADITIONAL / CT-03**