



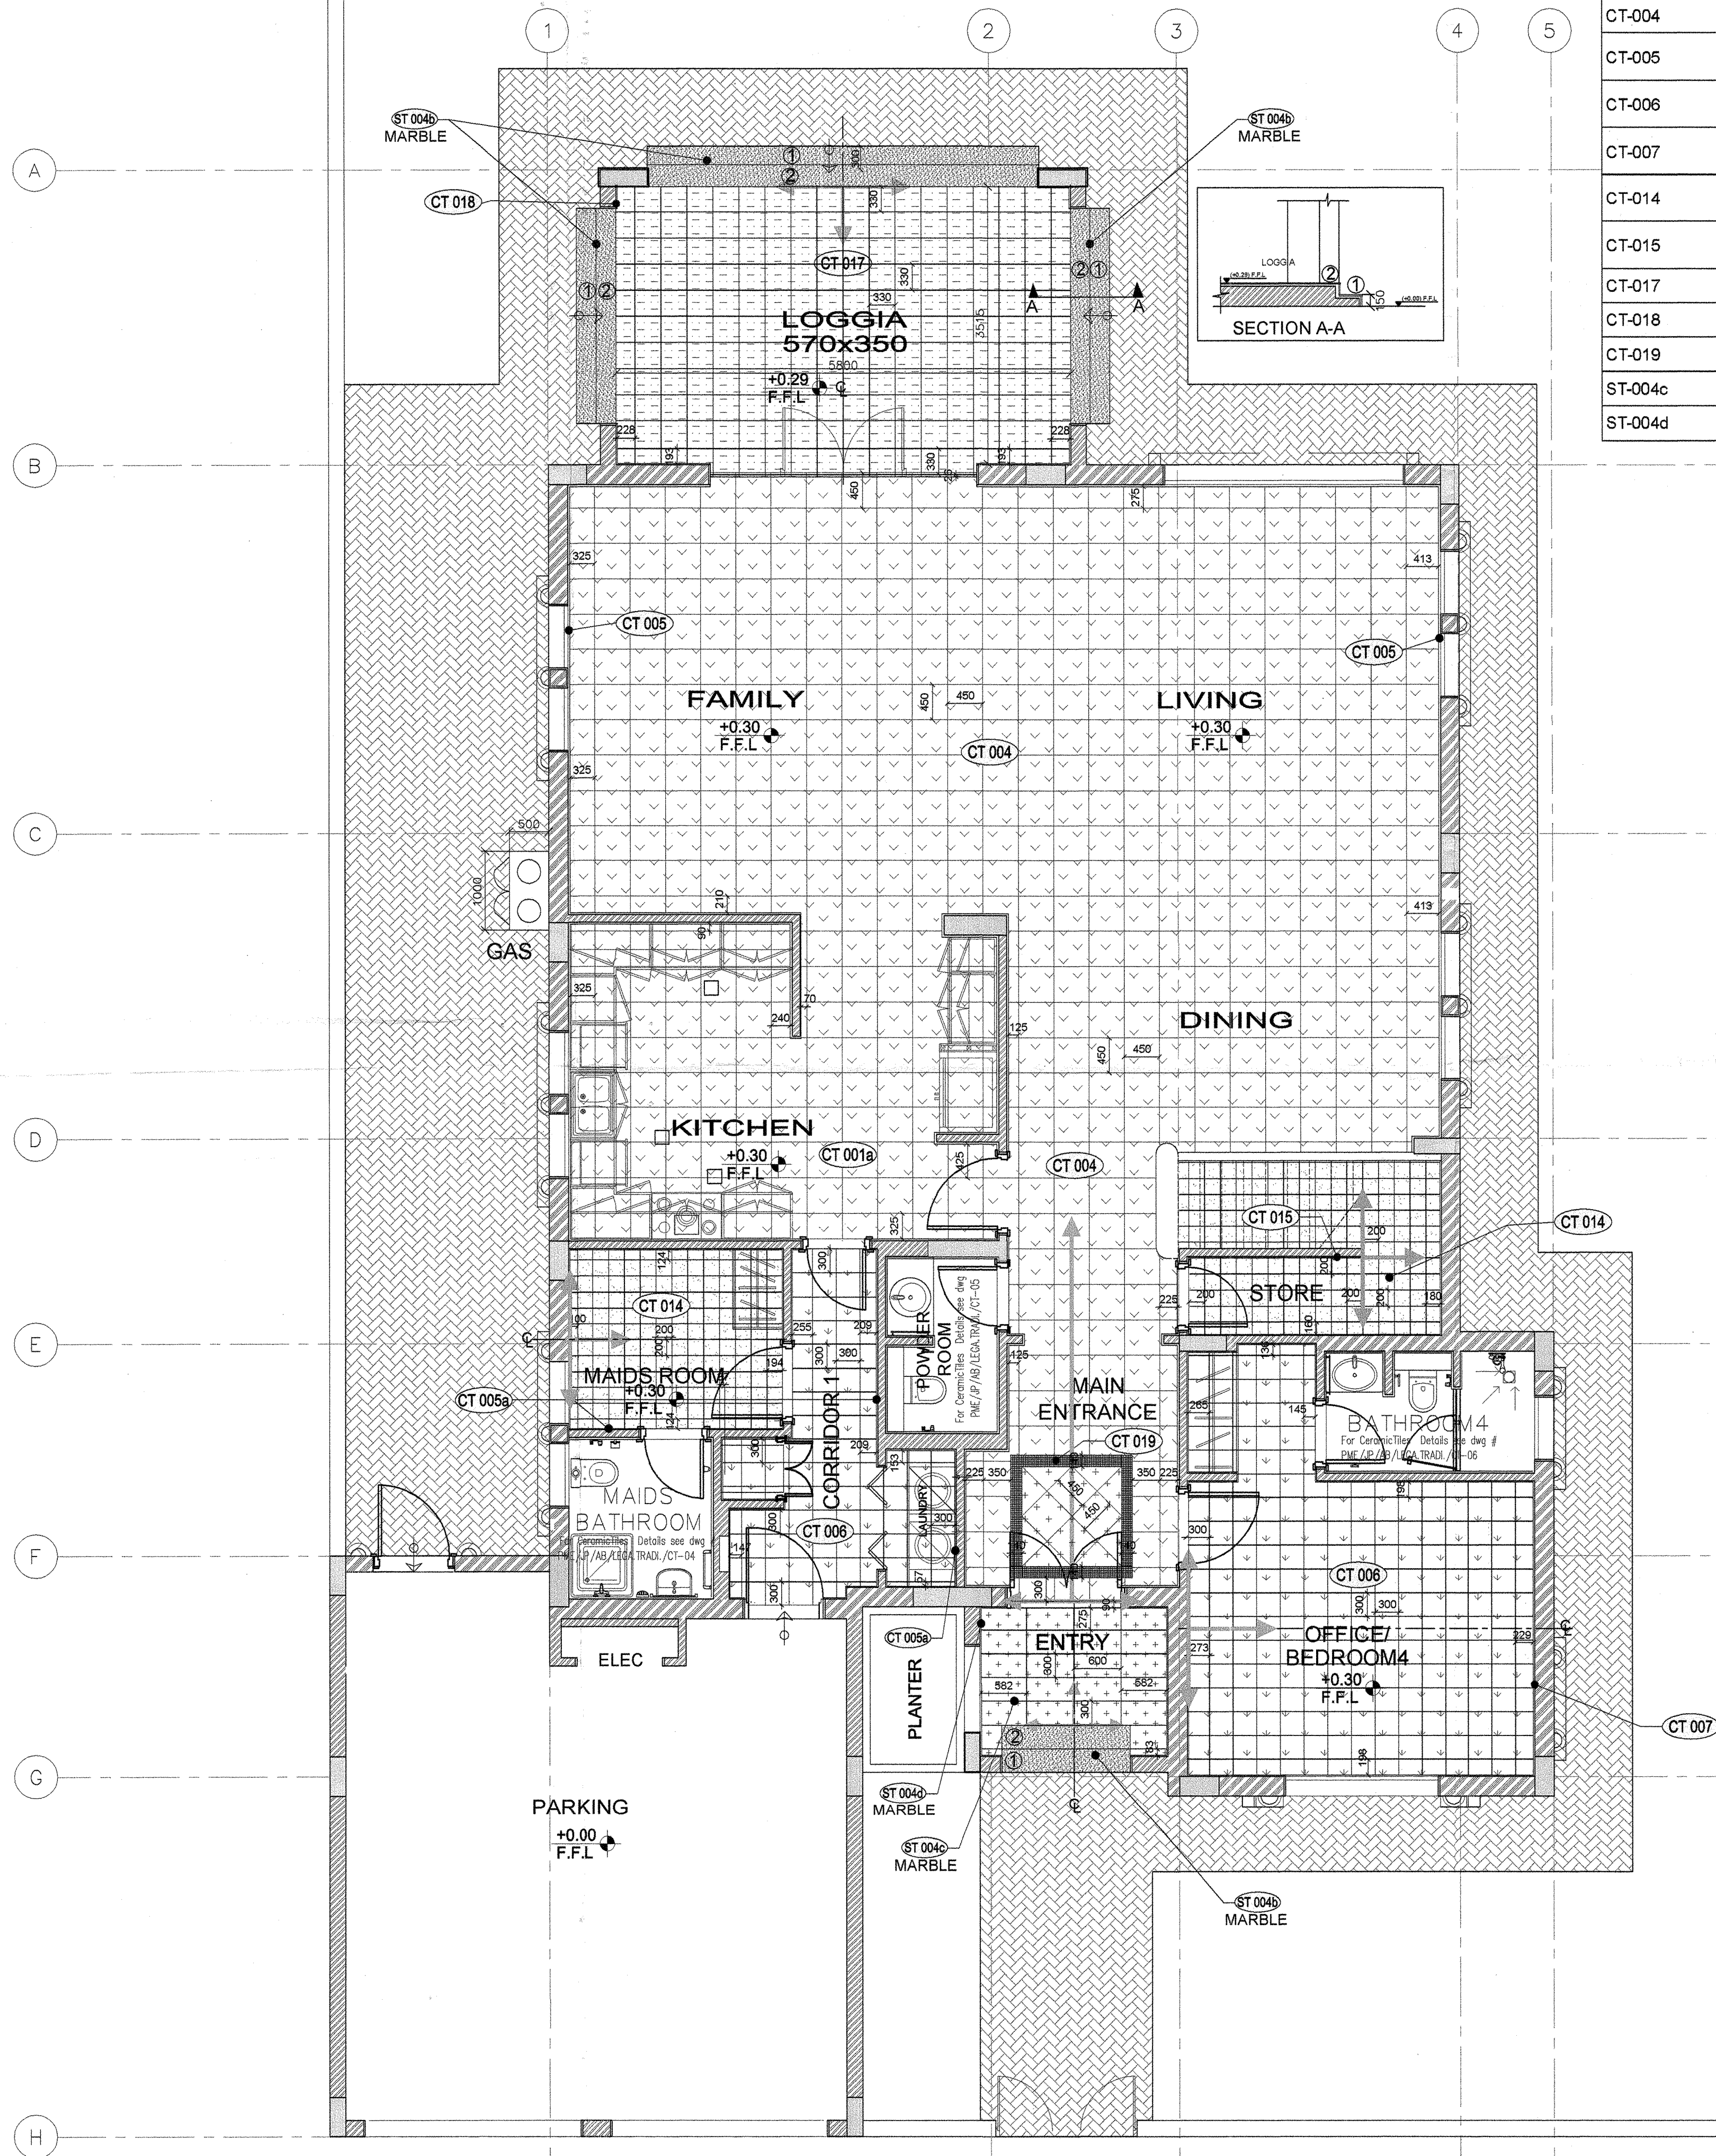


Reference	Traditional		Dimension (mm)	Application	Area
	Brand Name	Model			
CT-004	Pamesa	Alfa Beige	450 x 450	Floors	Main Ent, Family, Living & Dining
CT-005	Pamesa	Alfa Beige	80 x 450	Skirting	Main Ent, Family, Living & Dining
CT-006	Pamesa	Alfa Beige	300 x 300	Floors	Master, General Bed Room, Family, Dressing, Corridor 1 & 2
CT-007	Pamesa	Alfa Beige	80 x 300	Skirting	Master, General Bed Room, Family, Dressing, Corridor 1 & 2
CT-014	Guocera	E827B	200 x 200	Floors	Maid's Room, Laundry, Store & Maid's Bathroom
CT-015	Guocera	E827B	100 x 200	Skirting	Maid's Room, Laundry, Store
CT-017	Esma	Talavera Marron	330 x 330	Floors	Terrace & Loggia
CT-018	Esma	Talavera Marron	100 x 330	Skirting	Terrace & Loggia
CT-019	Marble	Mix(L.E.M+C.M)	20 x 20	Mosaic	Main Entrance
ST-004c	Marble	Mix(L.E.M+C.M)	30 x 60	Mosaic	Entry
ST-004d	Marble	Mix(L.E.M+C.M)	10 x 60	Mosaic	Entry

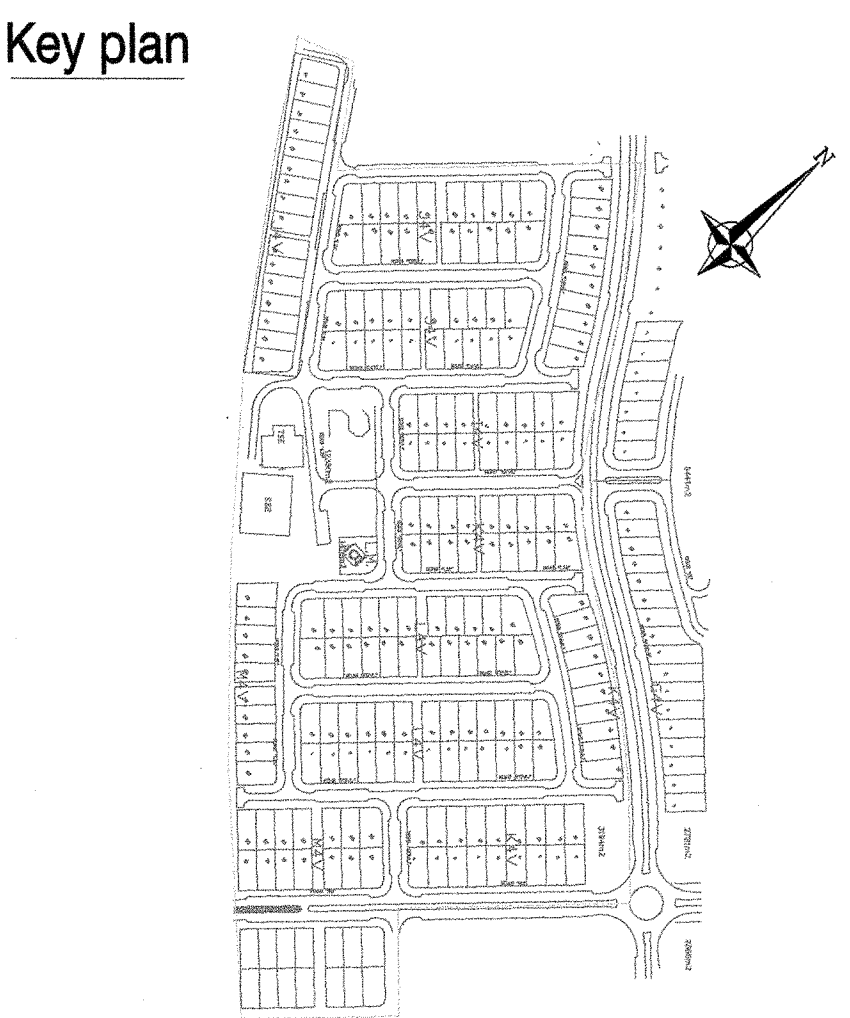

NOTE:
 1. ALL DIMENSIONS ARE IN MILLIMETERS
 2. ALL JOINT ARE 2mm
 ** CERAMIC TILES FOR KITCHEN & BATHROOMS TO BE SUMMITTED SEPARATELY

	MARBLE (IN ENTRY) (300 x 300)
	CT-004 (450 x450)
	CT-017 (330 x 330)
	CT-014 (200 x 200)
	CT-006 (300 x 300)
	CT-019 (20X20)

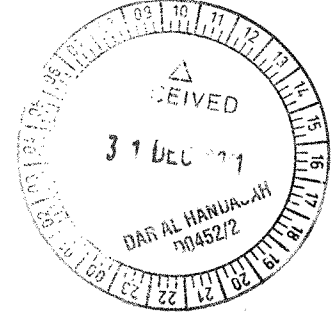

dar al-handasah
 Share and Partners

☒ CODE 1 APPROVED
☐ CODE 2 APPROVED AS NOTED
☐ CODE 3 RESUBMIT FOR APPROVAL
☐ CODE 4 REJECTED

BY: _____ DATE: _____

Approval shall not relieve the contractor of any of his obligations under the Contract or constitute authorization of any change to Contract Documents or variation to the works. Contractor is responsible for dimensions, quantities and coordination with other trades.

AS BUILT DRAWING

Project

JUMAIRAH PARK

Employer

NAKHEEL

Consultant

dar al-handasah
share and partners

Main Contractor

Pauling Middle East

Package

PACKAGE - 2&2A

Drawing Title

**LEGACY TRADITIONAL
TILING (FLOORING)
IN GROUND FLOOR**

Drawn: T.Murugan
Scale: 1:50
Date: 24.12.2011


Review: Eng. Ziad
Checked: Eng.Ghassan Zeitouni

Drawing No.
PME / JP / AB / LEGACY TRADITIONAL / CT-001

P.O. BOX: 17777, DUBAI, U.A.E.
 PHONE: + 971 - 4 - 3803388
 FAX: + 971 - 4 - 3803335
 Website: www.nakheel.ae
 E-MAIL: info@nakheel.ae





P.O. BOX: 55624, DUBAI, U.A.E.
 PHONE: + 971 - 2 - 4029922
 FAX: + 971 - 2 - 4029953
 E-MAIL: pauling@emirates.net.ae

P
AB008
R-1

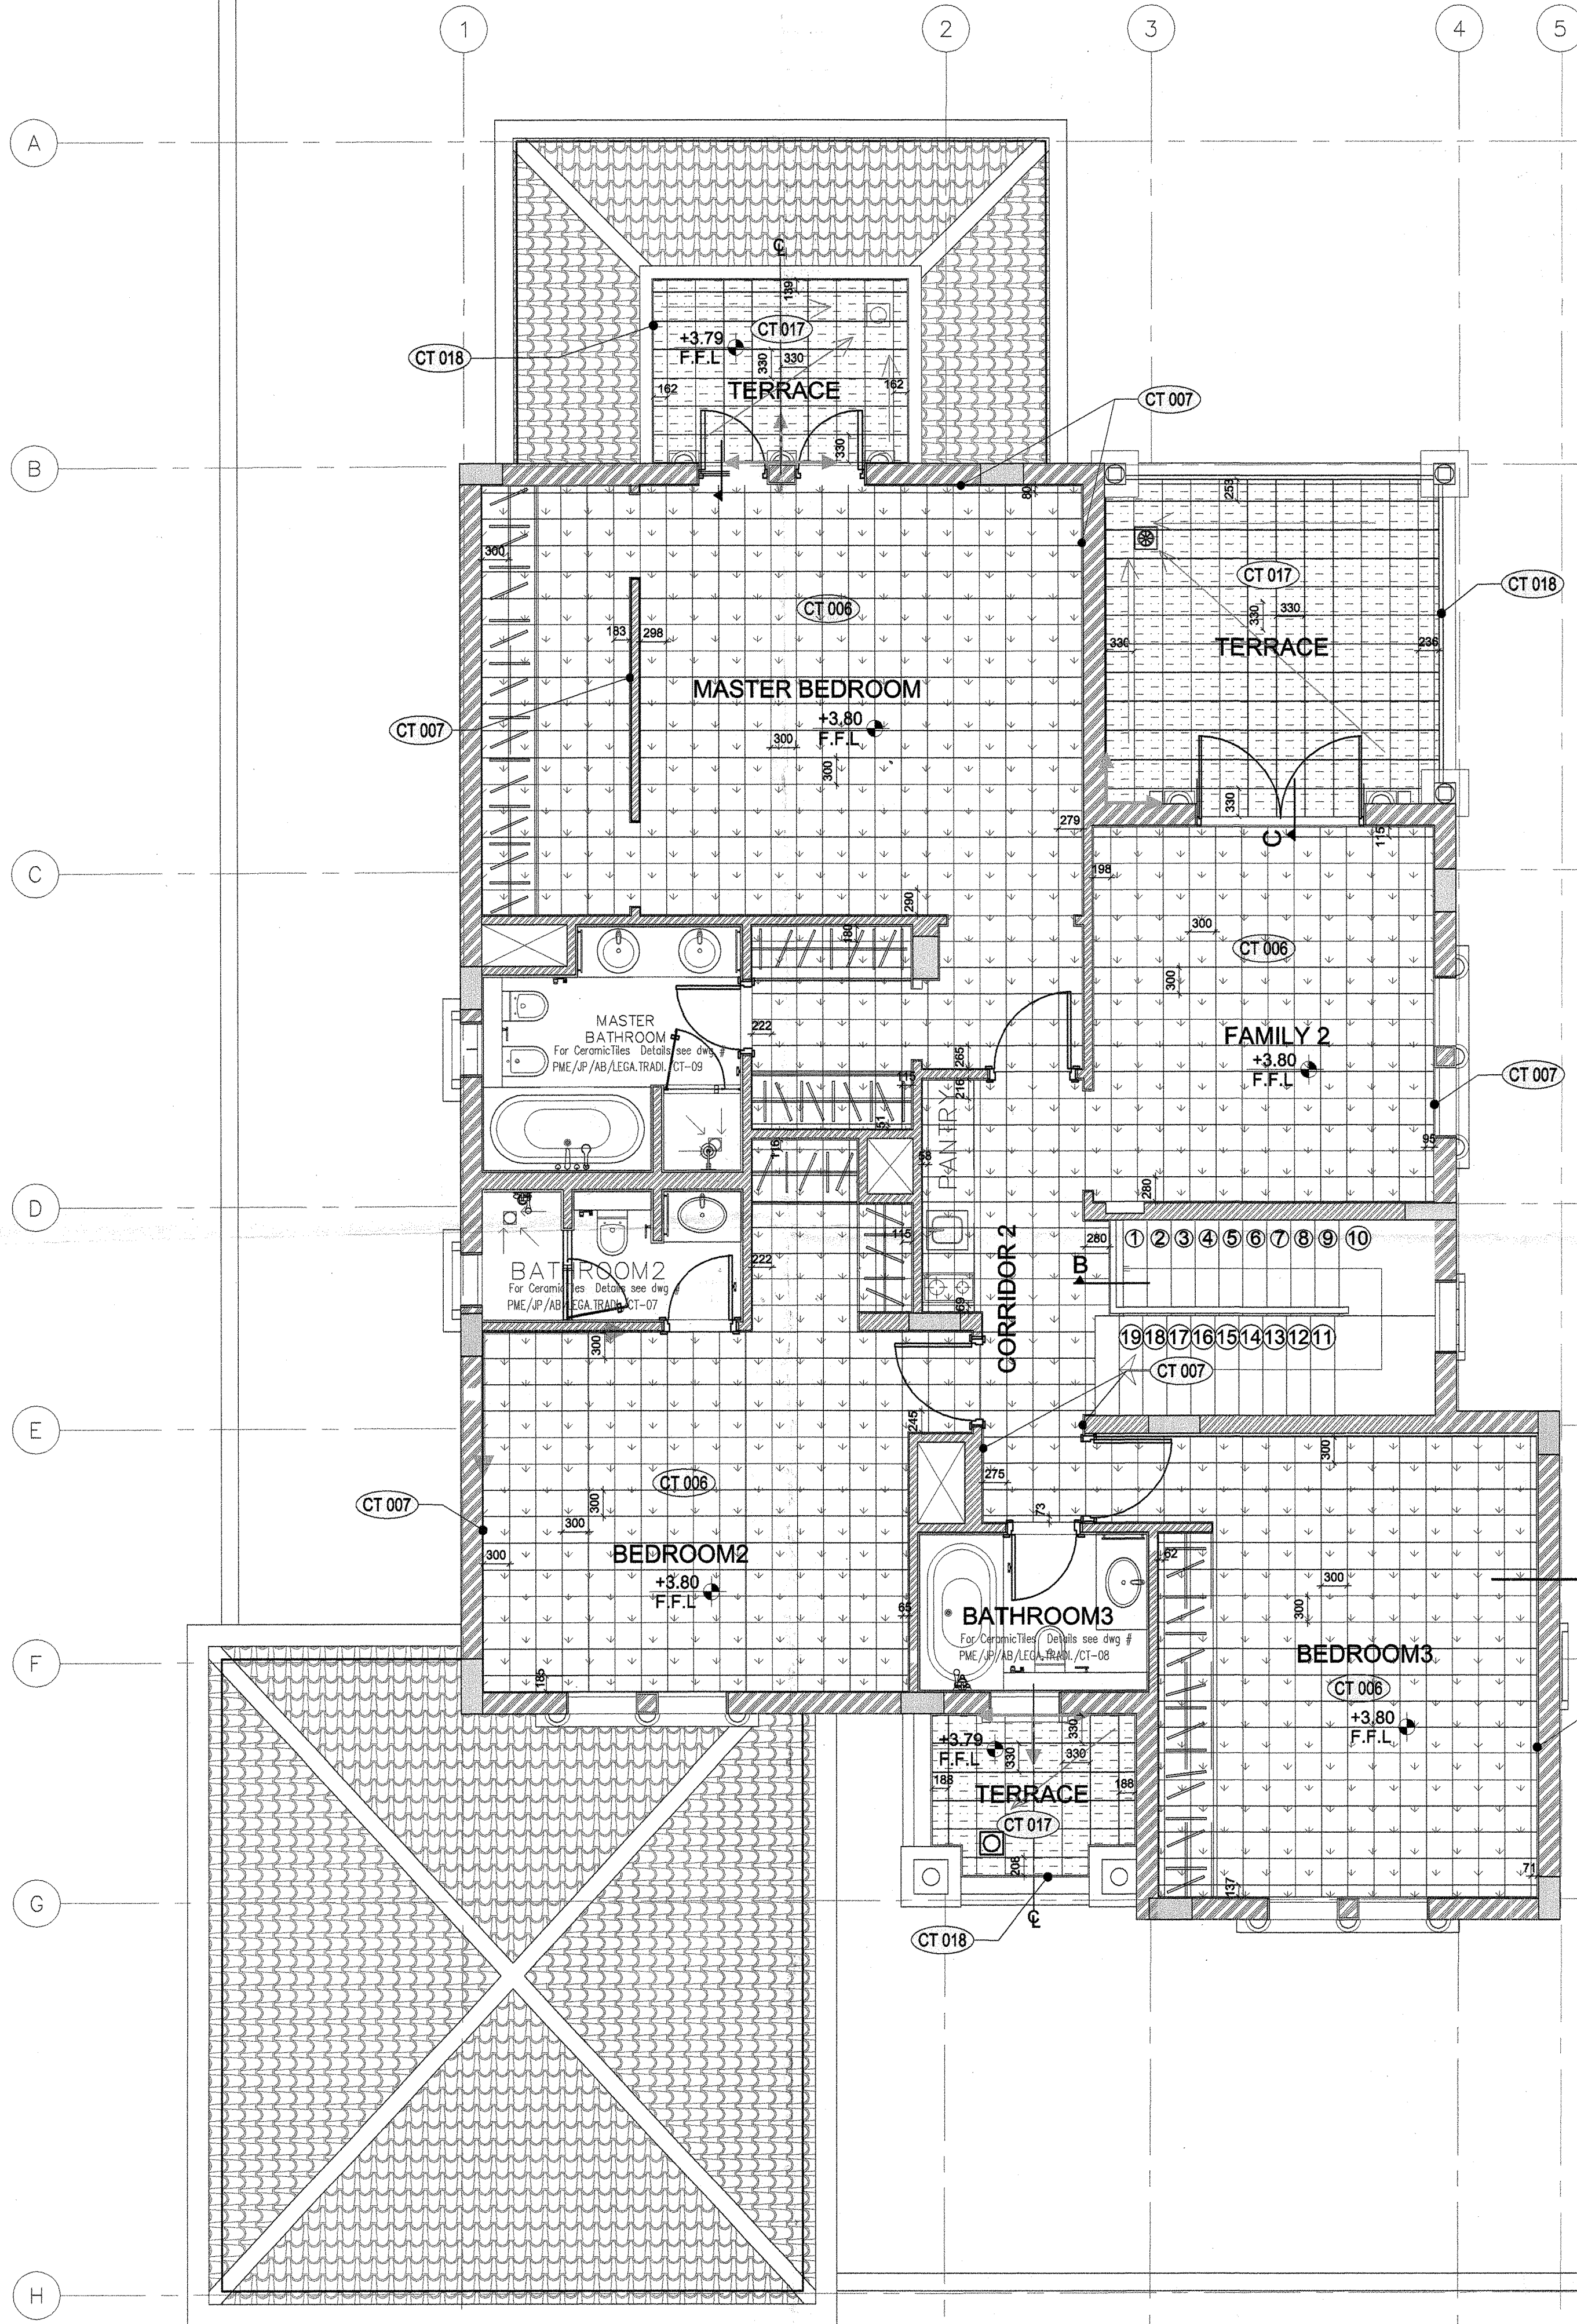

Reference	Traditional		Dimension (mm)	Application	Area
	Brand Name	Model			
CT-006	Pamesa	Alfa Beige	300 x 300	Floors	Master, General Bed Room, Family, Dressing, Corridor 1 & 2
CT-007	Pamesa	Alfa Beige	80 x 300	Skirting	Master, General Bed Room, Family, Dressing, Corridor 1 & 2
CT-017	Esma	Talavera Marron	330 x 330	Floors	Terrace & Loggia
CT-018	Esma	Talavera Marron	100 x 330	Skirting	Terrace & Loggia

(ALL SIZES WILL BE AS PER APPROVED SAMPLE)

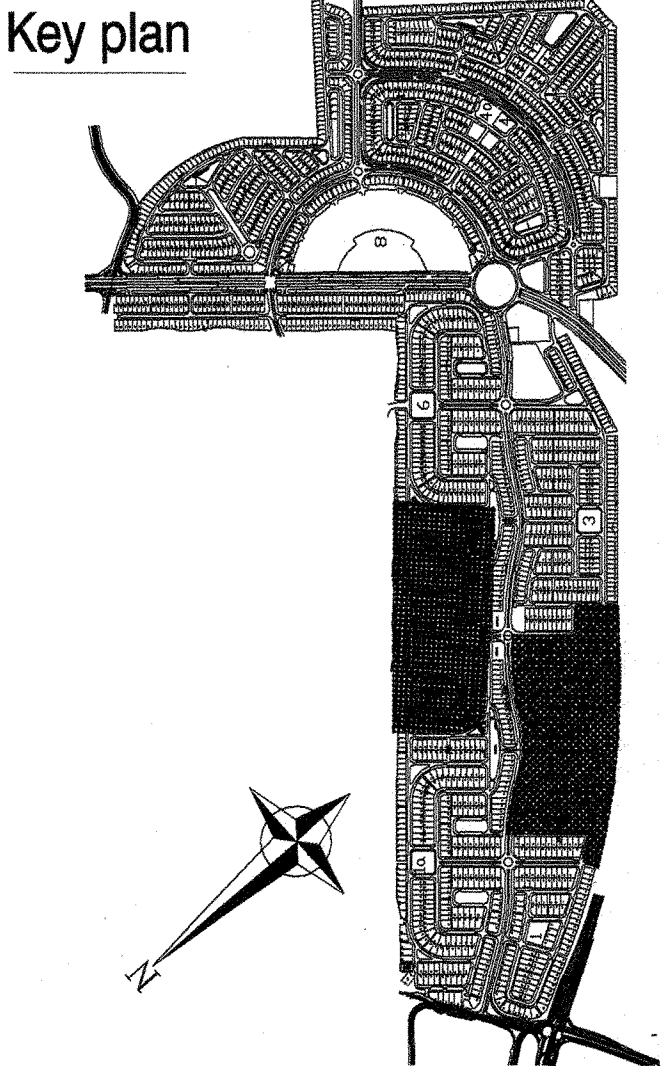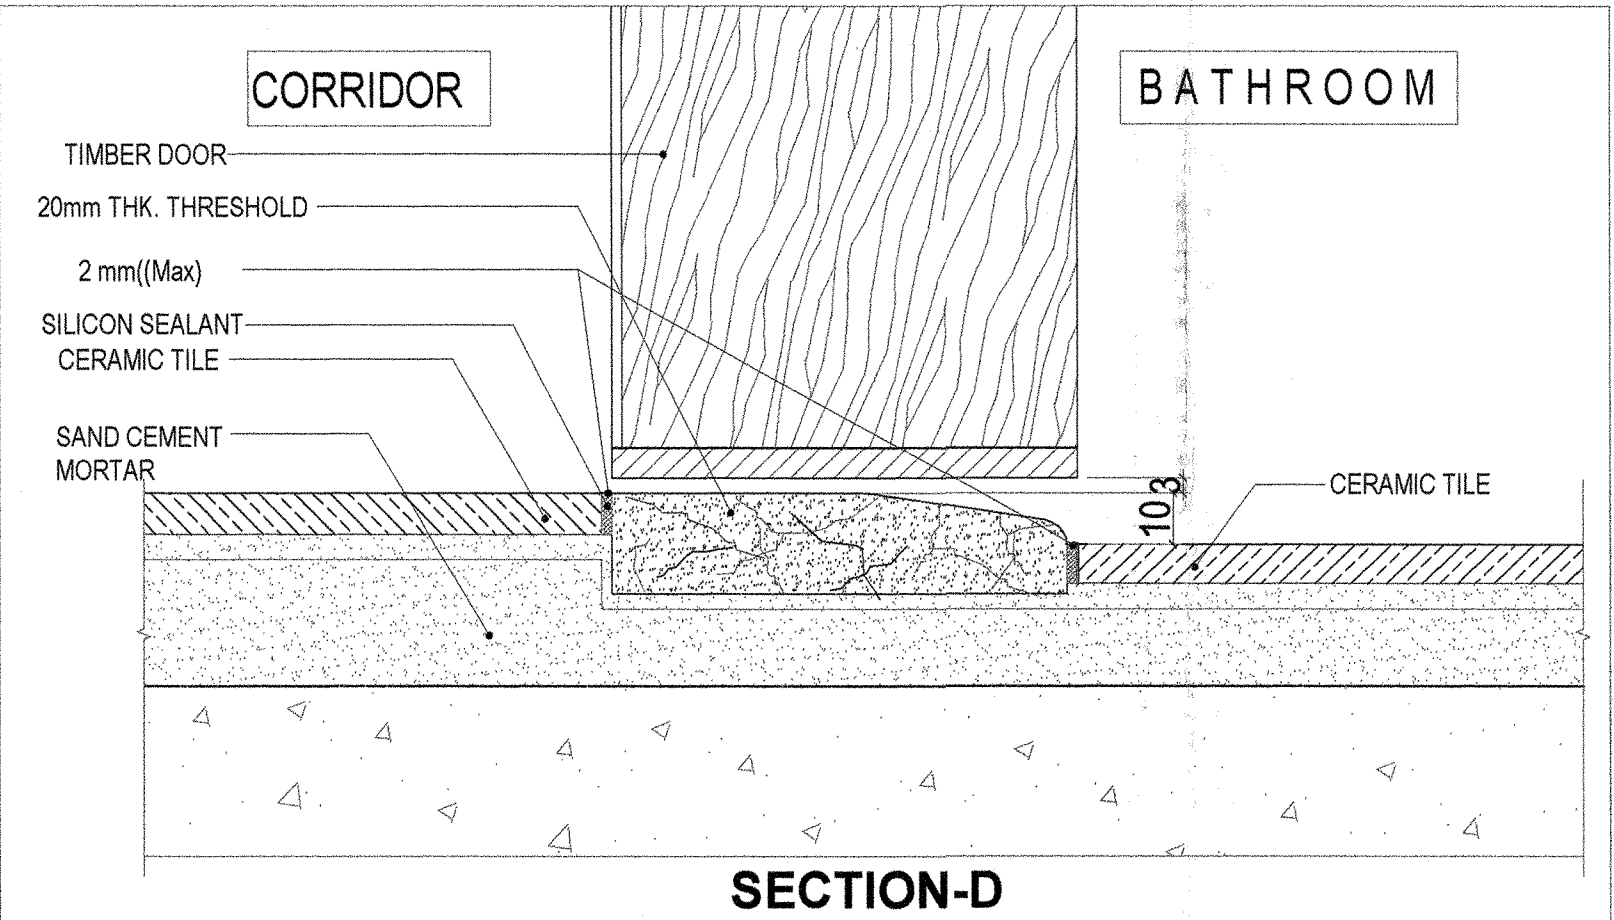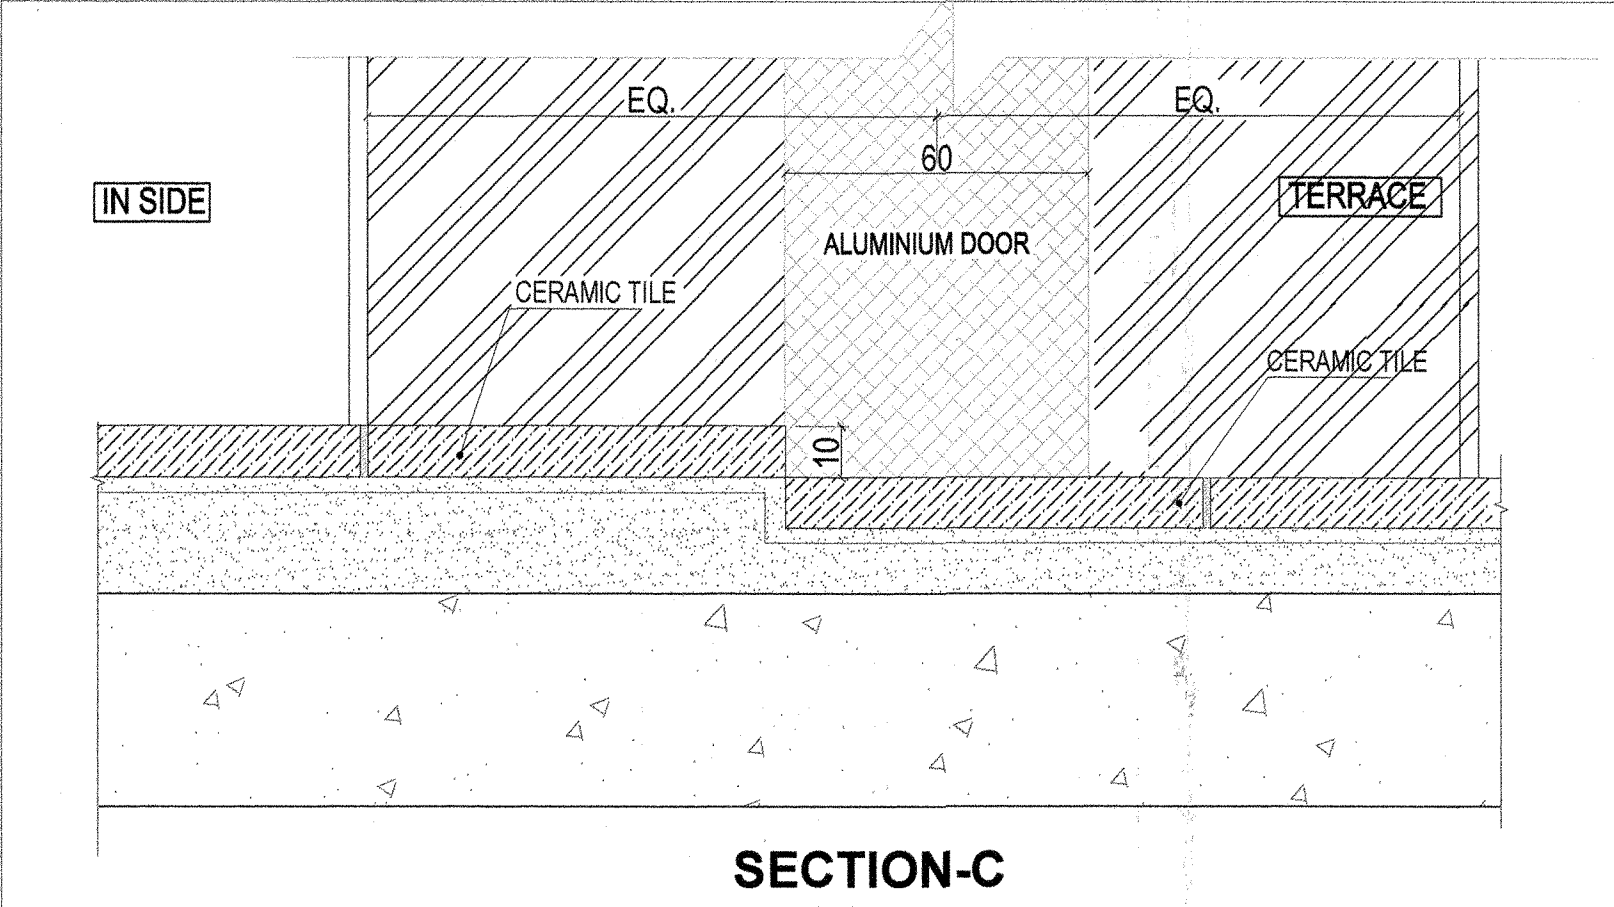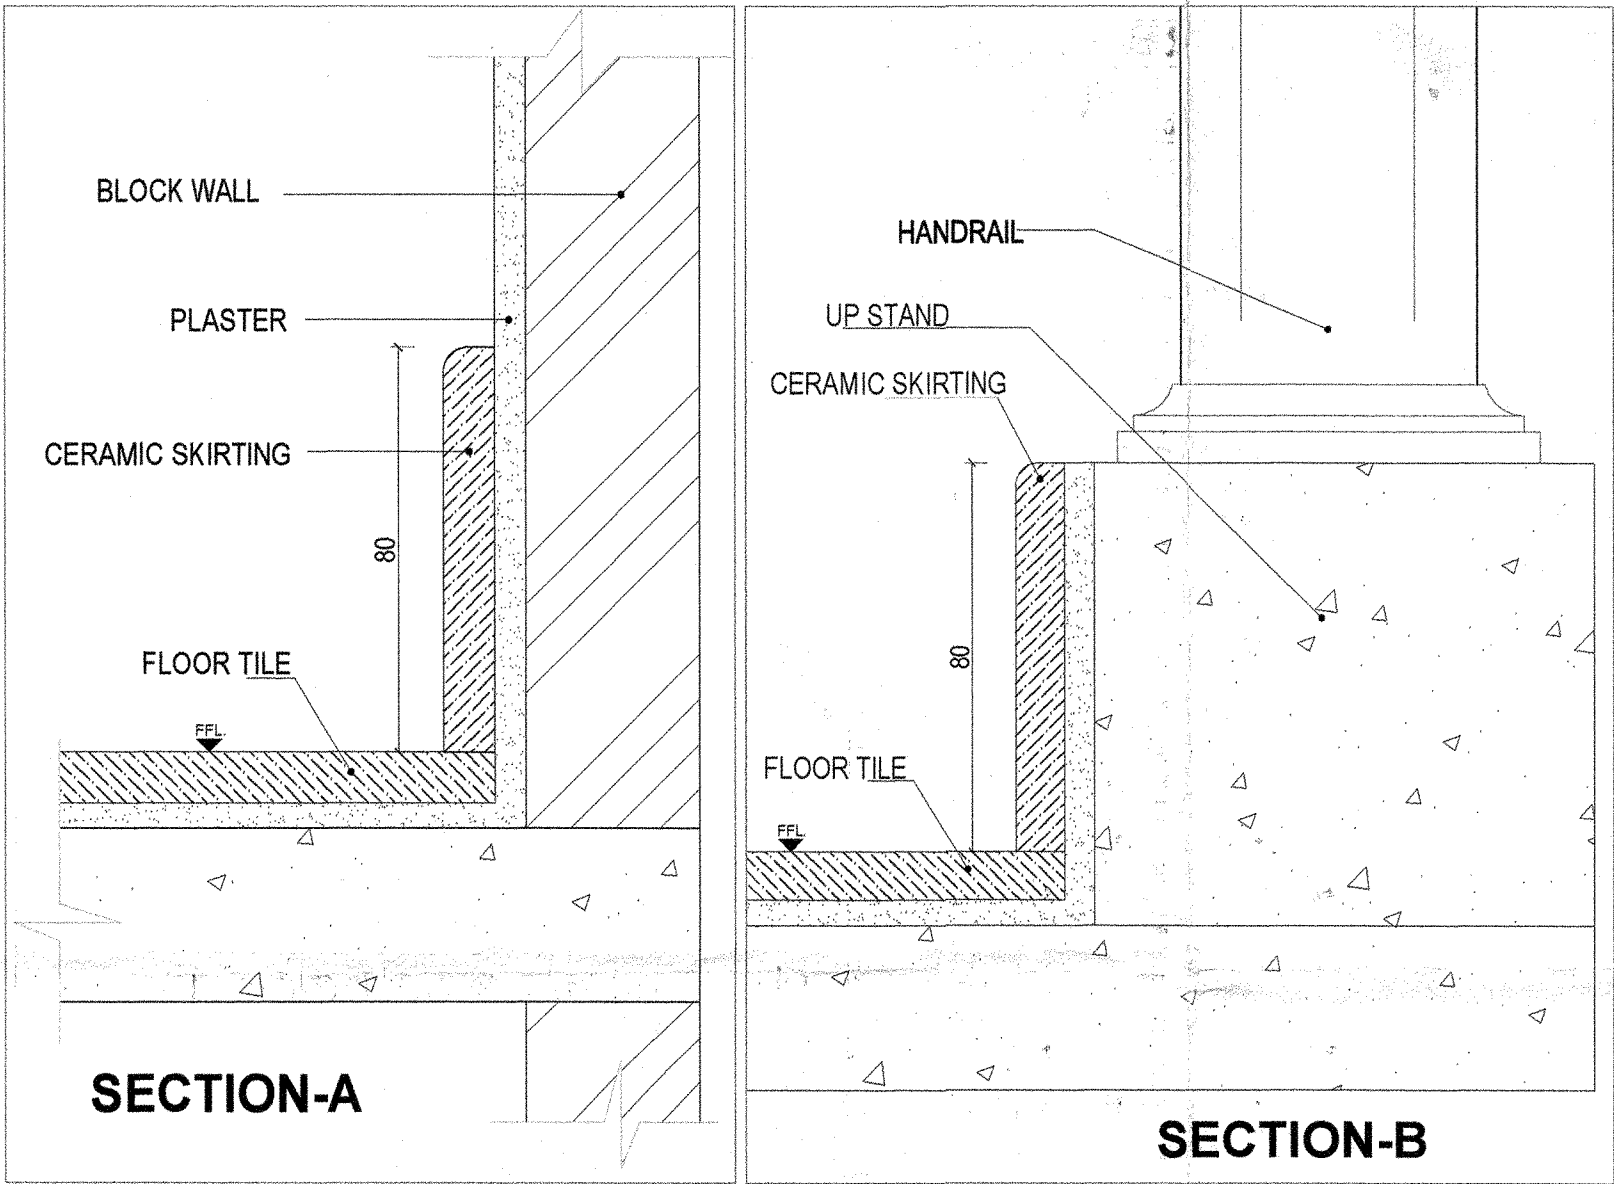

NOTE:
1. ALL DIMENSIONS ARE IN MILLIMETERS
2. ALL JOINT ARE 2mm
** CERAMIC TILES FOR KITCHEN & BATHROOMS
TO BE SUMITTED SEPARATELY

LEGEND	
	CT 006 (300 x 300)
	CT-017 (330 x 330)

dar al-handasah
Sheir and Partners

☒ CODE 1 APPROVED
☐ CODE 2 APPROVED AS NOTED
WORK MAY PROCEED SUBJECT TO
INCORPORATION OF ENDORSED
COMMENTS
☐ CODE 3 RESUBMIT FOR APPROVAL
WORK MAY NOT PROCEED
☐ CODE 4 REJECTED

BY: _____ DATE: _____

Approval shall not relieve the contractor of any of his
obligations under the Contract or constitute authorization of
any change to Contract Documents or variation to the work.
Contractor is responsible for dimensions, quantities and
coordination with other trades.




AS BUILT DRAWING

Project

JUMAIRAH PARK

Employer

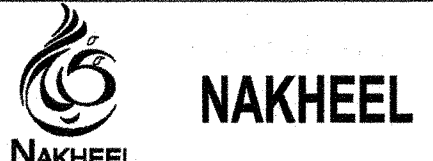

Consultant



Pauling Middle East

Main Contractor

Package

PACKAGE - 2&2A

LEGACY TRADITIONAL
TILING (FLOORING)
IN FIRST FLOOR

Drawing Title

Drawn: T.Murugan	Review: Eng. Ziad	Checked: Eng.Ghassan Zeitouni
Scale: 1:50	Date: 24.12.2011	

Drawing No.

PME / JP / AB / LEGACY TRADITIONAL / CT-002