


JUMEIRAH PARK VILLAS (PACKAGE 2 & 2A) MASTER PLAN SHOWING THE DETAILS OF DELETION OF THE G.R.C

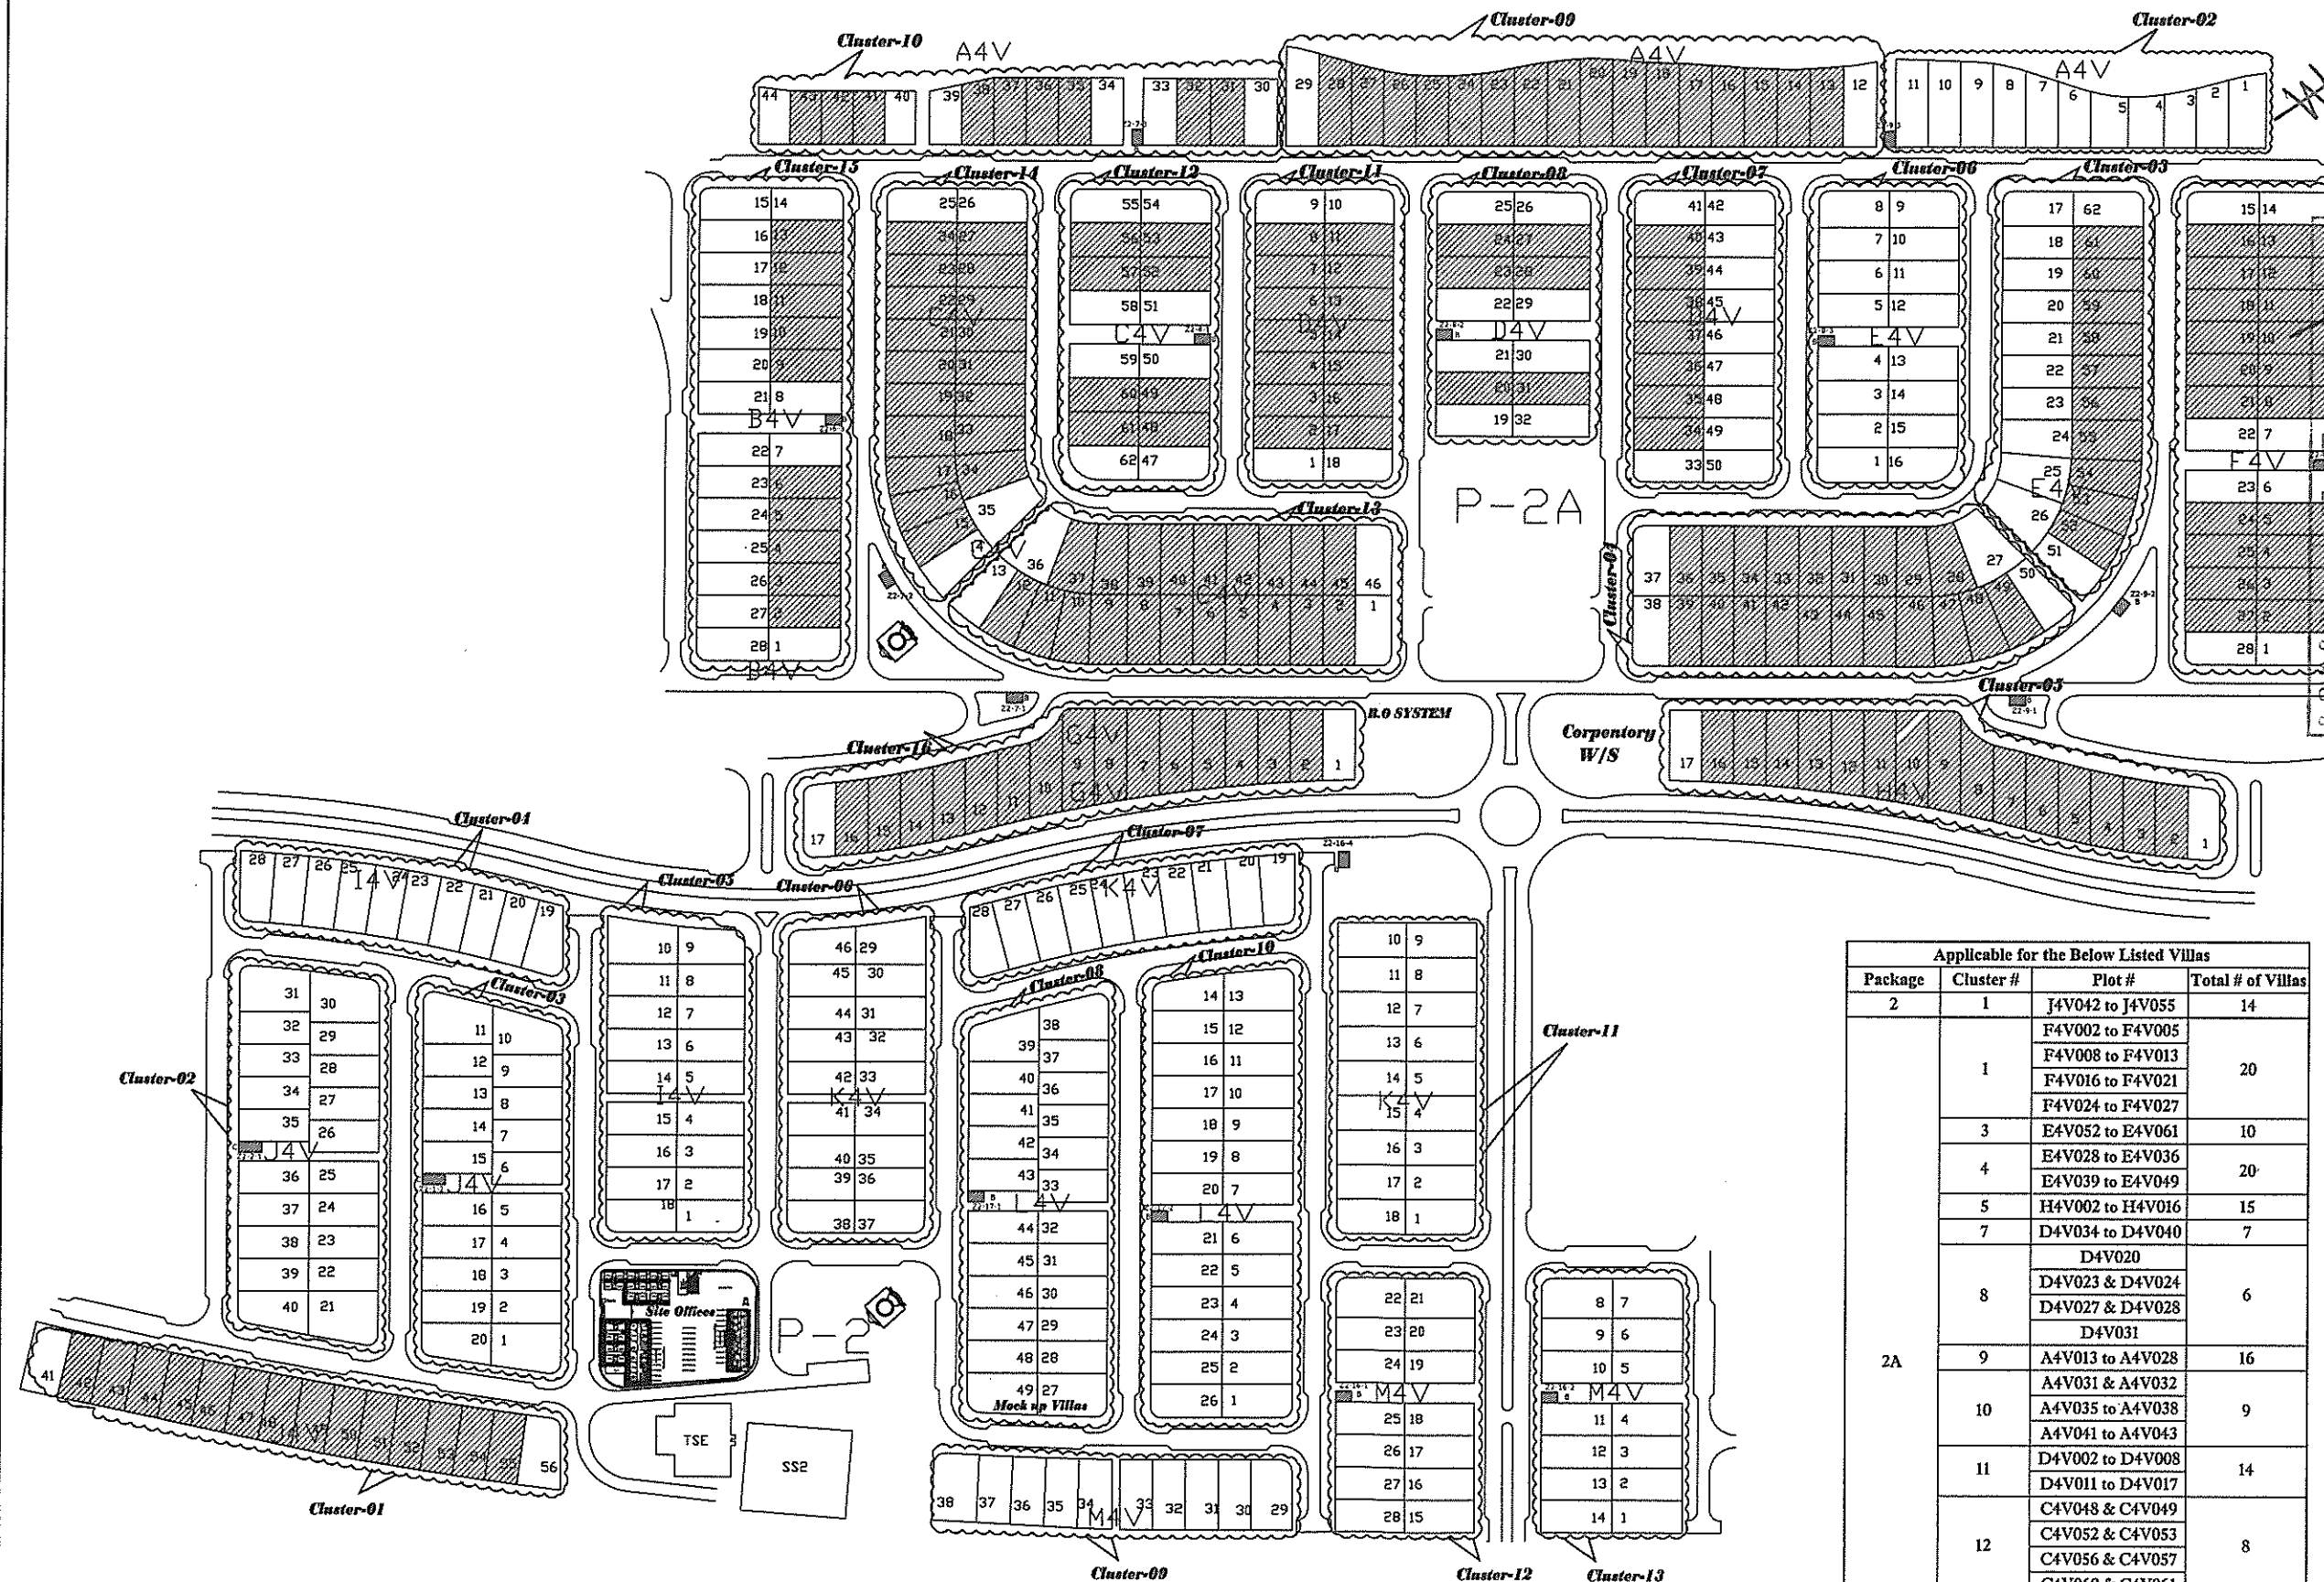

NOTES :-

- 1: ALL DIMENSIONS ARE IN MM UNLESS OTHERWISE INDICATED.
- 2: ALL LEVELS ARE IN METERS UNLESS OTHERWISE INDICATED.
- 3: DO NOT SCALE THE DRAWINGS FOLLOW THE WRITTEN DIMENSIONS ONLY.
- 4: ALL GRC WORKS MINIMUM THICKNESS OF THE SKIN IS 10 TO 12 MM THICK.

5: ALL GRC WORKS ARE WHITE SMOOTH FINISHED WITH S.S FITTINGS

CODE 1	APPROVED
CODE 2	APPROVED AS NOTED WORK MAY PROCEED SUBJECT TO THE INFORMATION OF ENDORSED COMMENTS
CODE 3	RESUBMIT FOR APPROVAL WORK MAY NOT PROCEED
CODE 4	REJECTED

DATE:

Approval shall not relieve the contractor of any of his obligations under the Contract or constitute authorization of change to Contract Documents or variation to the works. Contractor is responsible for dimensions, quantities and coordination with other trades.



Applicable for the Below Listed Villas			
Package	Cluster #	Plot #	Total # of Villas
2	1	J4V042 to J4V055	14
	1	F4V002 to F4V005	
	1	F4V008 to F4V013	20
	1	F4V016 to F4V021	
	1	F4V024 to F4V027	
	3	E4V052 to E4V061	10
	4	E4V028 to E4V036	20
	4	E4V039 to E4V049	
	5	H4V002 to H4V016	15
	7	D4V034 to D4V040	7
	8	D4V020	
	8	D4V023 & D4V024	6
	8	D4V027 & D4V028	
	8	D4V031	
2A	9	A4V013 to A4V028	16
	10	A4V031 & A4V032	
	10	A4V035 to A4V038	9
	10	A4V041 to A4V043	
	11	D4V002 to D4V008	14
	11	D4V011 to D4V017	
	12	C4V048 & C4V049	
	12	C4V052 & C4V053	8
	12	C4V056 & C4V057	
	12	C4V060 & C4V061	
	13	C4V002 to C4V012	20
	13	C4V037 to C4V045	
	14	C4V015 to C4V024	18
	14	C4V027 to C4V034	
	15	B4V002 to B4V006	10
	15	B4V009 to B4V013	
	16	G4V002 to G4V016	15
Total Villas			202 Villas

Deletion of G.R.C from the Both Side Elevation's (Ground Floor Only)

AS BUILT DWG

PROJECT:

**JUMEIRAH PARK
525-VILLAS
4V-REGIONAL**

CLIENT:

NAKHEEL
DEVELOPERS
15th LEVEL
P.O. BOX - 17777
DUBAI - UAE
TEL : 04-3800000
FAX : 04-3800000

SUBMITTING CONSULTANT:

dar al-handasah
architects and engineers

Main Contractor

Pauling Middle East

P.O. BOX: 40174, ABU DHABI, U.A.E.
PHONE : + 971 - 2 - 4579222
FAX : + 971 - 2 - 4579222
E-MAIL : pauling@pauling.com

SUB CONTRACTOR FOR G.R.C WORKS:


SPEED HOUSE
TEL: 7482929, P.O. BOX: 1461, ADHAN, U.A.E.
Fax: 56 743771 & email: speedhouse@speedhouse.com

CAD BY: S Khanl
CHECKED BY: RM
APPROVED BY: RM

DRAWING TITLE:

KEY PLAN LAYOUT

DWG NO: SH / PME / JP / AB / LE / GRC / 001A

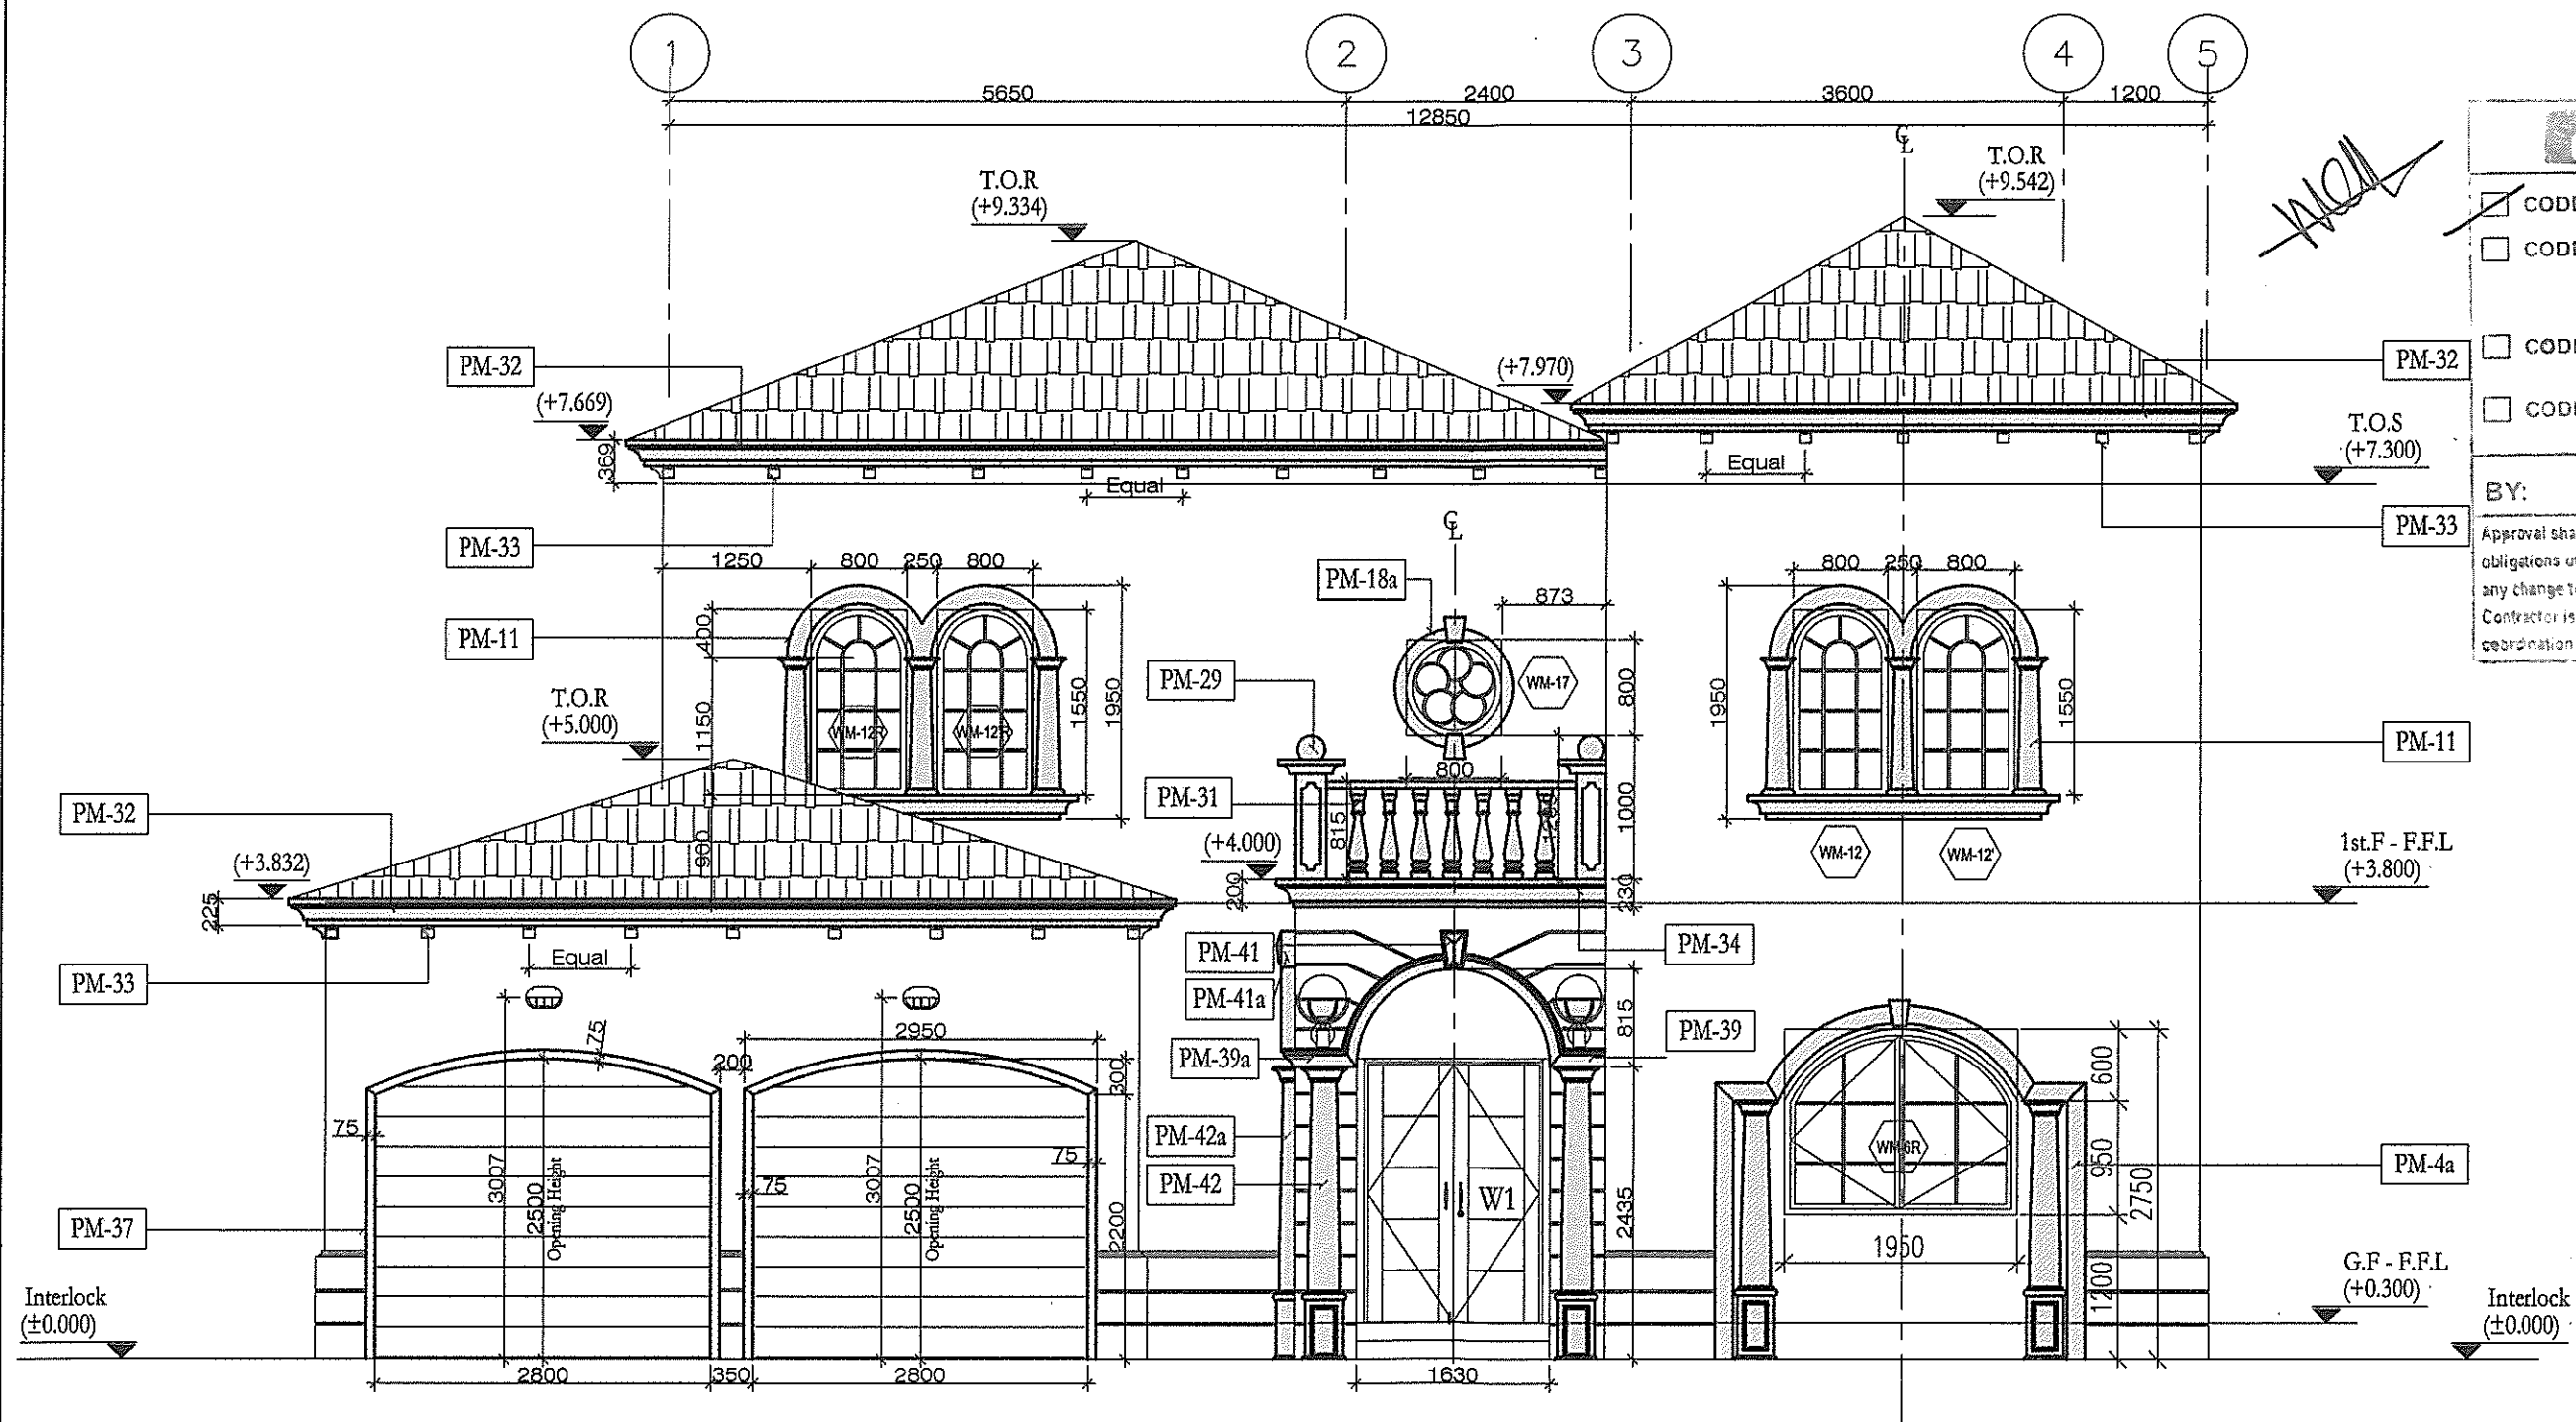

Front Elevation
Scale-N.T.C

NOTES :-

- 1: ALL DIMENSIONS ARE IN MM UNLESS OTHERWISE INDICATED.
- 2: ALL LEVELS ARE IN METERS UNLESS OTHERWISE INDICATED.
- 3: DO NOT SCALE THE DRAWINGS FOLLOW THE WRITTEN DIMENSIONS ONLY.
- 4: ALL GRC WORKS MINIMUM THICKNESS OF THE SKIN IS 10 TO 12 MM THICK.
- 5: ALL GRC WORKS ARE WHITE SMOOTH FINISHED WITH S.S FITTINGS

SHARIF PARTNERS
Sharif and Partners

☒ CODE

☐ CODE

☐ CODE

☐ CODE

BY:

Approval shall not relieve the contractor of any of his obligations under the Contract or constitute authorization of any change to Contract Documents or release the works. Contractor is responsible for dimensions, quantities and coordination with other trades.

APPROVED

APPROVED AS NOTED
WORK MAY PROCEED SUBJECT TO
INCORPORATION OF ENDORSED
COMMENTS

RESUBMIT FOR APPROVAL
WORK MAY NOT PROCEED

REJECTED

DATE:

RECEIVED
DAR AL HANDASAH
25 JUL 2012
PKG 2&2A

AS BUILT DWG

PROJECT:

**JUMEIRAH PARK
525-VILLAS**

CLIENT:

NAKHEEL
EMIRATES TOWERS
39th LEVEL
P.O. BOX - 17777
DUBAI - UAE
TEL : 04-3903318
FAX : 04-3903335

SUBMITTING CONSULTANT:

dar al-handasah
sharif and partners
architects - engineers - interior designers

Main Contractor

Pauling Middle East

P.O. BOX : 45174, ABU DHABI, U.A.E.
PHONE : + 971 - 2 - 6329222
FAX : + 971 - 2 - 6329233
E-MAIL : pauling@paulingme.com

SUB CONTRACTOR FOR GRC WORKS:


SPEED HOUSE
TEL : 04-3903318, P.O. BOX 1641, ABU DHABI, U.A.E.
Fax : 04-3903318, E-mail : speedhouse@speedhouse.com

CAD BY: S Khanl RM
CHECKED BY: RM
APPROVED BY: RM

DRAWING TITLE:

G.R.C. ELEVATION DETAILS

DWG NO: SH / PME / JP / AB / LE / GRC / 002A

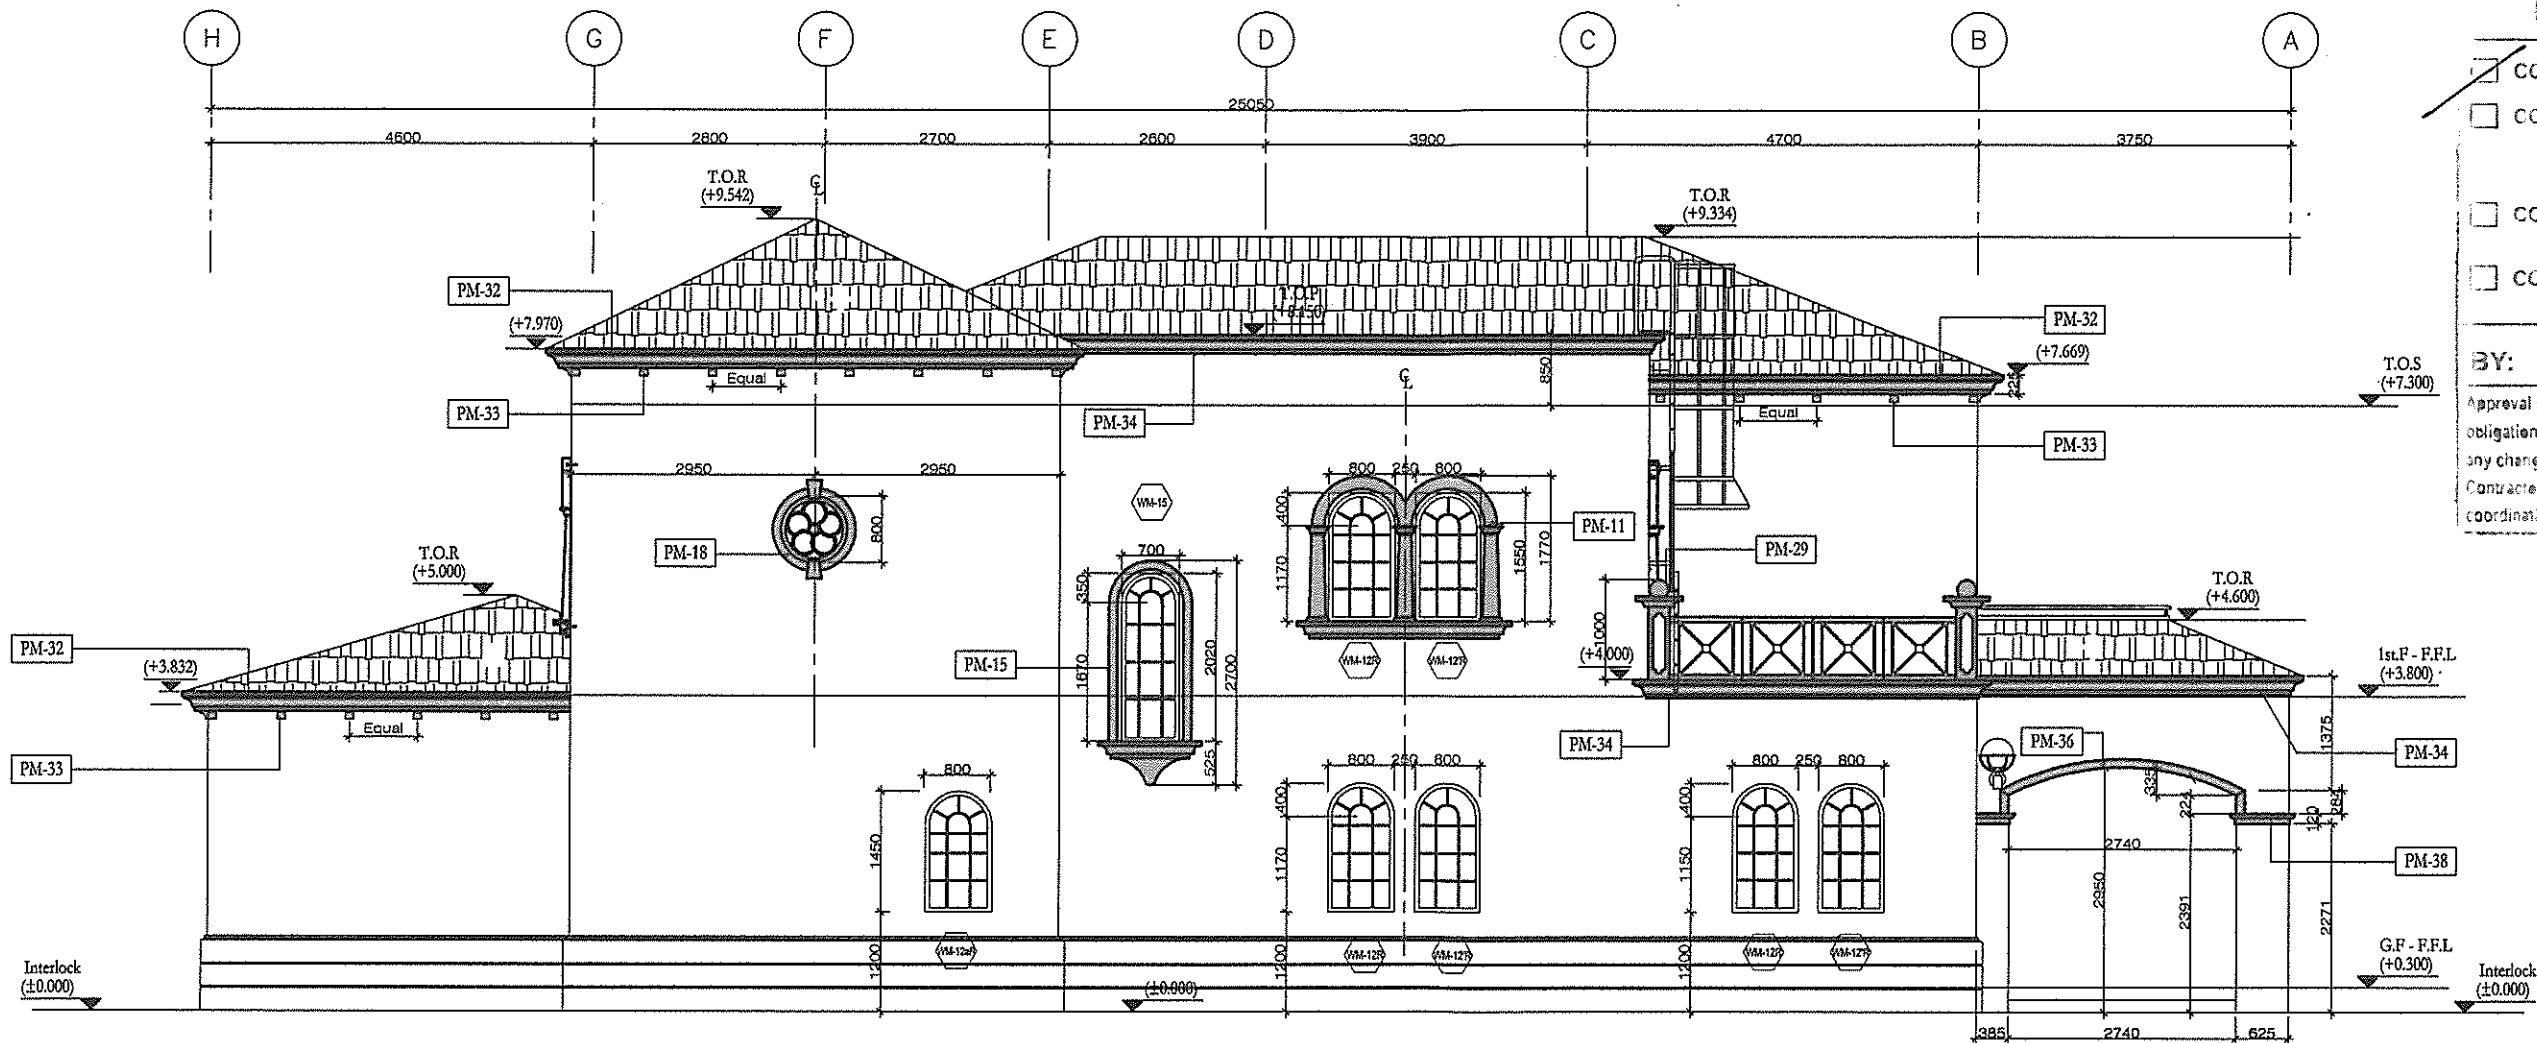

Right Elevation
Scale-N.T.C

NOTES :-

- 1 : ALL DIMENSIONS ARE IN MM UNLESS OTHERWISE INDICATED.
- 2 : ALL LEVELS ARE IN METERS UNLESS OTHERWISE INDICATED.
- 3 : DO NOT SCALE THE DRAWINGS FOLLOW THE WRITTEN DIMENSIONS ONLY.
- 4 : ALL GRC WORKS MINIMUM THICKNESS OF THE SKIN IS 10 TO 12 MM THICK.
- 5 : ALL GRC WORKS ARE WHITE SMOOTH FINISHED WITH S.S FITTINGS

dar al-handasah Shair and Partners	
☒ CODE 1	APPROVED
☐ CODE 2	APPROVED AS NOTED WORK MAY PROCEED SUBJECT TO INCORPORATION OF ENDORSED COMMENTS
☐ CODE 3	RESUBMIT FOR APPROVAL WORK MAY NOT PROCEED
☐ CODE 4	REJECTED
BY:	DATE:
Approval shall not relieve the contractor of any of his obligations under the Contract or constitute authorization of any change to Contract Document or variation to the works. Contractor is responsible for dimensions, quantities and coordination with other trades.	



AS BUILT DWG

PROJECT:
**JUMEIRAH PARK
525-VILLAS**

CLIENT:
NAKHEEL
EXHIBITS TOWER
15th LEVEL
P.O. BOX - 17777
DUBAI - UAE
TEL : 04-3903333
FAX : 04-3903333

SUBMITTING CONSULTANT:
dar al-handasah
shair and partners
ARCHITECTS - ENGINEERS - PLANNERS


Main Contractor
Pauling Middle East
P.O. BOX 14174, ABU DHABI, U.A.E.
PHONE : + 971 - 2 - 6329122
FAX : + 971 - 2 - 6325111
E-MAIL : pauling@middleeast.ae

SUB CONTRACTOR FOR GRC WORKS:
SH SPEED HOUSE
TEL: 742229 - P.O. BOX 1631, AJMAN, U.A.E.
Fax 06 7417774 email: shair@speedhouse.com

CAD BY	CHECKED BY	APPROVED BY
S Khand	RM	RM

DRAWING TITLE:
G.R.C. ELEVATION DETAILS

DWG NO:
SH / PME / JP / AB / LE / GRC / 003A

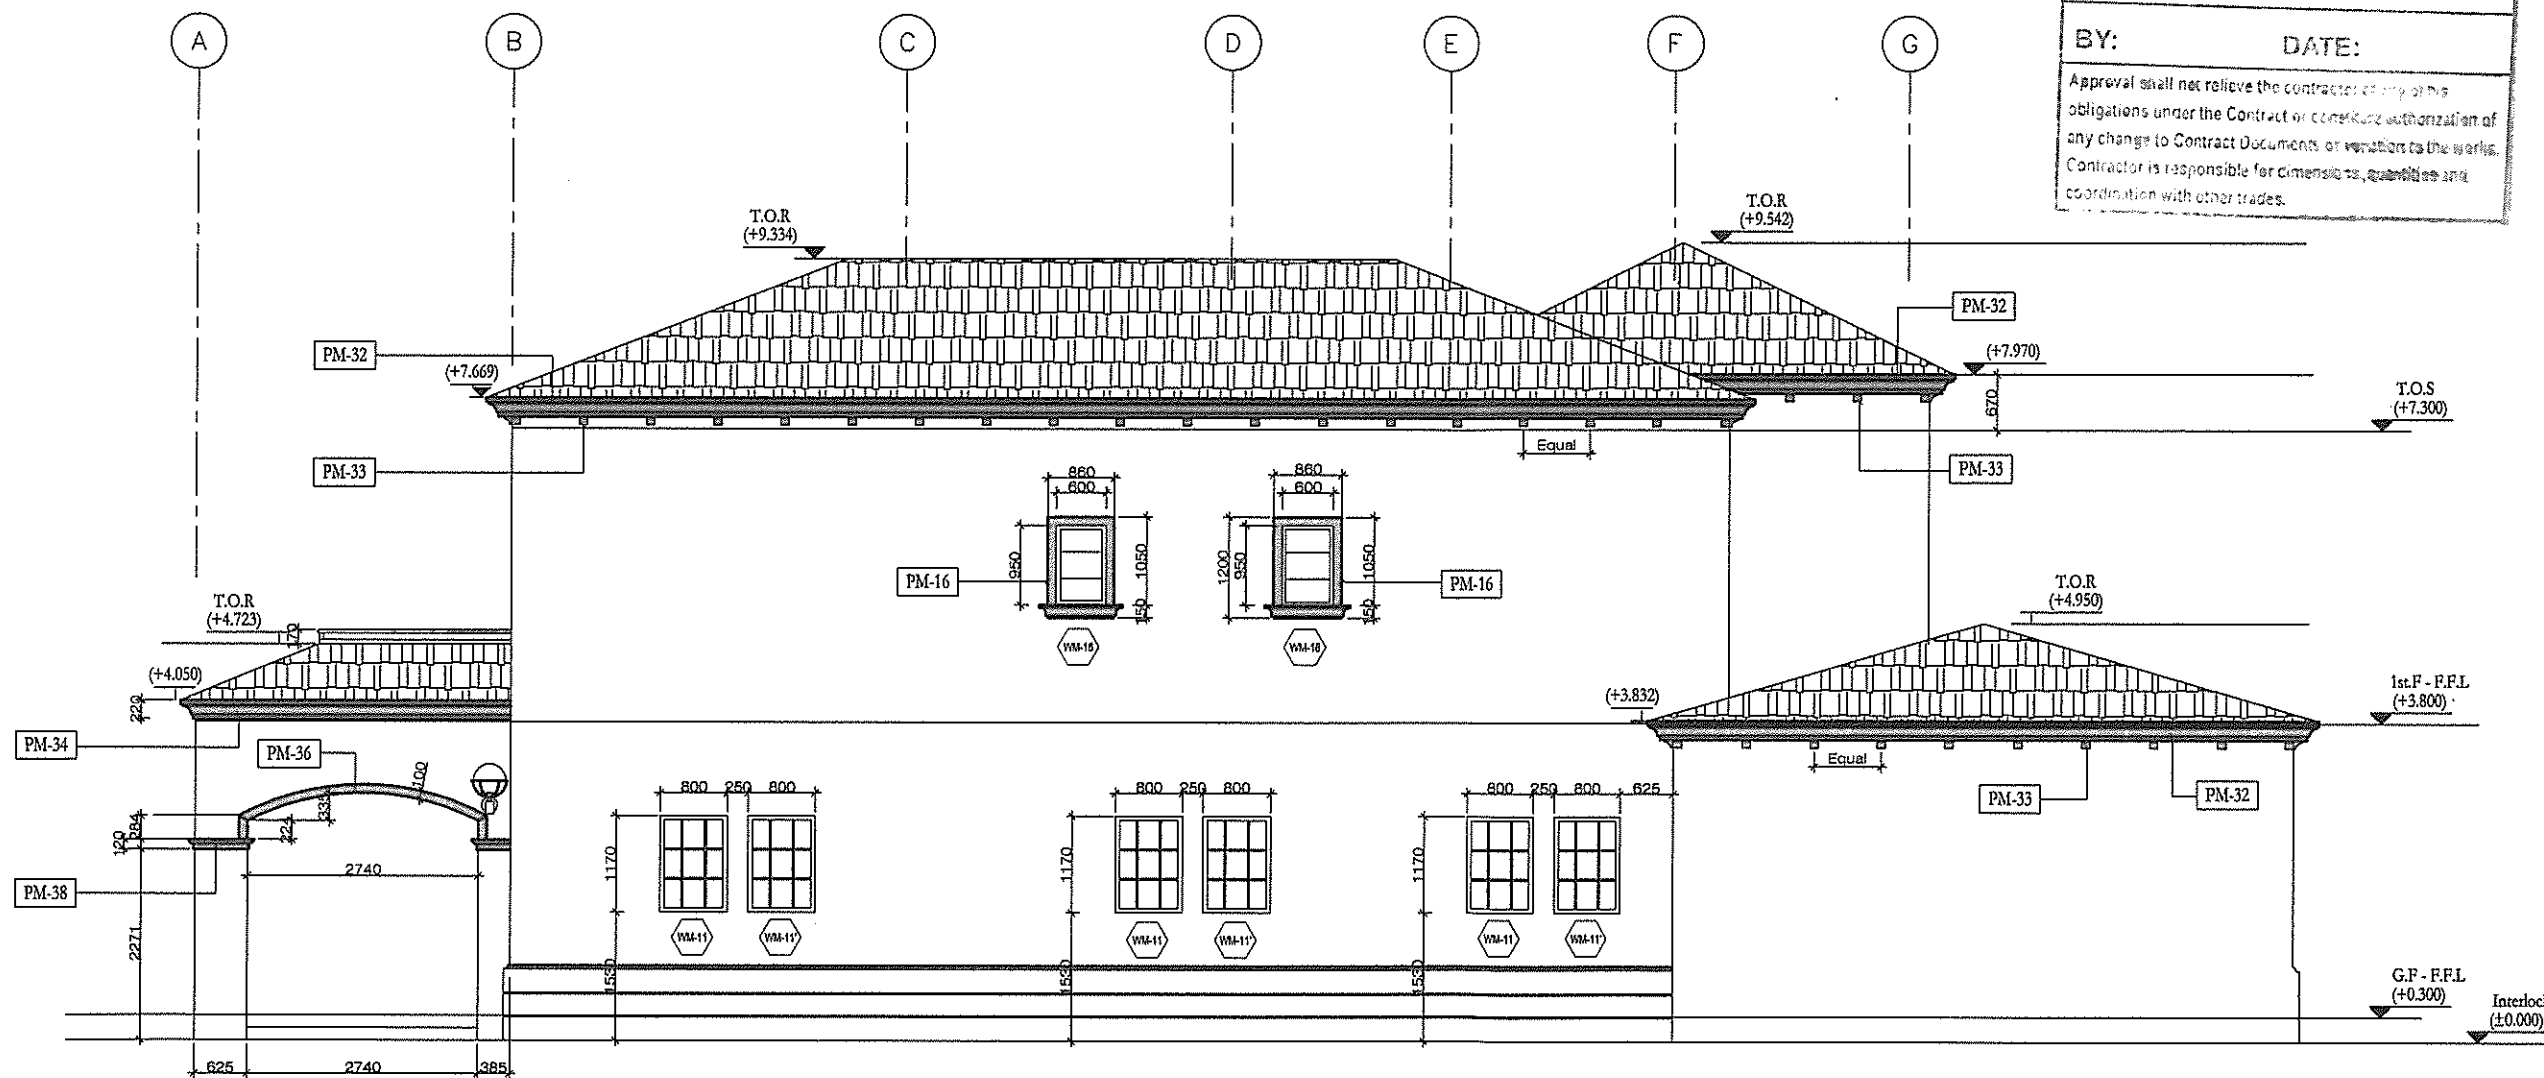

Left Elevation
Scale-N.T.C

dar al-handasah
Shair and Partners

☒ CODE 1 APPROVED

☐ CODE 2 APPROVED AS NOTED
WORK MAY PROCEED SUBJECT TO
INCORPORATION OF ENDORSED
COMMENTS

☐ CODE 3 RESUBMIT FOR APPROVAL
WORK MAY NOT PROCEED

☐ CODE 4 REJECTED

BY: _____ DATE: _____

Approval shall not relieve the contractor of any of his
obligations under the Contract or constitute authorization of
any change to Contract Documents or variation to the work.
Contractor is responsible for dimensions, quantities and
coordination with other trades.

NOTES :-

- 1 : ALL DIMENSIONS ARE IN MM UNLESS OTHERWISE INDICATED.
- 2 : ALL LEVELS ARE IN METERS UNLESS OTHERWISE INDICATED.
- 3 : DO NOT SCALE THE DRAWINGS FOLLOW THE WRITTEN DIMENSIONS ONLY.
- 4 : ALL GRC WORKS MINIMUM THICKNESS OF THE SKIN IS 10 TO 12 MM THICK.
- 5 : ALL GRC WORKS ARE WHITE SMOOTH FINISHED WITH S.S FITTINGS



AS BUILT DWG

PROJECT:
**JUMEIRAH PARK
525-VILLAS**

CLIENT:
NAKHEEL
EMIRATES TOWERS
18th LEVEL
P.O. BOX - 12777
DUBAI - UAE
TEL : 04-3903388
FAX : 04-3903335

SUBMITTING CONSULTANT:



Main Contractor

Pauling Middle East
P.O. BOX - 45116, ABU DHABI, U.A.E.
PHONE : + 971 - 2 - 4399222
FAX : + 971 - 2 - 4321533
E-MAIL : pauling@middleeast.ae


SUB CONTRACTOR FOR G.R.C WORKS:

SPEED HOUSE
TEL: 5422729 - P.O. BOX - 1631, ABU DHABI, U.A.E.
Fax: 06 7437714 - email: speedhouse@speedhouse.ae

CAD BY	CHECKED BY	APPROVED BY
S Khami	RM	RM

DRAWING TITLE:
G.R.C. ELEVATION DETAILS

DWG NO:
SH / PME / JP / AB / LE / GRC / 004A

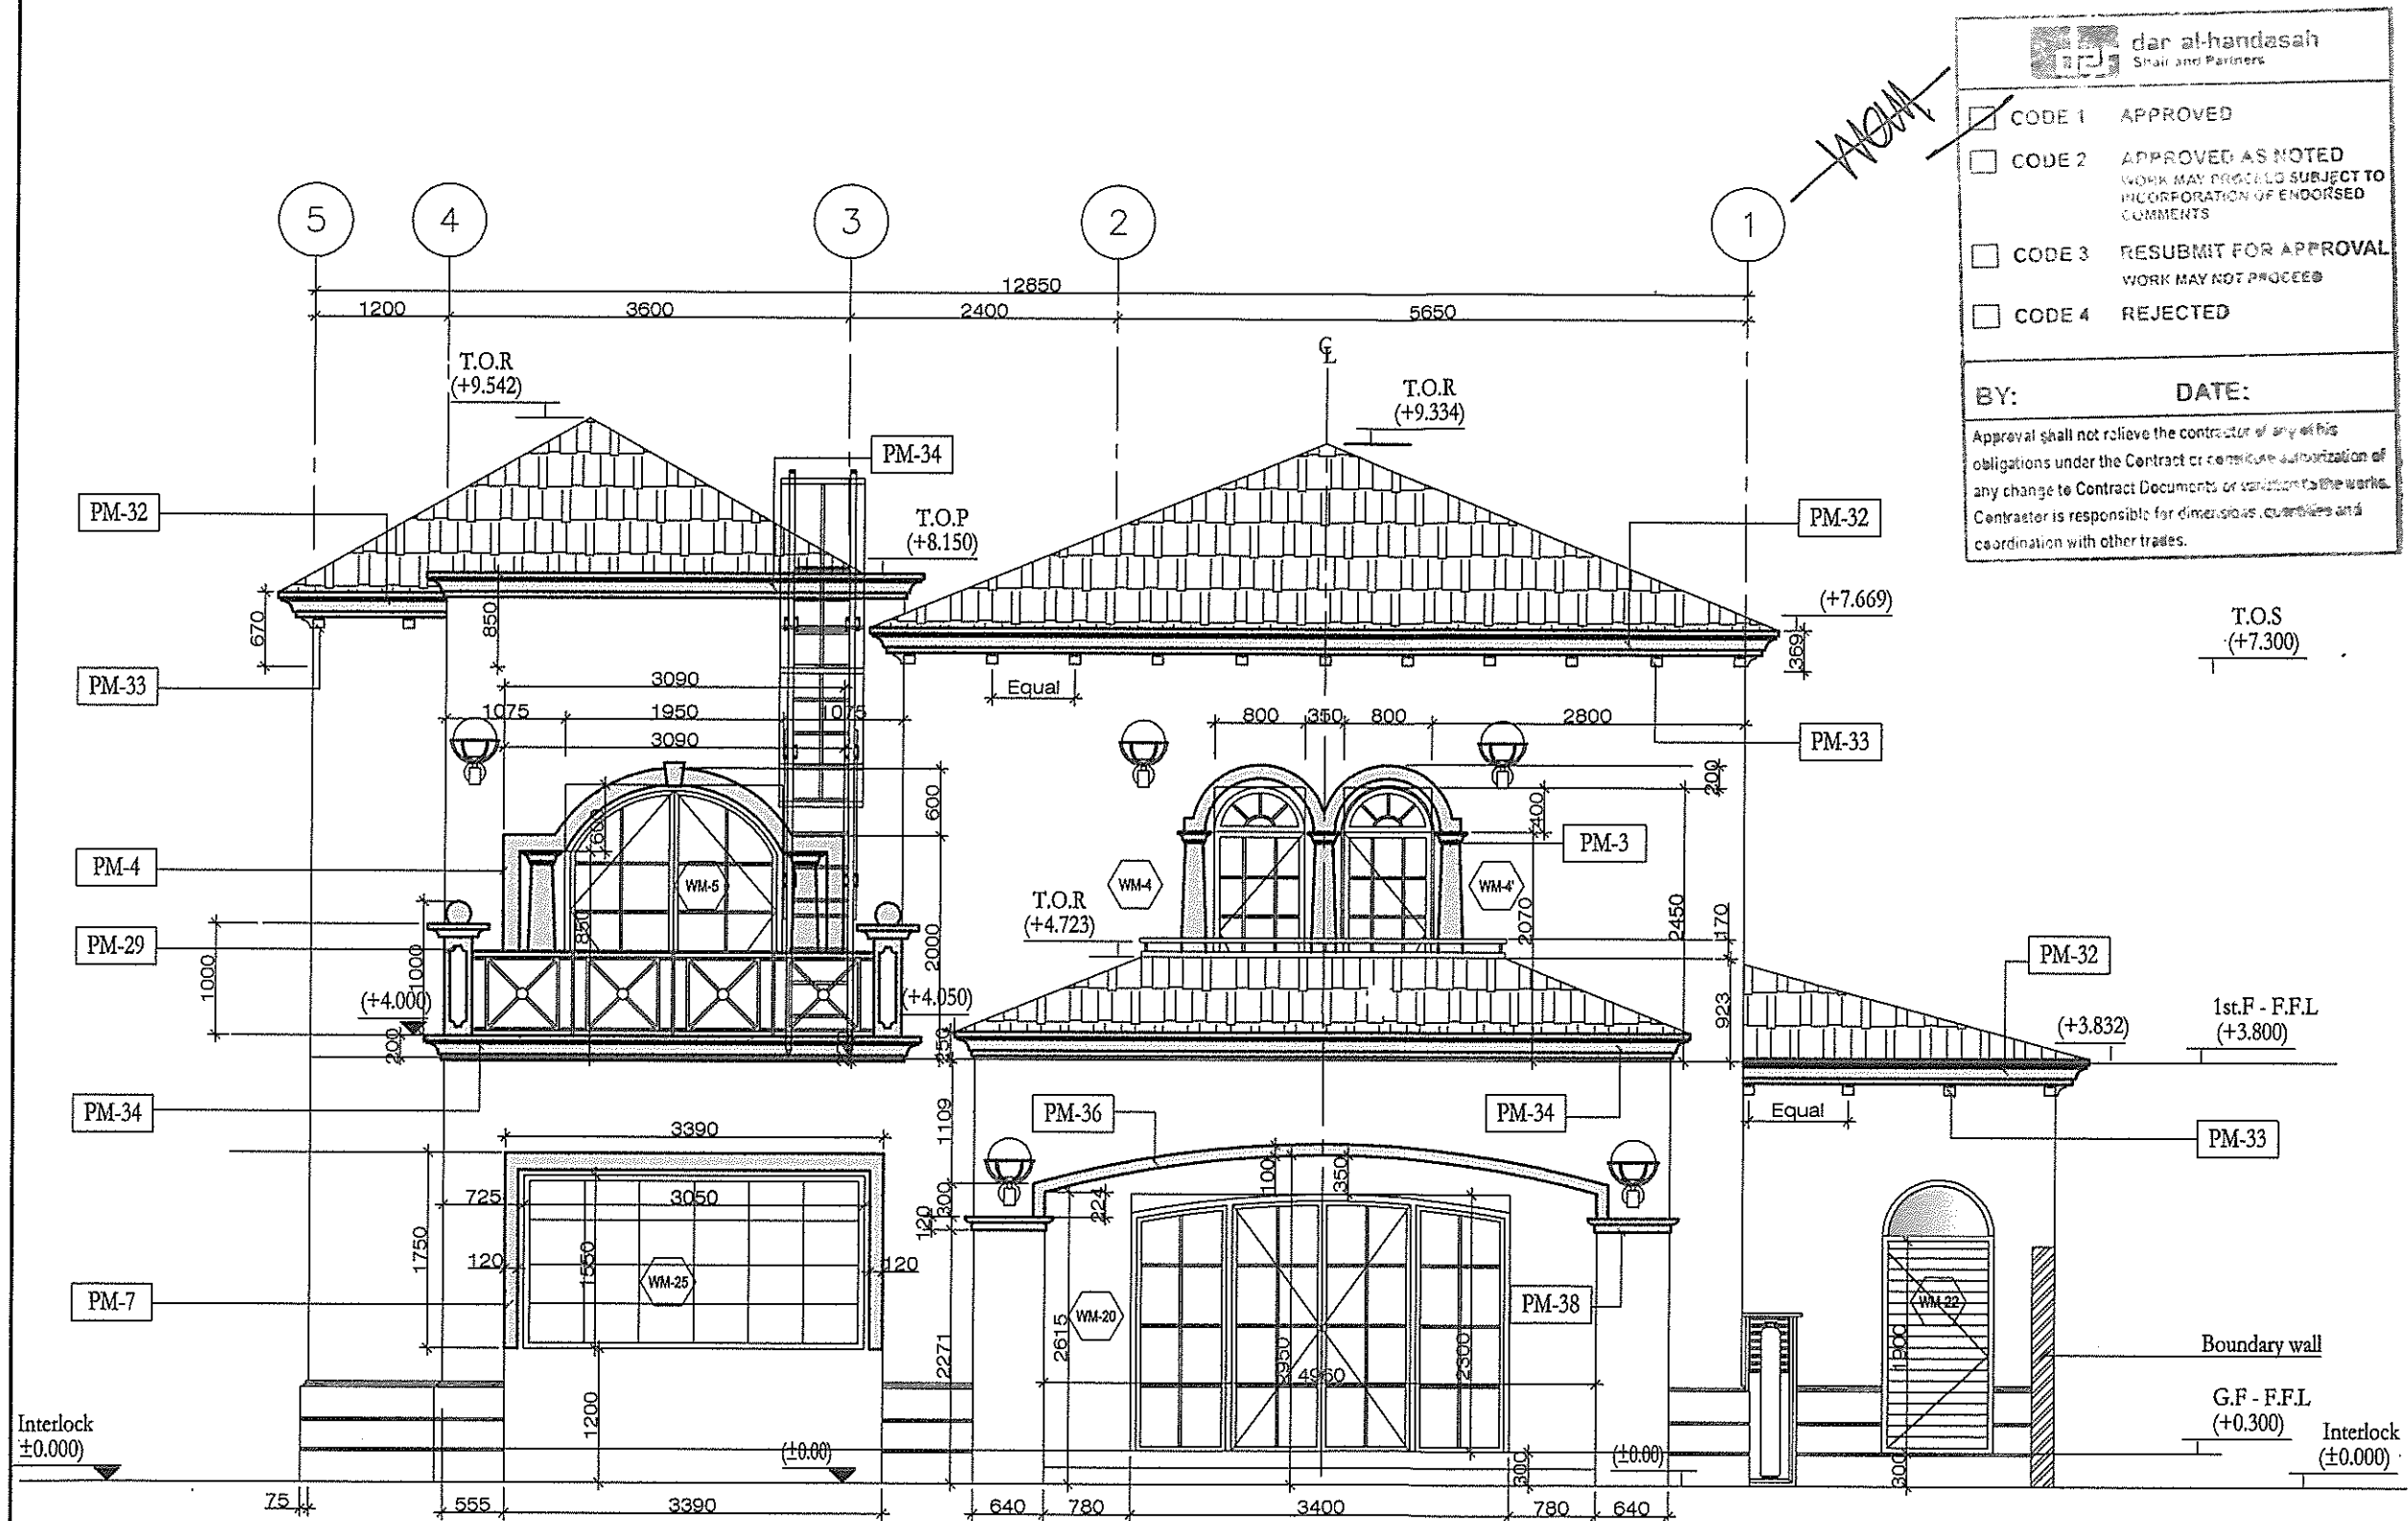

Back Elevation
Scale-N.T.C

dar al-handasah
Shair and Partners

☐ CODE 1 APPROVED

☐ CODE 2 APPROVED AS NOTED
WORK MAY PROCEED SUBJECT TO
INCORPORATION OF ENDORSED
COMMENTS

☐ CODE 3 RESUBMIT FOR APPROVAL
WORK MAY NOT PROCEED

☐ CODE 4 REJECTED

BY: _____ DATE: _____

Approval shall not relieve the contractor of any of his
obligations under the Contract or certificate authorization of
any change to Contract Documents or variations to the work.
Contractor is responsible for dimensions, quantities and
coordination with other trades.

- NOTES :-**
- 1: ALL DIMENSIONS ARE IN MM UNLESS OTHERWISE INDICATED.
 - 2: ALL LEVELS ARE IN METERS UNLESS OTHERWISE INDICATED.
 - 3: DO NOT SCALE THE DRAWINGS FOLLOW THE WRITTEN DIMENSIONS ONLY.
 - 4: ALL GRC WORKS MINIMUM THICKNESS OF THE SKIN IS 10 TO 12 MM THICK.
 - 5: ALL GRC WORKS ARE WHITE SMOOTH FINISHED WITH S.S FITTINGS



AS BUILT DWG

PROJECT:
**JUMEIRAH PARK
525-VILLAS**

CLIENT: **NAKHEEL**
DUBAI TRADING
15th LEVEL
P.O. BOX - 1777
DUBAI - UAE
TEL : 04-3903388
FAX : 04-3903355

SUBMITTING CONSULTANT:
dar al-handasah
shair and partners





Main Contractor
Pauling Middle East
P.O. BOX: 41176, ADU DHABI, U.A.E.
PHONE : + 971 - 2 - 4329722
FAX : + 971 - 2 - 4329553
E-MAIL : pauling@middleeast.ae

SUB CONTRACTOR FOR G.R.C WORKS:
SPEED HOUSE
TEL: 7462277, P.O. BOX: 1651, ADHAN, U.A.E.
Fax: 04 7437771, e-mail: speedhouse@speedhouse.com



CAD BY: S Khani CHECKED BY: RM APPROVED BY: RM

DRAWING TITLE:
G.R.C. ELEVATION DETAILS

DWG NO:
SH / PME / JP / AB / LE / GRC / 005A

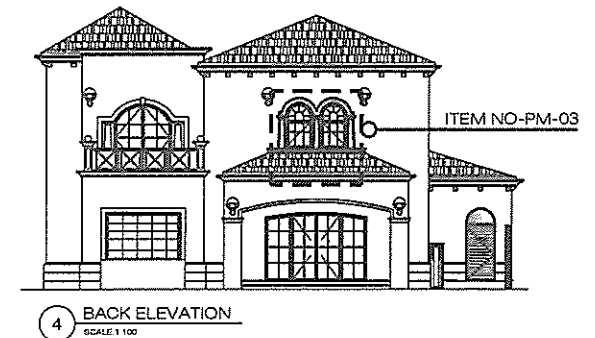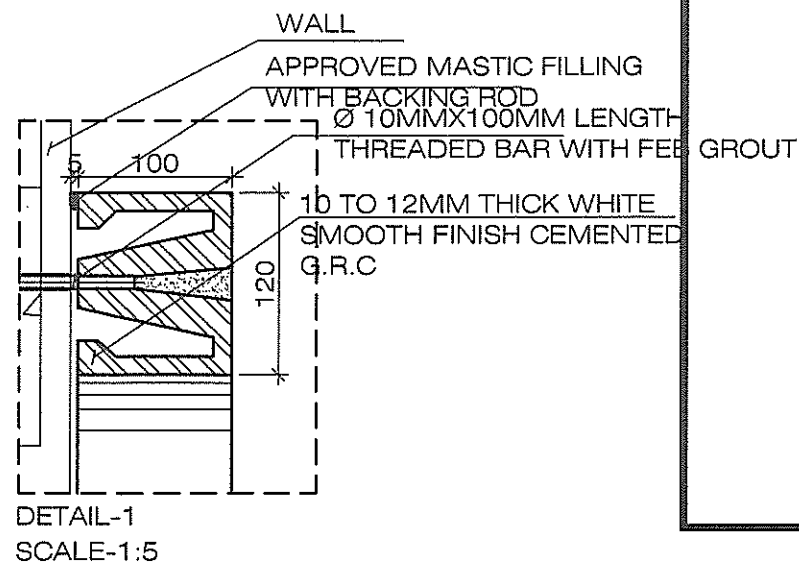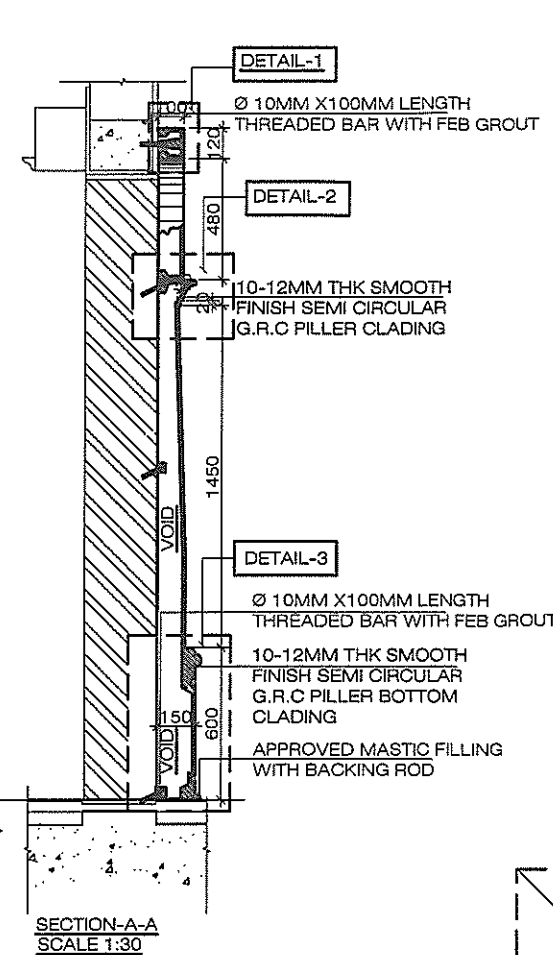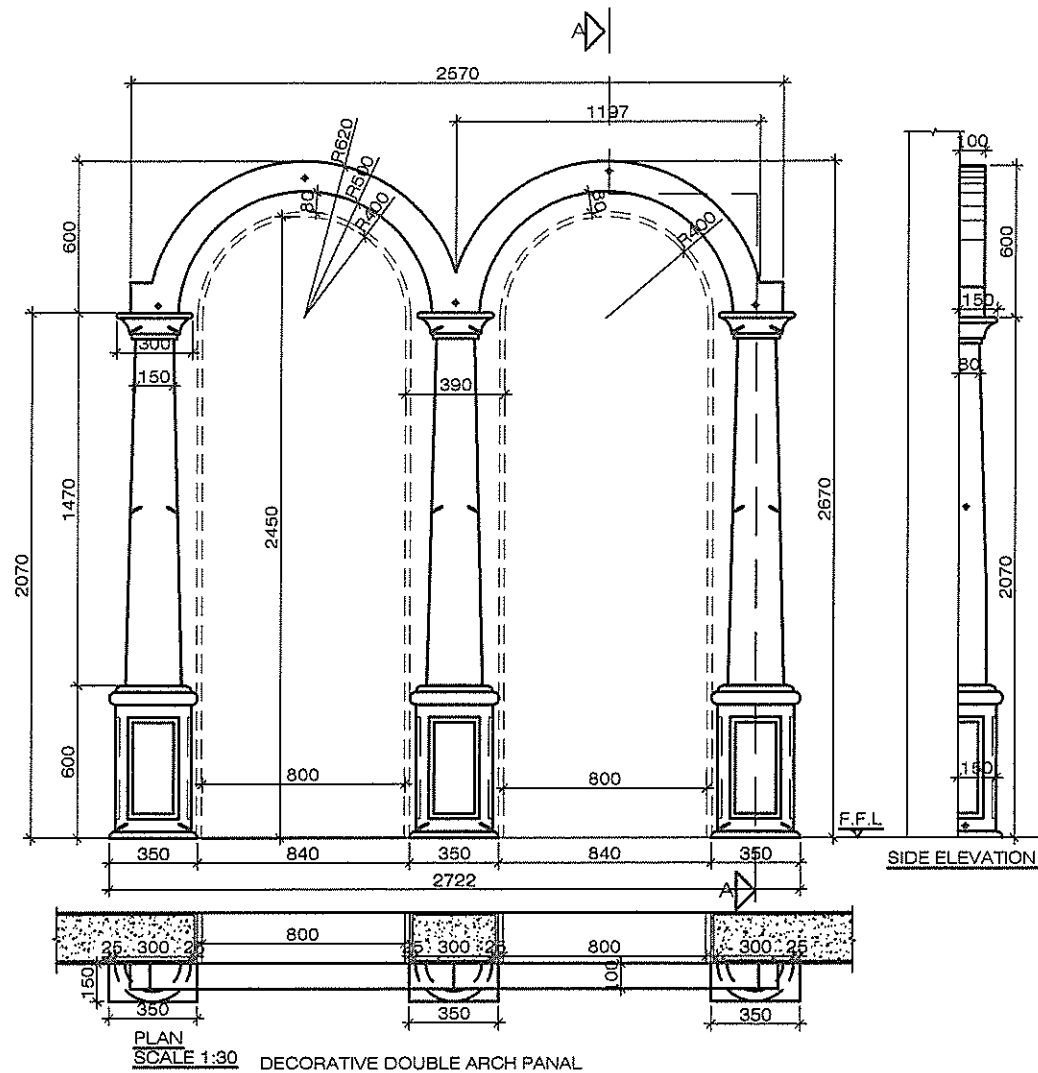

ITEM NO PM-03

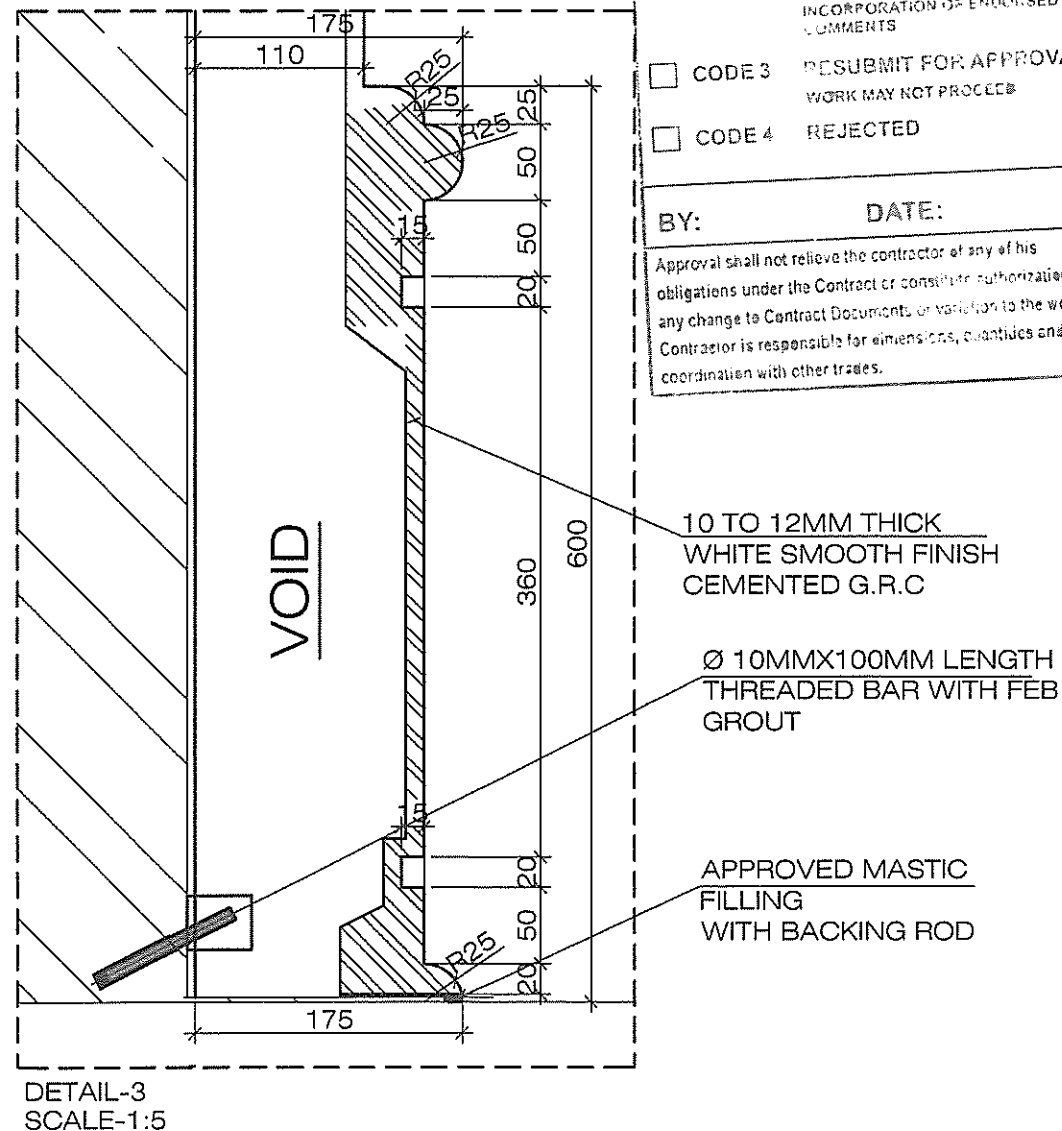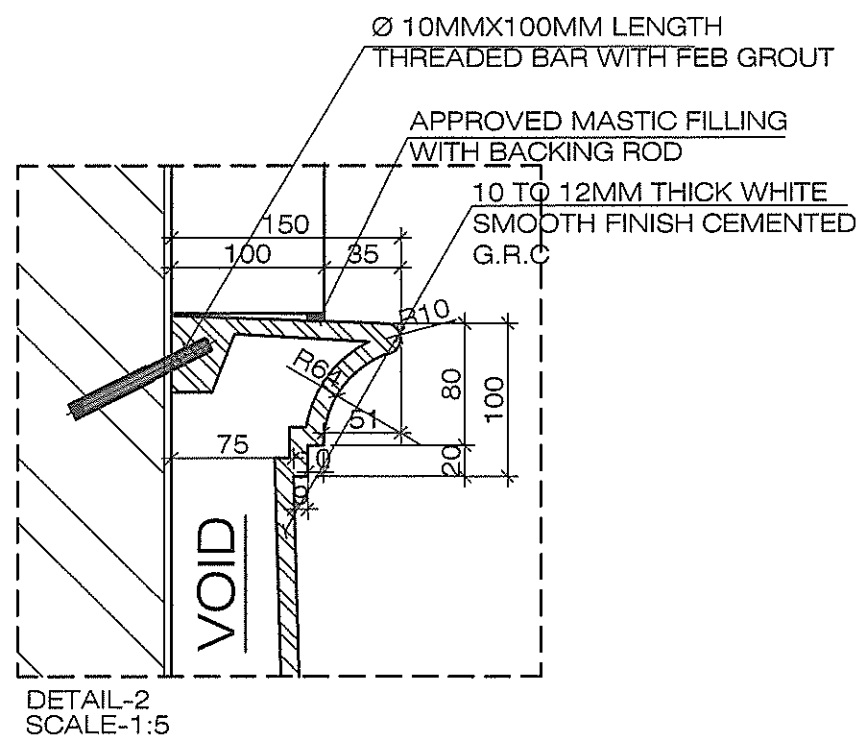

dar al-handasah
Shair and Partners

CODE 1 APPROVED

CODE 2 APPROVED AS NOTED
WORK MAY PROCEED SUBJECT TO
INCORPORATION OF ENDORSED
COMMENTS

CODE 3 RESUBMIT FOR APPROVAL
WORK MAY NOT PROCEED

CODE 4 REJECTED

BY: DATE:

Approval shall not relieve the contractor of any of his
obligations under the Contract or constitute authorization of
any change to Contract Documents or variation to the works.
Contractor is responsible for dimensions, quantities and
coordination with other trades.

- NOTES :-
- 1: ALL DIMENSIONS ARE IN MM UNLESS OTHERWISE INDICATED.
 - 2: ALL LEVELS ARE IN METERS UNLESS OTHERWISE INDICATED.
 - 3: DO NOT SCALE THE DRAWINGS FOLLOW THE WRITTEN DIMENSIONS ONLY.
 - 4: ALL GRC WORKS MINIMUM THICKNESS OF THE SKIN IS 10 TO 12 MM THICK.
 - 5: ALL GRC WORKS ARE WHITE SMOOTH FINISHED WITH S.S FITTINGS



AS BUILT DWG

PROJECT:
**JUMEIRAH PARK
525-VILLAS
4V-LEGACY**

CLIENT:
NAKHEEL
EMIRATES TOWERS
15th LEVEL
P.O. BOX - 17777
DUBAI - UAE
TEL : 04-3933388
FAX : 04-3933355

SUBMITTING CONSULTANT:
dar al-handasah
shair and partners
DUBAI - EMIRATES - U.A.E.


Main Contractor
Pauling Middle East
P.O. BOX 145125, ABU DHABI, U.A.E.
PHONE : + 971 - 2 - 6329222
FAX : + 971 - 2 - 6329222
E-MAIL : pauling1@comstar.ae

SUB CONTRACTOR FOR GRC WORKS:
SH SPEED HOUSE
TEL: 7462229 - P.O. BOX 1451, ADHAN, U.A.E.
Fax 7437714 - email: hennocppal@speedhouse.com




CAD BY: S Khanl
CHECKED BY: RM
APPROVED BY: RM

DRAWING TITLE:
ITEM NO PM-03

DWG NO:
SH / PME / JP / AB / LE / GRC / 006A

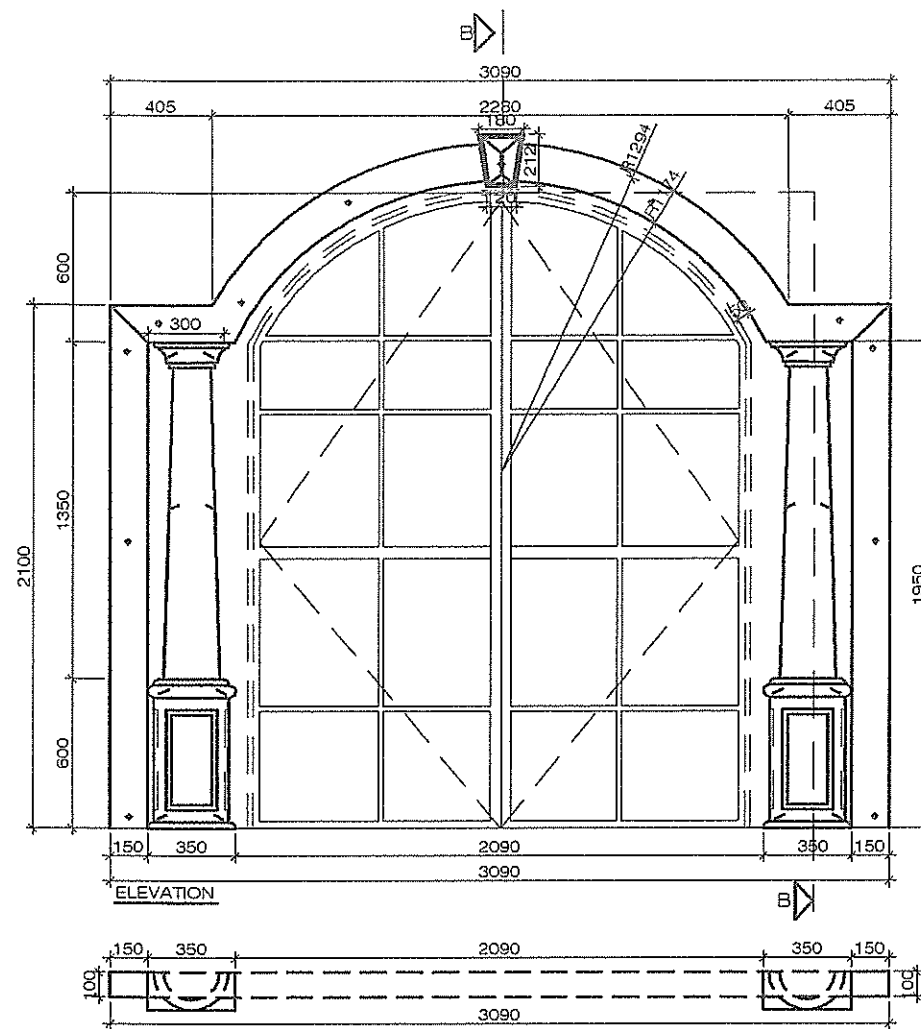

SIDE ELEVATION

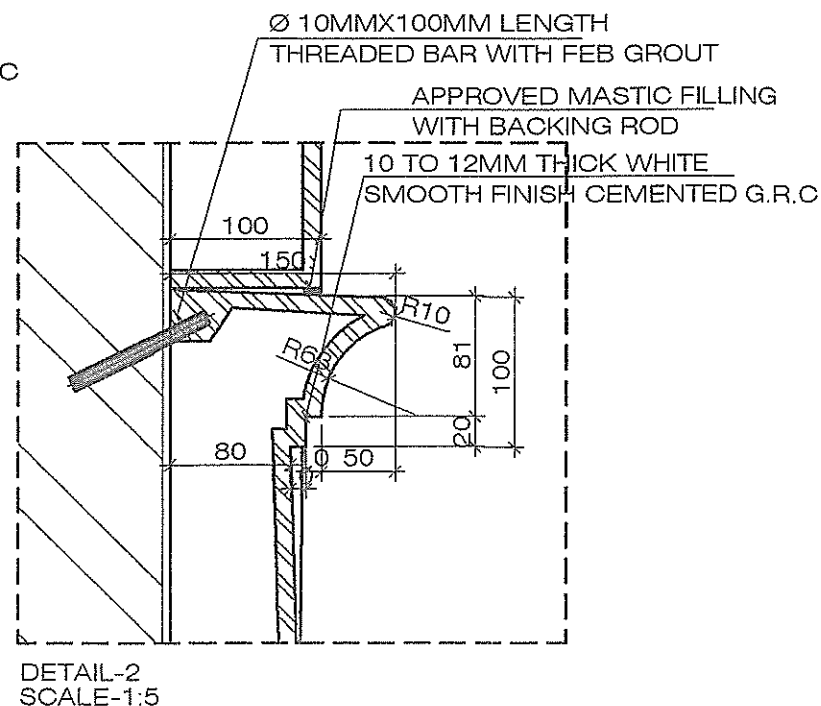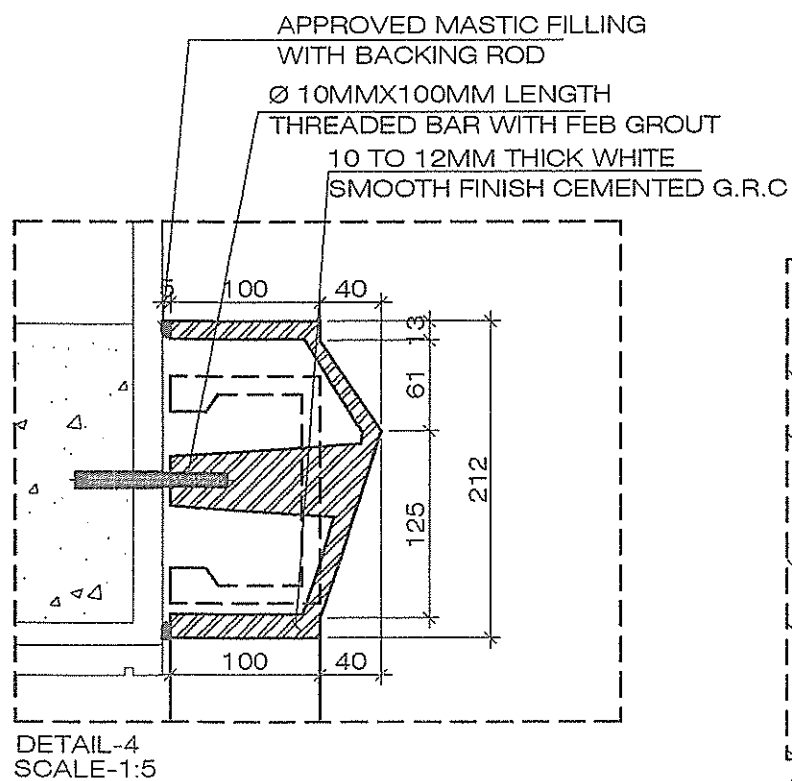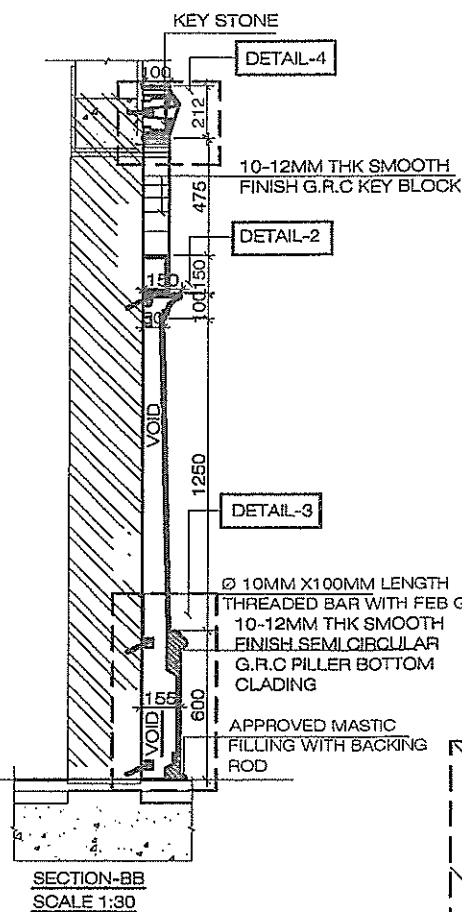


Applicable for the Below Listed Villas			
Package	Cluster #	Plot #	Total # of Villas
2A	1	J4V042 to J4V055	14
		F4V002 to F4V005	
		F4V008 to F4V013	20
		F4V016 to F4V021	
		F4V024 to F4V027	
		E4V018 to E4V025	10
		E4V028 to E4V035	20
		B4V039 to B4V049	
		H4V002 to H4V016	15
		H4V024 to H4V040	7
		D4V020	
		D4V023 to D4V024	
		D4V027 to D4V028	6
		D4V031	
		A4V013 to A4V028	16
		A4V031 to A4V032	
	A4V035 to A4V038	9	
	A4V041 to A4V043		
	D4V002 to D4V008	14	
	D4V011 to D4V017		
C4V048 to C4V049			
C4V052 to C4V053	8		
C4V056 to C4V057			
C4V060 to C4V061			
C4V002 to C4V012			
C4V037 to C4V045	20		
C4V015 to C4V024			
C4V027 to C4V034	18		
B4V002 to B4V006			
B4V009 to B4V013	10		
G4V002 to G4V016	15		
Total Villas			202 Villas



NOTES :

- 1: ALL DIMENSIONS ARE IN MM UNLESS OTHERWISE INDICATED.
- 2: ALL LEVELS ARE IN METERS UNLESS OTHERWISE INDICATED.
- 3: DO NOT SCALE THE DRAWINGS FOLLOW THE WRITTEN DIMENSIONS ONLY.
- 4: ALL GRC WORKS MINIMUM THICKNESS OF THE SKIN IS 10 TO 12 MM THICK.
- 5: ALL GRC WORKS ARE WHITE SMOOTH FINISHED WITH S.S FITTINGS

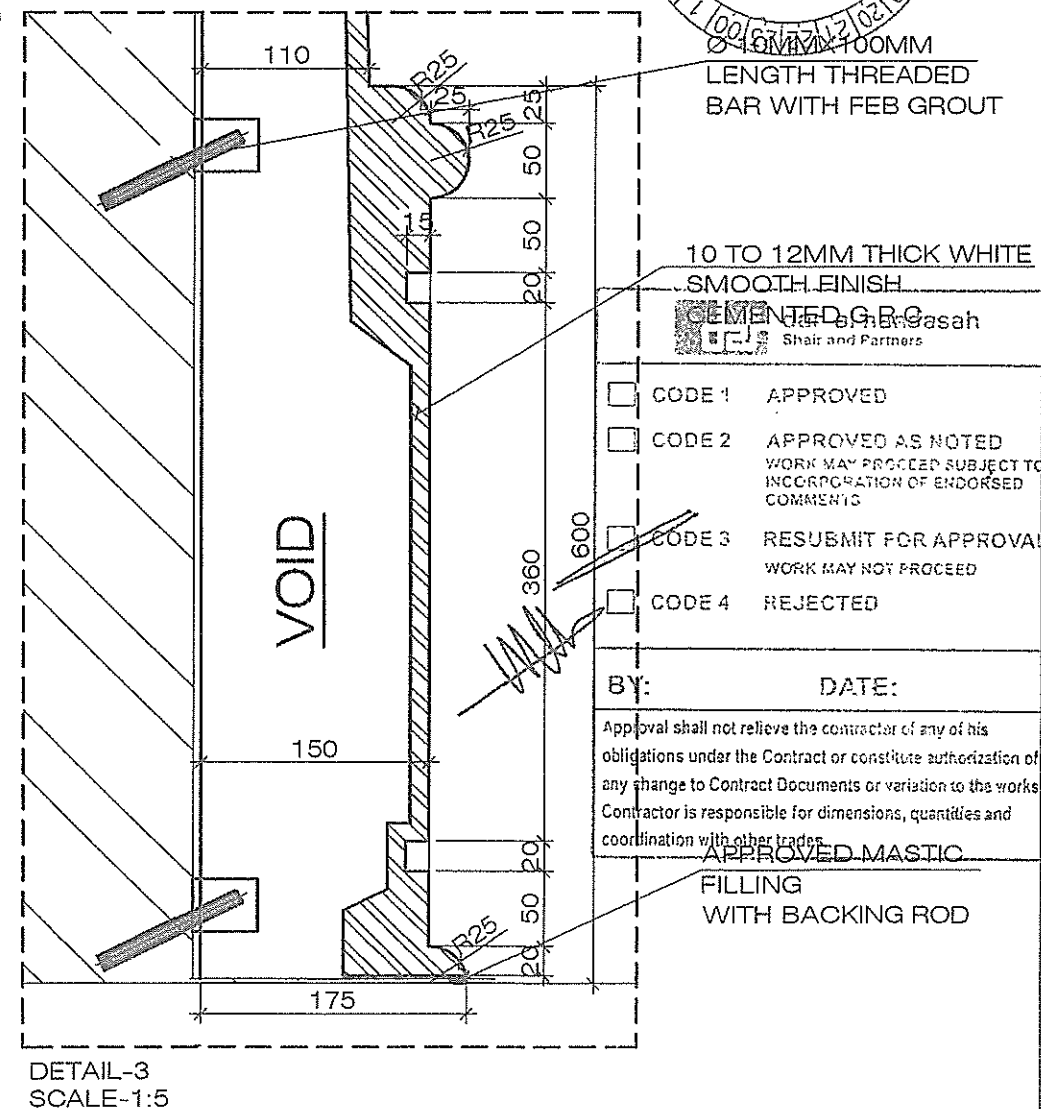

AS BUILT DWG

PROJECT:
**JUMEIRAH PARK
525-VILLAS
4V-LEGASY**

CLIENT:
NAKHEEL
EMIRATES TRADING
JSC. LEVEL
P.O. BOX - 31177
DUBAI - U.A.E.
TEL : 04-3502318
FAX : 04-3502355

SUBMITTING CONSULTANT:
dar al-handasah
shair and partners
P.O. BOX - 145176, ABU DHABI, U.A.E.
TEL : 02-4022229 - P.O. BOX 145176, ABU DHABI, U.A.E.
FAX : 02-4022229 - P.O. BOX 145176, ABU DHABI, U.A.E.






Main Contractor
Pauling Middle East
P.O. BOX 145176, ABU DHABI, U.A.E.
TEL : 02-4022229 - P.O. BOX 145176, ABU DHABI, U.A.E.
FAX : 02-4022229 - P.O. BOX 145176, ABU DHABI, U.A.E.

SUBCONTRACTOR FOR GRC WORKS:
SPEED HOUSE
TEL : 04-3502318 - P.O. BOX 145176, ABU DHABI, U.A.E.
FAX : 04-3502355 - P.O. BOX 145176, ABU DHABI, U.A.E.


CAD BY: S Khani
CHECKED BY: RM
APPROVED BY: RM

DRAWING TITLE:
ITEM NO PM-04

DWG NO: SH / PME / JP / AB / LE / GRC / 007A

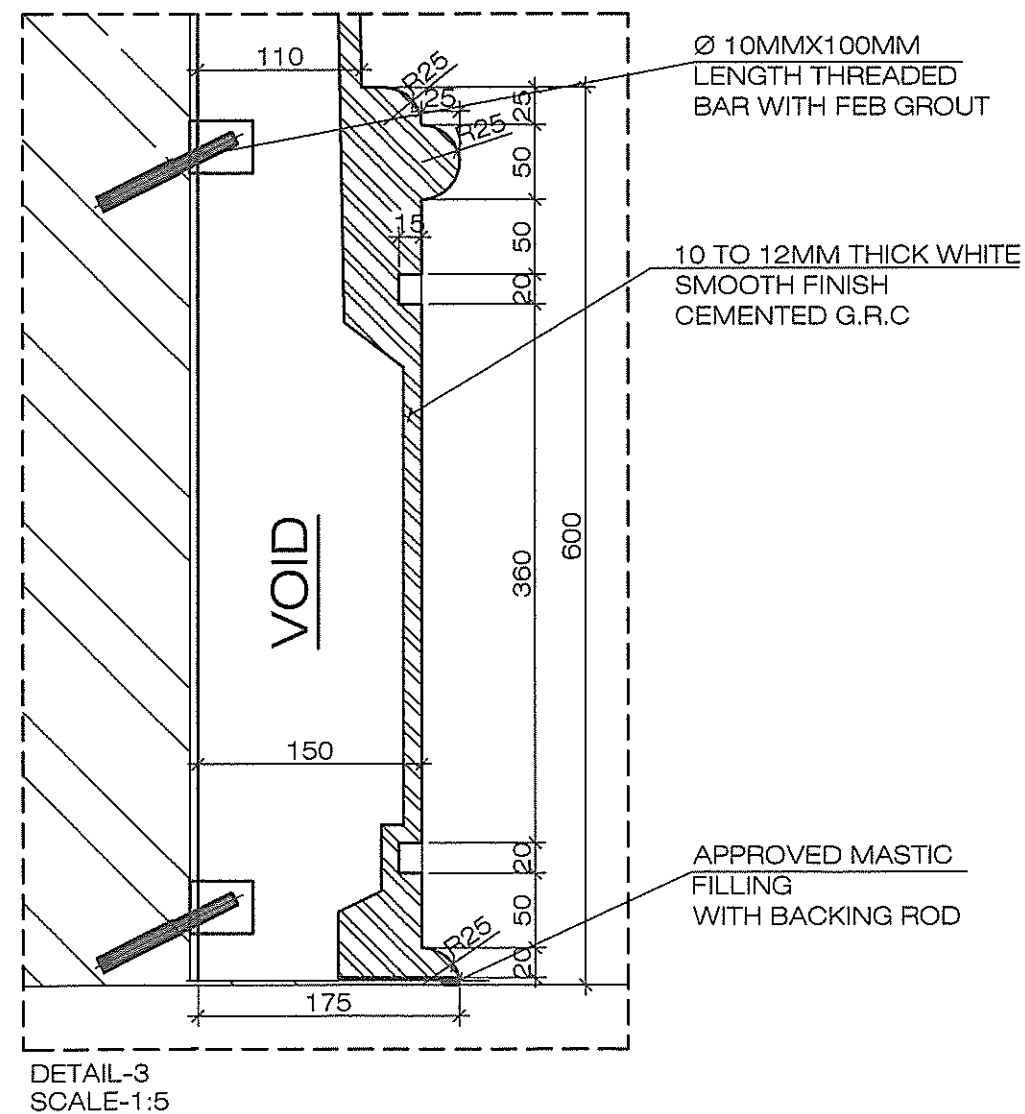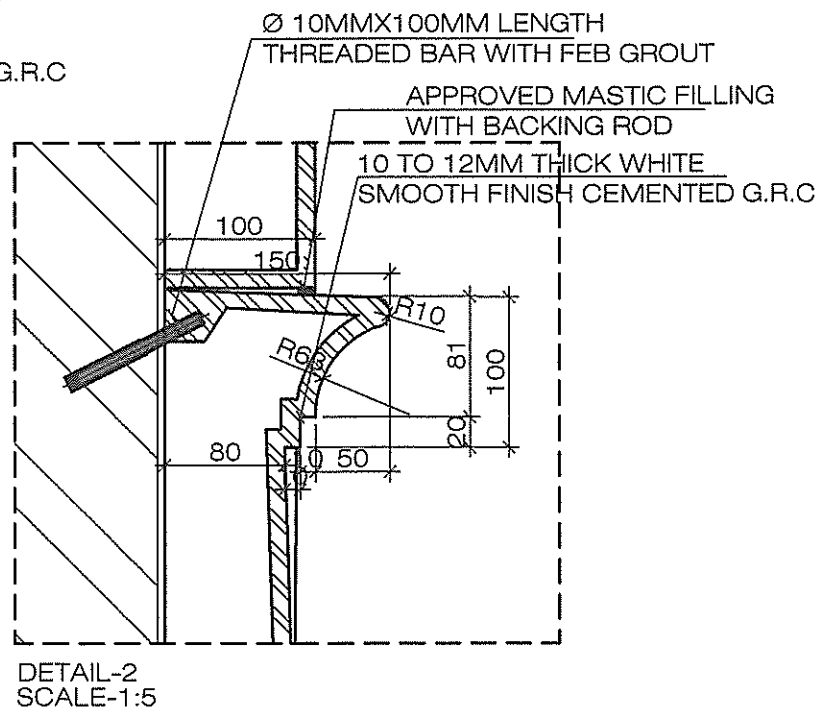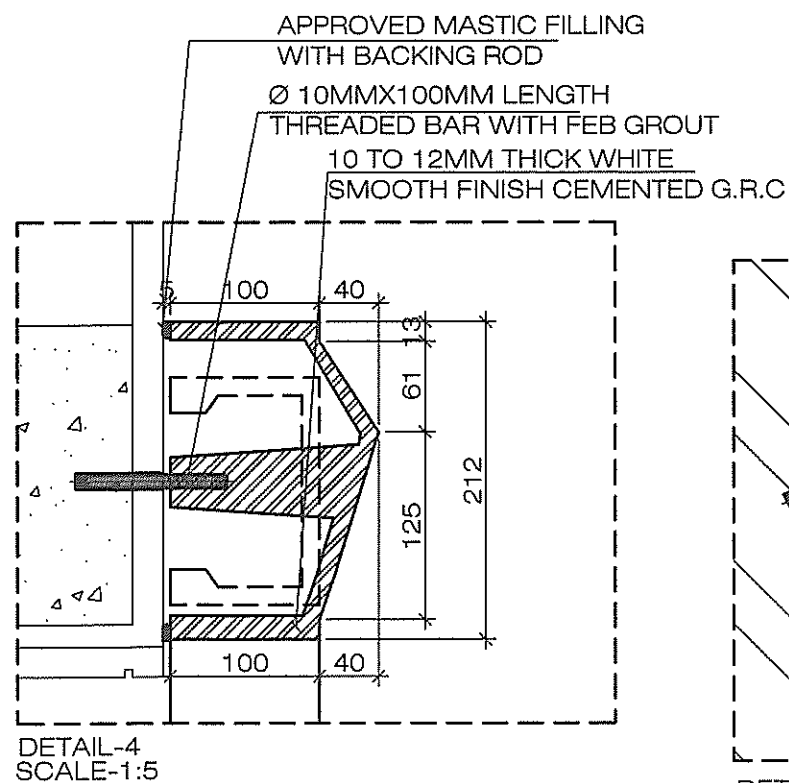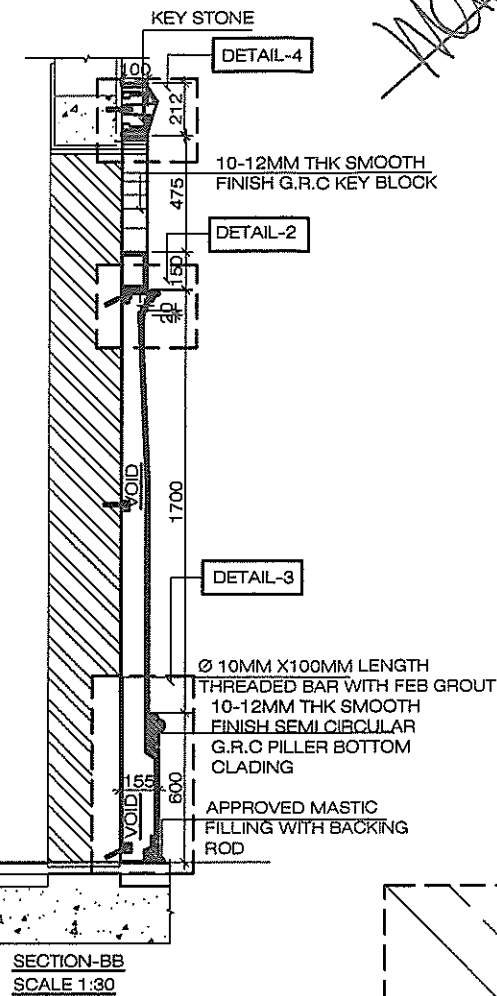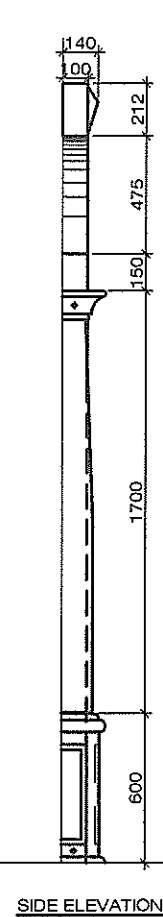

 dar al-handasah Share and Partners	
☒	CODE 1 APPROVED
☐	CODE 2 APPROVED AS NOTED WORK MAY PROCEED SUBJECT TO INCORPORATION OF ENDORSED COMMENTS
☐	CODE 3 RESUBMIT FOR APPROVAL WORK MAY NOT PROCEED
☐	CODE 4 REJECTED
BY: _____ DATE: _____	
Approval shall not relieve the contractor of any of his obligations under the Contract or constitute authorisation of any change to Contract Documents or variation to the works. Contractor is responsible for dimensions, quantities and coordination with other trades.	

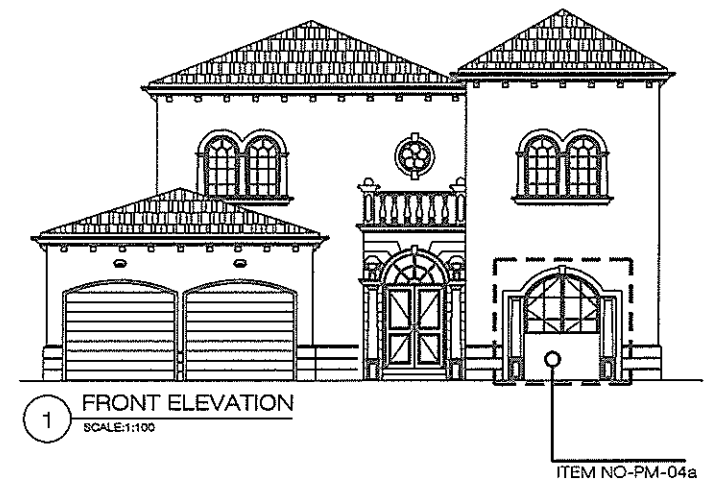

NOTES :-

- 1 : ALL DIMENSIONS ARE IN MM UNLESS OTHERWISE INDICATED.**
- 2 : ALL LEVELS ARE IN METERS UNLESS OTHERWISE INDICATED.**
- 3 : DO NOT SCALE THE DRAWINGS FOLLOW THE WRITTEN DIMENSIONS ONLY.**
- 4 : ALL GRC WORKS MINIMUM THICKNESS OF THE SKIN IS 10 TO 12 MM THICK.**
- 5 : ALL GRC WORKS ARE WHITE SMOOTH FINISHED WITH S.S FITTINGS**



AS BUILT DWG

PROJECT:
JUMEIRAH PARK
525-VILLAS
4V-LEGASY

CLIENT:  **NAKHEEL**
EXTRAITS TOWERS
15th LEVEL
P.O. BOX • 17777
DUBAI • UAE
TEL : 04-3903388
FAX : 04-3903325

SUBMITTING CONSULTANT:

 **dar al-handasah**
sheil and partners

BURN - SERV - DUNG
ASCHI - SIA -

Main Contractor

 **Pauling Middle East**

P.O. BOX : 43176, ABU DHABI, U.A.E.
PHONE : + 971 - 2 - 6319922
FAX : + 971 - 2 - 6325553
E-MAIL : pauling1@emirates.net.ae

SUB CONTRACTOR FOR G.R.C WORKS:



 **SPEED HOUSE**

TEL: 7482929 - P.O. BOX : 1651, ARMAN, U.A.E.
fax 06 7437714 - email: temocypd@speerdhouse.com


CAD BY	CHKD BY	APPROVED BY
S Khanl	RM	RM

DRAWING TITLE:
ITEM NO PM-04a

DWG NO: SH/PME/JP/AB/LE/GRC/008A

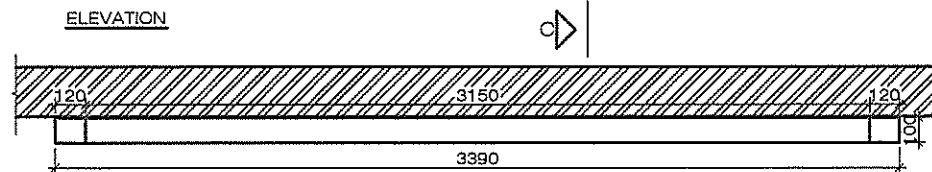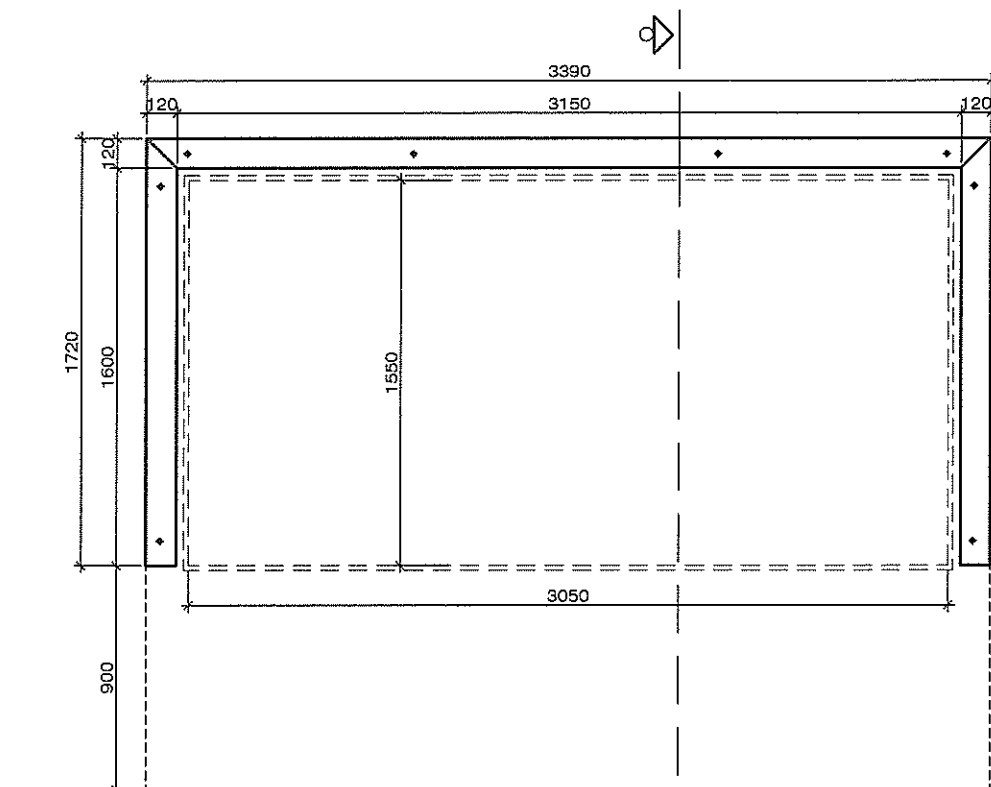


PLAN
SCALE 1:30
DECORATIVE STRIP CLADDING
PANEL-ITEM NO-PM-07

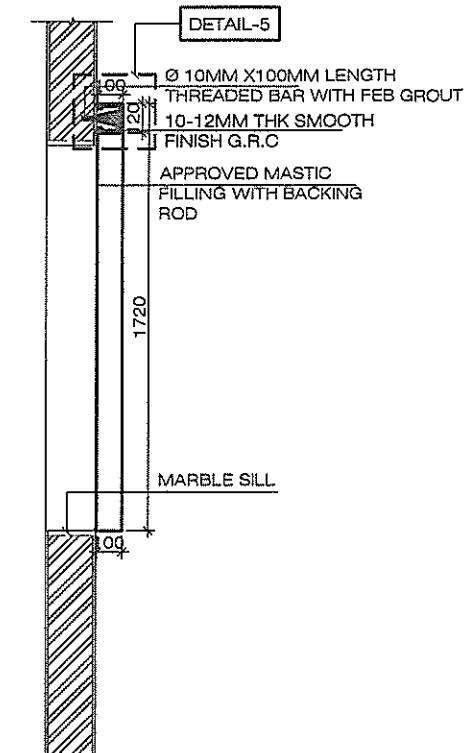

SECTION-CC
SCALE 1:30

ITEM NO PM-07

dar al-handasah Shair and Partners	
☐ CODE 1	APPROVED
☐ CODE 2	APPROVED AS NOTED WORK MAY PROCEED SUBJECT TO INCORPORATION OF ENDORSED COMMENTS
☐ CODE 3	RESUBMIT FOR APPROVAL WORK MAY NOT PROCEED
☐ CODE 4	REJECTED
BY: _____ DATE: _____	
Approval shall not relieve the contractor of any of his obligations under the Contract or constitute authorization of any change to Contract Documents or variation to the works. Contractor is responsible for dimensions, quantities and coordination with other trades.	

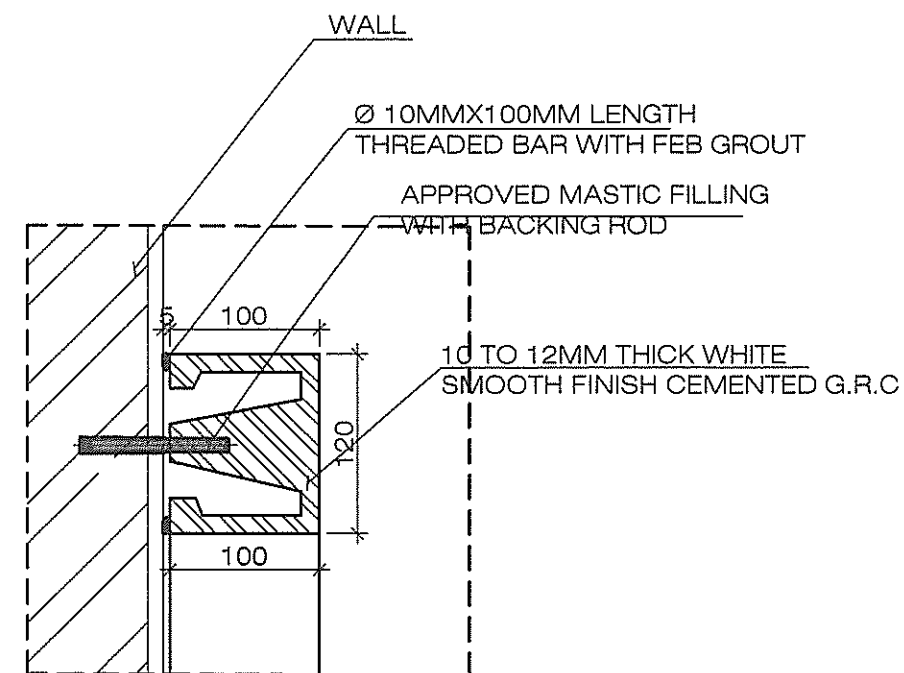

DETAIL-5
SCALE 1:5



NOTES :-

- 1: ALL DIMENSIONS ARE IN MM UNLESS OTHERWISE INDICATED.
- 2: ALL LEVELS ARE IN METERS UNLESS OTHERWISE INDICATED.
- 3: DO NOT SCALE THE DRAWINGS FOLLOW THE WRITTEN DIMENSIONS ONLY.
- 4: ALL GRC WORKS MINIMUM THICKNESS OF THE SKIN IS 10 TO 12 MM THICK.
- 5: ALL GRC WORKS ARE WHITE SMOOTH FINISHED WITH S.S FITTINGS



AS BUILT DWG

PROJECT:
**JUMEIRAH PARK
525-VILLAS
4V-LEGASY**

CLIENT:
NAKHEEL
ENTRATES TOWERS
13th LEVEL
P.O. BOX - 17777
DUBAI - UAE
TEL : 04-3993388
FAX : 04-3993335

SUBMITTING CONSULTANT:
dar al-handasah
shair and partners
DUBAI - UAE
P.O. BOX - 17777
TEL : 04-3993388
FAX : 04-3993335

Main Contractor
Pauling Middle East
P.O. BOX : 45178, ABU DHABI, U.A.E.
PHONE : + 971-2-4229923
FAX : + 971-2-4229923
E-MAIL : pauling1@paulingme.com.ae


SUB CONTRACTOR FOR GRC WORKS:
SPEED HOUSE
SPEED HOUSE
TEL: 7422727 - P.O. BOX: 1651, AJMAN, U.A.E.
fax 06 7437714 - email: info@speedhouse.com

CAD BY	CHECKED BY	APPROVED BY
S Khan	RM	RM


DRAWING TITLE:
ITEM NO PM-07

DWG NO:
SH / PME / JP / AB / LE / GRC / 009A


ITEM NO PM-11

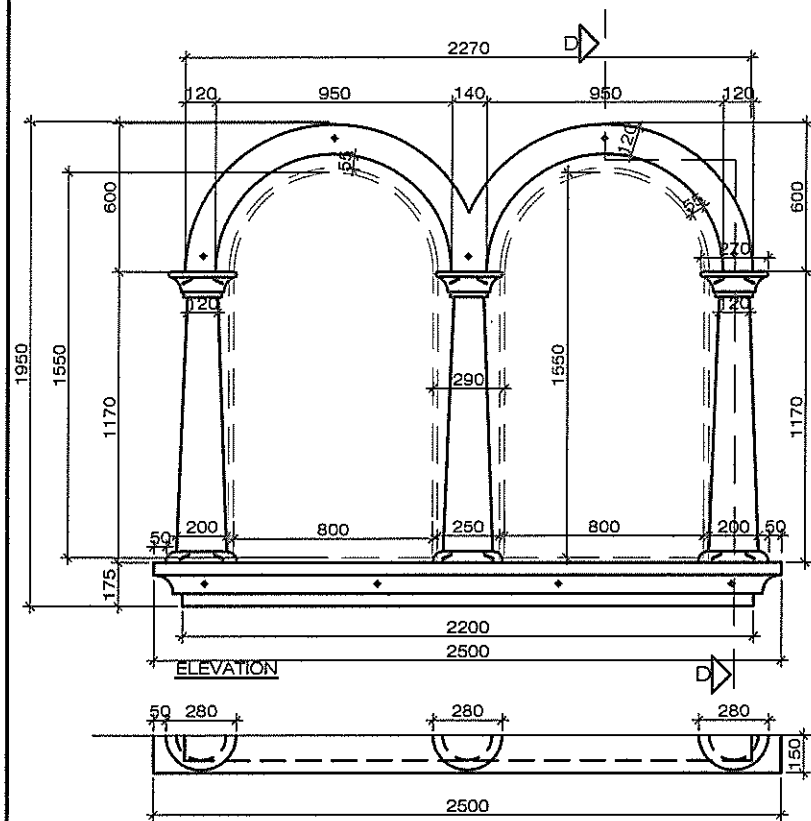

PLAN
SCALE 1:30
DECORATIVE DOUBLE ARCH
PANEL WITH BOTTOM SILL-ITEM
NO-PM-11

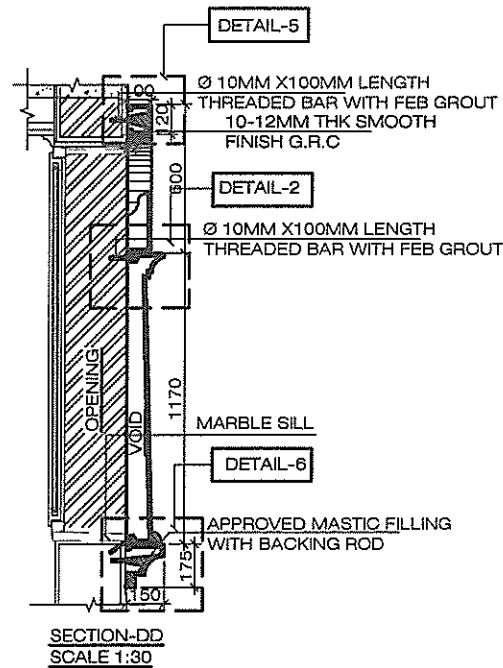


SECTION-DD
SCALE 1:30

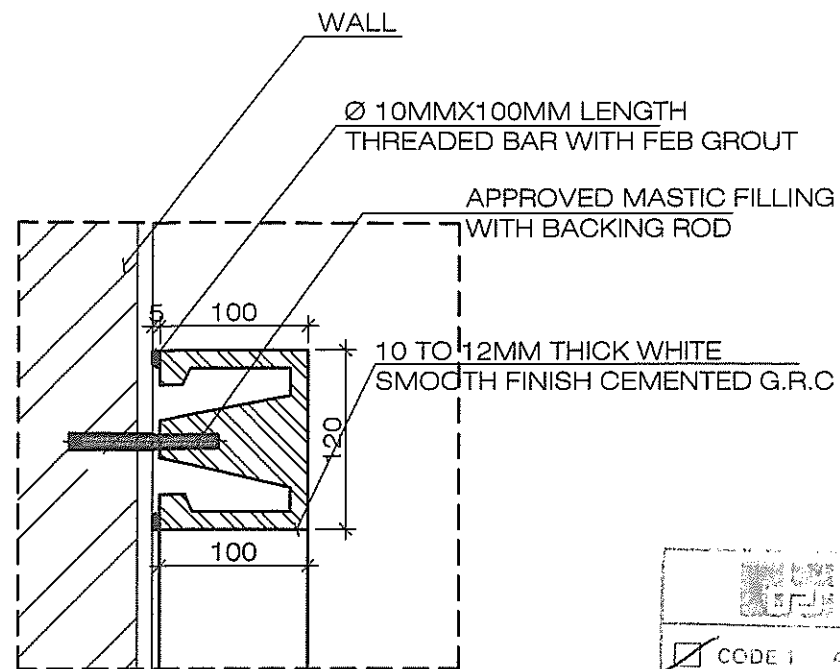

DETAIL-5
SCALE-1:5

dar al-handasah Shair and Partners	
☒ CODE 1	APPROVED
☐ CODE 2	APPROVED AS NOTED WORK MAY PROCEED SUBJECT TO INCORPORATION OF ENDORSED COMMENTS
☐ CODE 3	RESUBMIT FOR APPROVAL WORK MAY NOT PROCEED
☐ CODE 4	REJECTED
BY:	DATE:
Approval shall not relieve the contractor of any of his obligations under the Contract or constitute authorization of any change to Contract Documents or variation to the works. Contractor is responsible for dimensions, quantities and coordination with other trades.	

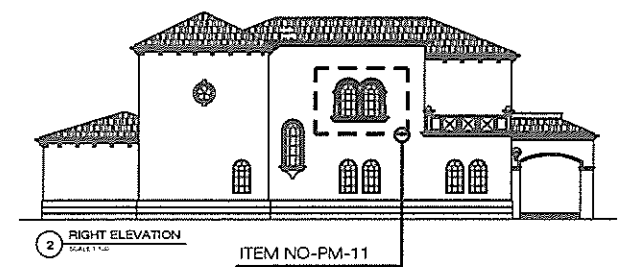

NOTES :-

- 1: ALL DIMENSIONS ARE IN MM UNLESS OTHERWISE INDICATED.
- 2: ALL LEVELS ARE IN METERS UNLESS OTHERWISE INDICATED.
- 3: DO NOT SCALE THE DRAWINGS FOLLOW THE WRITTEN DIMENSIONS ONLY.
- 4: ALL GRC WORKS MINIMUM THICKNESS OF THE SKIN IS 10 TO 12 MM THICK.
- 5: ALL GRC WORKS ARE WHITE SMOOTH FINISHED WITH S.S FITTINGS



AS BUILT DWG

PROJECT:
**JUMEIRAH PARK
525-VILLAS
4V-LEGASY**

CLIENT:
NAKHEEL
ENTRATES TOWERS
13th LEVEL
DUBAI - UAE
TEL : 04-3903388
FAX : 04-3903335

SUBMITTING CONSULTANT:
dar al-handasah
shair and partners
DUBAI - UAE
TEL : 04-3903388
FAX : 04-3903335


Main Contractor
Pauling Middle East
P.O. BOX : 45176, ABU DHABI, U.A.E.
PHONE : + 971-2-4529922
FAX : + 971-2-4529933
E-MAIL : pauling@middleeast.net.ae

SUB CONTRACTOR FOR GRC WORKS:
SPEED HOUSE
TEL: 7482929 - P.O. BOX: 1651, AJMAN, U.A.E.
FAX: 06 7437714 e-mail: speedhouse@speedhouse.com


CAD BY: S Khan
CHECKED BY: RM
APPROVED BY: RM

DRAWING TITLE:
ITEM NO PM-11



DWG NO:
SH / PME / JP / AB / LE / GRC / 010A

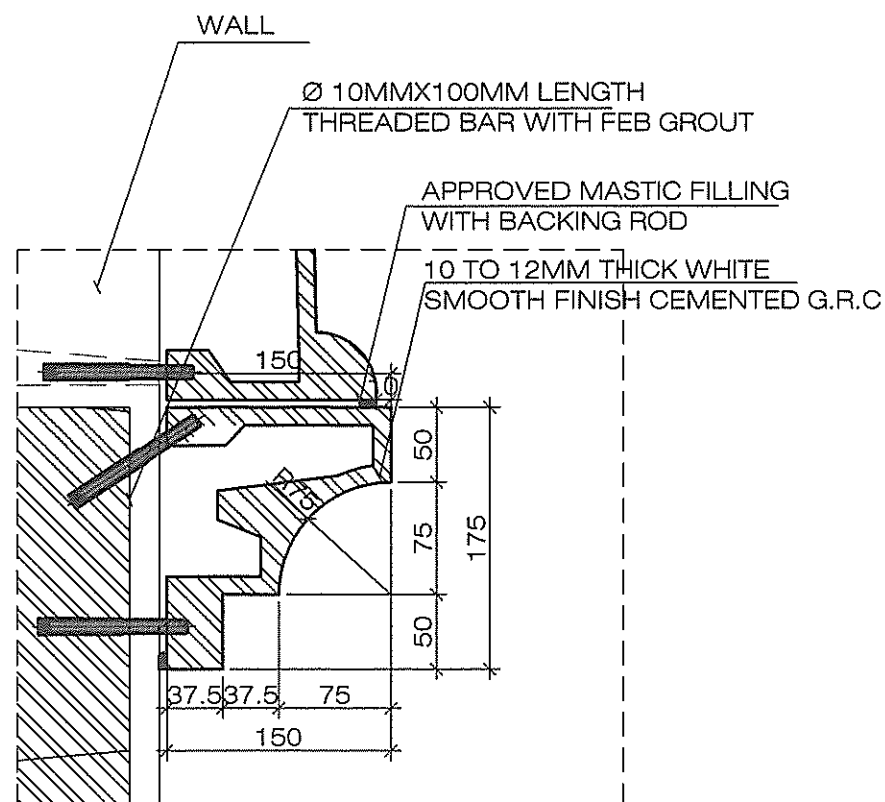



DETAIL-6
SCALE-1:5

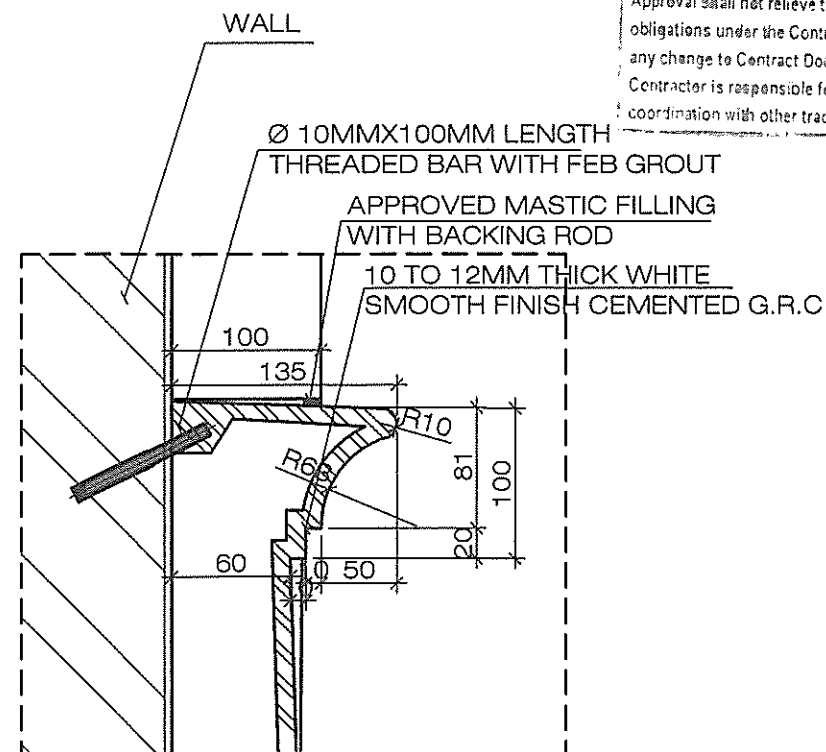

DETAIL-2
SCALE-1:5

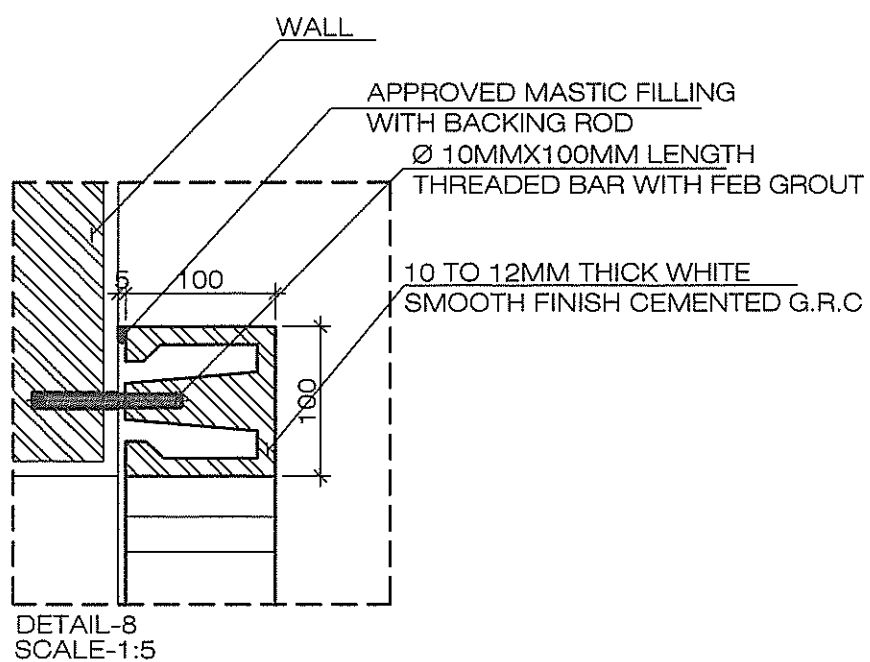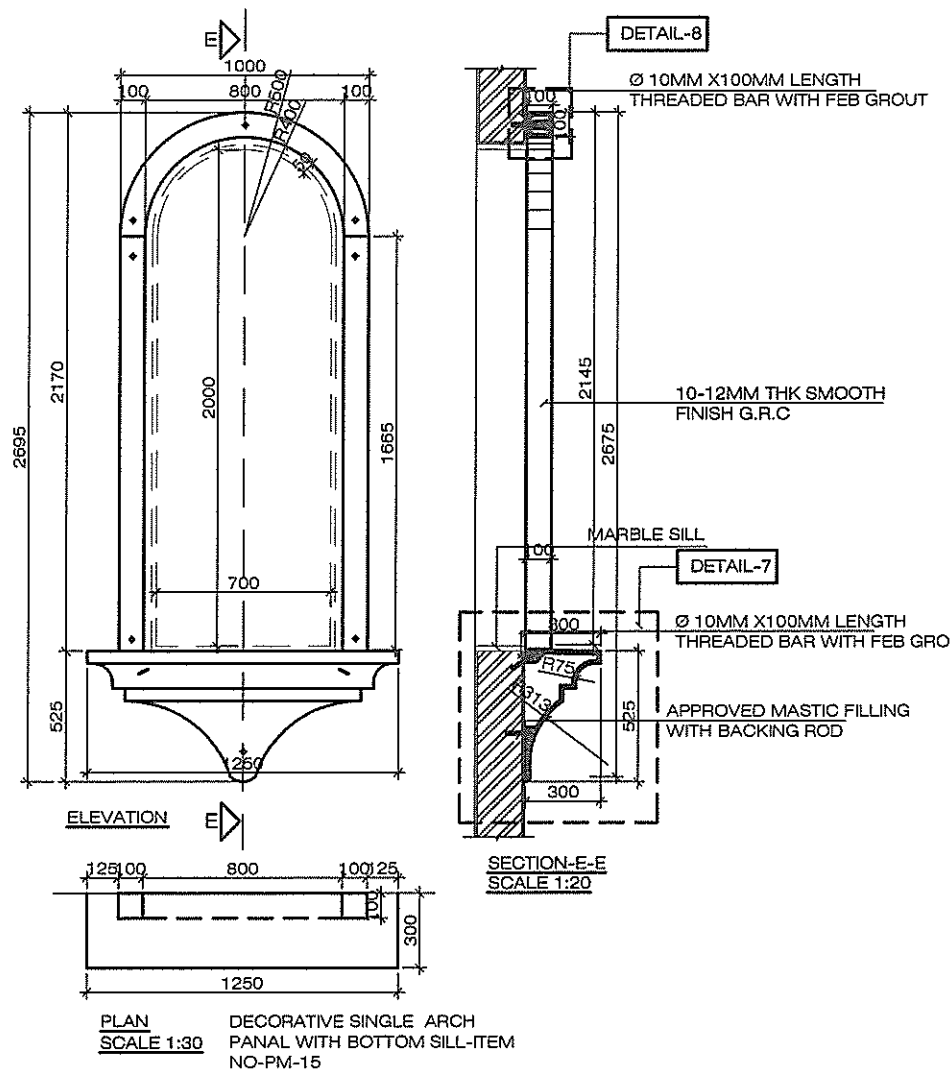

ITEM NO PM-15

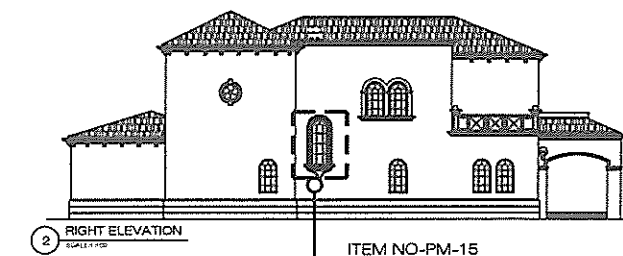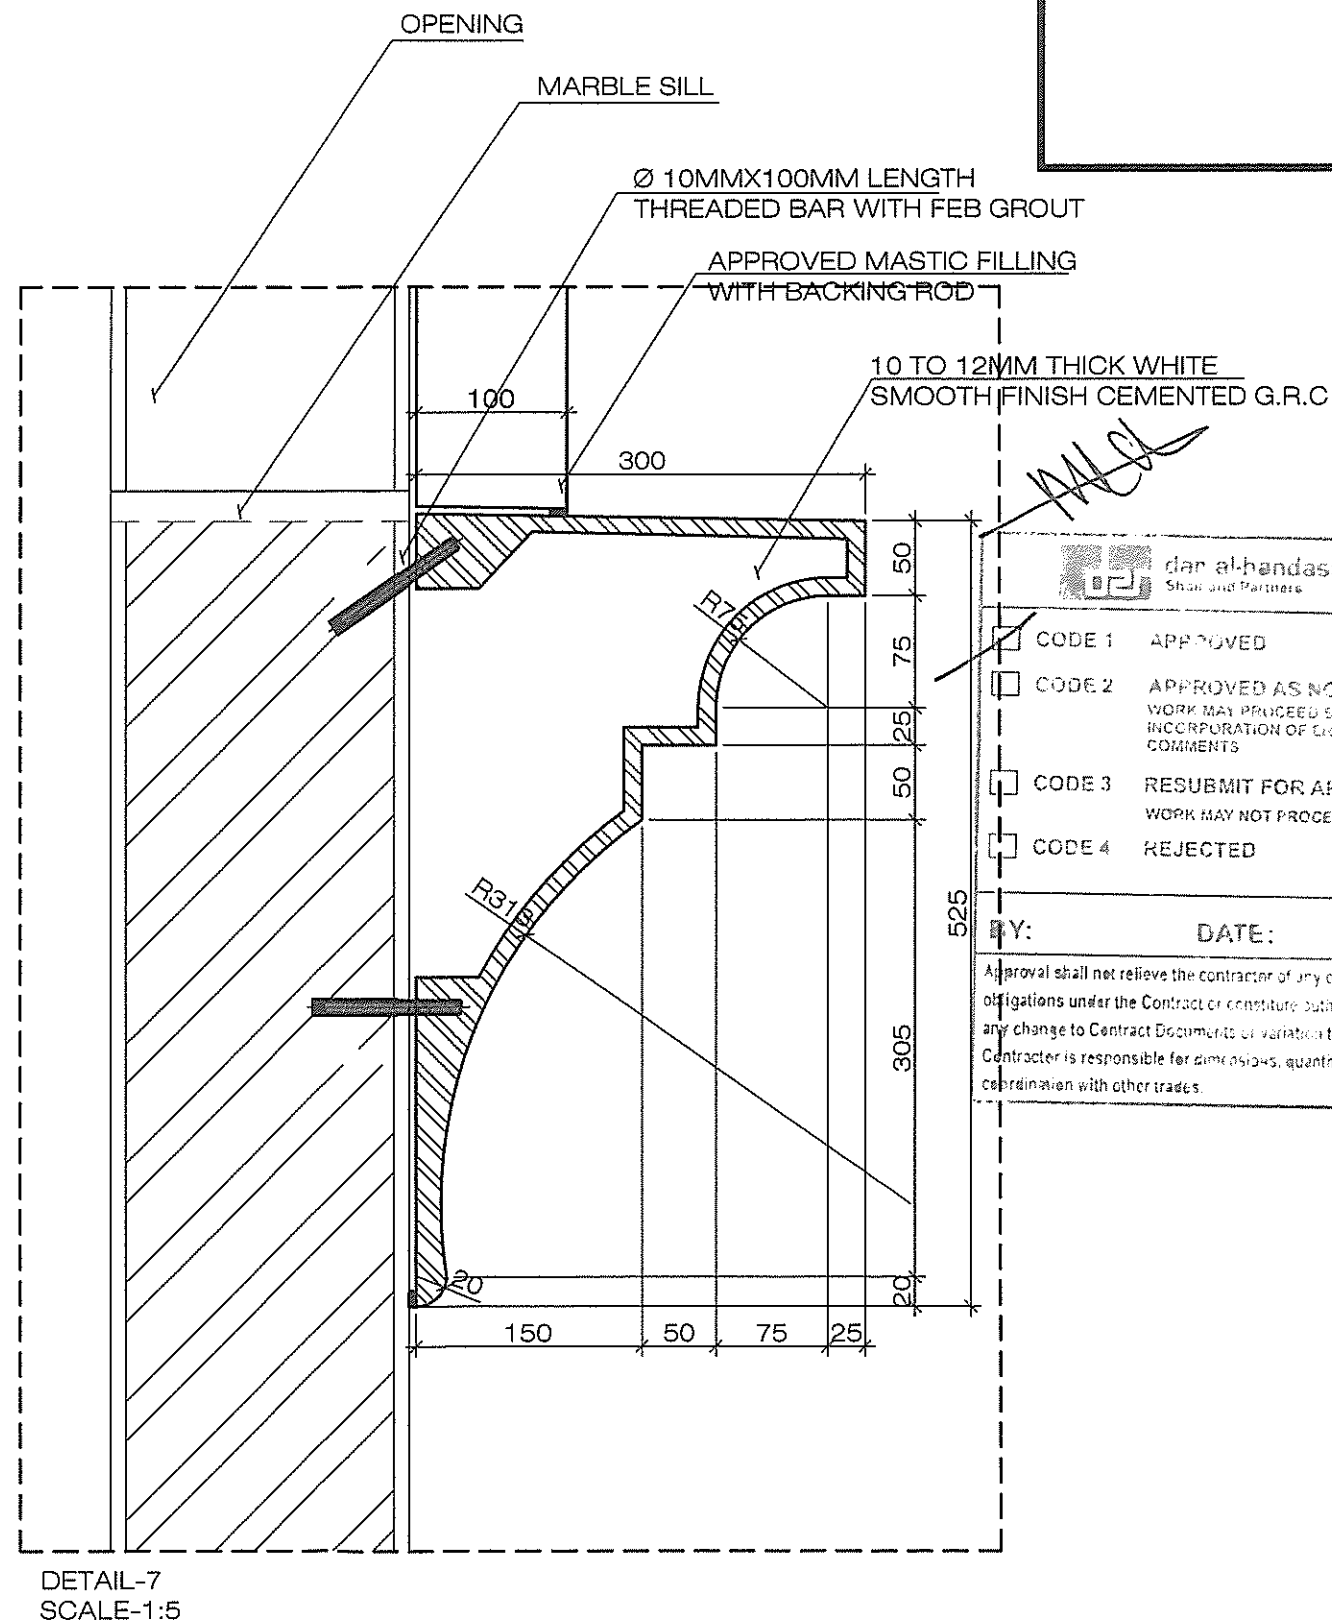

NOTES :-

- 1 : ALL DIMENSIONS ARE IN MM UNLESS OTHERWISE INDICATED.
- 2 : ALL LEVELS ARE IN METERS UNLESS OTHERWISE INDICATED.
- 3 : DO NOT SCALE THE DRAWINGS FOLLOW THE WRITTEN DIMENSIONS ONLY.
- 4 : ALL GRC WORKS MINIMUM THICKNESS OF THE SKIN IS 10 TO 12 MM THICK.
- 5 : ALL GRC WORKS ARE WHITE SMOOTH FINISHED WITH S.S FITTINGS.

dar al-handasah
Shari and Partners

☒	CODE 1	APPROVED
☒	CODE 2	APPROVED AS NOTED WORK MAY PROCEED SUBJECT TO INCORPORATION OF ENDORSED COMMENTS
☐	CODE 3	RESUBMIT FOR APPROVAL WORK MAY NOT PROCEED
☐	CODE 4	REJECTED

BY: _____ DATE: _____

Approval shall not relieve the contractor of any of his obligations under the Contract or constitute authorization of any change to Contract Documents or variation to the works. Contractor is responsible for dimensions, quantities and coordination with other trades.



AS BUILT DWG

PROJECT:
**JUMEIRAH PARK
525-VILLAS
4V-LEGASY**

CLIENT:
NAKHEEL
EMIRATES TOWERS
13th LEVEL
P.O. BOX : 17777
DUBAI - UAE
TEL : 04-3903338
FAX : 04-3903335

SUBMITTING CONSULTANT:
dar al-handasah
shari and partners
DUBAI - UAE
P.O. BOX : 17777
DUBAI - UAE
TEL : 04-3903338
FAX : 04-3903335


Main Contractor
Pauling Middle East
P.O. BOX : 43176, ABU DHABI, U.A.E.
PHONE : + 971-2-4359522
FAX : + 971-2-4359523
E-MAIL : pauling@middleeast.ae

SUB CONTRACTOR FOR GRC WORKS:
SPEED HOUSE
TEL: 7482929 - P.O. BOX : 1431, AJMAN, U.A.E.
FAX 06 7437714 - email: speedhouse@speedhouse.ae


CAD BY	CHECKED BY	APPROVED BY
S Khan	RM	RM

DRAWING TITLE:
ITEM NO PM-15

DWG NO:
SH / PME / JP / AB / LE / GRC / 011A

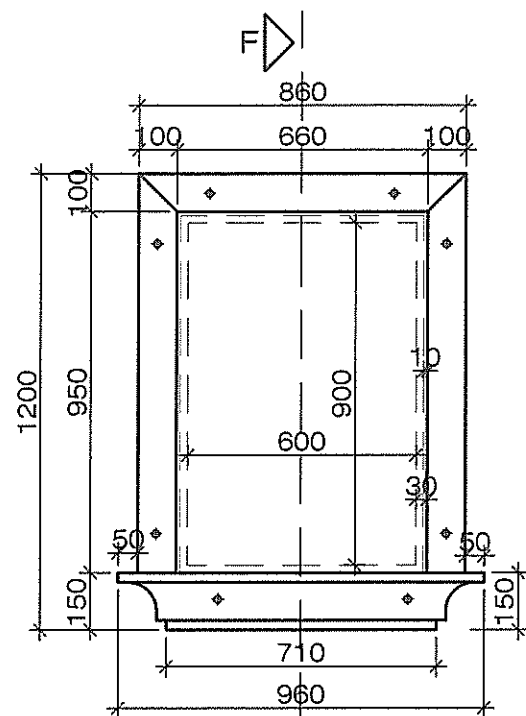


ELEVATION F

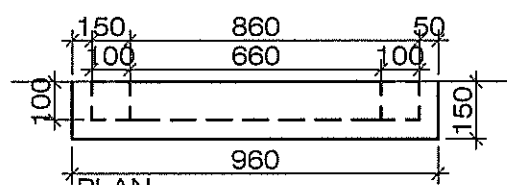


PLAN

SCALE 1:20

DECORATIVE RECTANGLE
PANAL WITH BOTTOM SILL-ITEM
NO-PM-16

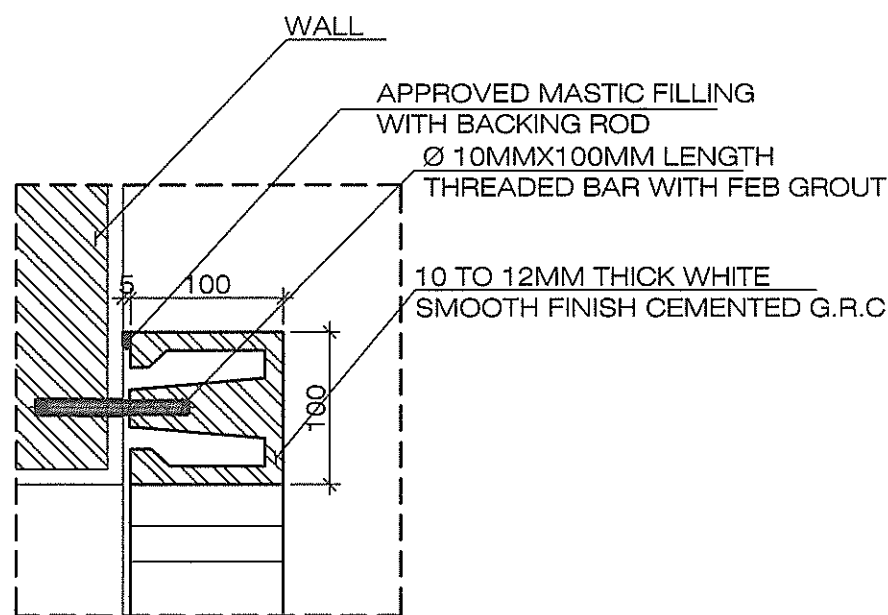

DETAIL-8
SCALE-1:5

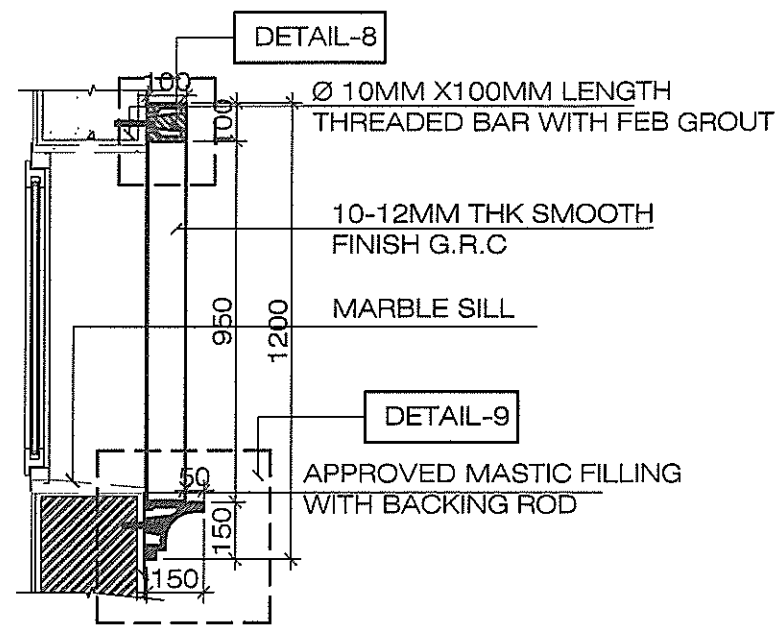

SECTION-FF
SCALE 1:20

DETAIL-8


Ø 10MM X100MM LENGTH
THREADED BAR WITH FEB GROUT

10-12MM THK SMOOTH
FINISH G.R.C

MARBLE SILL

DETAIL-9

APPROVED MASTIC FILLING
WITH BACKING ROD

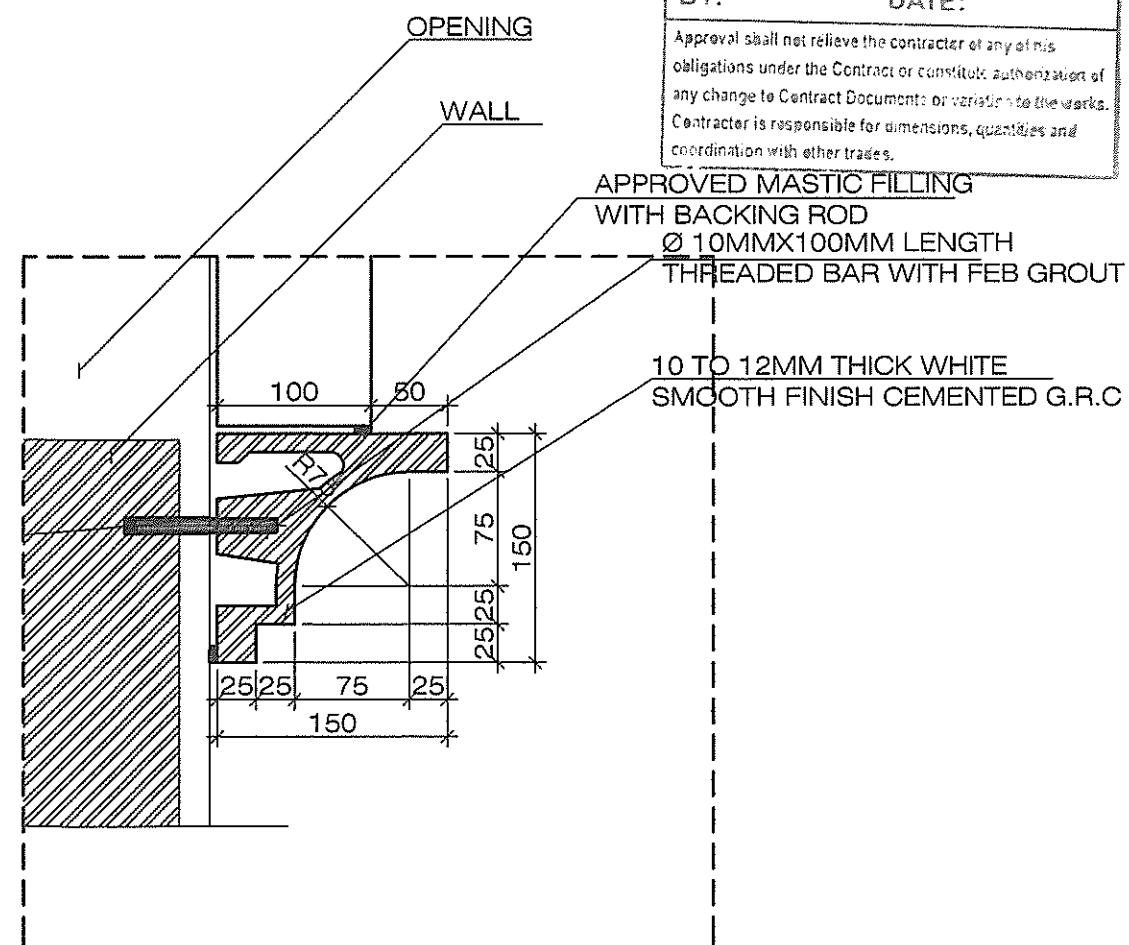

DETAIL-9
SCALE-1:5


ITEM NO PM-16

- CODE 1 APPROVED
- CODE 2 APPROVED AS NOTED
WORK MAY PROCEED SUBJECT TO
INCORPORATION OF ENDORSED
COMMENTS
- CODE 3 RESUBMIT FOR APPROVAL
WORK MAY NOT PROCEED
- CODE 4 REJECTED

BY:

DATE:

Approval shall not relieve the contractor of any of his
obligations under the Contract or constitute authorization of
any change to Contract Documents or variation to the works.
Contractor is responsible for dimensions, quantities and
coordination with other trades.

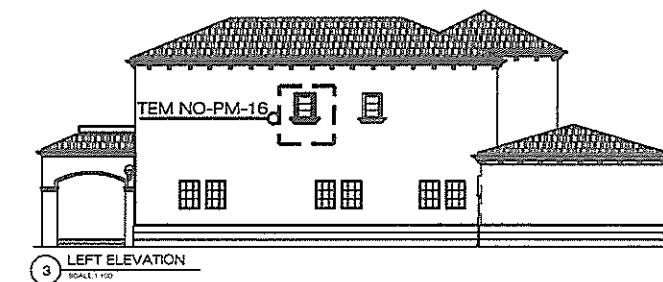

NOTES :-

- 1: ALL DIMENSIONS ARE IN
MM UNLESS OTHERWISE
INDICATED.
- 2: ALL LEVELS ARE IN
METERS UNLESS OTHERWISE
INDICATED.
- 3: DO NOT SCALE THE DRAWINGS
FOLLOW THE WRITTEN DIMENSIONS
ONLY.
- 4: ALL GRC WORKS MINIMUM
THICKNESS OF THE SKIN IS 10 TO 12
MM THICK.

- 5: ALL GRC WORKS ARE WHITE
SMOOTH FINISHED WITH S.S
FITTINGS.



AS BUILT DWG

PROJECT:
**JUMEIRAH PARK
525-VILLAS
4V-LEGASY**

CLIENT:
NAKHEEL
EXHIBITS TOWNS
15th LEVEL
P.O. BOX - 12777
DUBAI - UAE
TEL : 04-3933388
FAX : 04-3933335

SUBMITTING CONSULTANT:
dar al-handasah
architects and partners
DUBAI - ABU DHABI - AMMAN

Main Contractor
Pauling Middle East
P.O. BOX : 45178, ABU DHABI, U.A.E.
PHONE : + 971 - 2 - 4522222
FAX : + 971 - 2 - 4522222
E-MAIL : pauling1@middleeast.ae

SUB CONTRACTOR FOR GRC WORKS:
SPEED HOUSE
TEL : 7407270 - P.O. BOX 1451, AMMAN, U.A.E.
fax 7407714 - email: hmc@speedhouse.com



CAD BY: S Khaili RM

CHECKED BY: RM


APPROVED BY: RM

DRAWING TITLE:
ITEM NO PM-16

DWG NO:
SH / PME / JP / AB / LE / GRC / 012A

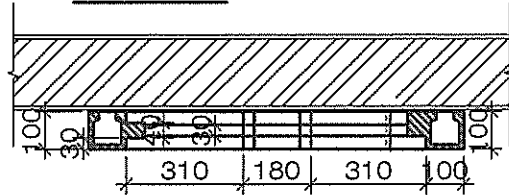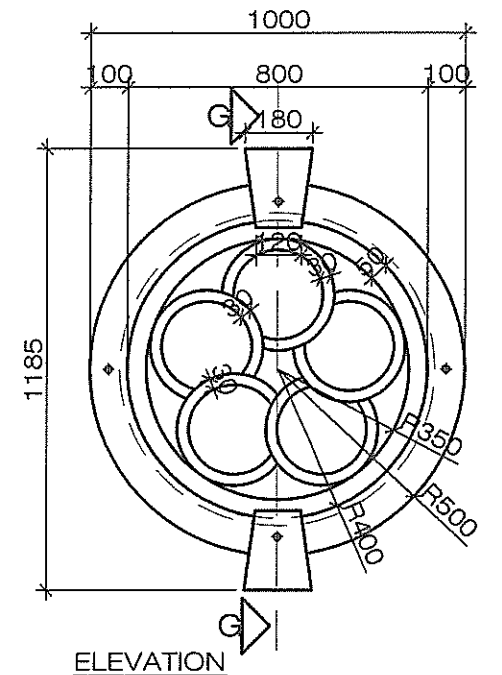


PLAN
SCALE 1:20
DECORATIVE CIRCLE PANEL
ITEM NO-PM-18

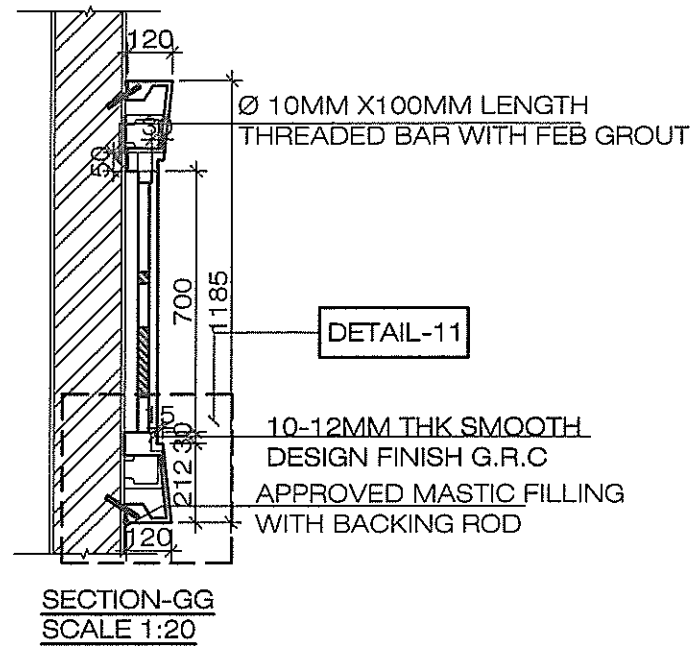


DETAIL-11

ITEM NO PM-18

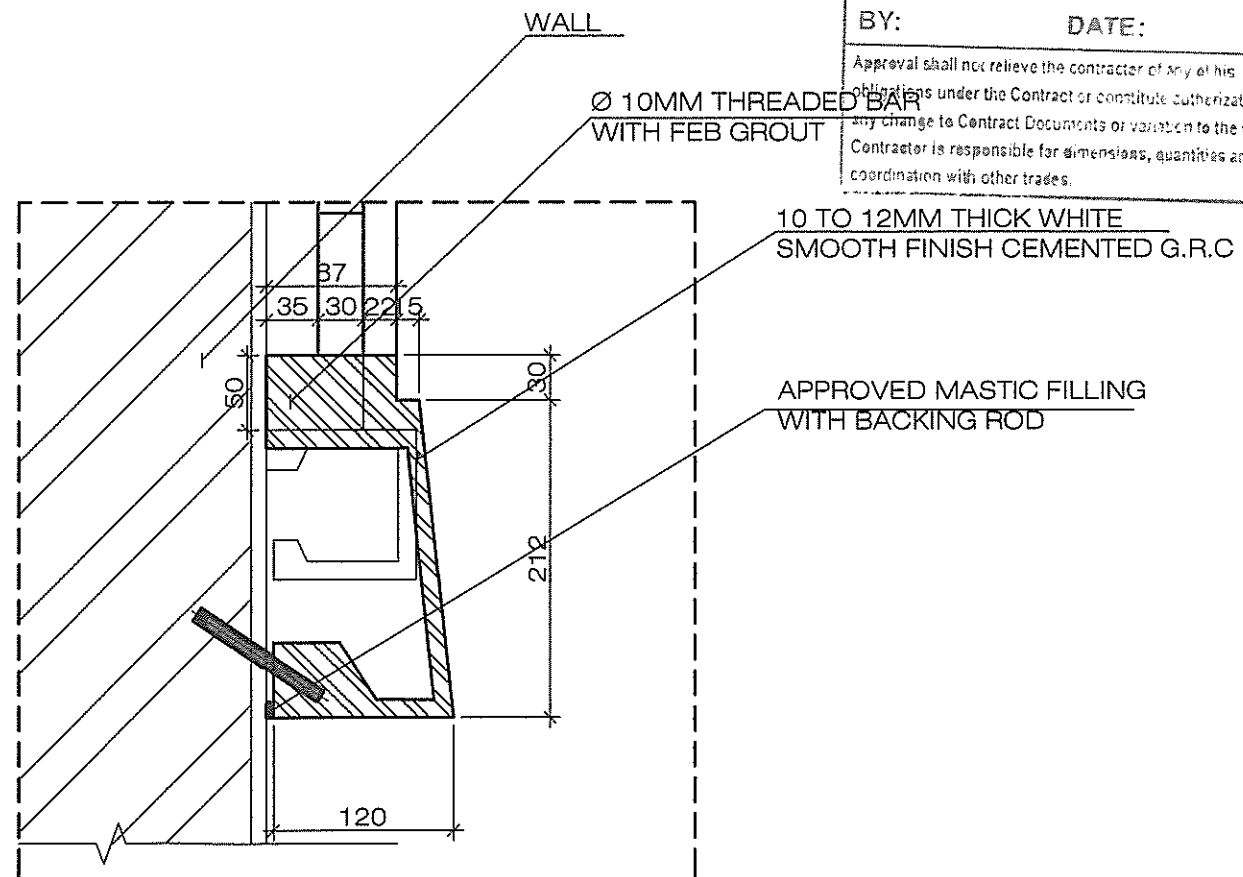

DETAIL-11
SCALE-1:5

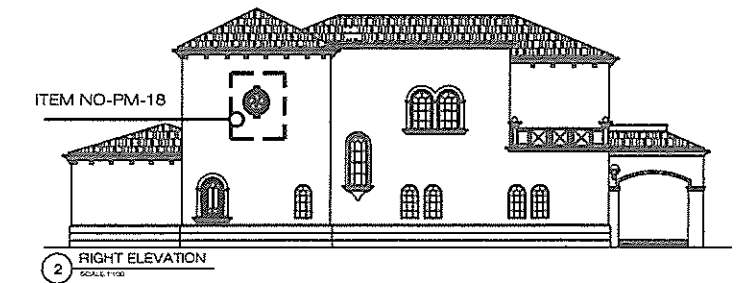

RIGHT ELEVATION
SCALE 1:100

dar al-handasah
Shair and Partners

☐ CODE 1 APPROVED

☐ CODE 2 APPROVED AS NOTED
WORK MAY PROCEED SUBJECT TO
INCORPORATION OF ENDORSED
COMMENTS

☐ CODE 3 RESUBMIT FOR APPROVAL
WORK MAY NOT PROCEED

☐ CODE 4 REJECTED

BY: _____ DATE: _____

Approval shall not relieve the contractor of any of his
obligations under the Contract or constitute authorization of
any change to Contract Documents or variation to the works.
Contractor is responsible for dimensions, quantities and
coordination with other trades.

- NOTES :-**
- 1: ALL DIMENSIONS ARE IN MM UNLESS OTHERWISE INDICATED.
 - 2: ALL LEVELS ARE IN METERS UNLESS OTHERWISE INDICATED.
 - 3: DO NOT SCALE THE DRAWINGS FOLLOW THE WRITTEN DIMENSIONS ONLY.
 - 4: ALL GRC WORKS MINIMUM THICKNESS OF THE SKIN IS 10 TO 12 MM THICK.
 - 5: ALL GRC WORKS ARE WHITE SMOOTH FINISHED WITH S.S FITTINGS



AS BUILT DWG

PROJECT:
JUMEIRAH PARK
525-VILLAS
4V-LEGASY

CLIENT:
NAKHEEL
DEVELOPERS
13th FLOOR
P.O. BOX - 17777
DUBAI - UAE
TEL : 04-3903388
FAX : 04-3903335

SUBMITTING CONSULTANT:
dar al-handasah
shair and partners
DUBAI - UAE
P.O. BOX - 17777
TEL : 04-3903388
FAX : 04-3903335






Main Contractor
Pauling Middle East
P.O. BOX: 43116, ABU DHABI, U.A.E.
PHONE : + 971 - 2 - 4339923
FAX : + 971 - 2 - 4339923
E-MAIL : pauling@paulingme.com

SUB CONTRACTOR FOR GRC WORKS:
SPEED HOUSE
TEL: 0433229 - P.O. BOX: 1651, ADHAN, U.A.E.
Fax 04 7437714 email: info@speedhouse.com

CAD BY: S Khan
CHECKED BY: RM
APPROVED BY: RM

DRAWING TITLE:
ITEM NO PM-18

DWG NO:
SH / PME / JP / AB / LE / GRC / 013A

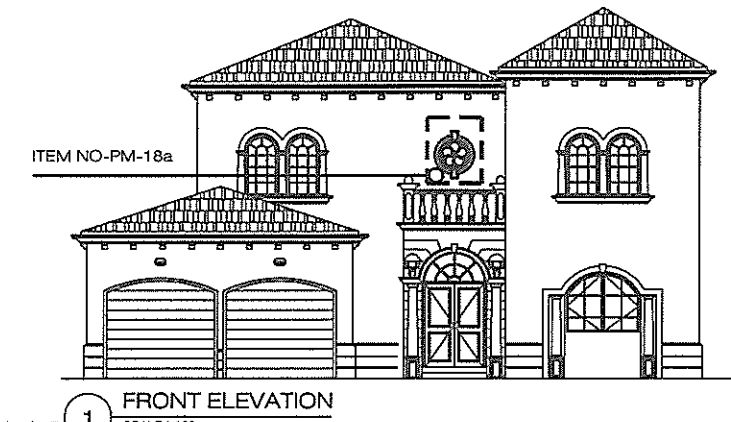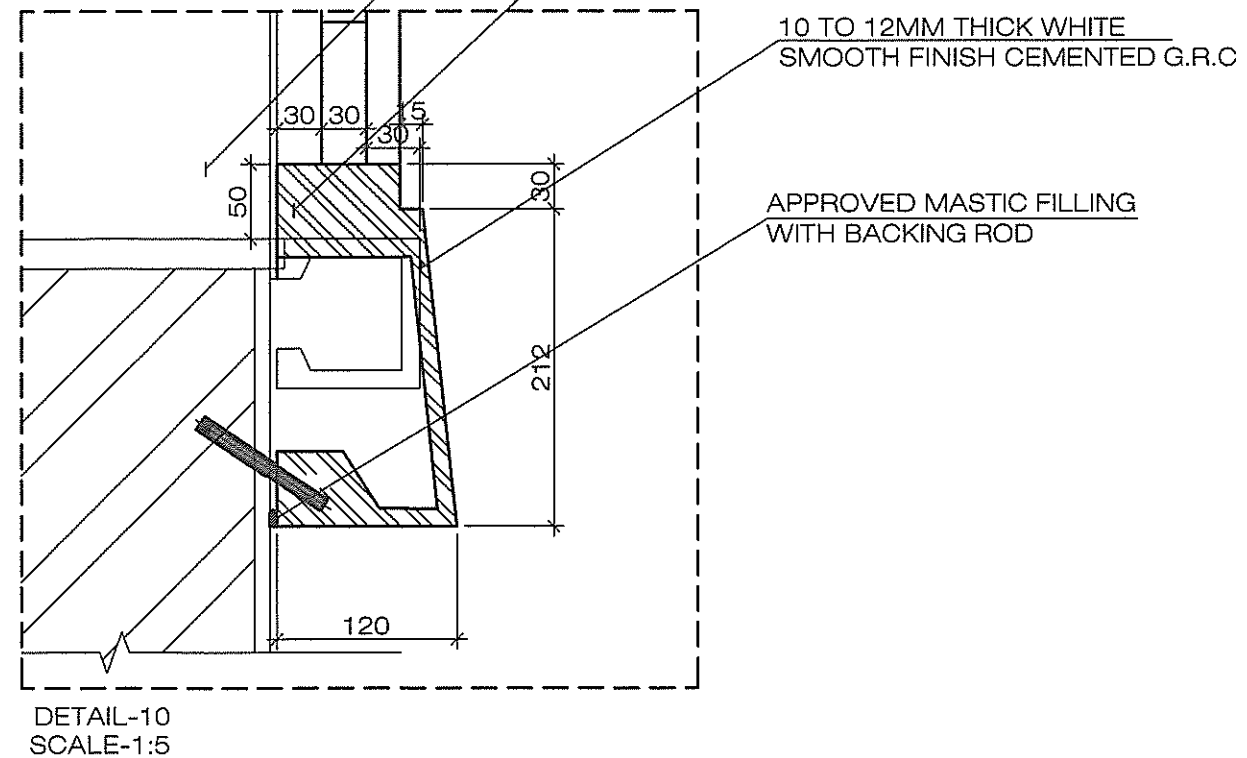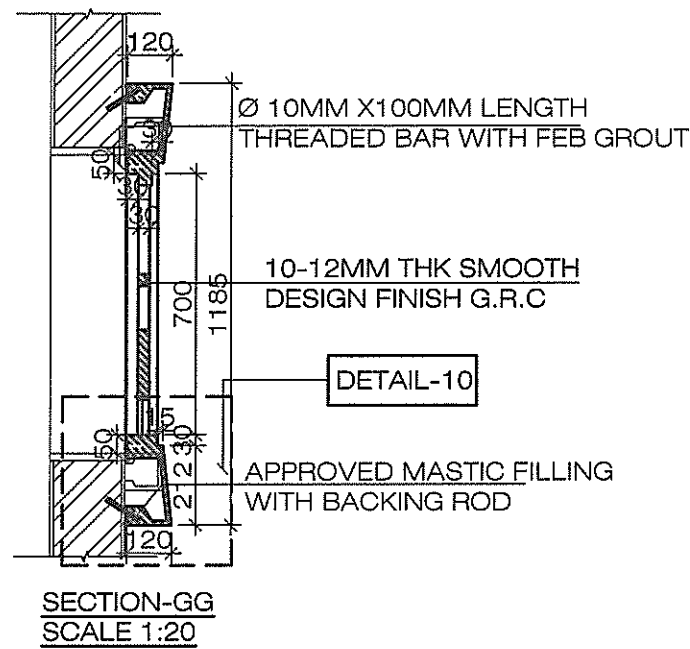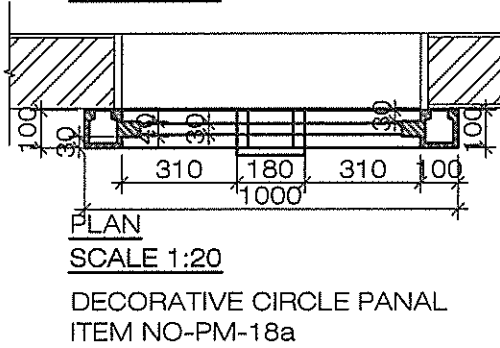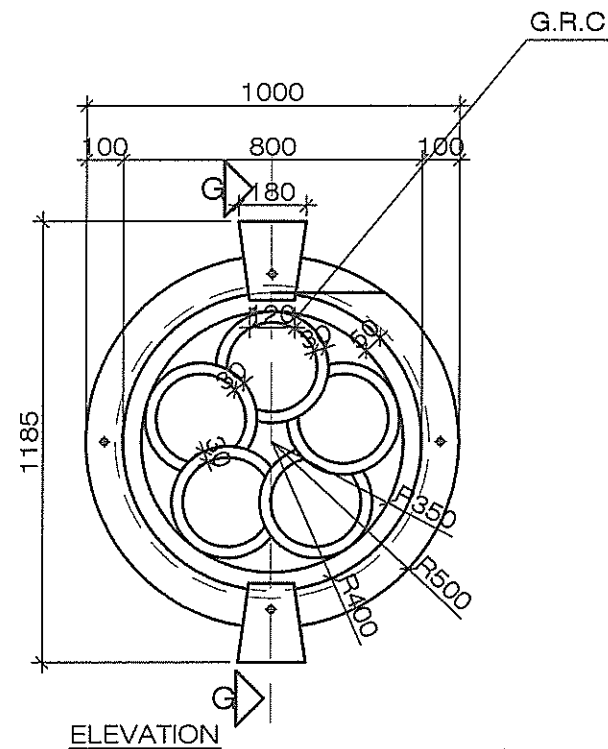

dar al-handasah
Partners

CODE 1: ☒ APPROVED

CODE 2: ☐ APPROVED AS NOTED
WORK MAY PROCEED SUBJECT TO
INCORPORATION OF ENDORSED
COMMENTS

CODE 3: ☐ RESUBMIT FOR APPROVAL
WORK MAY NOT PROCEED

CODE 4: ☐ REJECTED

BY: _____ DATE: _____

Approval shall not relieve the contractor of any of his
obligations under the Contract or constitute authorization of
any change to Contract Documents or variation to the works.

- NOTES :-**
- 1: ALL DIMENSIONS ARE IN MM UNLESS OTHERWISE INDICATED.
 - 2: ALL LEVELS ARE IN METERS UNLESS OTHERWISE INDICATED.
 - 3: DO NOT SCALE THE DRAWINGS FOLLOW THE WRITTEN DIMENSIONS ONLY.
 - 4: ALL GRC WORKS MINIMUM THICKNESS OF THE SKIN IS 10 TO 12 MM THICK.
 - 5: ALL GRC WORKS ARE WHITE SMOOTH FINISHED WITH S.S. FITTINGS



AS BUILT DWG

PROJECT:
**JUMEIRAH PARK
525-VILLAS
4V-LEGASY**

CLIENT:
NAKHEEL
DEVELOPERS
18th LEVEL
P.O. BOX - 12777
DUBAI - UAE
TEL : 04-3903318
FAX : 04-3903315

SUBMITTING CONSULTANT:
dar al-handasah
architects & engineers
DAR AL HANDASAH
ARCHITECTS & ENGINEERS

Main Contractor
Pauling Middle East
P.O. BOX: 45176, ABU DHABI, U.A.E.
PHONE : + 971-2-4329922
FAX : + 971-2-4329922
E-MAIL : pauling1@paulingme.com



SUB CONTRACTOR FOR GRC WORKS:
SPEED HOUSE
SPEED HOUSE
TEL: 7462222 - P.O. BOX: 1661, ADJMAN, U.A.E.
TEL: 06 7427775 - email: info@speedhouse.com

CAD BY	CHECKED BY	APPROVED BY
S Khanal	RM	RM



DRAWING TITLE:
ITEM NO PM-18a

DWG NO:
SH / PME / JP / AB / LE / GRC / 014A

ITEM NO PM-29

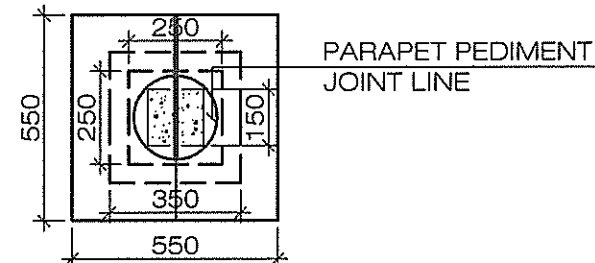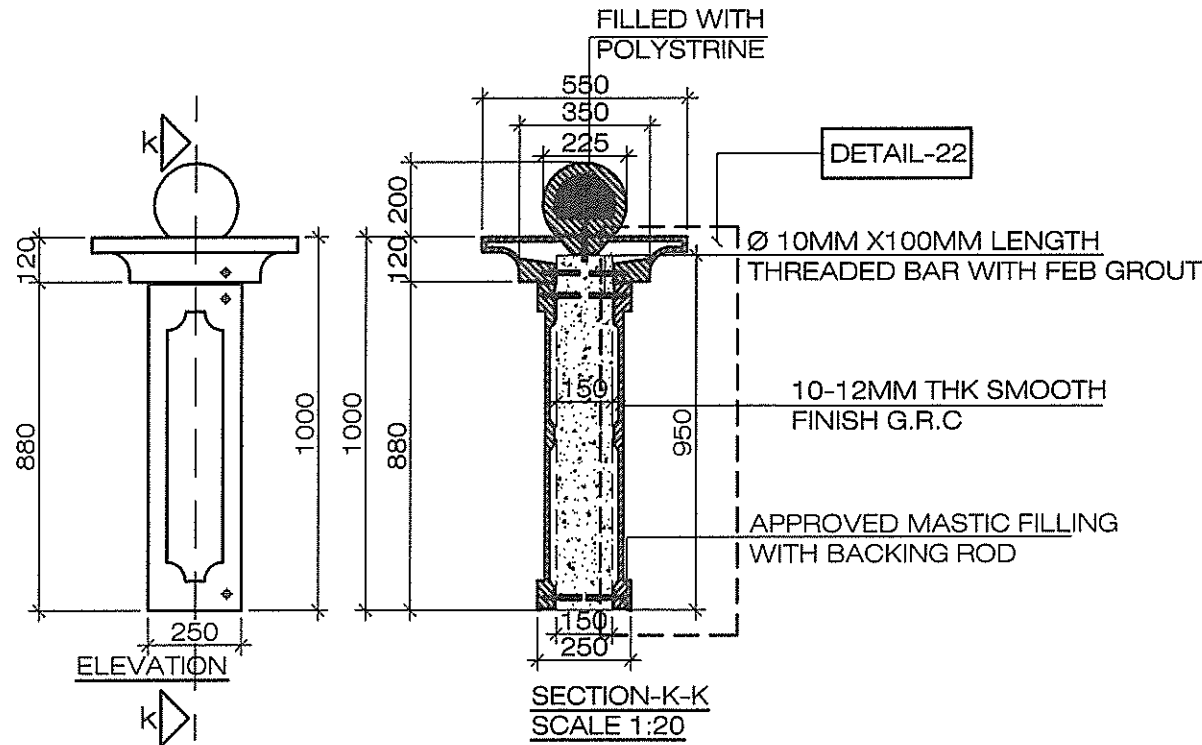

DECORATIVE PARAPET
PEDIMENT -ITEM NO-PM-29

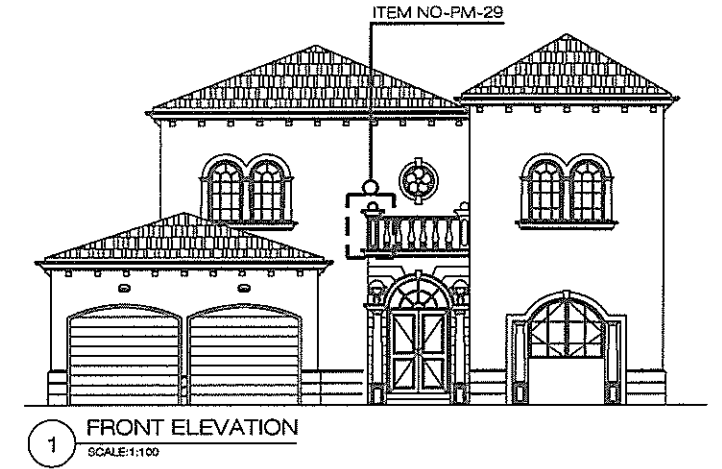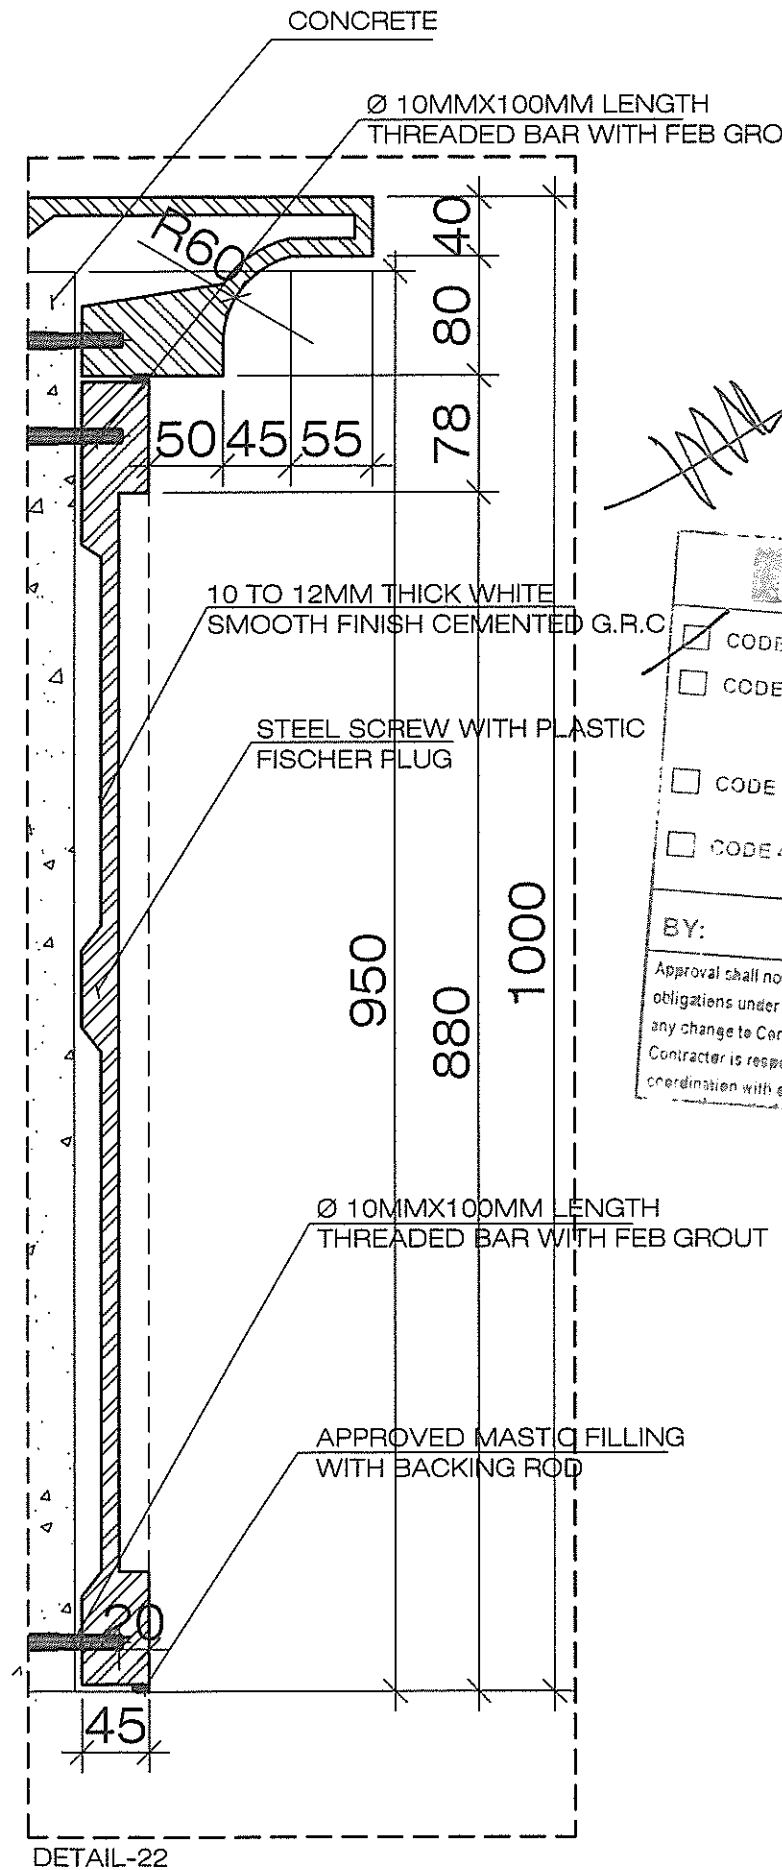

NOTES :-

- 1 : ALL DIMENSIONS ARE IN MM UNLESS OTHERWISE INDICATED.
- 2 : ALL LEVELS ARE IN METERS UNLESS OTHERWISE INDICATED.
- 3 : DO NOT SCALE THE DRAWINGS FOLLOW THE WRITTEN DIMENSIONS ONLY.
- 4 : ALL GRC WORKS MINIMUM THICKNESS OF THE SKIN IS 10 TO 12 MM THICK.
- 5 : ALL GRC WORKS ARE WHITE SMOOTH FINISHED WITH S.S FITTINGS.

dar al-handasah
Shair and Partners

☒ CODE 1 APPROVED

☐ CODE 2 APPROVED AS NOTED
WORK MAY PROCEED SUBJECT TO
INCORPORATION OF ENDORSED
COMMENTS

☐ CODE 3 RESUBMIT FOR APPROVAL
WORK MAY NOT PROCEED

☐ CODE 4 REJECTED

BY: _____ DATE: _____

Approval shall not relieve the contractor of any of his obligations under the Contract or constitute authorization of any change to Contract Documents or variation to the works. Contractor is responsible for dimensions, quantities and coordination with other trades.



AS BUILT DWG

PROJECT:
**JUMEIRAH PARK
525-VILLAS
4V-LEGASY**

CLIENT:
NAKHEEL
EXHIBITS TOWER
13th LEVEL
P.O. BOX - 17777
DUBAI - UAE
TEL : 04-3803388
FAX : 04-3803385

SUBMITTING CONSULTANT:
dar al-handasah
Shair and Partners
DUBAI - U.A.E.
شارع - د.ع.


Main Contractor
Pauling Middle East
P.O. BOX : 45176, ABU DHABI, U.A.E.
PHONE : + 971-2-4529922
FAX : + 971-2-4529923
E-MAIL : pauling@paulingme.com

SUB CONTRACTOR FOR G.R.C WORKS:
SPEED HOUSE
TEL: 2402352 - P.O. BOX: 1611, AMMAN, U.A.E.
Fax: 06 7407714 - email: huncopy@speedhouse.com




CAD BY	CHECKED BY	APPROVED BY
S Khand	RM	RM

DRAWING TITLE:
ITEM NO PM-29

DWG NO:
SH / PME / JP / AB / LE / GRC / 015A

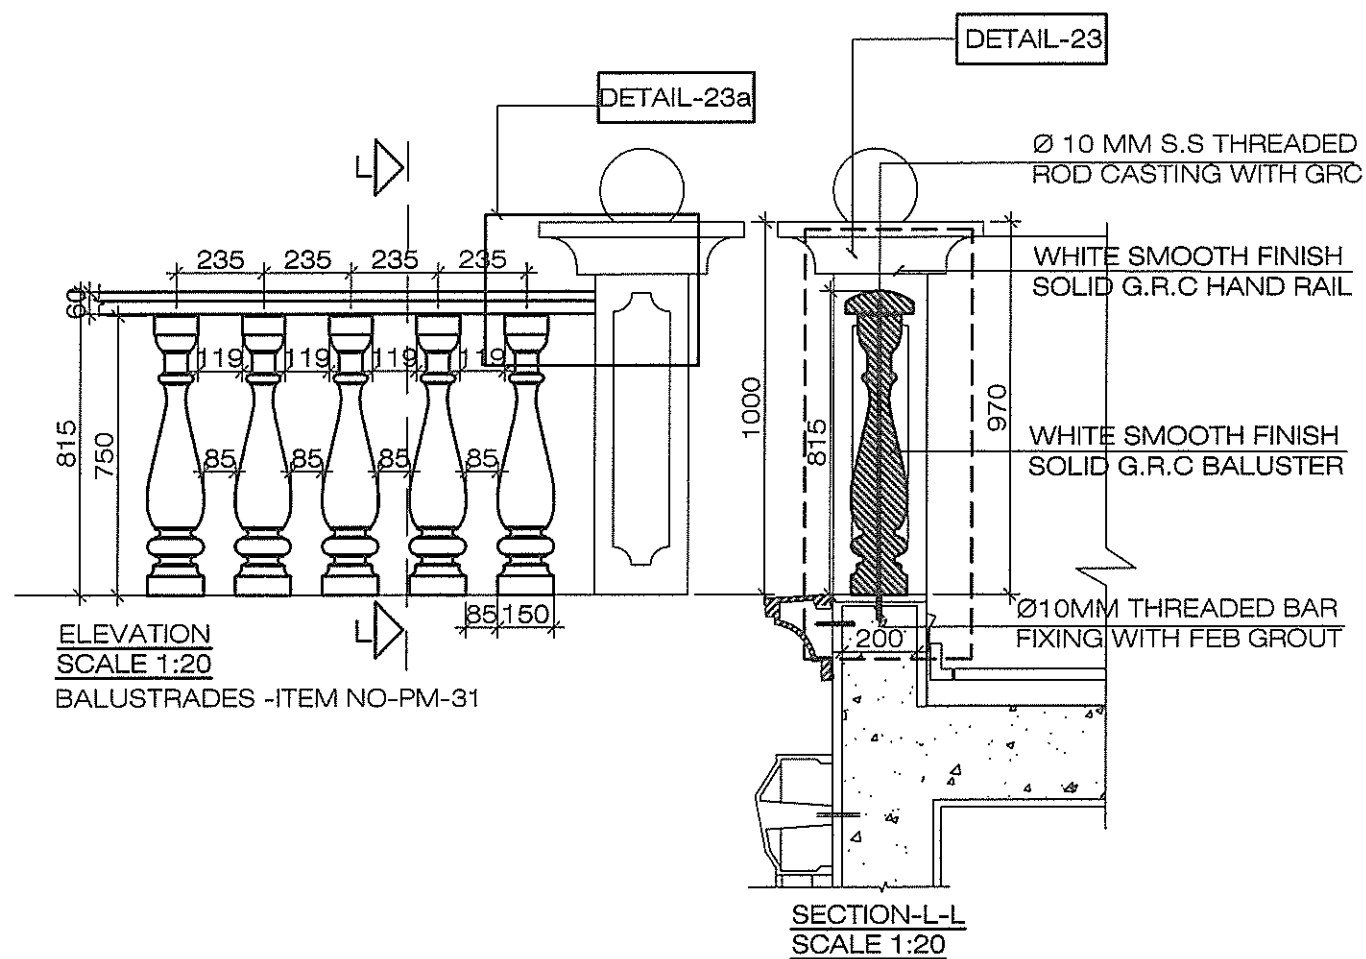

ITEM NO PM-31

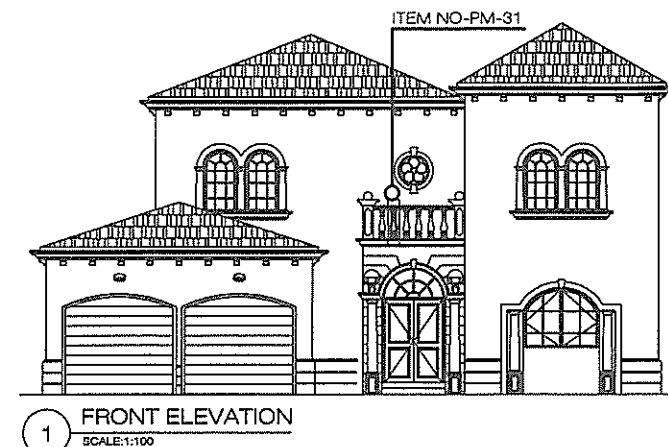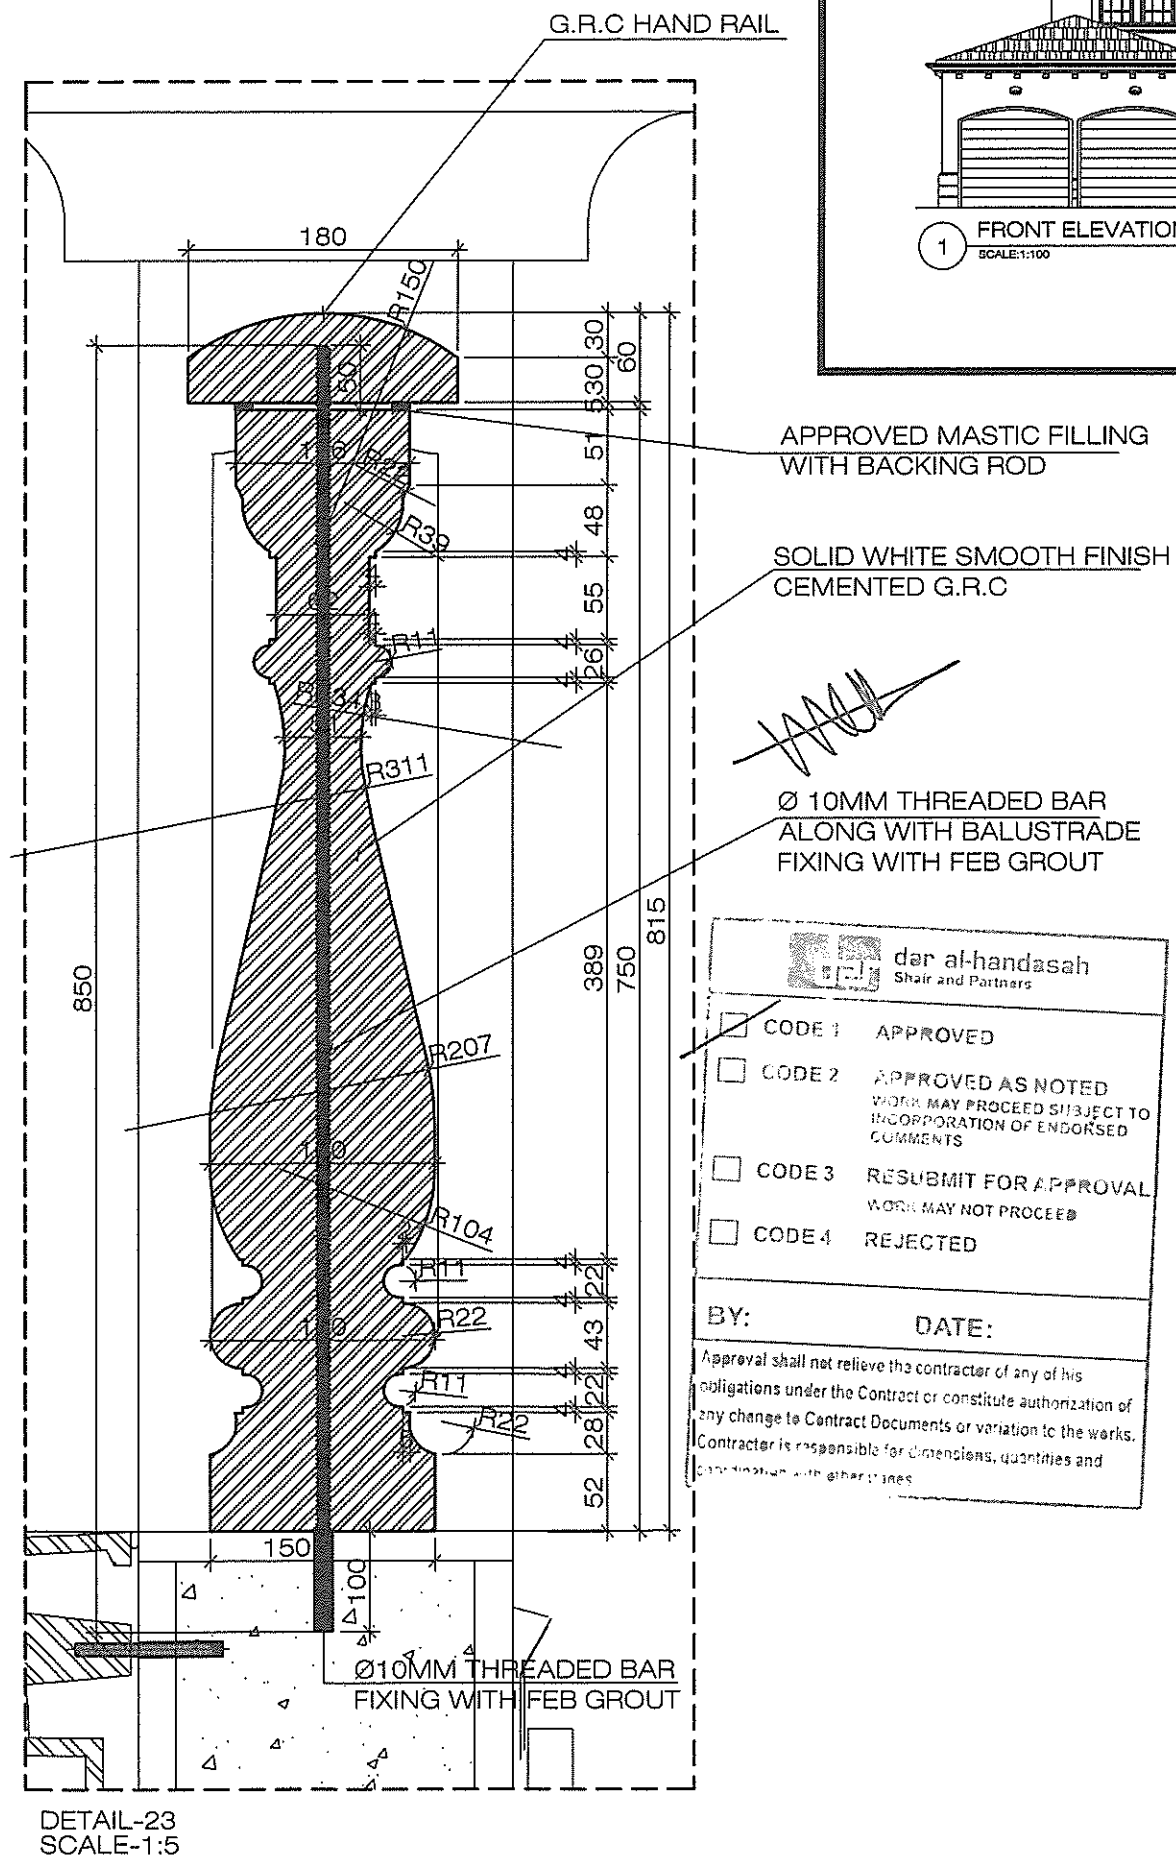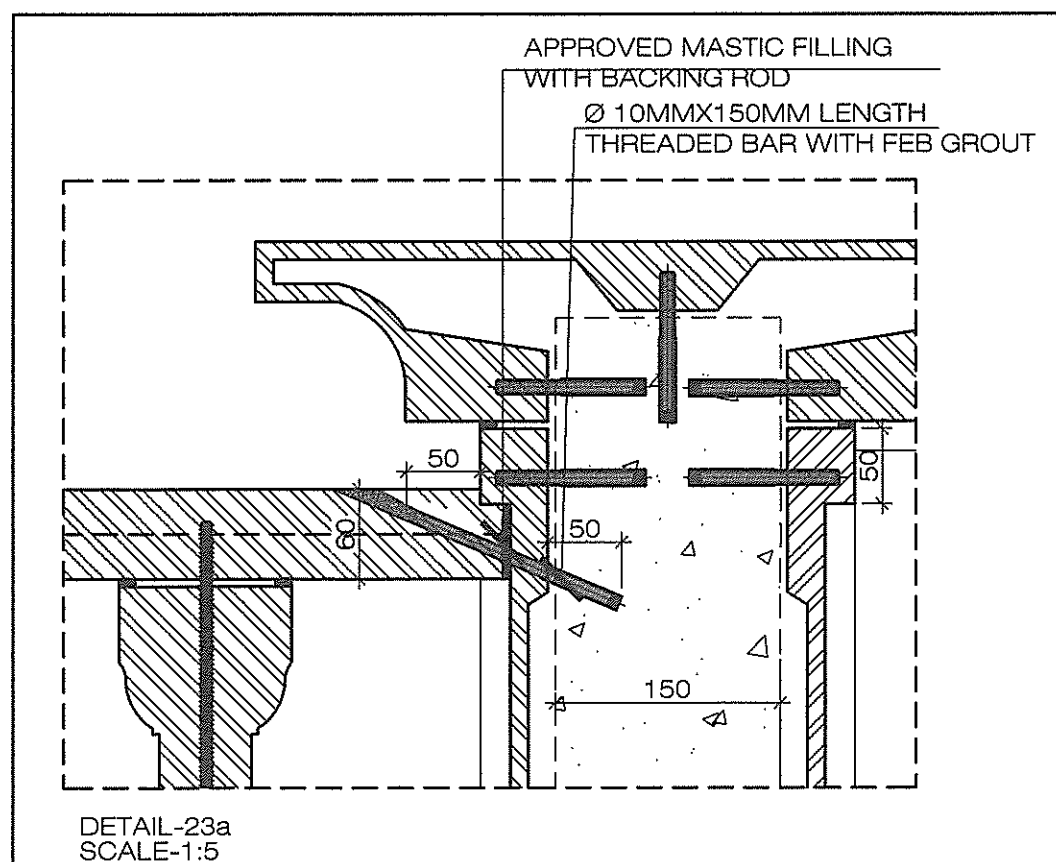

NOTES :-

- 1: ALL DIMENSIONS ARE IN MM UNLESS OTHERWISE INDICATED.
- 2: ALL LEVELS ARE IN METERS UNLESS OTHERWISE INDICATED.
- 3: DO NOT SCALE THE DRAWINGS FOLLOW THE WRITTEN DIMENSIONS ONLY.
- 4: ALL GRC WORKS MINIMUM THICKNESS OF THE SKIN IS 10 TO 12 MM THICK.
- 5: ALL GRC WORKS ARE WHITE SMOOTH FINISHED WITH S.S FITTINGS



AS BUILT DWG

PROJECT:
**JUMEIRAH PARK
525-VILLAS
4V-LEGASY**

CLIENT:
NAKHEEL
INDICATES TOWER
15th LEVEL
P.O. BOX - 17777
DUBAI - UAE
TEL : 04-3503333
FAX : 04-3503335

SUBMITTING CONSULTANT:



Main Contractor

Pauling Middle East
P.O. BOX: 45176, ABU DHABI, U.A.E.
PHONE : + 971-2-4229922
FAX : + 971-2-4225553
E-MAIL : pauling1@emirates.net.ae




SUB CONTRACTOR FOR GRC WORKS:

SPEED HOUSE
TEL: 442327 - P.O. BOX 3431, ADHAN, U.A.E.
TEL 06 7477714 - email: info@speedhouse.com


CAD BY: S Khanl
CHECKED BY: RM
APPROVED BY: RM

DRAWING TITLE:
ITEM NO PM-31

DWG NO:
SH / PME / JP / AB / LE / GRC / 016A

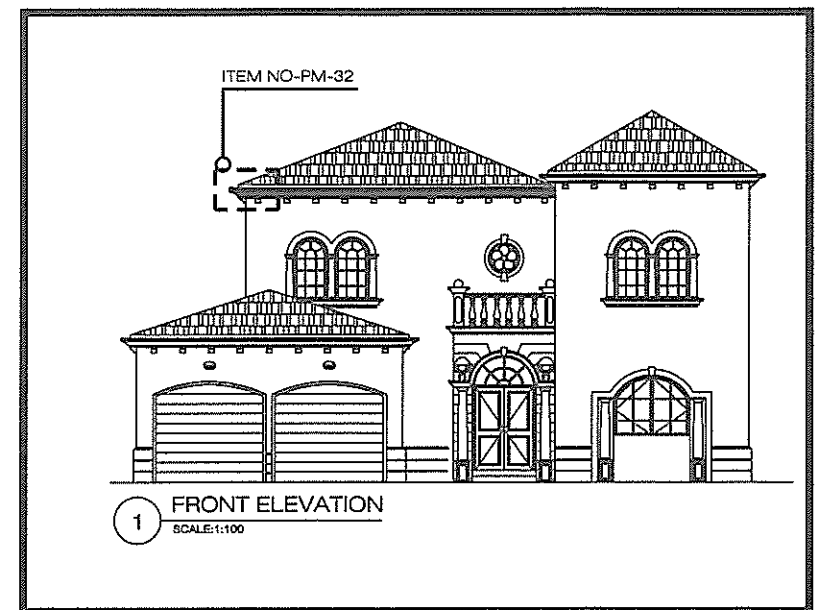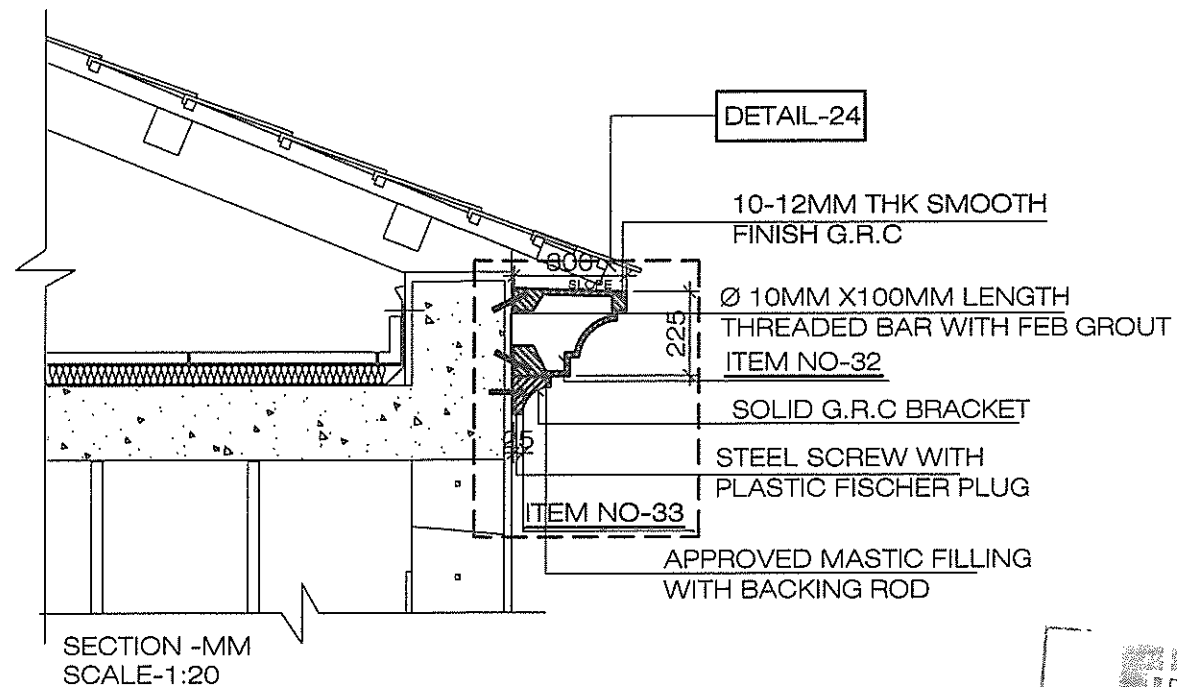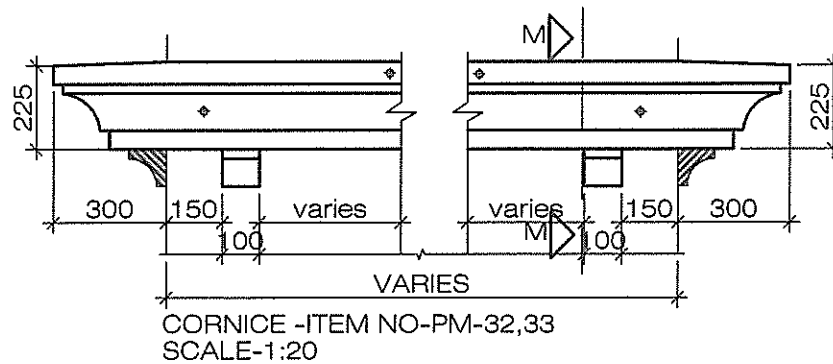

ITEM NO PM-32

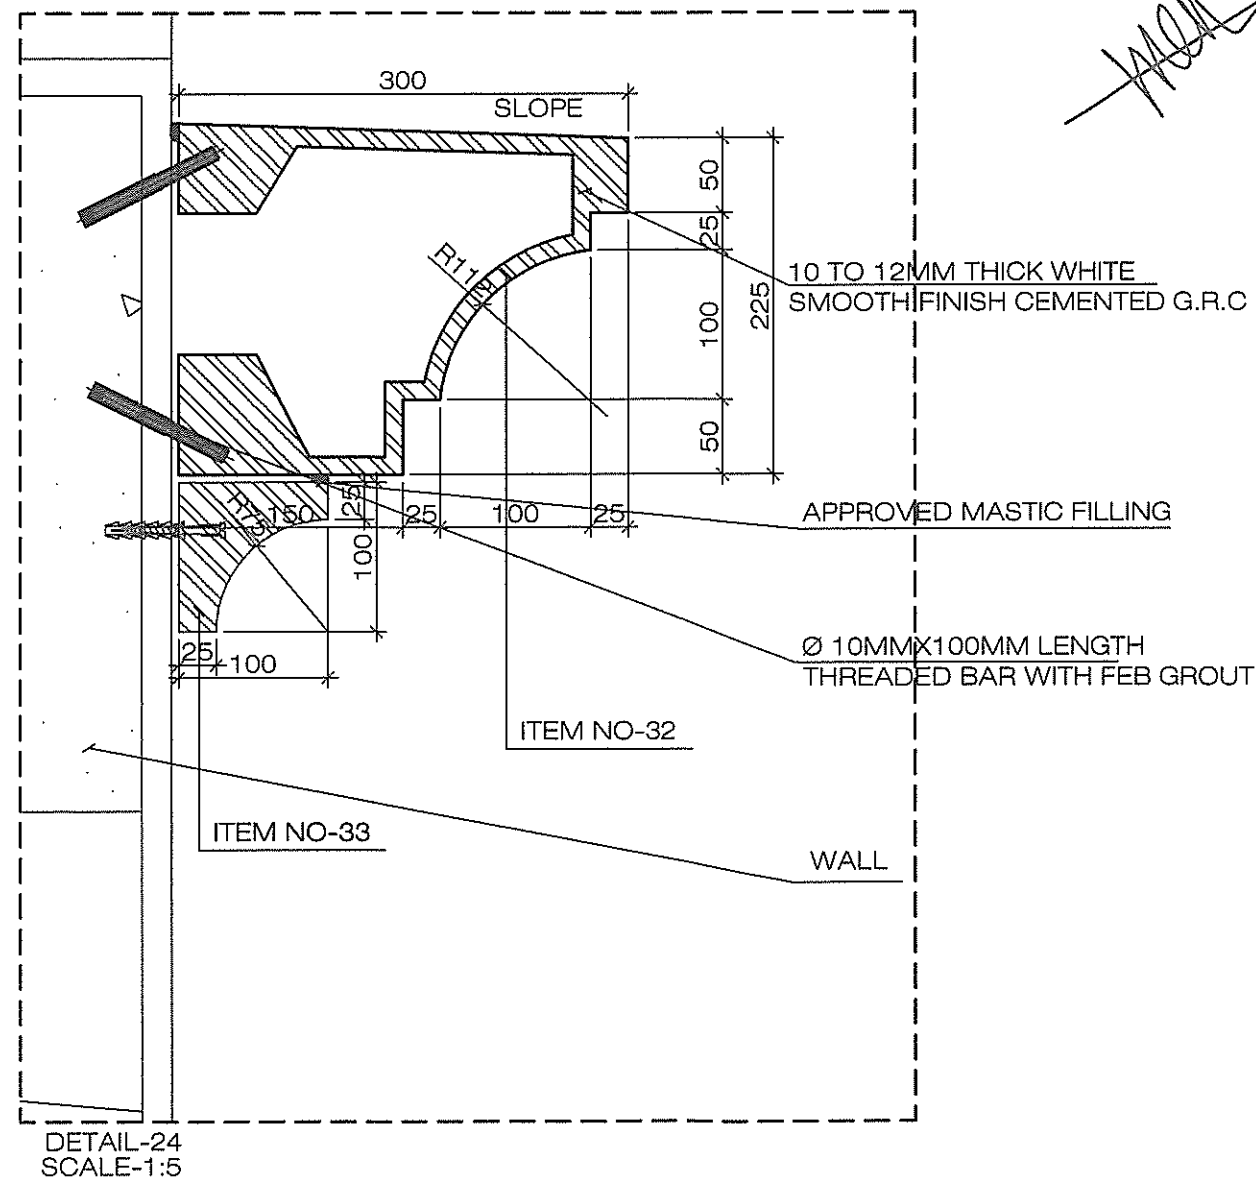

dar al-handasah
Shair and Partners

☐ CODE 1 APPROVED

☐ CODE 2 APPROVED AS NOTED
WORK MAY PROCEED SUBJECT TO
INCORPORATION OF ENDORSED
COMMENTS

☐ CODE 3 RESUBMIT FOR APPROVAL
WORK MAY NOT PROCEED

☐ CODE 4 REJECTED

BY: _____ DATE: _____

Approval shall not relieve the contractor of any of his
obligations under the Contract or constitute a limitation of
any change to Contract Documents or variations to the works.
Contractor is responsible for dimensions, quantities and
coordination with other trades.

NOTES :-

- 1: ALL DIMENSIONS ARE IN MM UNLESS OTHERWISE INDICATED.
- 2: ALL LEVELS ARE IN METERS UNLESS OTHERWISE INDICATED.
- 3: DO NOT SCALE THE DRAWINGS FOLLOW THE WRITTEN DIMENSIONS ONLY.
- 4: ALL GRC WORKS MINIMUM THICKNESS OF THE SKIN IS 10 TO 12 MM THICK.
- 5: ALL GRC WORKS ARE WHITE SMOOTH FINISHED WITH S.S FITTINGS.



AS BUILT DWG

PROJECT:
**JUMEIRAH PARK
525-VILLAS
4V-LEGASY**

CLIENT:
NAKHEEL
EXTRATES TOWERS
19th LEVEL
P.O. BOX - 1777
DUBAI - UAE
TEL : 04-3903335
FAX : 04-3903335

SUBMITTING CONSULTANT:
dar al-handasah
shair and partners
ARCHITECTS - ENGINEERS - PLANNERS

Main Contractor
Pauling Middle East
P.O. BOX: 41176, ABU DHABI, U.A.E.
PHONE : + 971-2-4529922
FAX : + 971-2-4529922
E-MAIL : pauling@middleeast.ae


SUB CONTRACTOR FOR G.R.C WORKS:
SPEED HOUSE
TEL: 7422927 - P.O. BOX: 1631, AMAN, U.A.E.
Fax 06 7427777 (e-mail: info@speedhouse.com)

CAD BY	CHECKED BY	APPROVED BY
S Khan	RM	RM



DRAWING TITLE:
ITEM NO PM-32

DWG NO:
SH / PME / JP / AB / LE / GRC / 017A


ITEM NO PM-33

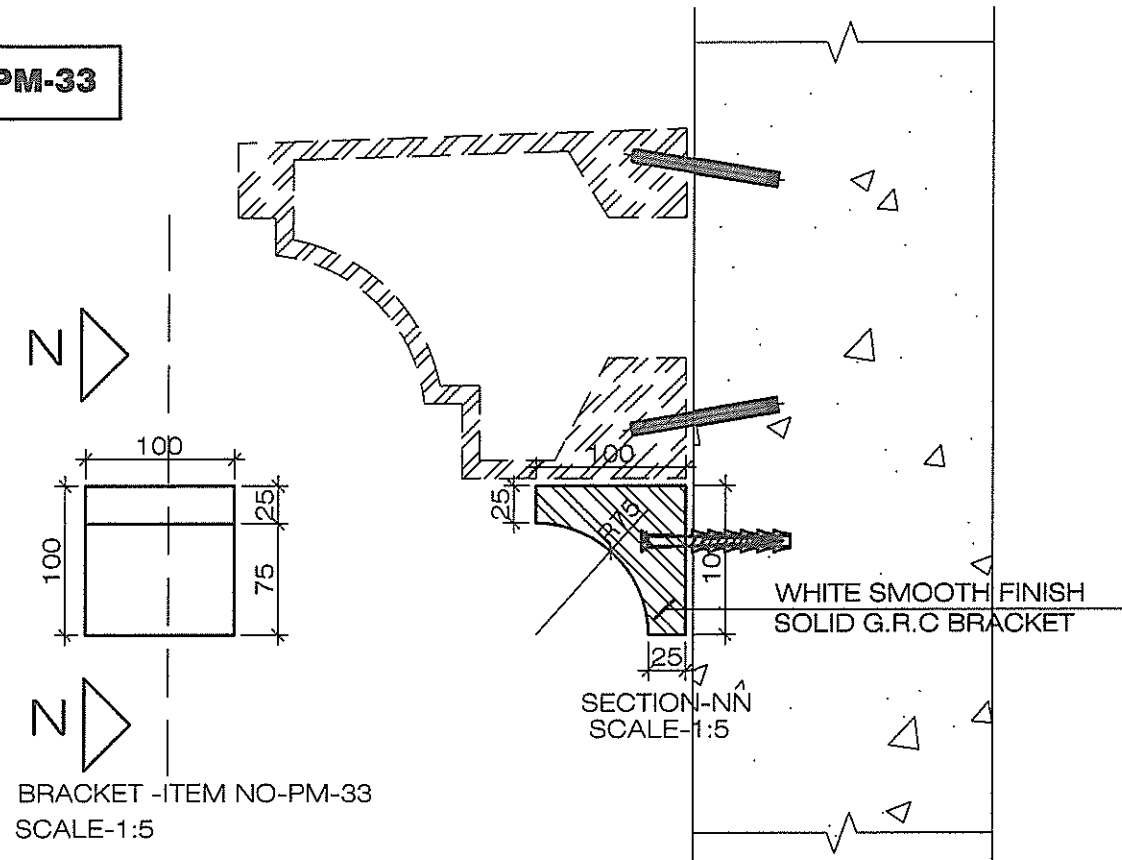

ITEM NO PM-34

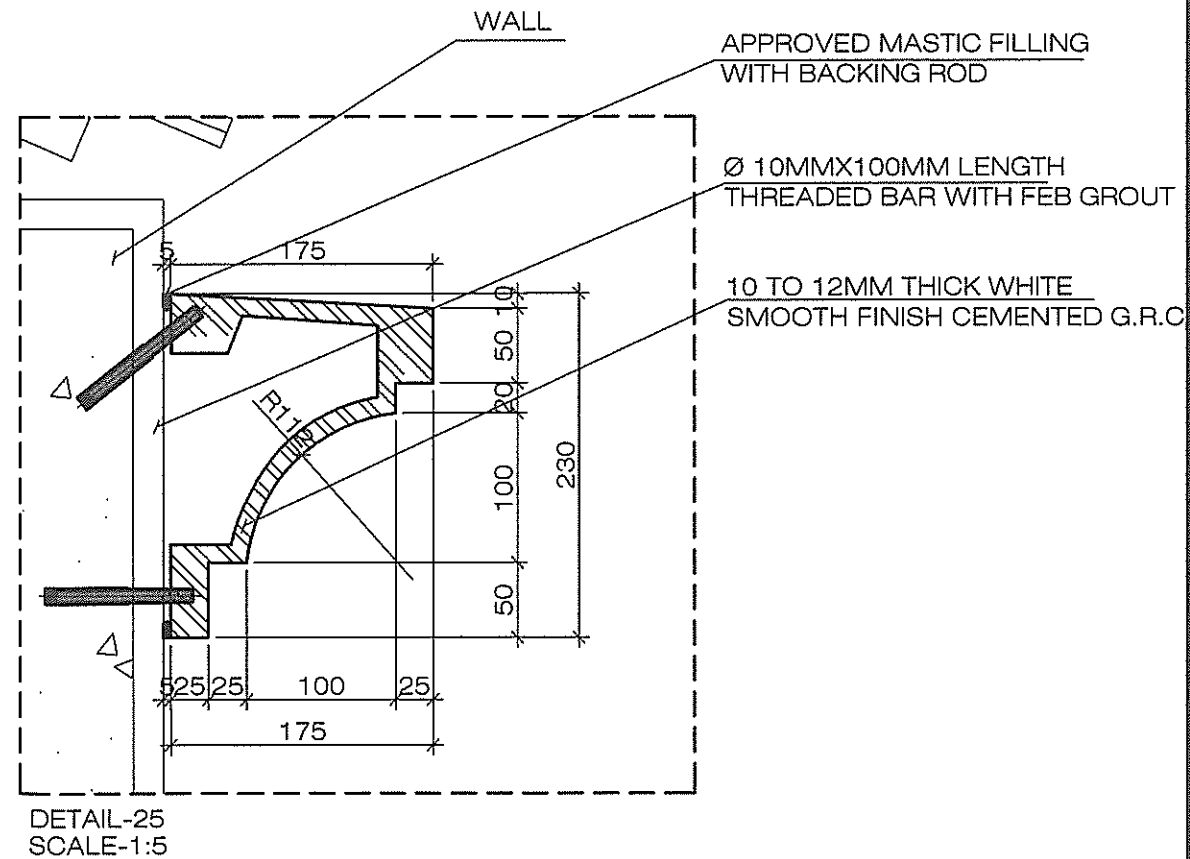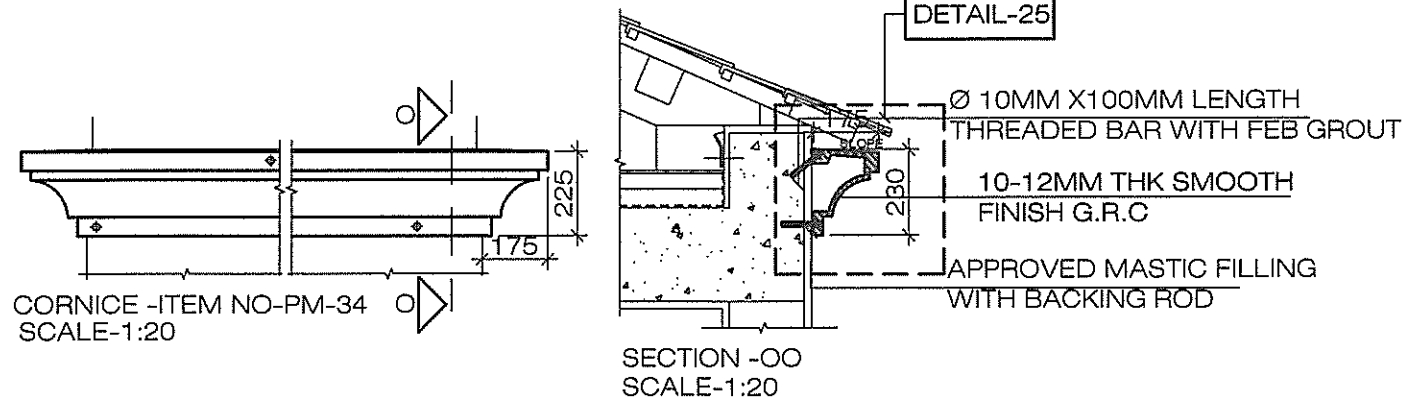

dar al-handasah Shair and Partners	
☒	CODE 1 APPROVED
☐	CODE 2 APPROVED AS NOTED WORK MAY PROCEED SUBJECT TO INCORPORATION OF ENFORCED COMMENTS
☐	CODE 3 RESUBMIT FOR APPROVAL WORK MAY NOT PROCEED
☐	CODE 4 REJECTED
BY: DATE:	
Approval shall not relieve the contractor of any of his obligations under the Contract documents or the obligation of any change to Contract Documents. The contractor is responsible for coordination of the works. Contractor is responsible for dimensions, quantities and coordination with other trades.	

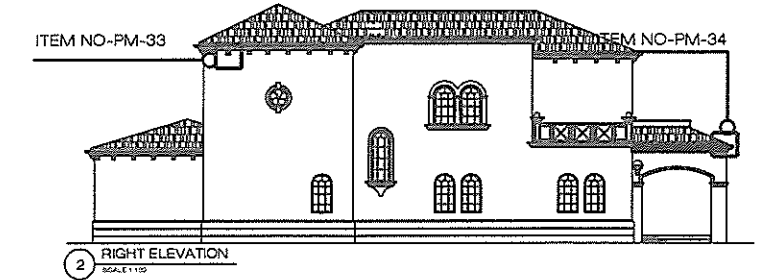

NOTES :-

- 1 : ALL DIMENSIONS ARE IN MM UNLESS OTHERWISE INDICATED.
- 2 : ALL LEVELS ARE IN METERS UNLESS OTHERWISE INDICATED.
- 3 : DO NOT SCALE THE DRAWINGS FOLLOW THE WRITTEN DIMENSIONS ONLY.
- 4 : ALL GRC WORKS MINIMUM THICKNESS OF THE SKIN IS 10 TO 12 MM THICK.
- 5 : ALL GRC WORKS ARE WHITE SMOOTH FINISHED WITH S.S FITTINGS



AS BUILT DWG

PROJECT:
**JUMEIRAH PARK
525-VILLAS
4V-LEGASY**

CLIENT:
NAKHEEL
ESTATES TRAKS
15th LEVEL
P.O. BOX - 27777
DUBAI - UAE
TEL : 04-3003388
FAX : 04-3003335

SUBMITTING CONSULTANT:
dar al-handasah
shair and partners
ENGINEERS ARCHITECTS INTERIORS

Main Contractor
Pauling Middle East
P.O. BOX : 45176, ABU DHABI, U.A.E.
PHONE : + 971-2-4629922
FAX : + 971-2-4629922
E-MAIL : pauling@pauling.com


SUB CONTRACTOR FOR G.R.C WORKS:
SPEED HOUSE
SPEED HOUSE
TEL: 7453925 - P.O. BOX: 1451, AMAN, U.A.E.
Fax 06 7477114 - email: sncspeed@speedhouse.com

CAD BY	CHECKED BY	APPROVED BY
S Khan	RM	RM



DRAWING TITLE:
ITEM NO PM-33,34

DWG NO:
SH / PME / JP / AB / LE / GRC / 018A

ITEM NO PM-36

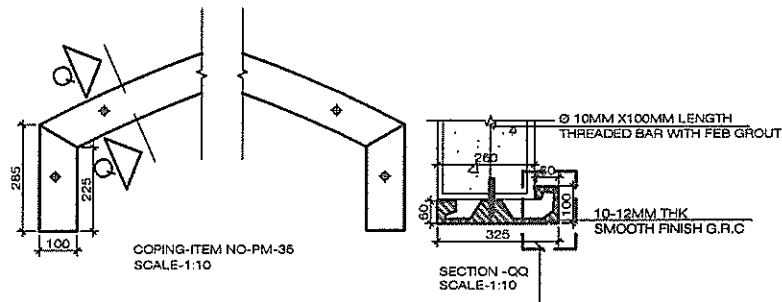

DETAIL-27

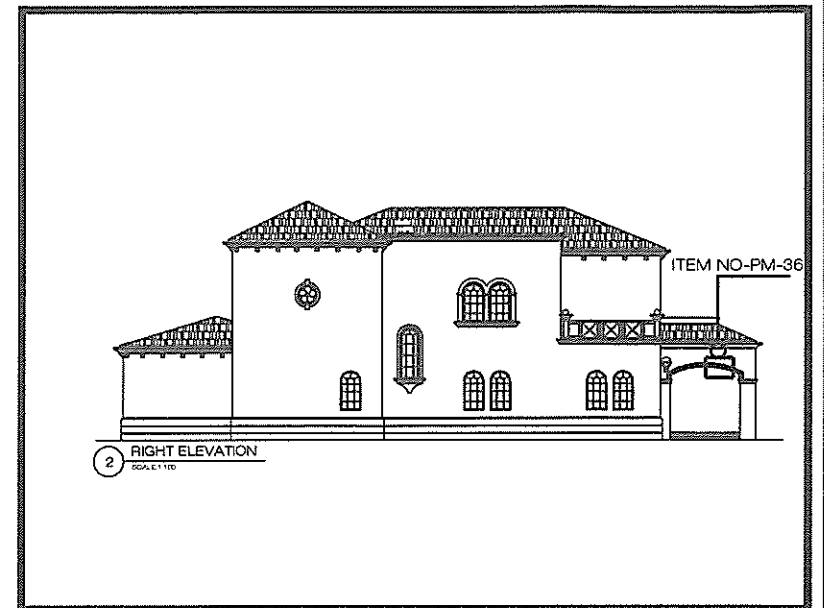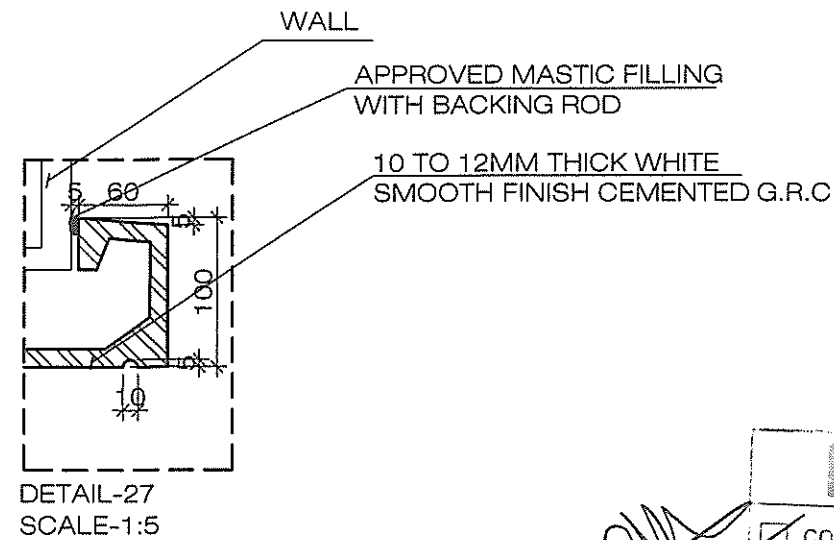

NOTES :-

- 1: ALL DIMENSIONS ARE IN MM UNLESS OTHERWISE INDICATED.
- 2: ALL LEVELS ARE IN METERS UNLESS OTHERWISE INDICATED.
- 3: DO NOT SCALE THE DRAWINGS FOLLOW THE WRITTEN DIMENSIONS ONLY.
- 4: ALL GRC WORKS MINIMUM THICKNESS OF THE SKIN IS 10 TO 12 MM THICK.
- 5: ALL GRC WORKS ARE WHITE SMOOTH FINISHED WITH S.S FITTINGS



dar al-handasah
Shar and Partners

☒ CODE 1 APPROVED



☐ CODE 2 APPROVED AS NOTED
WORK MAY PROCEED SUBJECT TO
INCORPORATION OF ENFORCED
COMMENTS

☐ CODE 3 RESUBMIT FOR APPROVAL
WORK MAY NOT PROCEED

☐ CODE 4 REJECTED

BY: _____ DATE: _____

Approval shall not relieve the contractor of his obligations under the Contract or of his responsibility of any change to Contract Documents or of the works. Contractor is responsible for dimensions, quantities and coordination with other trades.

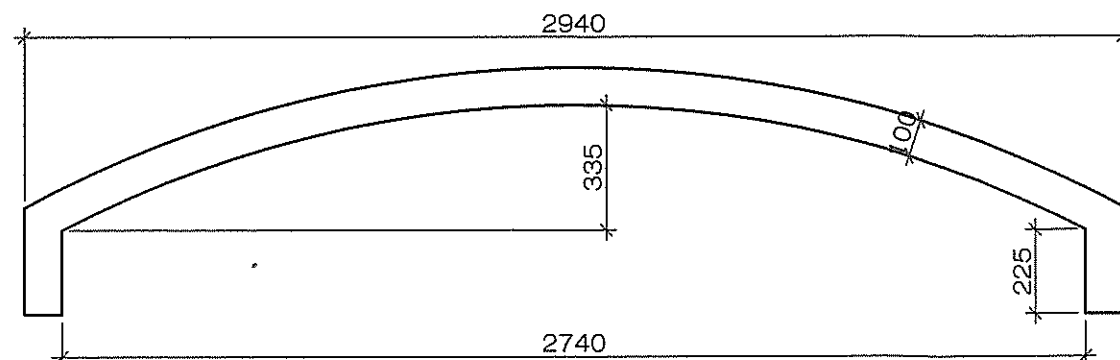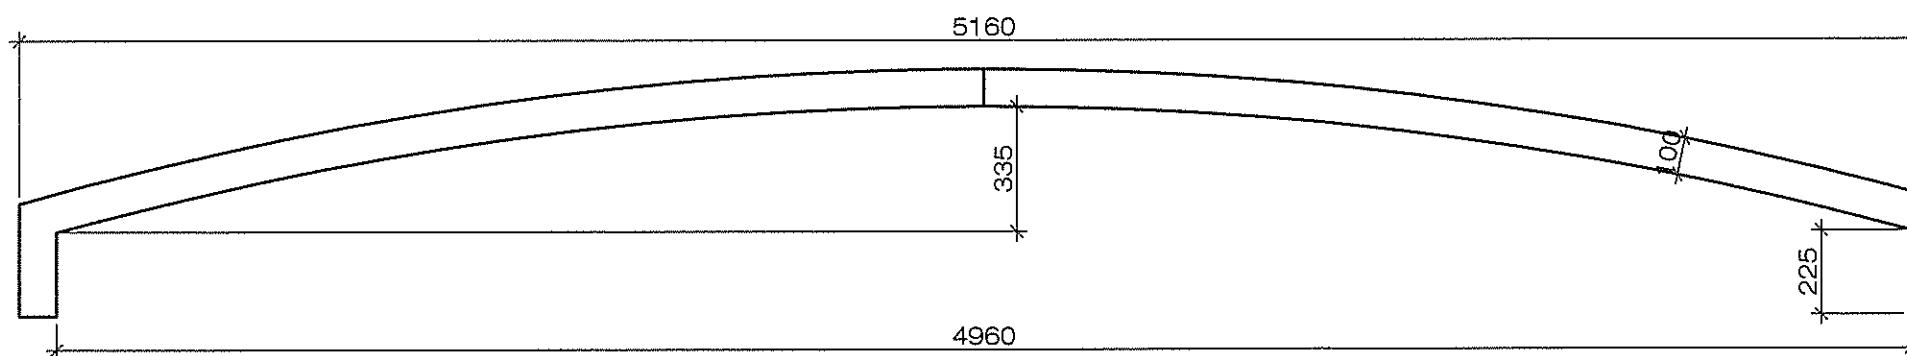

AS BUILT DWG

PROJECT:
**JUMEIRAH PARK
525-VILLAS
4V-LEGASY**

CLIENT:
NAKHEEL
DEKHTAS TOWERS
15TH LEVEL
P.O. BOX - 17777
DUBAI - UAE
TEL : 04-3303333
FAX : 04-3303335

SUBMITTING CONSULTANT:
dar al-handasah
Shar and Partners

Main Contractor
Pauling Middle East
P.O. BOX: 45176, ARJUN, U.A.E.
PHONE : + 971 - 2 - 622922
FAX : + 971 - 2 - 622923
E-MAIL : pauling@pauling.com.ae


SUB CONTRACTOR FOR G.R.C WORKS:
SPEED HOUSE
TEL: 7462929 - P.O. BOX: 3651, ADJMAN, U.A.E.
Fax: 66 7437714 - e-mail: info@speedhouse.com

CAD BY	CHECKED BY	APPROVED BY
S Khan	RM	RM


DRAWING TITLE:
ITEM NO PM-36

DWG NO:
SH / PME / JP / AB / LE / GRC / 019A

ITEM NO PM-37

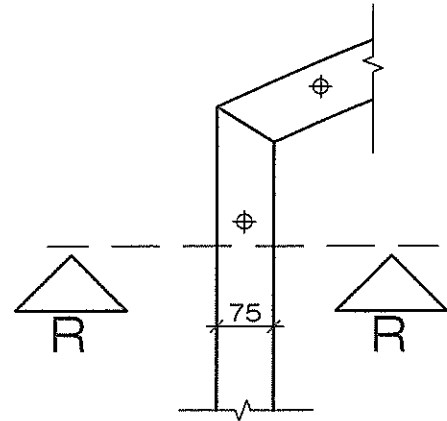


G.R.C.SOLID BAND-ITEM NO-PM-37
SCALE-1:10

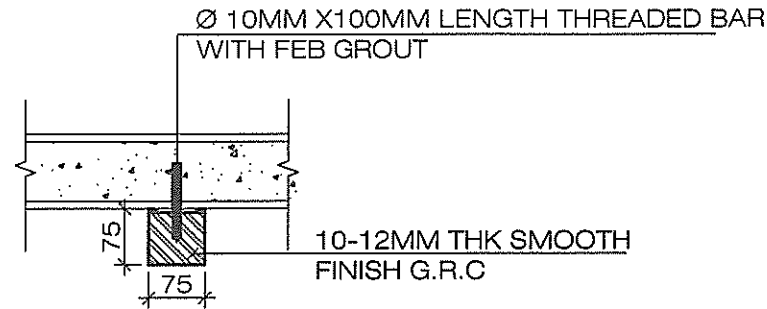


SECTION -RR
SCALE-1:10

ITEM NO PM-38

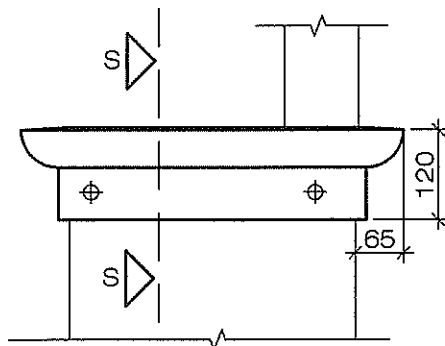


CORNICE-ITEM NO-PM-38
SCALE-1:10

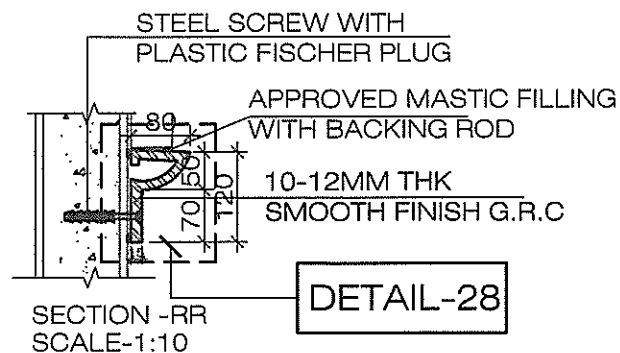

SECTION -RR
SCALE-1:10

DETAIL-28

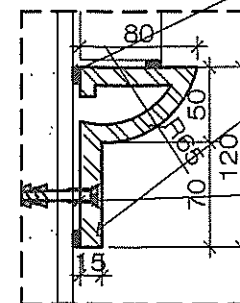


DETAIL-28
SCALE-1:5

APPROVED MASTIC FILLING
WITH BACKING ROD

10 TO 12MM THICK WHITE
SMOOTH FINISH CEMENTED G.R.C

STEEL SCREW WITH PLASTIC
FISCHER PLUG

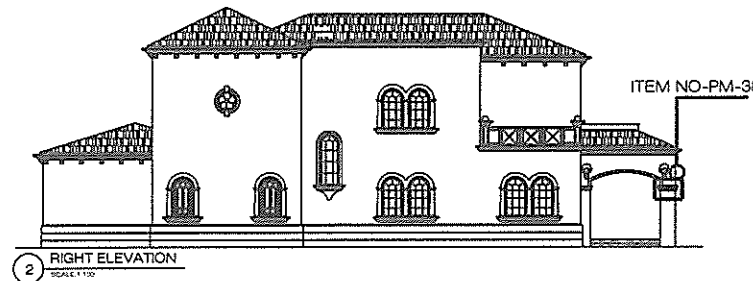

NOTES :-

- 1 : ALL DIMENSIONS ARE IN MM UNLESS OTHERWISE INDICATED.
- 2 : ALL LEVELS ARE IN METERS UNLESS OTHERWISE INDICATED.
- 3 : DO NOT SCALE THE DRAWINGS FOLLOW THE WRITTEN DIMENSIONS ONLY.
- 4 : ALL GRC WORKS MINIMUM THICKNESS OF THE SKIN IS 10 TO 12 MM THICK.
- 5 : ALL GRC WORKS ARE WHITE SMOOTH FINISHED WITH S.S FITTINGS



AS BUILT DWG

PROJECT:
**JUMEIRAH PARK
525-VILLAS
4V-LEGASY**

CLIENT:
NAKHEEL
EMIRATES TOWERS
15th LEVEL
P.O. BOX - 2777
DUBAI - UAE
TEL : 04-3503314
FAX : 04-3503335

SUBMITTING CONSULTANT:
dar al-handasah
shair and partners
ARCHITECTS
ENGINEERS
INTERIORS

Main Contractor
Pauling Middle East
P.O. BOX: 45176, ABU DHABI, U.A.E.
PHONE : + 971-2-4329922
FAX : + 971-2-4324153
E-MAIL : pauling1@comcast.net.ae

SUB CONTRACTOR FOR G.R.C WORKS:
SPEED HOUSE
TEL: 742220 P.O. BOX: 1651, AMMAN, U.A.E.
TEL: 06 741771 E-MAIL: info@speedhouse.com

CAD BY	CHECKED BY	APPROVED BY
S Khan	RM	RM

DRAWING TITLE:
ITEM NO PM-37,38


DWG NO:
SH / PME / JP / AB / LE / GRC / 020A

dar al-handasah
Shair and Partners





☒ CODE 1	APPROVED
☐ CODE 2	APPROVED AS NOTED WORK MAY PROCEED SUBJECT TO INCORPORATION OF ENDORSED COMMENTS
☐ CODE 3	RESUBMIT FOR APPROVAL WORK MAY NOT PROCEED
☐ CODE 4	REJECTED

BY: _____ DATE: _____

Approval shall not relieve the contractor of his obligations under the Contract or contract of any change to Contract Documents or to the works. Contractor is responsible for dimensions, quantities and coordination with other trades.

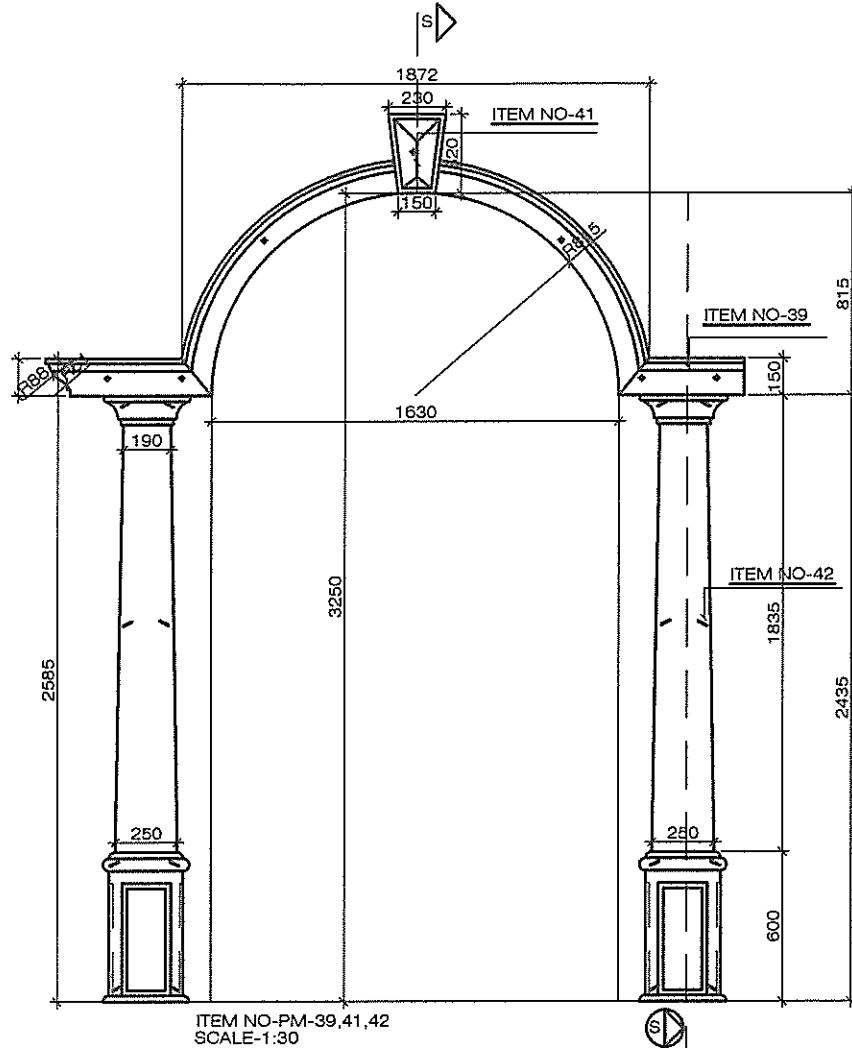

ITEM NO PM-39,41,42

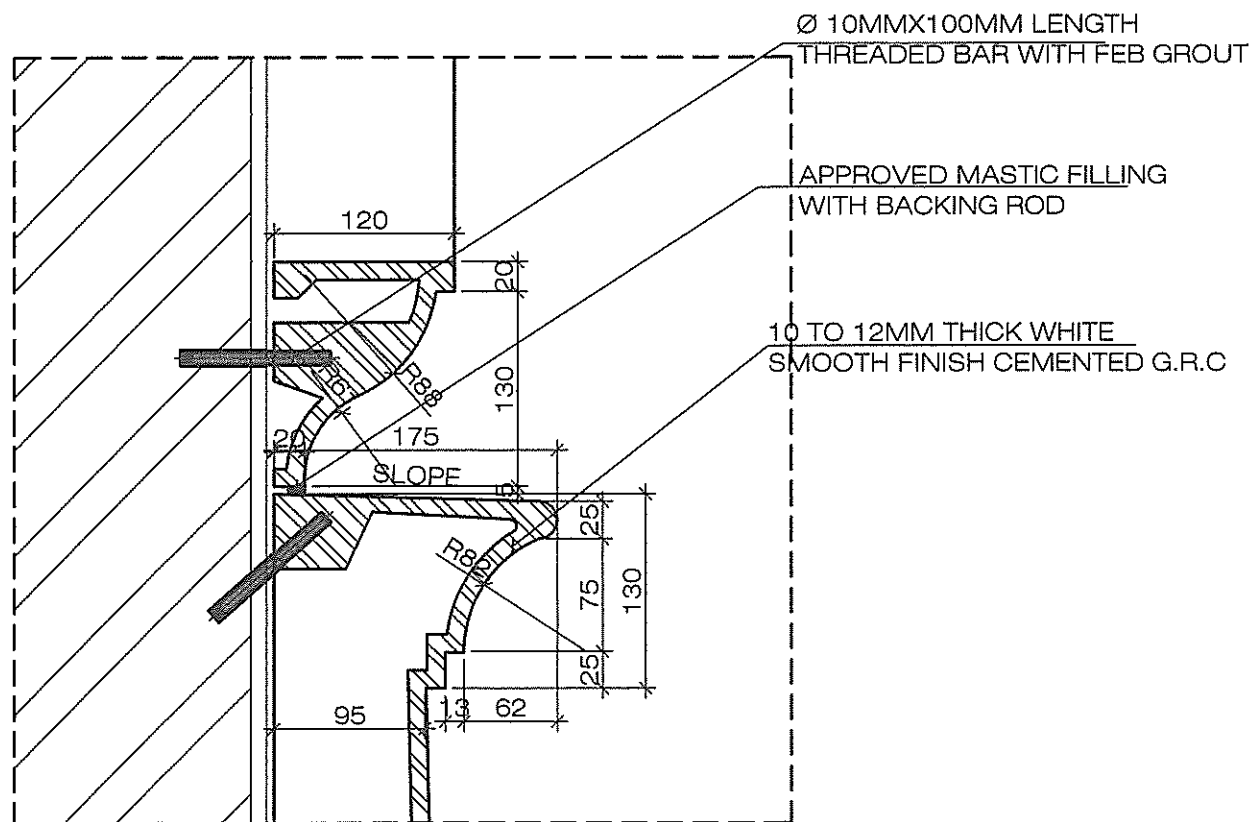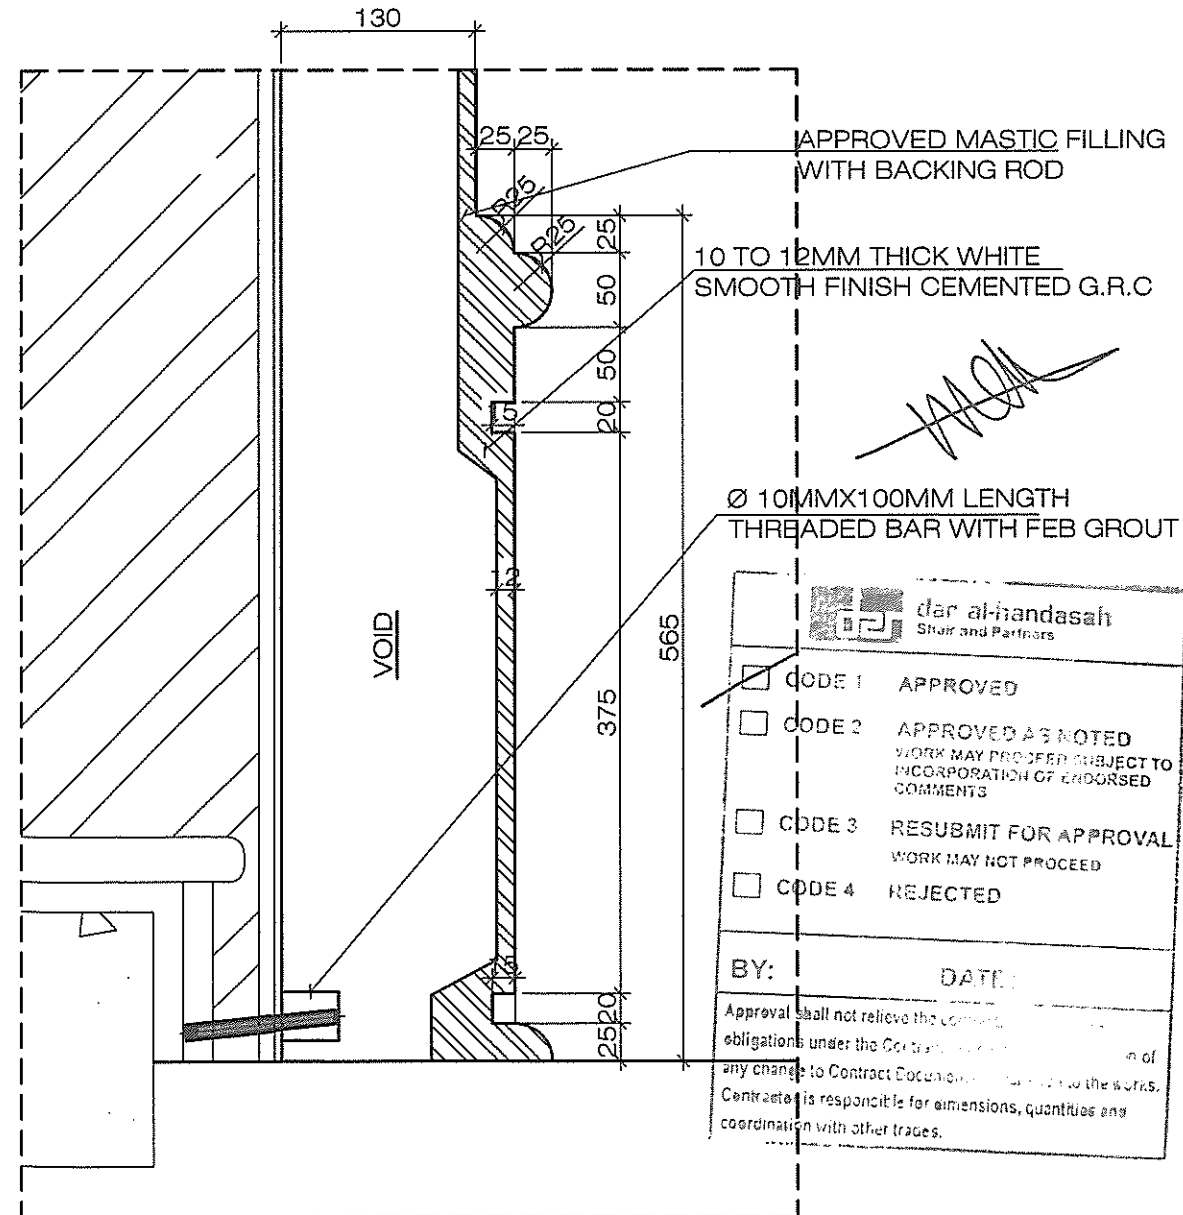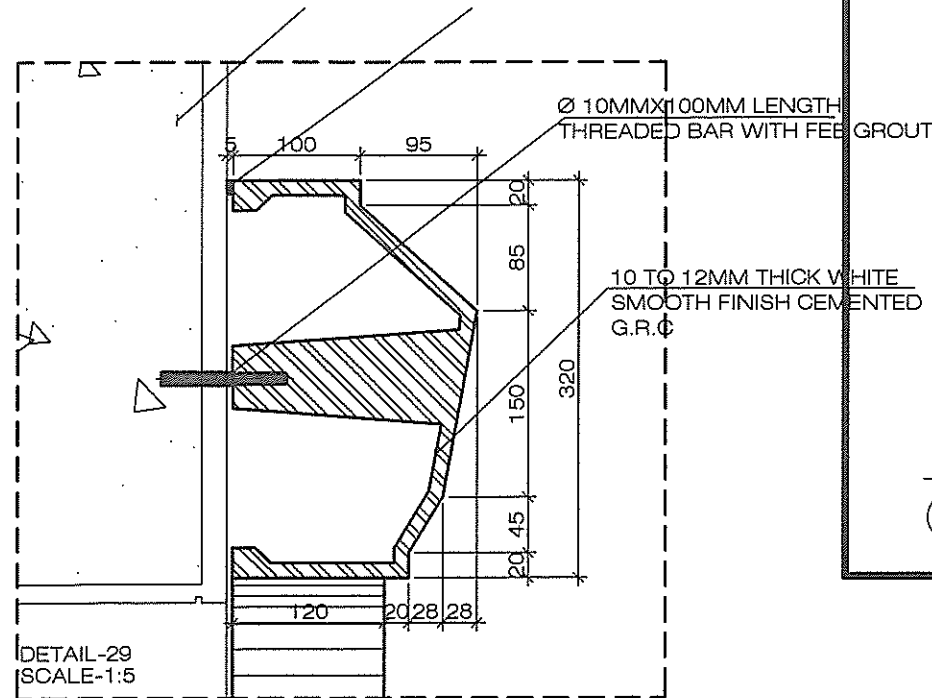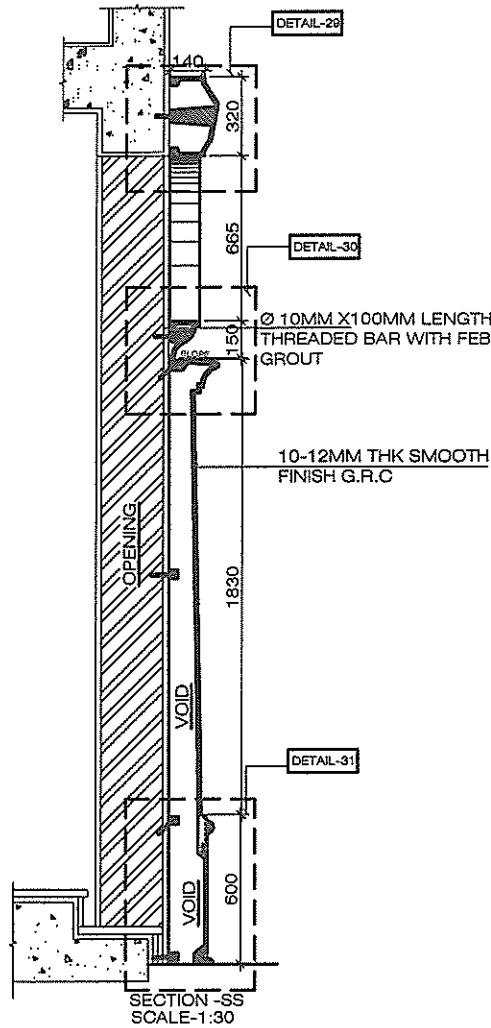

- NOTES :-**
- 1: ALL DIMENSIONS ARE IN MM UNLESS OTHERWISE INDICATED.
 - 2: ALL LEVELS ARE IN METERS UNLESS OTHERWISE INDICATED.
 - 3: DO NOT SCALE THE DRAWINGS FOLLOW THE WRITTEN DIMENSIONS ONLY.
 - 4: ALL GRC WORKS MINIMUM THICKNESS OF THE SKIN IS 10 TO 12 MM THICK.
 - 5: ALL GRC WORKS ARE WHITE SMOOTH FINISHED WITH S.S FITTINGS.



AS BUILT DWG

PROJECT:
JUMEIRAH PARK 525-VILLAS 4V-LEGASY

CLIENT:
NAKHEEL
DUBAI TRUST
P.O. BOX - 1777
DUBAI - UAE
TEL : 04-3803333
FAX : 04-3803333

SUBMITTING CONSULTANT:
dar al-handasah
Shair and Partners
ARCHITECTS - ENGINEERS - INTERIORS

Main Contractor
Pauling Middle East
P.O. BOX: 45174, ABU DHABI, U.A.E.
PHONE : + 971-2-4529923
FAX : + 971-2-4529923
E-MAIL : pauling@middleeast.ae


SUB CONTRACTOR FOR G.R.C WORKS:
SPEED HOUSE
TEL: 7402929 - P.O. BOX 1861, AJMAN, U.A.E.
Fax: 06-7477714 e-mail: info@speedhouse.ae

CAD BY	CHECKED BY	APPROVED BY
S Khan	RM	RM


DRAWING TITLE:
ITEM NO PM-39,41,42

DWG NO:
SH / PME / JP / AB / LE / GRC / 021A


☐ CODE 1	APPROVED
☐ CODE 2	APPROVED AS NOTED WORK MAY PROCEED SUBJECT TO INCORPORATION OF ENDORSED COMMENTS
☐ CODE 3	RESUBMIT FOR APPROVAL WORK MAY NOT PROCEED
☐ CODE 4	REJECTED
BY: _____ DATE: _____	
Approval shall not relieve the contractor of his obligations under the Contract and shall not constitute any change to Contract Documents. The contractor is responsible for dimensions, quantities and coordination with other trades.	

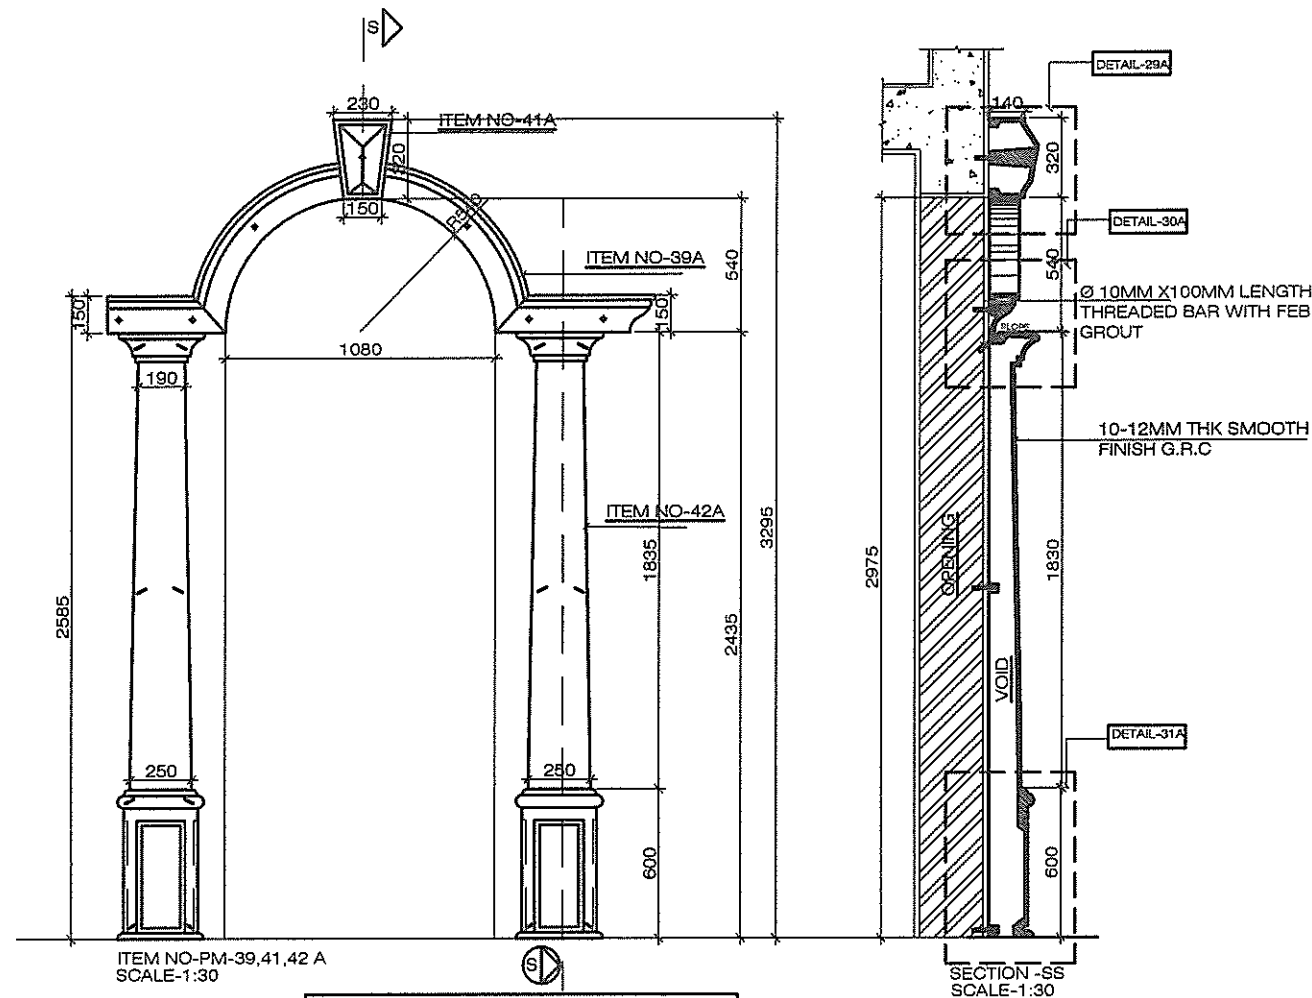


ITEM NO PM-39,41,42-A

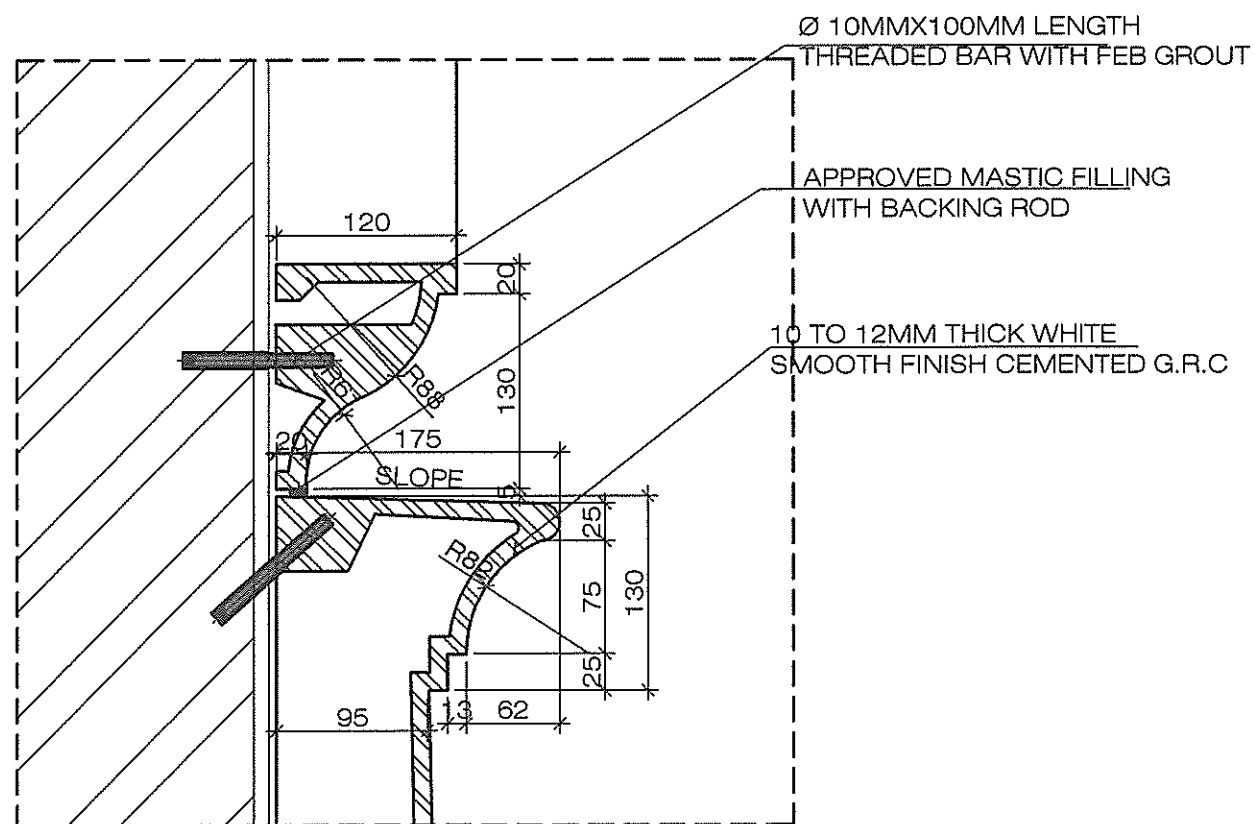


DETAIL-30A
SCALE-1:5

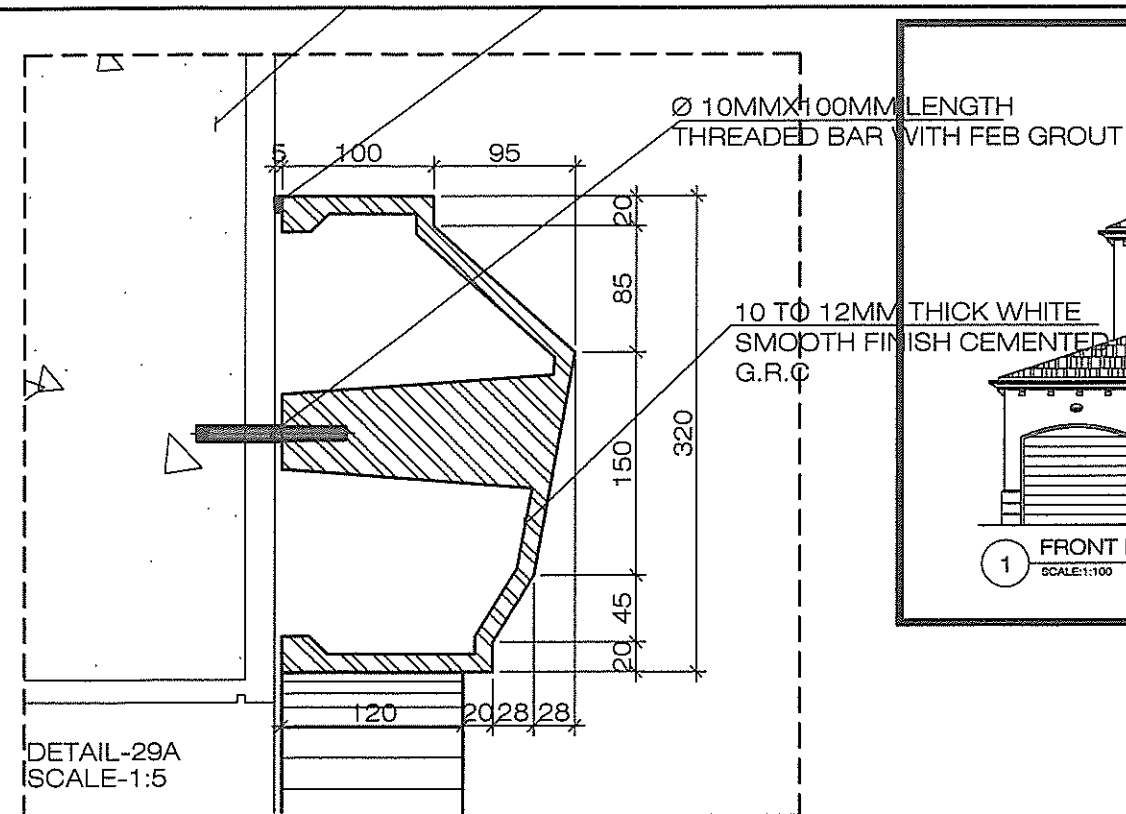

DETAIL-29A
SCALE-1:5

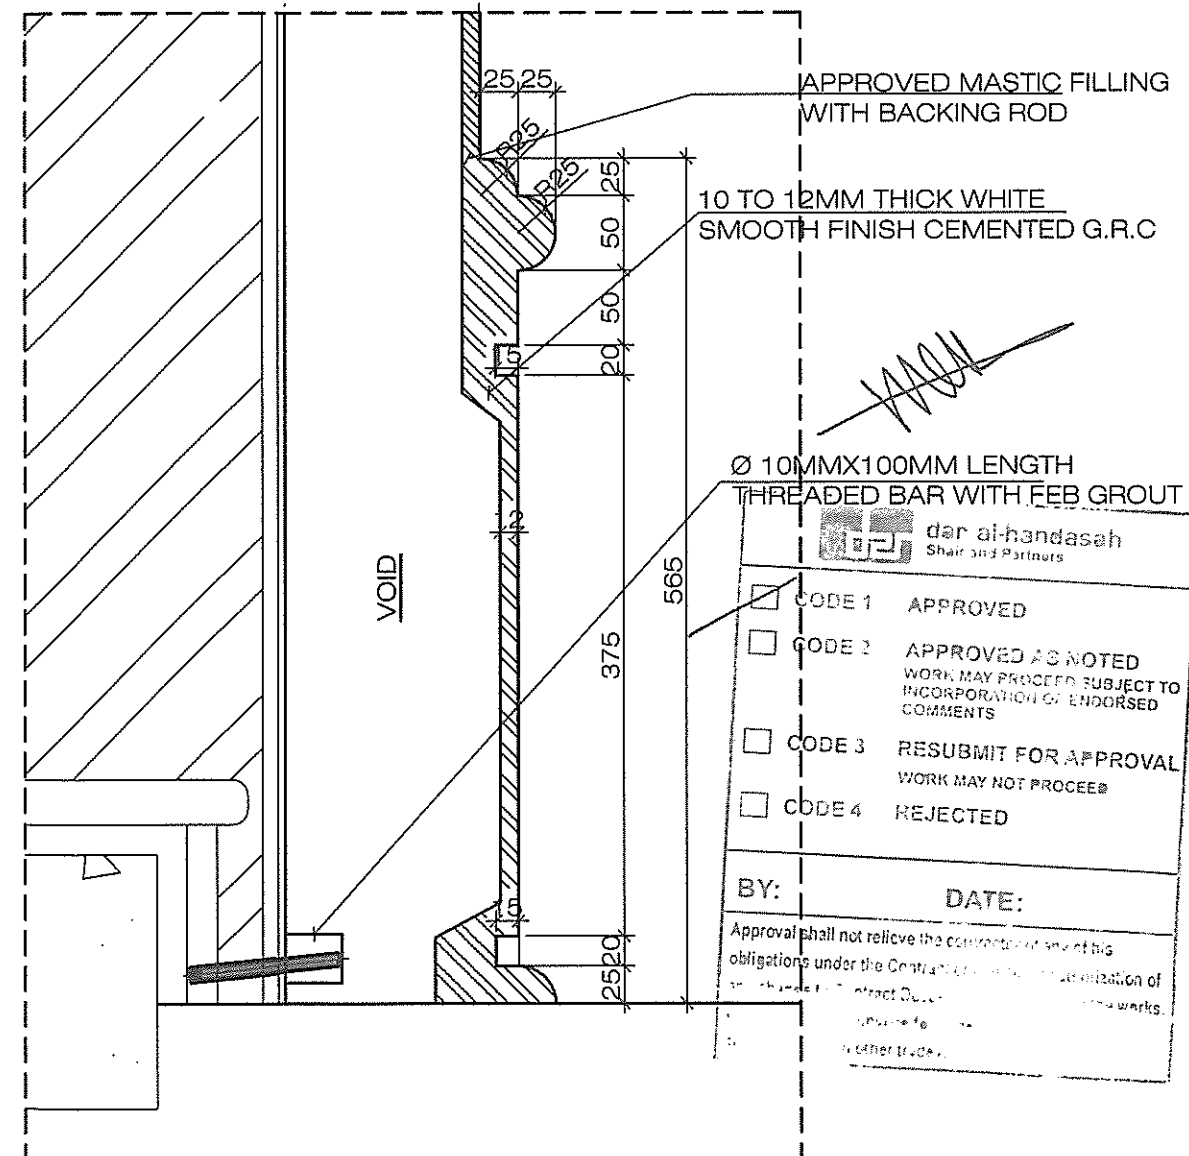

DETAIL-31A
SCALE-1:5

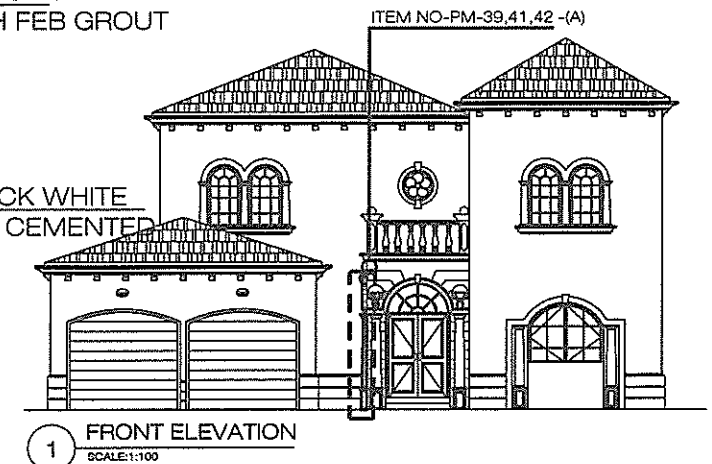

NOTES :-

- 1 : ALL DIMENSIONS ARE IN MM UNLESS OTHERWISE INDICATED.
- 2 : ALL LEVELS ARE IN METERS UNLESS OTHERWISE INDICATED.
- 3 : DO NOT SCALE THE DRAWINGS FOLLOW THE WRITTEN DIMENSIONS ONLY.
- 4 : ALL GRC WORKS MINIMUM THICKNESS OF THE SKIN IS 10 TO 12 MM THICK.
- 5 : ALL GRC WORKS ARE WHITE SMOOTH FINISHED WITH S.S FITTINGS



AS BUILT DWG

PROJECT:
JUMEIRAH PARK 525-VILLAS
4V-LEGACY

CLIENT:
NAKHEEL
CREATES TOMORROW
18th LEVEL
P.O. BOX - 17777
DUBAI - UAE
TEL : 04-3903388
FAX : 04-3903335

SUBMITTING CONSULTANT:
dar al-handasah
Shair and Partners
PUNJABI - INDIAN - PAKISTANI - BANGLADESHI - ARAB

Main Contractor
Pauling Middle East
P.O. BOX: 45176, ABU DHABI, U.A.E.
PHONE : + 971-2-4529922
FAX : + 971-2-4529923
E-MAIL : pauling1@middleeast.net.ae

SUB CONTRACTOR FOR G.R.C WORKS:
SPEED HOUSE
TEL: 74632529, P.O. BOX: 1461, ABU DHABI, U.A.E.
fax 06 7437714, e-mail: info@speedhouse.net.ae

CAD BY: S Khan **CHECKED BY:** RM **APPROVED BY:** RM

DRAWING TITLE:
ITEM NO PM-39,41,42-(A)

DWG NO: SH / PME / JP / AB / LE / GRC / 022A