



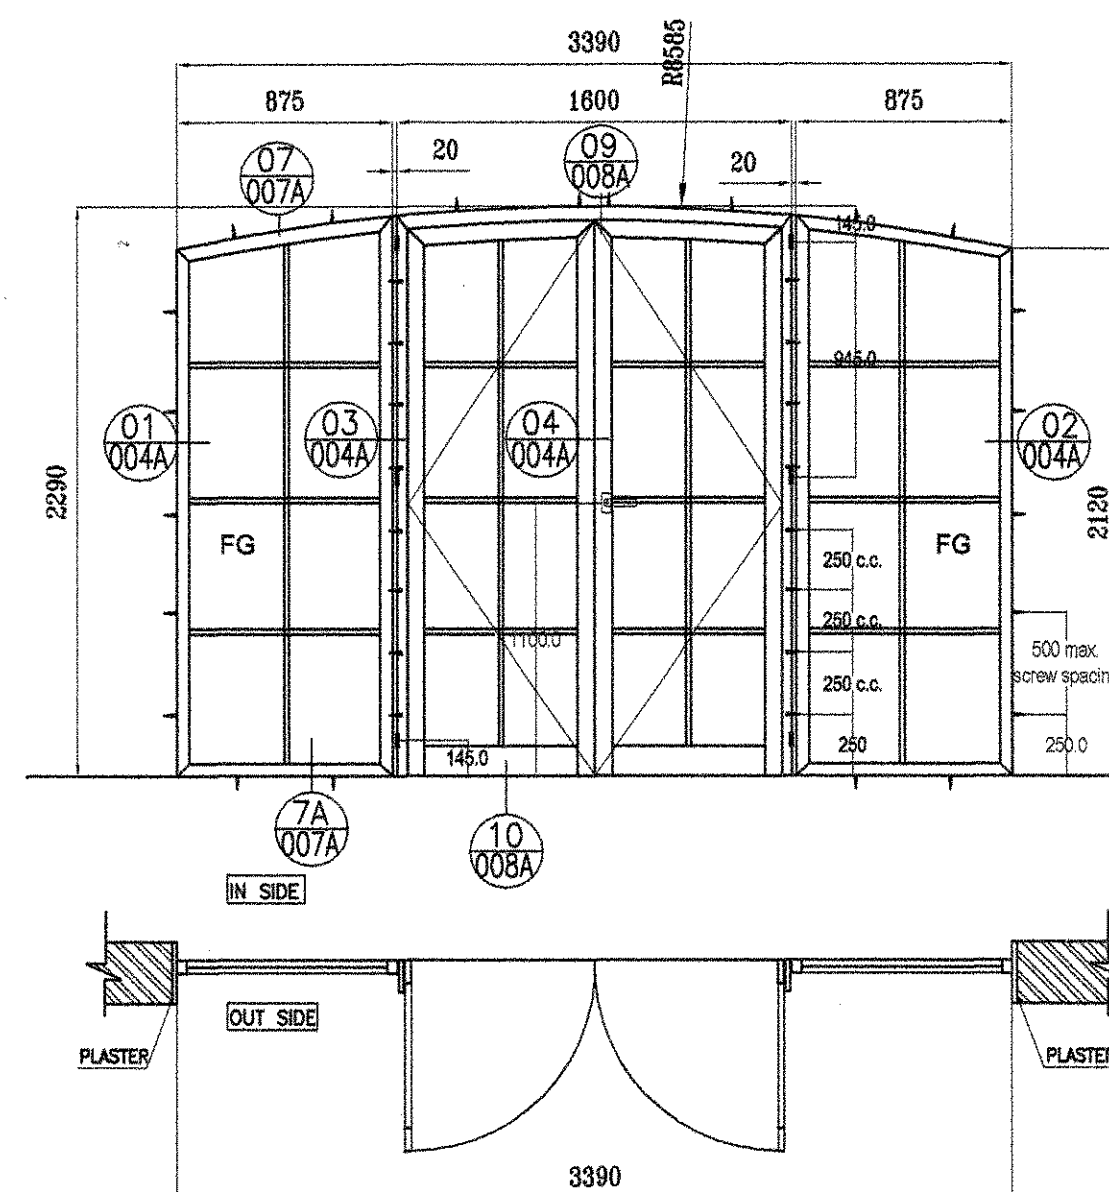


ITEM: DM20 (OUT)
SIZE: 3.39X2.29
G.FLR-FAMILY
QTY: 1 NO

S.I. NO.	DESCRIPTION	CODE NO.	COLOR	QTY
1.	Corner Splice	003.101	BR	4 Pcs
2.	Door Handle	003.664	L1	1 Pairs
3.	Door Lock	003.936	L5	1 Set
4.	Door Rod	003.716	BR	1 Pcs
5.	Door Hinge	003.667	L1	6 Pairs
6.	Cylinder	003.666	BR	1 Pcs
7.	Tower Bolt	003.666	L5	2 Pcs
8.	Fixing Screw	003.041	BR	12 Pcs
9.	Drainage Hole Cover	005.003	L1	4 Pcs
10.	Frame Corner	203.010	BR	2 Pcs
11.	Shutter Corner	308.016	BR	2 Pcs
12.	Shutter Corner	308.012	BR	4 Pcs
13.	Shutter Corner	308.012	BR	4 Pcs
14.	Intermediate Cover	308.538	L1	1 Pair
15.	Joint	308.547	L1	1 Pair
16.	Bottom Screw	308.014	BR	2 Nos
17.	Bottom Screw	003.044	BR	2 Nos
18.	Glazing Rubber	023.204	L5	26 Lm
19.	Glazing Rubber	023.234	L5	26 Lm
20.	Frame Rubber	023.220	L5	12 Lm
21.	Shutter Rubber	023.567	L5	12 Lm
22.	Door Closer	GEZE081000	WHITE	1 No
23.	Door Stopper	DEVON 85.171.61	Satin Finish	2 Nos

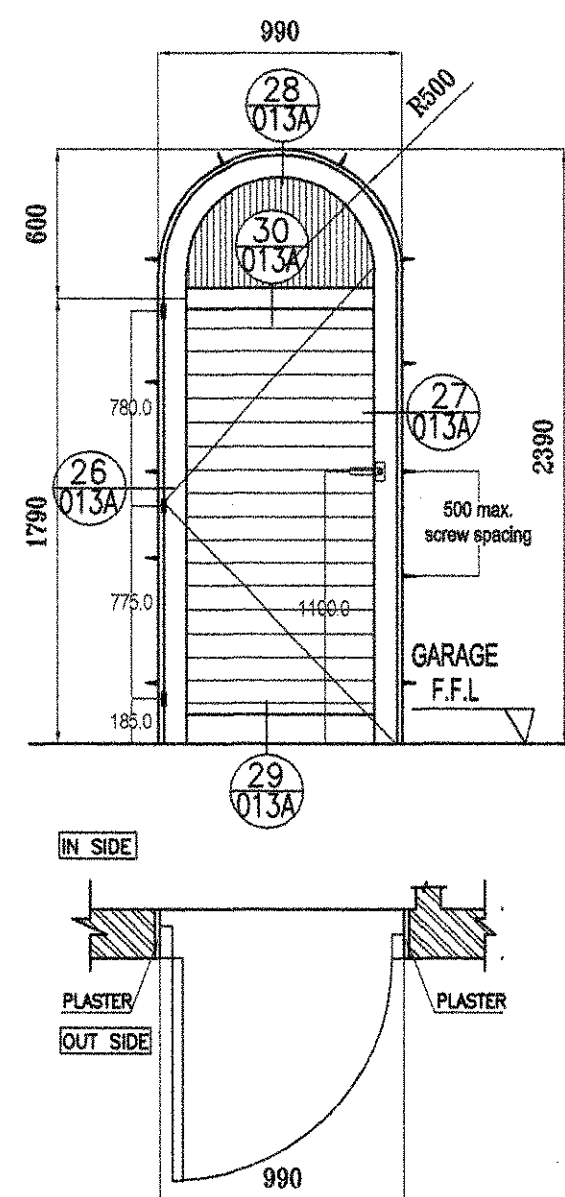

ITEM: DM22 (OUT)
SIZE: 0.99X2.39
G.FLR-PARKING
QTY: 1 NO

S.I. NO.	DESCRIPTION	CODE NO.	COLOR	QTY
1.	Door Handle	003.664	L1	1 Pairs
2.	Door Lock	003.932	L5	1 Set
3.	Door Rod	003.715	BR	1 Pcs
4.	Door Hinge	003.667	L1	3 Pairs
5.	Cylinder	003.666	BR	1 Pcs
6.	Block Screw	005.032	BR	2 Pcs
7.	Shutter Corner	003.299	BR	2 Pcs
8.	Door Hinge Support	003.299	BR	2 Pcs
9.	Frame Rubber	023.220	L5	6.6 Lm
10.	Shutter Rubber	023.567	L5	6.6 Lm

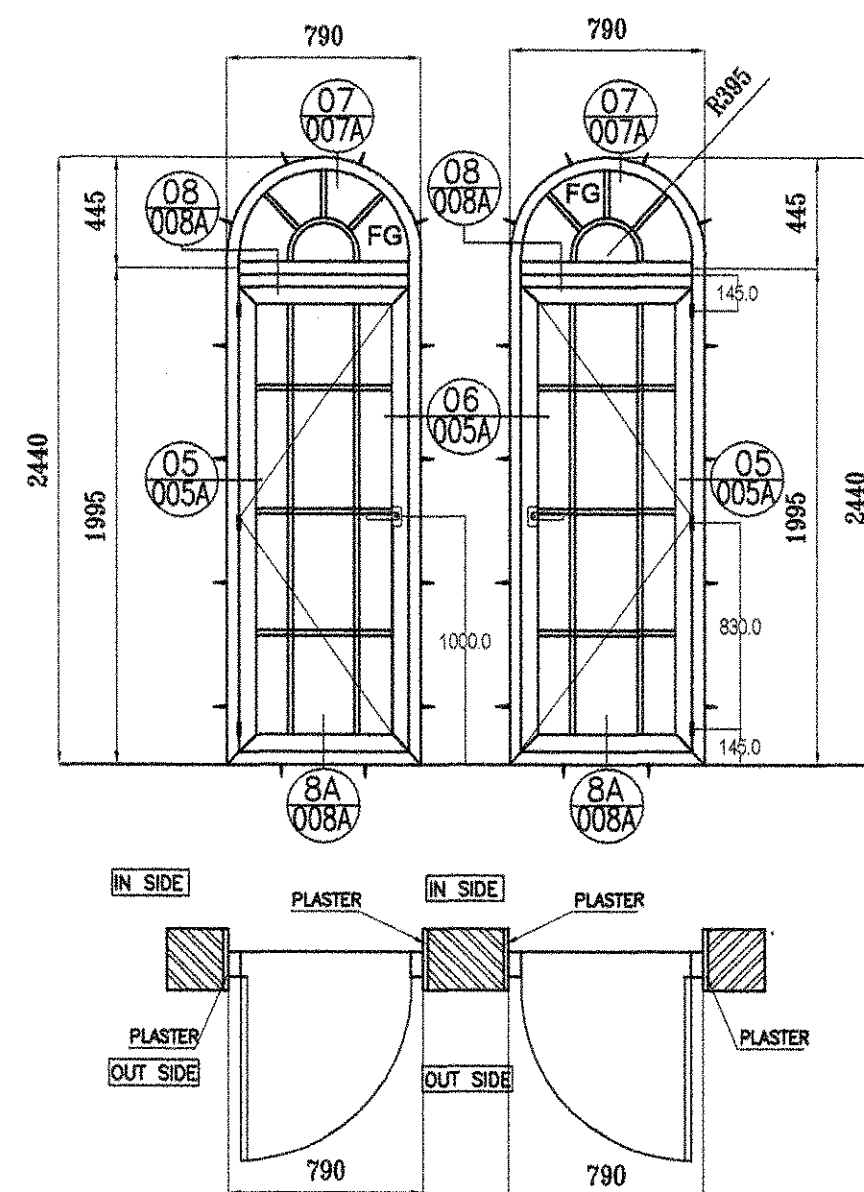

ITEM: DM4 (OUT)
SIZE: 0.79X2.44
F.FLR-M.BED ROOM
QTY: 1 NO

ITEM: DM4' (OUT)
SIZE: 0.79X2.44
F.FLR-M.BED ROOM
QTY: 1 NO

S.I. NO.	DESCRIPTION	CODE NO.	COLOR	QTY
1.	Corner Splice	003.101	BR	12 Pcs
2.	Door Handle	003.664	L1	2 Pairs
3.	Door Lock	003.935	L5	2 Set
4.	Door Rod	003.716	BR	2 Pcs
5.	Door Hinge	003.667	L1	6 Pairs
6.	Cylinder	003.666	BR	2 Pcs
7.	Shower Block	003.432	BR	4 Pcs
8.	Plastic Block	308.054	L1	4 Pcs
9.	Drainage Hole Cover	005.003	L1	4 Pcs
10.	Frame Corner	203.010	BR	4 Pcs
11.	Frame Corner	308.016	BR	4 Pcs
12.	Shutter Corner	203.012	BR	8 Pcs
13.	Shutter Corner	308.012	BR	8 Pcs
14.	Block Screw	003.037	BR	8 Pcs
15.	Glazing Rubber	023.204	L5	18 Lm
16.	Glazing Rubber	023.234	L5	18 Lm
17.	Frame Rubber	023.220	L5	12 Lm
18.	Shutter Rubber	023.567	L5	12 Lm
19.	Door Closer	GEZE081000	WHITE	1 No
20.	Door Stopper	DEVON 85.171.61	Satin Finish	2 Nos

- NOTE :
- FOR THE ELECTRICAL ROOM DOOR REFER DWG No.
 - PME / JP / AB / LE / ALU / 014A
 - PME / JP / AB / LE / ALU / 015A
 - PME / JP / AB / LE / ALU / 016A
 - PME / JP / AB / LE / ALU / 017A
 - FOR THE GAS ROOM DETAILS REFER DWG No.
 - PME / JP / AB / LE / ALU / 018A
 - PME / JP / AB / LE / ALU / 019A
 - PME / JP / AB / LE / ALU / 020A

ALUMINIUM SYSTEM PROFILE

SUB CONTRACTOR :
WHITE ALUMINIUM ENT.

GLAZING SCHEDULE

- For Bath rooms
- Outboard Lite : 6.00mm Blue-tinted Tempered Glass
- Air Space : 12.00mm Dehydrated
- Inboard Lite : 6.00mm Clear Sandblasting Tempered Glass
- For others
- Outboard Lite : 6.00mm Blue body-tinted Tempered Glass
- Air Space : 12.00mm Dehydrated
- Inboard Lite : 6.00mm Clear Tempered Glass

Note:

Reference No. of Detail

Reference No. of Drawing Sheet

AS BUILT DRAWING

JUMEIRAH PARK

NAKHEEL

dar al-handasah
sheir and partners

Pauling Middle East

WHITE ALUMINIUM ENT.

PACKAGE - 2

Cluster - 1

PACKAGE - 2A
Clusters - 1, 3 (Villas 51 to 62), 4, 5, 7 (Villas 33 to 41),
8, 9, 10, 11, 12, 13, 14, 15 (Villas 1 to 14) & 16

ALUMINIUM DOORS ELEVATION
LEGACY VILLAS

Drawn IBRAHIM Review Eng. Ziad Checked: GUGAN

Scale: 1:30 Date: 13-08-2012

Drawing No. **PME / JP / AB / LE / ALU / 002A**

NOTE:
* FOR KEY PLAN & ELEVATION REFER TO DRAWING NO.
PME/JP/AB/LE/ALU/001A

AB 135 41