
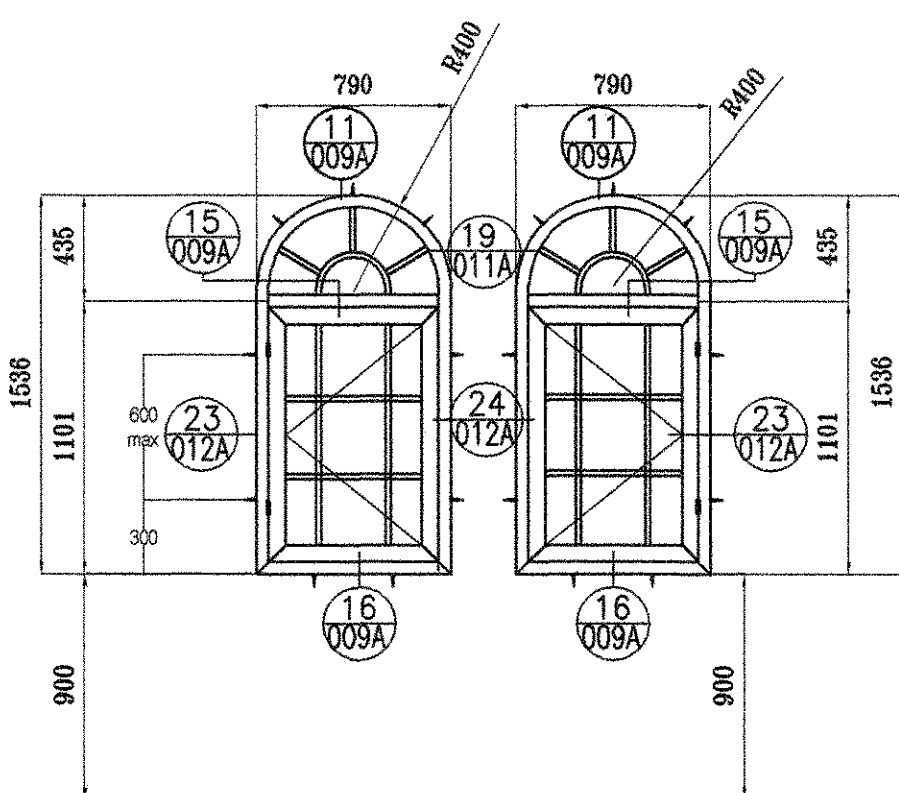
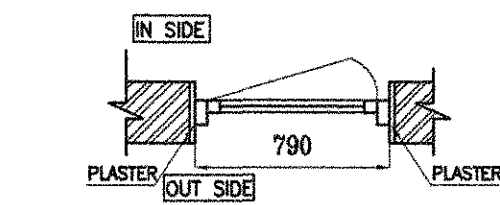



ITEM: WM12
 SIZE: 0.79X1.536
 GF&FF-L/D/F/BED RM
 QTY: 5 NOS

S.I NO.	DESCRIPTION	CODE NO	COLOR	QTY
1.	Corner Splice	003.101	BR	20 Pcs
2.	Window Handle	003.660	L1	10 Pcs
3.	Window Lock Pin	003.666	L5	20 Pcs
4.	Window Lock Keeper	003.670	L5	20 Pcs
5.	Door Hinge	003.657	L1	20 Pairs
6.	Drainage Hole Cover	005.003	L1	20 Pcs
7.	Shear Block	003.432	BR	20 Pcs
8.	Block Screw	003.037	BR	40 Pcs
9.	Plastic Block	308.054	L1	20 Pcs
10.	Frame & Shtr Corner	203.010	BR	60 Pcs
11.	Frame Corner	308.016	BR	20 Pcs
12.	Shutter Corner	308.018	BR	40 Pcs
13.	Glazing Rubber	023.234	L5	60 Lm
14.	Glazing Rubber	023.234	L5	60 Lm
15.	Frame Rubber	023.220	L5	40 Lm
16.	Shutter Rubber	023.567	L5	40 Lm

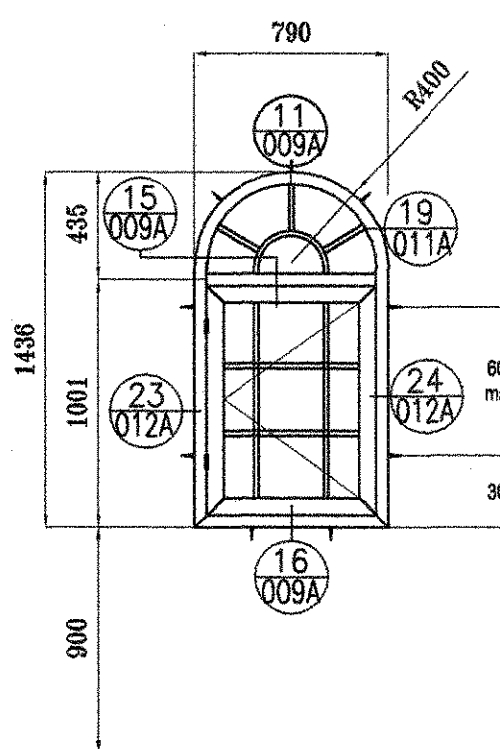


ITEM: WM12A
 SIZE: 0.79X1.436
 G.FLR-BATHROOM
 QTY: 1 NOS



S.I NO.	DESCRIPTION	CODE NO	COLOR	QTY
1.	Corner Splice	003.101	BR	2 Pcs
2.	Window Handle	003.660	L1	1 Pcs
3.	Window Lock Pin	003.666	L5	2 Pcs
4.	Window Lock Keeper	003.670	L5	2 Pcs
5.	Door Hinge	003.657	L1	2 Pairs
6.	Drainage Hole Cover	005.003	L1	2 Pcs
7.	Shear Block	003.432	BR	2 Pcs
8.	Block Screw	003.037	BR	4 Pcs
9.	Plastic Block	308.054	L1	2 Pcs
10.	Frame & Shtr Corner	203.010	BR	6 Pcs
11.	Frame Corner	308.016	BR	2 Pcs
12.	Shutter Corner	308.018	BR	4 Pcs
13.	Glazing Rubber	023.234	L5	6 Lm
14.	Glazing Rubber	023.234	L5	6 Lm
15.	Frame Rubber	023.220	L5	4 Lm
16.	Shutter Rubber	023.567	L5	4 Lm

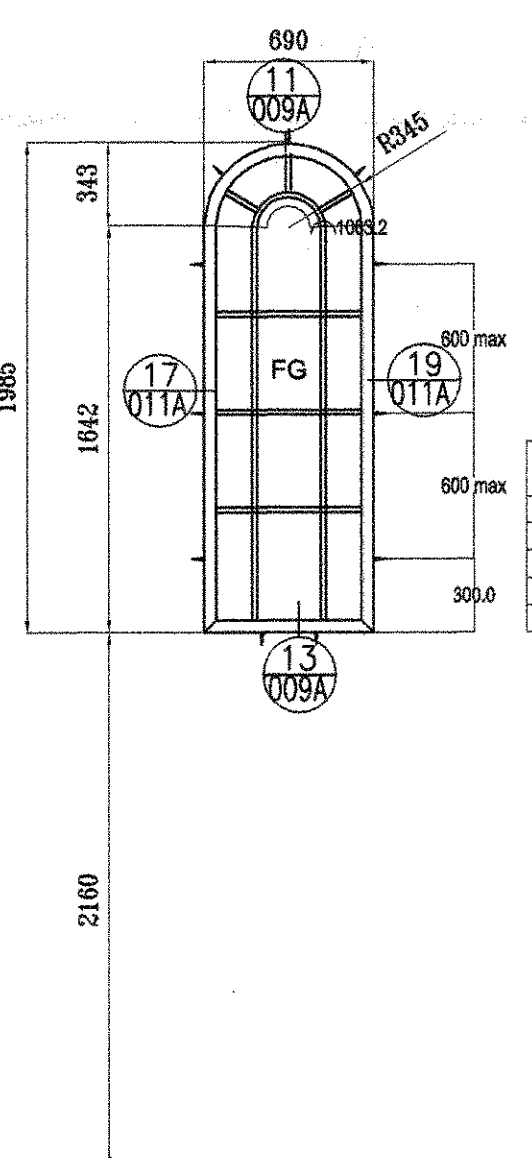

S.I NO.	DESCRIPTION	CODE NO	COLOR	QTY
1.	Corner Splice	003.101	BR	2 Pcs
2.	Frame Corner	203.010	BR	2 Pcs
3.	Frame Corner	308.016	BR	2 Pcs
4.	Glazing Rubber	023.234	L5	5 Lm
5.	Glazing Rubber	023.234	L5	5 Lm


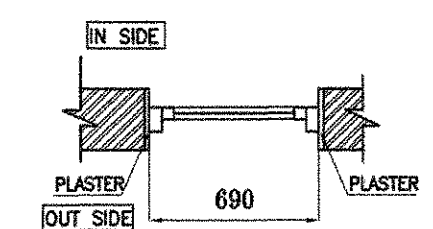


ITEM: WM15
 SIZE: 0.69X1.985
 In between g.f & f.f
 QTY: 1 NO

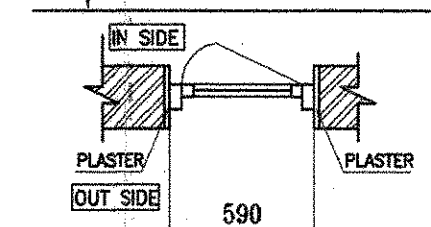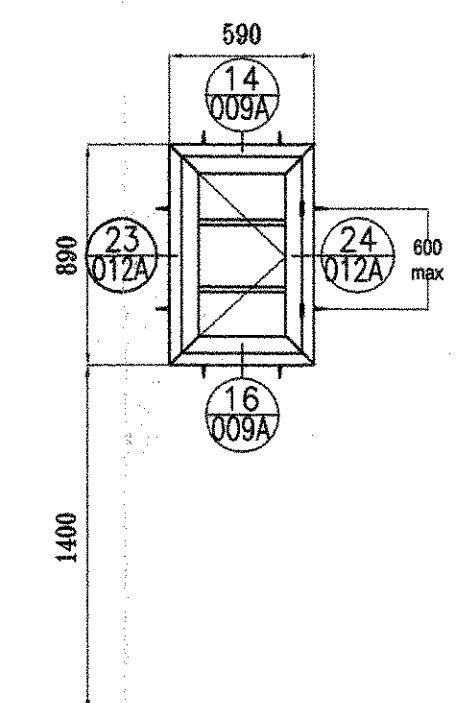



ITEM: WM16
 SIZE: 0.59X0.89
 F.FLR-BATHROOM
 QTY: 2 NOS

S.I NO.	DESCRIPTION	CODE NO	COLOR	QTY
1.	Corner Splice	003.101	BR	4 Pcs
2.	Window Handle	003.660	L1	1 Pcs
3.	Window Lock Pin	003.666	L5	2 Pcs
4.	Window Lock Keeper	003.670	L5	2 Pcs
5.	Door Hinge	003.657	L1	2 Pairs
6.	Drainage Hole Cover	005.003	L1	2 Pcs
7.	Frame & Shtr Corner	203.010	BR	8 Pcs
8.	Frame Corner	308.016	BR	4 Pcs
9.	Shutter Corner	308.018	BR	4 Pcs
10.	Glazing Rubber	023.234	L5	2.96 Lm
11.	Glazing Rubber	023.234	L5	2.96 Lm
12.	Frame Rubber	023.220	L5	2.96 Lm
13.	Shutter Rubber	023.567	L5	2.96 Lm

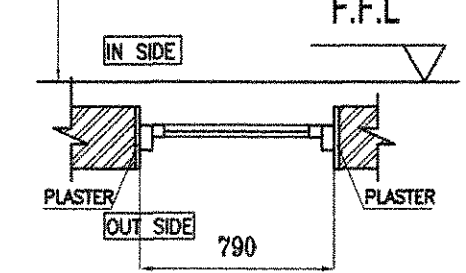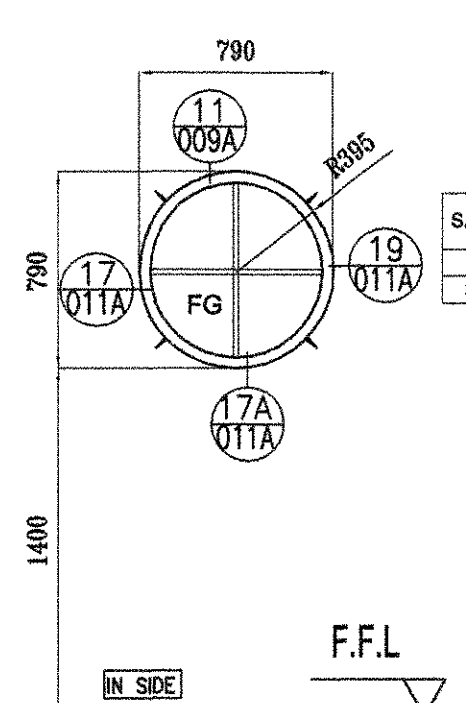

ITEM: WM17
 SIZE: 0.79X0.79
 F.FLR-BATH ROOM
 QTY: 1 NO

S.I NO.	DESCRIPTION	CODE NO	COLOR	QTY
1.	Glazing Rubber	023.204	L5	3 Lm
2.	Glazing Rubber	023.234	L5	3 Lm

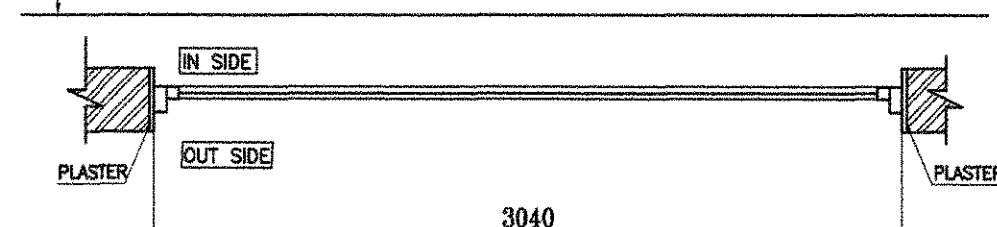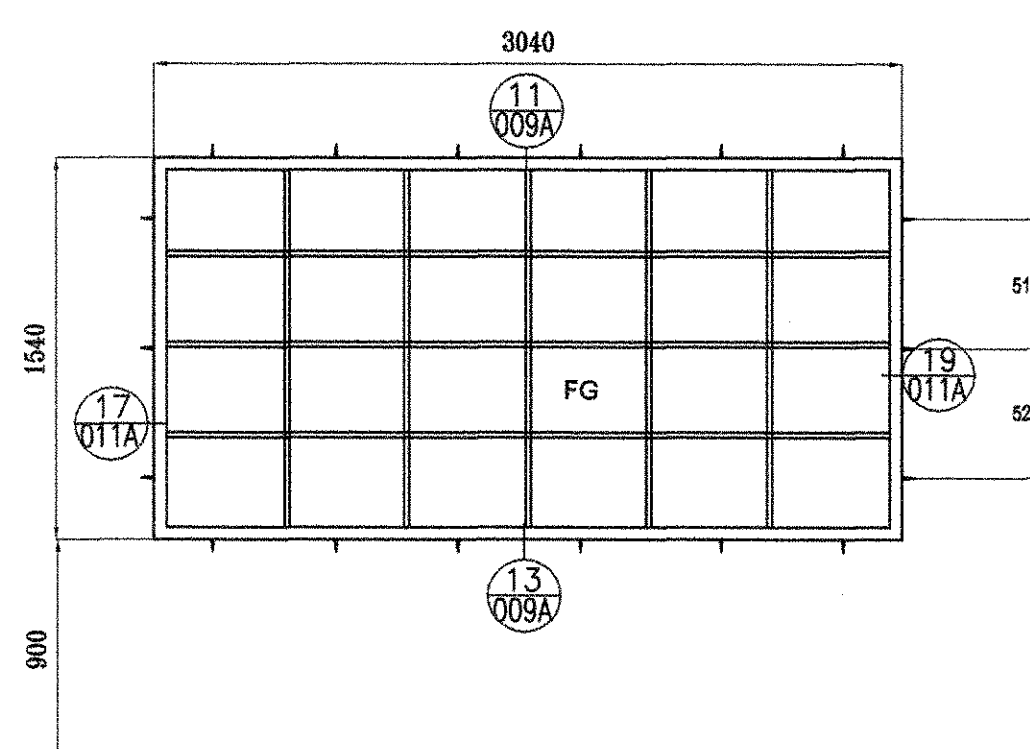

ITEM: WM25
 SIZE: 3.04X1.54
 G.FLR-LIVING
 QTY: 1 NO

S.I NO.	DESCRIPTION	CODE NO	COLOR	QTY
1.	Corner Splice	003.101	BR	4 Pcs
2.	Frame Corner	203.010	BR	8 Pcs
3.	Frame Corner	308.016	BR	8 Pcs
4.	Glazing Rubber	023.204	L5	10 Lm
5.	Glazing Rubber	023.234	L5	10 Lm
6.	Drainage Hole Cover	005.003	L1	2 Pcs

dar al-handasah
 Sha and Partners

☒ CODE 1 APPROVED
☐ CODE 2 APPROVED AS NOTED
 WORK MAY PROCEED SUBJECT TO
 INCORPORATION OF ENDORSED
 COMMENTS
☐ CODE 3 RESUBMIT FOR APPROVAL
 WORK MAY NOT PROCEED
☐ CODE 4 REJECTED

BY: DATE:

Approval shall not relieve the contractor of any of his
 obligations under the Contract or constitute authorization of
 any change in Contract Documents or variation to the work.
 Contractor is responsible for dimensions, quantities and
 coordination with other trades.

- NOTE :
- FOR THE ELECTRICAL ROOM DOOR REFER DWG No.
 - PME / JP / AB / LE / ALU / 014A
 - PME / JP / AB / LE / ALU / 015A
 - PME / JP / AB / LE / ALU / 016A
 - PME / JP / AB / LE / ALU / 017A
 - FOR THE GAS ROOM DETAILS REFER DWG No.
 - PME / JP / AB / LE / ALU / 018A
 - PME / JP / AB / LE / ALU / 019A
 - PME / JP / AB / LE / ALU / 020A

ALUMINIUM SYSTEM PROFILE

SUB CONTRACTOR :
WHITE ALUMINIUM ENT.

GLAZING SCHEDULE

- For Bath rooms
- Outboard Lite : 6.00mm Blue-tinted
 Tempered Glass
- Air Space : 12.00mm Dehydrated
- Inboard Lite : 6.00mm Clear Sandblasting
 Tempered Glass
- For others
- Outboard Lite : 6.00mm Blue body-tinted
 Tempered Glass
- Air Space : 12.00mm Dehydrated
- Inboard Lite : 6.00mm Clear Tempered Glass

Note:

Reference No. of Detail

Reference No. of Drawing Sheet

AS BUILT DRAWING

JUMEIRAH PARK



NAKHEEL



dar al-handasah
 sha and partners



Pauling Middle East



WHITE ALUMINIUM ENT.

PACKAGE - 2
 Cluster - 1

PACKAGE - 2A
 Clusters - 1, 3 (Villas 51 to 62), 4, 5, 7 (Villas 33 to 41),
 8, 9, 10, 11, 12, 13, 14, 15 (Villas 1 to 14) & 16

ALUMINIUM WINDOWS ELEVATION LEGACY VILLAS

Drawn	IBRAHIM	Review	Eng. Ziad	Checked:	GUGAN
Scale:	1:30	Date:	13-06-2012		
Drawing No.	PME / JP / AB / LE / ALU / 003A				

NOTE:
 * FOR KEY PLAN & ELEVATION REFER TO DRAWING NO.
 PME/JP/AB/LE/ALU/001A