



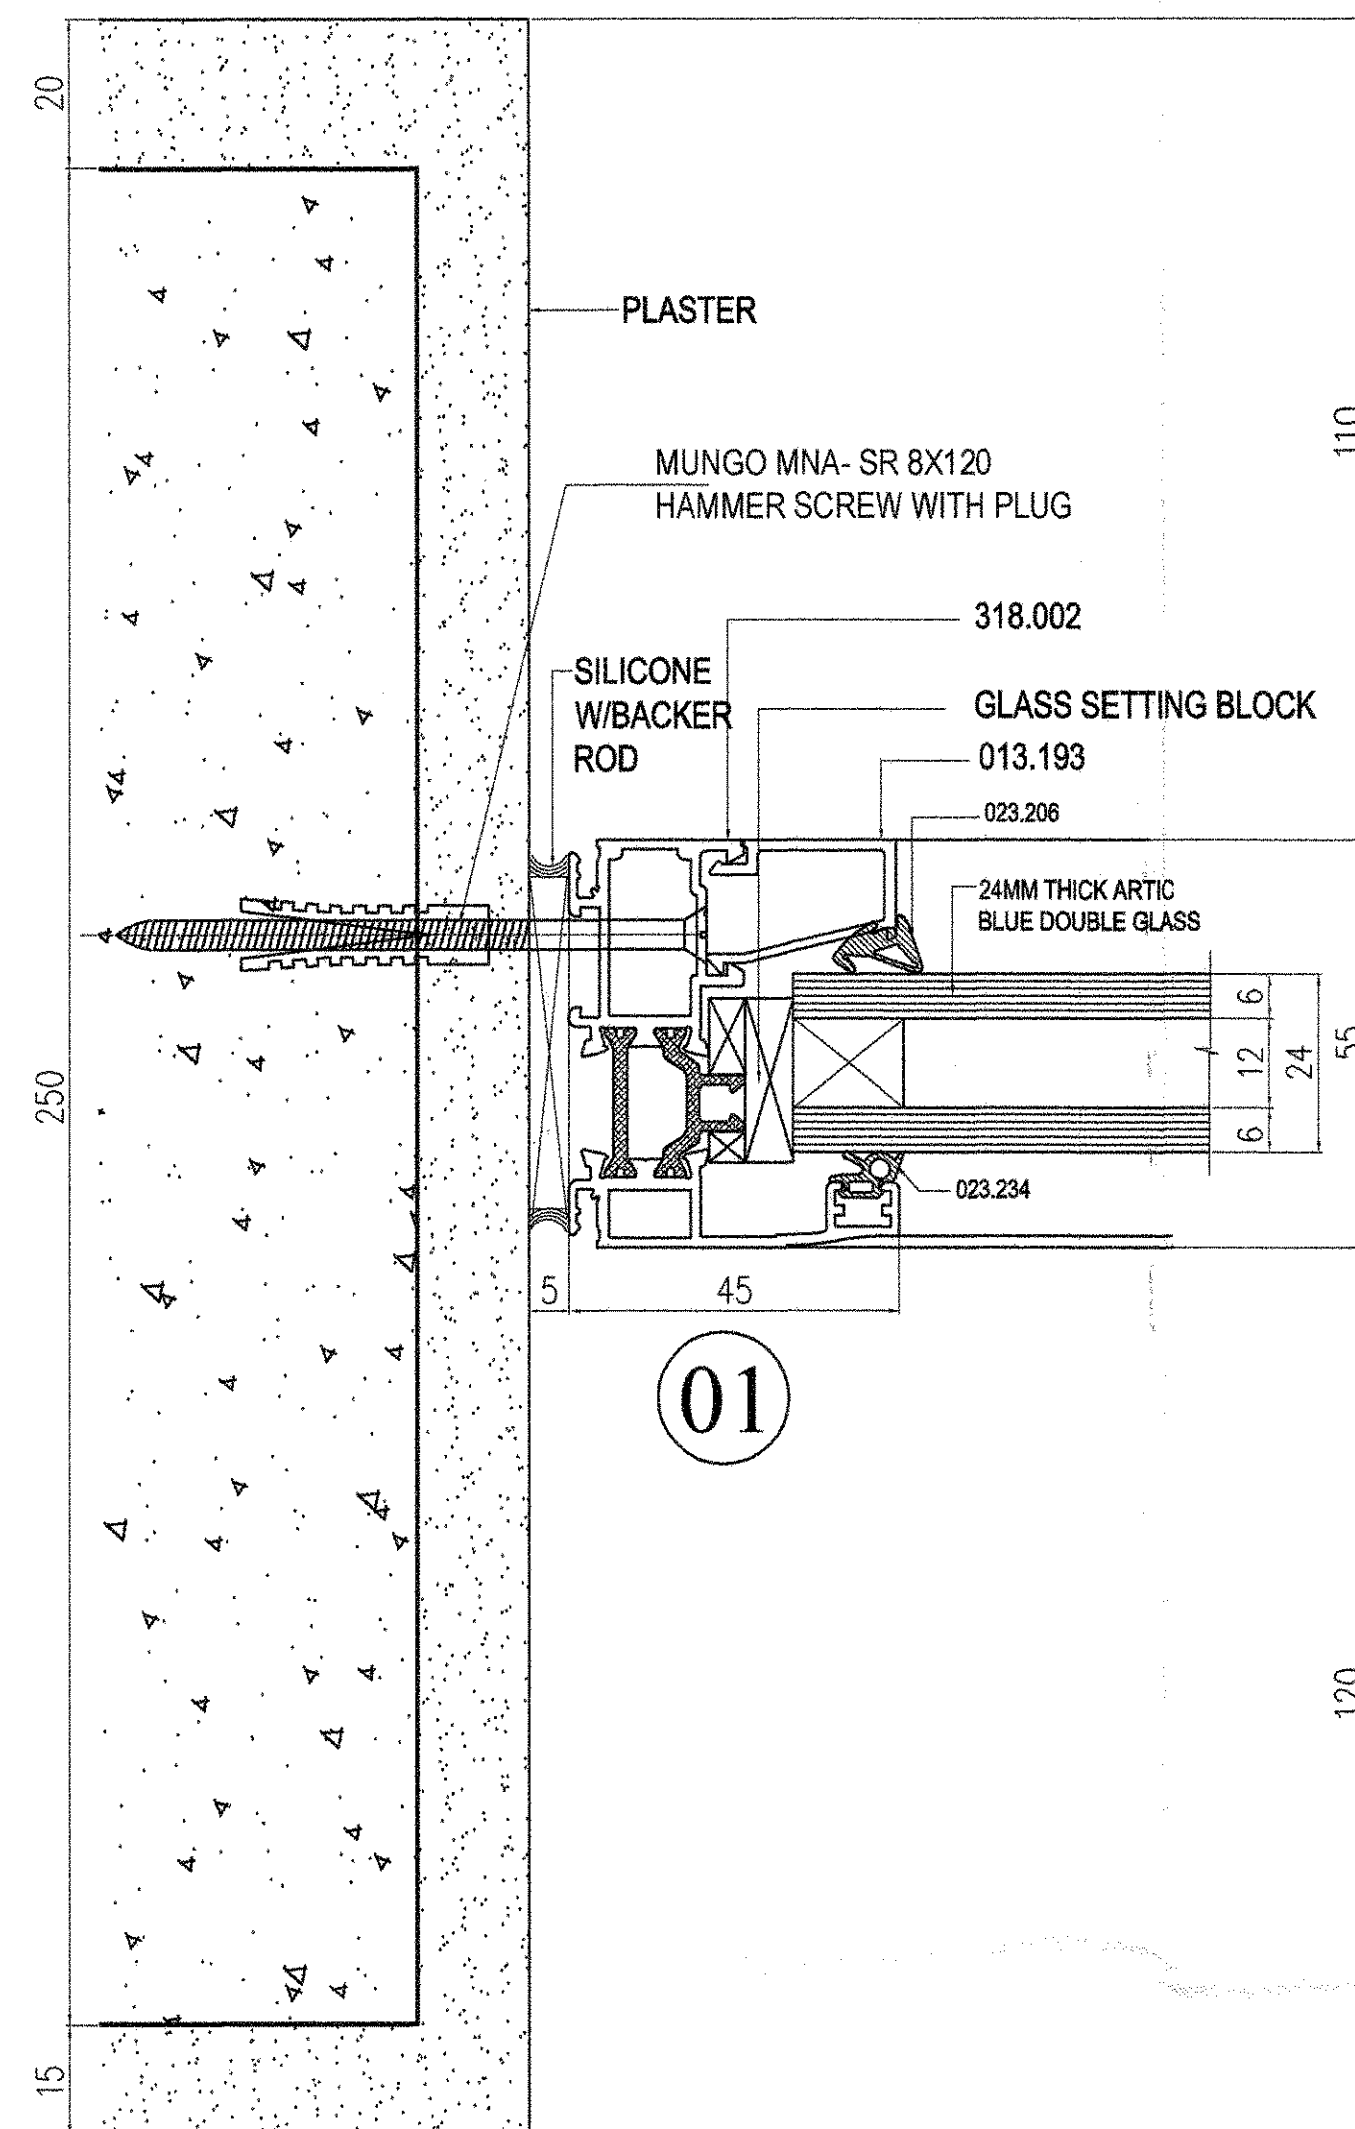


IN SIDE

OUT SIDE

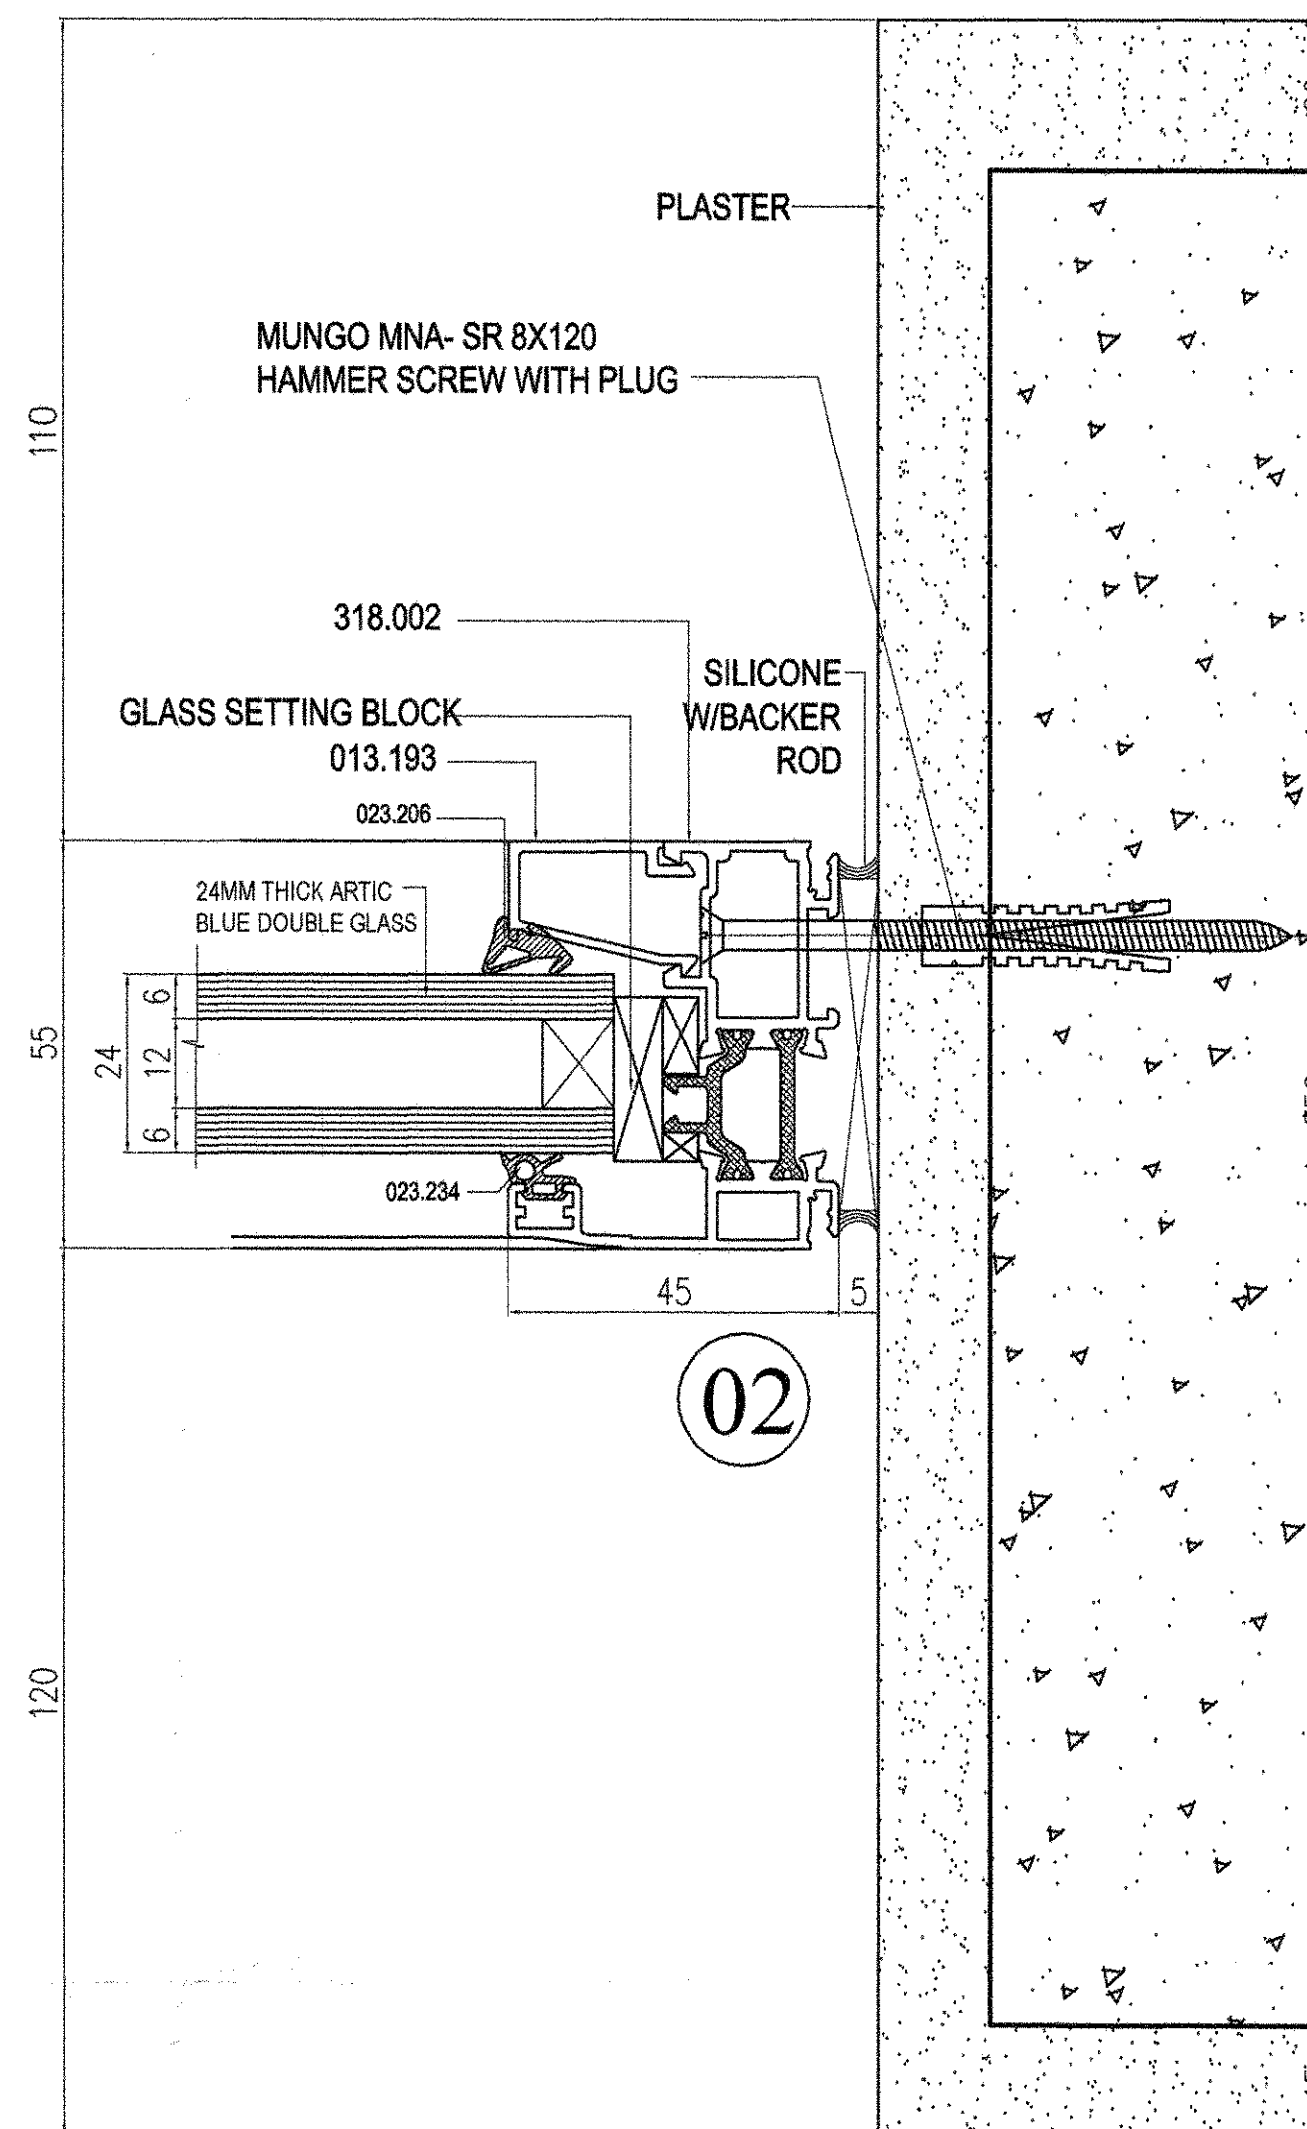


02

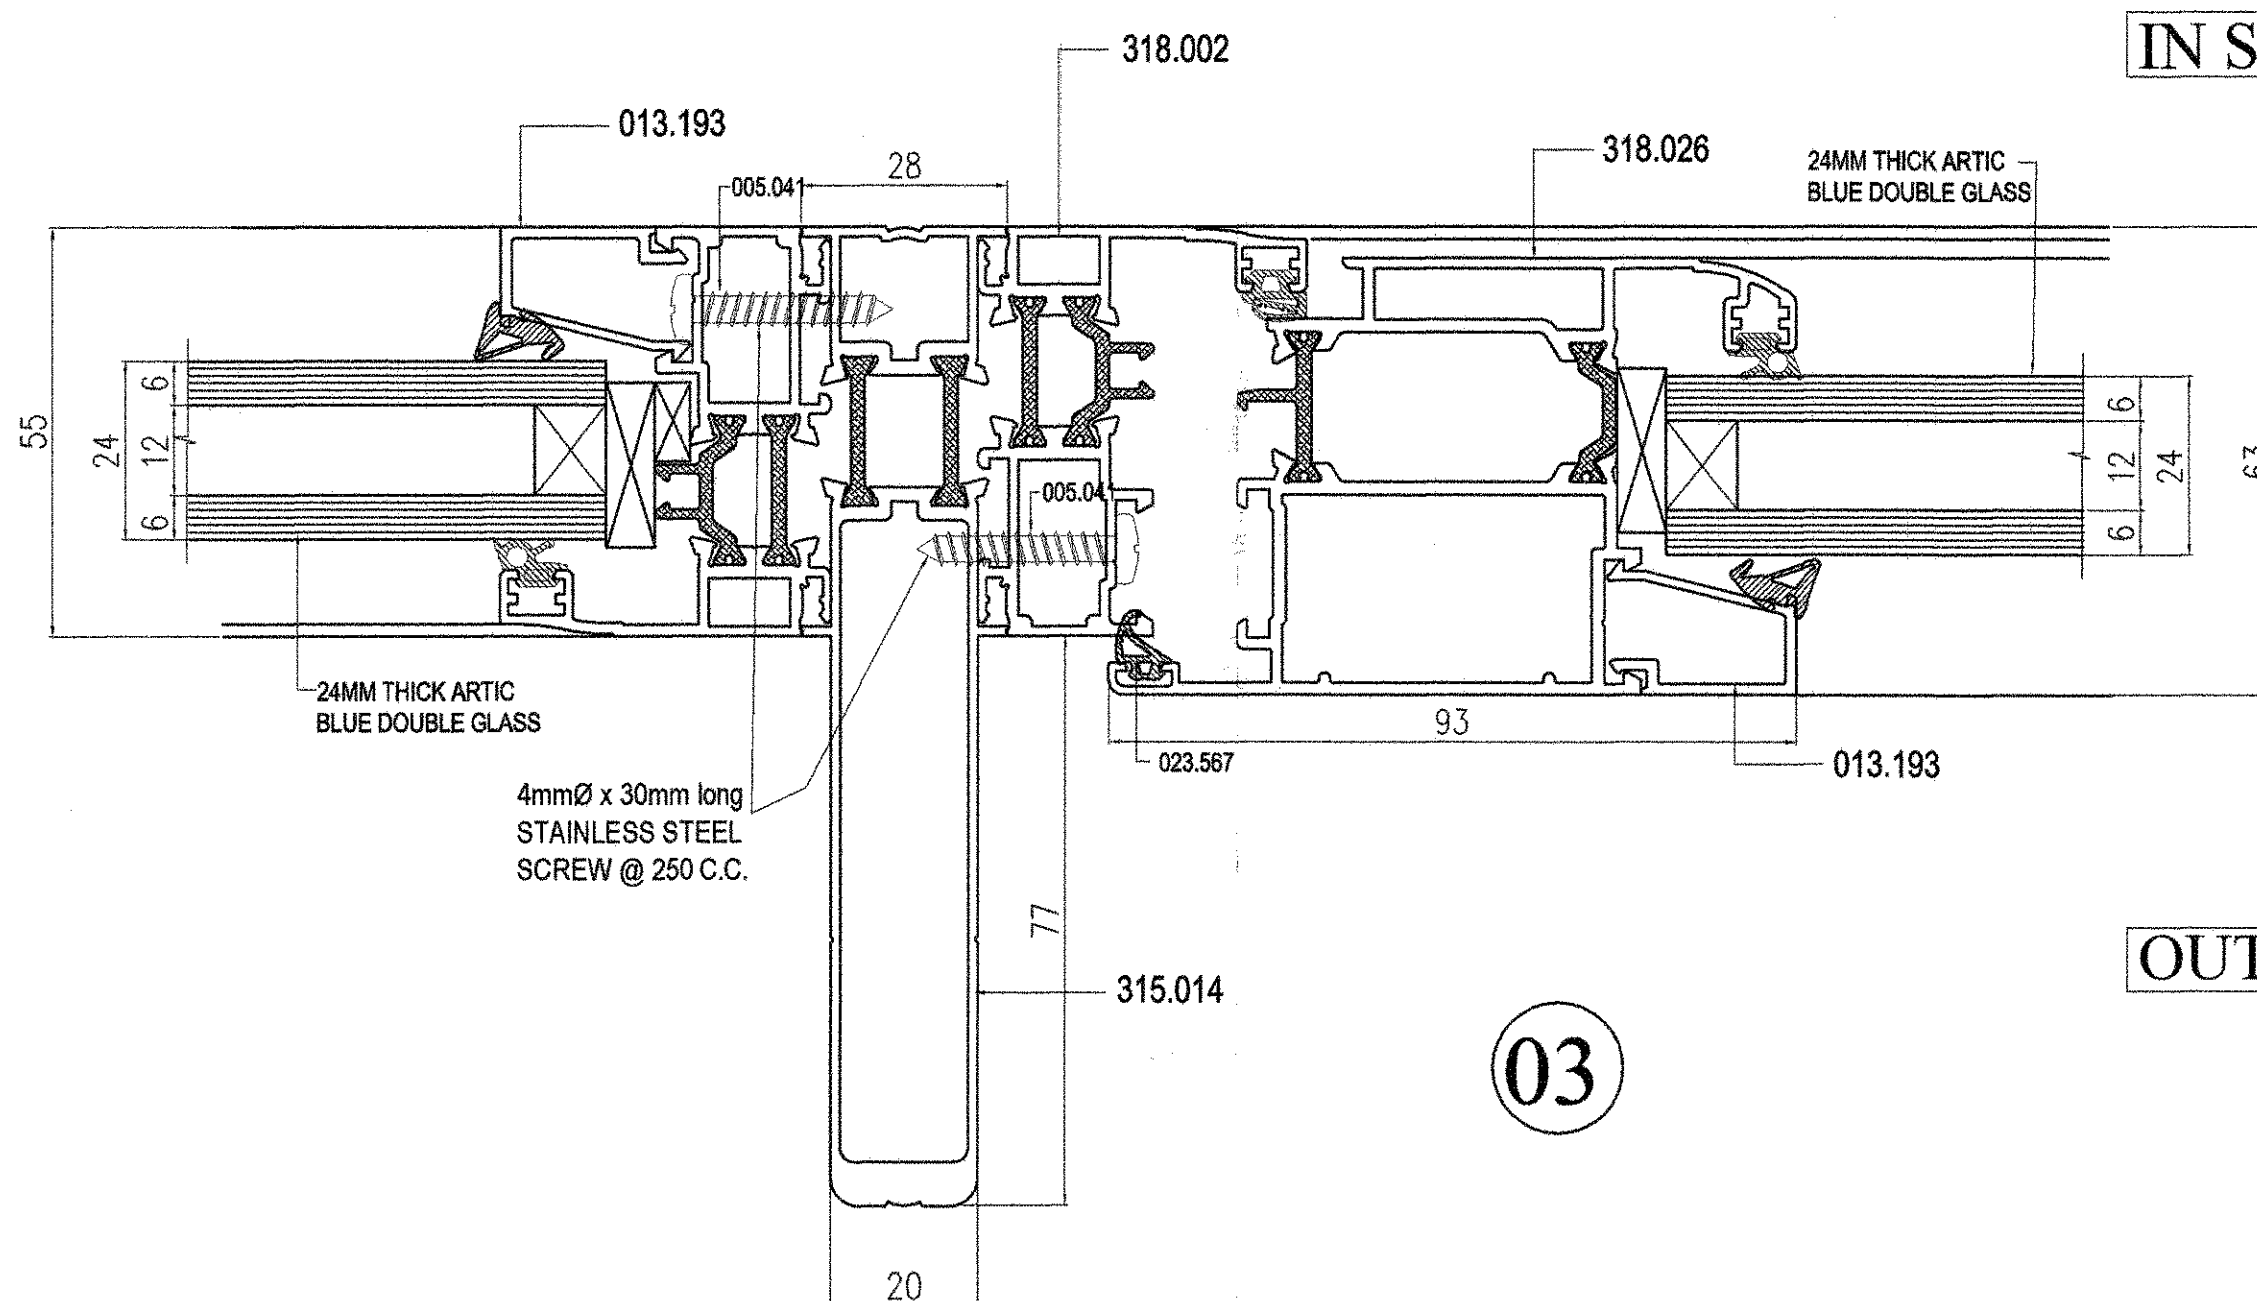

IN SIDE

OUT SIDE

03

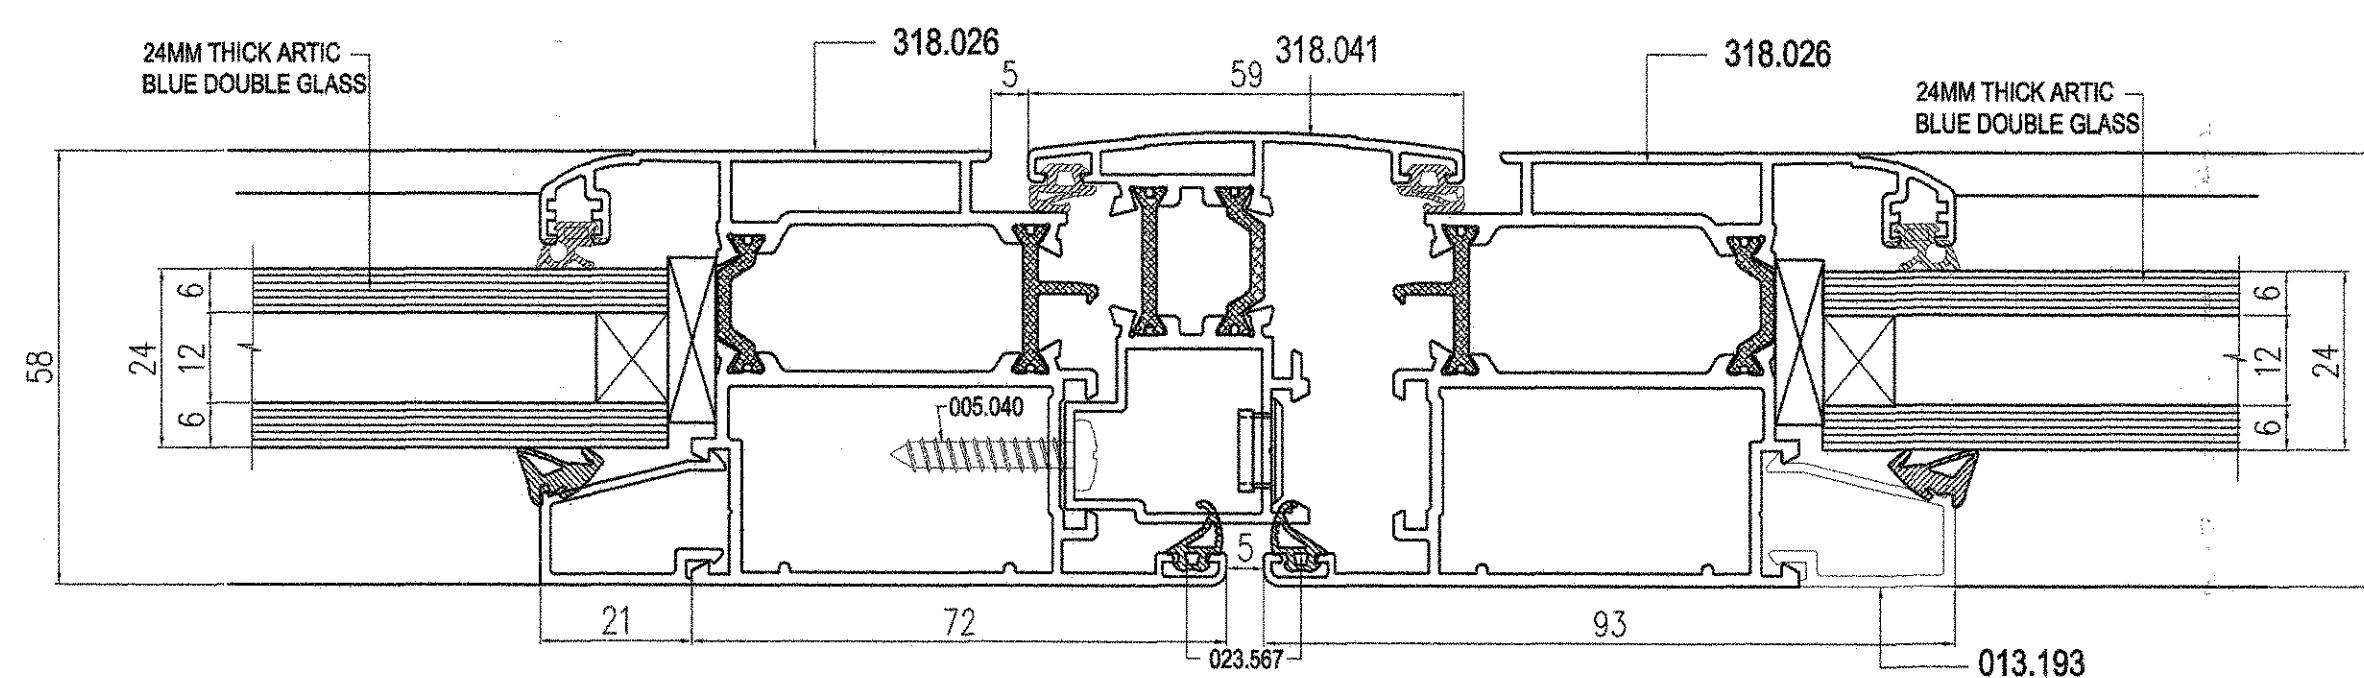

04

dar al-handasah
Sheir and Partners

☒ CODE 1 APPROVED
☐ CODE 2 APPROVED AS NOTED
 WORK MAY PROCEED SUBJECT TO
 INCORPORATION OF ENDORSED
 COMMENTS
☐ CODE 3 RESUBMIT FOR APPROVAL
 WORK MAY NOT PROCEED
☐ CODE 4 REJECTED

BY: DATE:

Approval shall not relieve the signatory of any of his
 obligations under the Contract or constitute authorization of
 any change to Contract Documents or variation to the works.
 Contractor is responsible for dimensions, quantities and
 coordination with other trades.

13/06/2012



AS BUILT DRAWING

JUMEIRAH PARK



Pauling Middle East



WHITE ALUMINIUM ENT.

PACKAGE - 2

Cluster - 1


PACKAGE - 2A

Clusters - 1, 3 (Villas 51 to 62), 4, 5, 7 (Villas 33 to 41),
8, 9, 10, 11, 12, 13, 14, 15 (Villas 1 to 14) & 16

ALUMINIUM & GLASS
DETAILS


Drawn	IBRAHIM	Review	Eng. Ziad	Checked:	GUGAN
Scale:	1:1	Date:	13-06-2012		

Drawing No. PME / JP / AB / LE / ALU / 004A

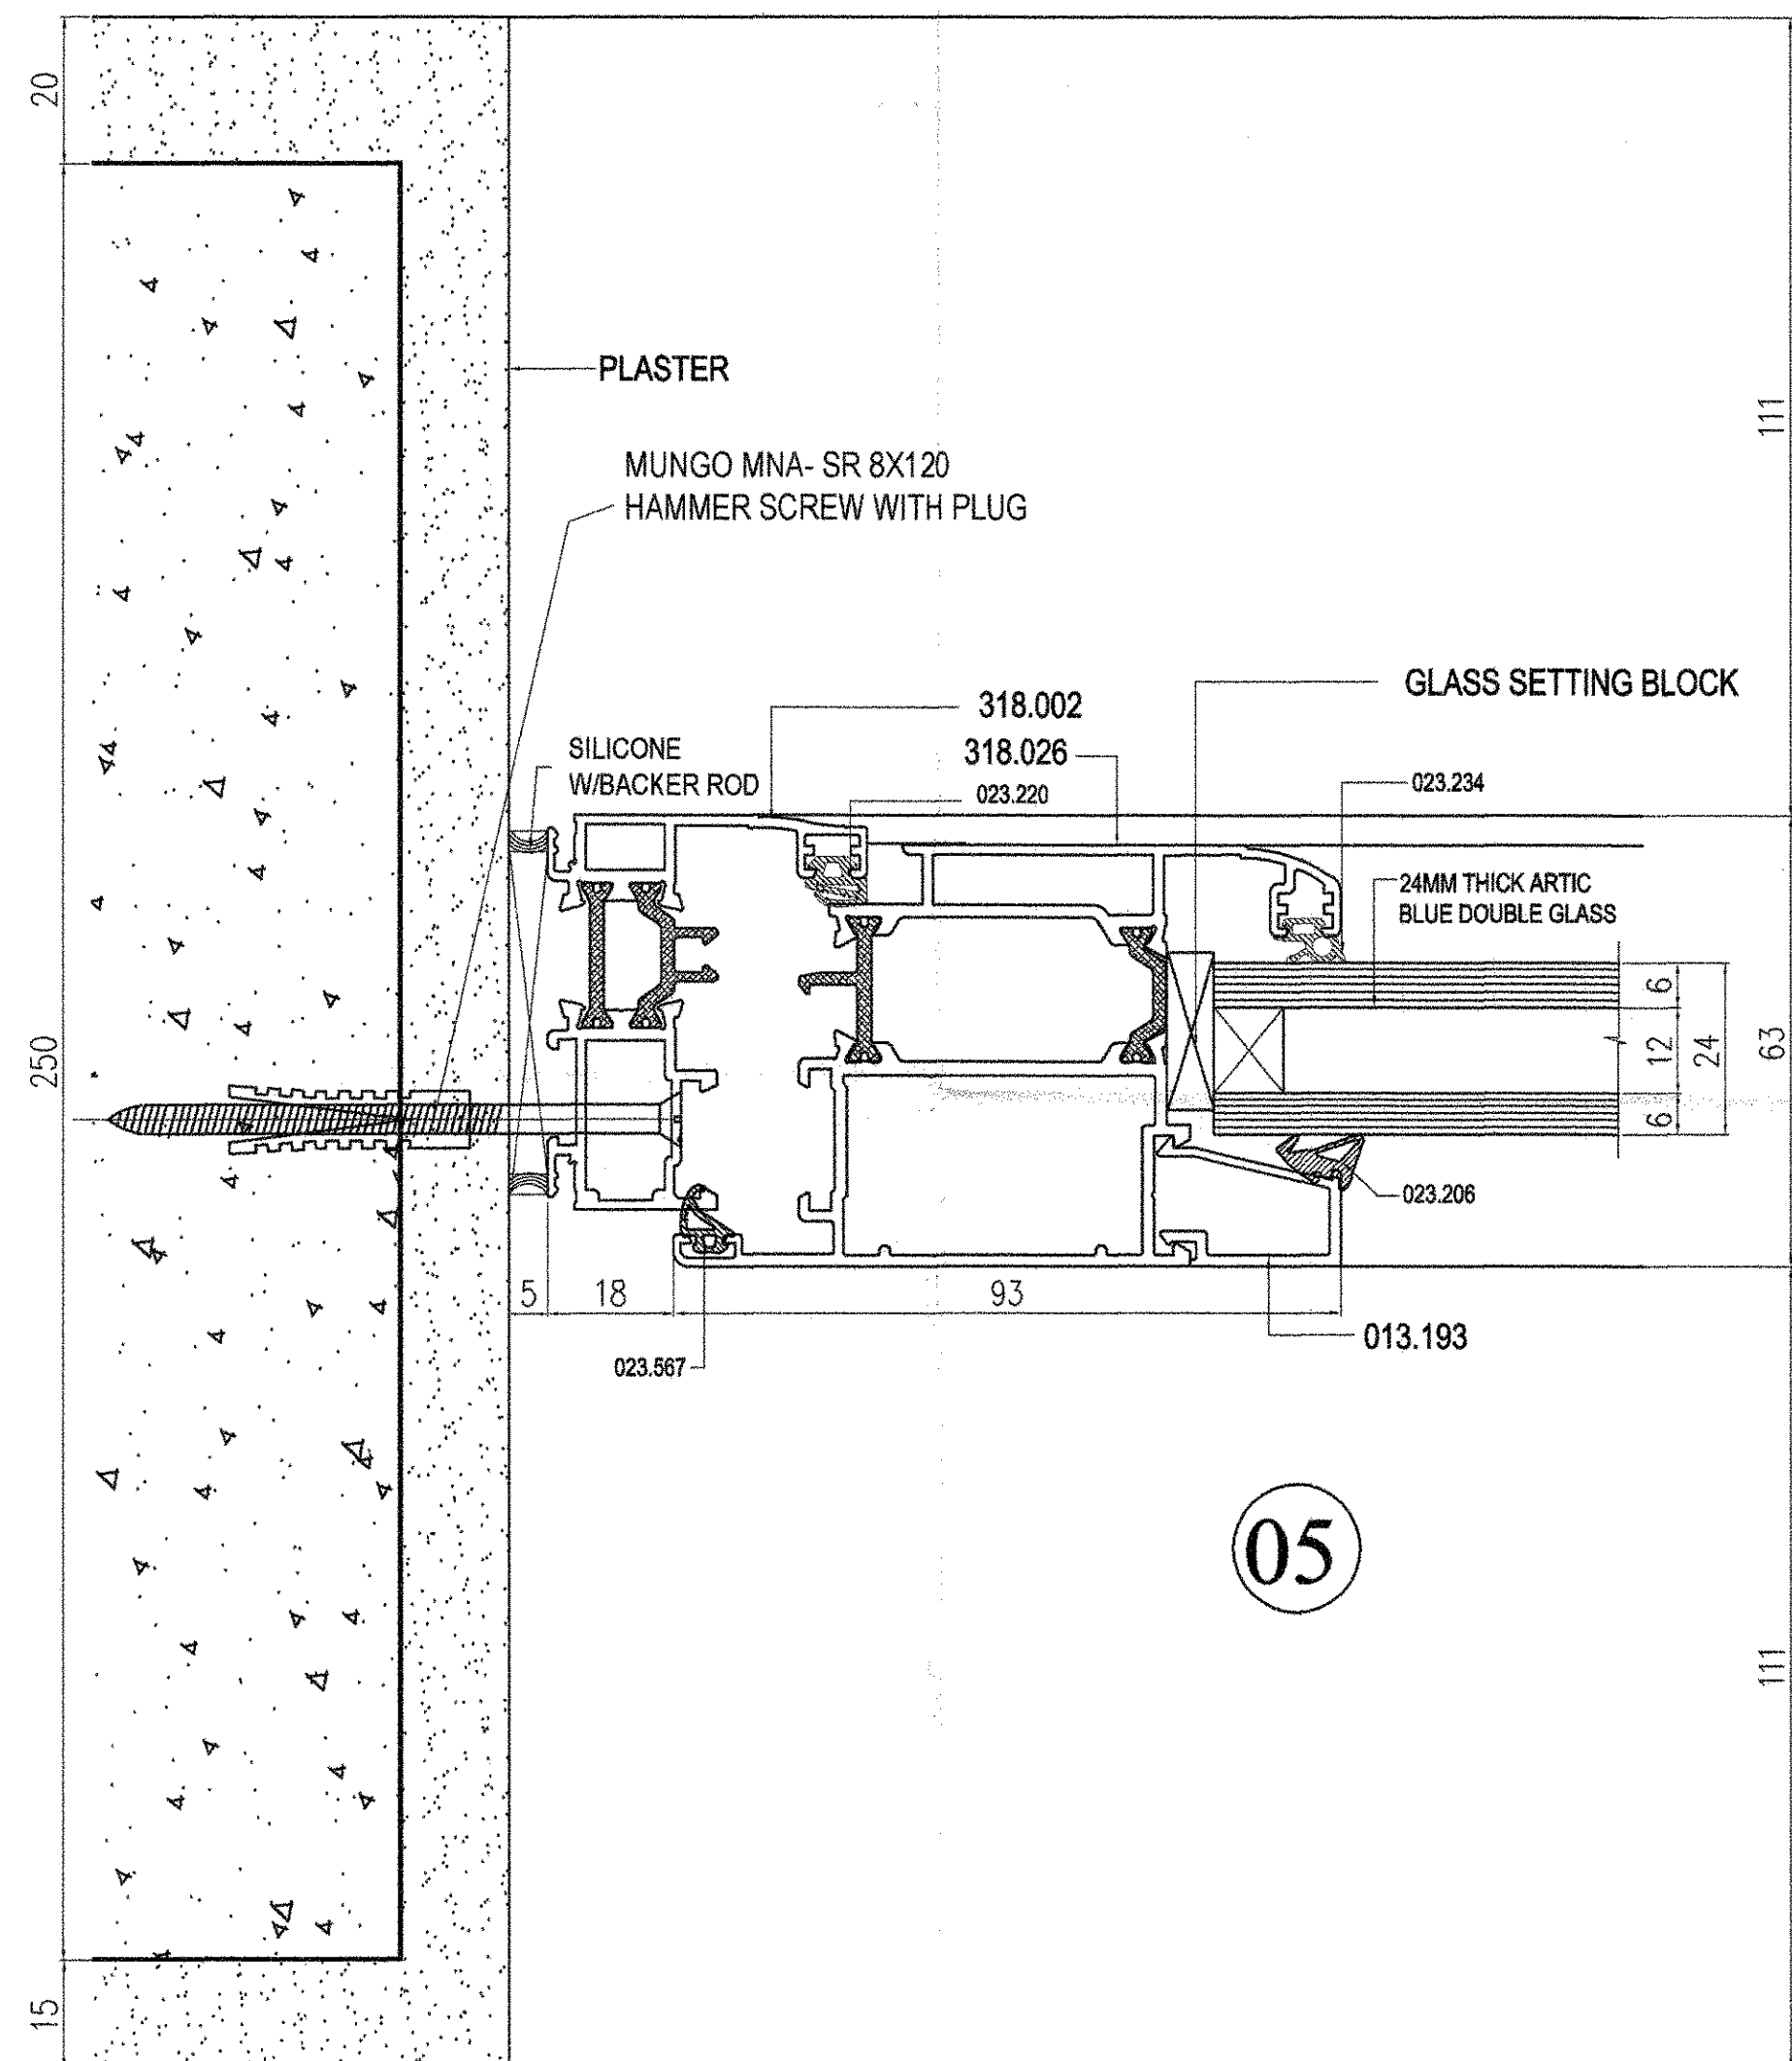

IN SIDE

OUT SIDE

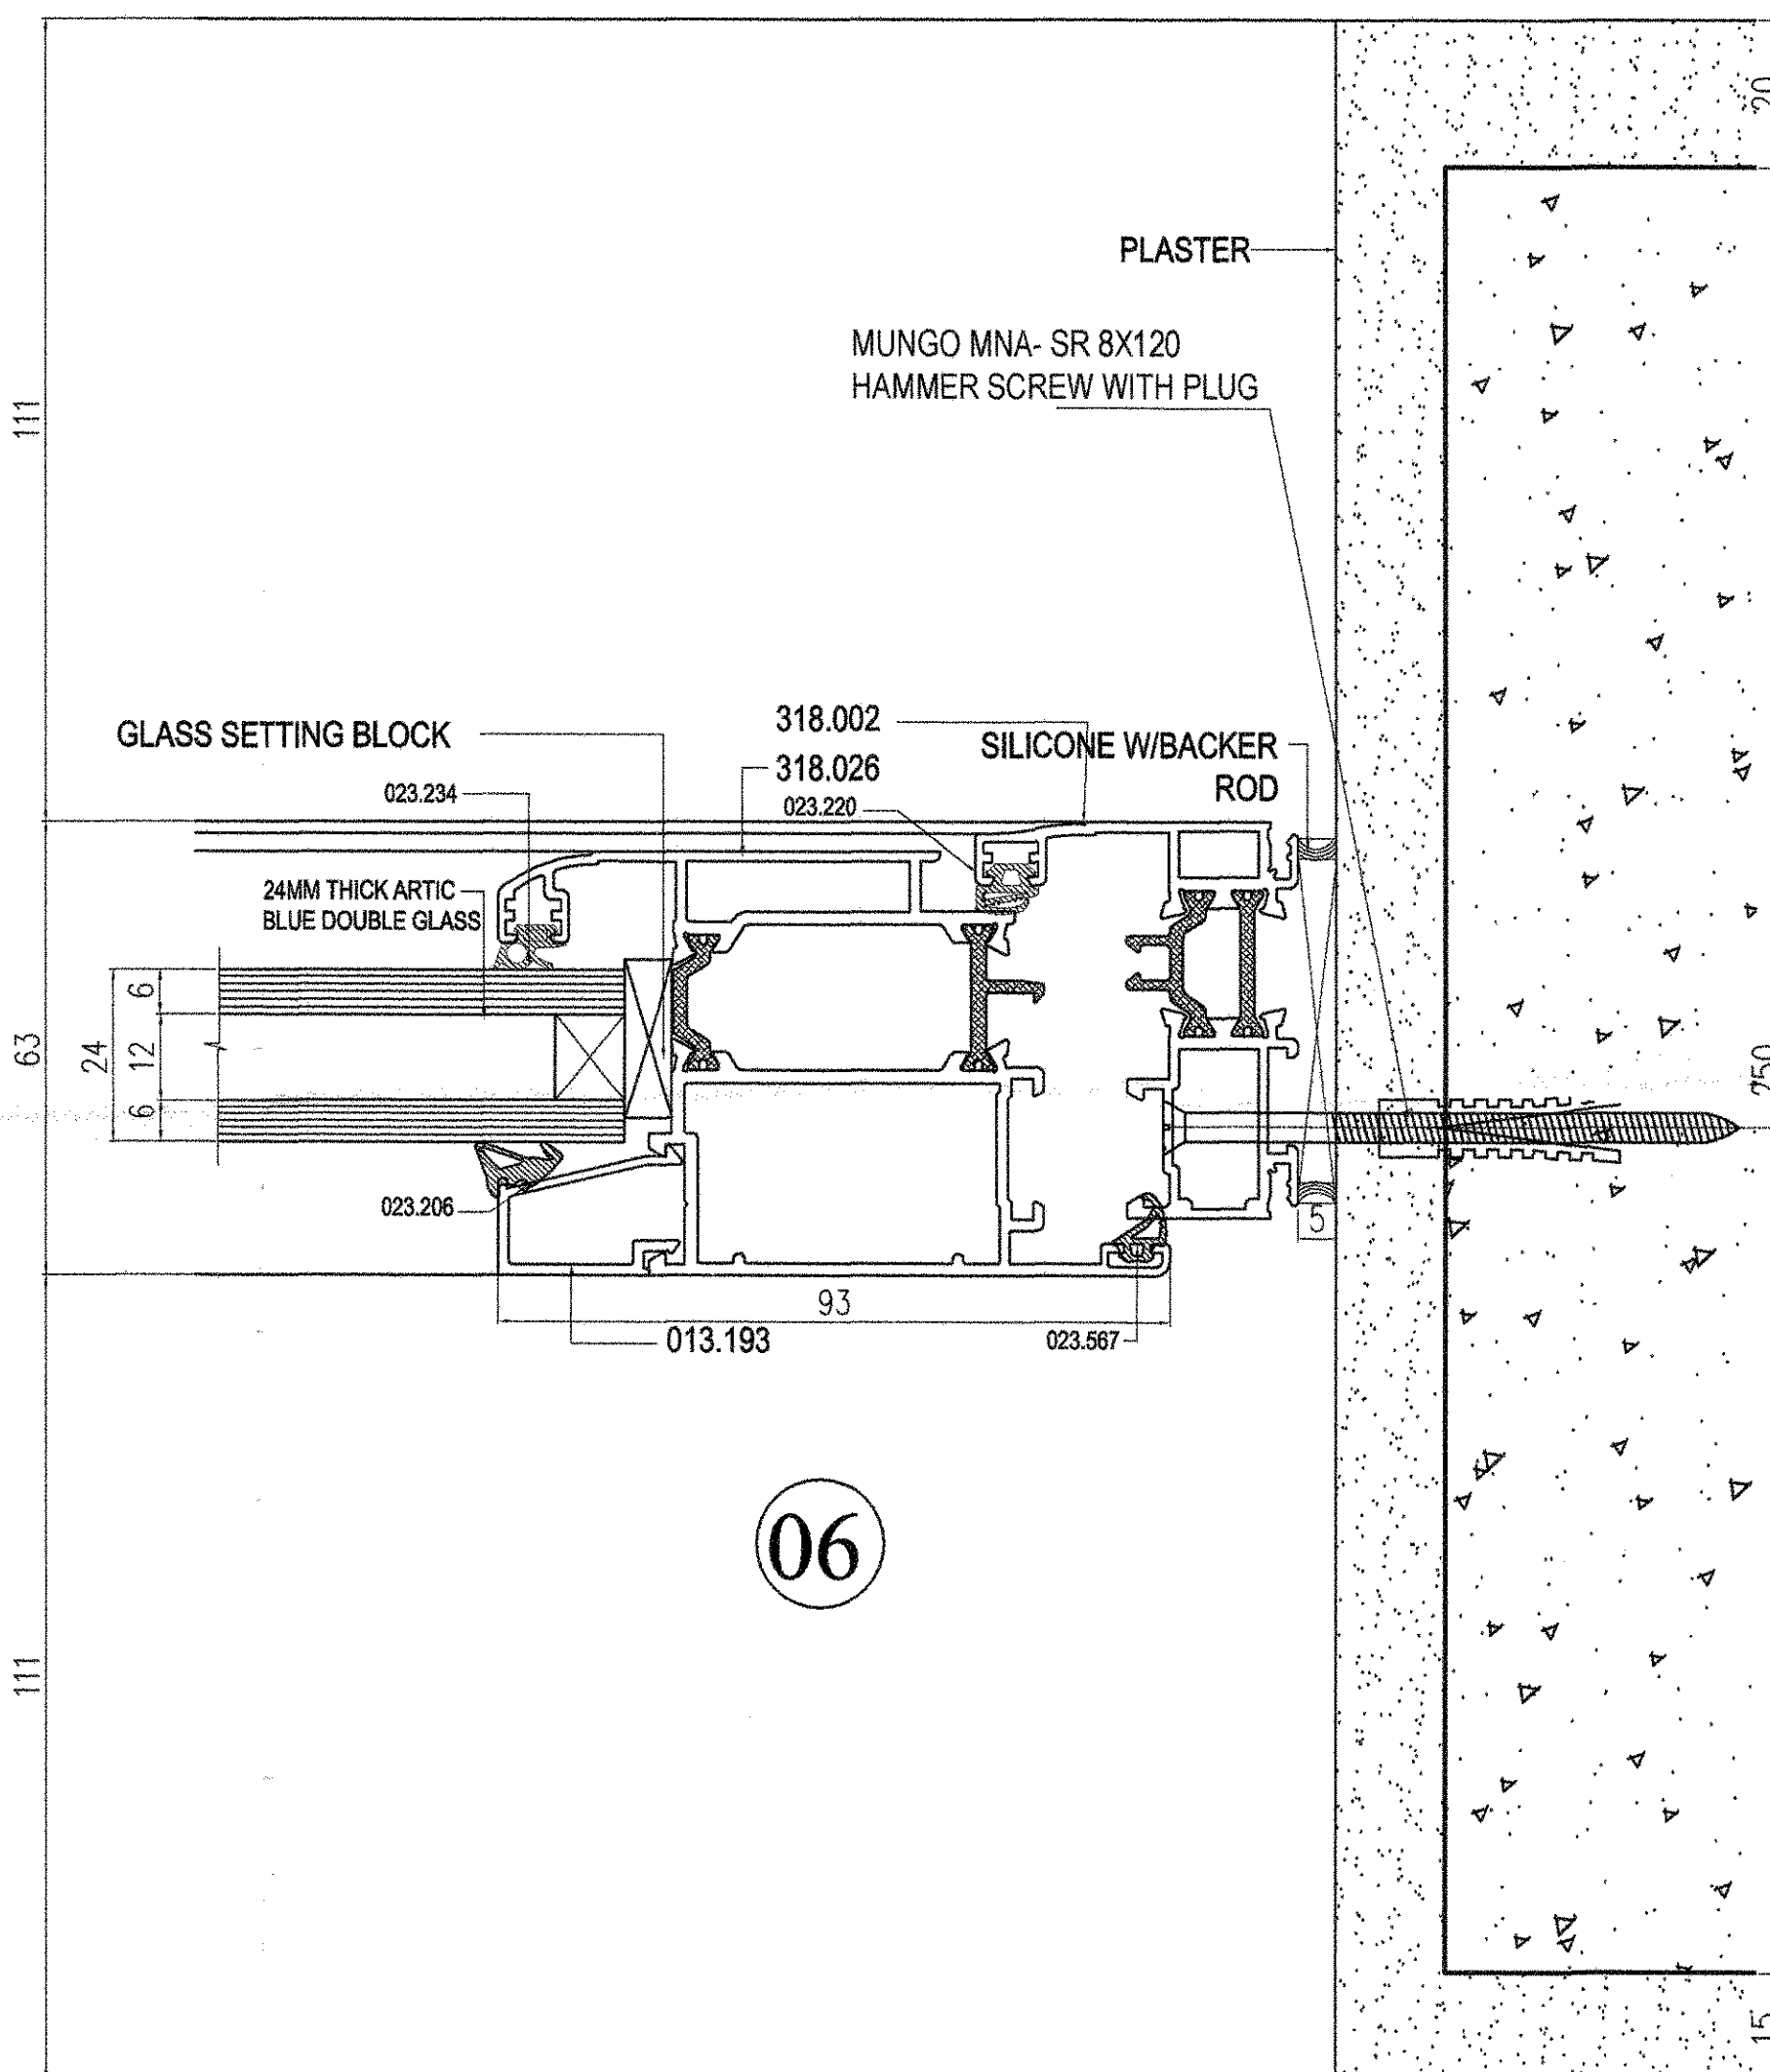

dar al-handasah
Sheair and Partners

☐ CODE 1 APPROVED

☐ CODE 2 APPROVED AS NOTED
WORK MAY PROCEED SUBJECT TO
INCORPORATION OF ENGINEER'S
COMMENTS


☐ CODE 3 RESUBMIT FOR APPROVAL
WORK MAY NOT PROCEED

☐ CODE 4 REJECTED

BY: _____ DATE: _____

Approval shall not relieve the contractor of any of his
obligations under the Contract or constitute authorization of
any change to Contract Documents or variation to the work.
Contractor is responsible for dimensions, quantities and
coordination with other trades.

23 Jun 2012

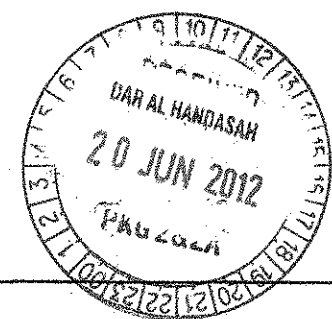

AS BUILT DRAWING

JUMEIRAH PARK



PACKAGE - 2

Cluster - 1


PACKAGE - 2A

**Clusters - 1, 3 (Villas 51 to 62), 4, 5, 7 (Villas 33 to 41),
8, 9, 10, 11, 12, 13, 14, 15 (Villas 1 to 14) & 16**

**ALUMINIUM & GLASS
DETAILS**


Drawn	IBRAHIM	Review	Eng. Ziad	Checked:	GUGAN
Scale:	1:1	Date:	13-06-2012		

Drawing No. **PME / JP / AB / LE / ALU / 005A**

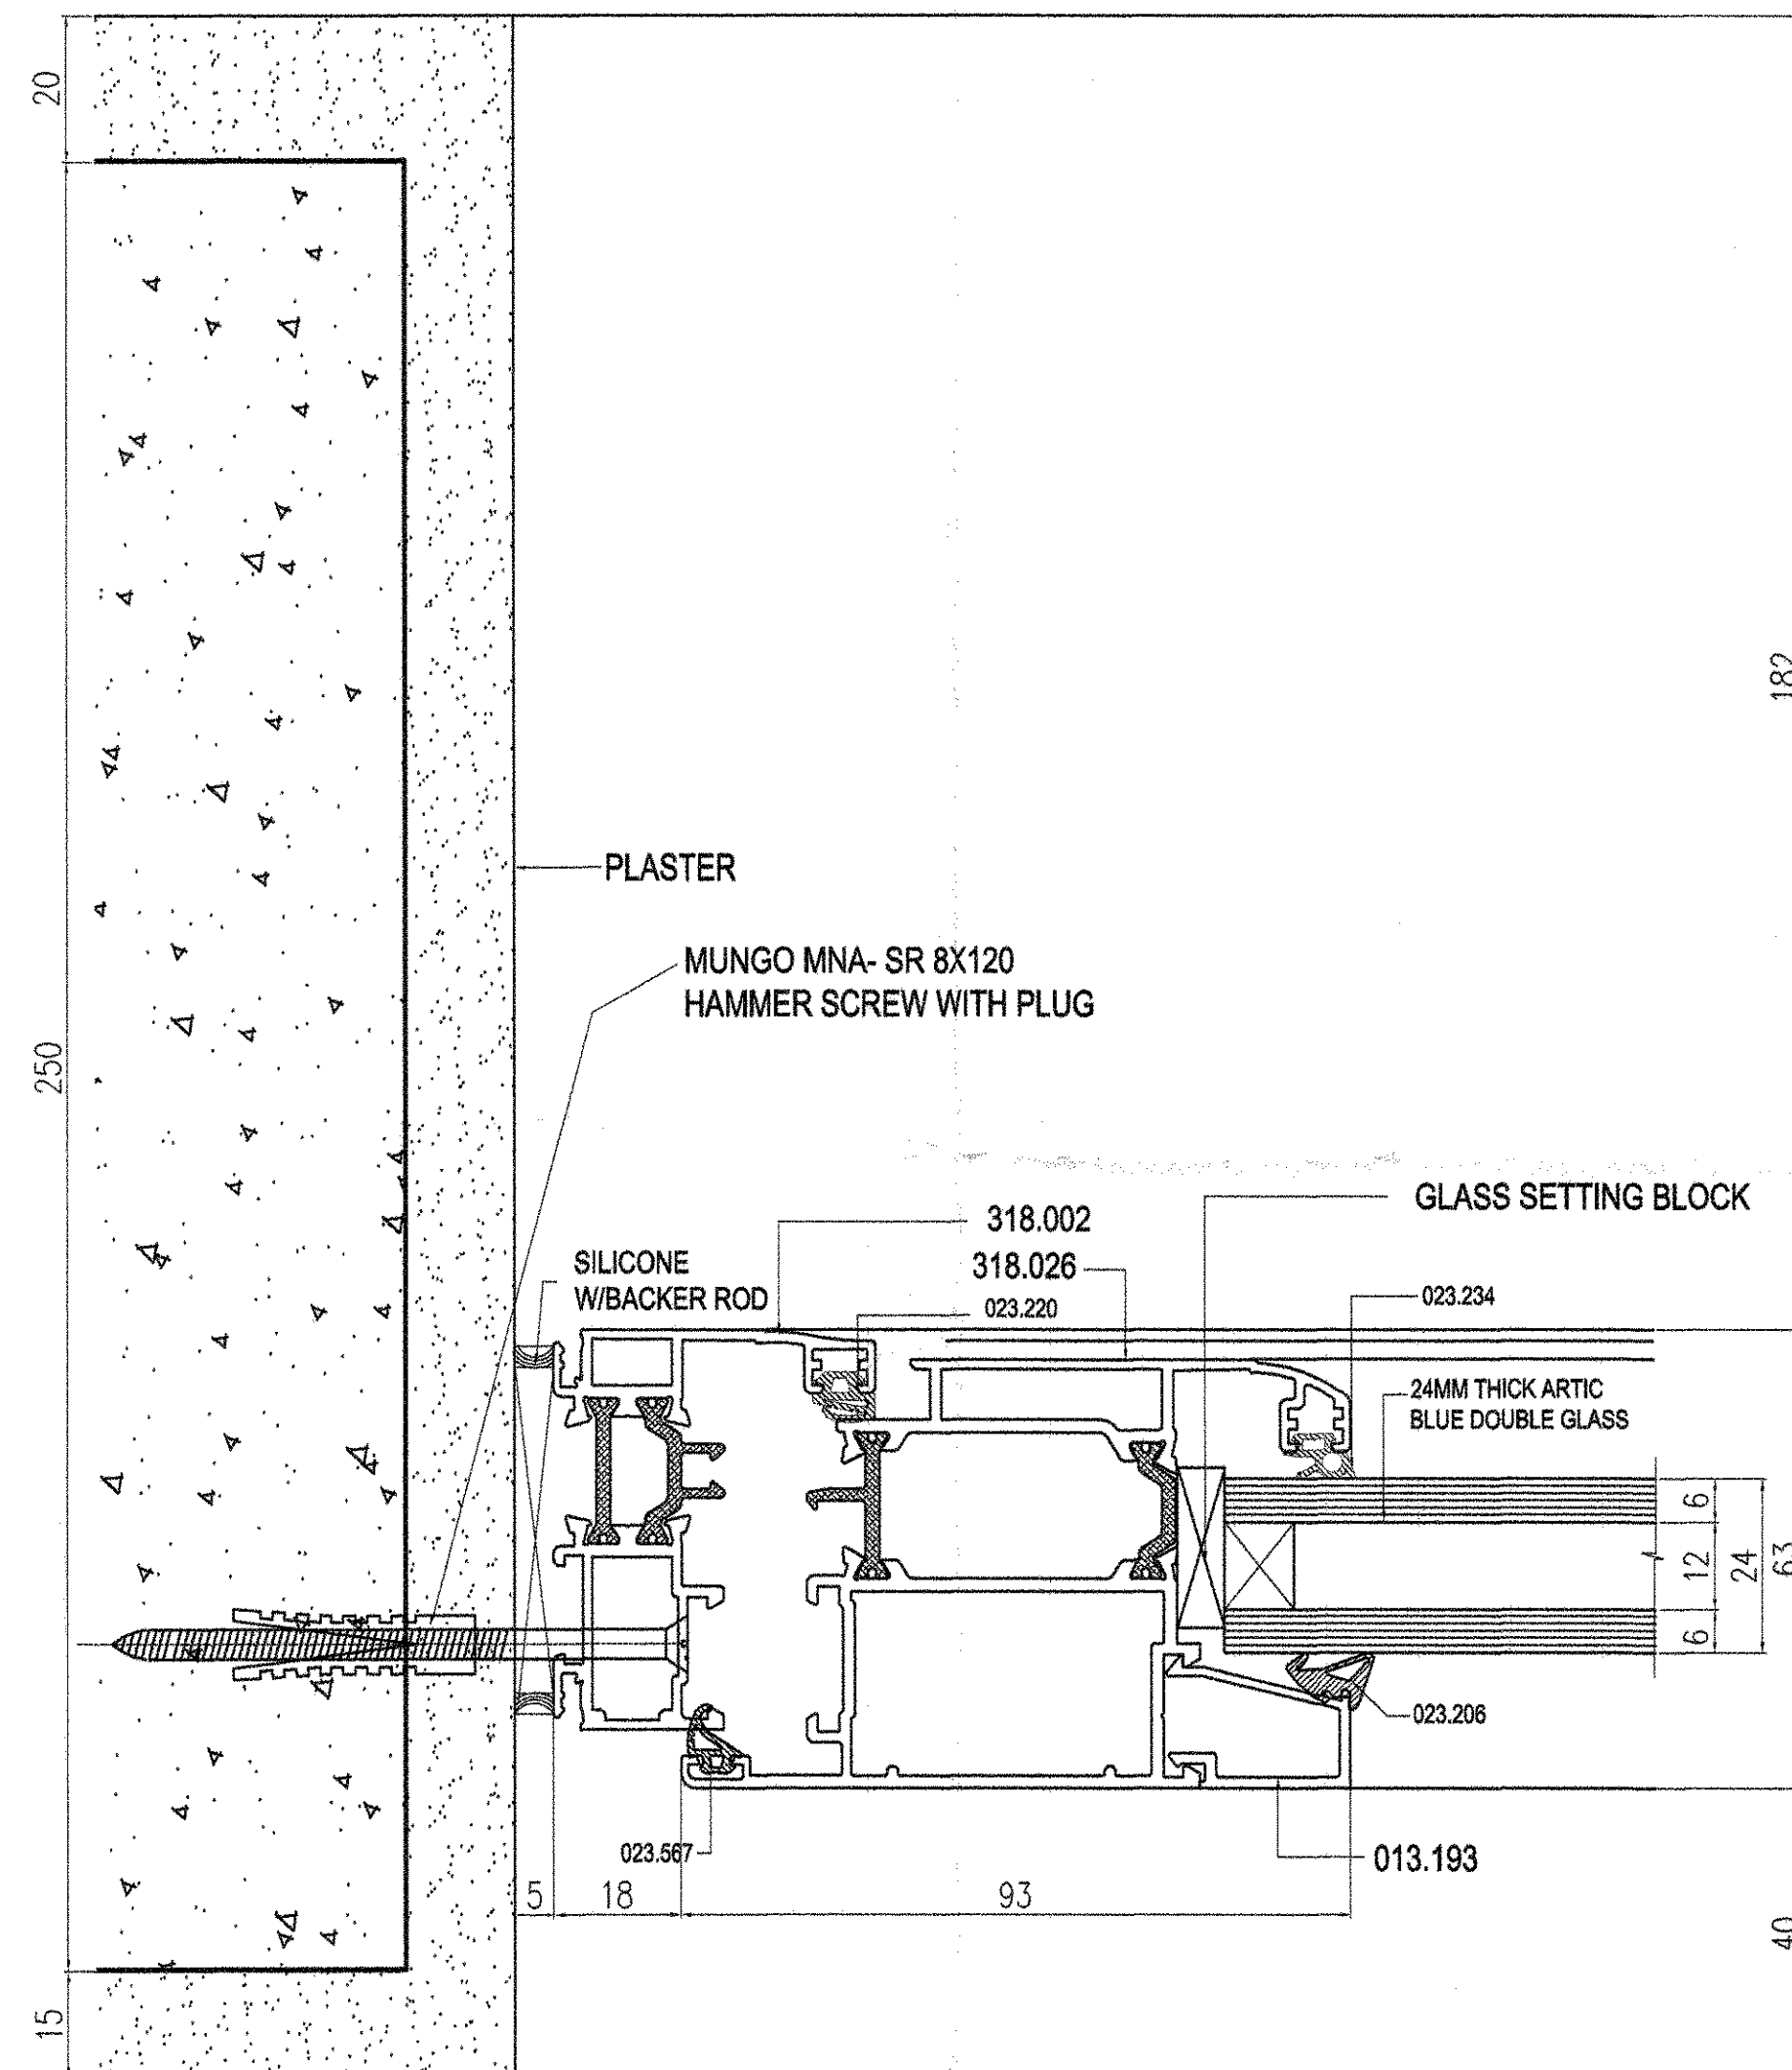

05A

IN SIDE

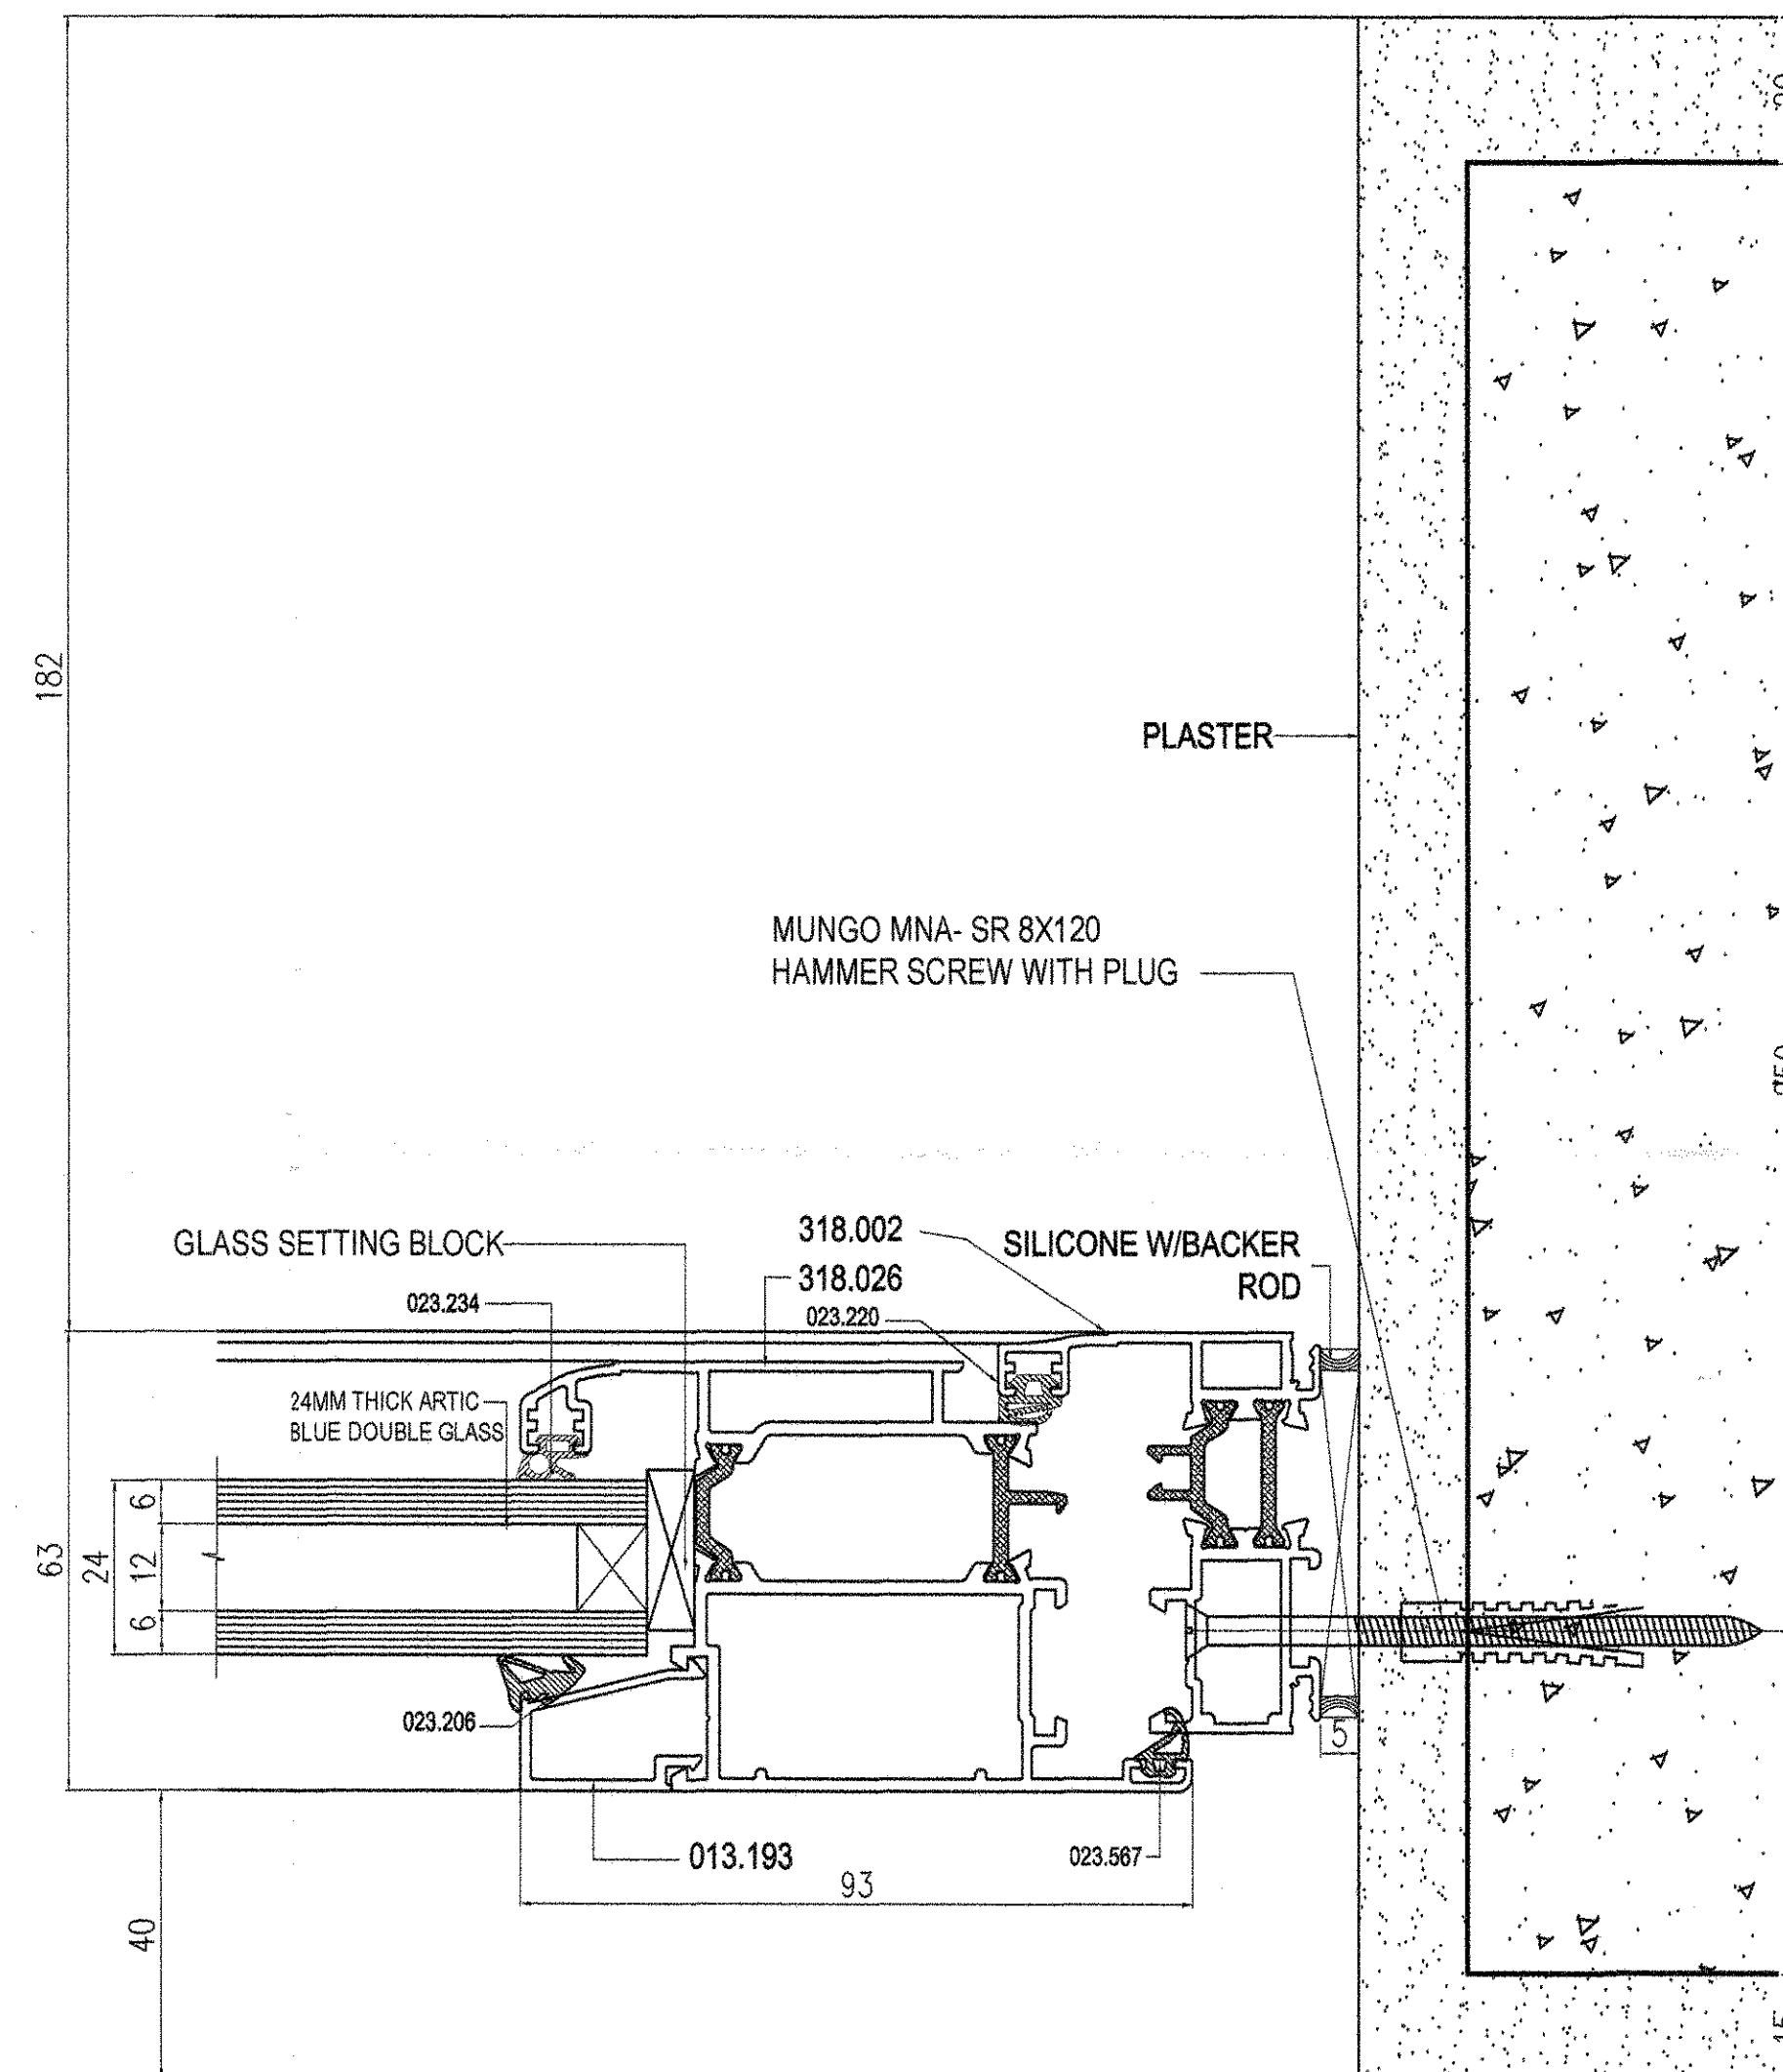

06A

OUT SIDE

dar al-handasah	
☒ CODE 1	APPROVED
☐ CODE 2	APPROVED AS NOTED WORK MAY PROCEED SUBJECT TO INCORPORATION OF ENDORSED COMMENTS
☐ CODE 3	RESUBMIT FOR APPROVAL WORK MAY NOT PROCEED
☐ CODE 4	REJECTED
BY:	DATE:
Approval shall not relieve the contractor of any of his obligations under the Contract or constitute authorization of any change to Contract Documents or variation to the work. Contractor is responsible for dimensions, quantities and coordination with other trades.	



AS BUILT DRAWING

JUMEIRAH PARK



PACKAGE - 2

Cluster - 1

PACKAGE - 2A





Clusters - 1, 3 (Villas 51 to 62), 4, 5, 7 (Villas 33 to 41),
8, 9, 10, 11, 12, 13, 14, 15 (Villas 1 to 14) & 16

ALUMINIUM & GLASS
DETAILS

Drawn	IBRAHIM	Review	Eng. Ziad	Checked:	GUGAN
Scale:	1:1	Date:	13-06-2012		

Drawing No.

PME / JP / AB / LE / ALU / 006A

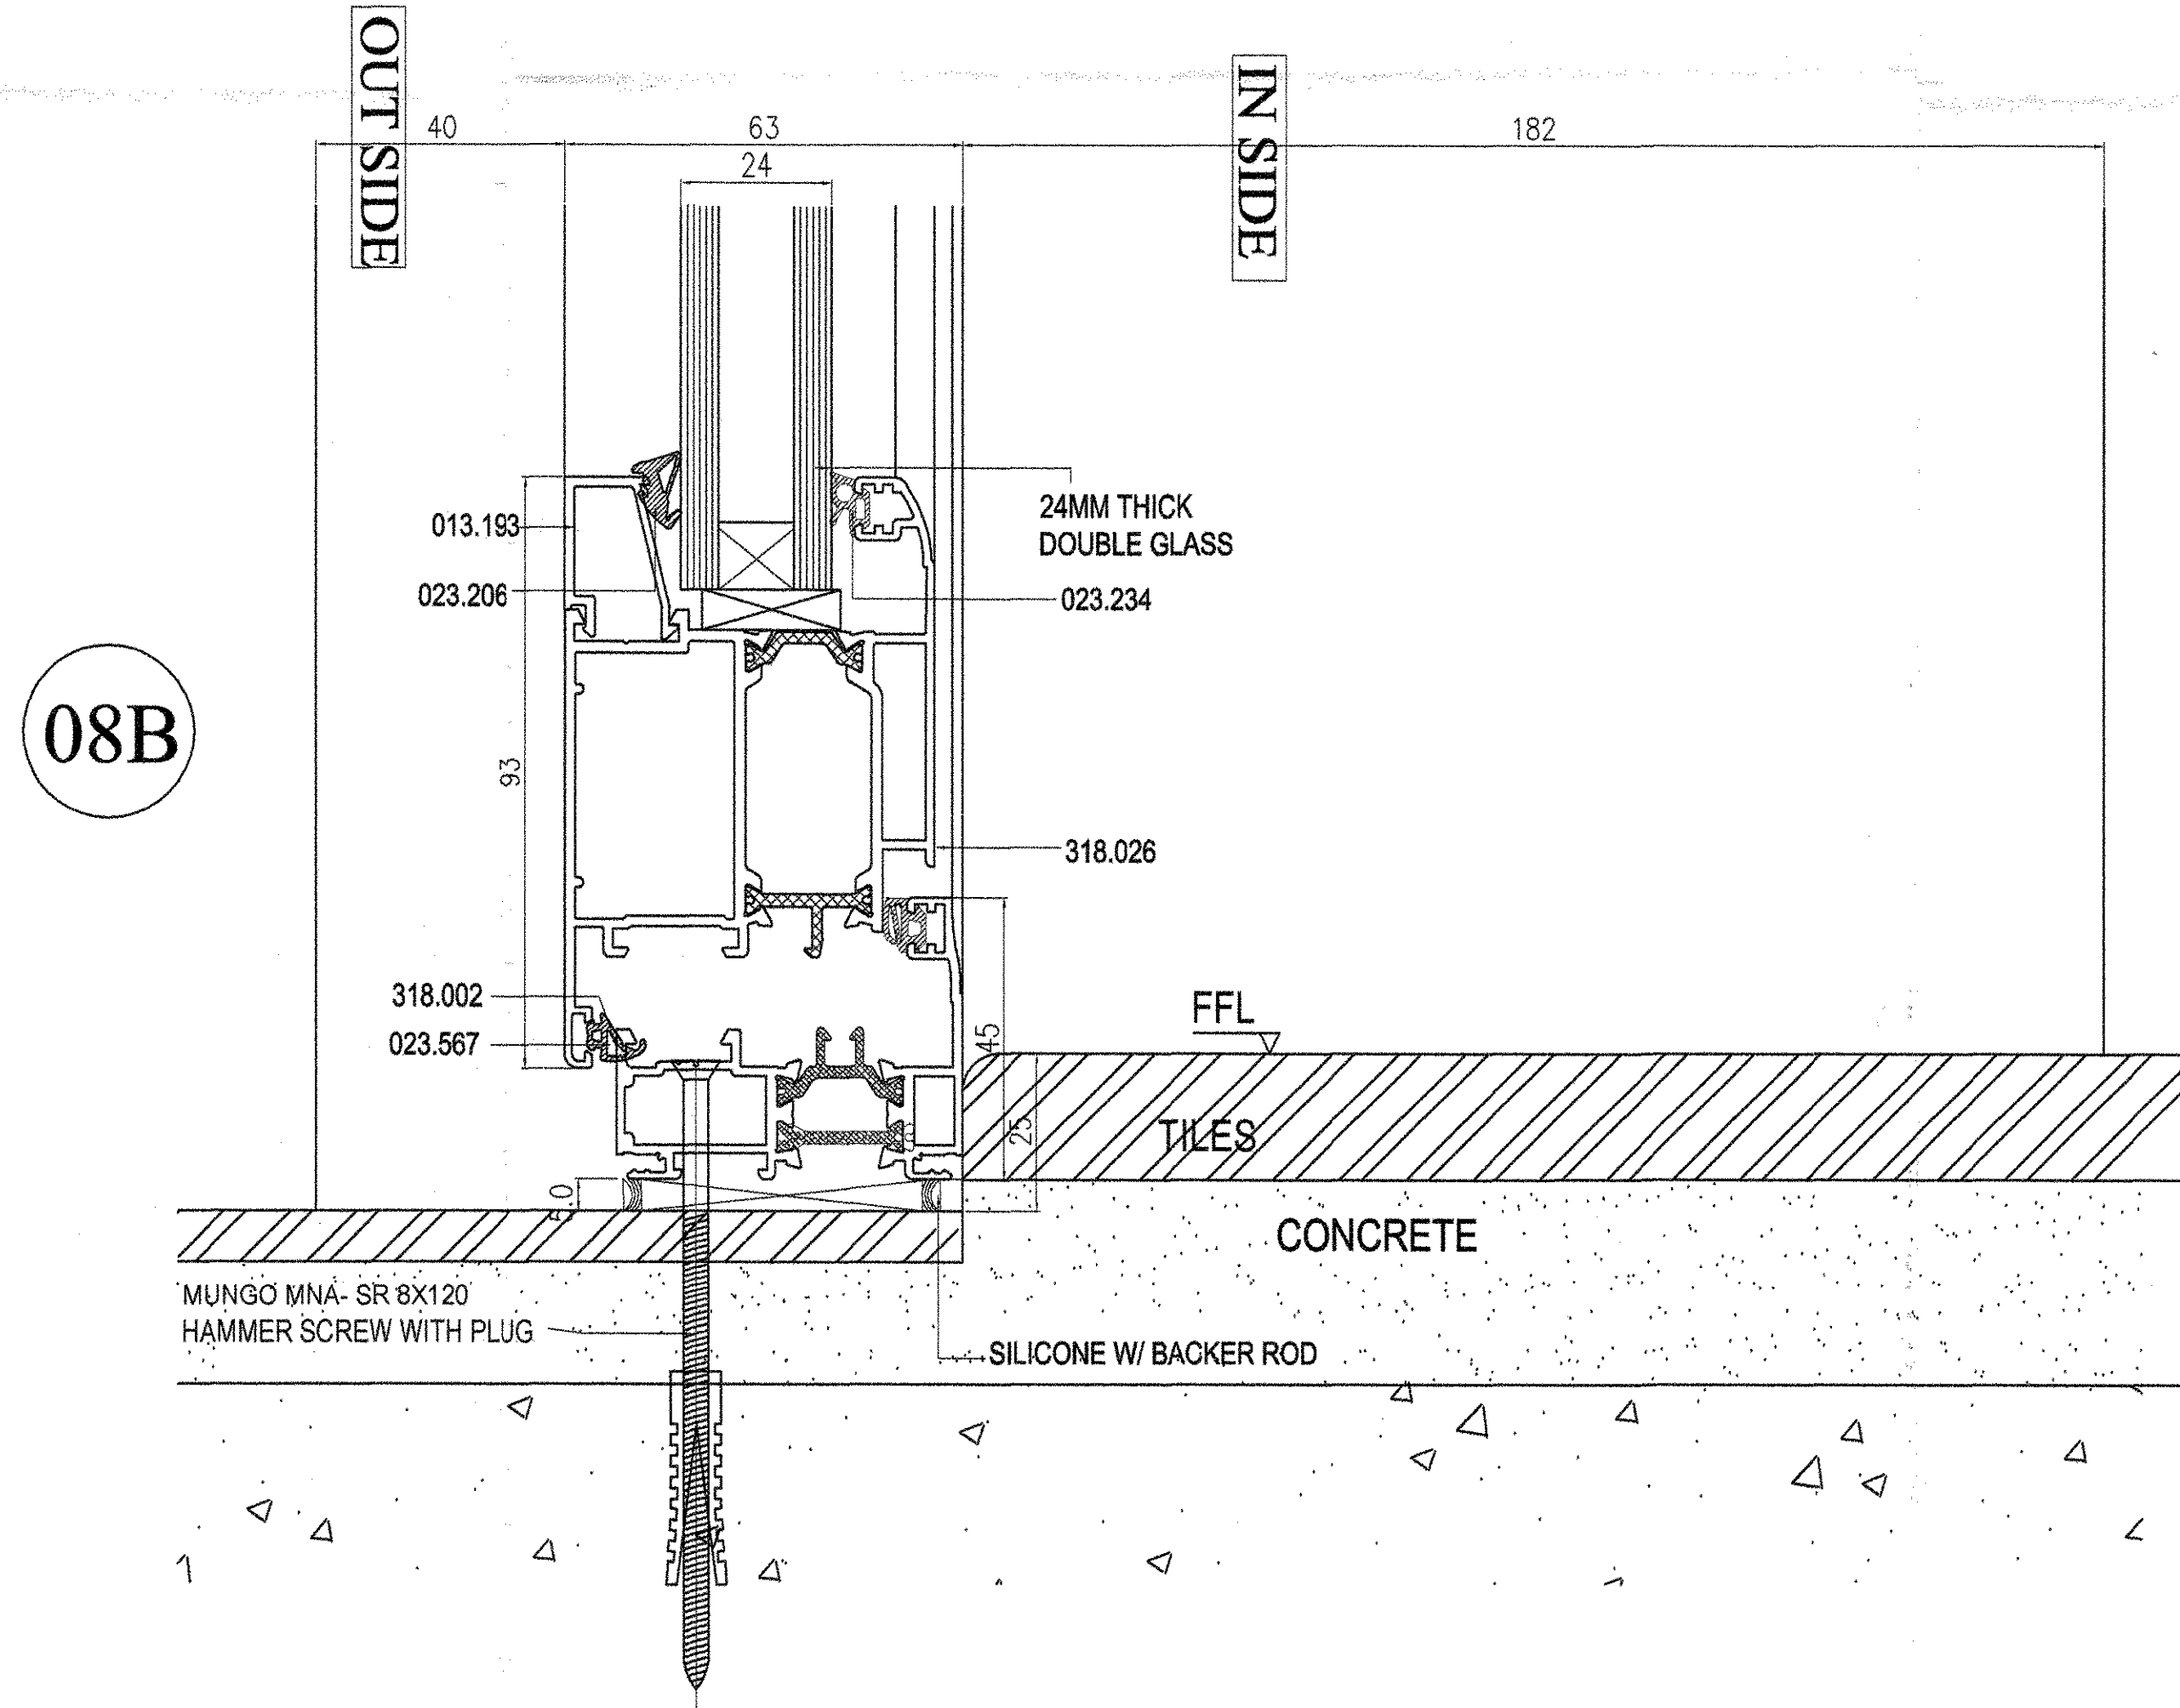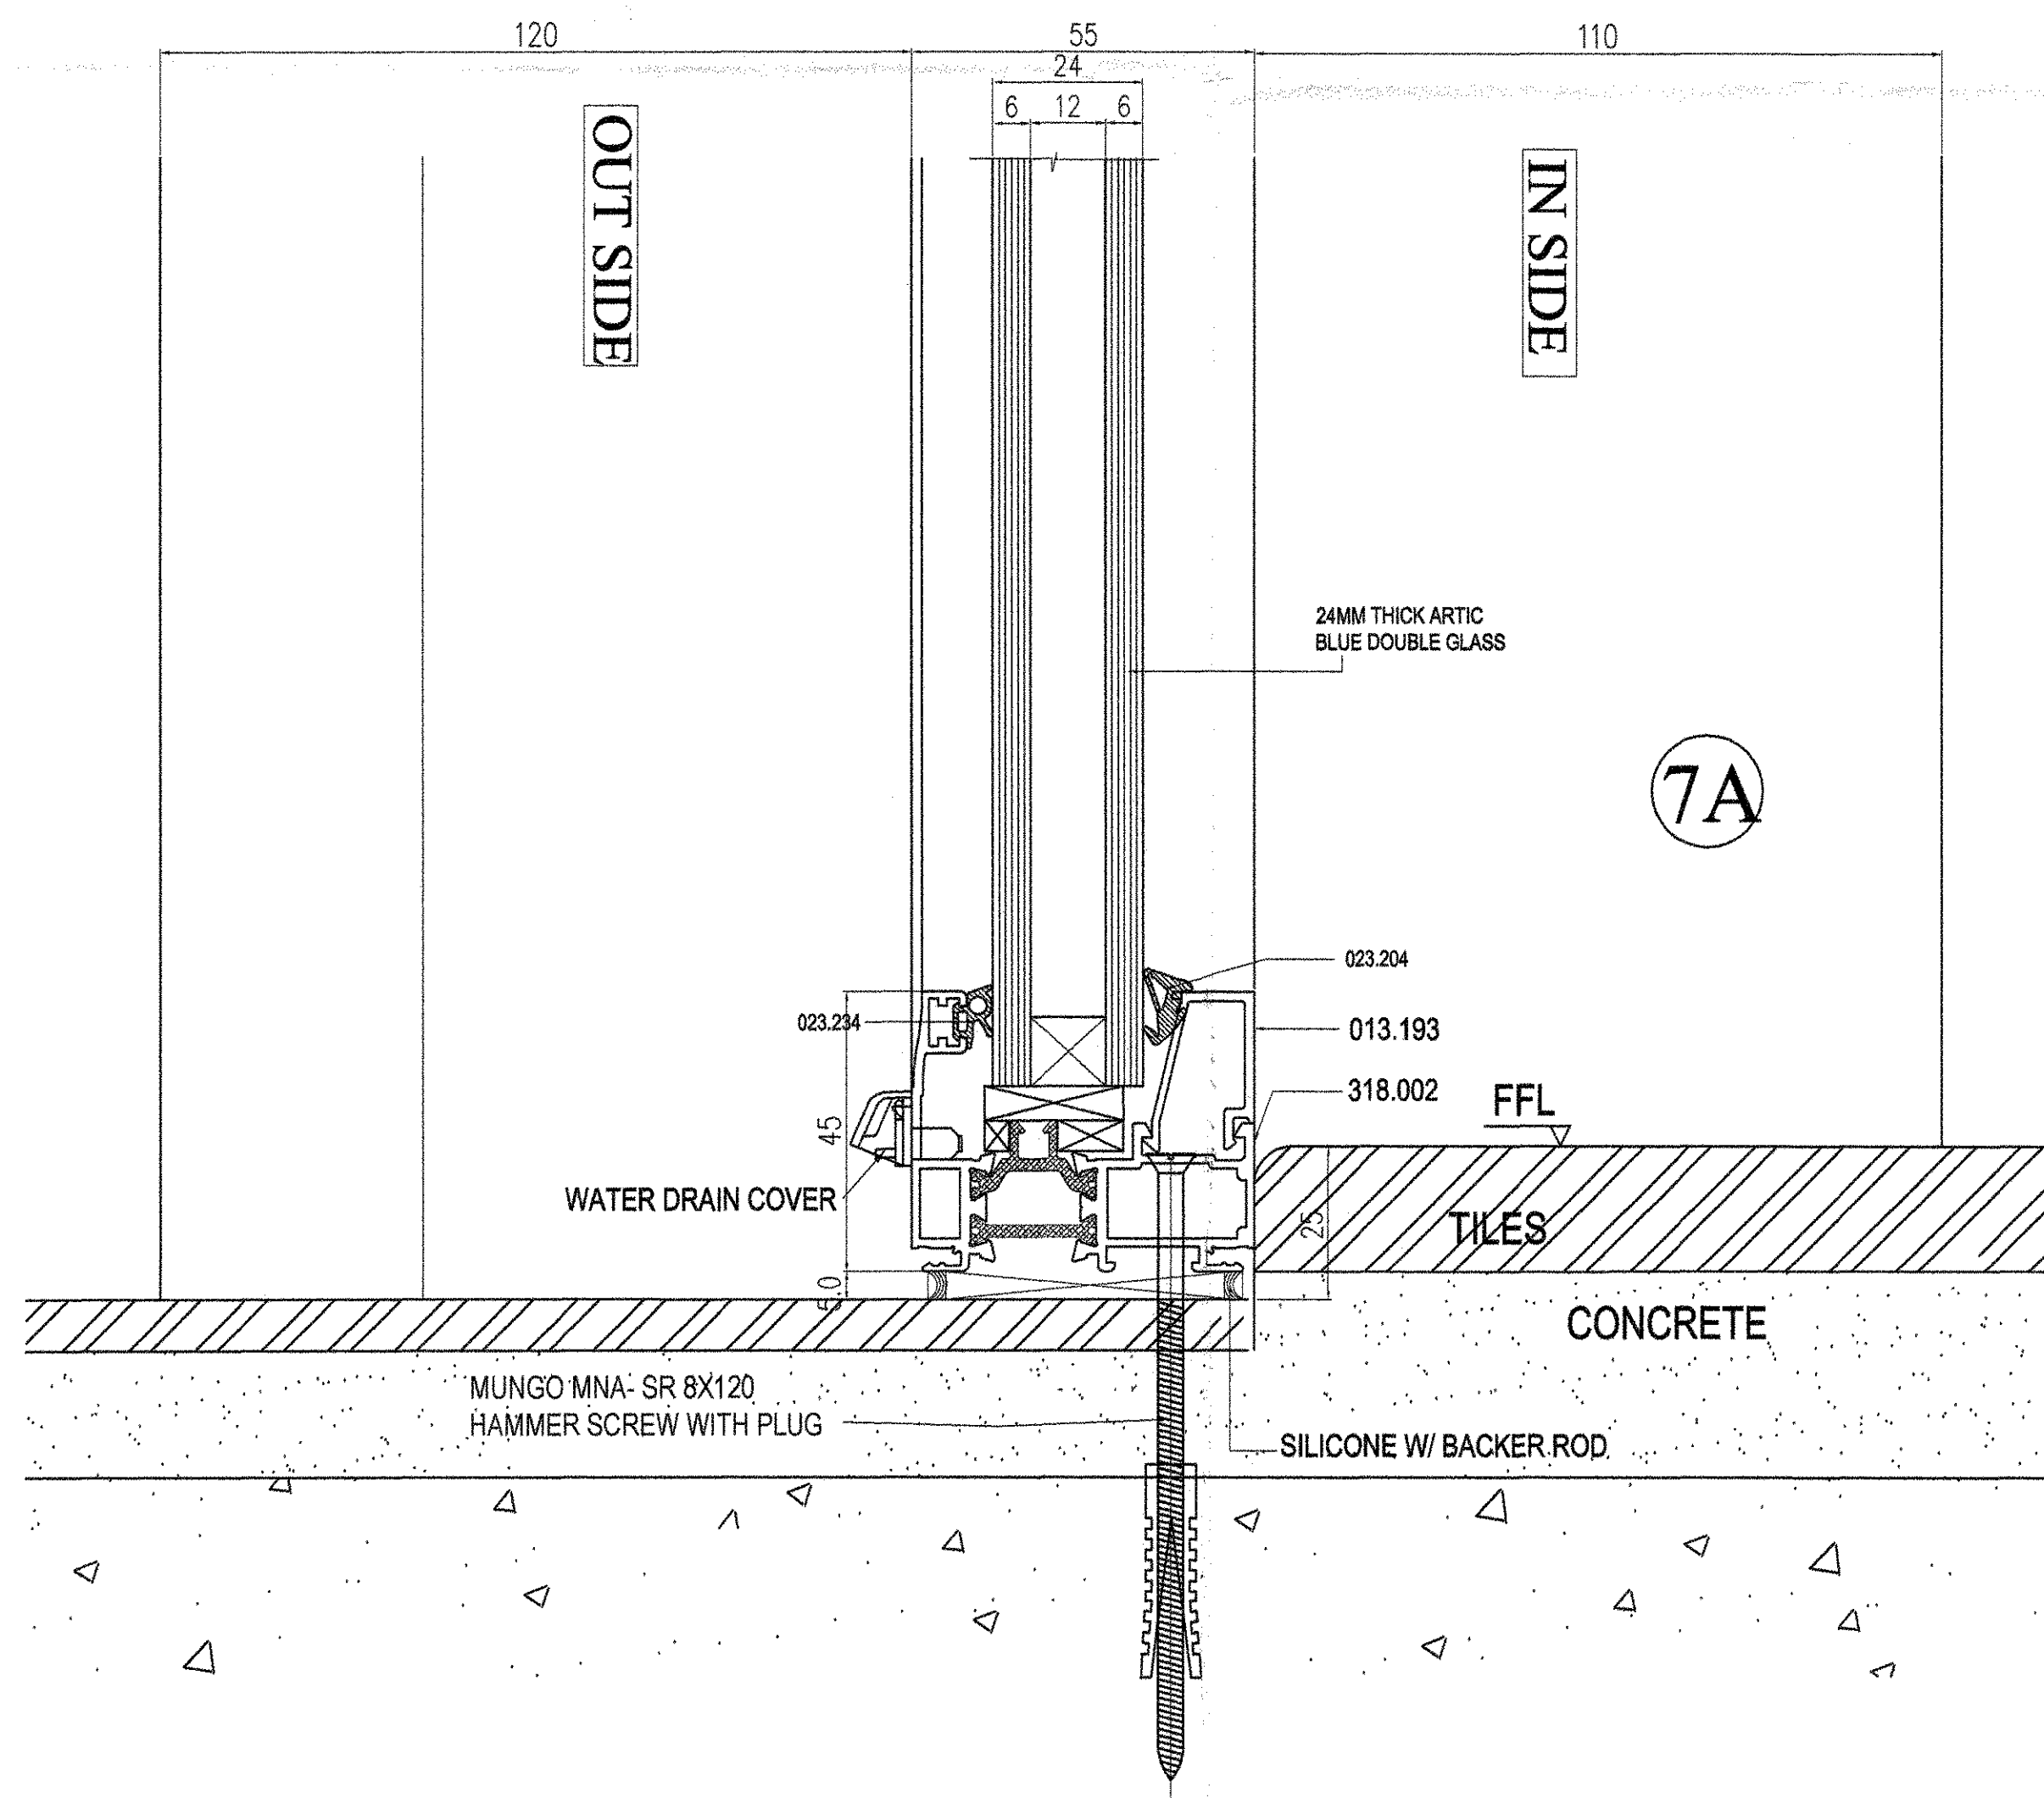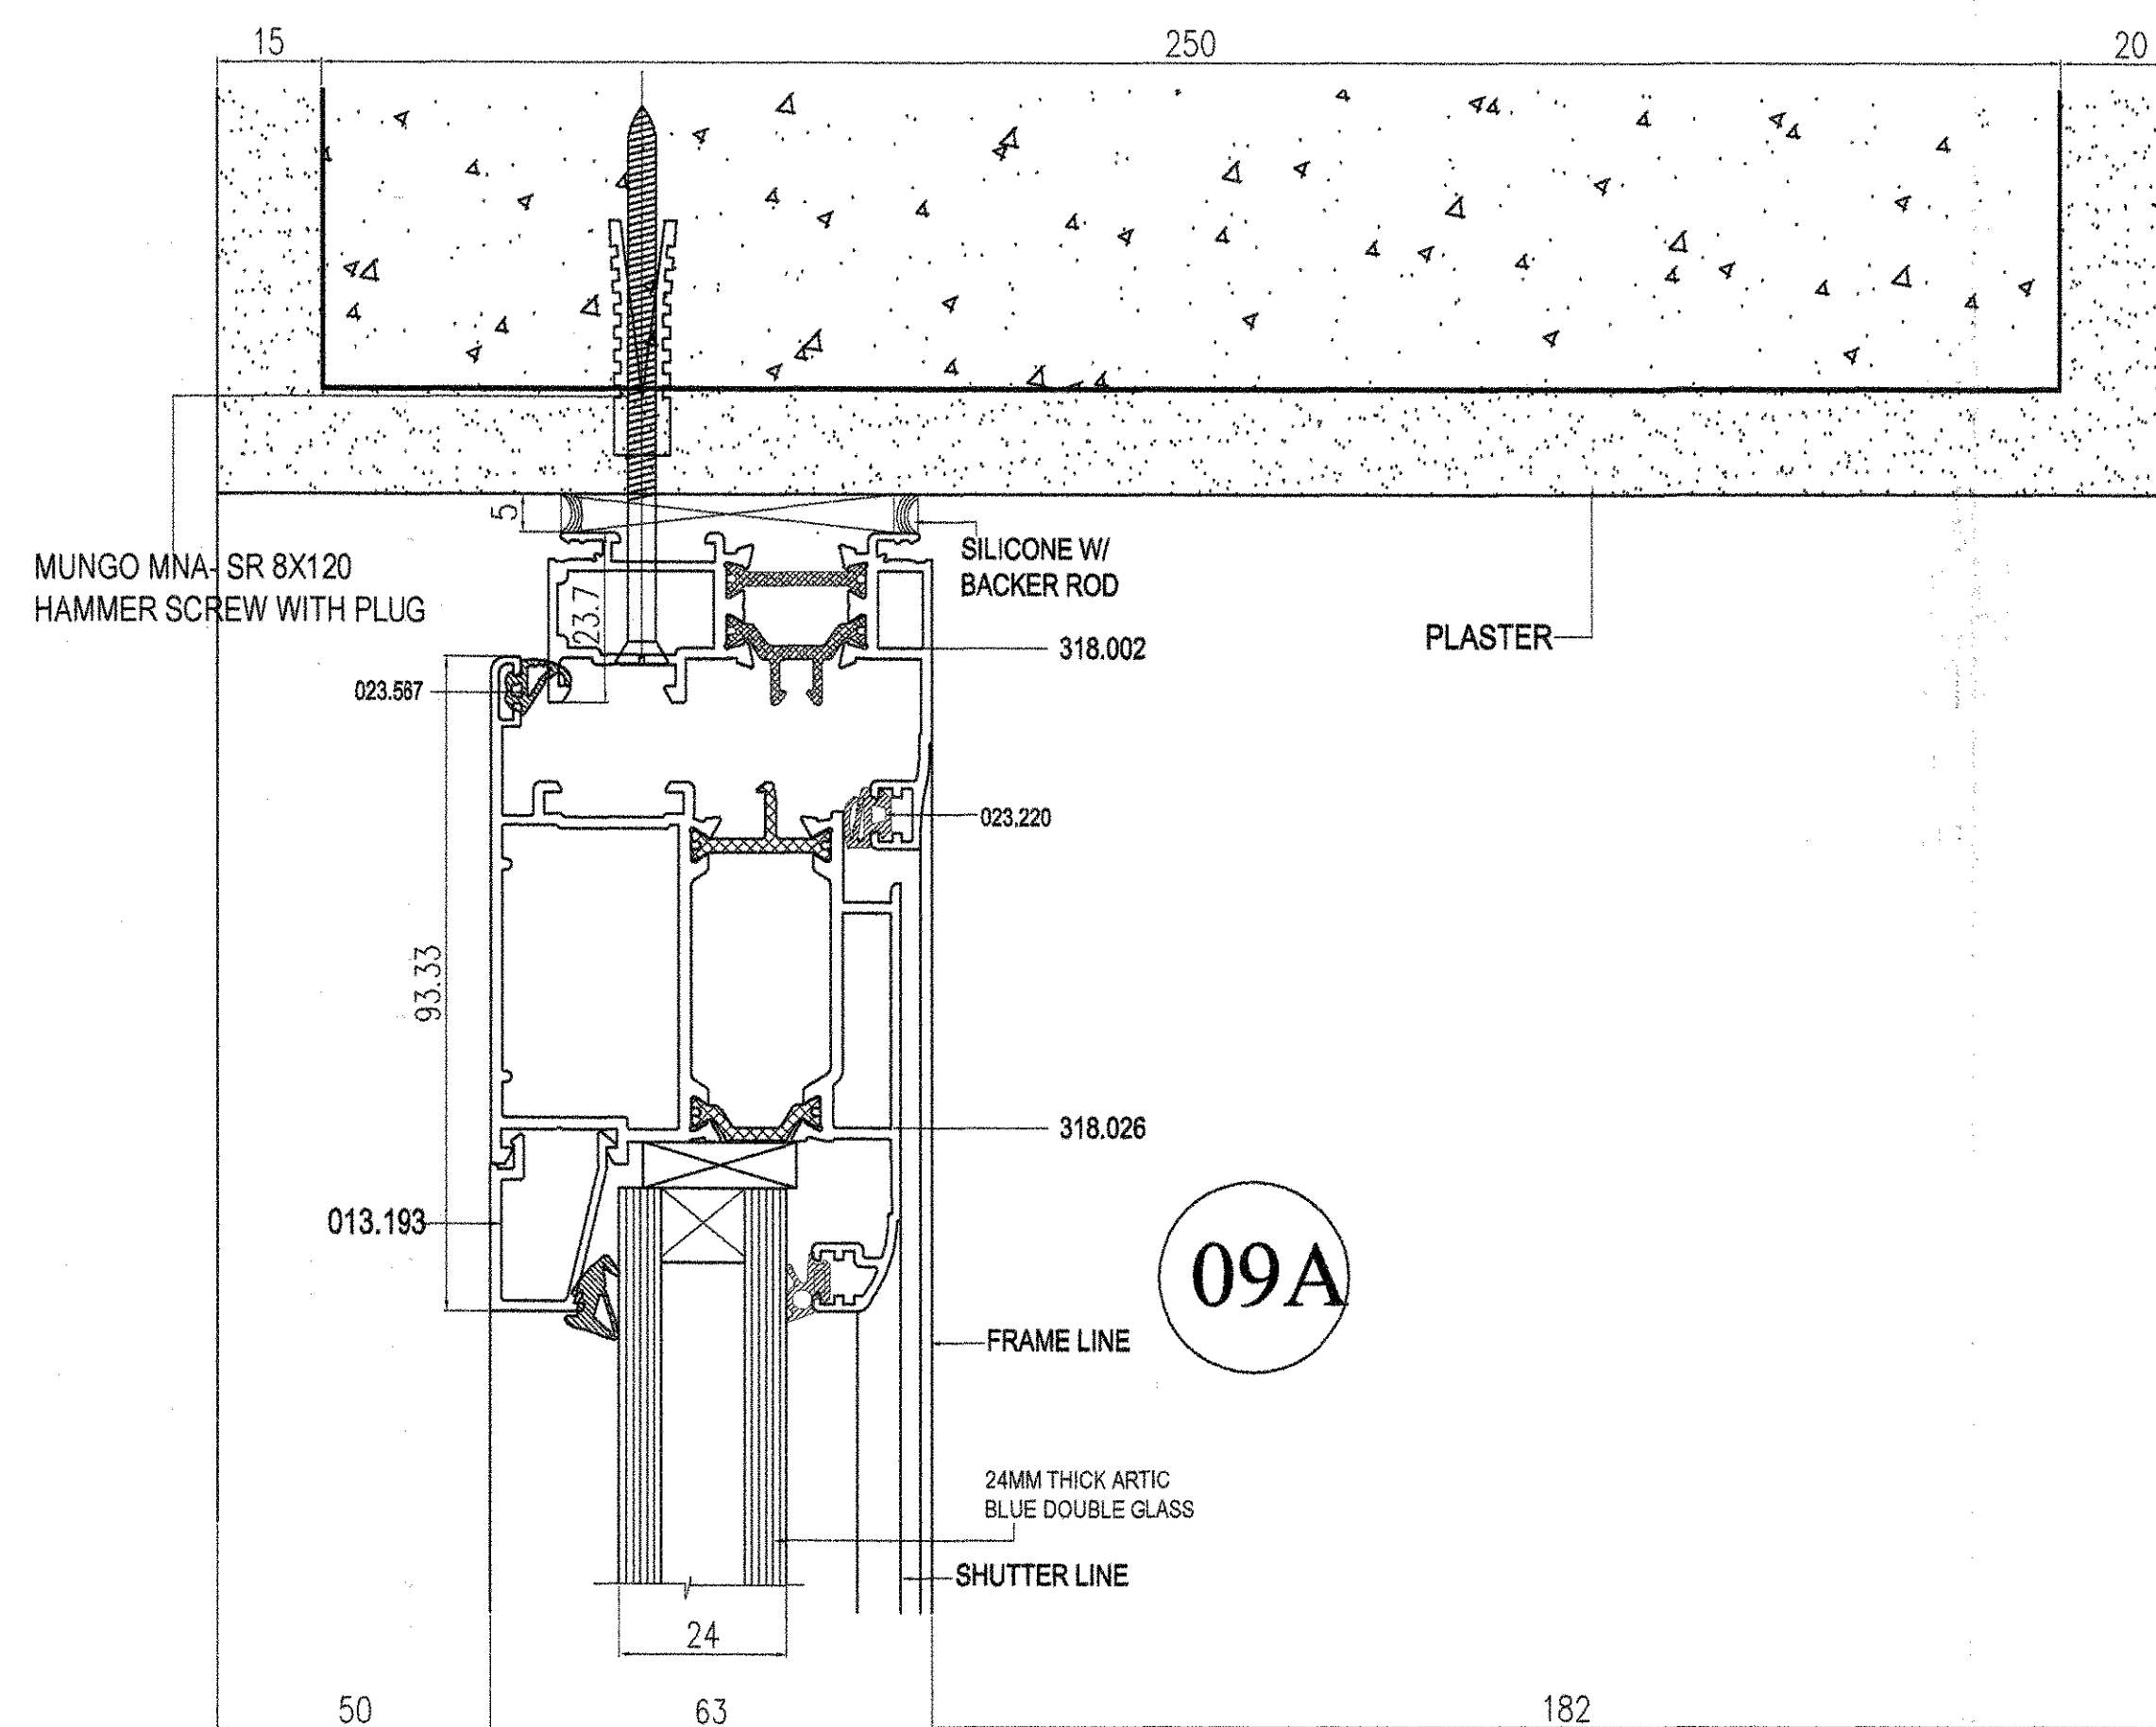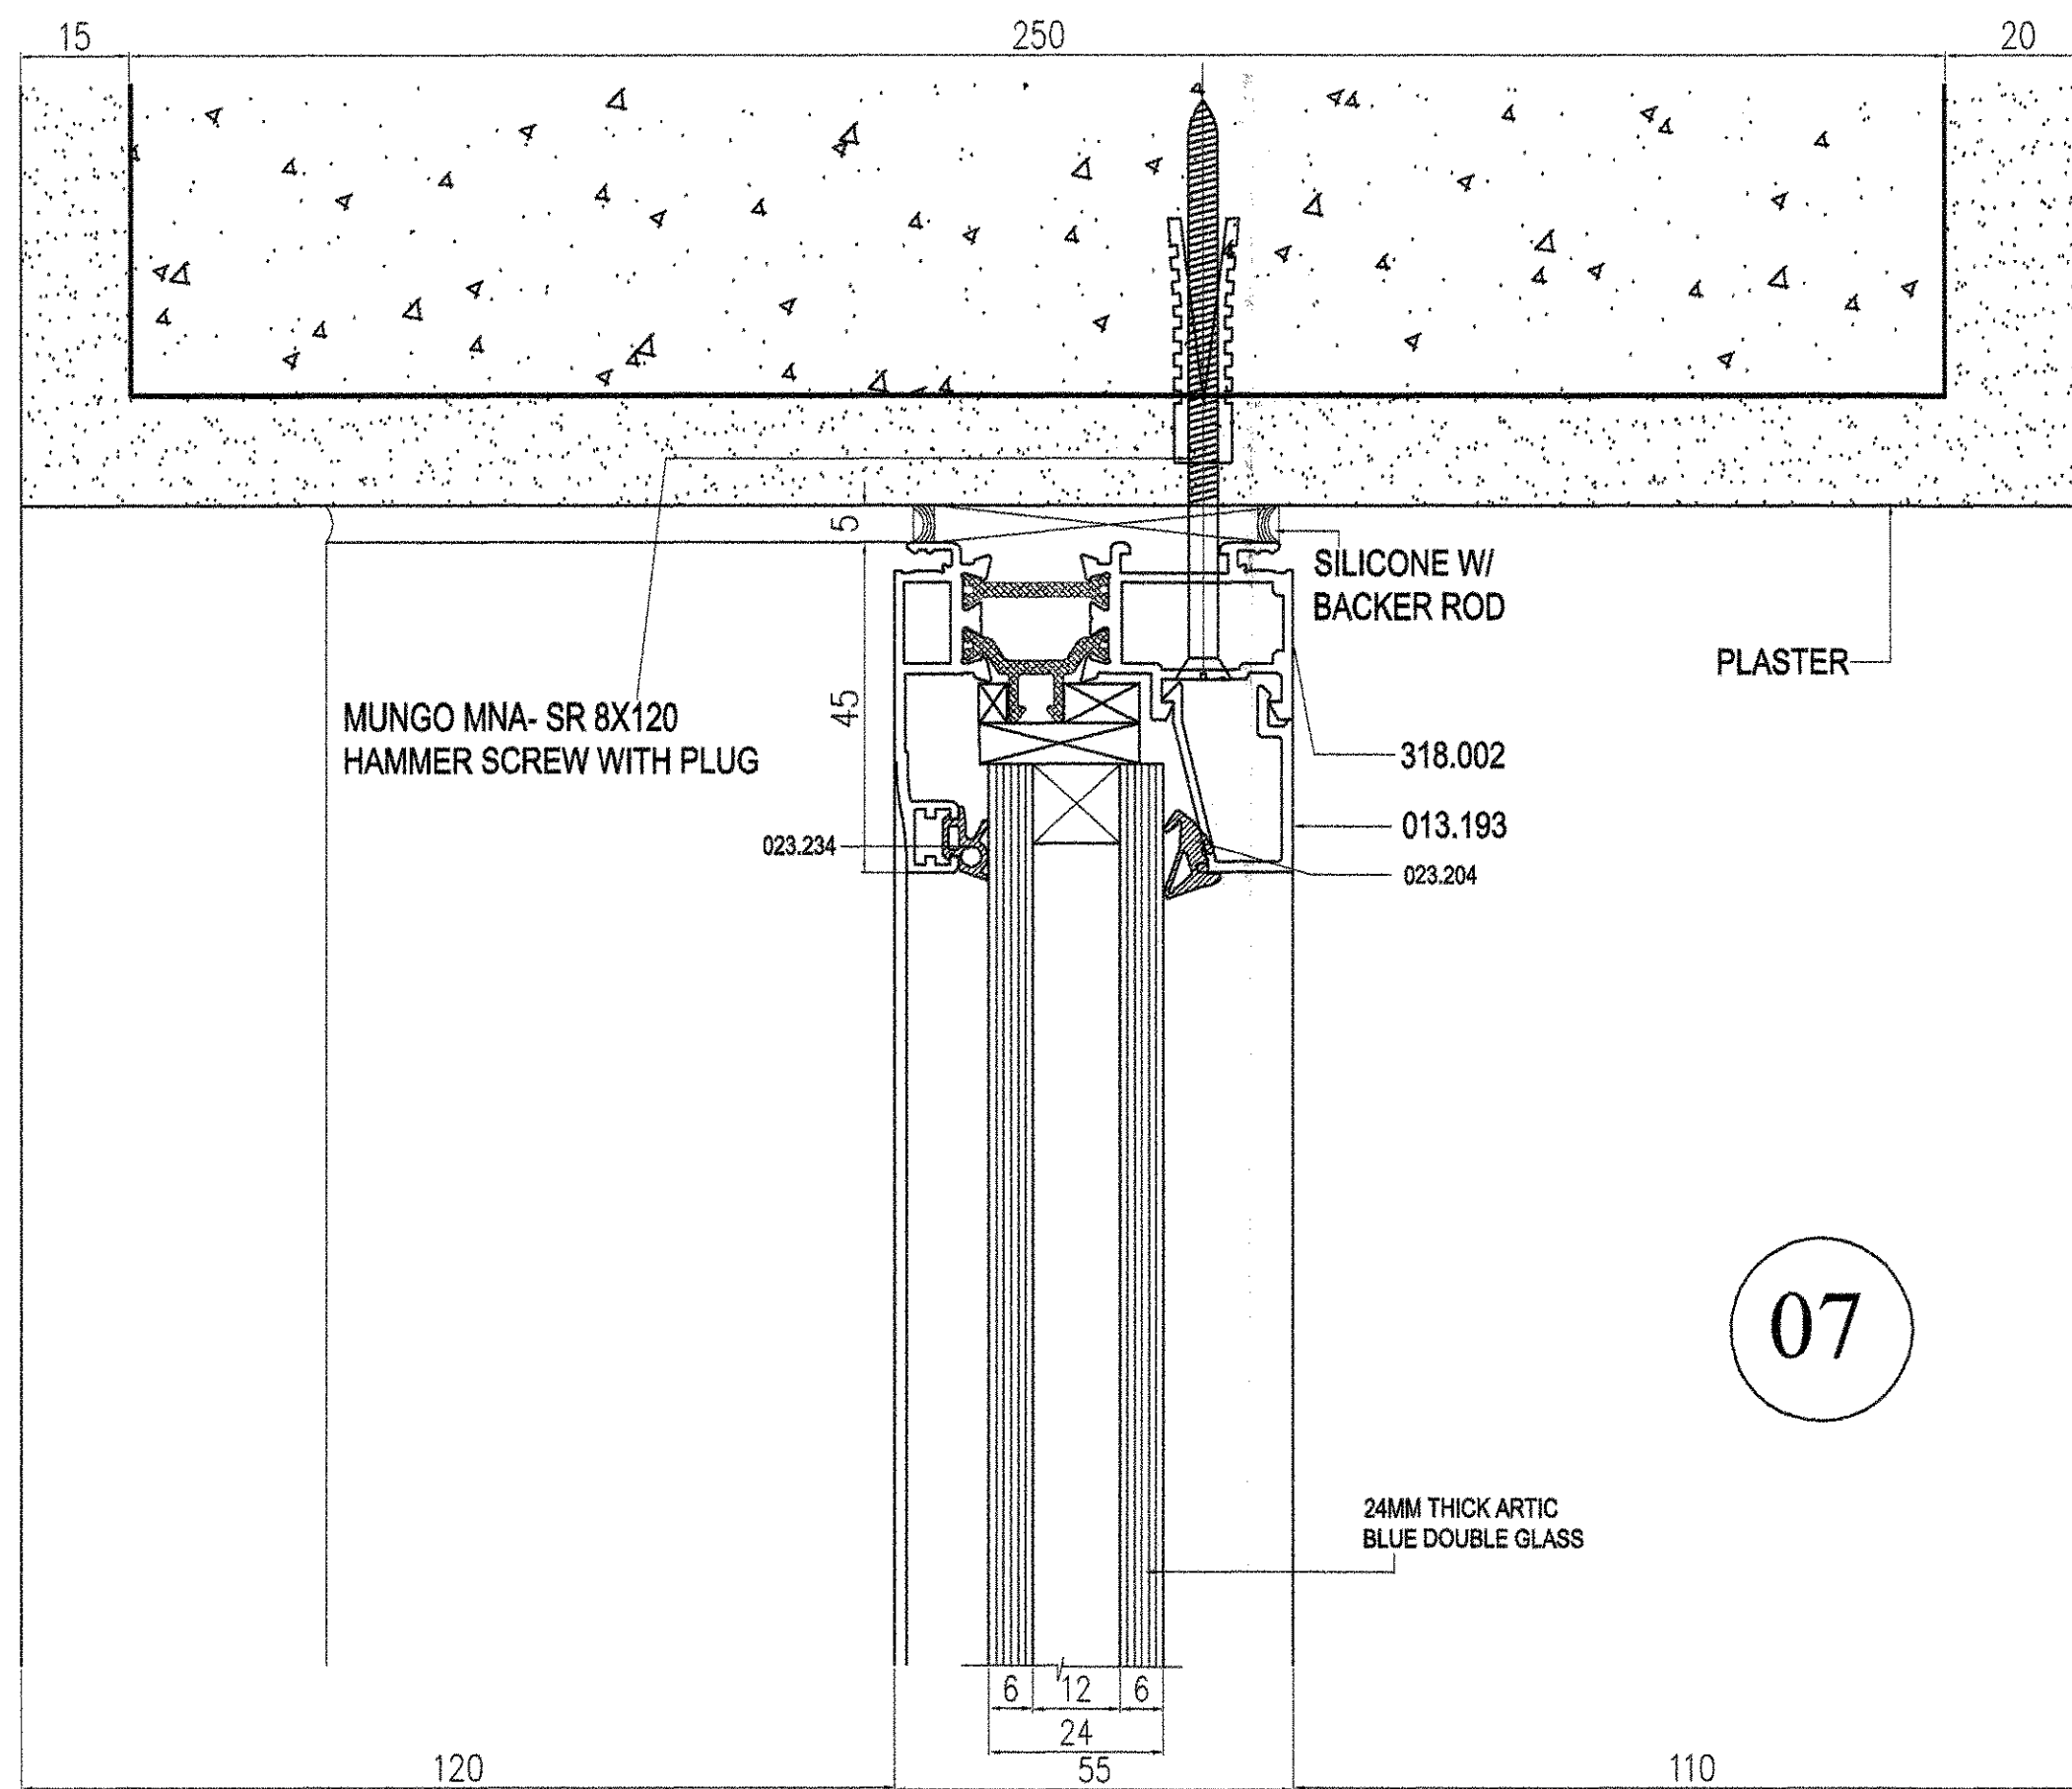

dar al-handasah
Sheir and Partners

☐ CODE 1 APPROVED

☐ CODE 2 APPROVED AS NOTED
WORK MAY PROCEED SUBJECT TO
INCORPORATION OF ENDORSED
COMMENTS

☐ CODE 3 RESUBMIT FOR APPROVAL
WORK MAY NOT PROCEED

☐ CODE 4 REJECTED

BY: _____ DATE: _____

Approval shall not relieve the contractor of any of his
obligations under the Contract or constitute authorization of
any change to Contract Documents or variation to the work.
Contractor is responsible for dimensions, quantities and
coordination with other trades.



AS BUILT DRAWING

JUMEIRAH PARK



Pauling Middle East



WHITE ALUMINIUM ENT.

PACKAGE - 2

Cluster - 1

PACKAGE - 2A





Clusters - 1, 3 (Villas 51 to 62), 4, 5, 7 (Villas 33 to 41),
8, 9, 10, 11, 12, 13, 14, 15 (Villas 1 to 14) & 16

ALUMINIUM & GLASS
DETAILS

Drawn: IBRAHIM Review: Eng. Zied Checked: GUGAN

Scale: 1:1 Date: 13-08-2012

Drawing No. PME / JP / AB / LE / ALU / 007A

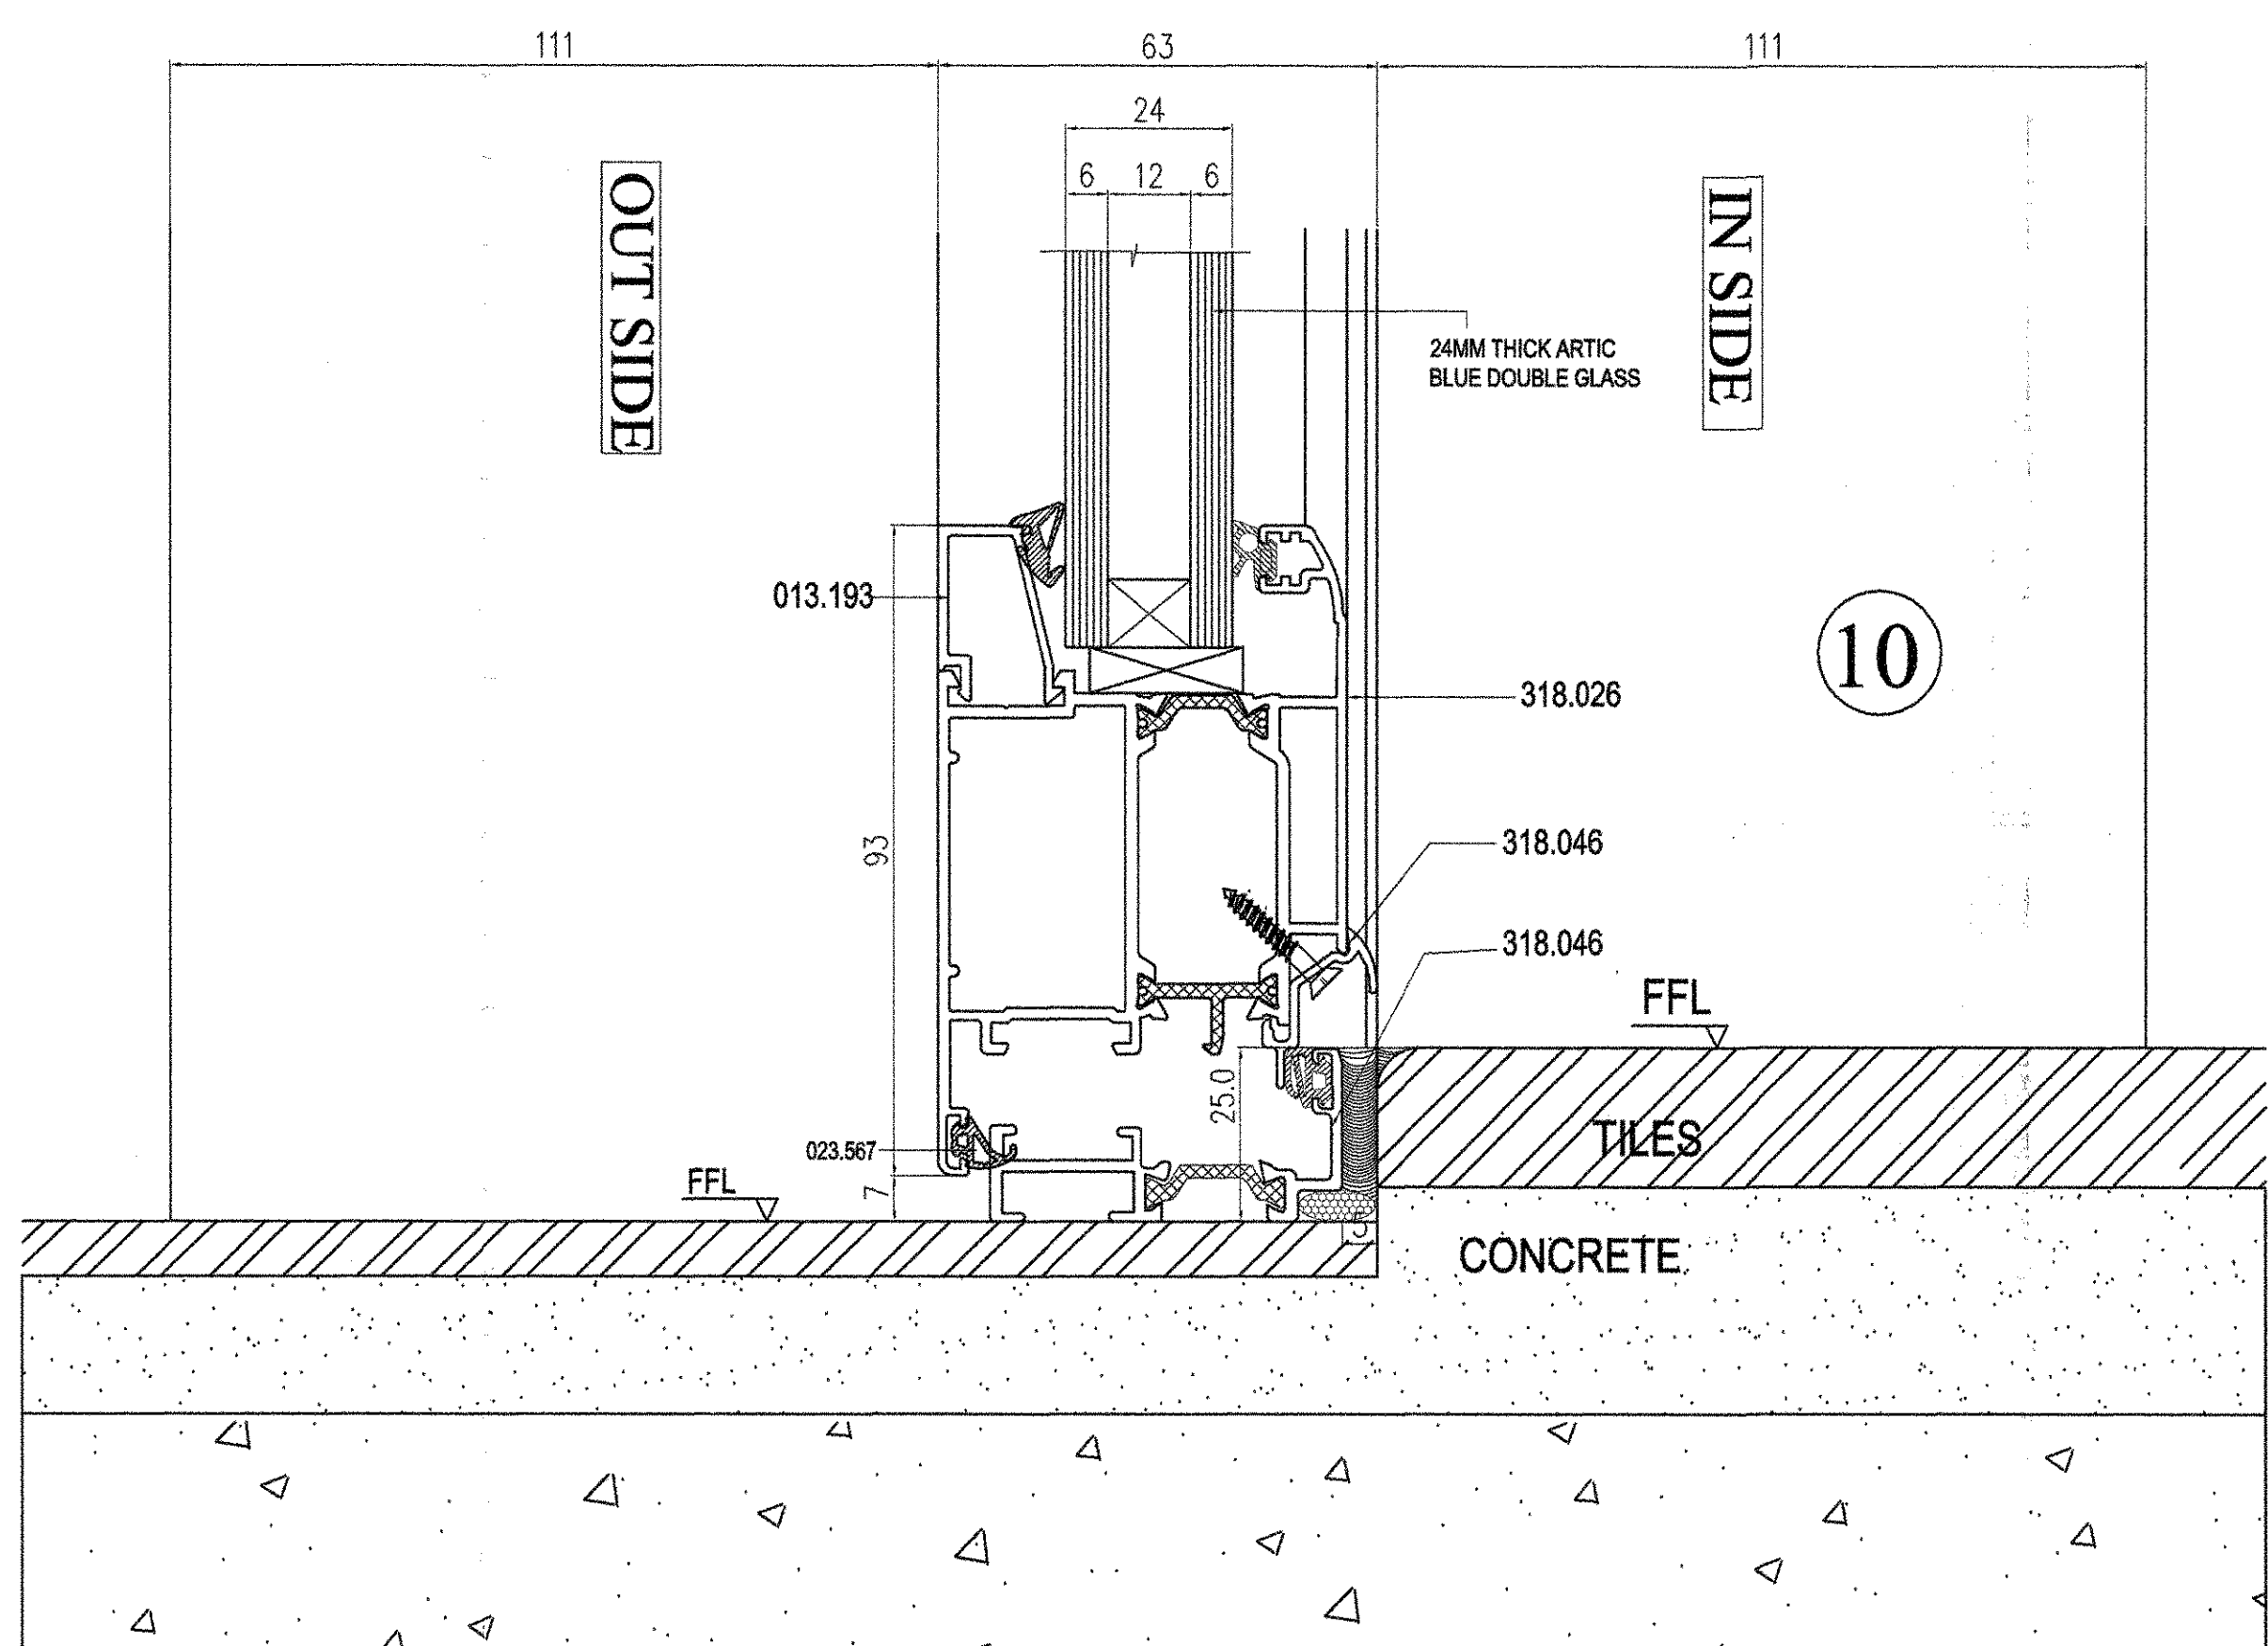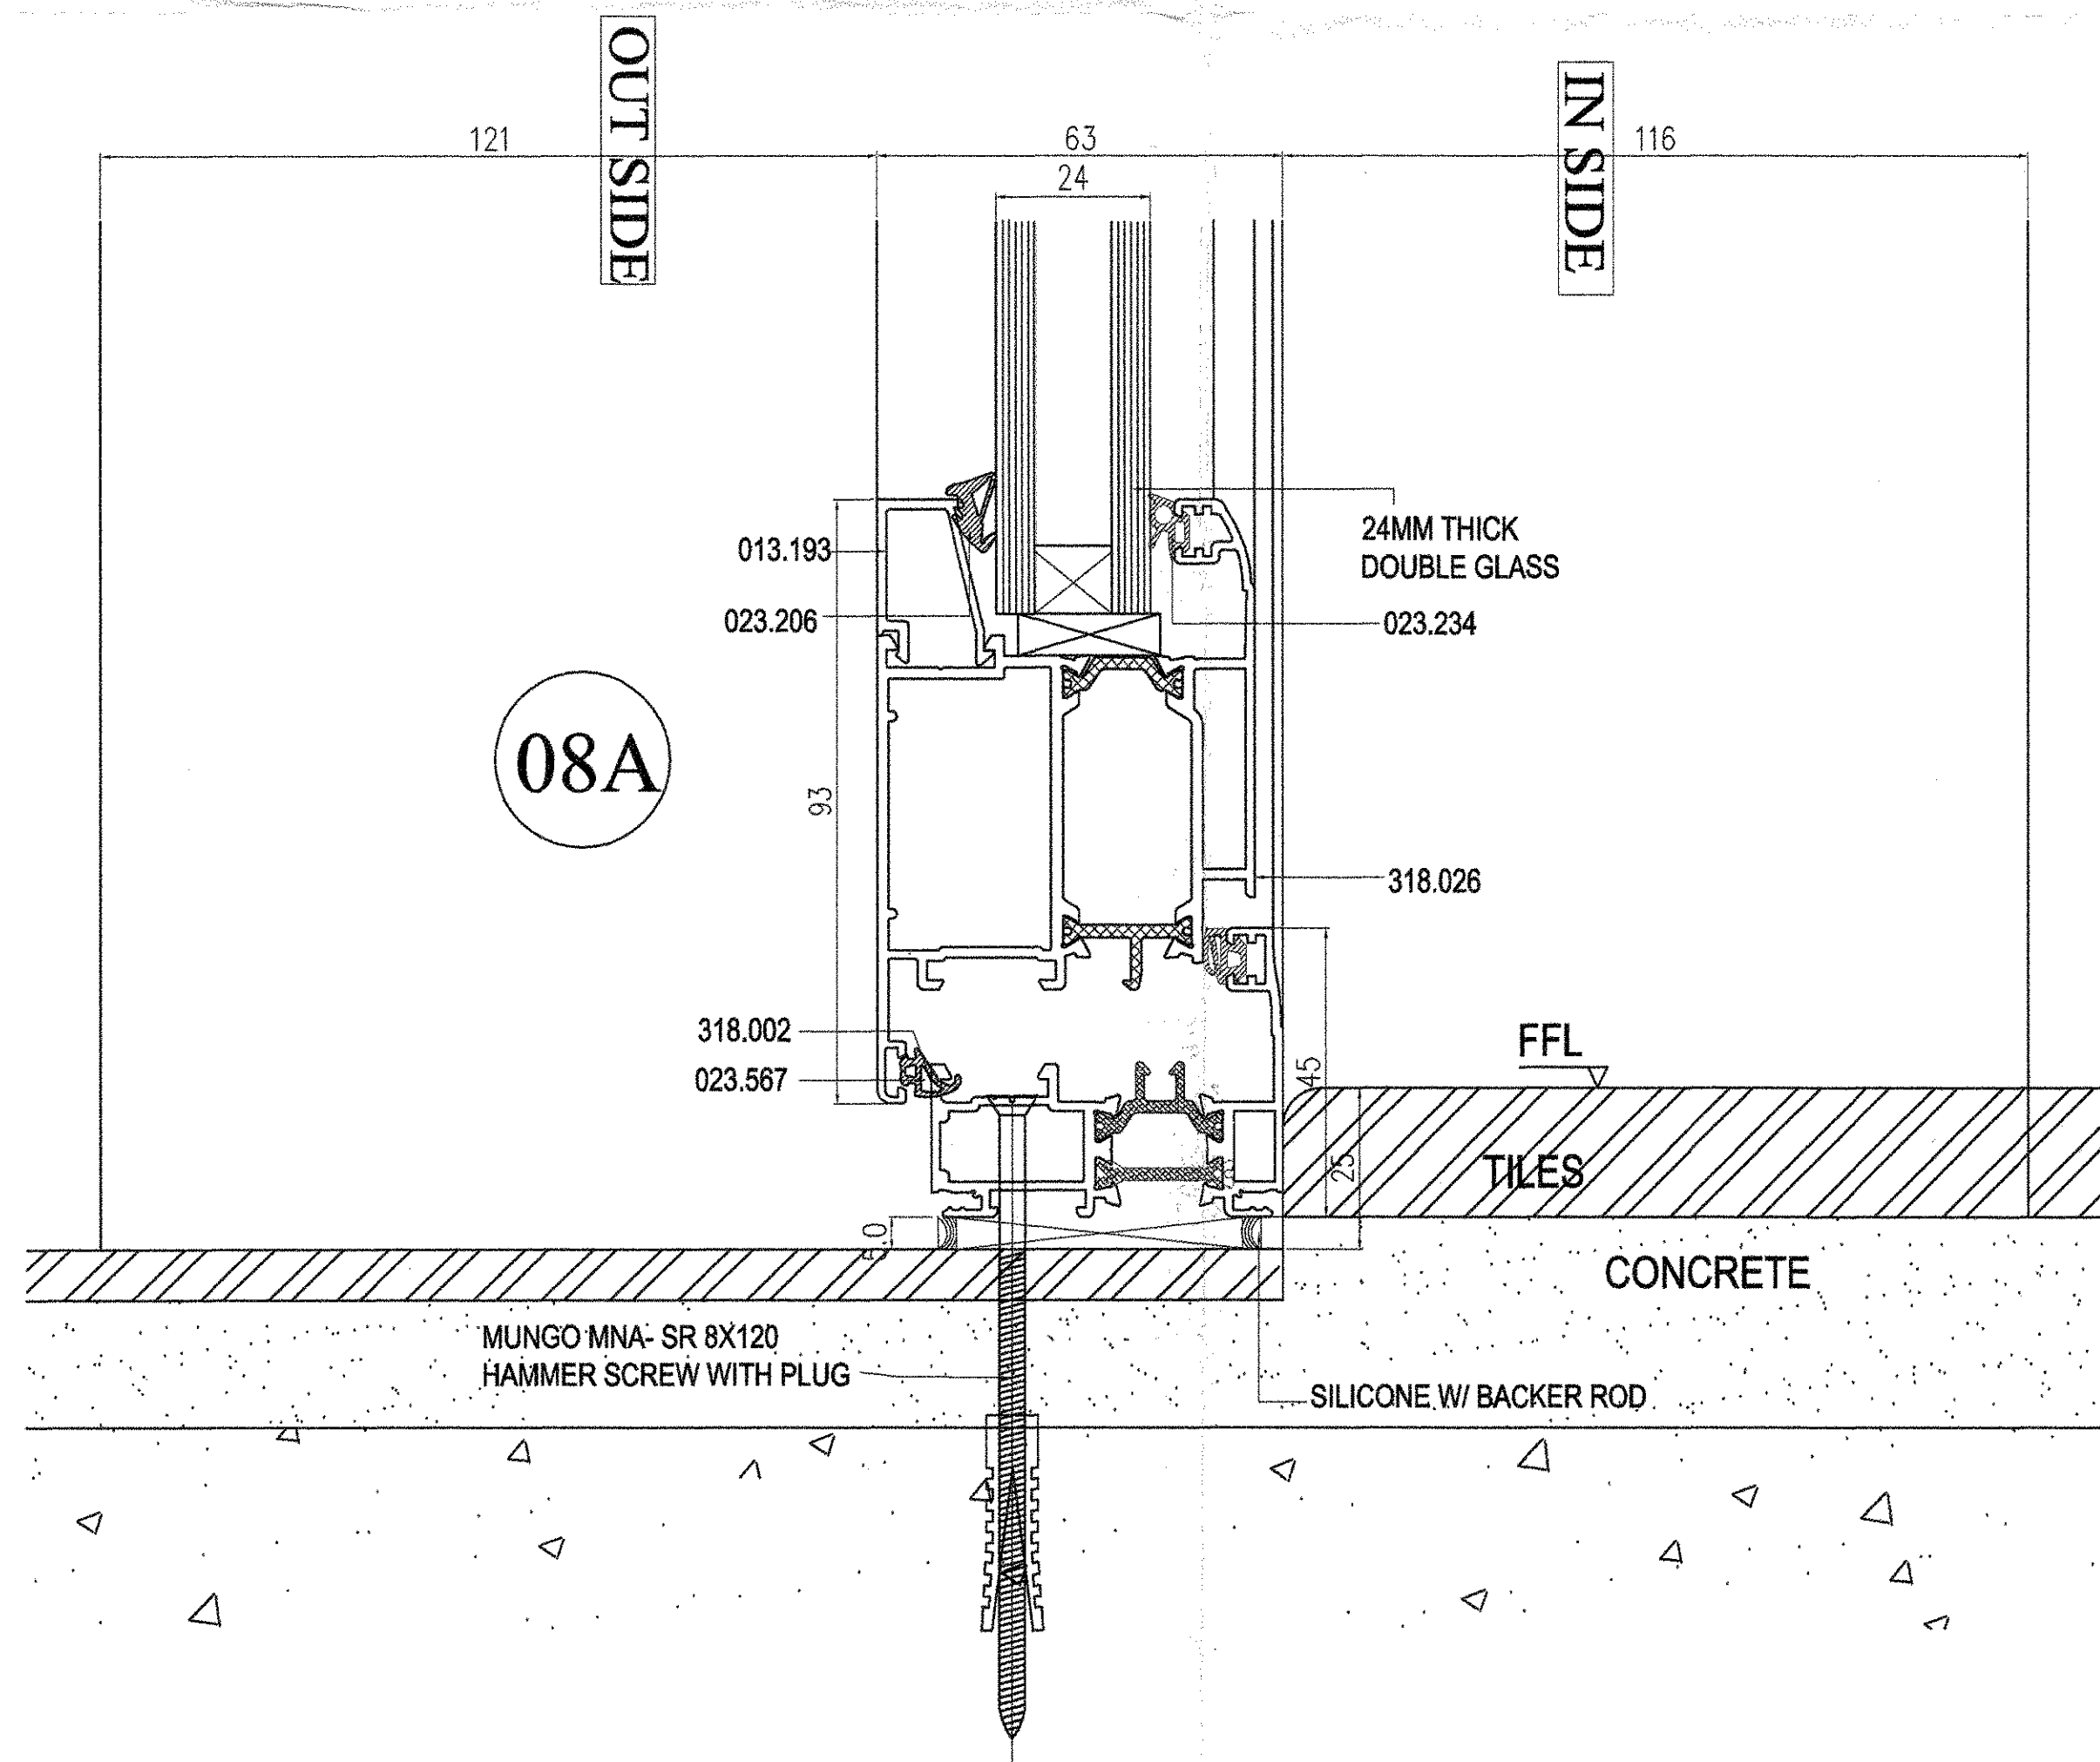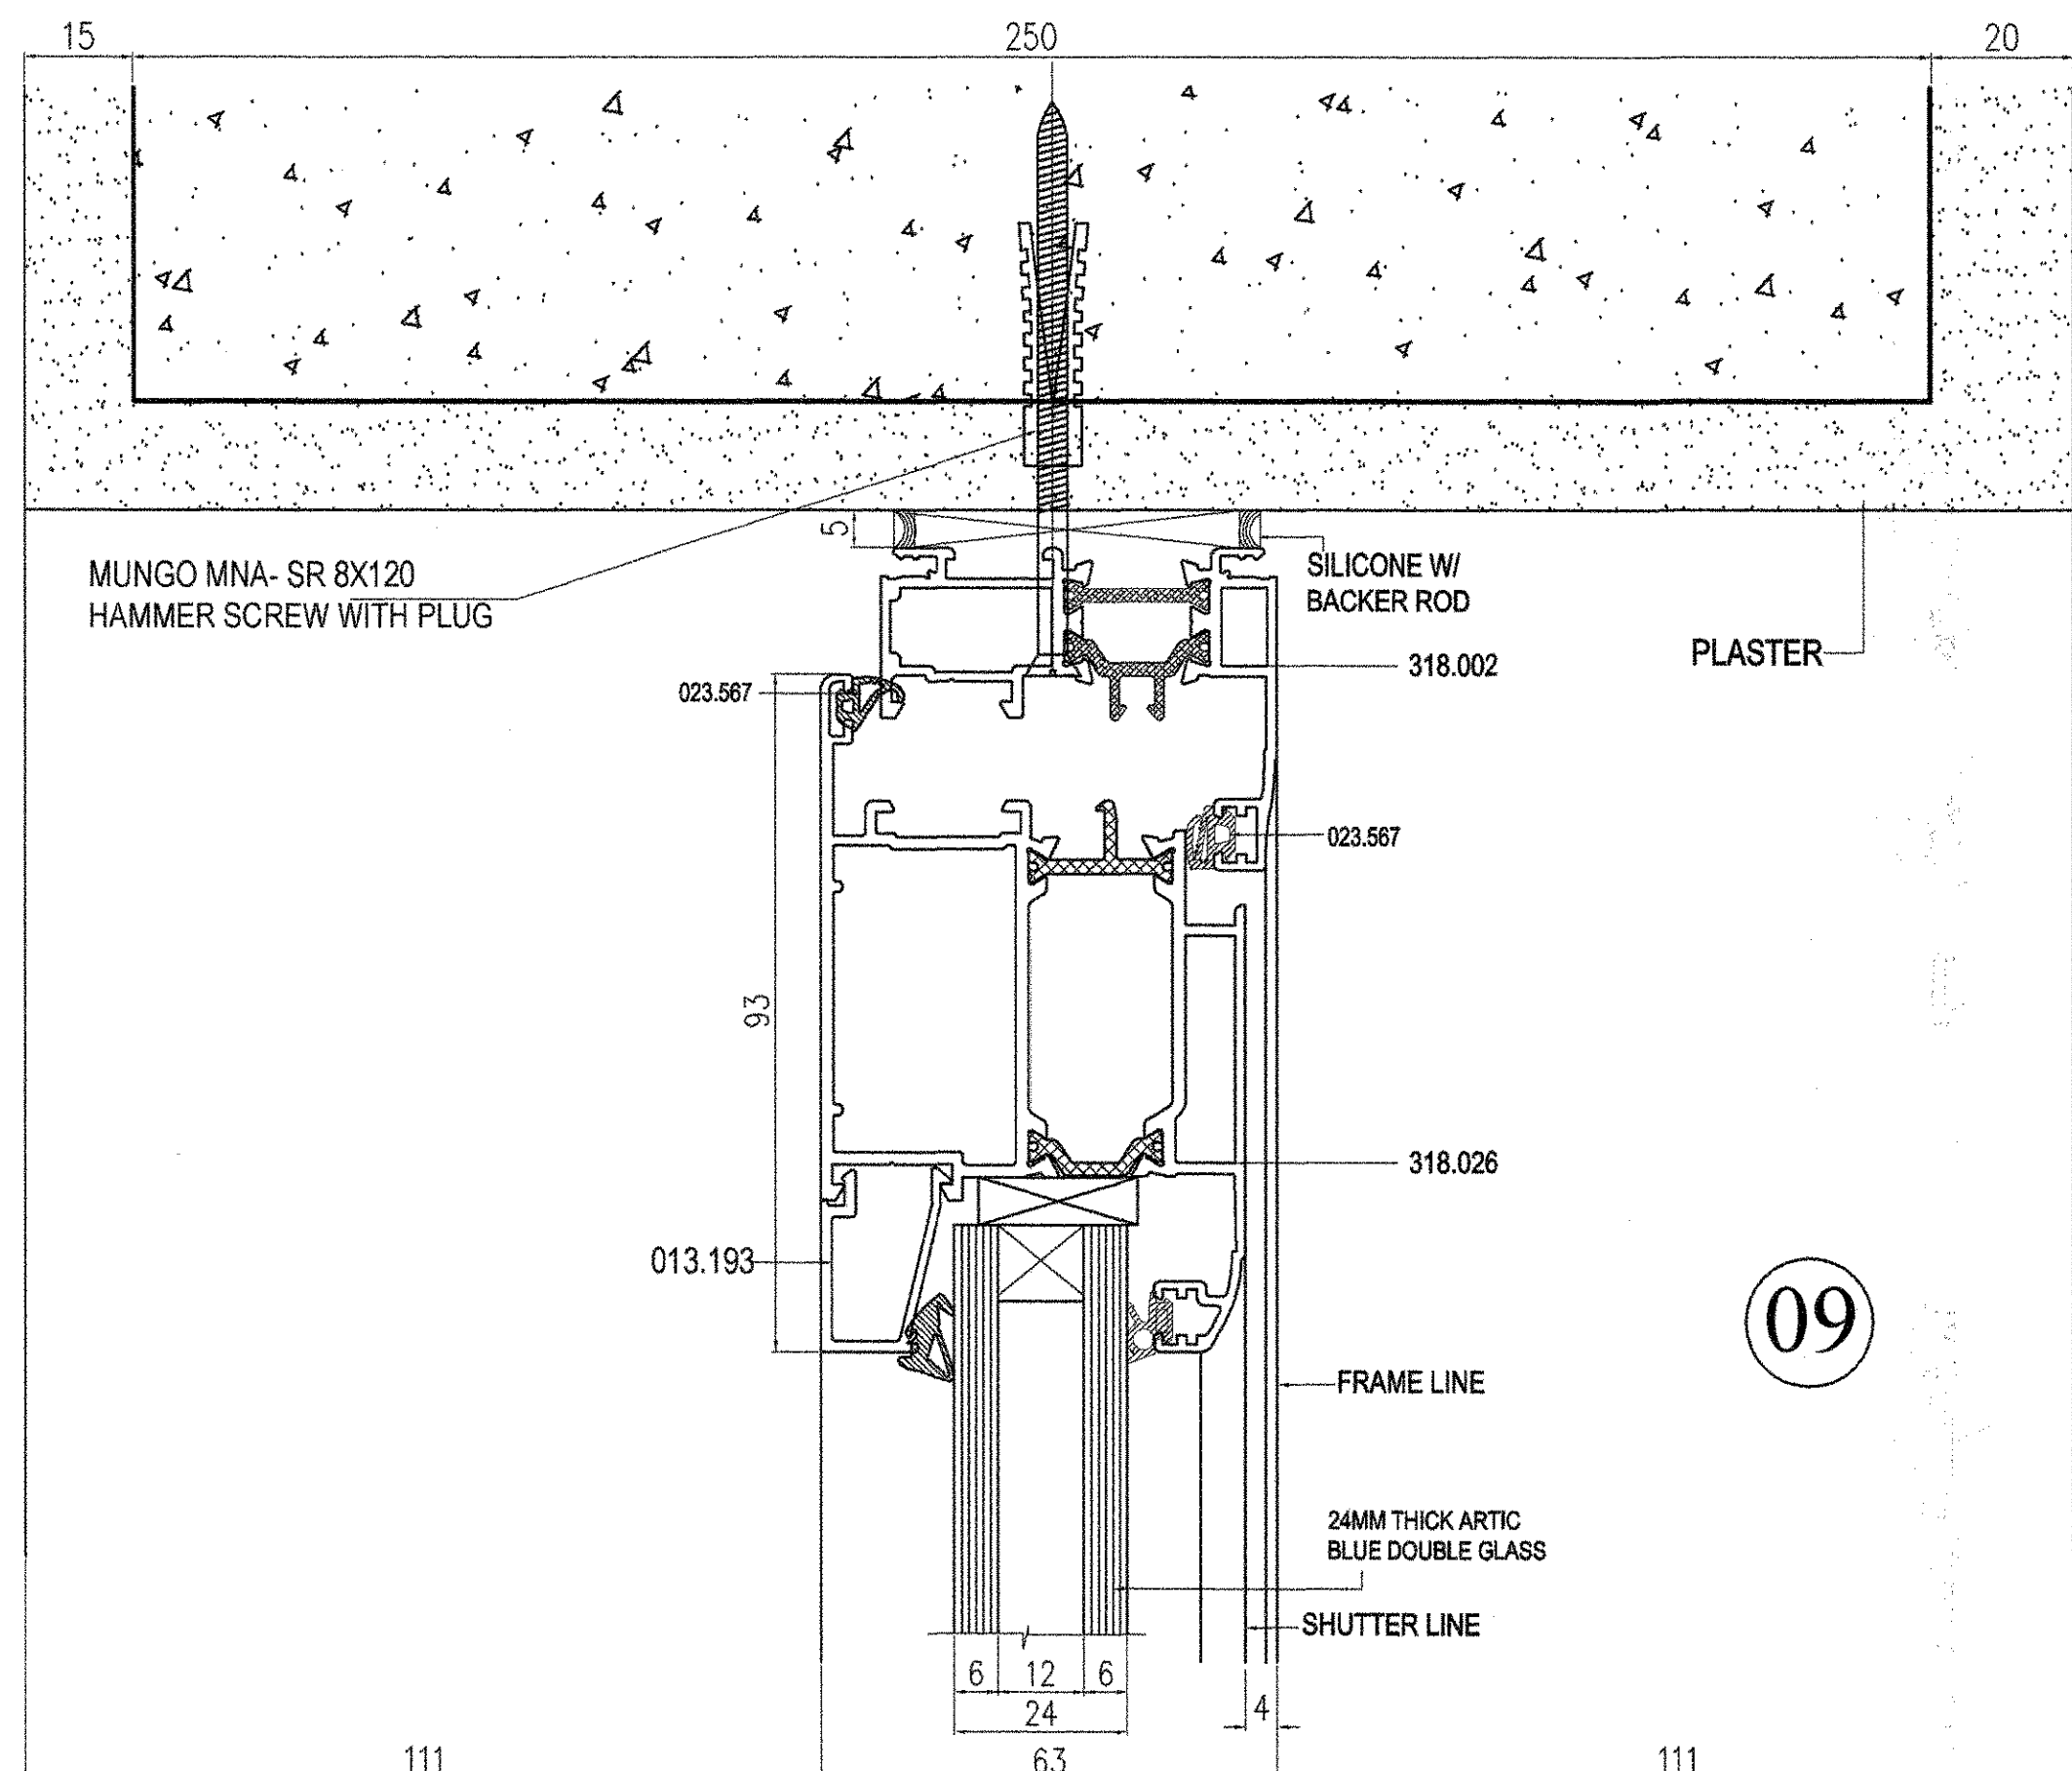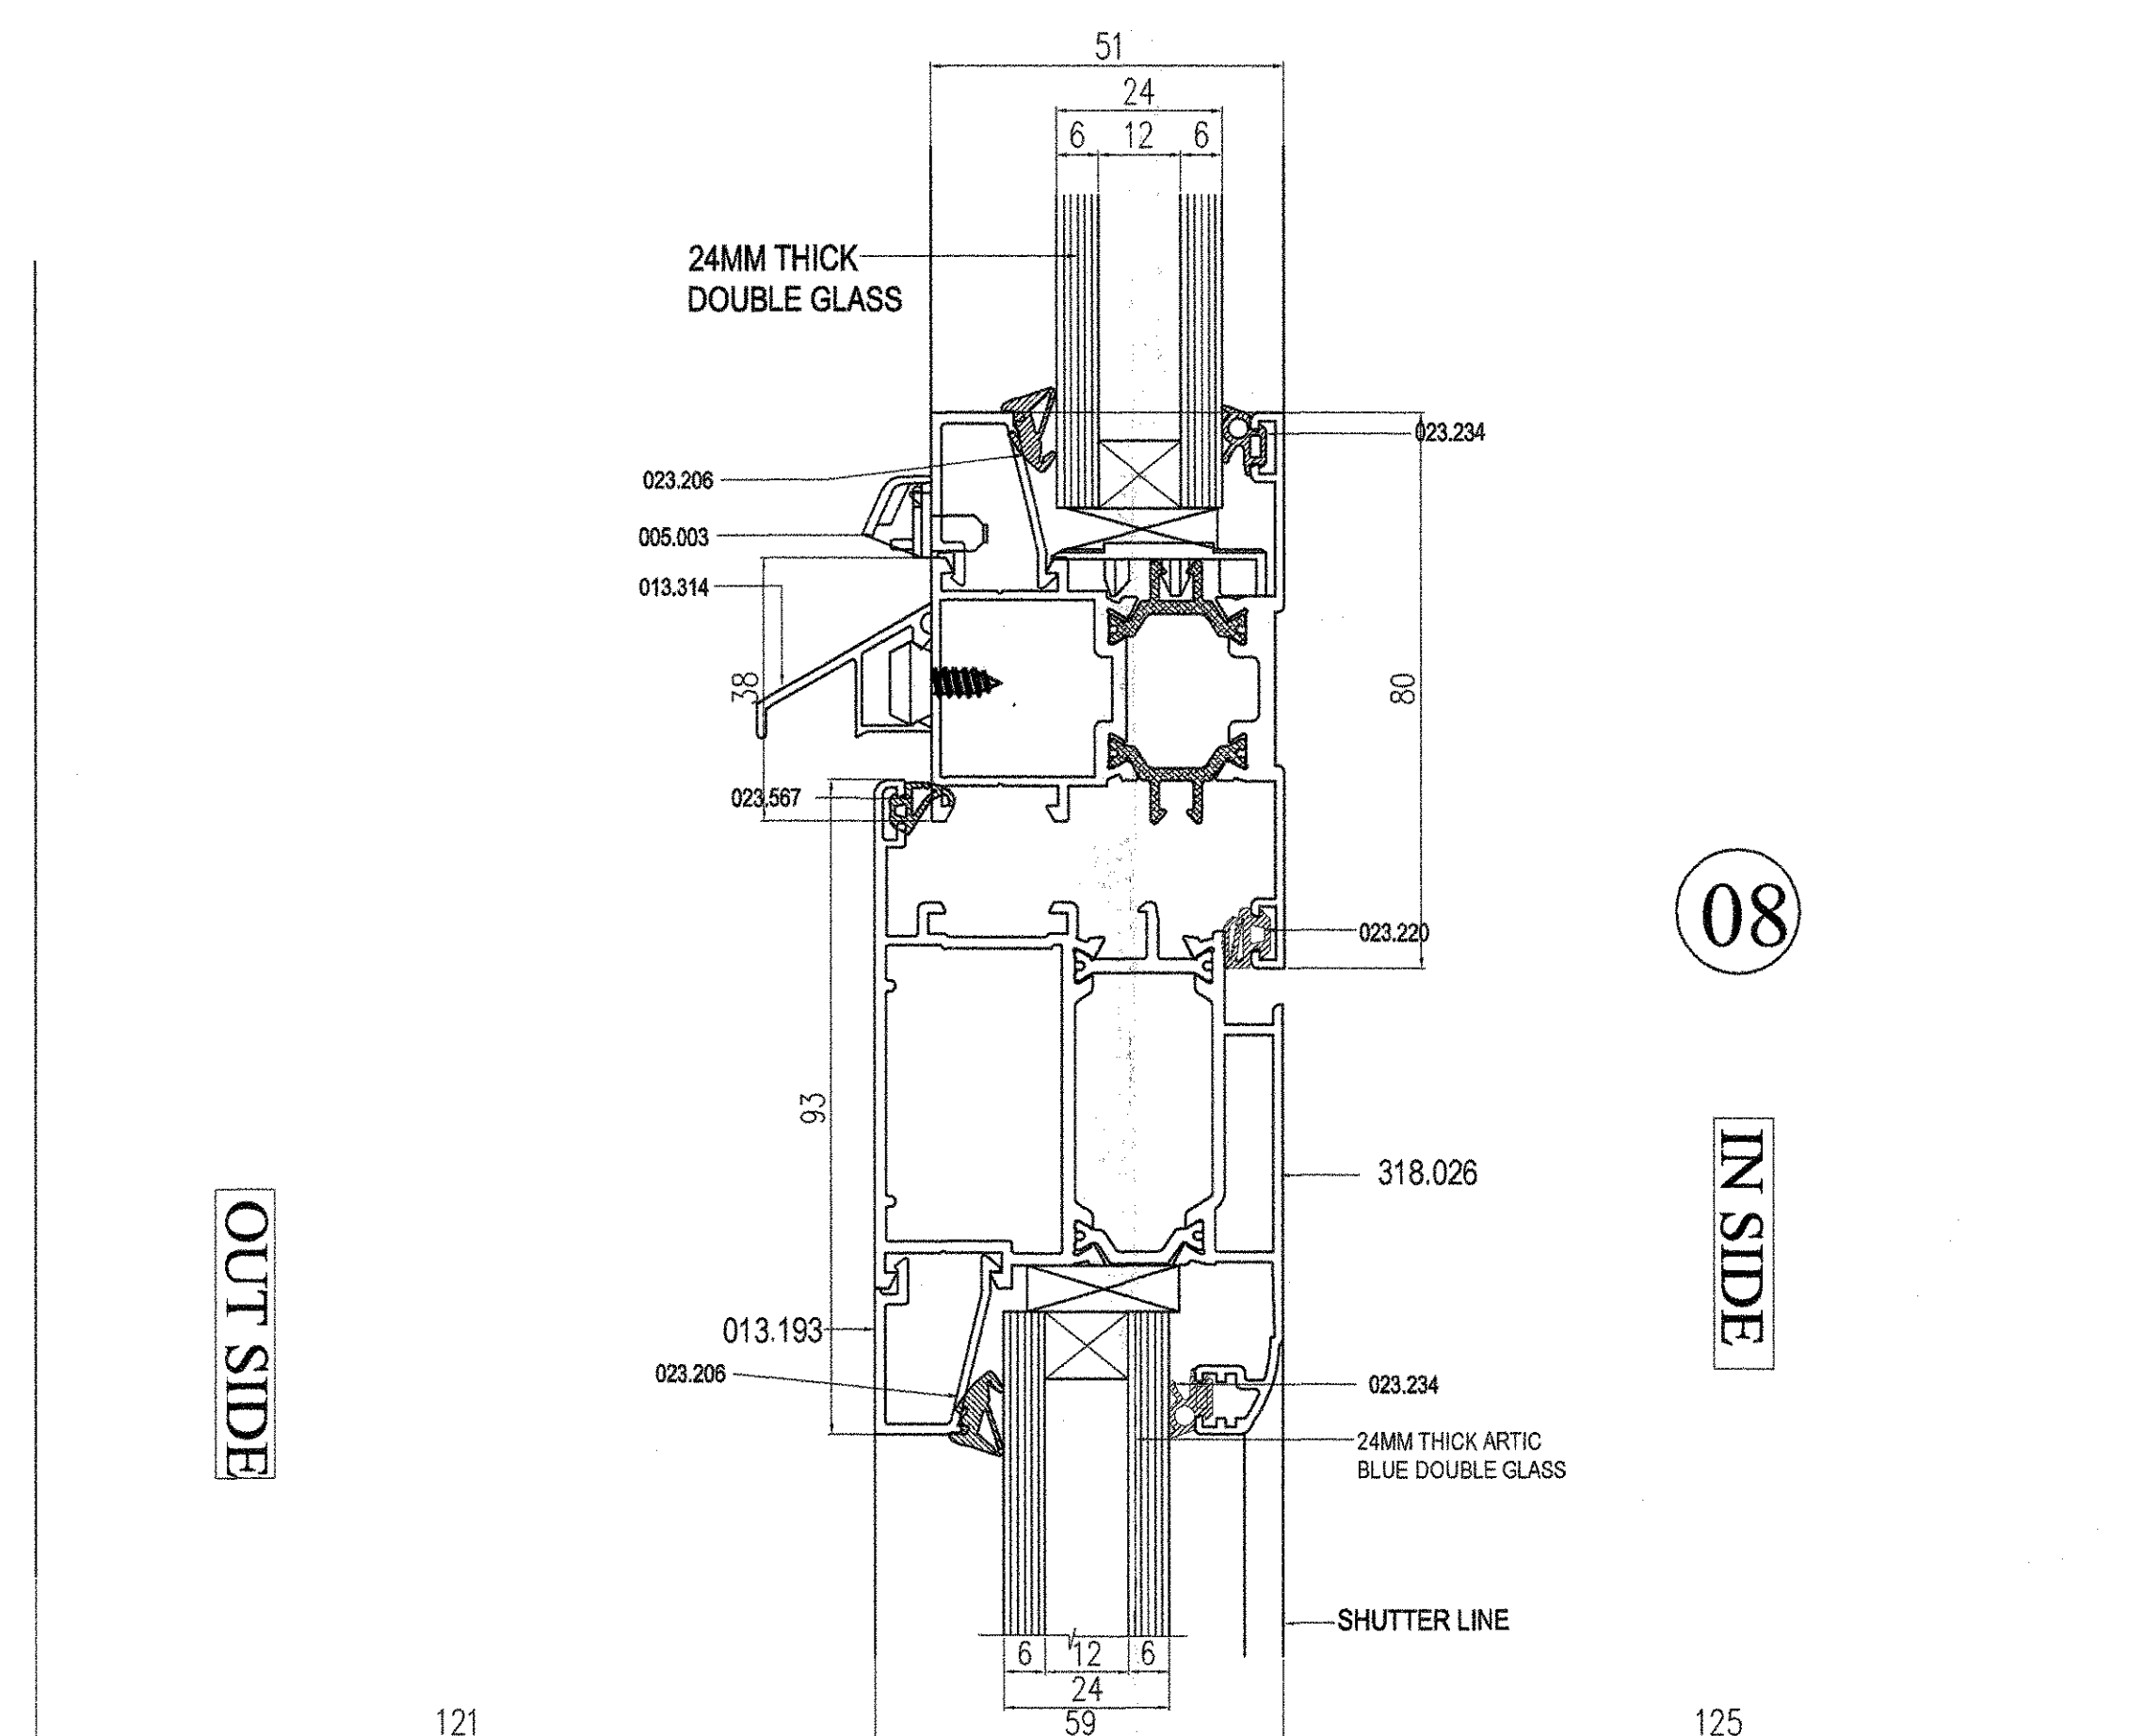

dar al-handasah
Sheir and Partners

☒ CODE 1 APPROVED
☐ CODE 2 APPROVED AS NOTED
 WORK MAY PROCEED SUBJECT TO
 INCORPORATION OF ENDORSED
 COMMENTS
☐ CODE 3 RESUBMIT FOR APPROVAL
 WORK MAY NOT PROCEED
☐ CODE 4 REJECTED

BY: _____ DATE: _____

Approval shall not release the contractor of any of his
 obligations under the Contract for completion or authorization of
 any change to Contract Documents or variation to the works.
 Contractor is responsible for dimensions, quantities and
 coordination with other trades.

6/7/2012








AS BUILT DRAWING

Project	JUMEIRAH PARK
Employer	NAKHEEL
Consultant	dar al-handasah sheir and partners
Main Contractor	Pauling Middle East
Sub Contractor	WHITE ALUMINIUM ENT.

PACKAGE - 2 Cluster - 1
 PACKAGE - 2A
 Clusters - 1, 3 (Villas 51 to 62), 4, 5, 7 (Villas 33 to 41),
 8, 9, 10, 11, 12, 13, 14, 15 (Villas 1 to 14) & 16

Drawing Title	ALUMINIUM & GLASS DETAILS
Drawn	IBRAHIM
Review	Eng. Ziad
Checked	GUGAN
Scale:	1:1
Date:	13-06-2012
Drawing No.	PME / JP / AB / LE / ALU / 008A

AB 135 g.1

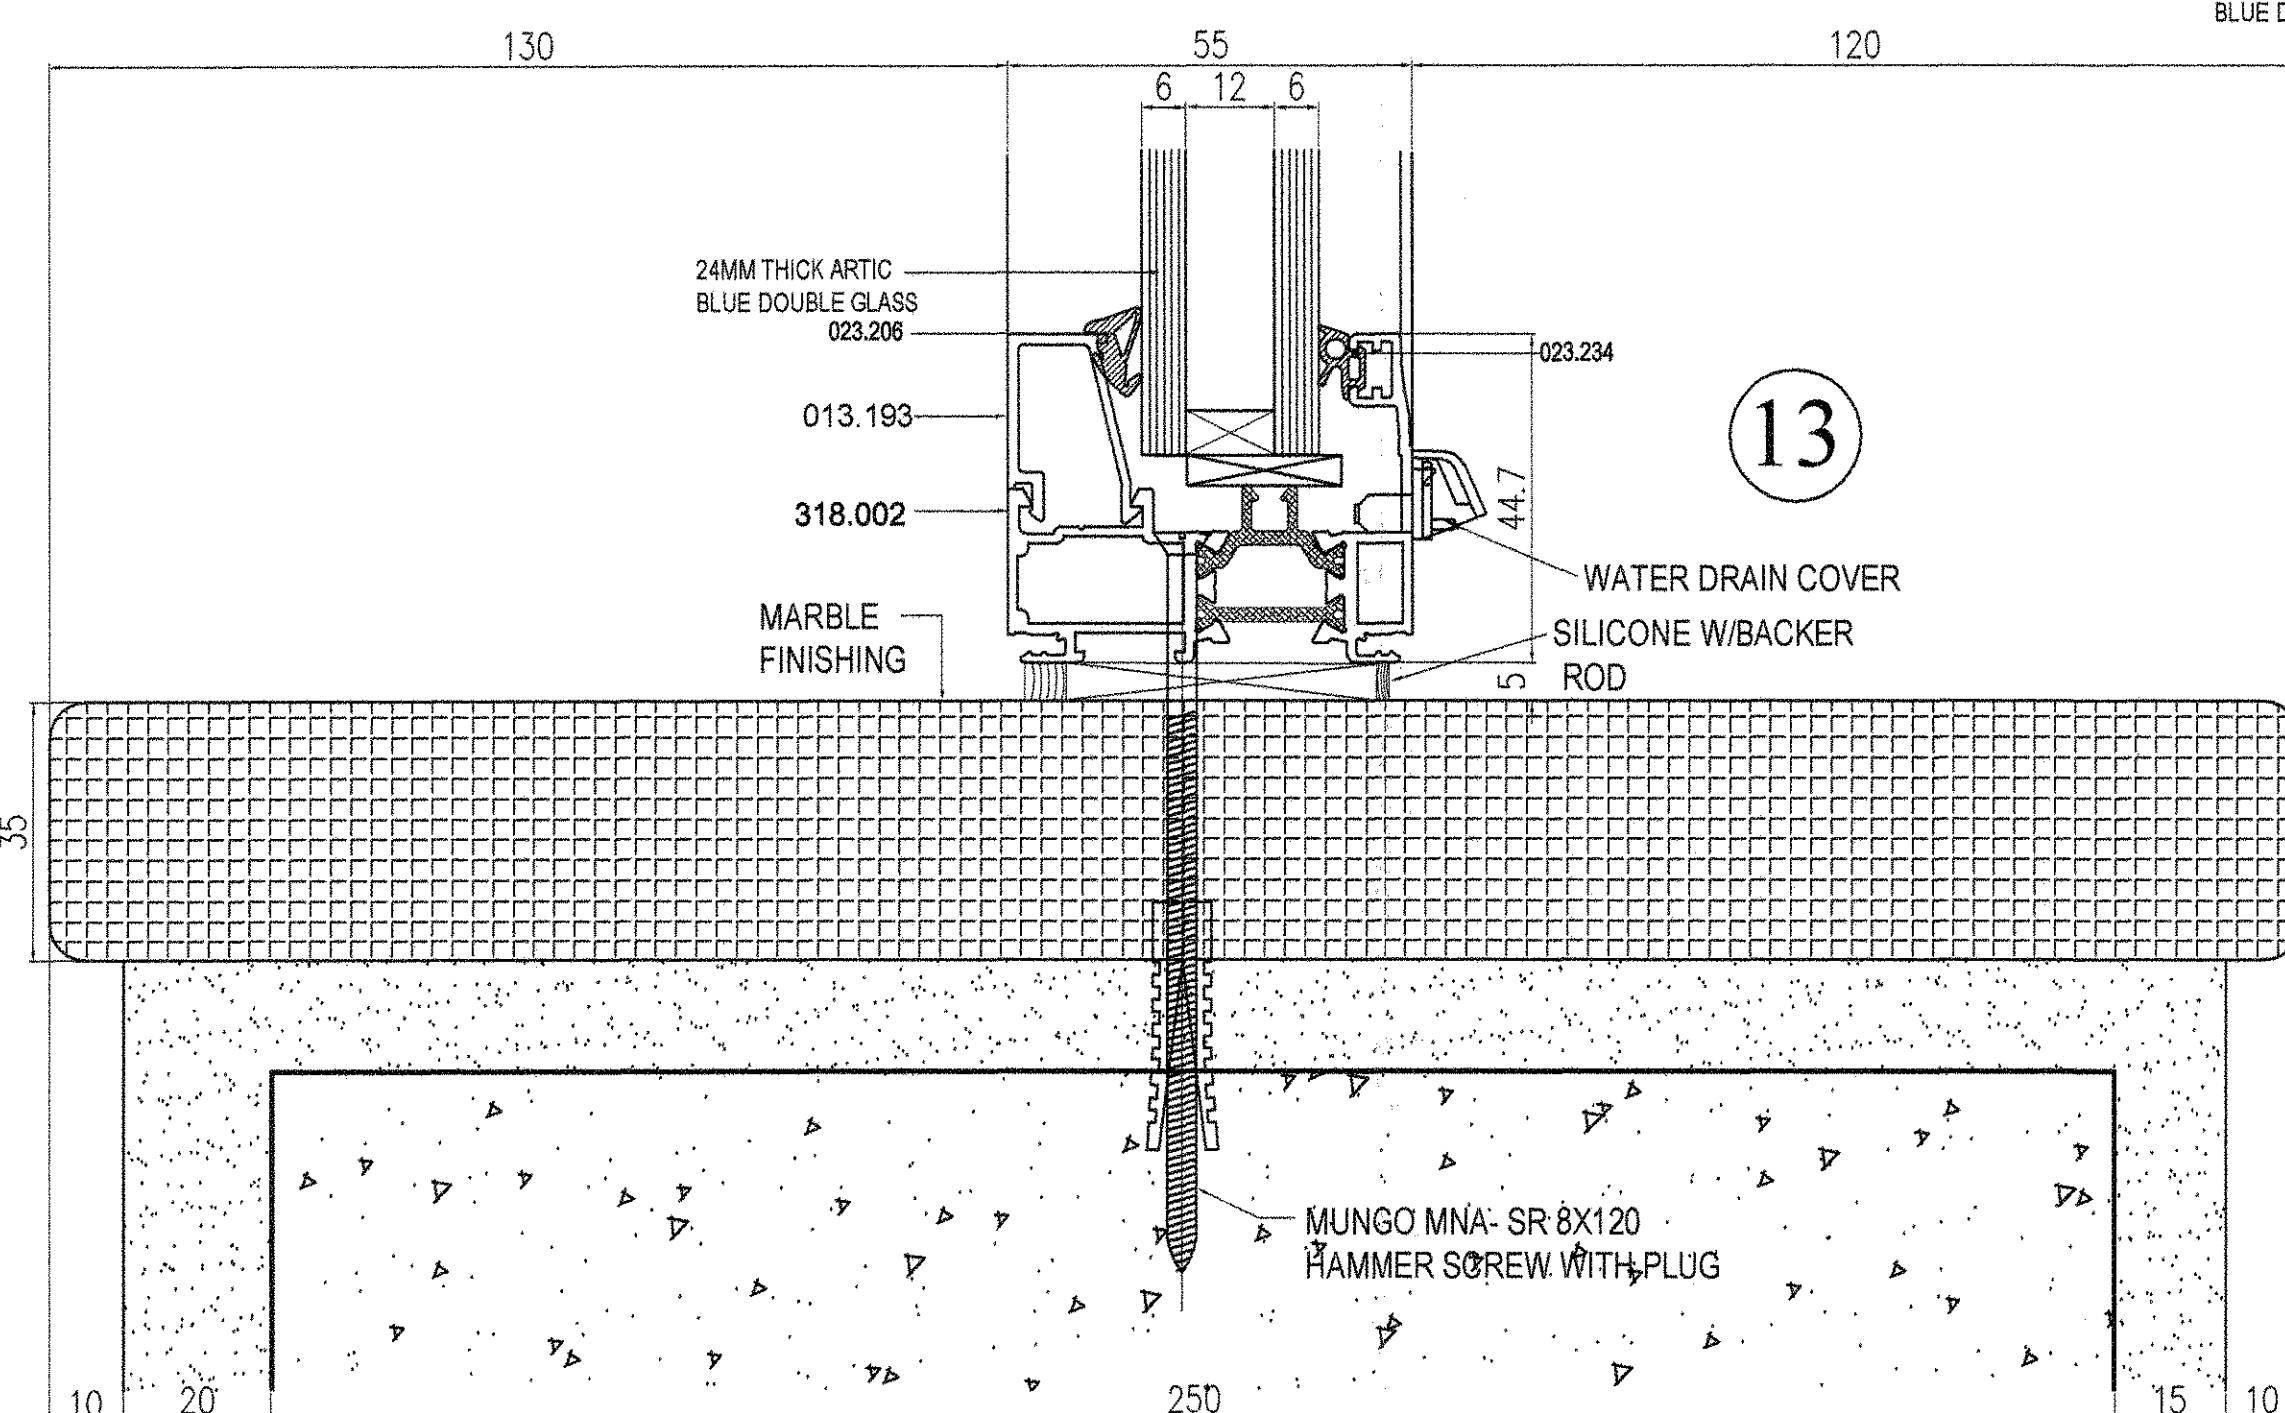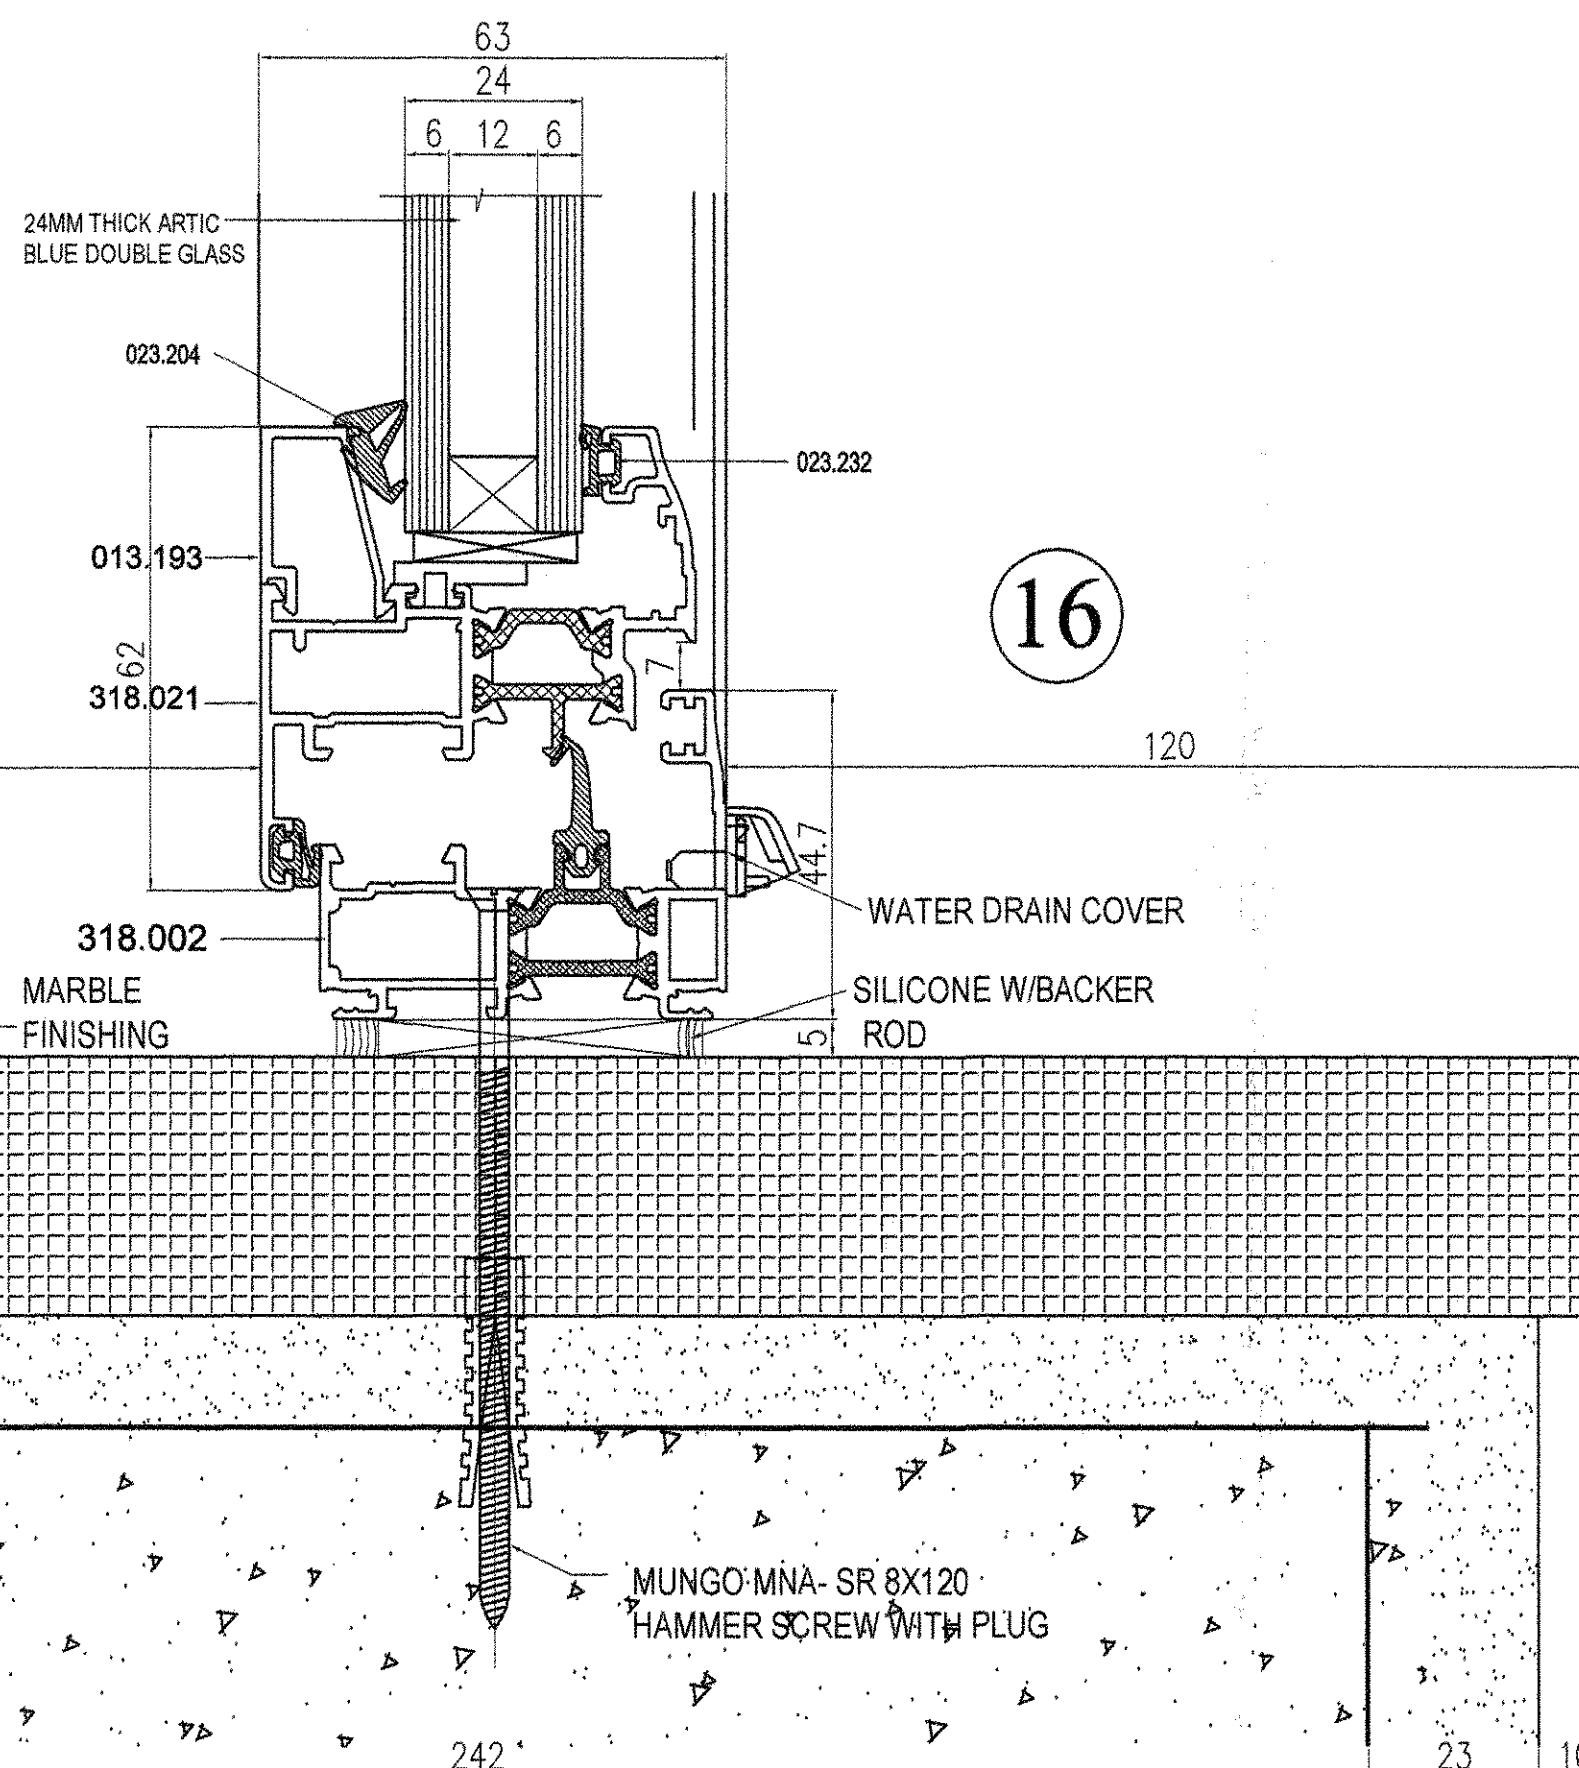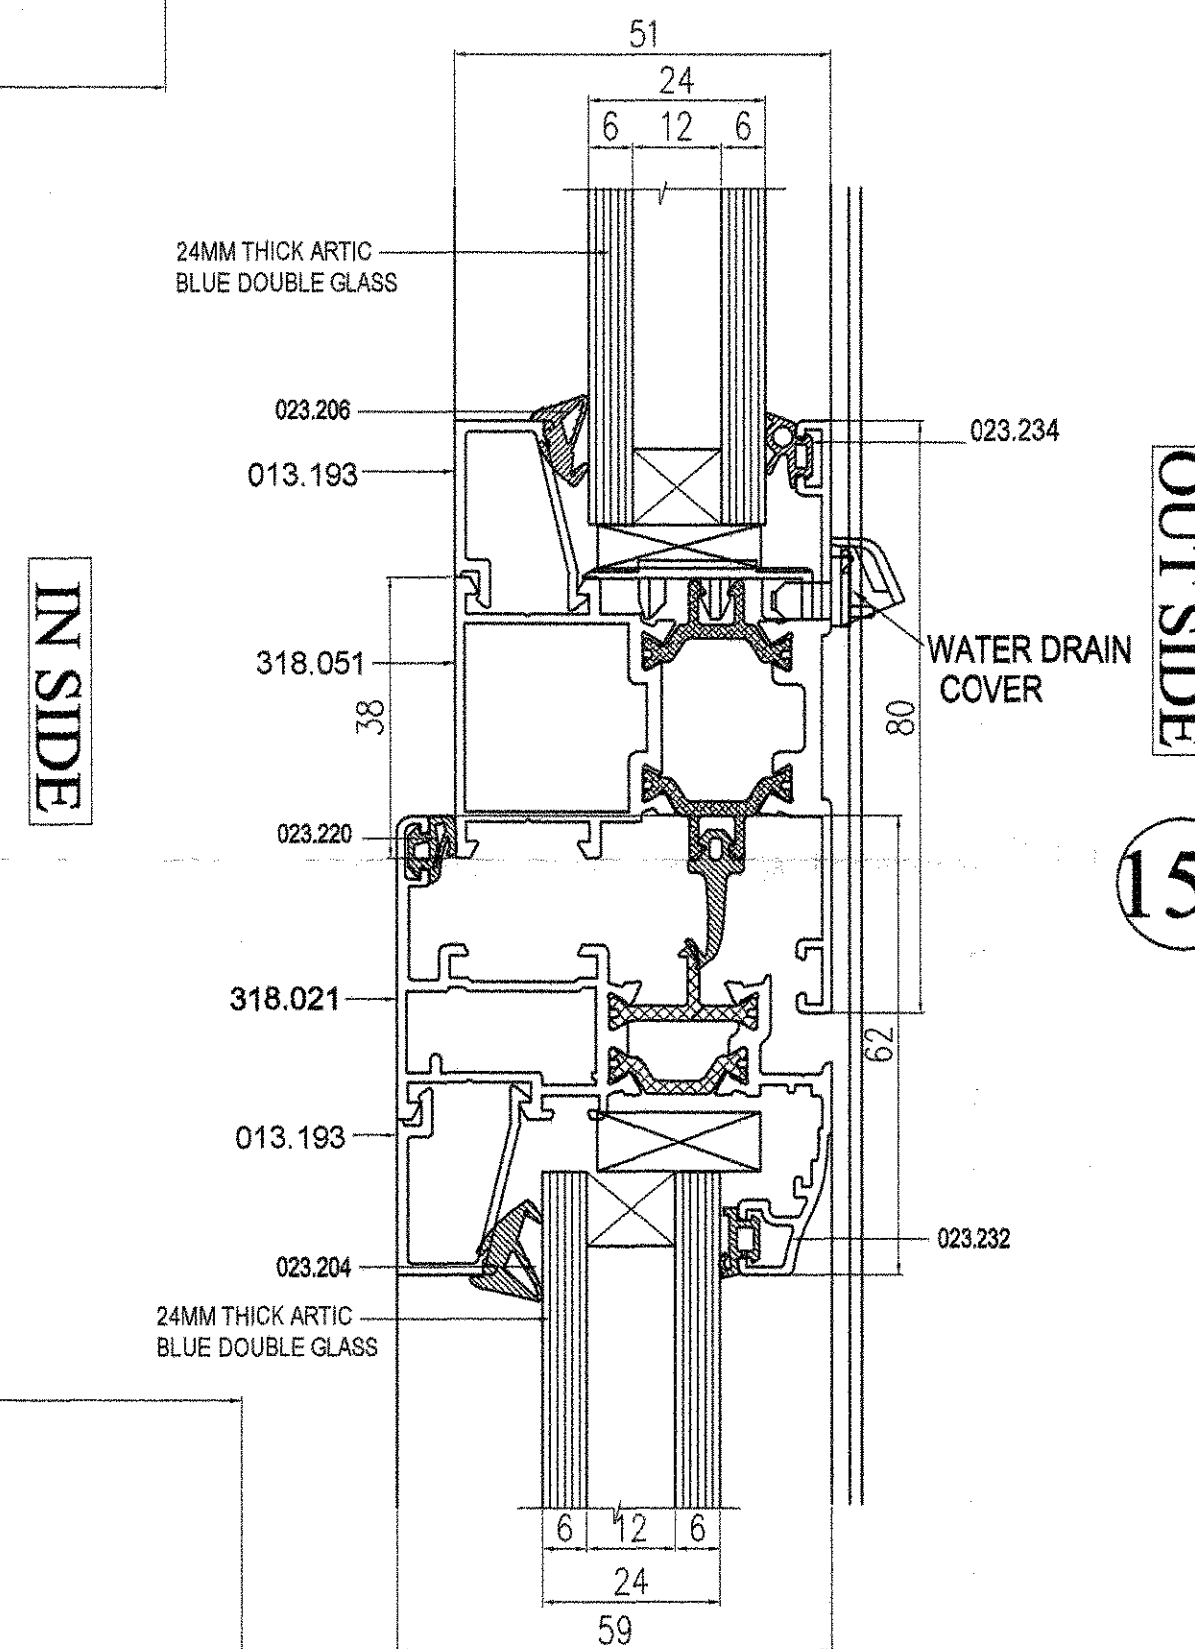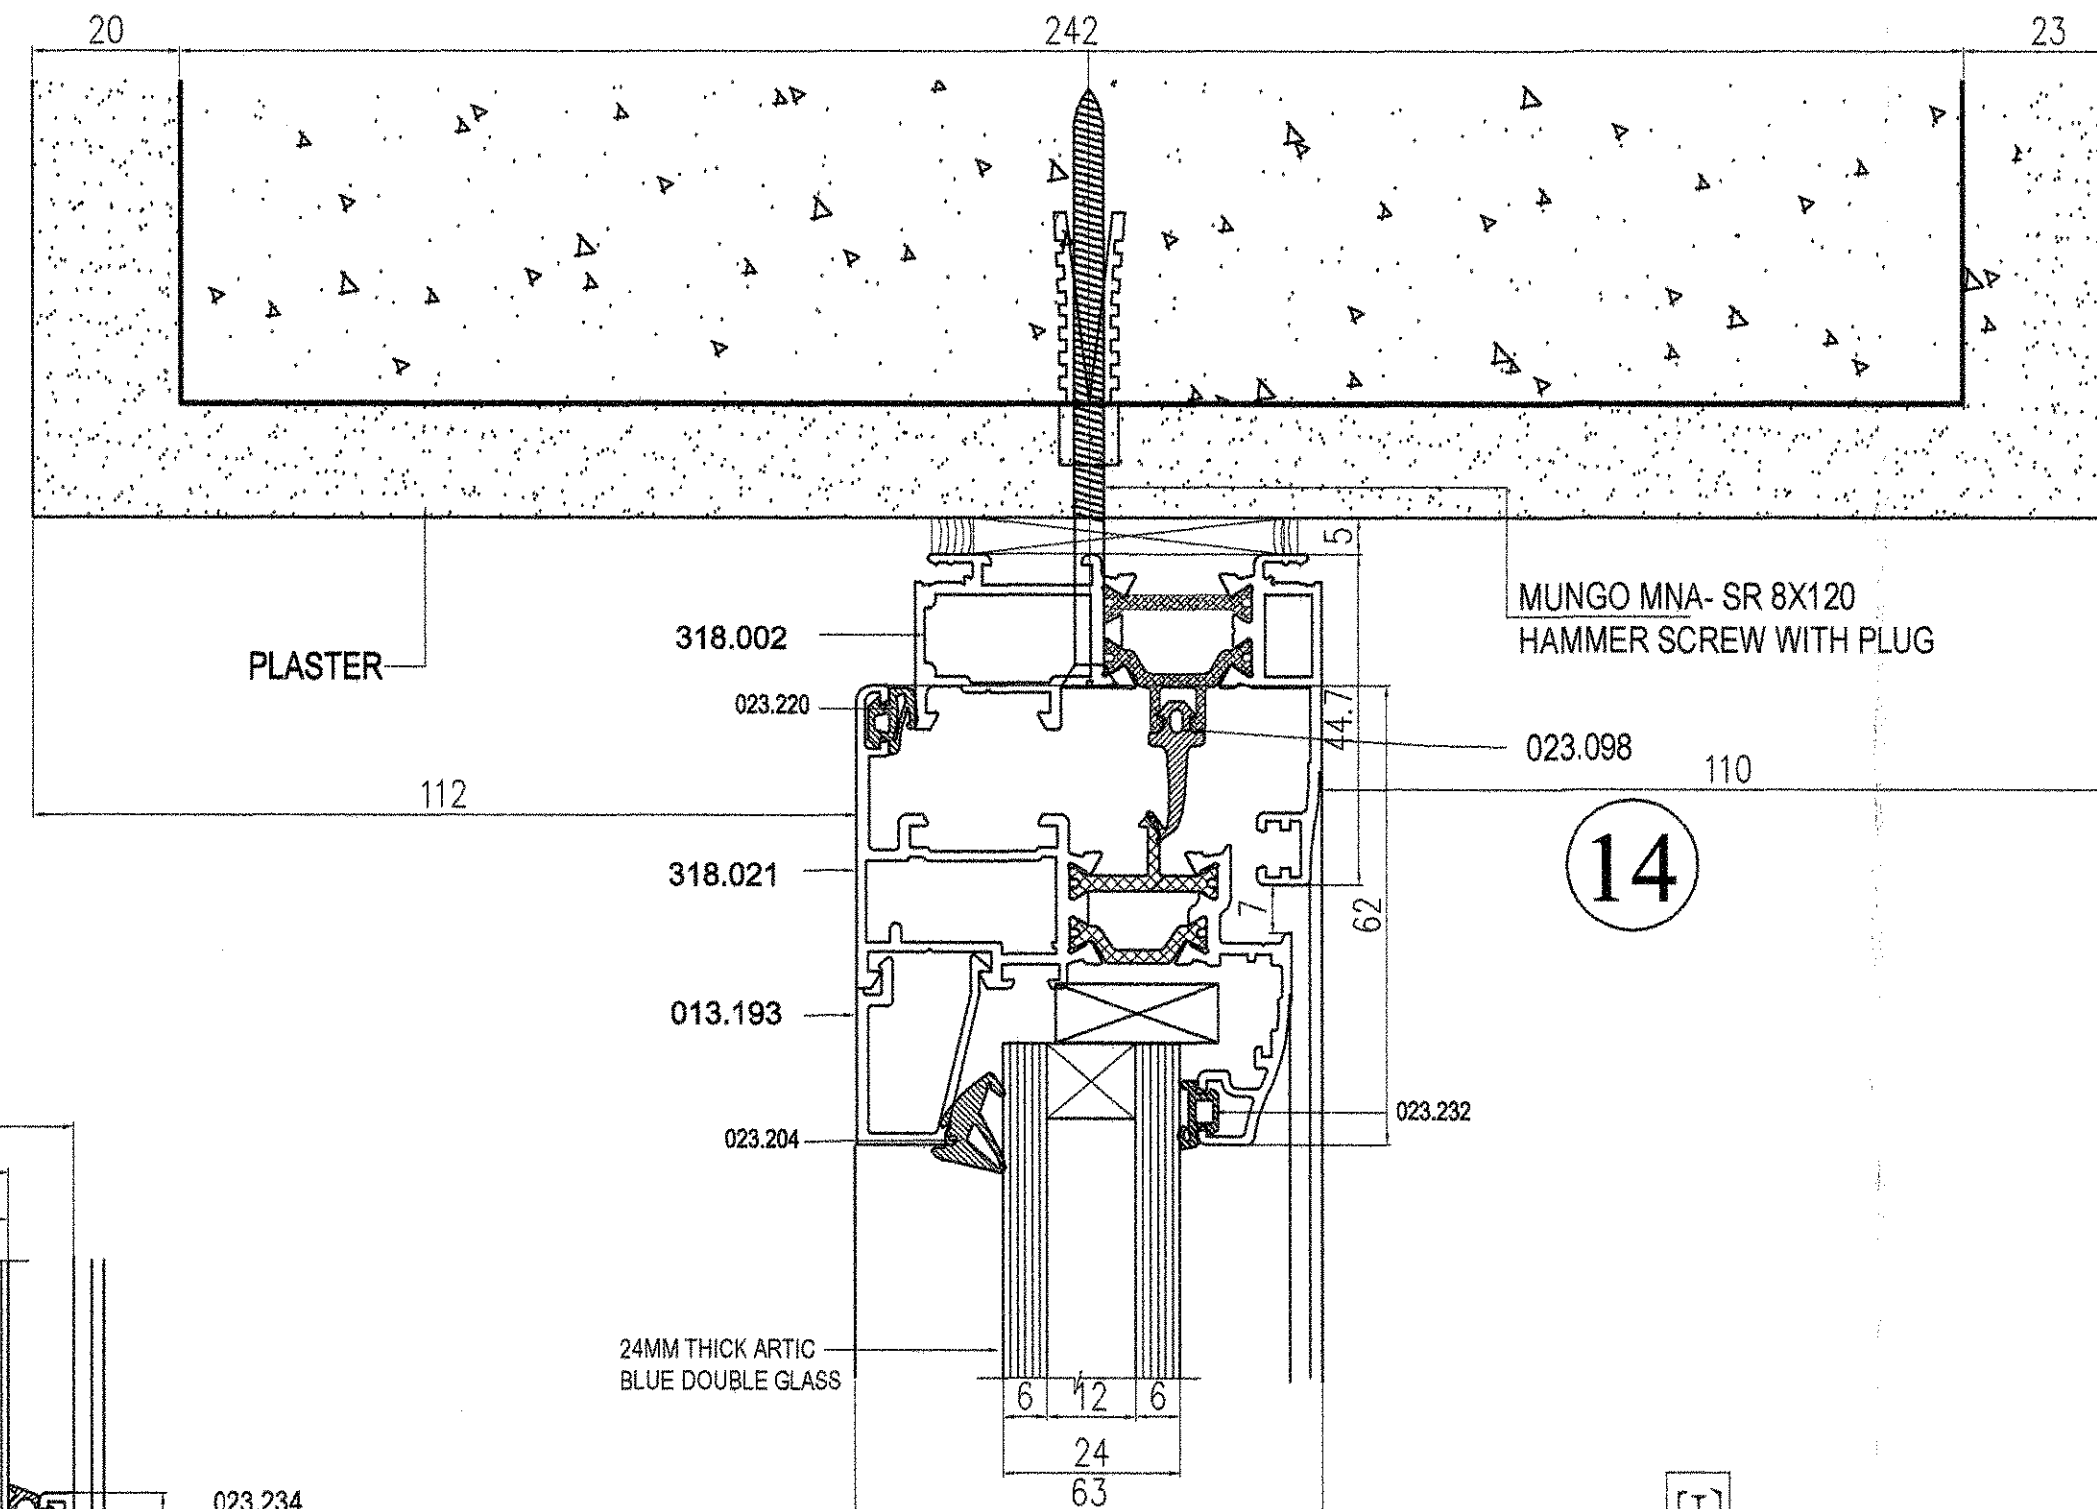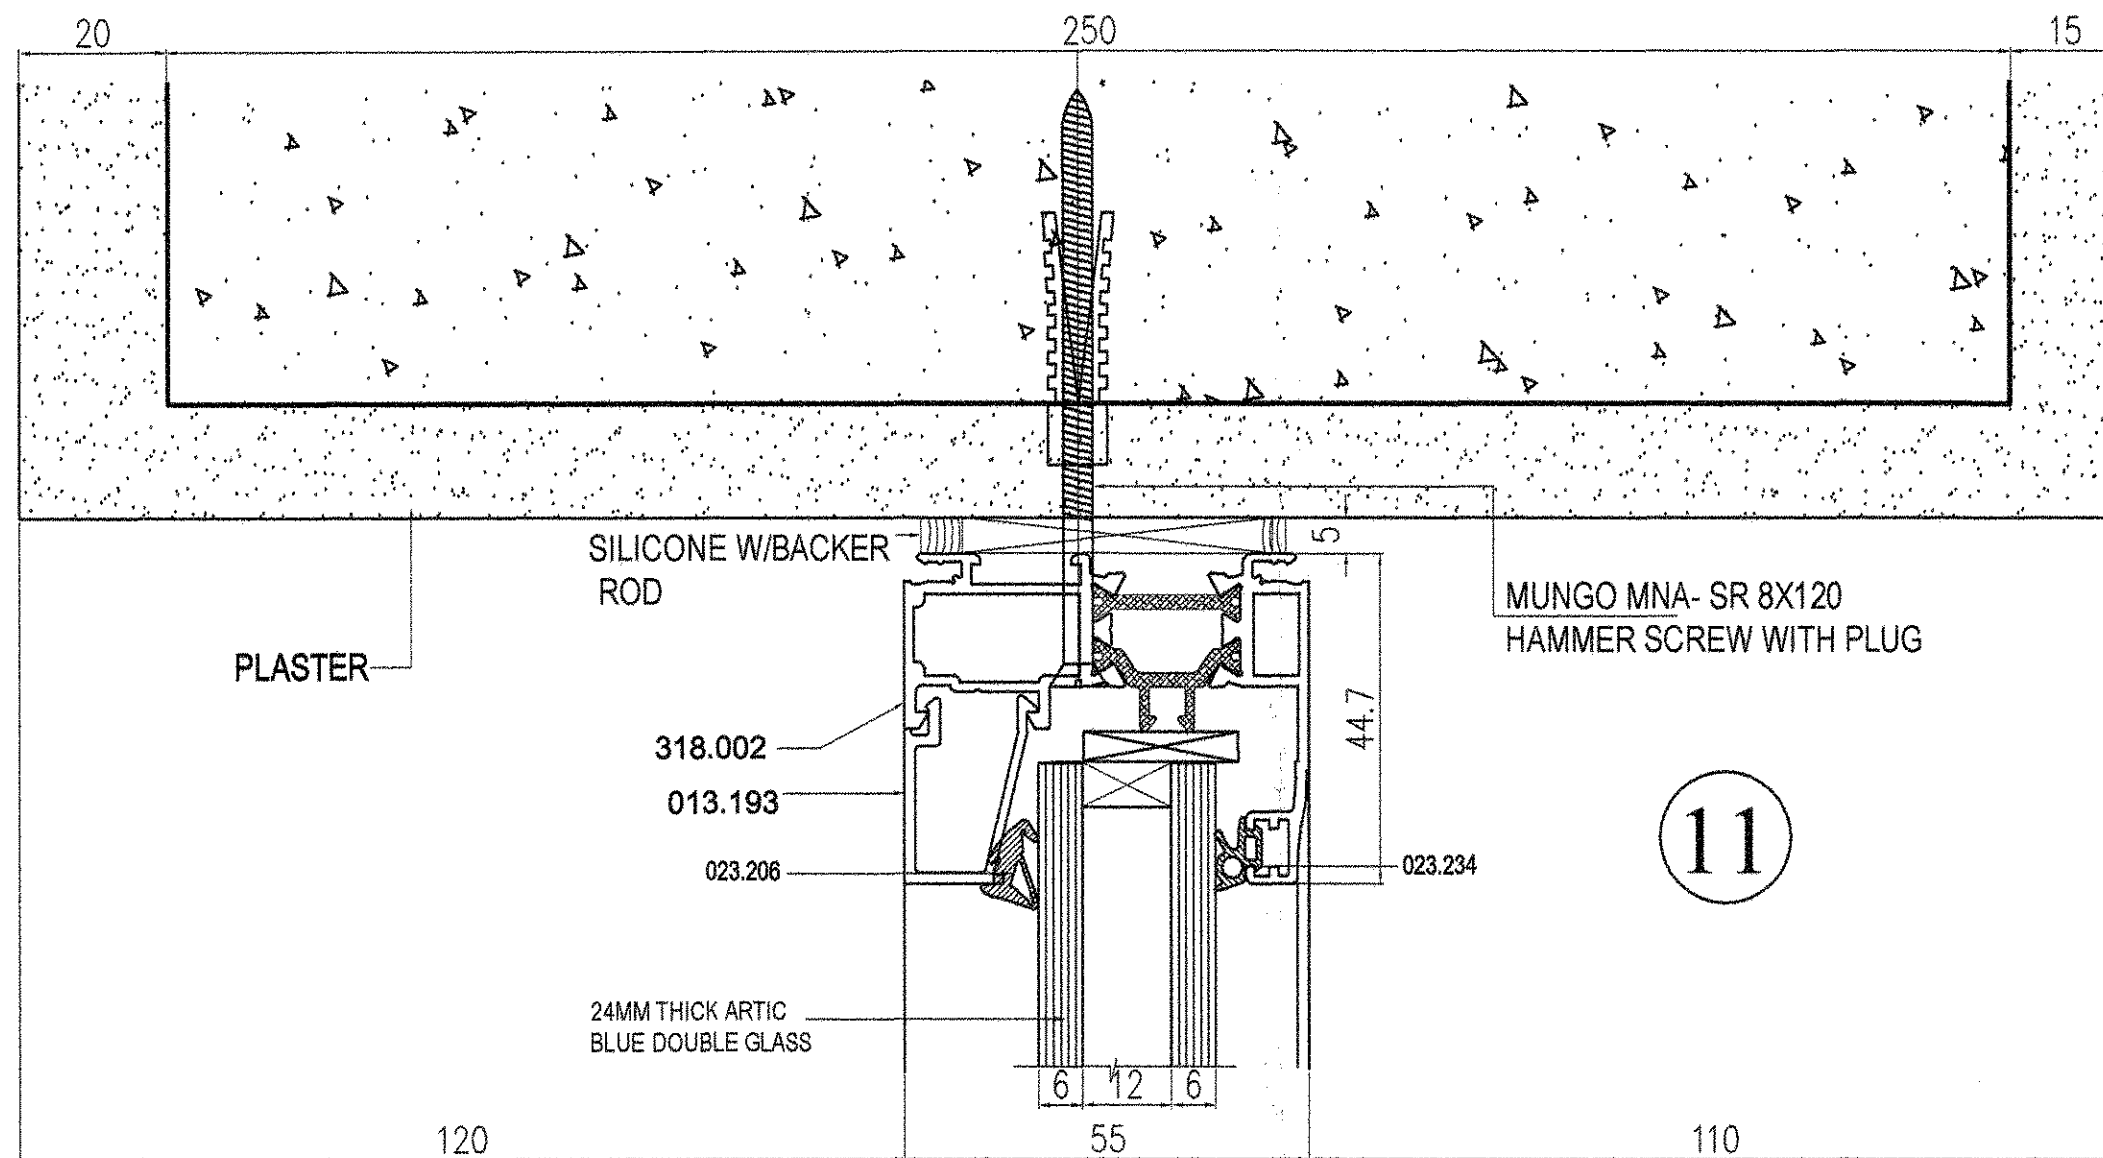


dar al-handasah
Shah and Partners

☒ CODE 1 APPROVED
☐ CODE 2 APPROVED AS NOTED
 WORK MAY PROCEED SUBJECT TO
 INCORPORATION OF ENDORSED
 COMMENTS
☐ CODE 3 RESUBMIT FOR APPROVAL
 WORK MAY NOT PROCEED
☐ CODE 4 REJECTED

BY: _____ DATE: _____

Approval shall not relieve the contractor of any of his obligations under the Contract or constitute authorization of any change to Contract Documents or valuation to the works. Contractor is responsible for dimensions, quantities and coordination with other trades.

23/6/2012

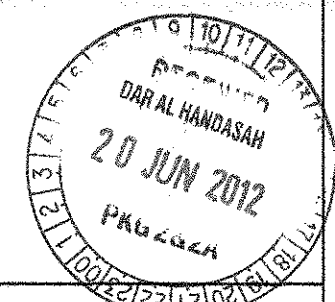

AS BUILT DRAWING

Project
JUMEIRAH PARK



Employer
NAKHEEL



Consultant
dar al-handasah shah and partners



Main Contractor
Pauling Middle East



Sub Contractor
WHITE ALUMINIUM ENT.

Package
PACKAGE - 2

Cluster - 1

PACKAGE - 2A


Clusters - 1, 3 (Villas 51 to 62), 4, 5, 7 (Villas 33 to 41), 8, 9, 10, 11, 12, 13, 14, 15 (Villas 1 to 14) & 16

Drawing Title
ALUMINIUM & GLASS DETAILS


Drawn: IBRAHIM Review: Eng. Ziad Checked: GUGAN

Scale: 1:1 Date: 13-06-2012


Drawing No. **PME / JP / AB / LE / ALU / 009A**

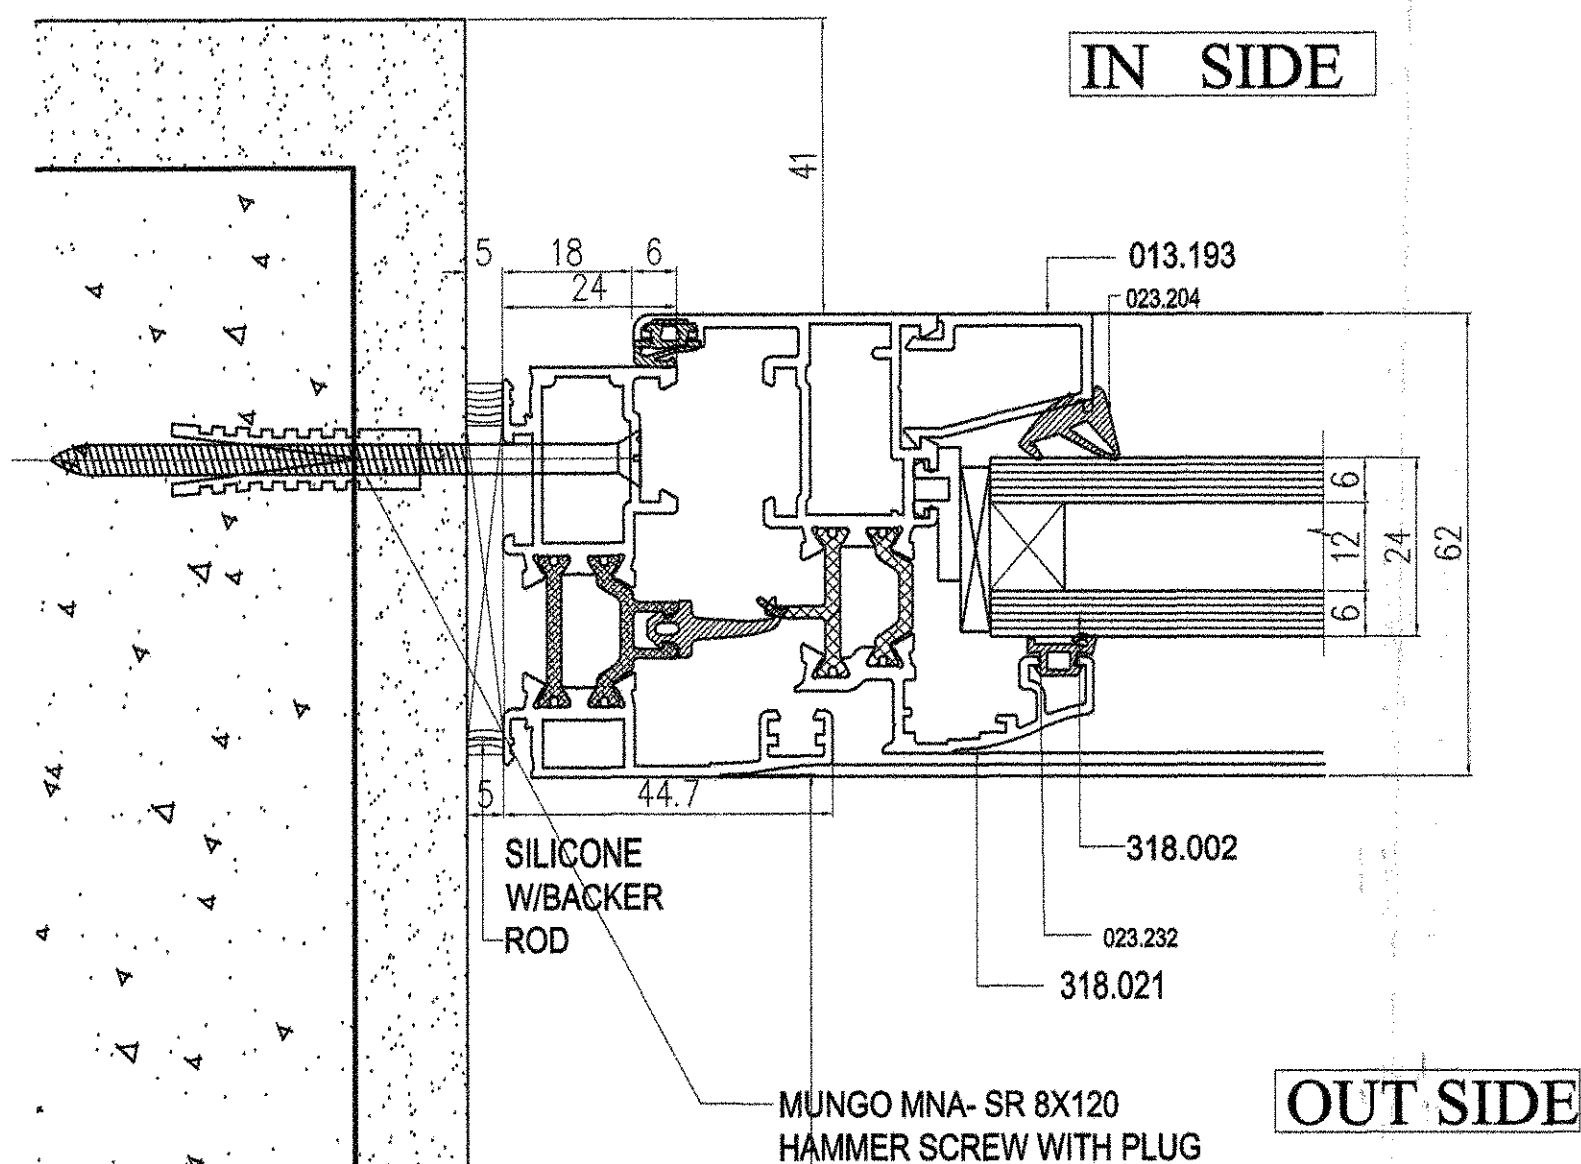


23A

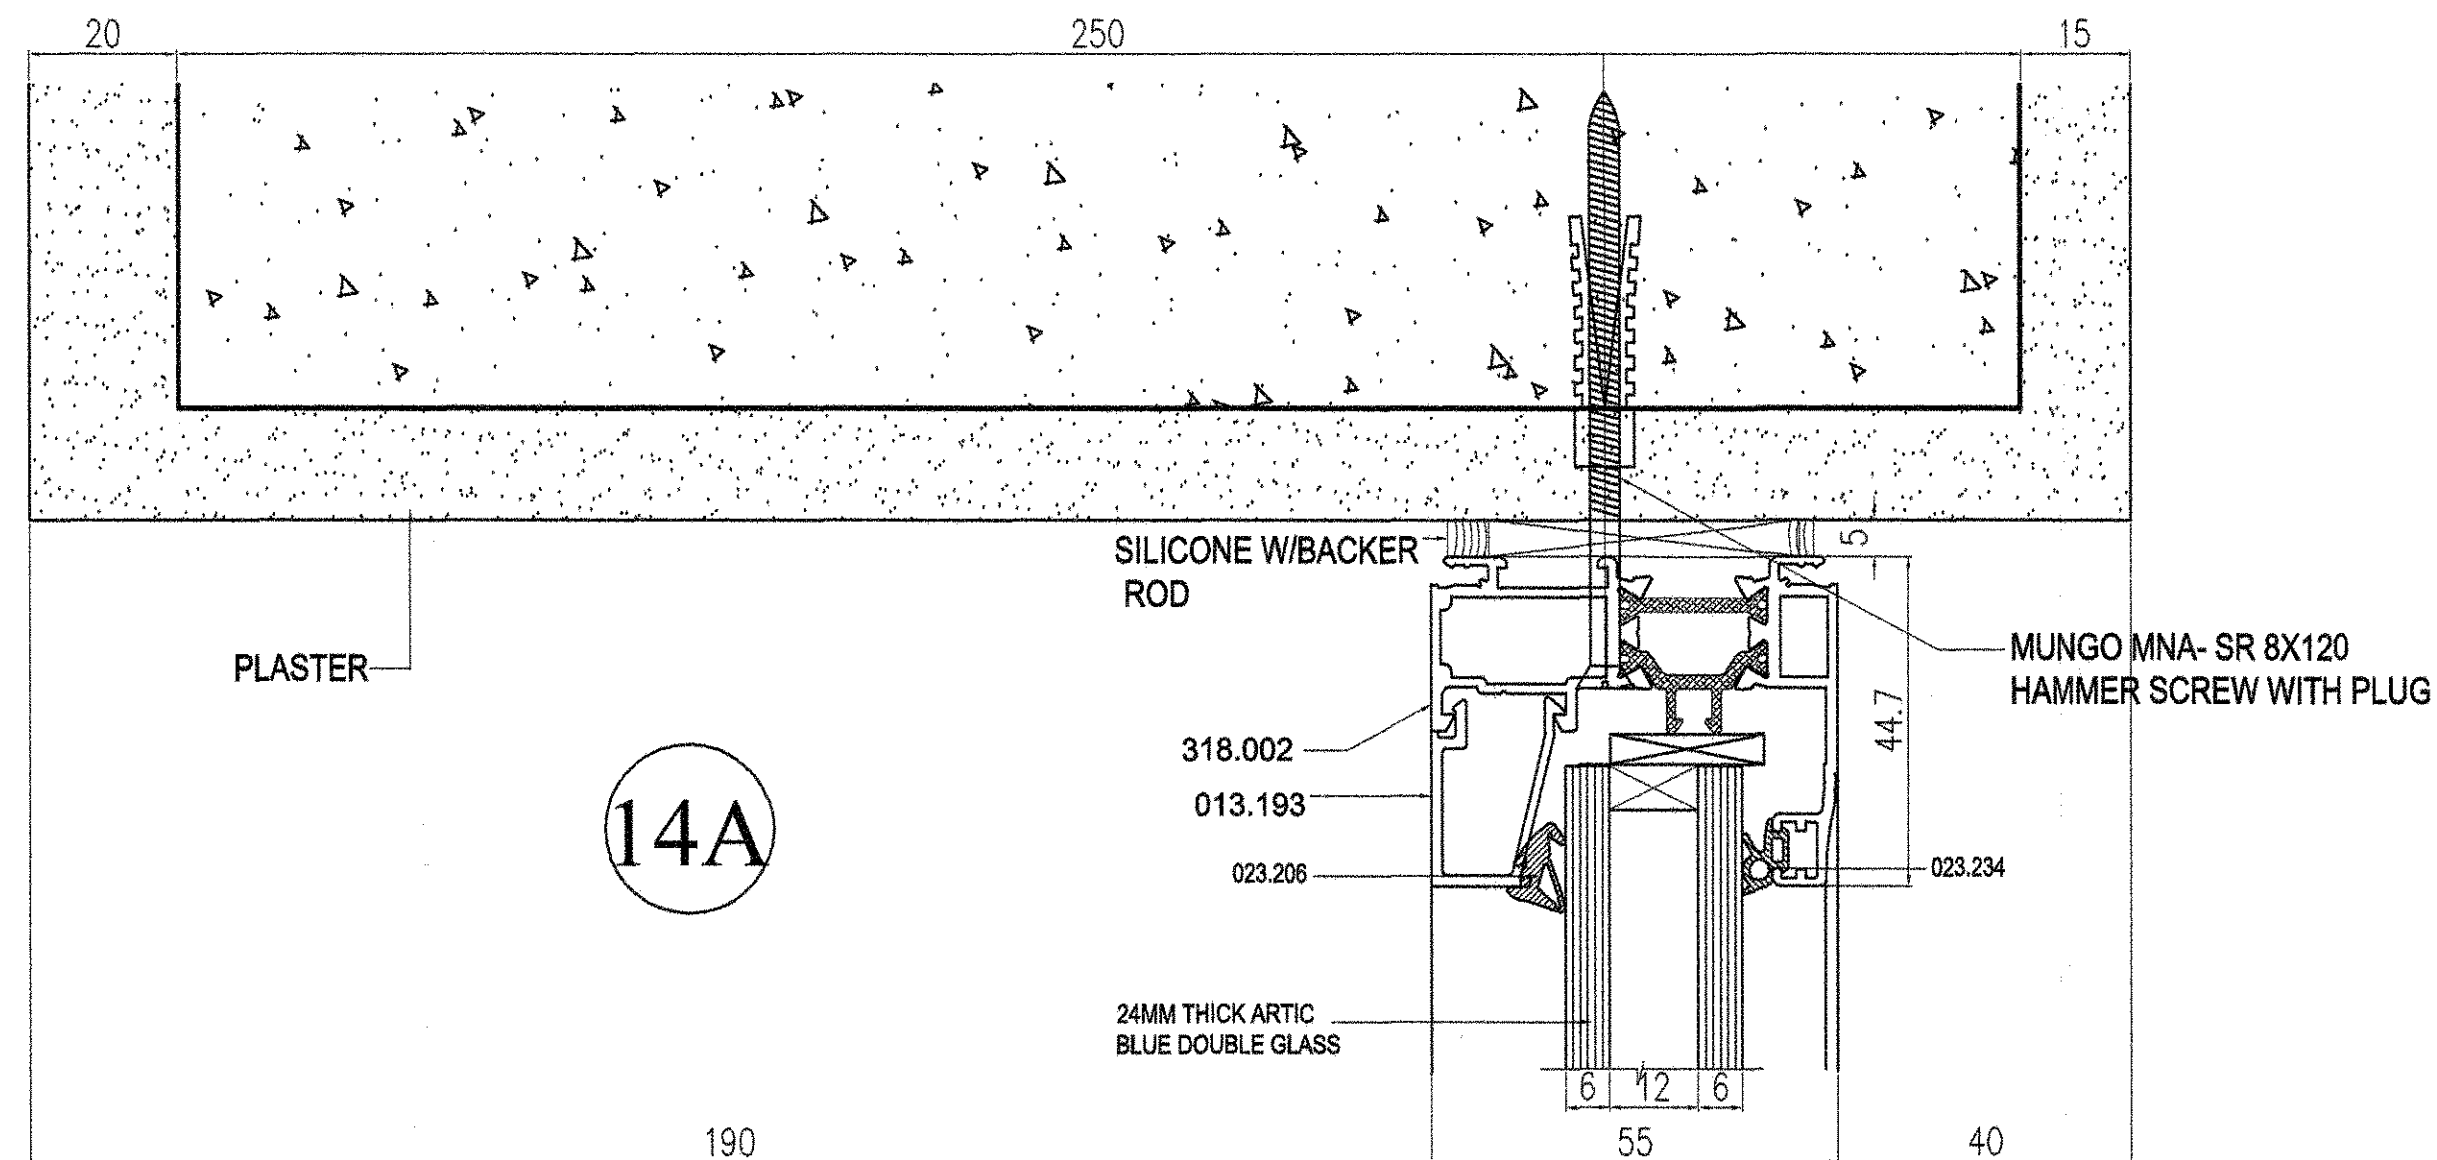

14A

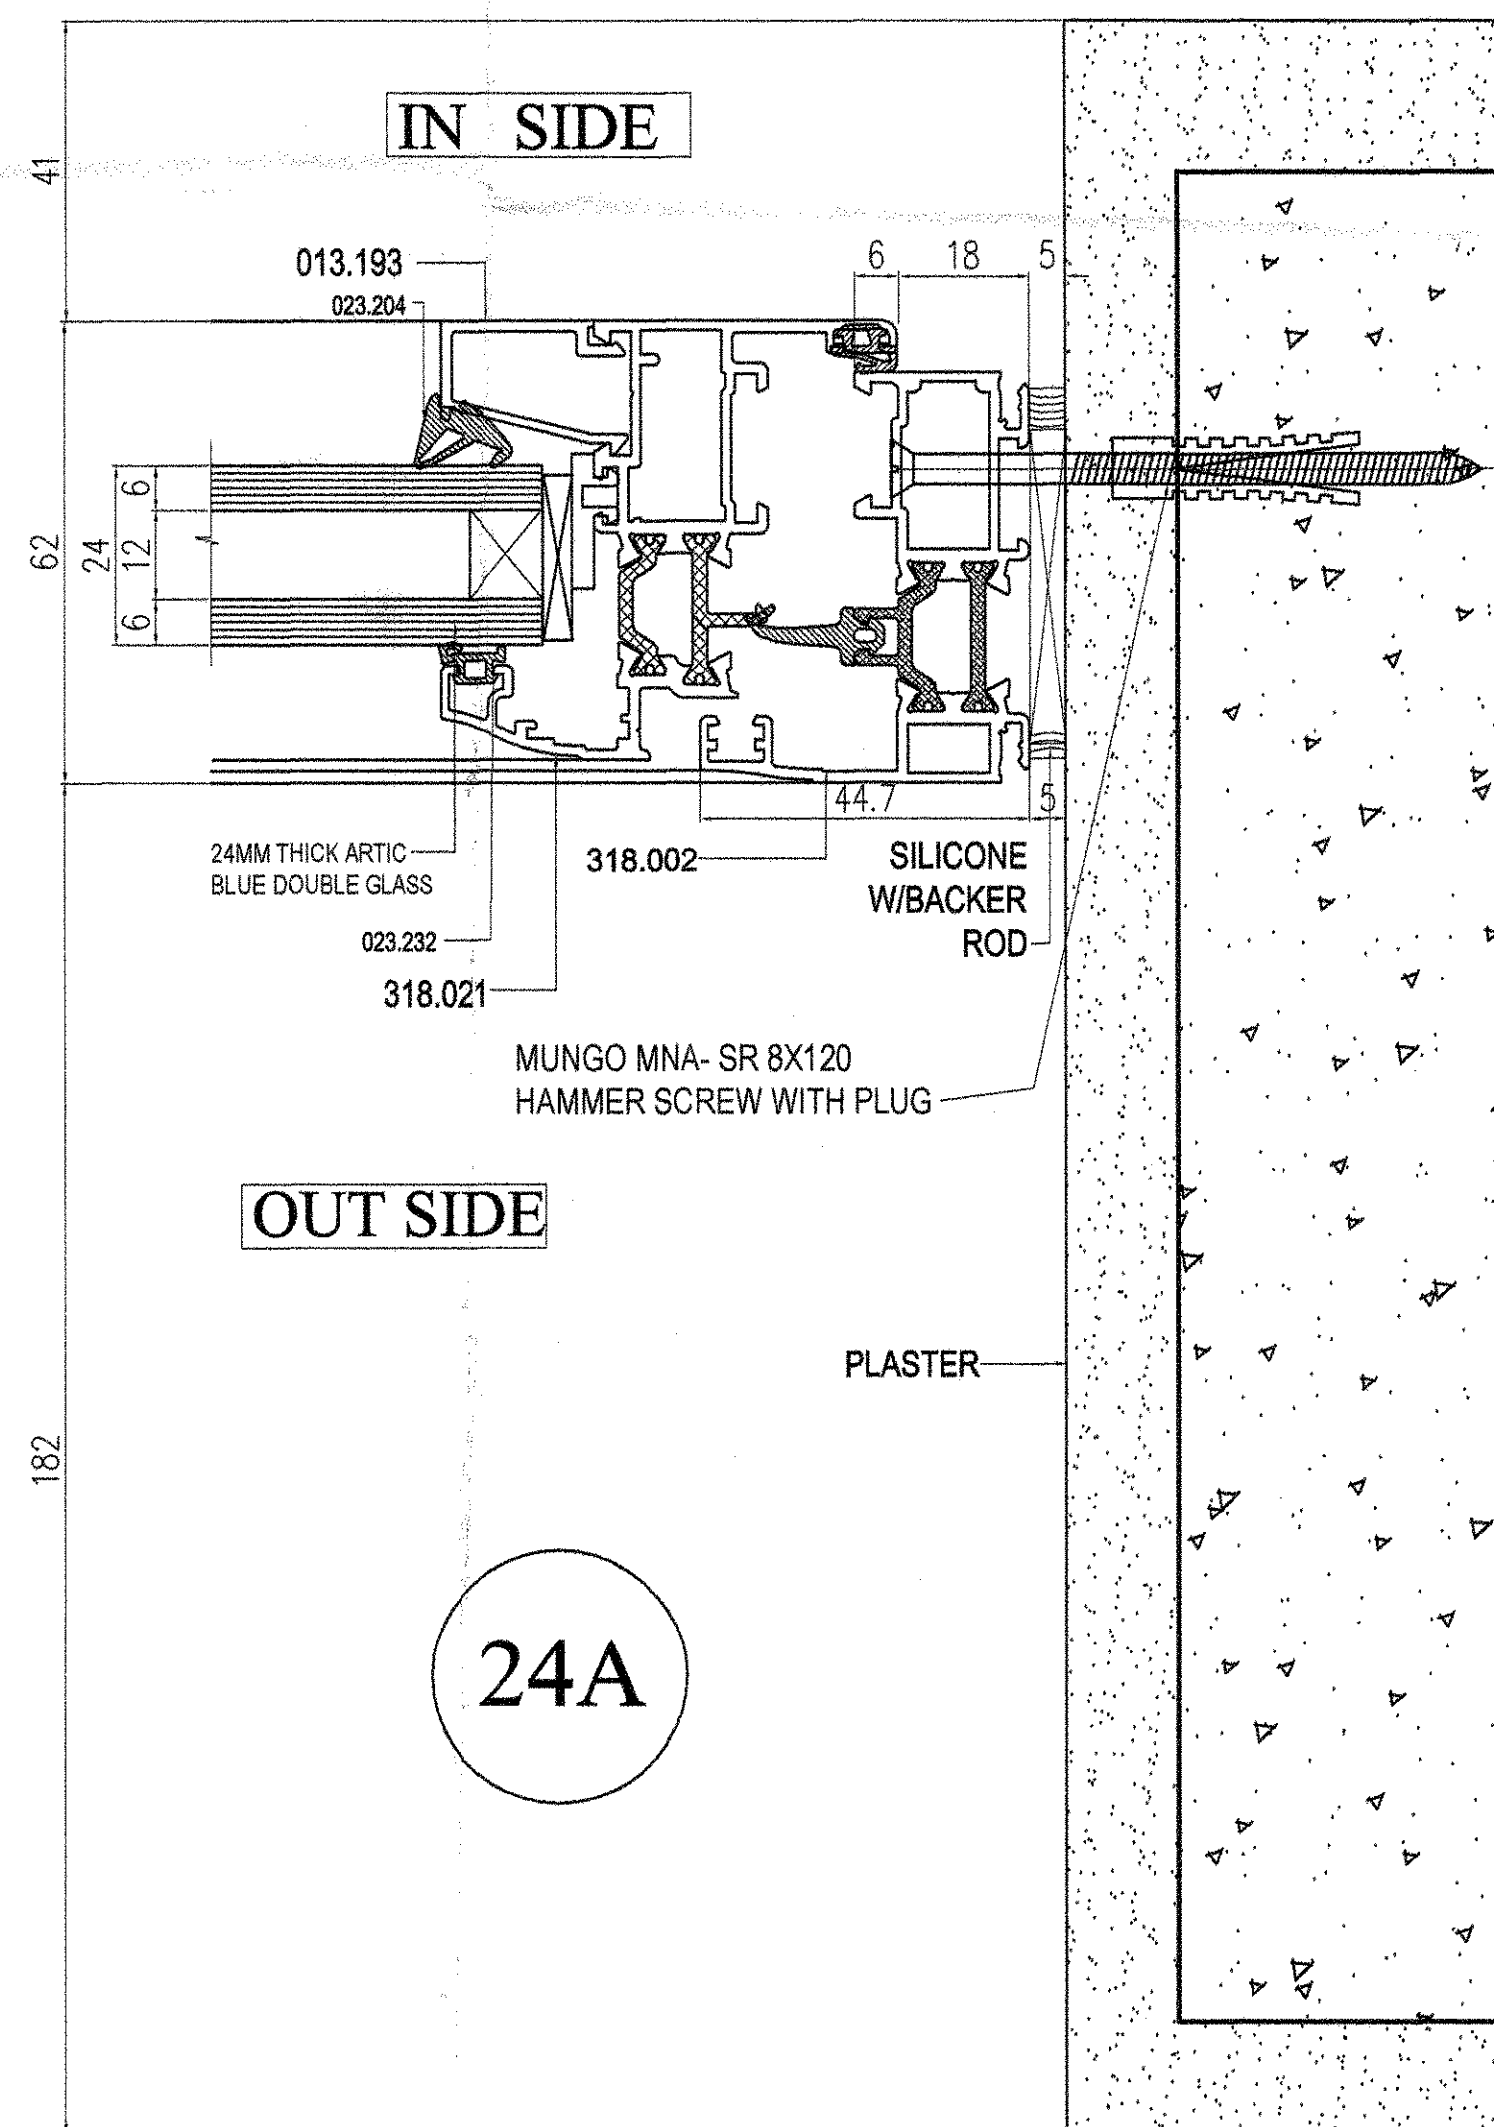

24A

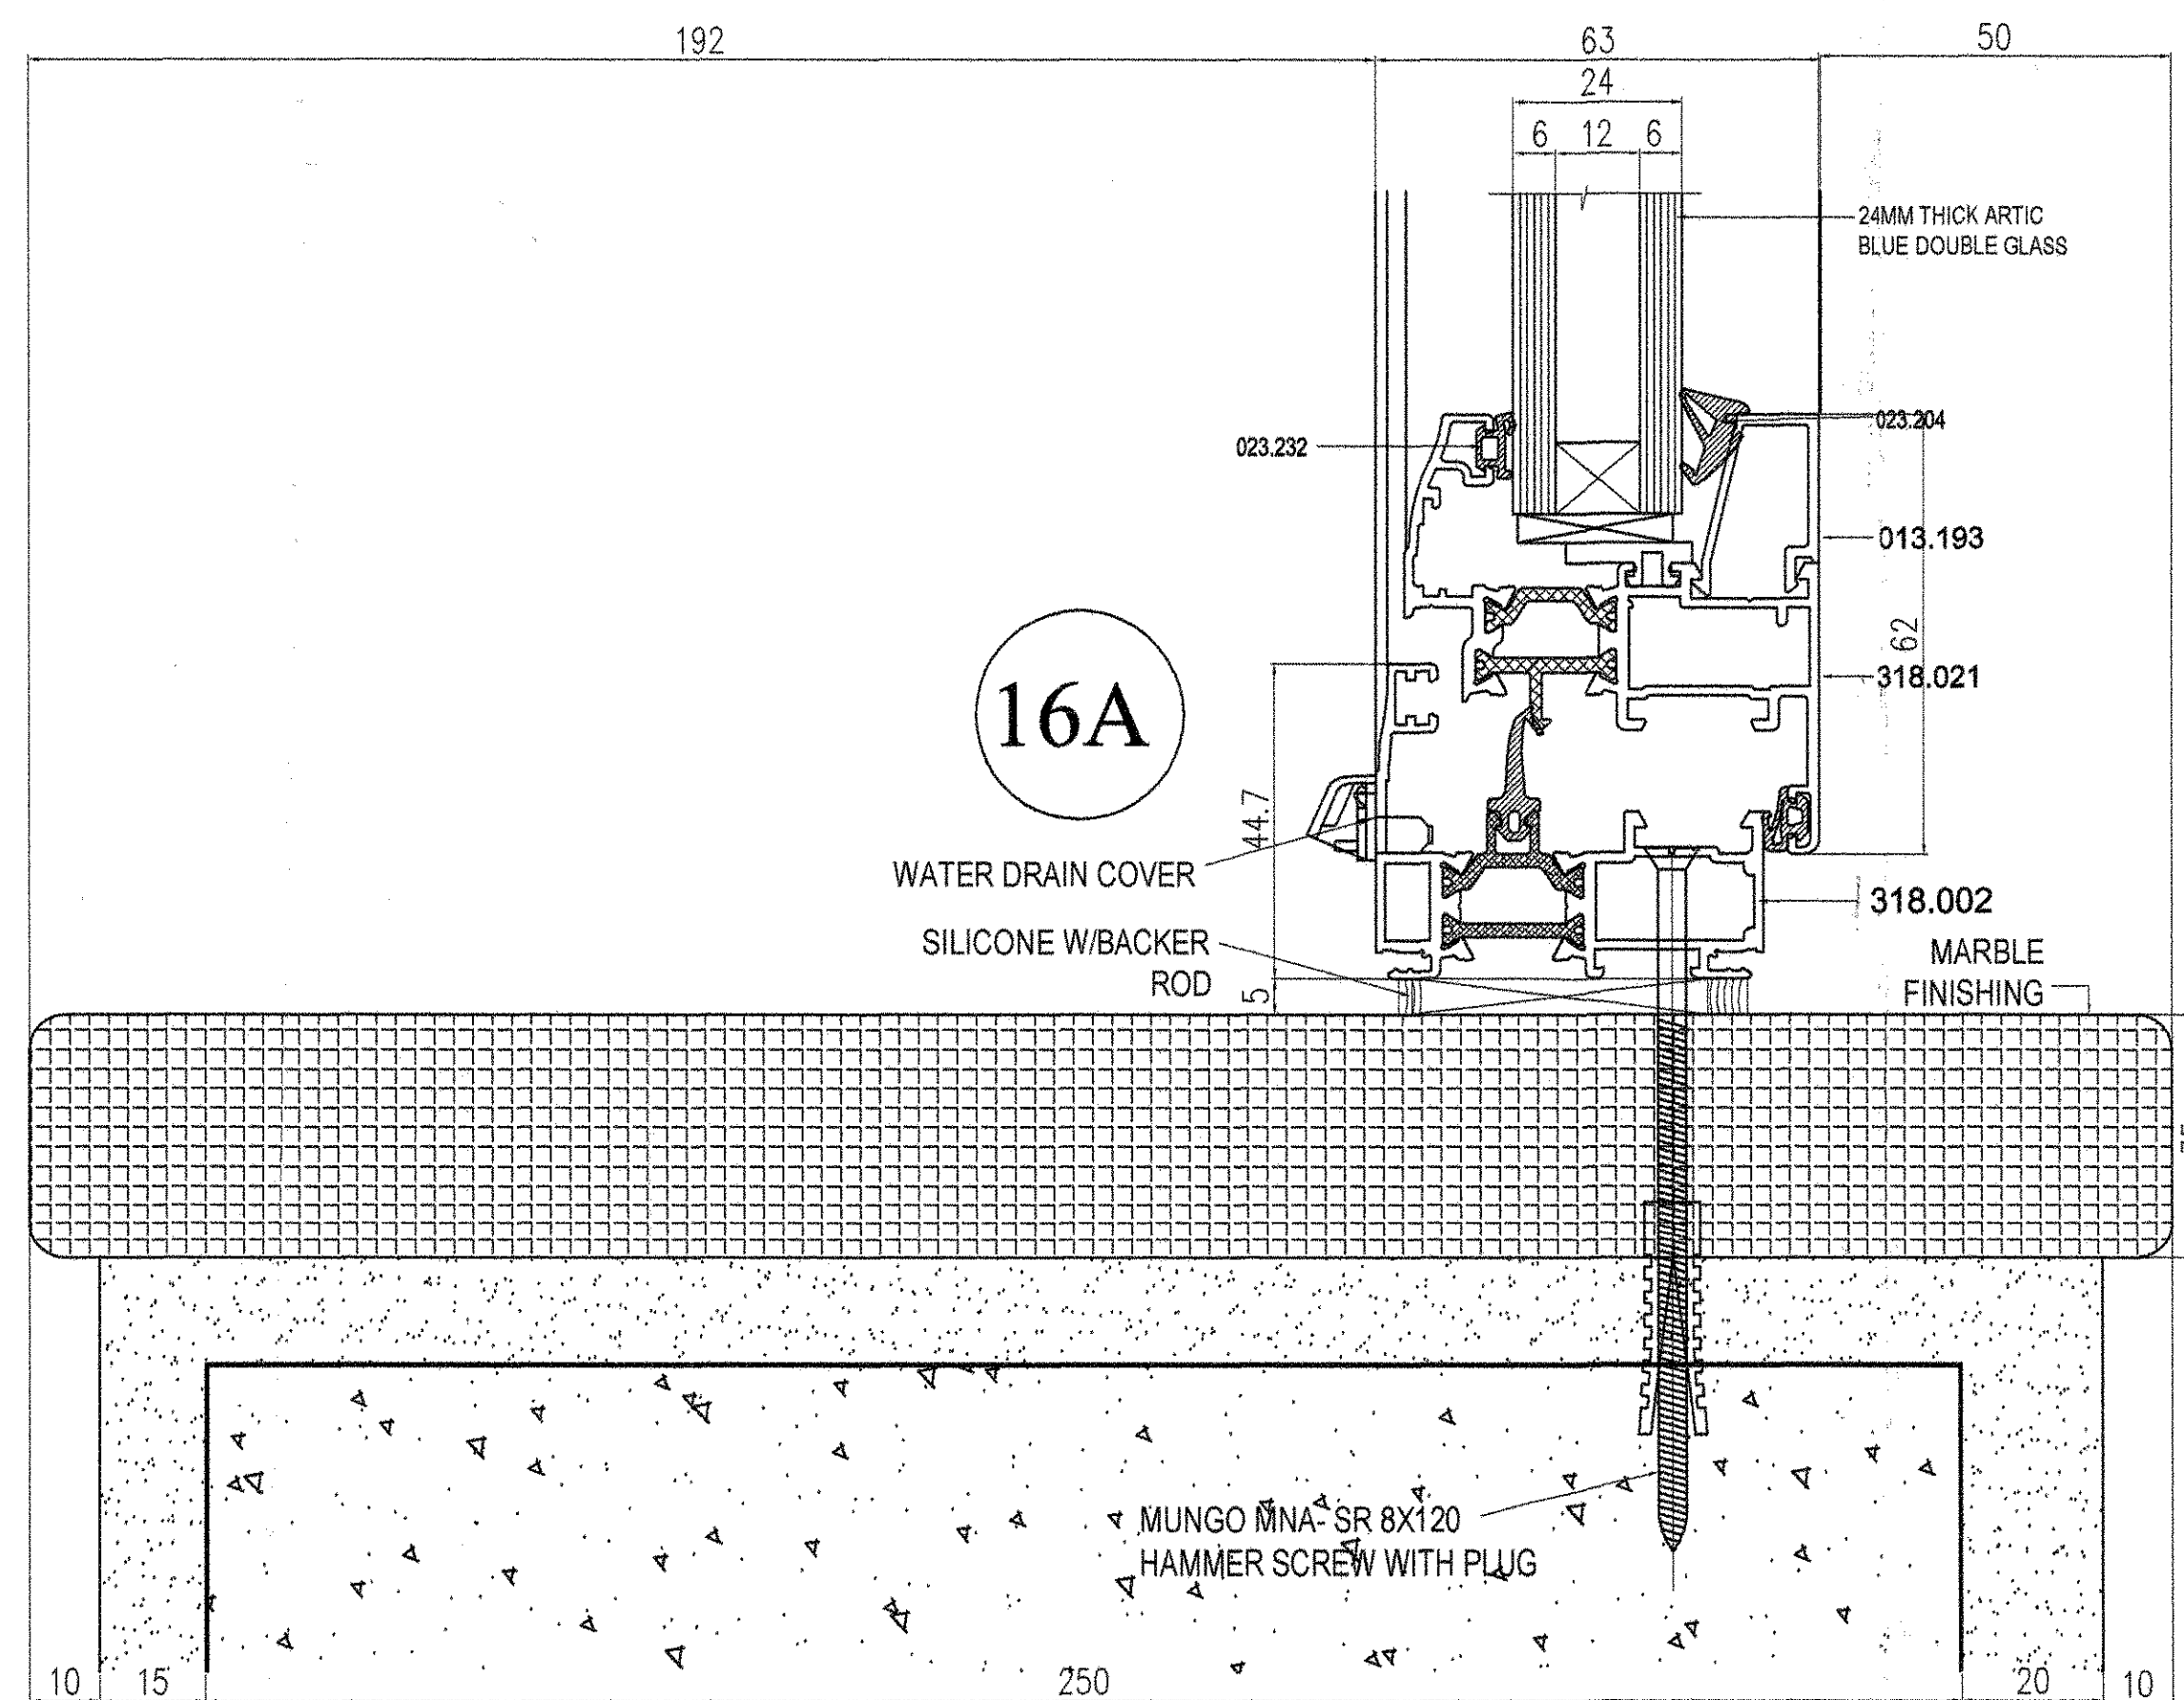

16A

dar al-handasah Shair and Partners	
☒ CODE 1	APPROVED
☐ CODE 2	APPROVED AS NOTED WORK MAY PROCEED SUBJECT TO INCORPORATION OF ENDORSED COMMENTS
☐ CODE 3	RESUBMIT FOR APPROVAL WORK MAY NOT PROCEED
☐ CODE 4	REJECTED
BY:	DATE:
Approval shall not relieve the contractor of any of his obligations under the Contract or constitute authorization of any change to Contract Documents or variation to the works. Contractor is responsible for dimensions, quantities and coordination with other trades.	

23 JUN 2012



AS BUILT DRAWING

Project
JUMEIRAH PARK

Employer
NAKHEEL
P.O. BOX: 17777, DUBAI, U.A.E.
PHONE: + 971 - 4 - 336088
FAX: + 971 - 4 - 336085
Website: www.nakheel.ae
E-MAIL: info@nakheel.ae

Consultant
dar al-handasah
shair and partners
P.O. BOX: 29624, DUBAI, U.A.E.
PHONE: + 971 - 4 - 333333
FAX: + 971 - 4 - 333331
www.daralhandasah.com




Main Contractor
Pauling Middle East
P.O. BOX: 45176, ABU DHABI, U.A.E.
PHONE: + 971 - 2 - 433992
FAX: + 971 - 2 - 433993
E-MAIL: pauling@emirates.net.ae

Sub Contractor
WHITE ALUMINIUM ENT.
P.O. BOX: 2402, ABU DHABI, U.A.E.
PHONE: + 971 - 2 - 554588
FAX: + 971 - 2 - 554592

Package
PACKAGE - 2
Cluster - 1
PACKAGE - 2A
Clusters - 1, 3 (Villas 51 to 62), 4, 5, 7 (Villas 33 to 41),
8, 9, 10, 11, 12, 13, 14, 15 (Villas 1 to 14) & 16

ALUMINIUM & GLASS DETAILS

Drawn	IBRAHIM	Review	Eng. Ziad	Checked:	GUGAN
Scale:	1:1	Date:	13-06-2012		
Drawing No.	PME / JP / AB / LE / ALU / 010A				

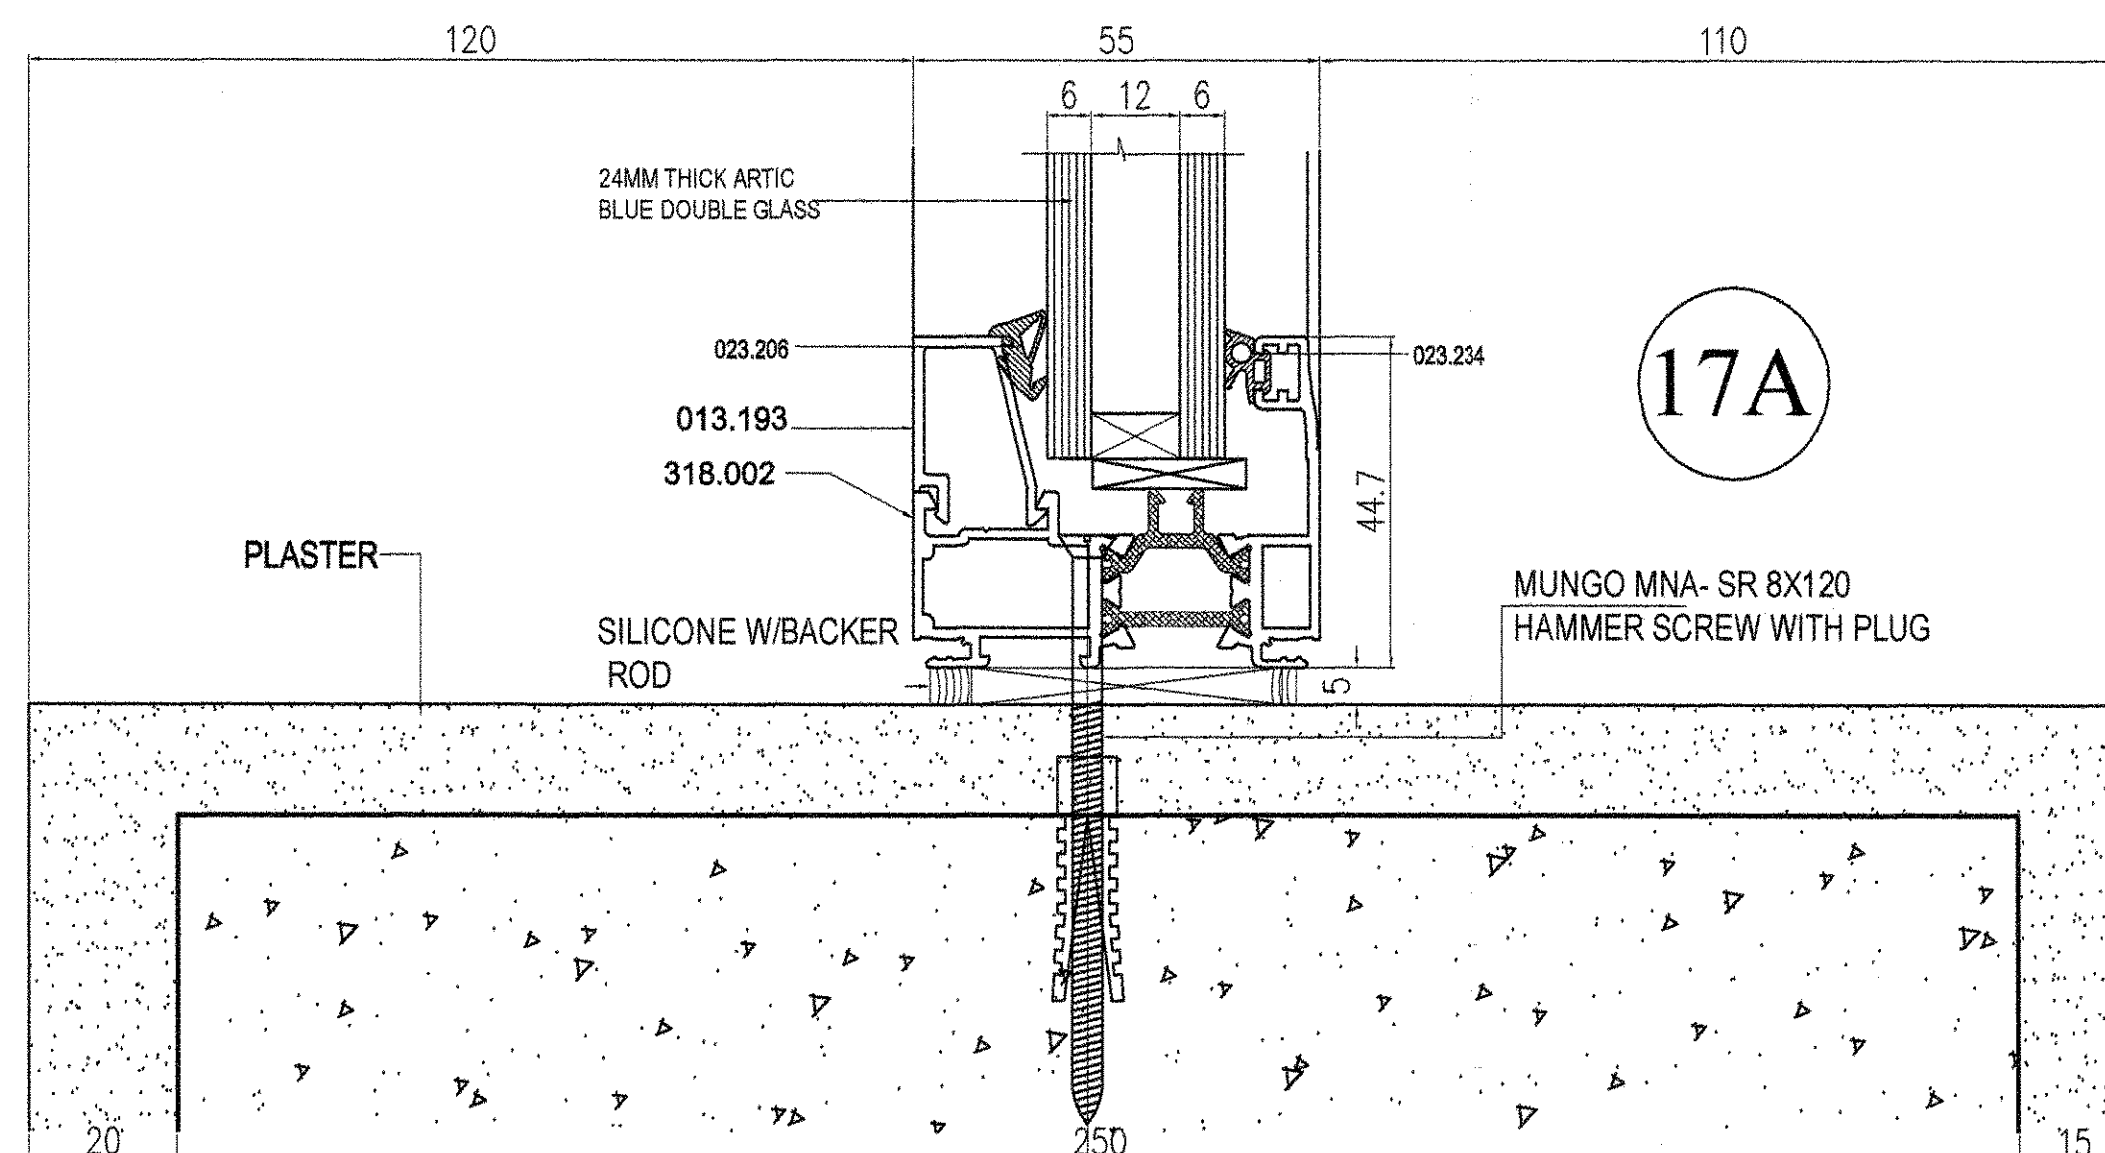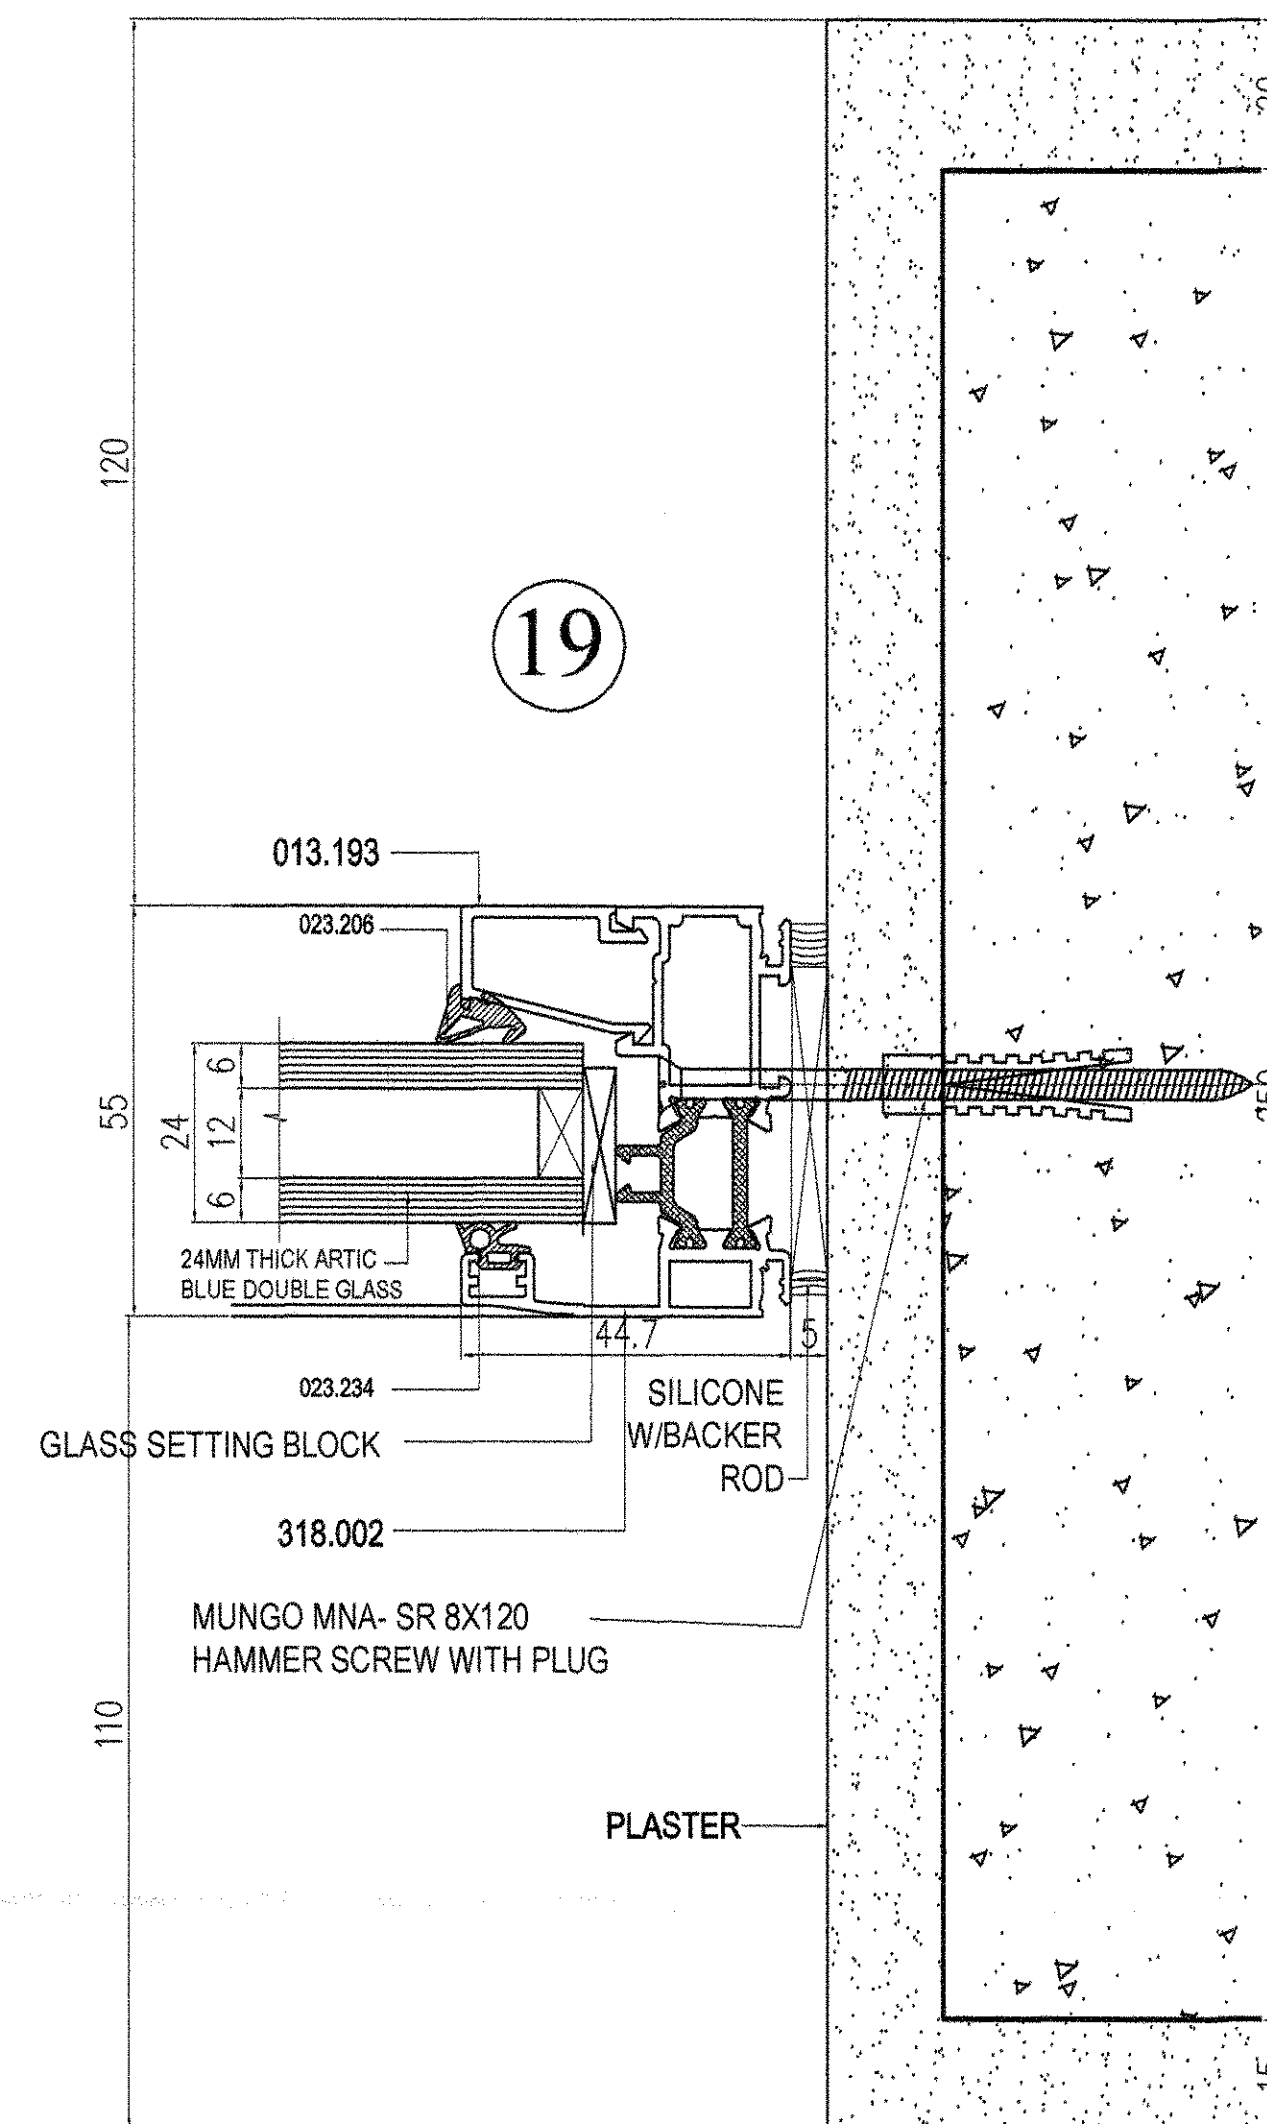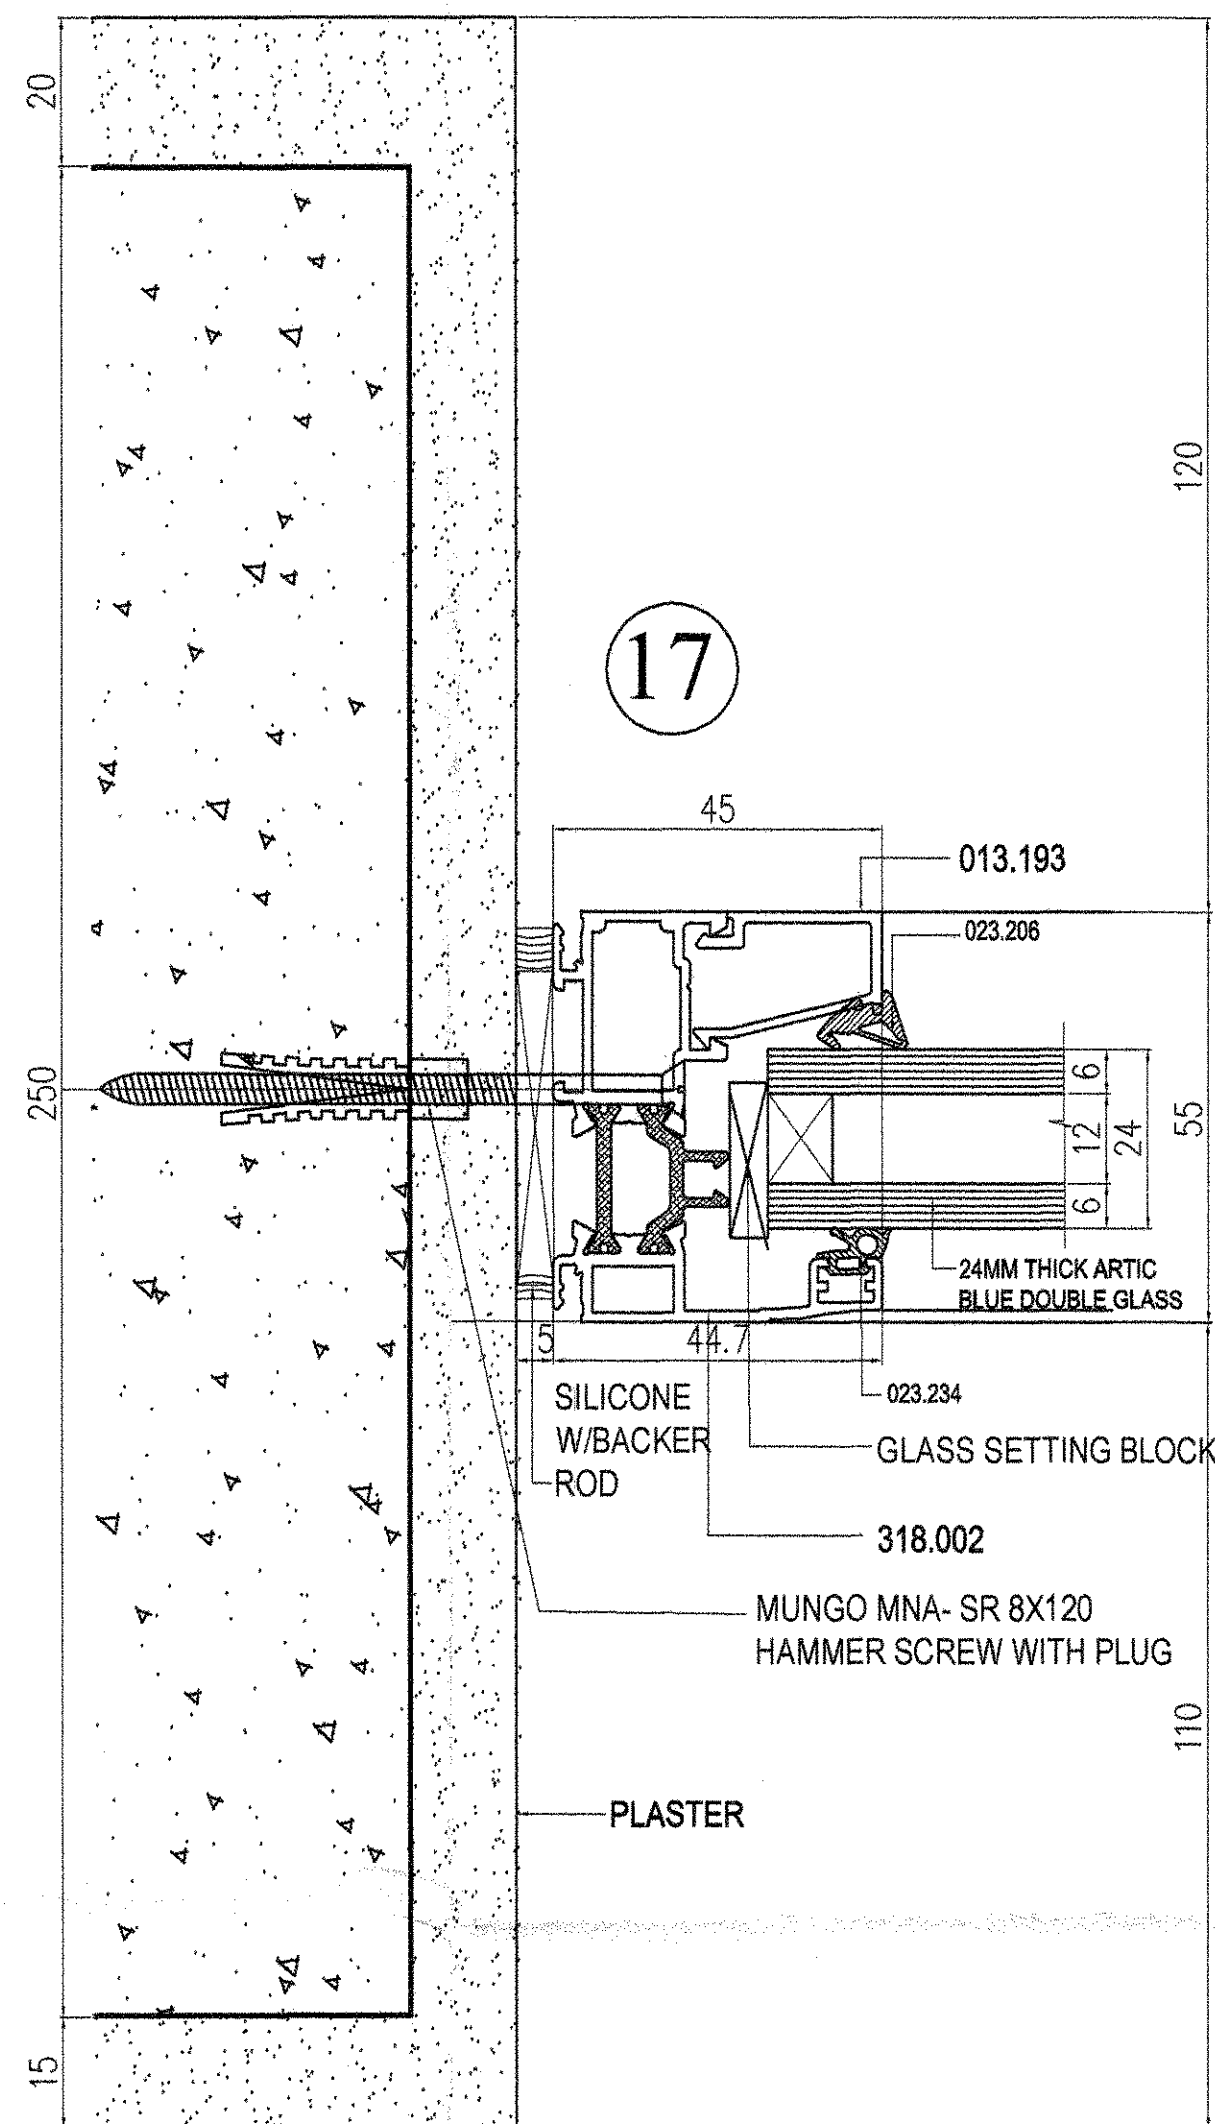

dar al-handasah
Shair and Partners

☒ CODE 1 APPROVED
☐ CODE 2 APPROVED AS NOTED
 WORK MAY PROCEED SUBJECT TO
 INCORPORATION OF ENDORSED
 COMMENTS
☐ CODE 3 RESUBMIT FOR APPROVAL
 WORK MAY NOT PROCEED
☐ CODE 4 REJECTED

BY: *[Signature]* DATE: 21/06/2012

Approval shall not relieve the contractor of any of his
 obligations under the Contract or constitute authorization of
 any change to Contract Documents or reliance to the work.
 Contractor is responsible for dimensions, quantities and
 coordination with other trades.



AS BUILT DRAWING

JUMEIRAH PARK



NAKHEEL

P.O. BOX: 17777, DUBAI, U.A.E.
 PHONE : + 971 4 363388
 FAX : + 971 4 363333
 Website : www.nakheel.ae
 E-MAIL : info@nakheel.ae



dar al-handasah
shair and partners

P.O. BOX: 55024, DUBAI, U.A.E.
 PHONE : + 971 4 355502
 FAX : + 971 4 30055121
 www.daralhandasah.com



Pauling Middle East

P.O. BOX: 45176, ABU DHABI, U.A.E.
 PHONE : + 971 2 4555552
 FAX : + 971 2 4555553
 E-MAIL : paulingmiddleeast.ae



WHITE ALUMINIUM ENT.

P.O. BOX: 3402, ABU DHABI, U.A.E.
 PHONE : + 971 2 554188
 FAX : + 971 2 554189

PACKAGE - 2

Cluster - 1


PACKAGE - 2A

Clusters - 1, 3 (Villas 51 to 62), 4, 5, 7 (Villas 33 to 41),
 8, 9, 10, 11, 12, 13, 14, 15 (Villas 1 to 14) & 16

ALUMINIUM & GLASS
 DETAILS



Drawn: IBRAHIM	Review: Eng. Zied	Checked: GUGAN
Scale: 1:1	Date: 13-08-2012	

Drawing No. **PME / JP / AB / LE / ALU / 011A**

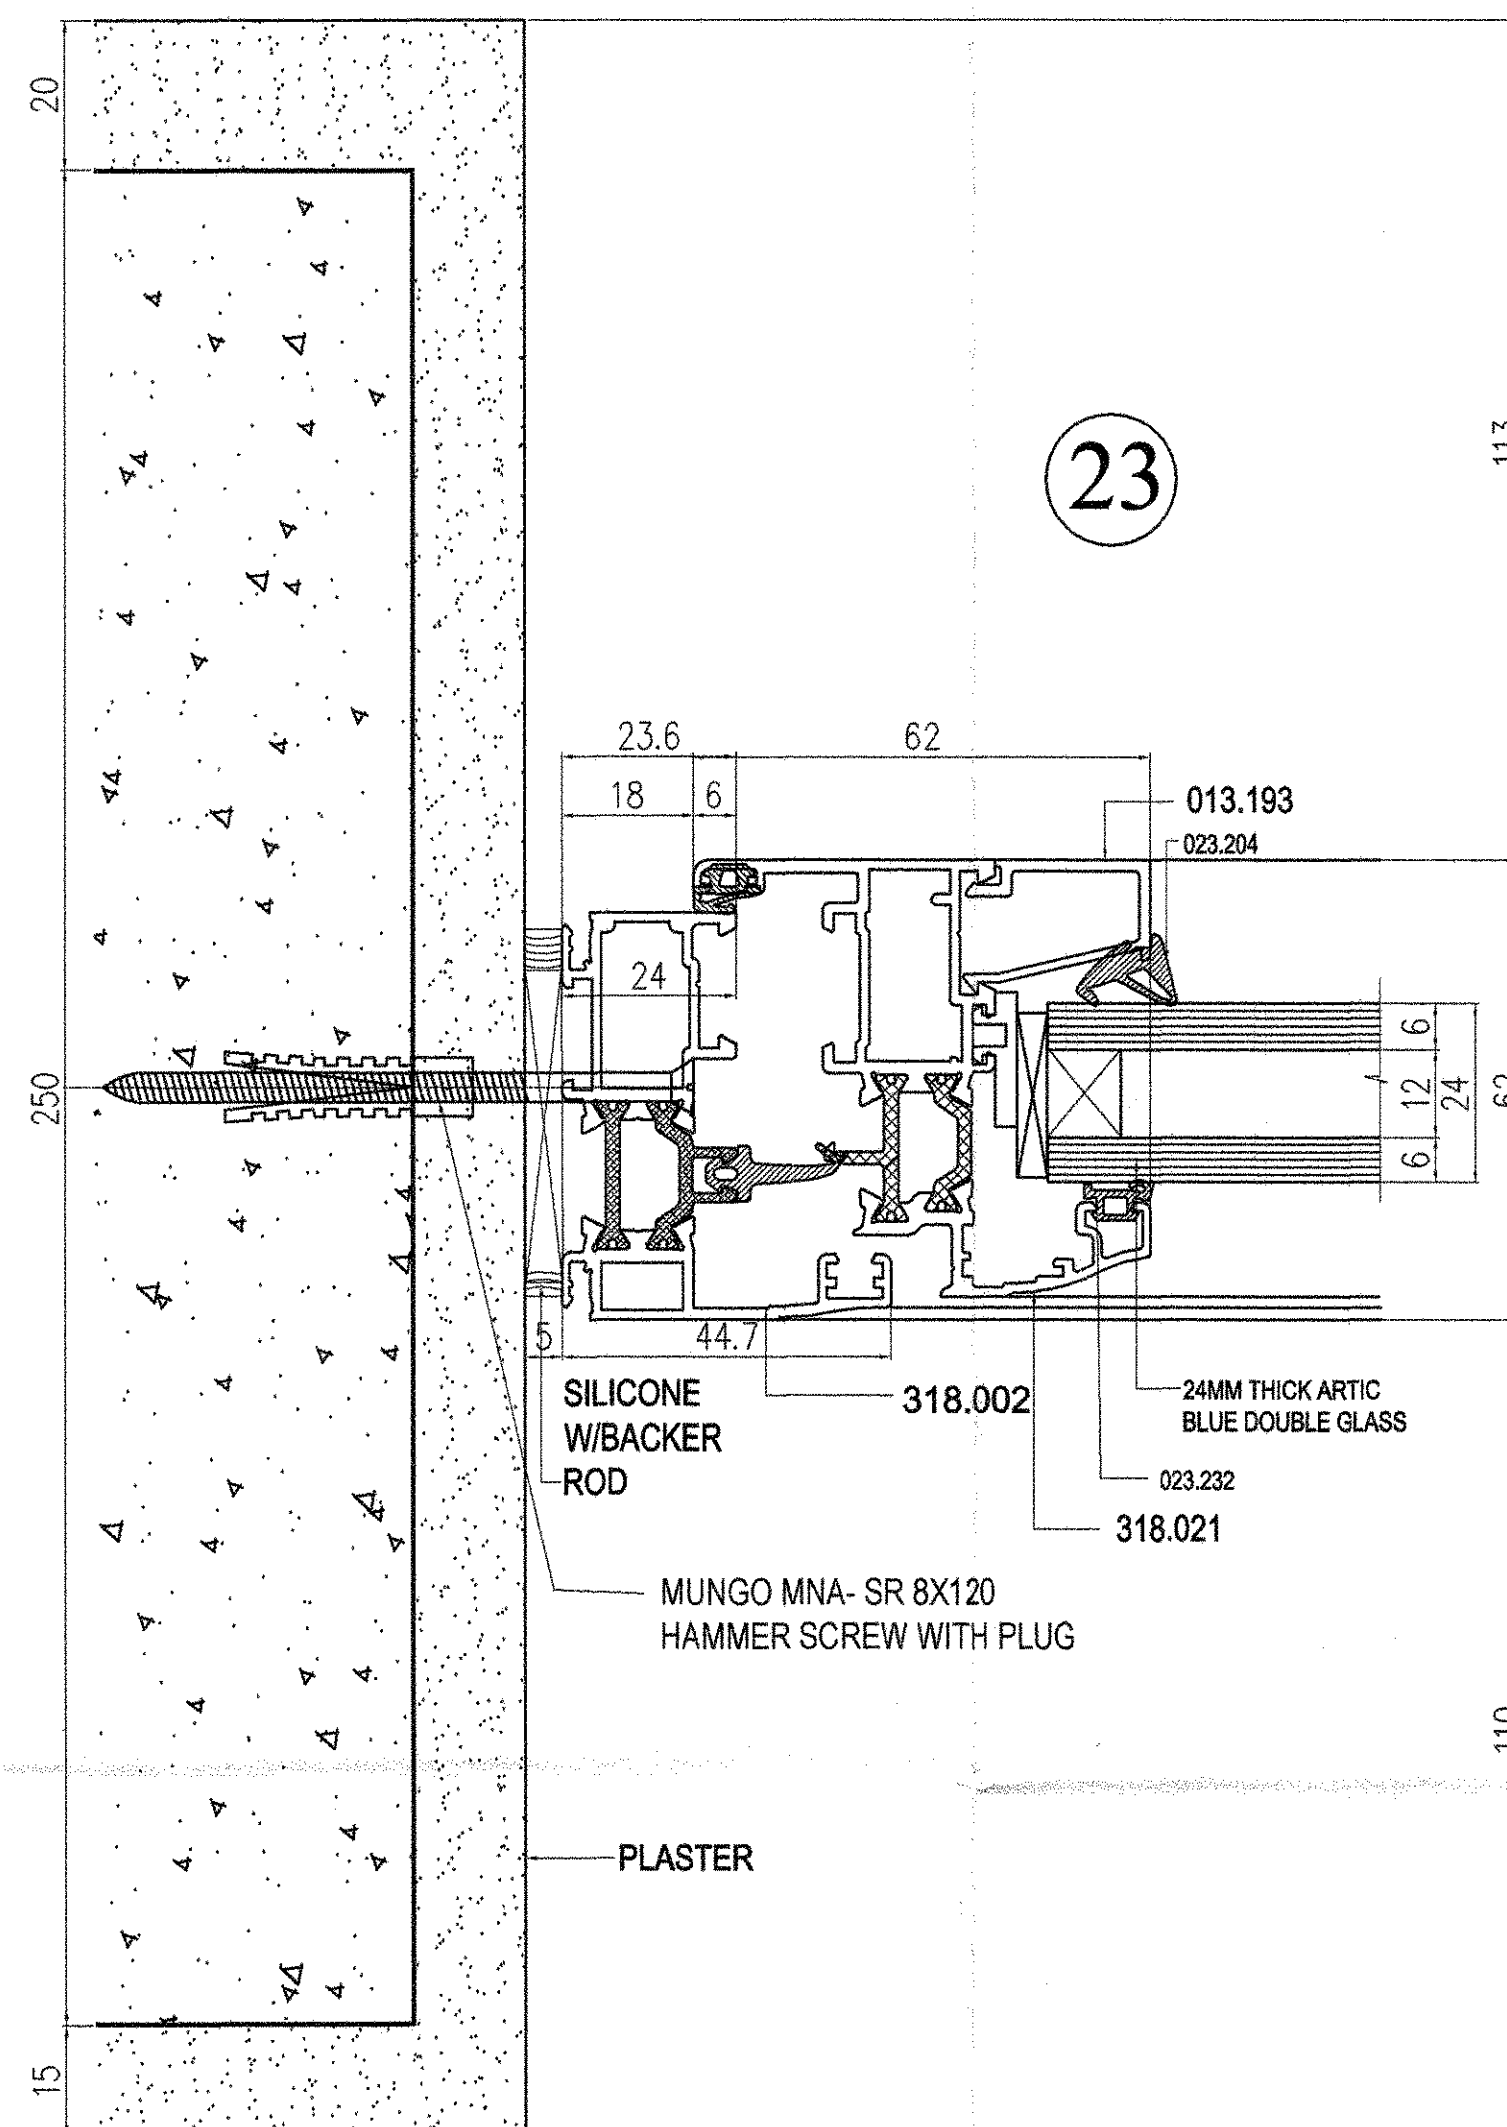

OUT SIDE

IN SIDE

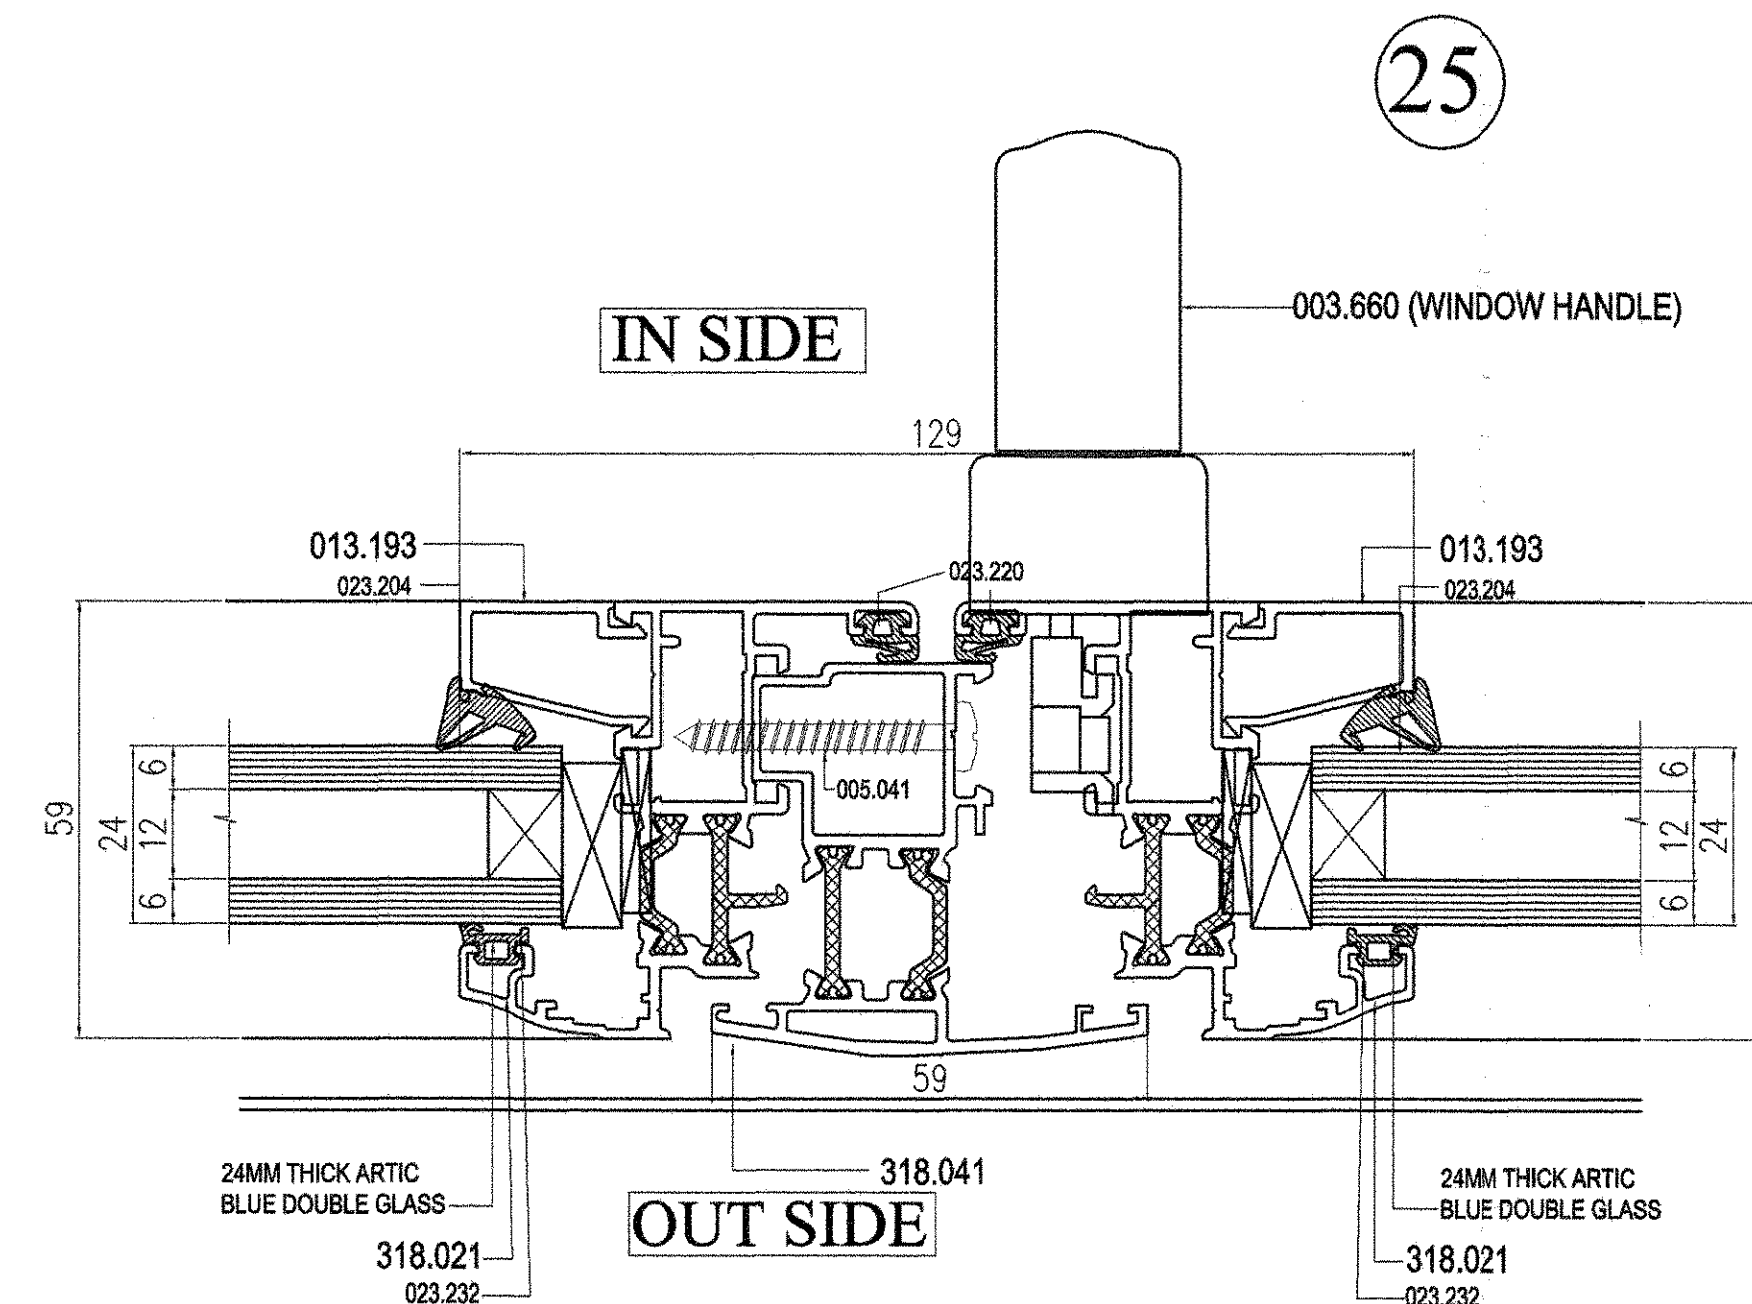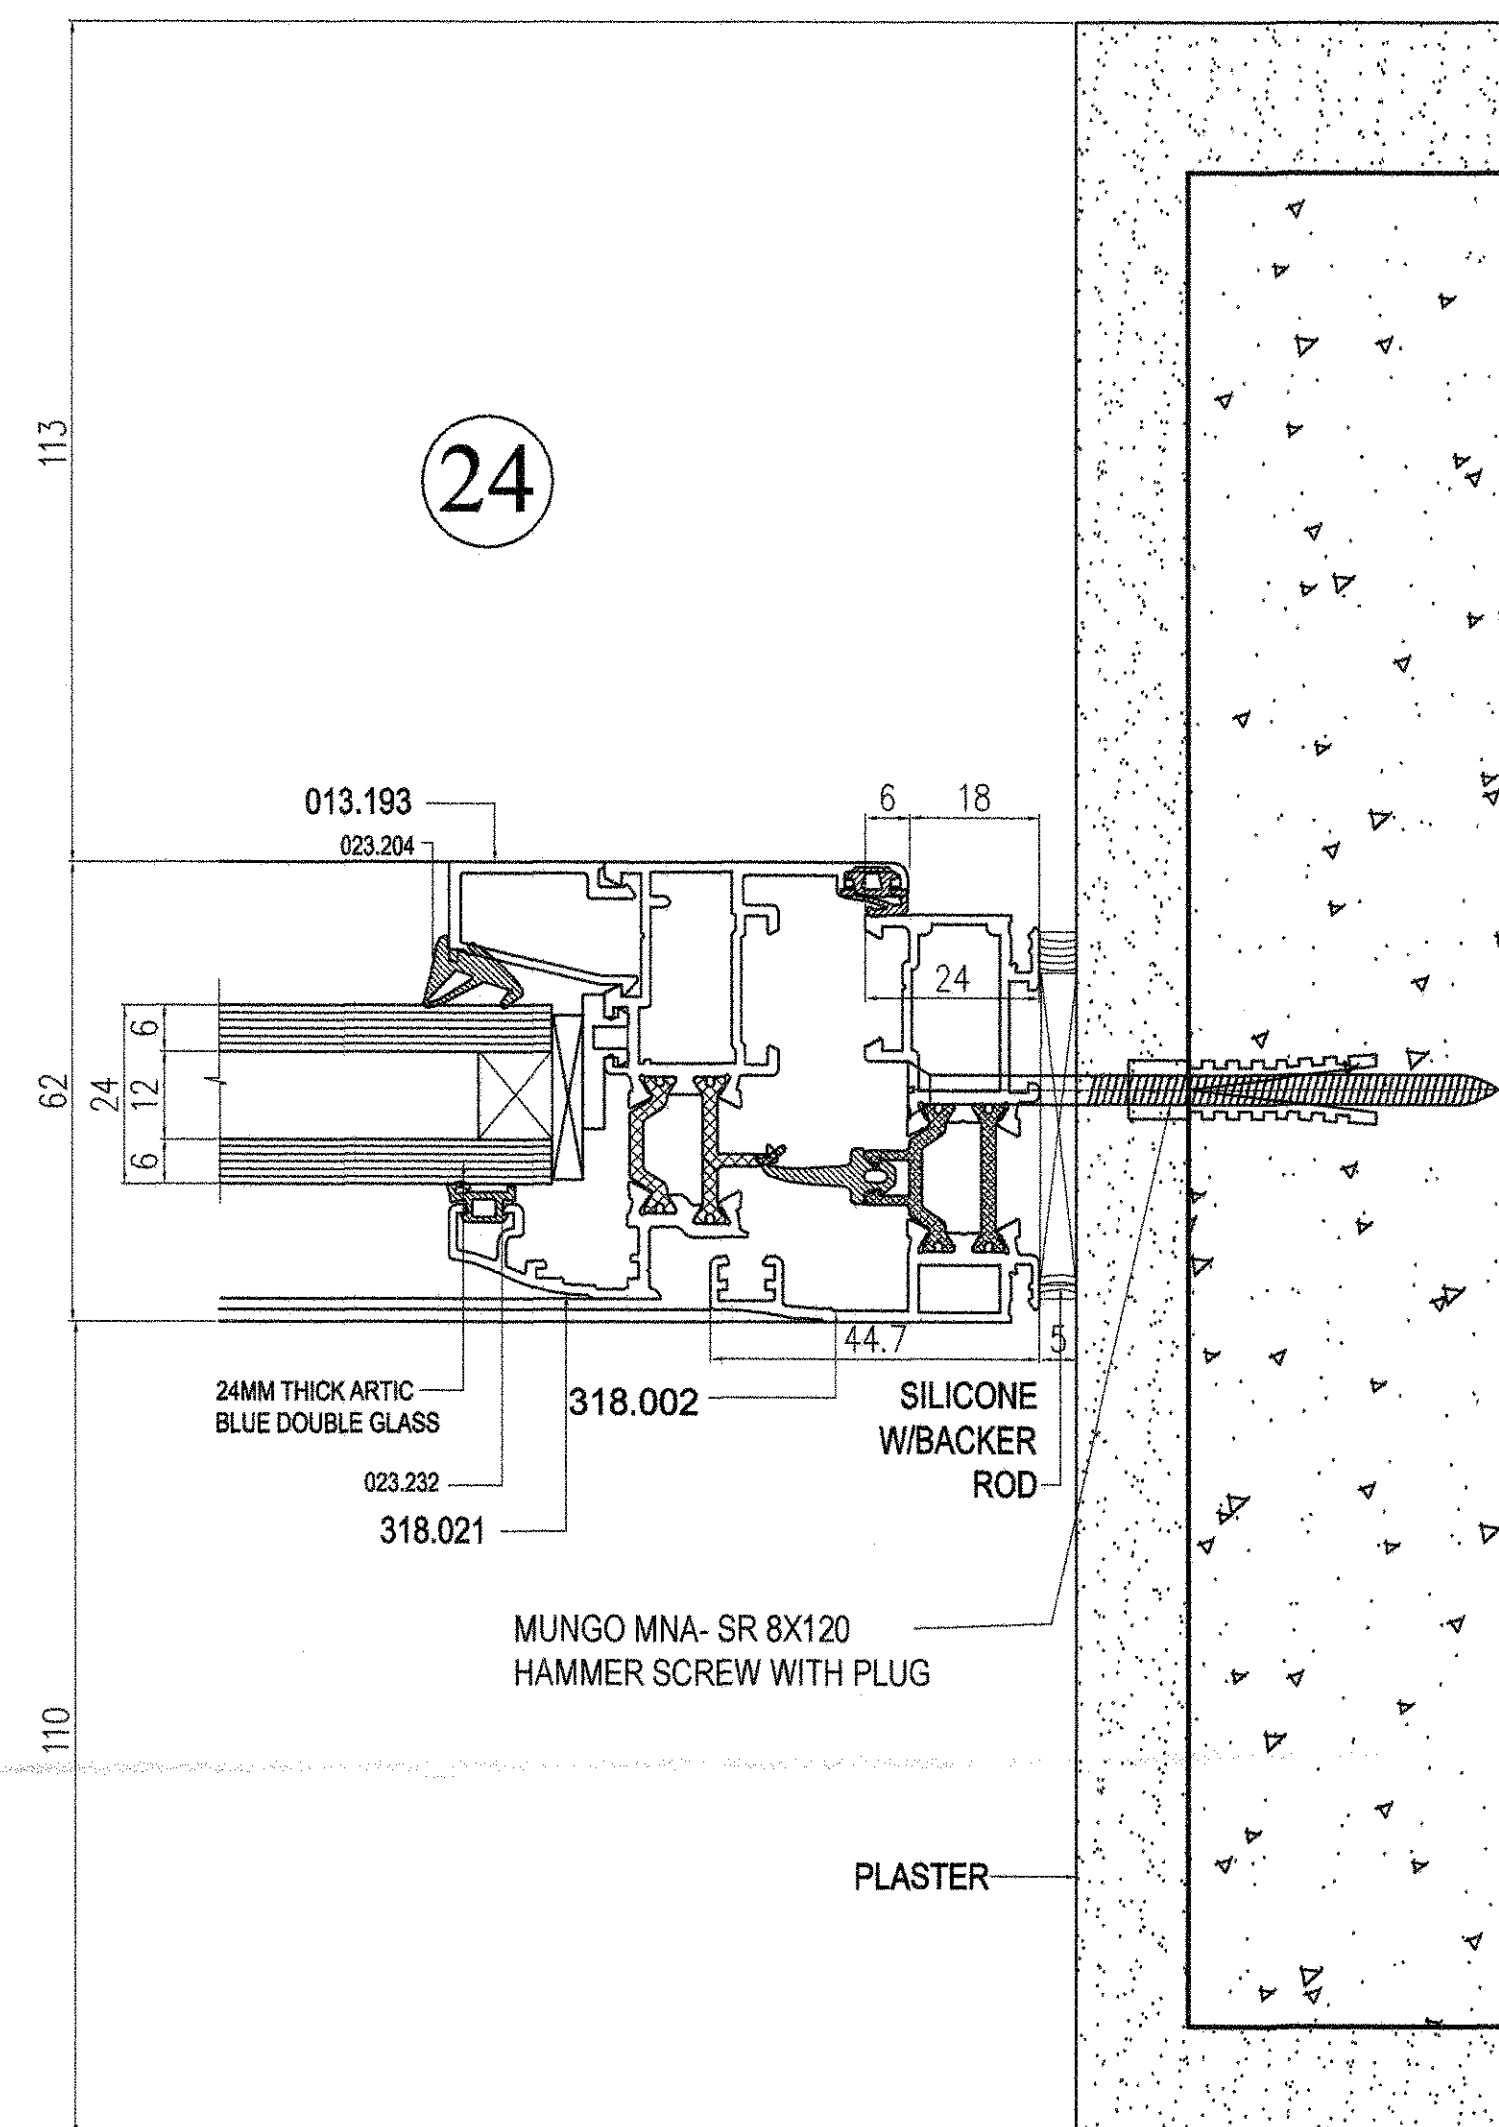

dar al-handasah
Sheir and Partners

☒ CODE 1 APPROVED

☐ CODE 2 APPROVED AS NOTED
WORK MAY PROCEED SUBJECT TO
INCORPORATION OF ENDORSED
COMMENTS

☐ CODE 3 RESUBMIT FOR APPROVAL
WORK MAY NOT PROCEED

☐ CODE 4 REJECTED

BY: _____ DATE: _____

Approval shall not relieve the contractor of any of his
obligations under the Contract or constitute authorization of
any change to Contract Documents or variation to the work.
Contractor is responsible for dimensions, quantities and
coordination with other trades.

20/06/2012



AS BUILT DRAWING

JUMEIRAH PARK



PACKAGE - 2

Cluster - 1

PACKAGE - 2A

Clusters - 1, 3 (Villas 51 to 62), 4, 5, 7 (Villas 33 to 41),
8, 9, 10, 11, 12, 13, 14, 15 (Villas 1 to 14) & 16



ALUMINIUM & GLASS
DETAILS

Drawn: IBRAHIM Review: Eng. Ziad Checked: GUGAN

Scale: 1:1 Date: 13-06-2012

Drawing No. PME / JP / AB / LE / ALU / 012A

AB 135

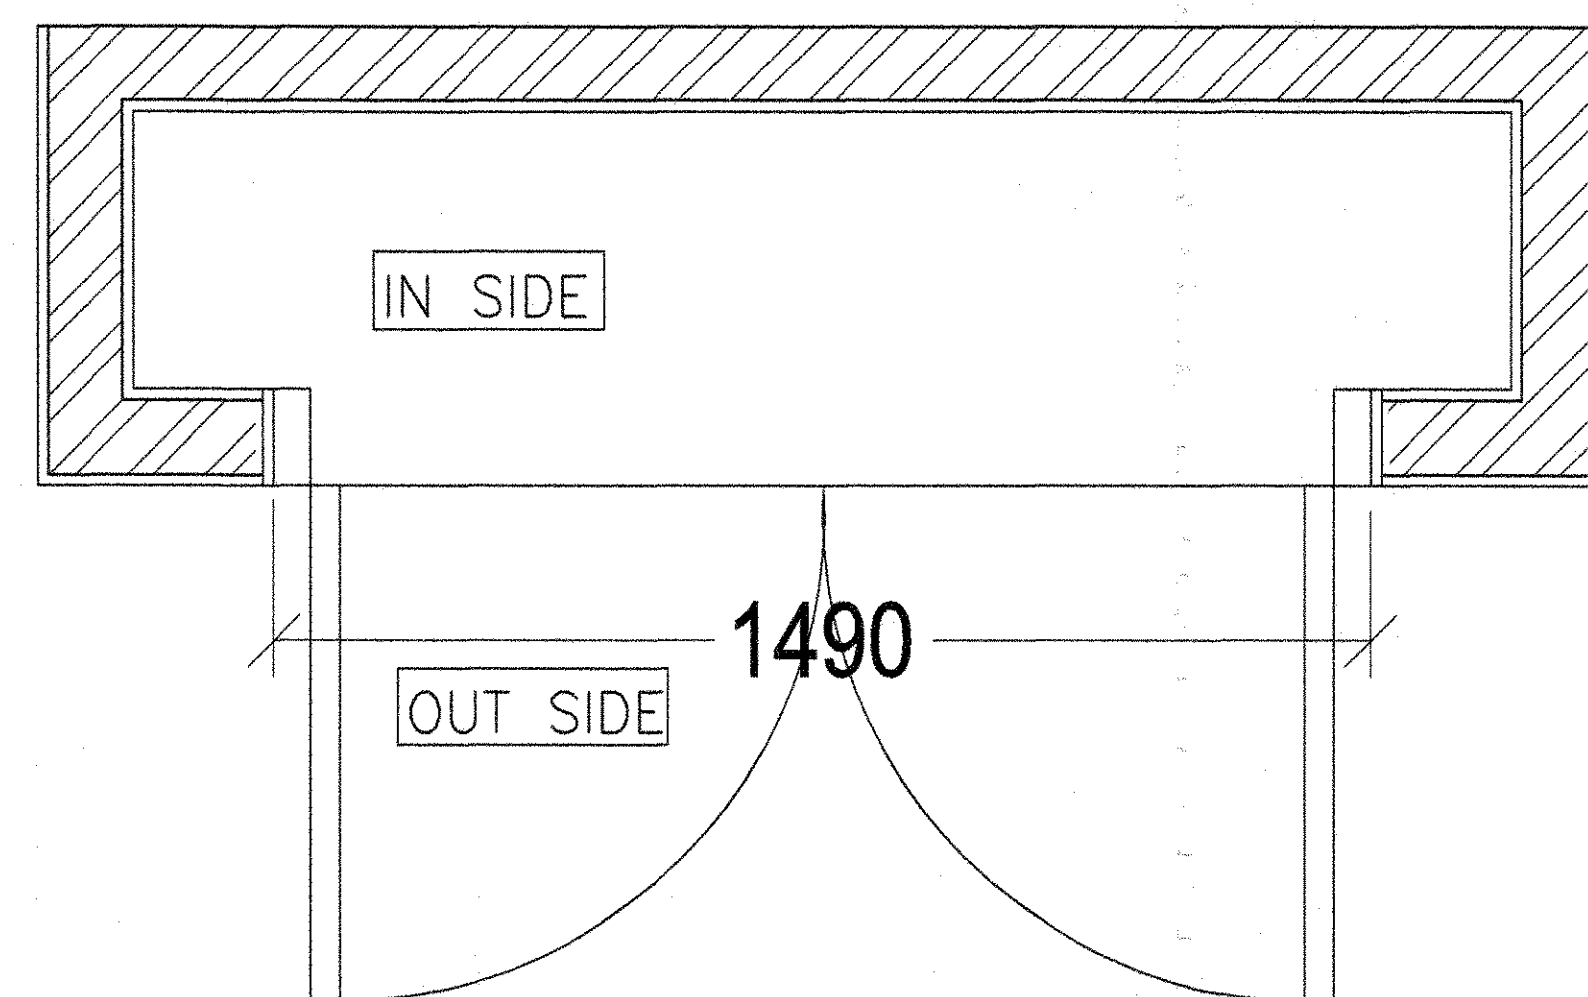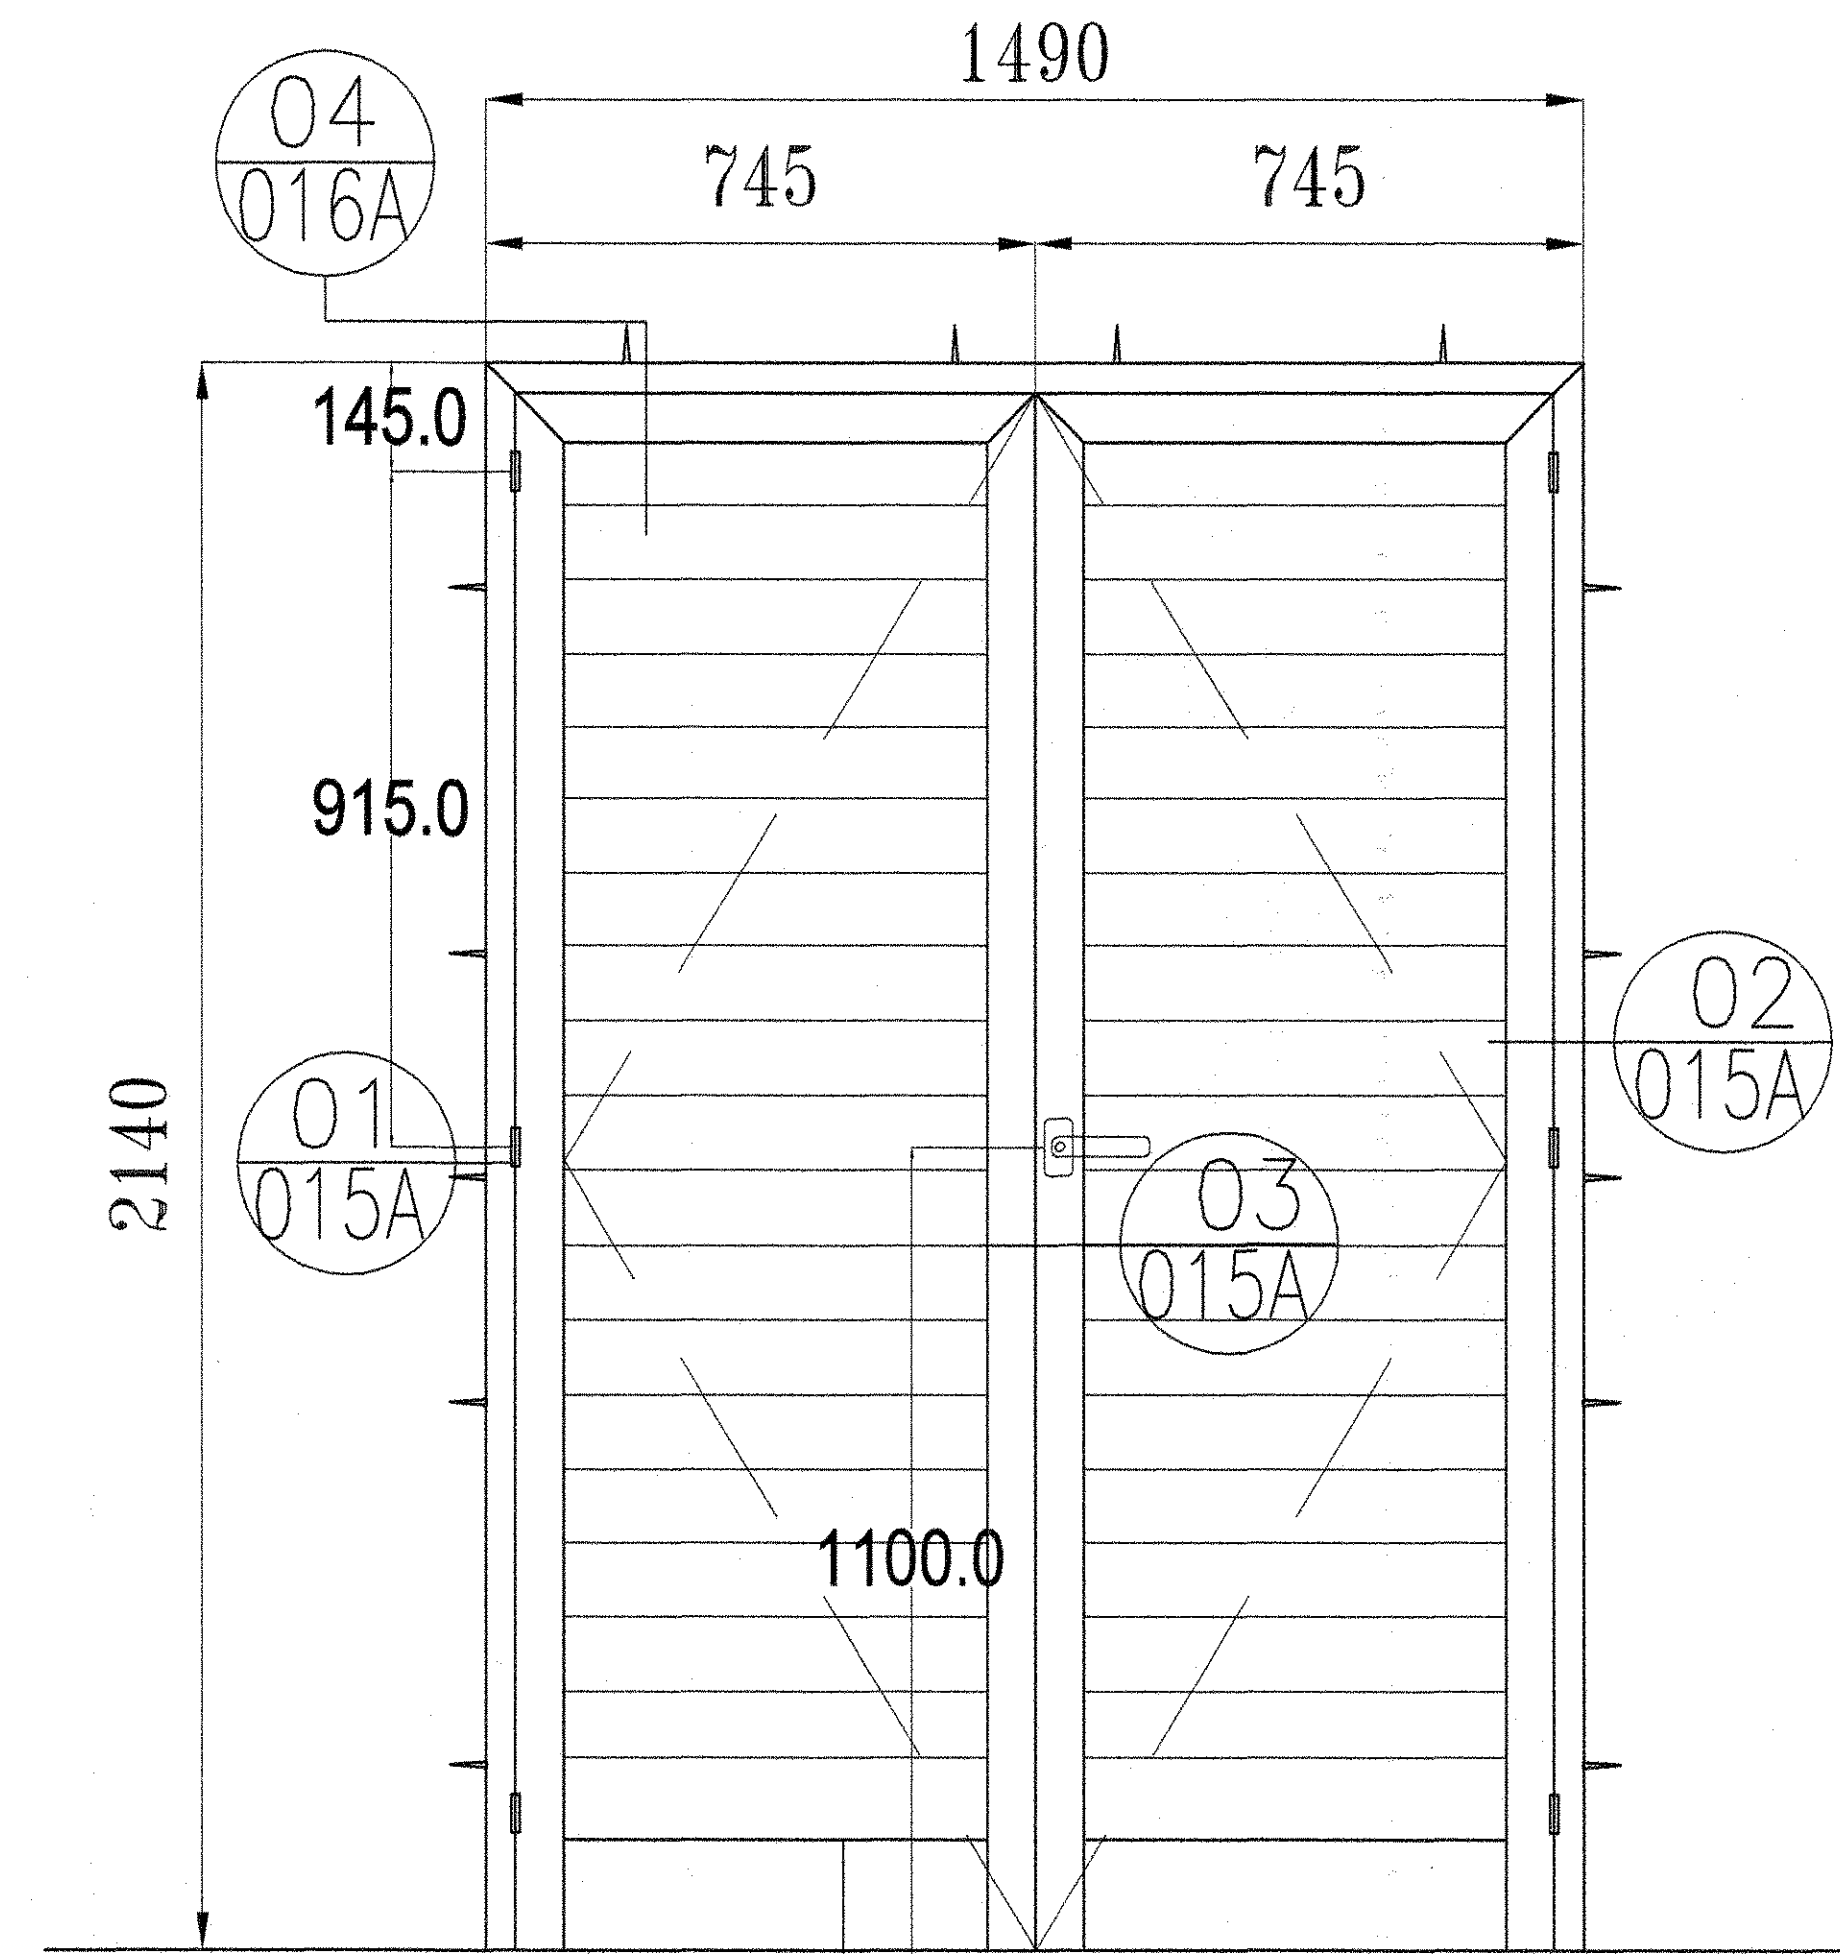

ITEM: DM24 (OUT)
 SIZE: 1.49X2.14
 G.FLR-GARAGE
 QTY: 1 NO

dar al-handasah Sheir and Partners	
☒ CODE 1	APPROVED
☐ CODE 2	APPROVED AS NOTED WORK MAY PROCEED SUBJECT TO INCORPORATION OF ENDORSED COMMENTS
☐ CODE 3	RESUBMIT FOR APPROVAL WORK MAY NOT PROCEED
☐ CODE 4	REJECTED
BY:	DATE:
Approval shall not relieve the Contractor of any of his obligations under the Contract or constitute authorization of any change to Contract Documents or variation to the work. Contractor is responsible for completeness, quantities and coordination with other trades.	

Hardware For Door & Windows

- 1.Louvre Door Handle - Profilsystemes - 003.664
- 2.Louvre Door Hinge - Profilsystemes - 003.657
- 3.Louvre Door Lock - Profilsystemes - 003.932

Note:

Reference No. of Detail

Reference No. of
Drawing Sheet



AS BUILT DRAWING

Project

JUMEIRAH PARK

Employer



NAKHEEL

P.O. BOX: 17777, DUBAI, U.A.E.
 PHONE : + 971 - 4 - 3603888
 FAX : + 971 - 4 - 3603855
 Website : www.nakheel.ae
 E-MAIL : info@nakheel.ae


Consultant



dar al-handasah
sheir and partners

P.O. BOX: 55624, DUBAI, U.A.E.
 PHONE : + 971 - 4 - 3333002
 FAX : + 971 - 4 - 3333021
 www.daralhandasah.com

Main Contractor

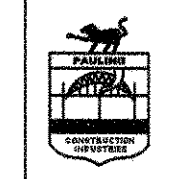

Pauling Middle East

P.O. BOX: 45176, ABU DHABI, U.A.E.
 PHONE : + 971 - 2 - 4339022
 FAX : + 971 - 2 - 4339033
 E-MAIL : pauling@emirates.net.ae

Sub Contractor



WHITE ALUMINIUM ENT.

P.O. BOX: 21402, ABU DHABI, U.A.E.
 PHONE : + 971 - 2 - 5545355
 FAX : + 971 - 2 - 5545353

PACKAGE - 2

Cluster - 1

PACKAGE - 2A

Clusters - 1, 3 (Villas 51 to 62), 4, 5, 7 (Villas 33 to 41),
 8, 9, 10, 11, 12, 13, 14, 15 (Villas 1 to 14) & 16






Drawing Title

ELEVATION ELECTRIC ROOM

Drawn	IBRAHIM	Review	Eng. Ziad	Checked:	GUGAN
-------	---------	--------	-----------	----------	-------

Scale:	1:10	Date:	13-06-2012
--------	------	-------	------------


Drawing No. **PME / JP / AB / LE / ALU / 014A**

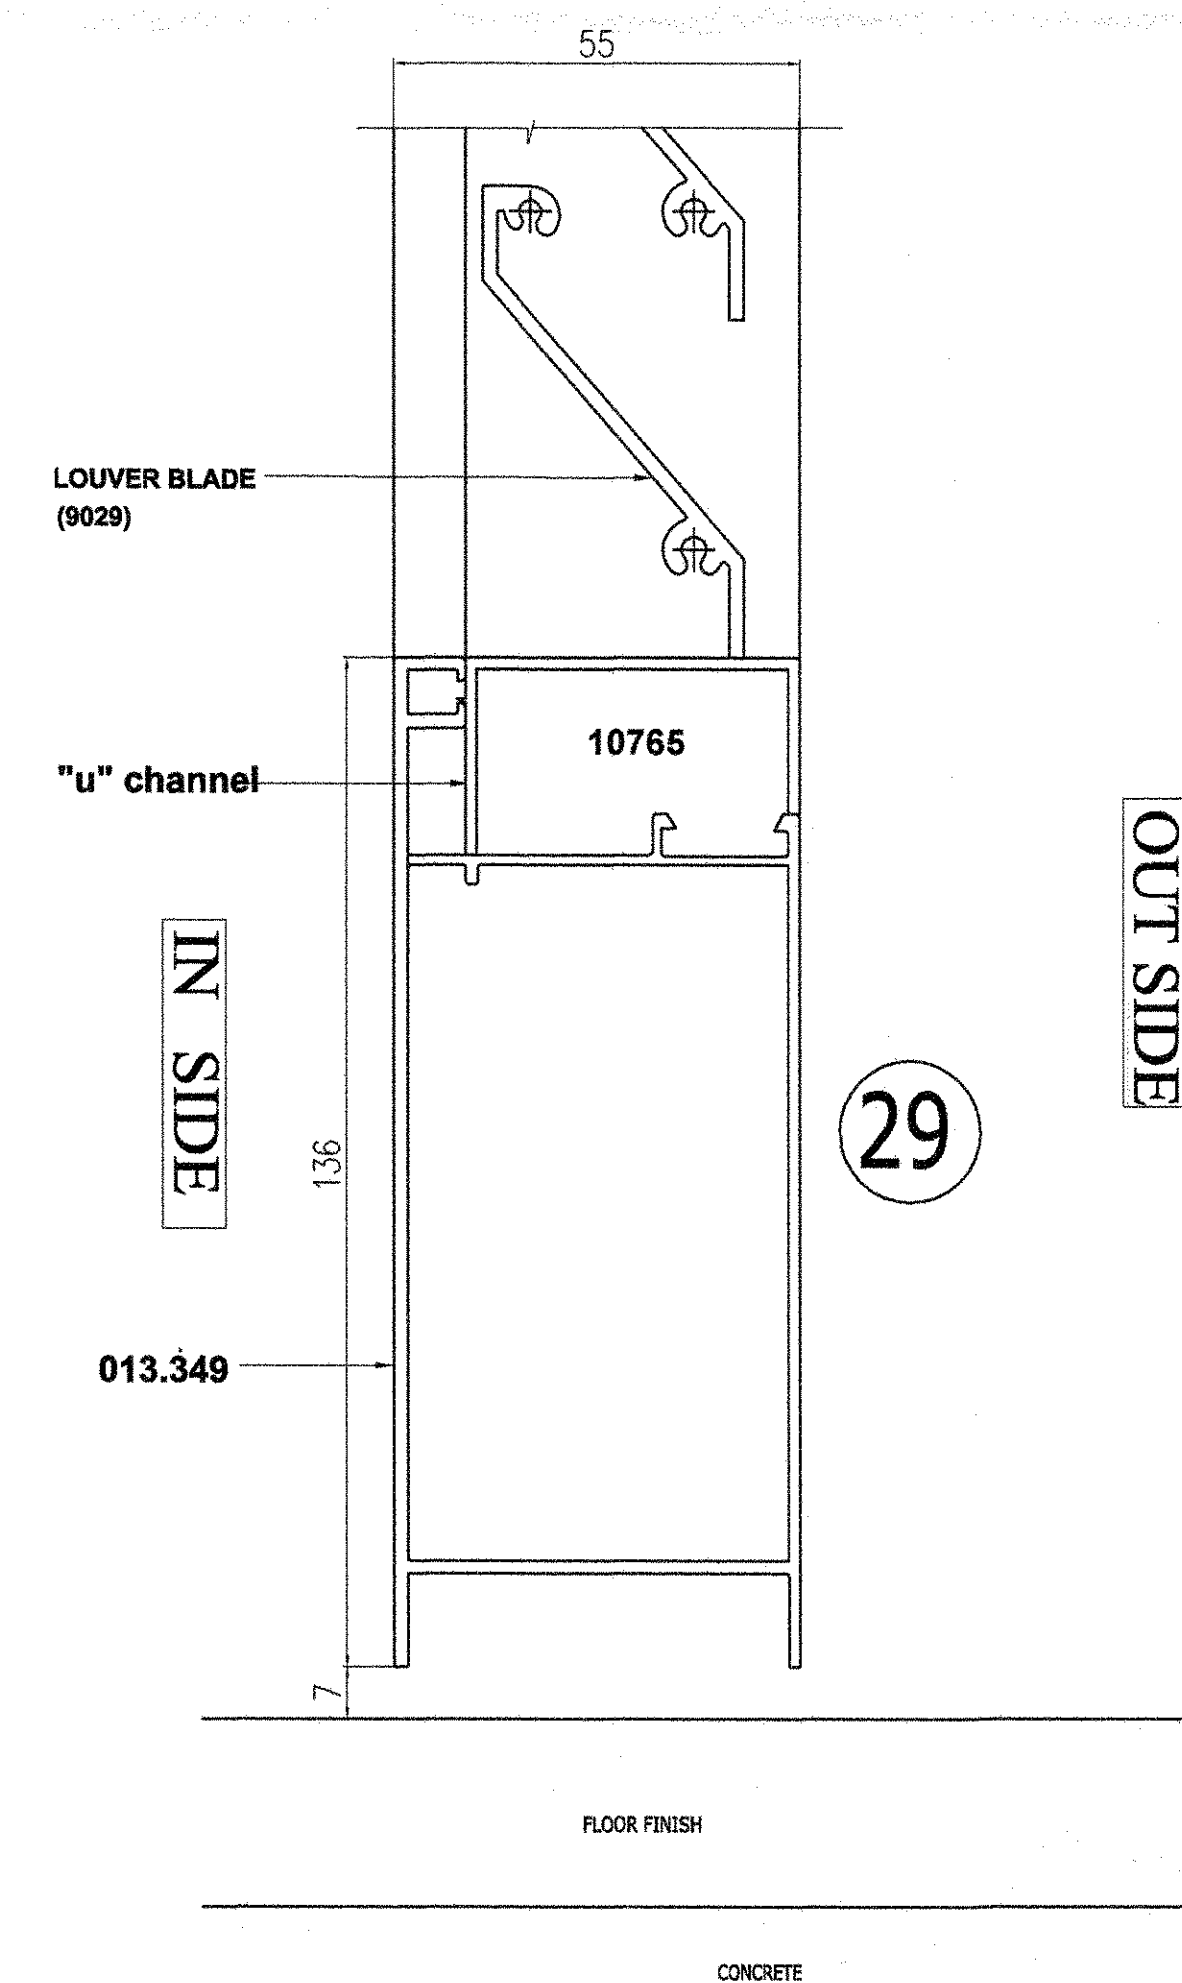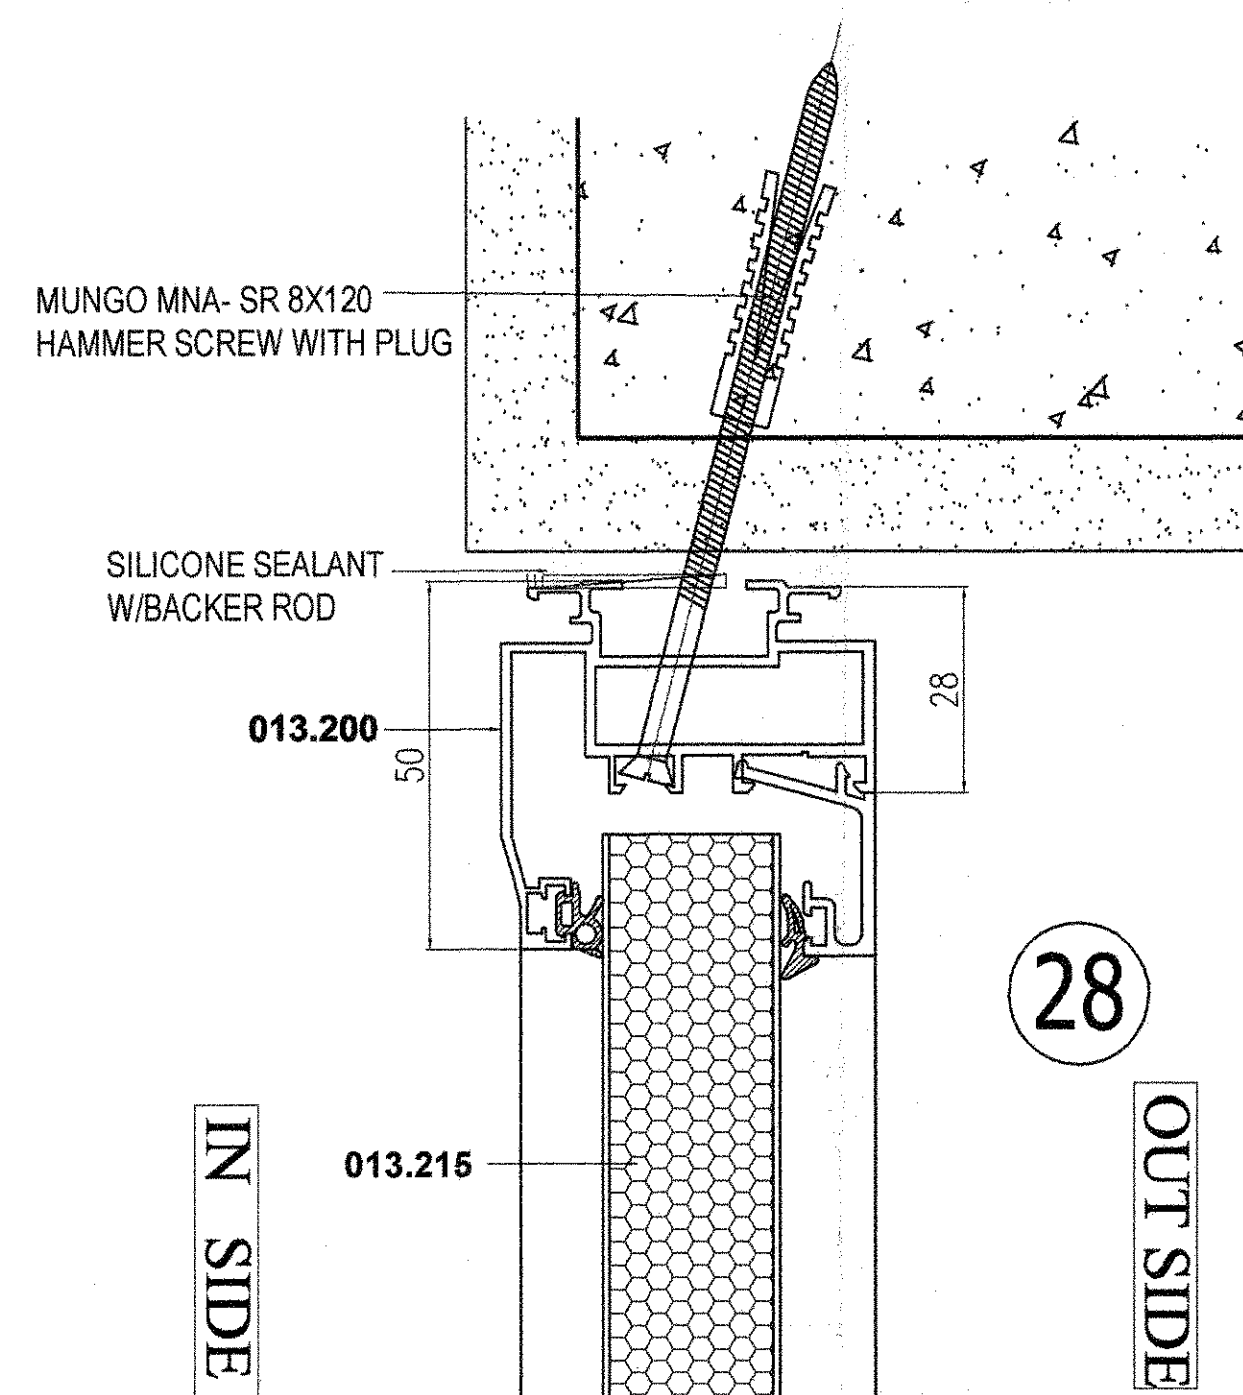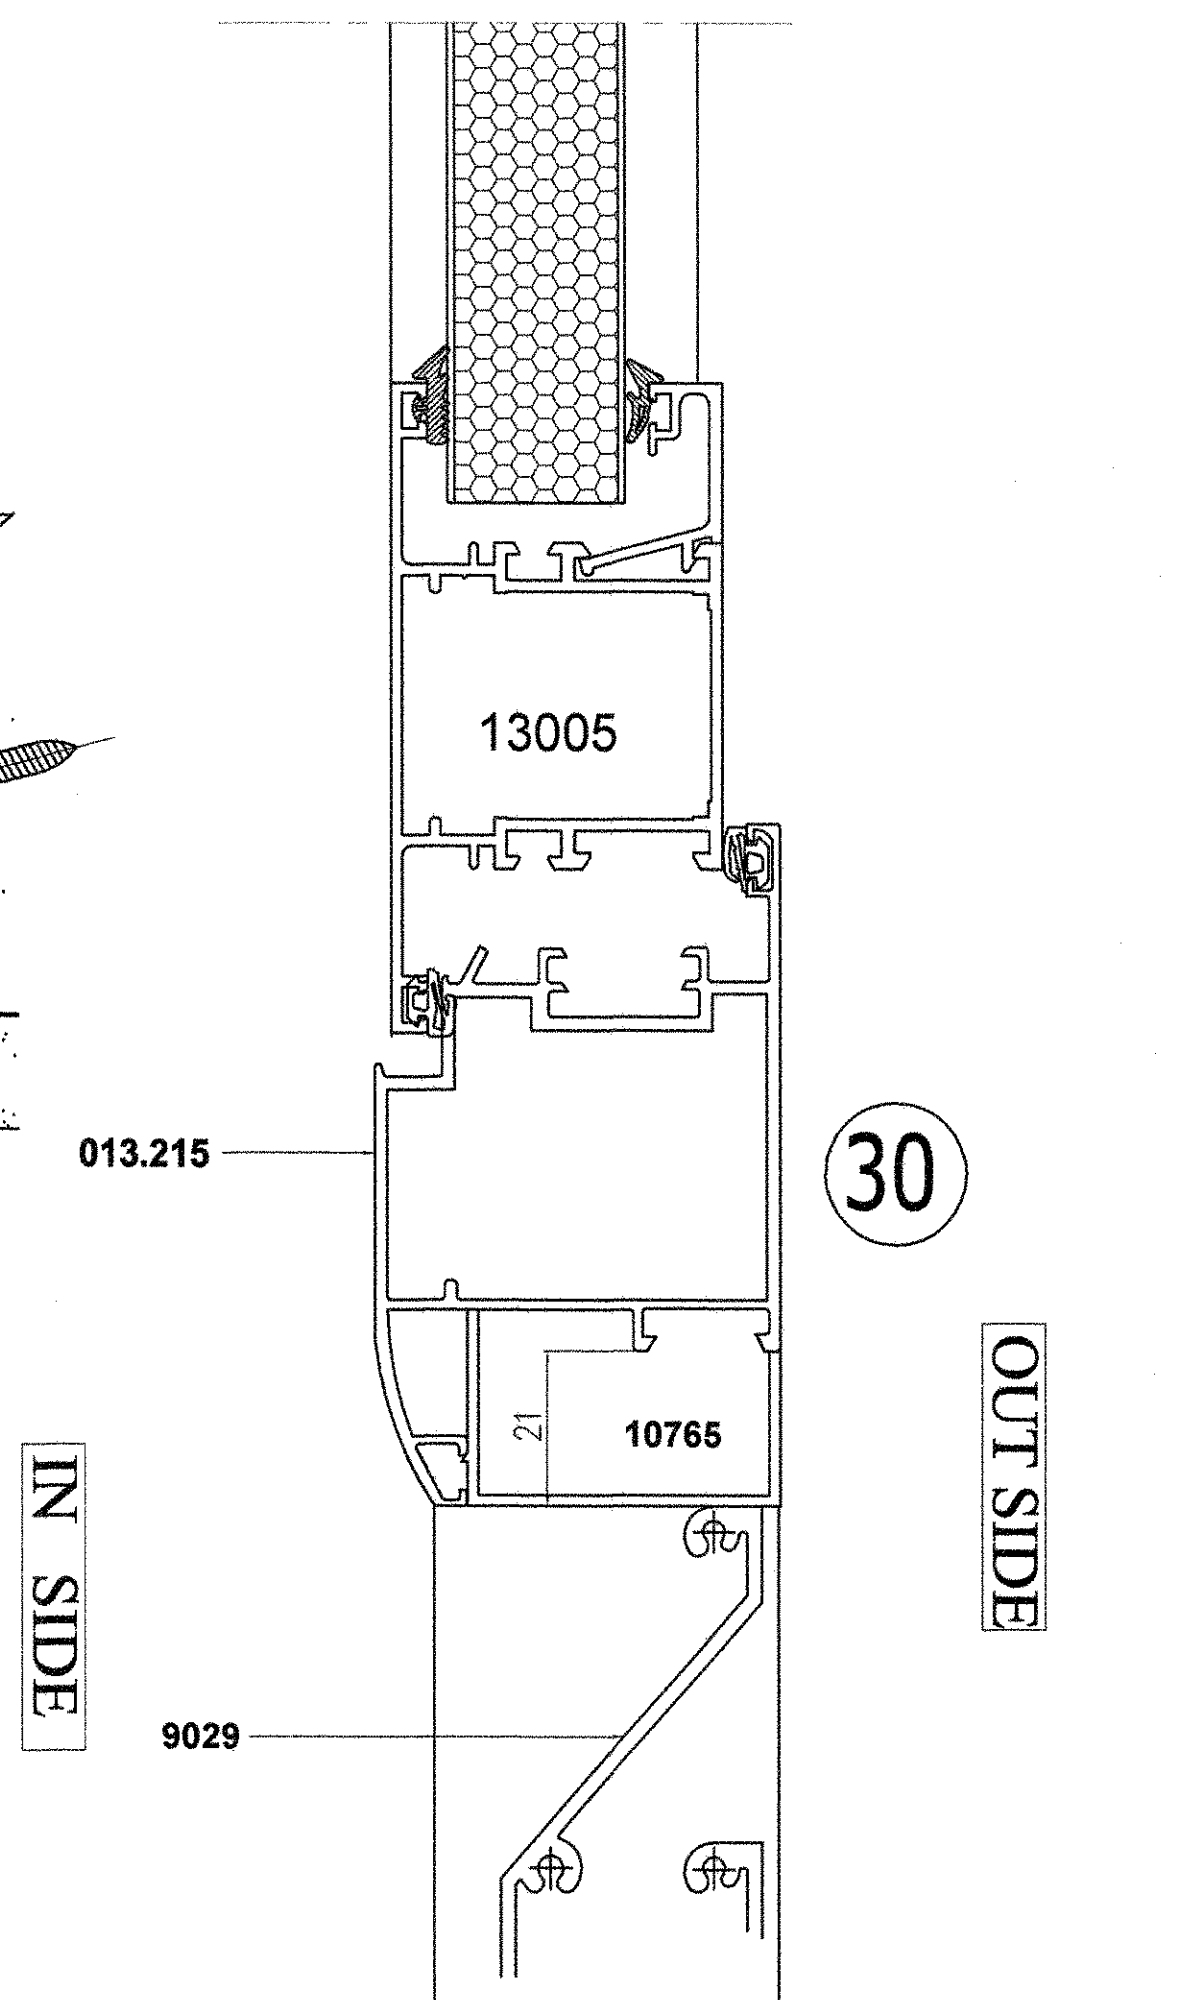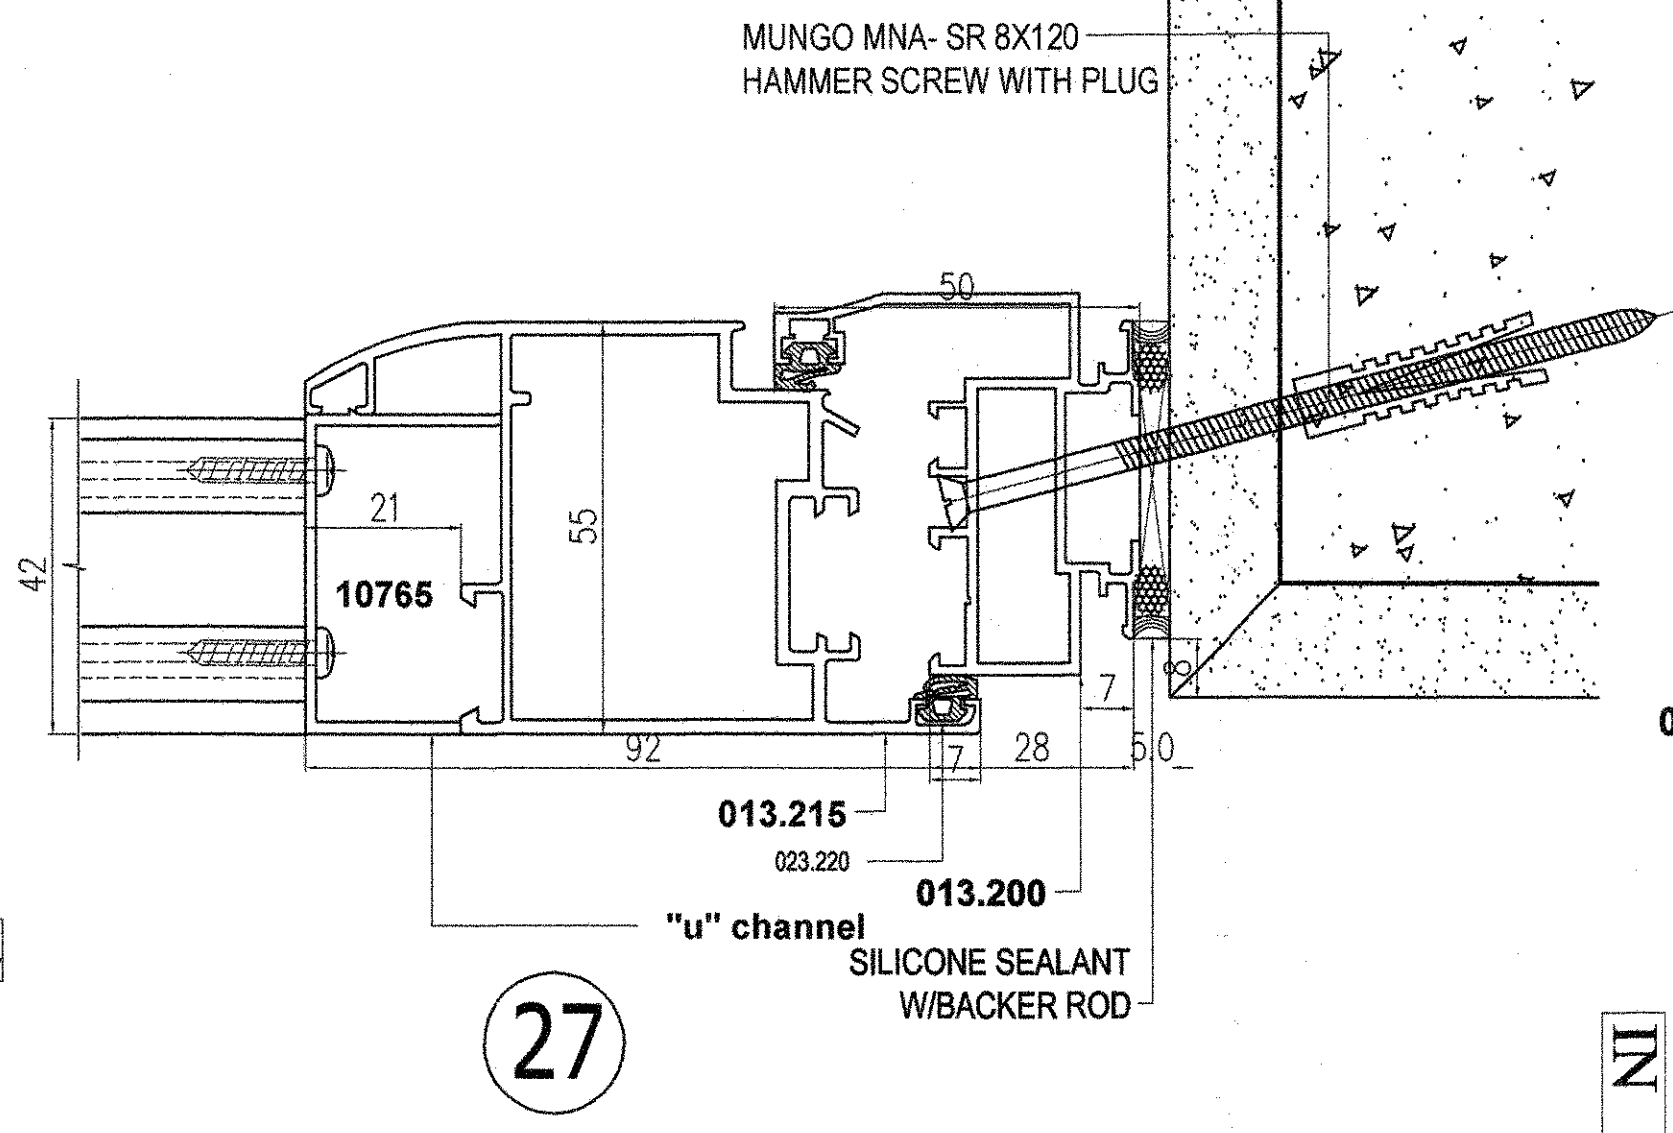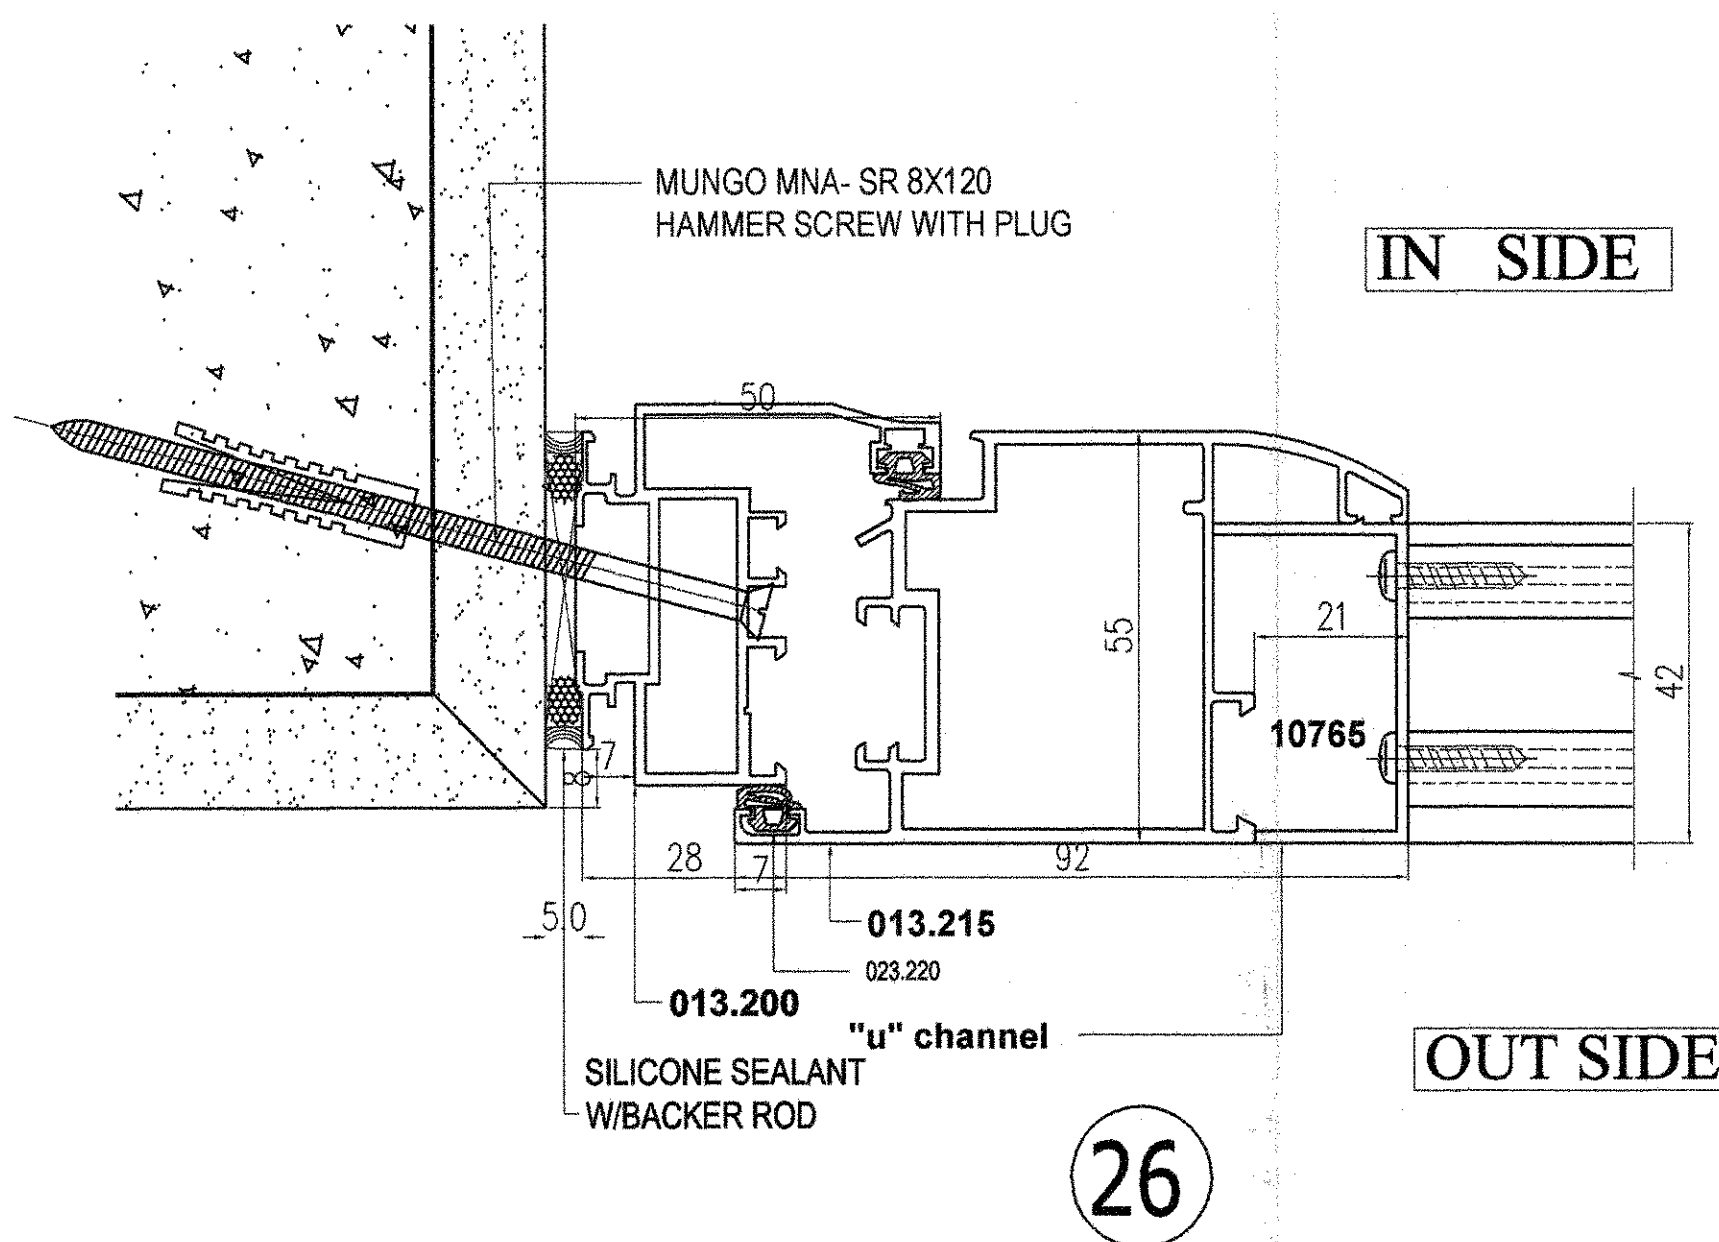

dar al-handasah Sheir and Partners	
☐ CODE 1	APPROVED
☐ CODE 2	APPROVED AS NOTED WORK MAY PROCEED SUBJECT TO INCORPORATION OF ENDORSED COMMENTS
☐ CODE 3	RESUBMIT FOR APPROVAL WORK MAY NOT PROCEED
☐ CODE 4	REJECTED
BY: _____ DATE: _____	
Approval seal not relieve the contractor of any of his obligations under the Contract or constitute authorization of any change to Contract Documents or variation to the work. Contractor is responsible for dimensions, quantities and coordination with other trades.	

AS BUILT DRAWING

JUMEIRAH PARK

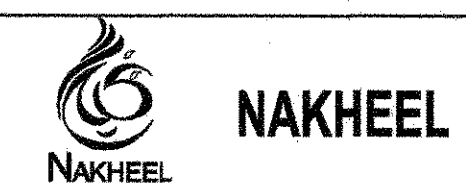

PACKAGE - 2

Cluster - 1

PACKAGE - 2A


Clusters - 1, 3 (Villas 51 to 62), 4, 5, 7 (Villas 33 to 41),
8, 9, 10, 11, 12, 13, 14, 15 (Villas 1 to 14) & 16

ALUMINIUM LOUVRE DETAILS

Drawn: IBRAHIM Review: Eng. Ziad Checked: GUGAN

Scale: 1:1 Date: 13-06-2012

Drawing No. PME / JP / AB / LE / ALU / 013A

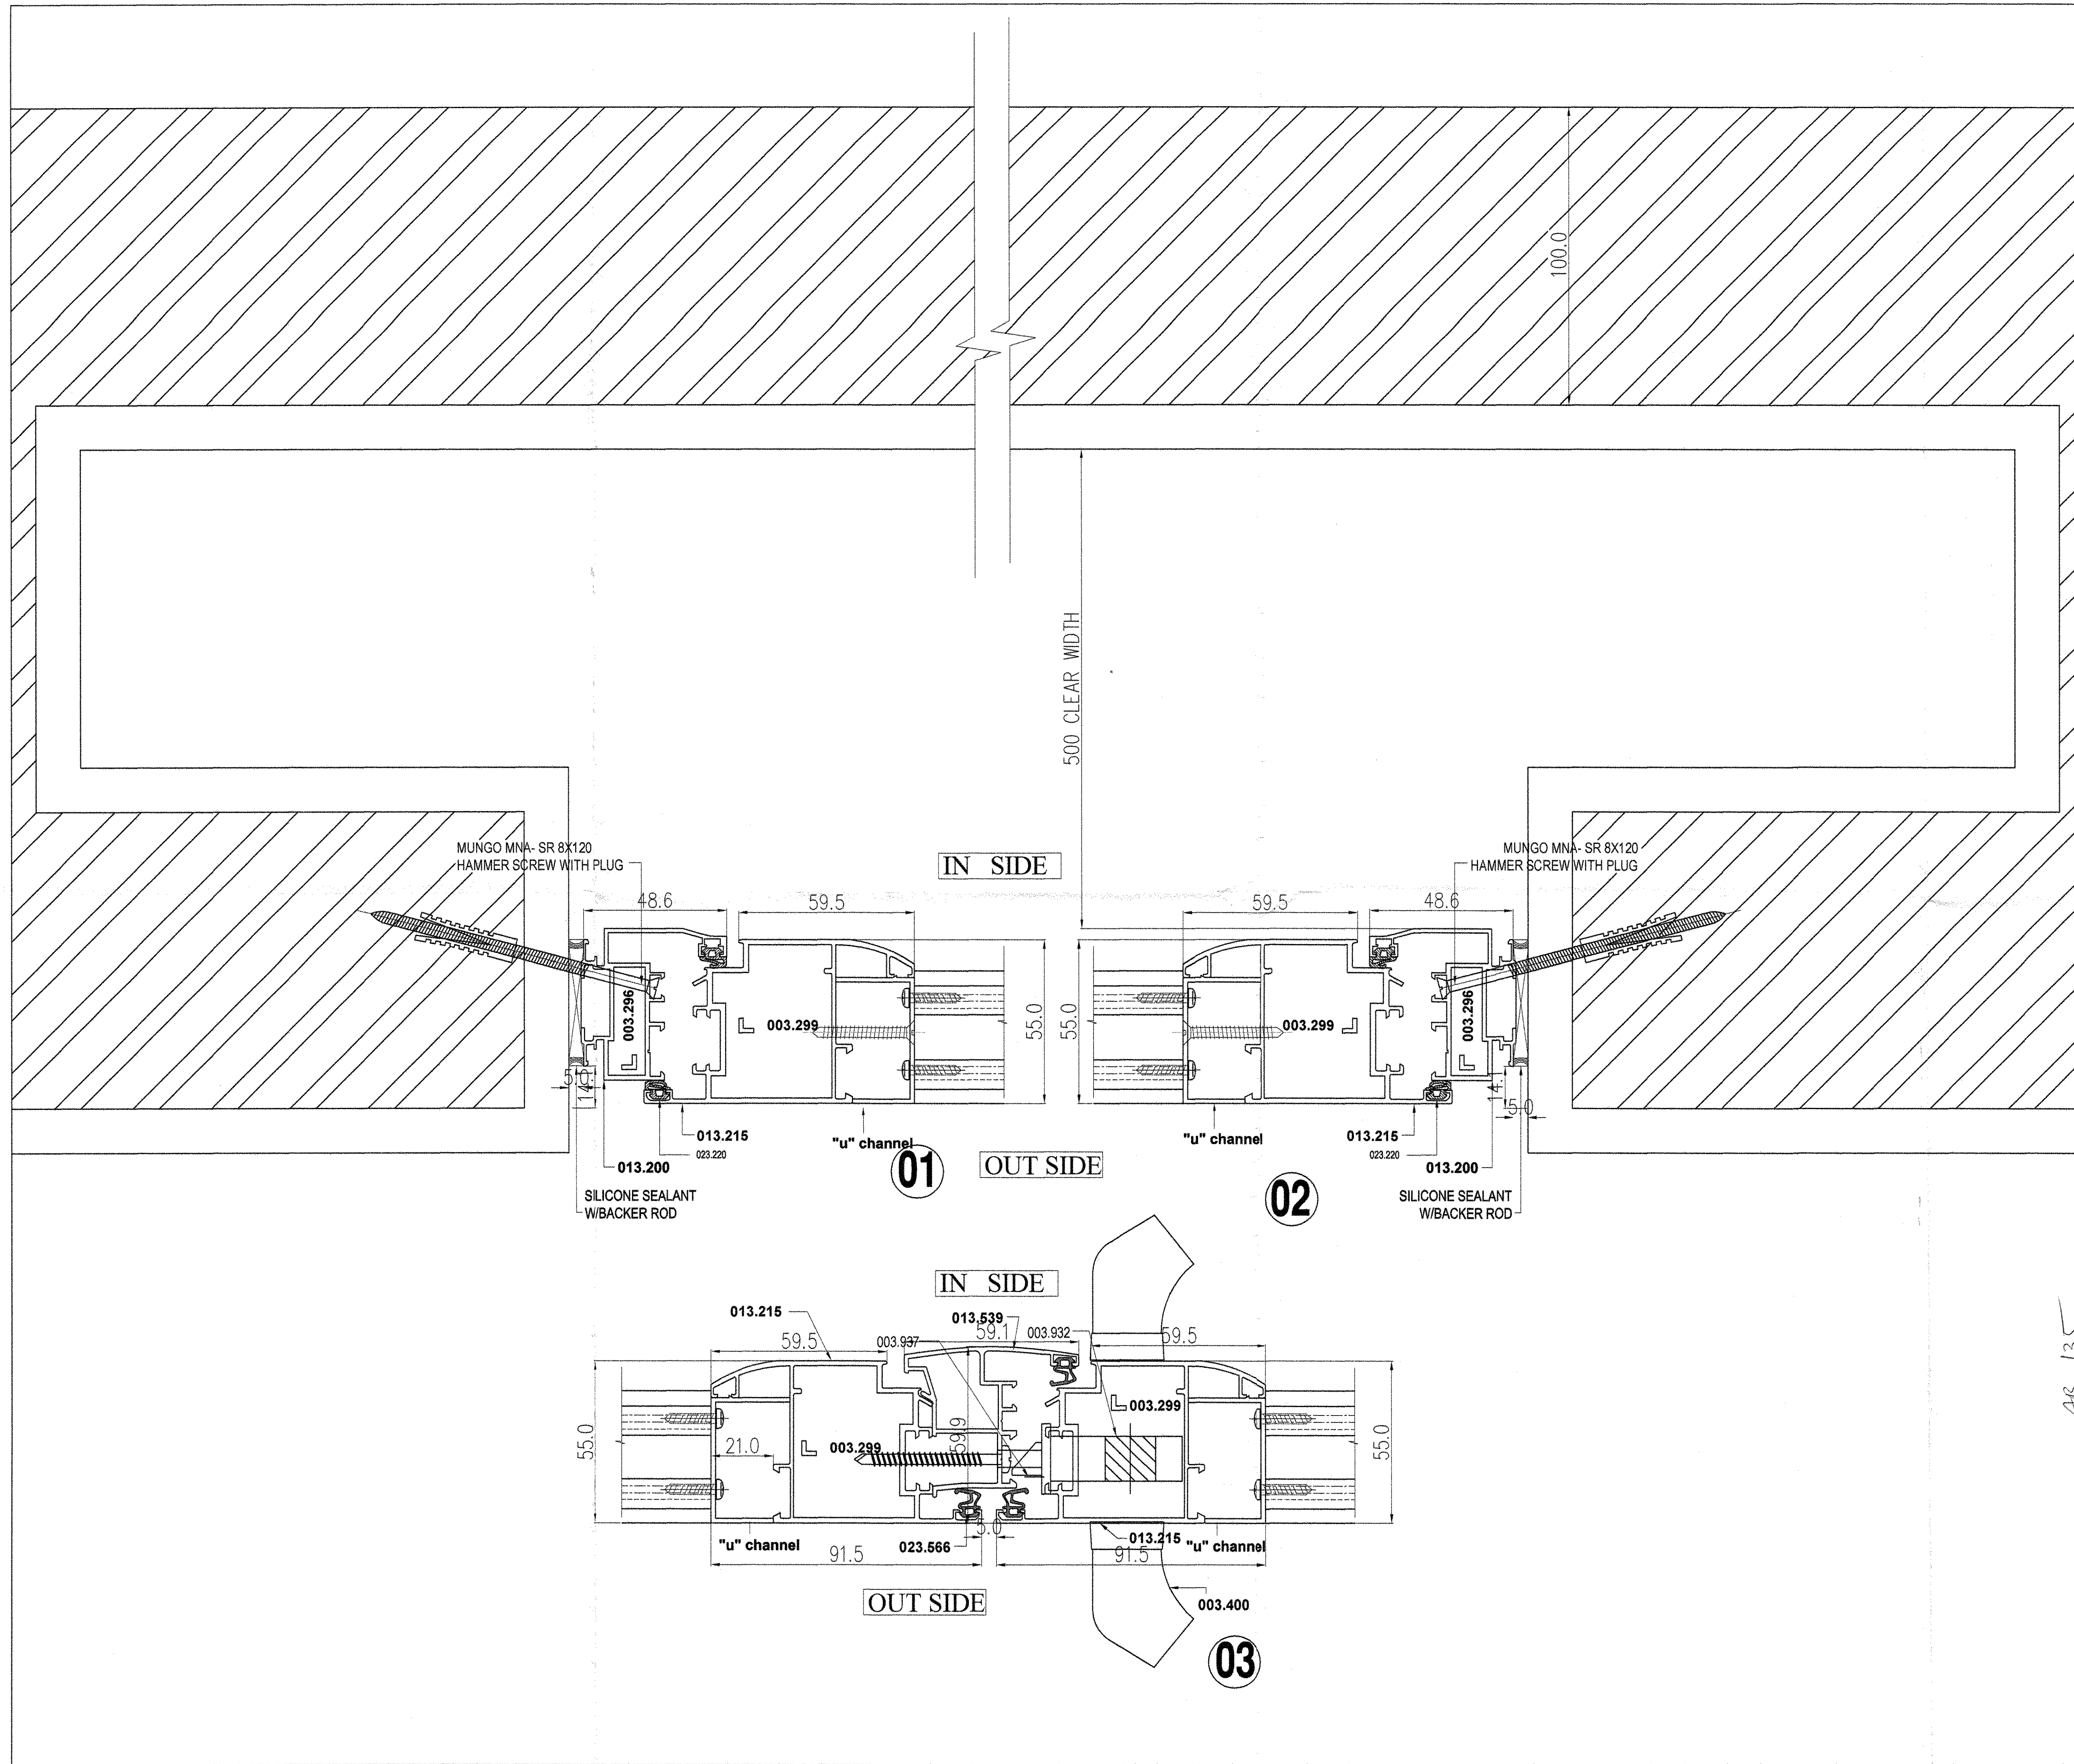

dar al-handasah
Shair and Partners

☒ CODE 1 APPROVED
☐ CODE 2 APPROVED AS NOTED
 WORK MAY PROCEED SUBJECT TO
 INCORPORATION OF ENDORSED
 COMMENTS
☐ CODE 3 RESUBMIT FOR APPROVAL
 WORK MAY NOT PROCEED
☐ CODE 4 REJECTED

BY: _____ DATE: _____

Approval shall not relieve the contractor of any of his
 obligations under the Contract or constitute authorization of
 any change to Contract Documents or variation to the work.
 Contractor is responsible for dimensions, quantities and
 coordination with other trades.

13 JUN 2012



AS BUILT DRAWING

Project
JUMEIRAH PARK

Employer
NAKHEEL
P.O. BOX: 17777, DUBAI, U.A.E.
PHONE: + 971-4-3503300
FAX: + 971-4-3503335
Website: www.nakheel.ae
E-MAIL: info@nakheel.ae

Consultant
dar al-handasah
shair and partners
P.O. BOX: 5924, DUBAI, U.A.E.
PHONE: + 971-4-3333302
FAX: + 971-4-3333321
www.daralhandasah.com

Main Contractor
Pauling Middle East
P.O. BOX: 45176, ABU DHABI, U.A.E.
PHONE: + 971-2-4539923
FAX: + 971-2-4539923
E-MAIL: pauling@middleeast.net.ae


Sub Contractor
WHITE ALUMINIUM ENT.
P.O. BOX: 2402, ABU DHABI, U.A.E.
PHONE: + 971-2-5545500
FAX: + 971-2-5545502

Package
PACKAGE - 2
Cluster - 1

PACKAGE - 2A
Clusters - 1, 3 (Villas 51 to 62), 4, 5, 7 (Villas 33 to 41),
8, 9, 10, 11, 12, 13, 14, 15 (Villas 1 to 14) & 16

Drawing Title
Details For Louver Door

Drawn IBRAHIM	Review Eng. Ziad	Checked: GUGAN
Scale: 1:1	Date: 13-06-2012	
Drawing No. PME / JP / AB / LE / ALU / 015A		

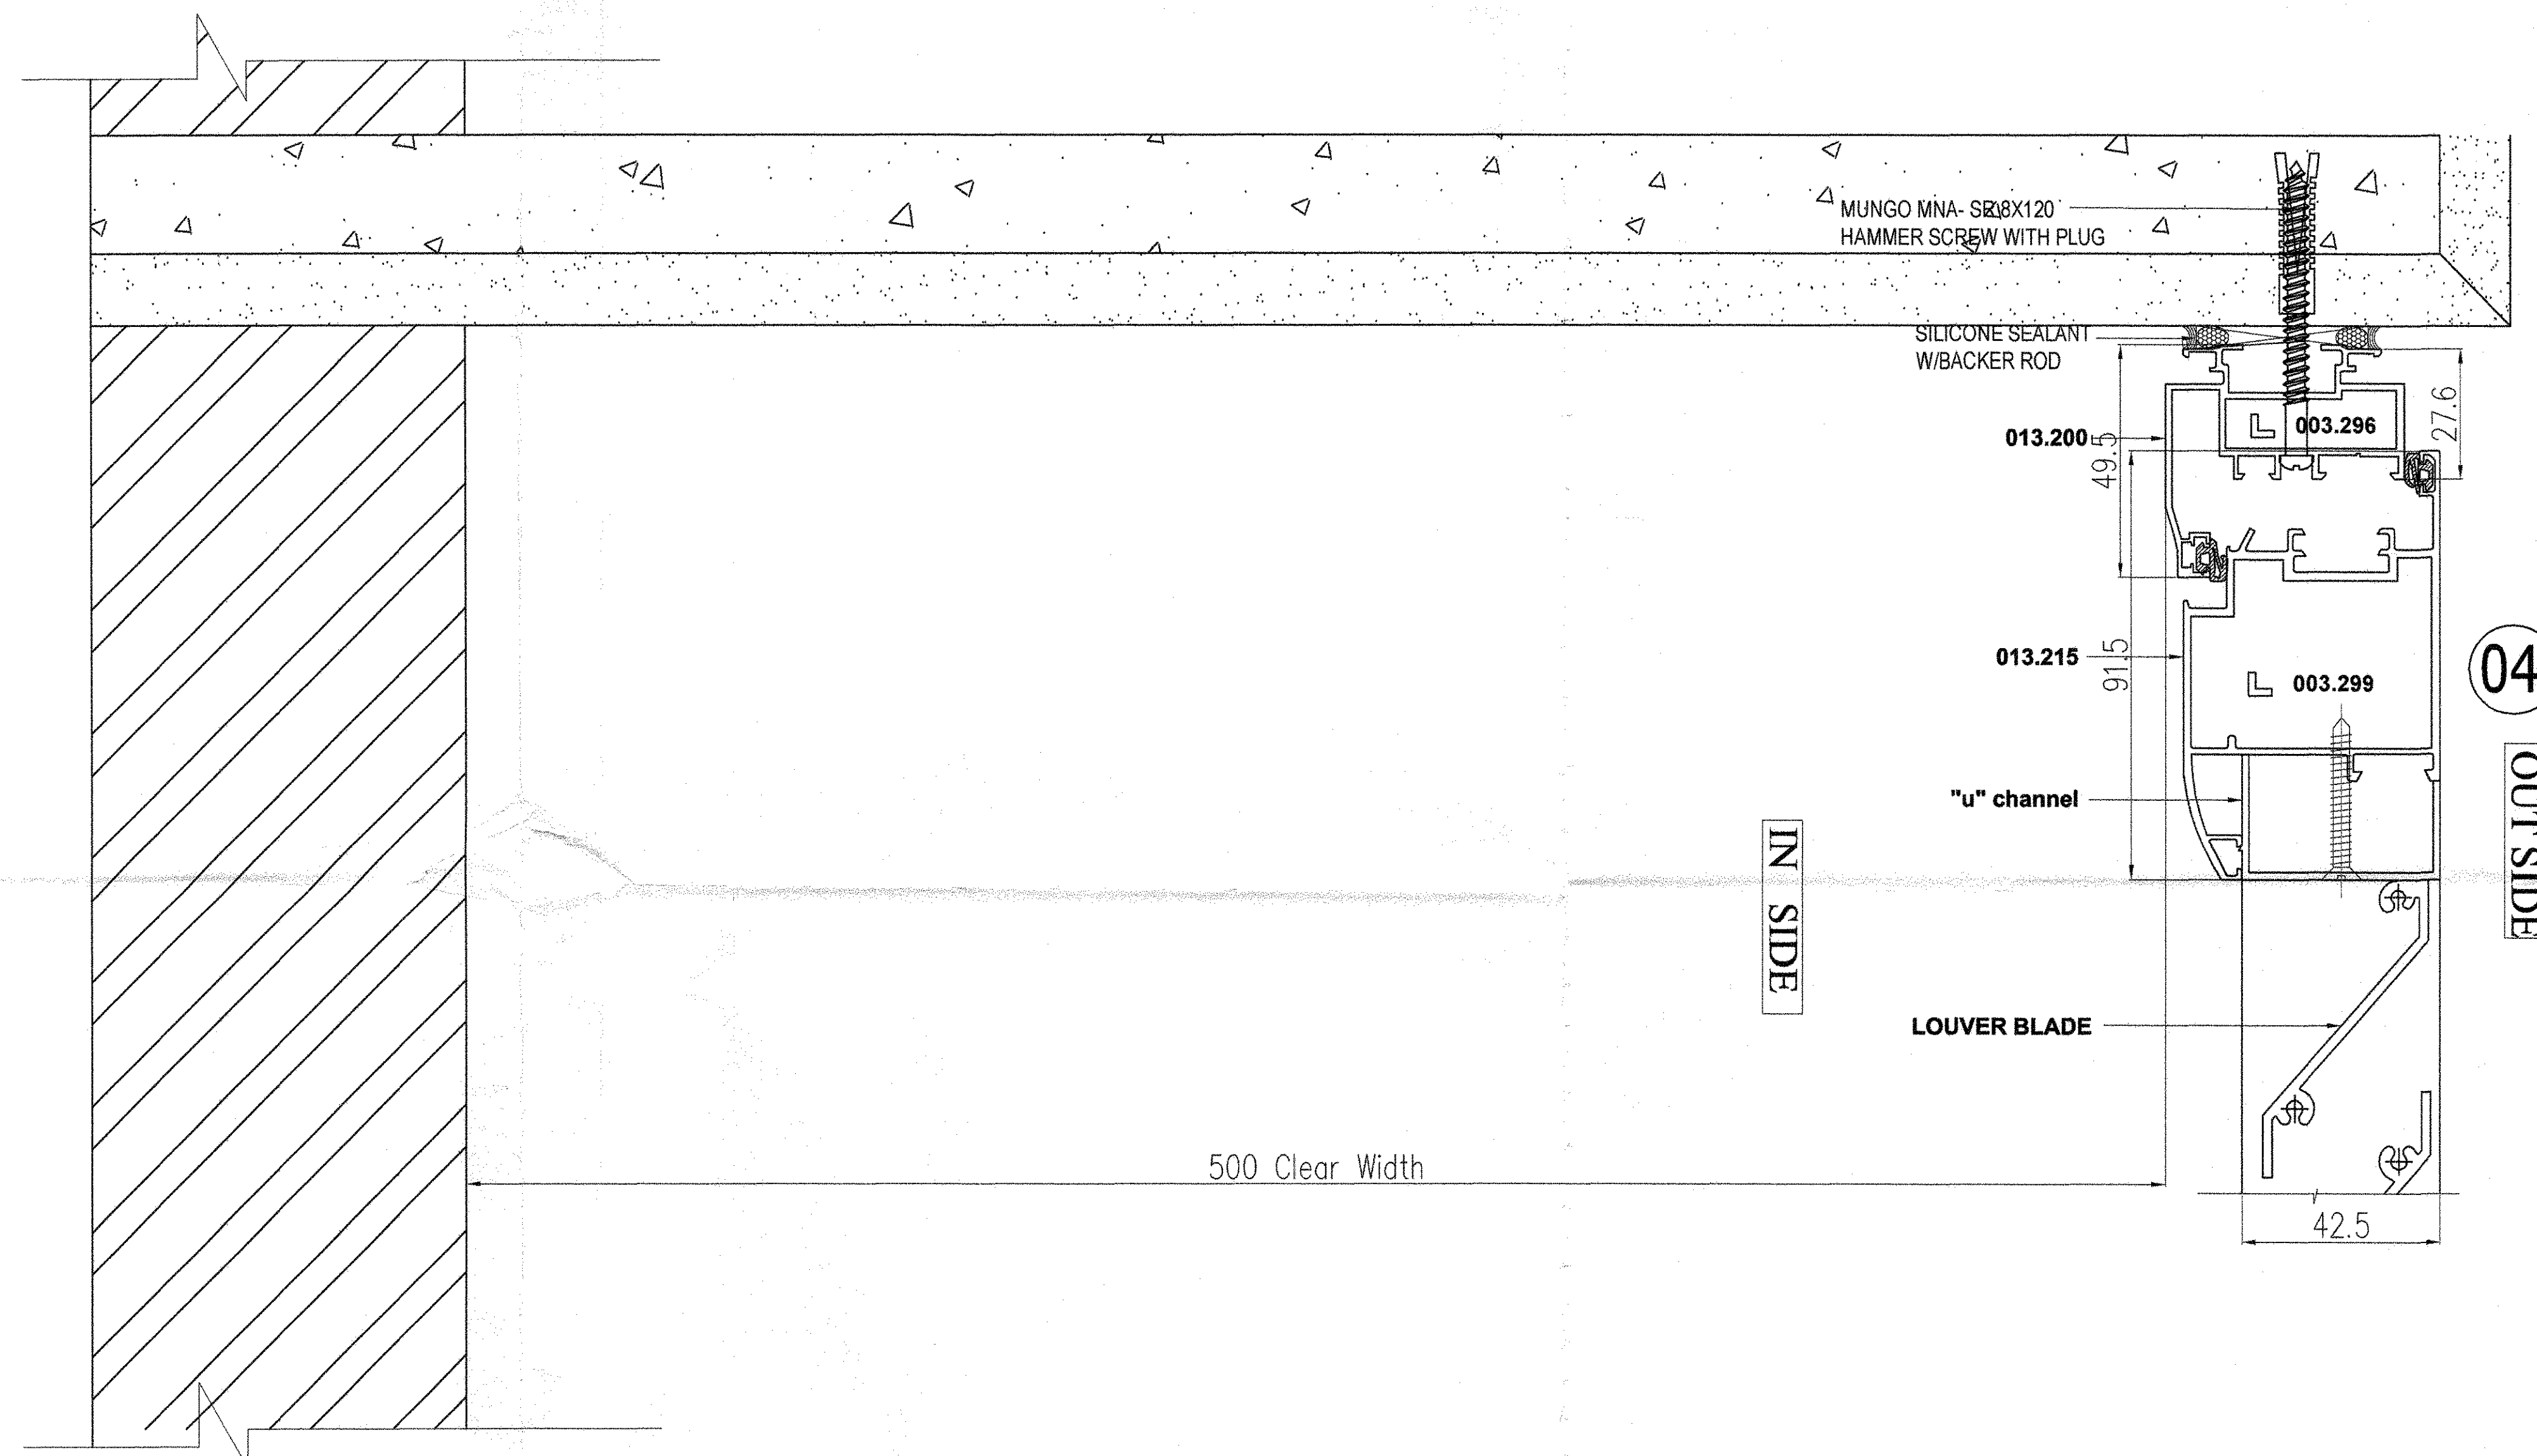

dar al-handasah
Shair and Partners

CODE 1 ☒ APPROVED
CODE 2 ☐ APPROVED AS NOTED
CODE 3 ☐ RESUBMIT FOR APPROVAL
CODE 4 ☐ REJECTED

BY: _____ DATE: _____

Approval shall not relieve the contractor of any of his obligations under the Contract or constitute authorization of any change to Contract Documents or variation to the works. Contractor is responsible for maintaining the quality and coordination with all relevant authorities.



AS BUILT DRAWING

Project

JUMEIRAH PARK

Employer



NAKHEEL

P.O. BOX: 17777, DUBAI, U.A.E.
PHONE : + 971 - 4 - 3603388
FAX : + 971 - 4 - 3603335
Website : www.nakheel.ae
E-MAIL : info@nakheel.ae

Consultant



dar al-handasah
shair and partners

P.O. BOX: 55024, DUBAI, U.A.E.
PHONE : + 971 - 4 - 3335302
FAX : + 971 - 4 - 3335312
www.daralhandasah.com

Main Contractor



Pauling Middle East

P.O. BOX: 45176, ABU DHABI, U.A.E.
PHONE : + 971 - 2 - 0229022
FAX : + 971 - 2 - 8755553
E-MAIL : pauling@pauling.net.ae

Sub Contractor



WHITE ALUMINIUM ENT.

P.O. BOX: 3402, ABU DHABI, U.A.E.
PHONE : + 971 - 2 - 5541880
FAX : + 971 - 2 - 5545592

Package

PACKAGE - 2

Cluster - 1

PACKAGE - 2A

**Clusters - 1, 3 (Villas 51 to 62), 4, 5, 7 (Villas 33 to 41),
8, 9, 10, 11, 12, 13, 14, 15 (Villas 1 to 14) & 16**


Drawing Title

Details For Louver Door

Drawn: IBRAHIM	Review: Eng. Ziad	Checked: GUGAN
----------------	-------------------	----------------

Scale: 1:1	Date: 13-06-2012
------------	------------------

Drawing No. **PME / JP / AB / LE / ALU / 016A**

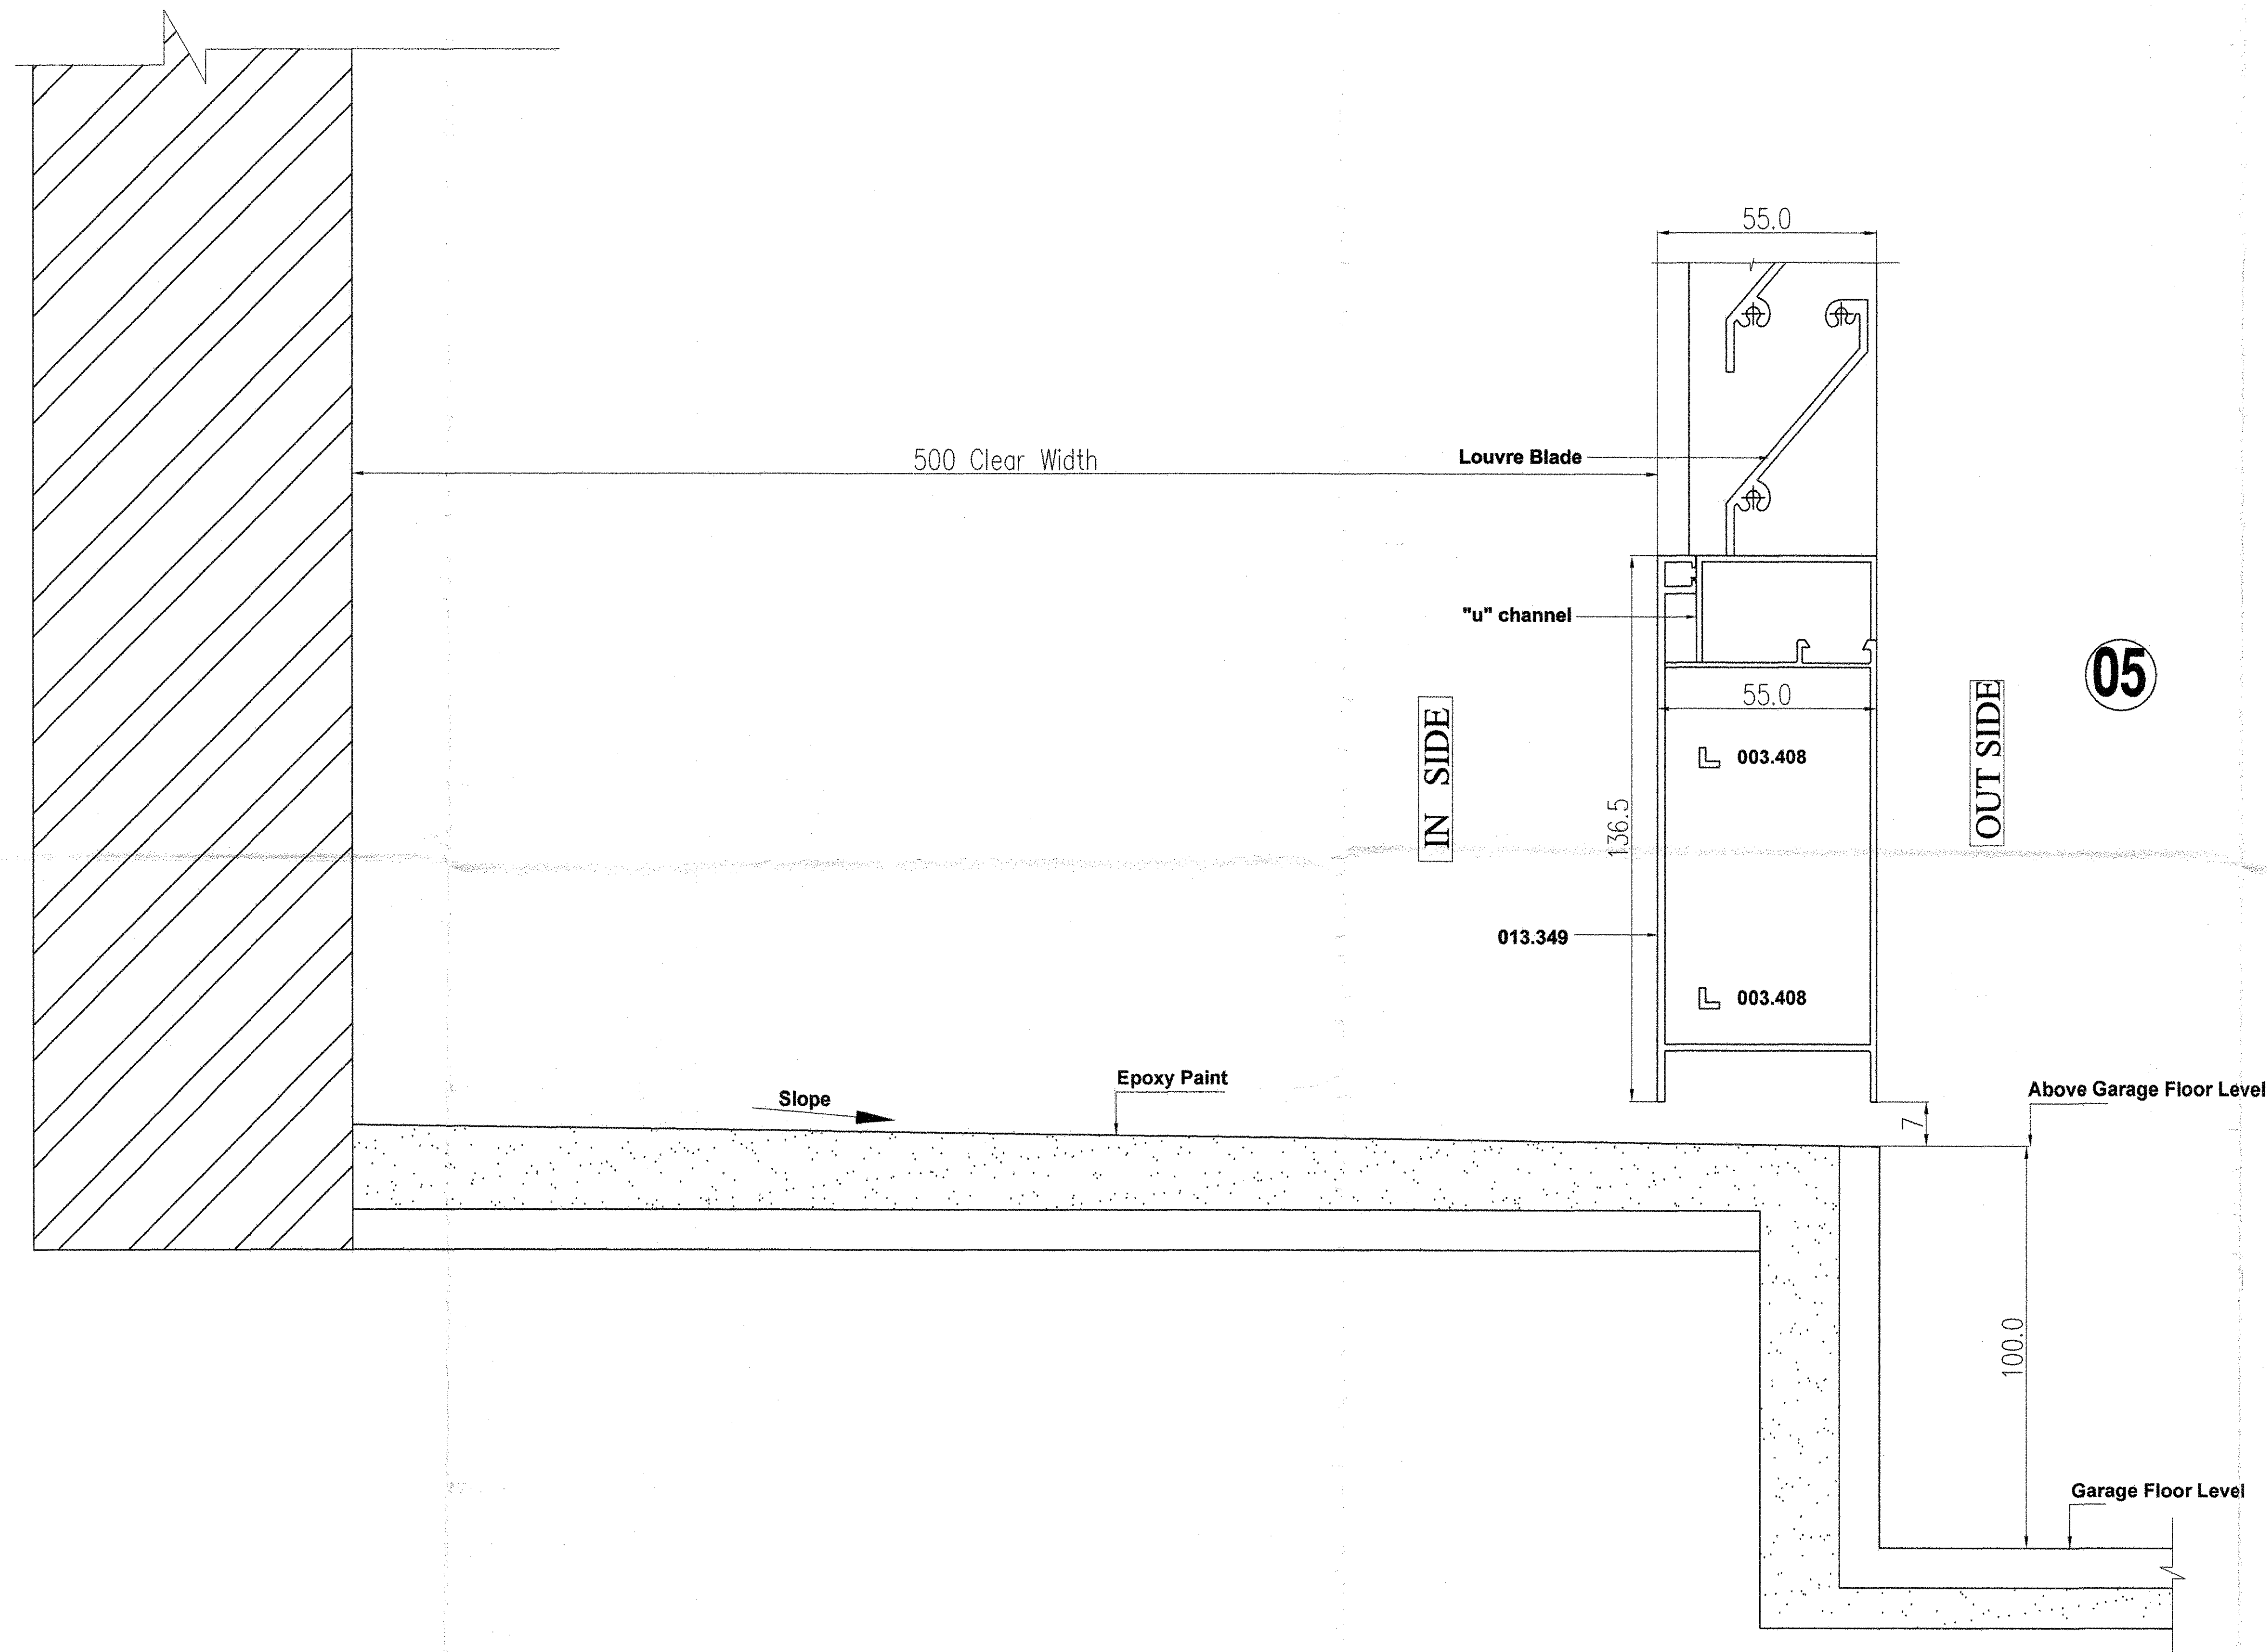

dar al-handasah Shear and Partners	
☒ CODE 1	APPROVED
☐ CODE 2	APPROVED AS NOTED WORK MAY PROCEED SUBJECT TO INCORPORATION OF ENDORSED COMMENTS
☐ CODE 3	RESUBMIT FOR APPROVAL WORK MAY NOT PROCEED
☐ CODE 4	REJECTED
BY:	DATE:
Approval shall not relieve the contractor of any of his obligations under the Contract or constitute authorization of any change to Contract Documents or violation to the work. Contractor is responsible for dimensions, quantities and coordination with other trades.	



AS BUILT DRAWING

JUMEIRAH PARK



NAKHEEL

Employer
P.O. BOX: 17777, DUBAI, U.A.E.
PHONE: + 971-4-360388
FAX: + 971-4-360355
Website: www.nakheel.ae
E-MAIL: info@nakheel.ae



dar al-handasah
shear and partners

Consultant
P.O. BOX: 55604, DUBAI, U.A.E.
PHONE: + 971-4-335302
FAX: + 971-4-335303
www.daralhandasah.com



Pauling Middle East

Main Contractor
P.O. BOX: 60176, ABU DHABI, U.A.E.
PHONE: + 971-2-629922
FAX: + 971-2-629933
E-MAIL: pauling@paulingmiddleeast.ae



WHITE ALUMINIUM ENT.

Sub Contractor
P.O. BOX: 2402, ABU DHABI, U.A.E.
PHONE: + 971-2-554580
FAX: + 971-2-554582

PACKAGE - 2

Cluster - 1

PACKAGE - 2A



Clusters - 1, 3 (Villas 51 to 62), 4, 5, 7 (Villas 33 to 41),
8, 9, 10, 11, 12, 13, 14, 15 (Villas 1 to 14) & 16

Drawing Title

Details For Louver Door

Drawn	IBRAHIM	Review	Eng. Ziad	Checked:	GUGAN
Scale:	1:1	Date:	13-06-2012		

Drawing No. **PME / JP / AB / LE / ALU / 017A**

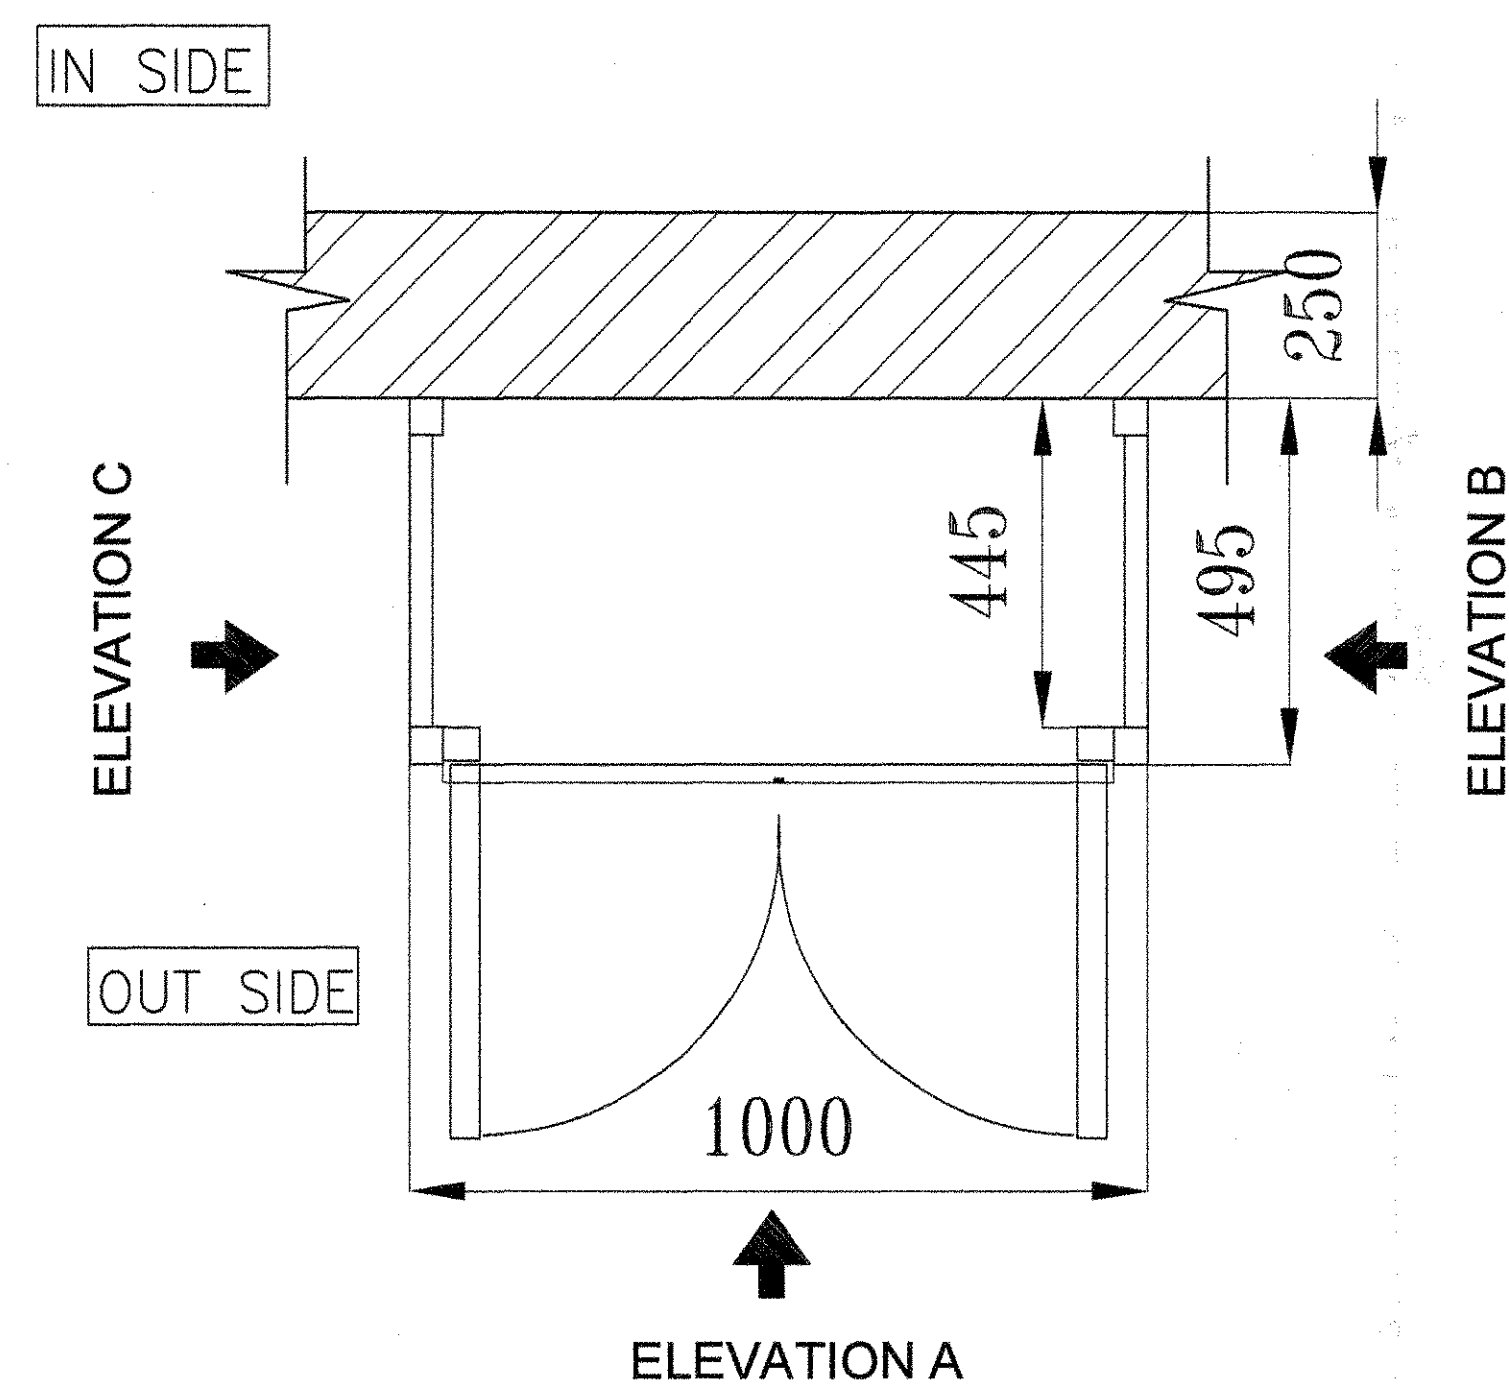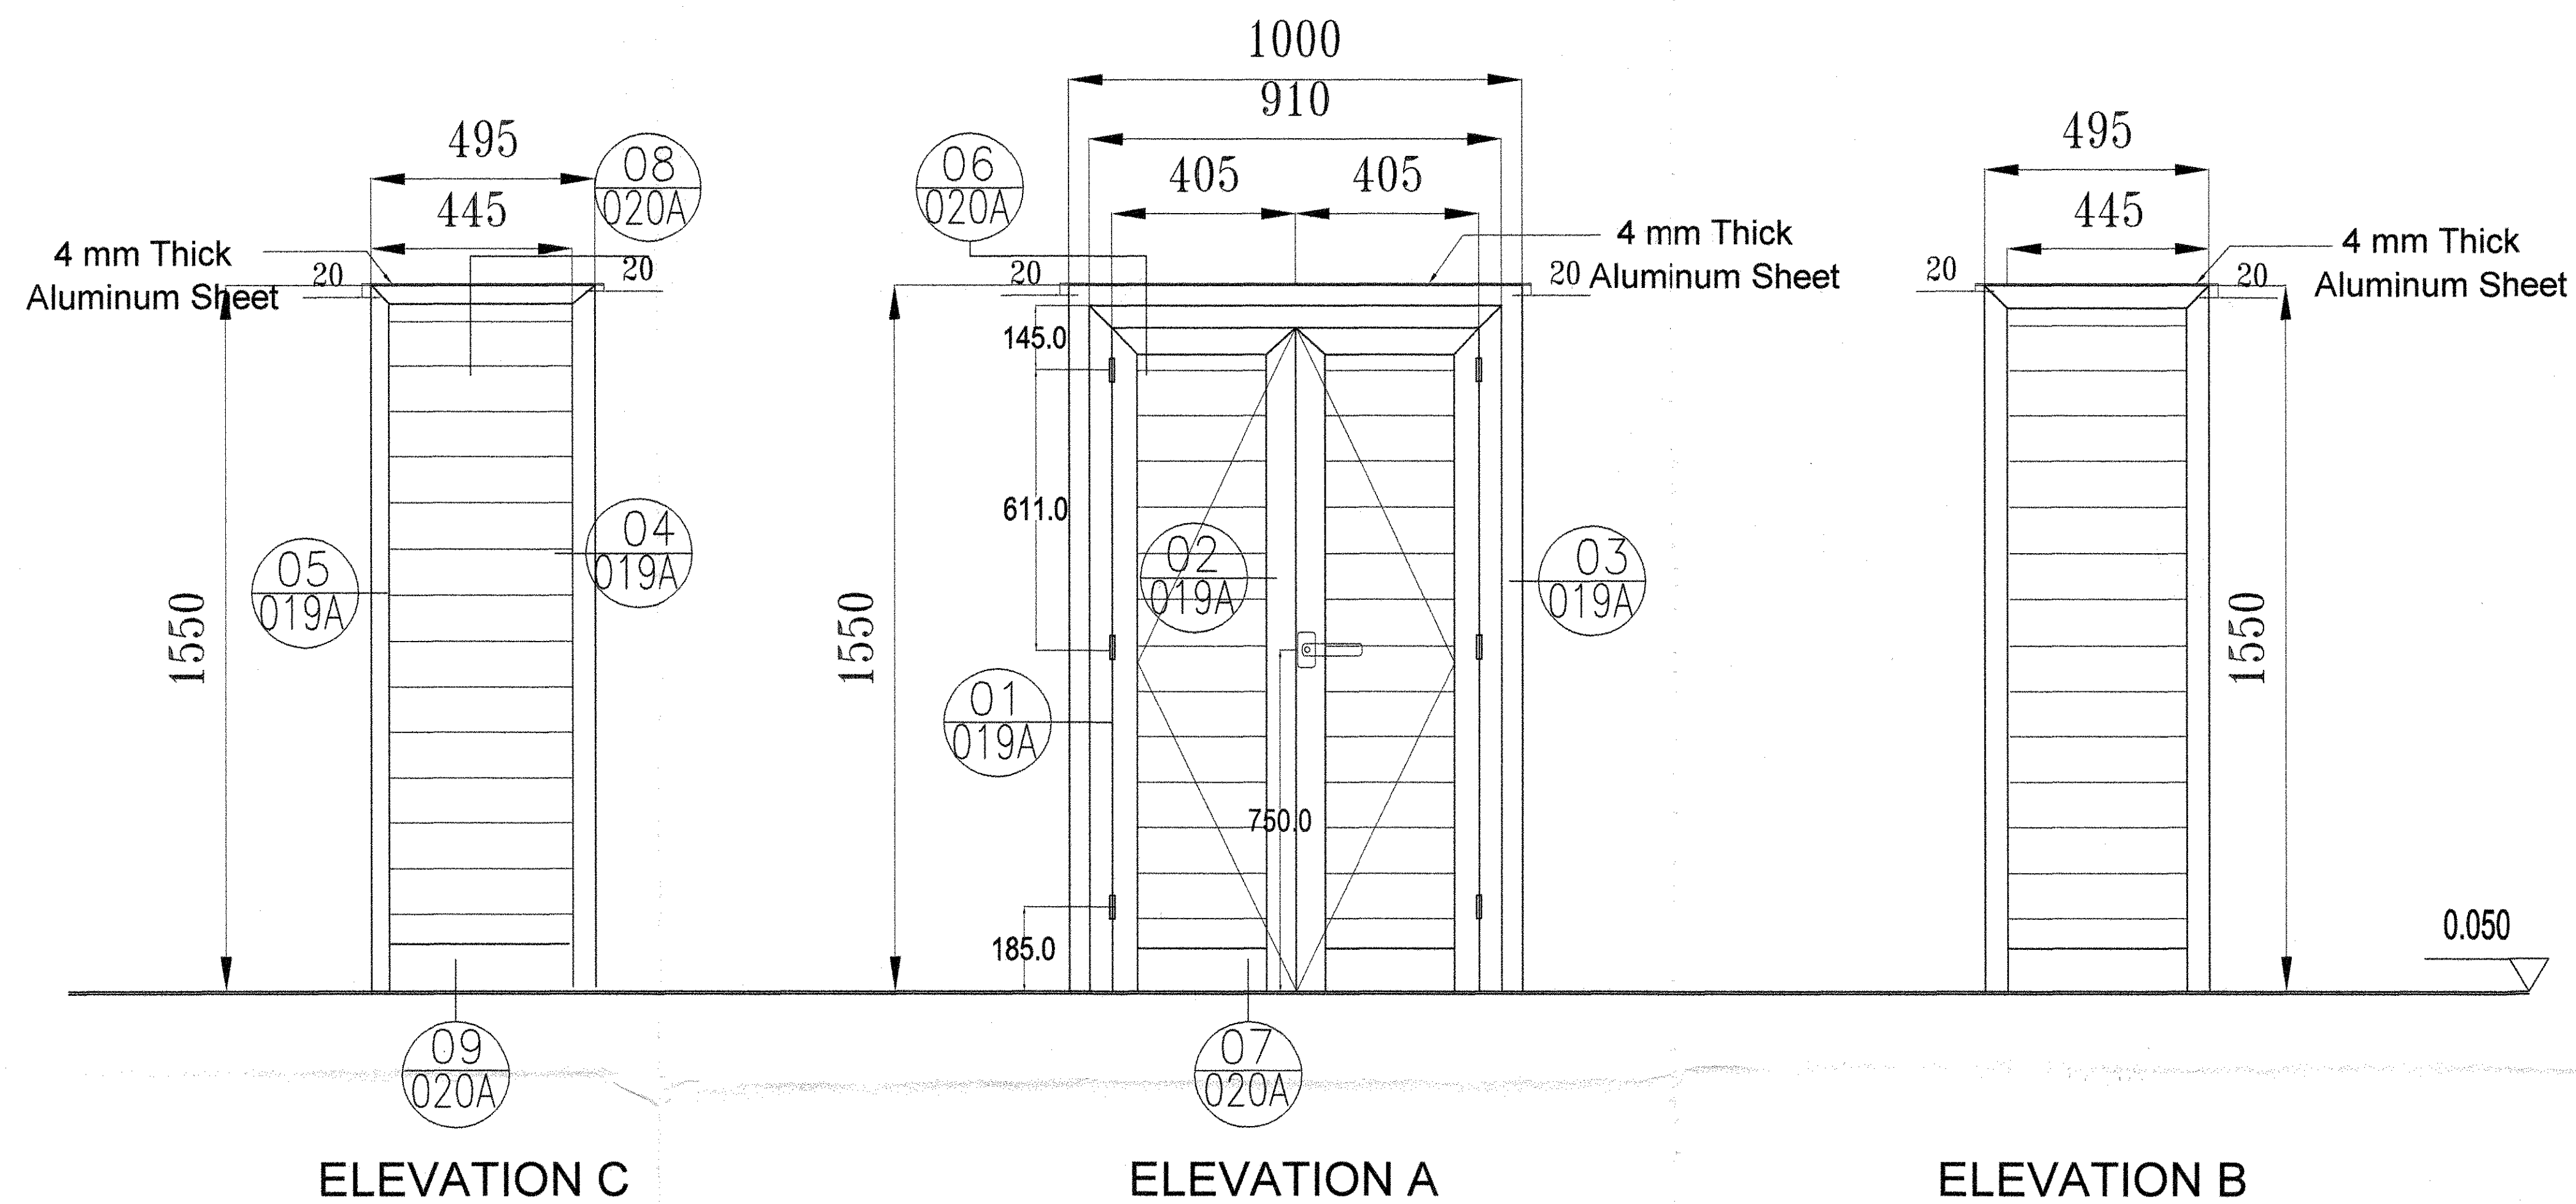

ITEM: GR
G.FLR-GAS ROOM
QTY: 1 NO

dar al-handasah sheir and partners	
☐ CODE 1	APPROVED
☐ CODE 2	APPROVED AS NOTED WORK MAY PROCEED SUBJECT TO INCORPORATION OF ENDORSED COMMENTS
☐ CODE 3	RESUBMIT FOR APPROVAL WORK MAY NOT PROCEED
☐ CODE 4	REJECTED
BY:	DATE:
Approval shall not relieve the contractor of any of his obligations under the Contract or constitute authorization of any change to Contract Documents or variation to the works. Contractor is responsible for dimensions, quantities and coordination with other trades.	

Hardware For Door & Windows

1. Louvre Door Handle - Giesse - 2462
2. Louvre Door Hinge - Giesse - 00120N
3. Louvre Door Lock - Welka - 101 30 01 0

Note:

Reference No. of Detail

Reference No. of
Drawing Sheet

AS BUILT DRAWING

JUMEIRAH PARK

NAKHEEL

dar al-handasah
sheir and partners

Pauling Middle East

WHITE ALUMINIUM ENT.

PACKAGE - 2

Cluster - 1


PACKAGE - 2A

Clusters - 1, 3 (Villas 51 to 62), 4, 5, 7 (Villas 33 to 41),
8, 9, 10, 11, 12, 13, 14, 15 (Villas 1 to 14) & 16

GAS ROOM DOOR ELEVATION

Drawn: IBRAHIM	Review: Eng. Ziad	Checked: GUGAN
Scale: 1:10	Date: 13-06-2012	

Drawing No. **PME / JP / AB / LE / ALU / 018A**

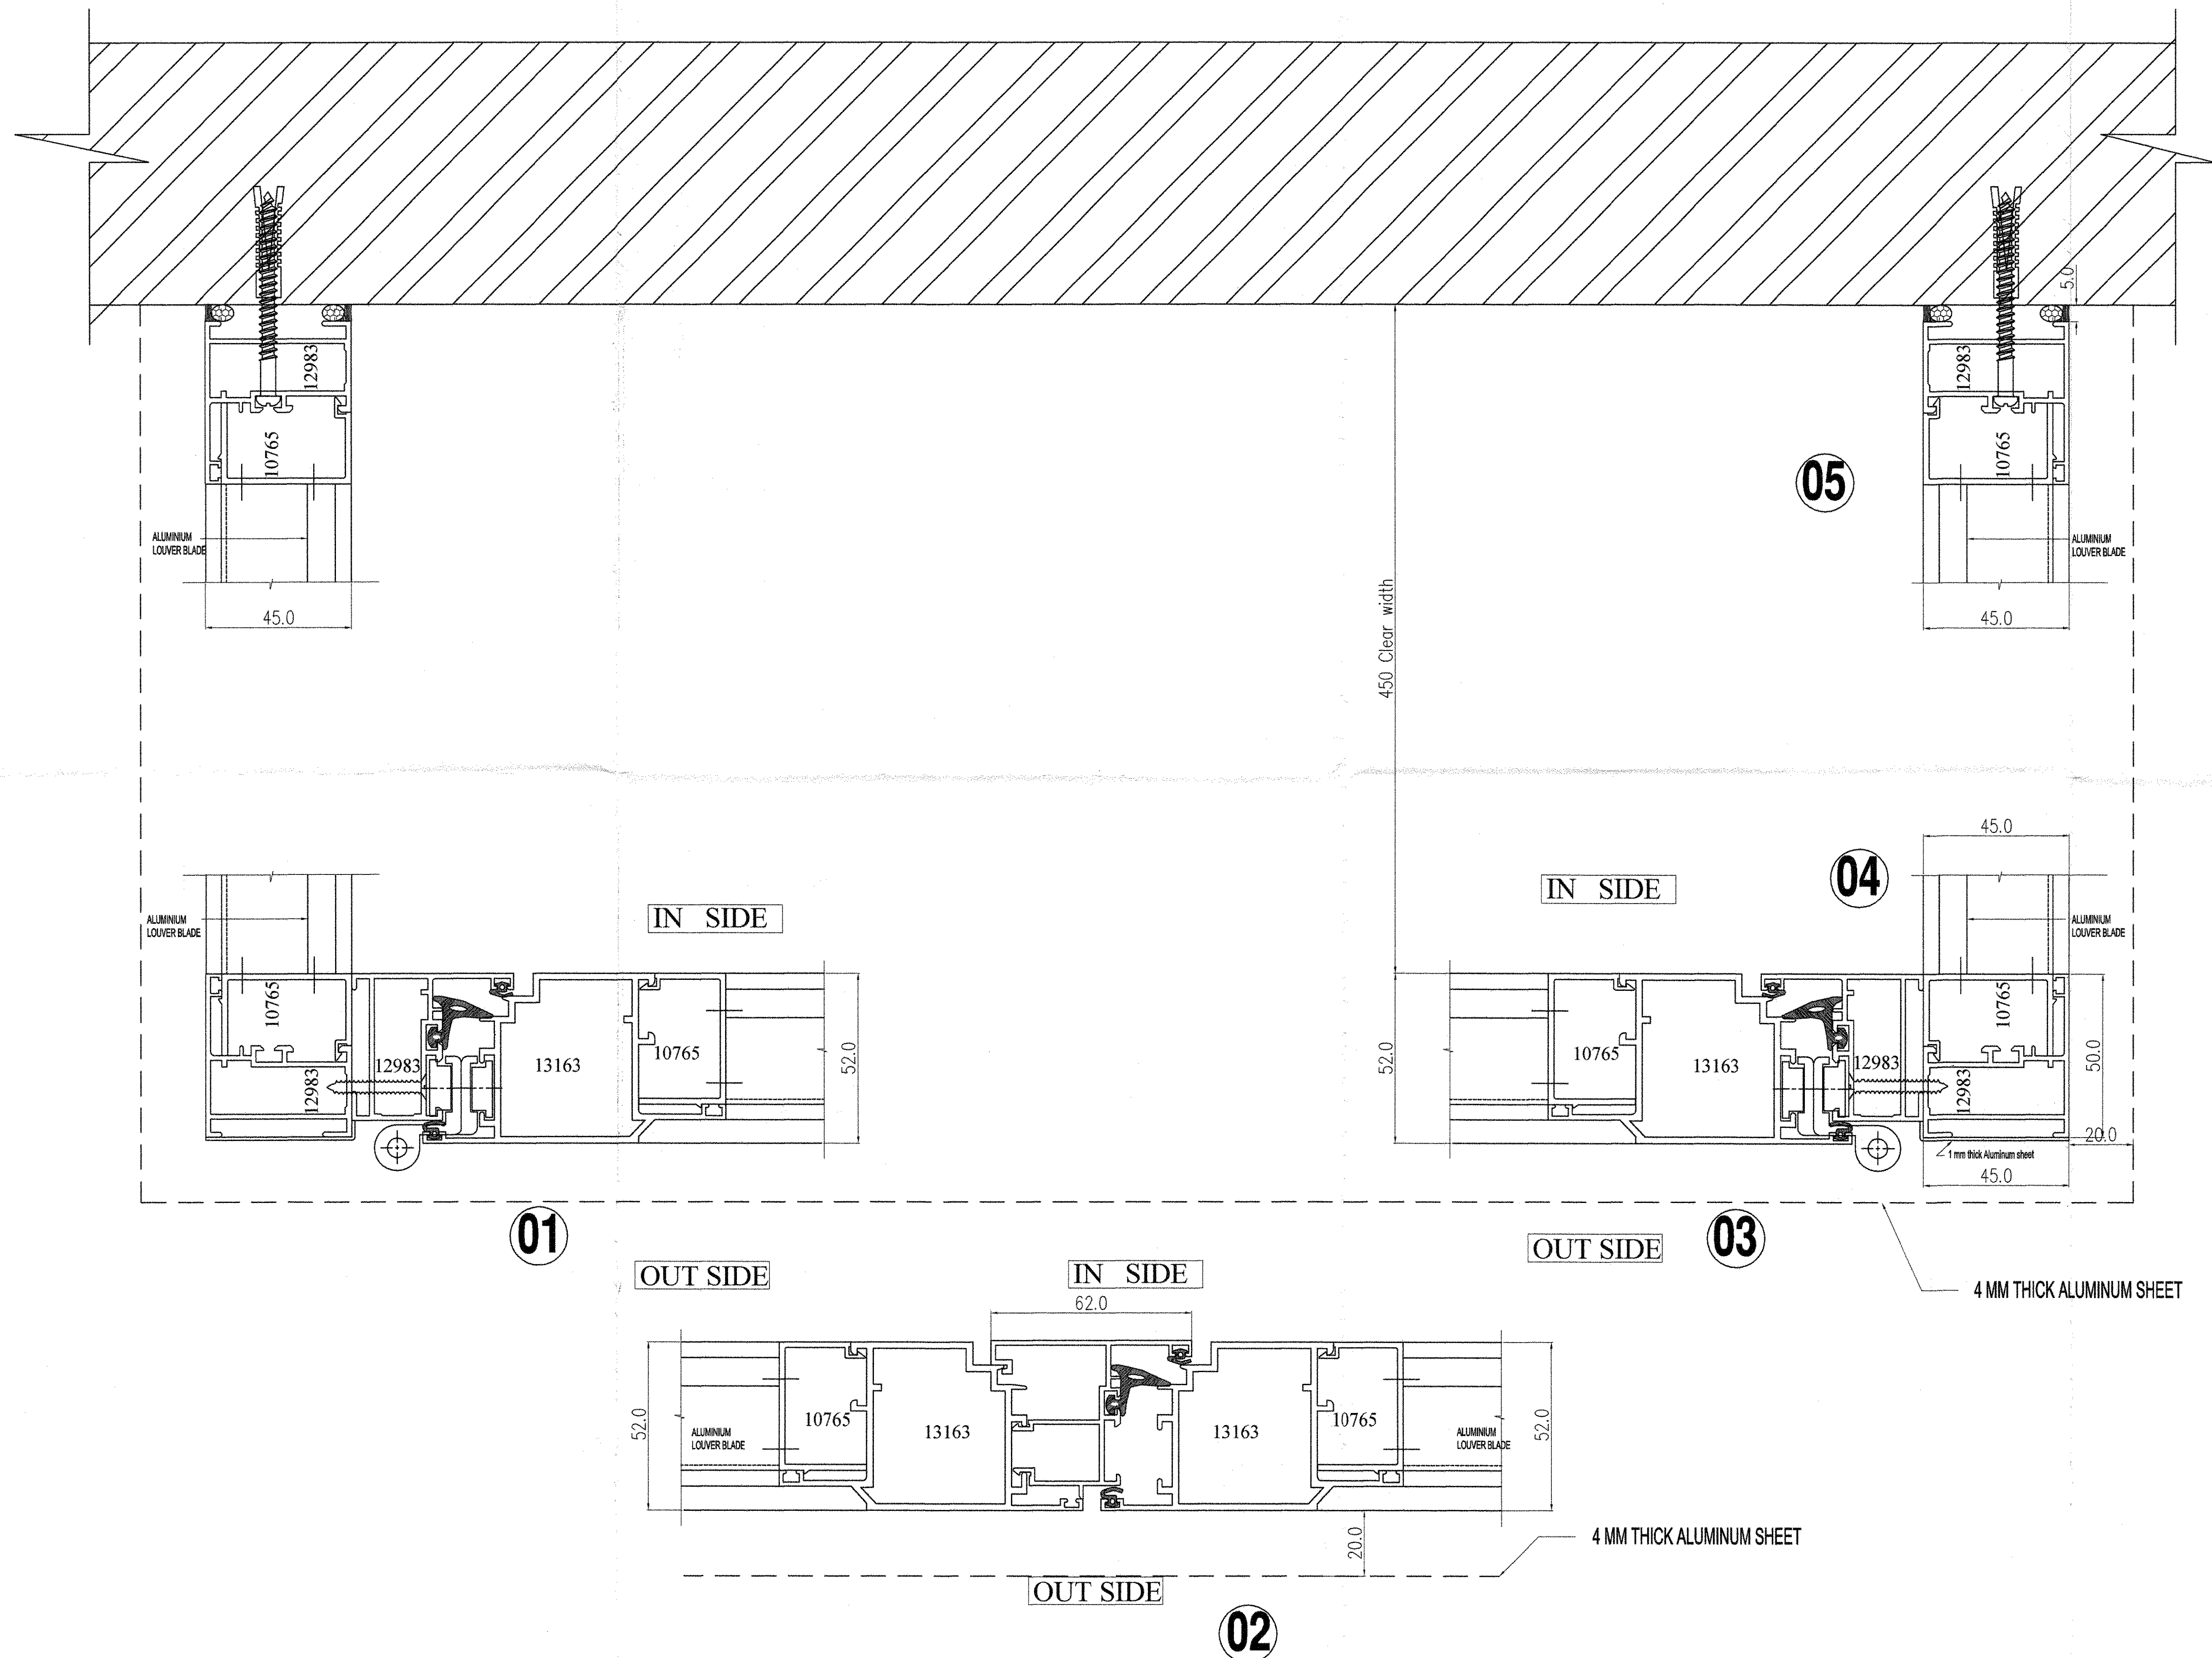

dar al-handasah
Shair and Partners

☐ CODE 1 APPROVED

☐ CODE 2 APPROVED AS NOTED
WORK MAY PROCEED SUBJECT TO
INCORPORATION OF ENDORSED
COMMENTS

☐ CODE 3 RESUBMIT FOR APPROVAL
WORK MAY NOT PROCEED

☐ CODE 4 REJECTED

BY: _____ DATE: _____

Approval shall not relieve the contractor of any of his obligations under the Contract or constitute authorization of any change to Contract Documents or variation to the works. Contractor is responsible for dimensions, quantities and coordination with other trades.



AS BUILT DRAWING

JUMEIRAH PARK



NAKHEEL



dar al-handasah
shair and partners



Pauling Middle East



WHITE ALUMINIUM ENT.

PACKAGE - 2

Cluster - 1

PACKAGE - 2A


Clusters - 1, 3 (Villas 51 to 62), 4, 5, 7 (Villas 33 to 41),
8, 9, 10, 11, 12, 13, 14, 15 (Villas 1 to 14) & 16

**GULF 45-SERIES LOUVER
DOOR ALUMINIUM DETAILS**

Drawn: IBRAHIM Review: Eng. Zied Checked: GUGAN

Scale: 1:1 Date: 13-06-2012

Drawing No. **PME / JP / AB / LE / ALU / 019A**

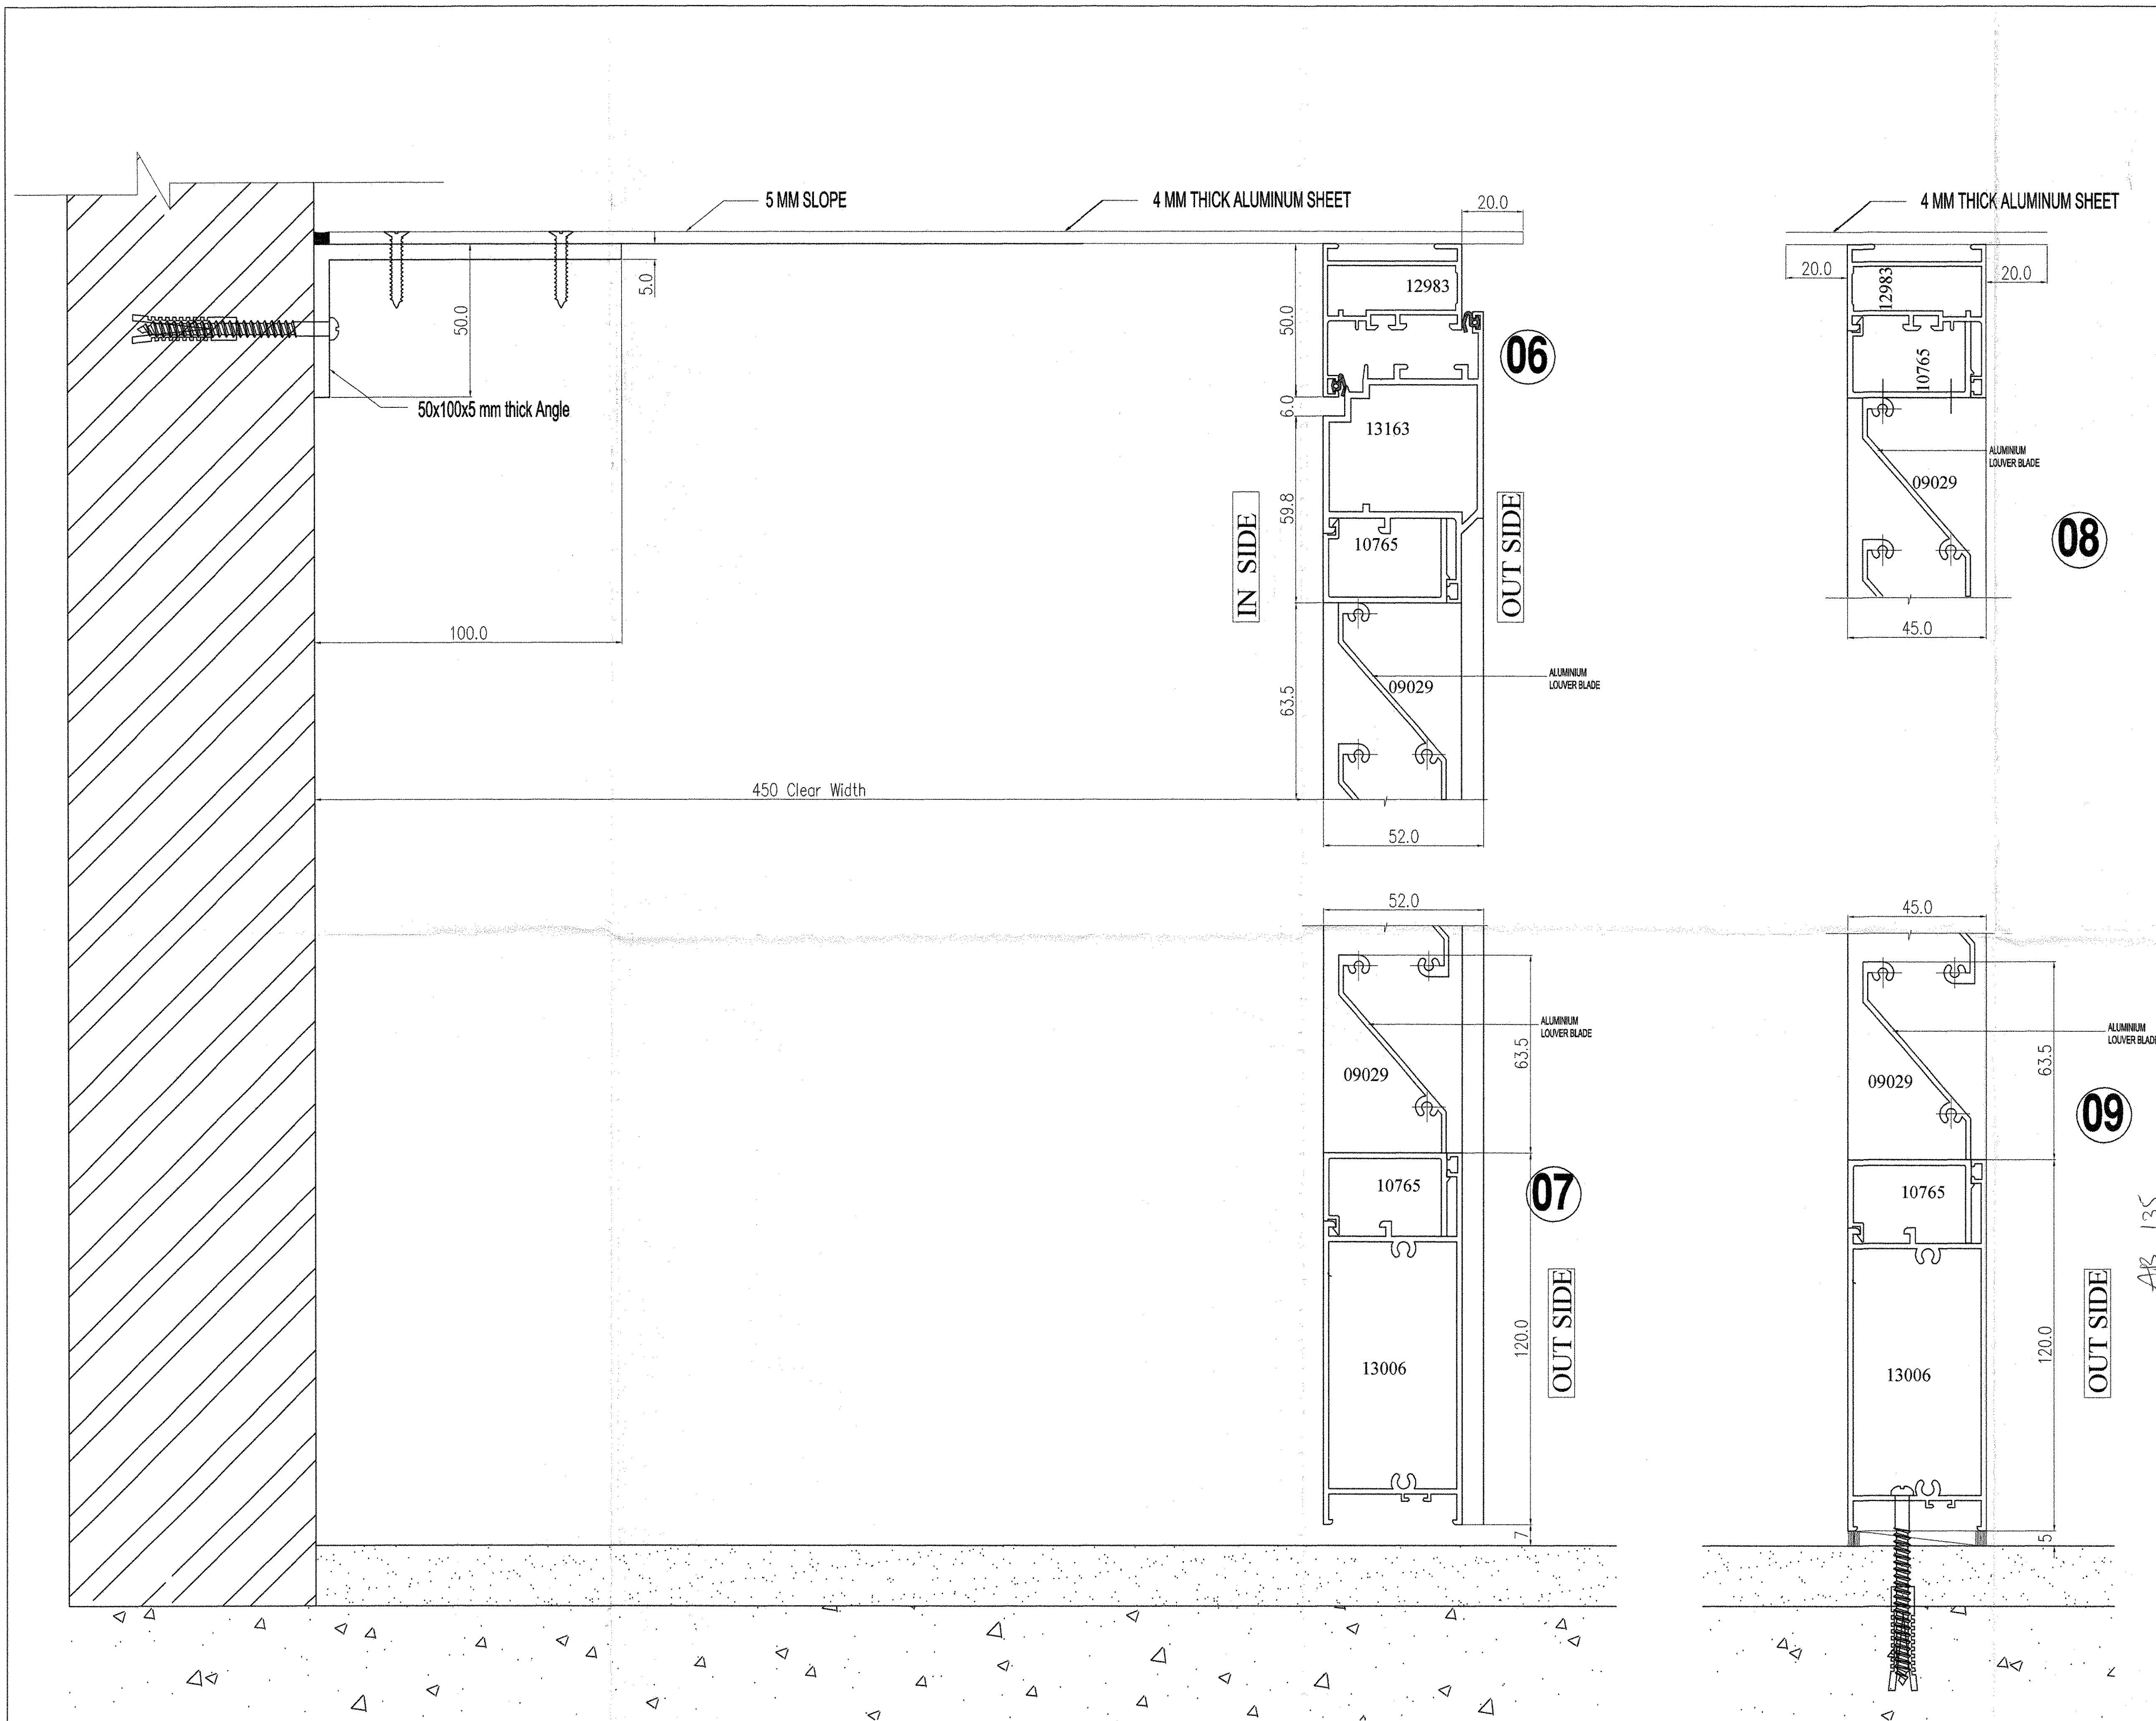

dar al-handasah
Sheir and Partners

☒ CODE 1 **APPROVED**
☐ CODE 2 **APPROVED AS NOTED**
 WORK MAY PROCEED SUBJECT TO
 INCORPORATION OF ENDORSED
 COMMENTS
☐ CODE 3 **RESUBMIT FOR APPROVAL**
 WORK MAY NOT PROCEED
☐ CODE 4 **REJECTED**

BY: **DATE:**

Approval shall not relieve the contractor of any of his
 obligations under the Contract or constitute authorization of
 any change to Contract Documents or releases to the works.
 Contractor is responsible for dimensions, quantities and
 coordination with other trades.

23 JUN 2012



AS BUILT DRAWING

Project
JUMEIRAH PARK

Employer
NAKHEEL
P.O. BOX: 17777, DUBAI, U.A.E.
PHONE : + 971 - 4 - 360388
FAX : + 971 - 4 - 360385
Website : www.nakheel.ae
E-MAIL : info@nakheel.ae

Consultant
dar al-handasah
sheir and partners
P.O. BOX: 55604, DUBAI, U.A.E.
PHONE : + 971 - 4 - 333302
FAX : + 971 - 4 - 333301
www.daralhandasah.com

Main Contractor
Pauling Middle East
P.O. BOX: 40176, ABU DHABI, U.A.E.
PHONE : + 971 - 2 - 432992
FAX : + 971 - 2 - 432955
E-MAIL : pauling@middleeast.net.ae

Sub Contractor
WHITE ALUMINIUM ENT.
P.O. BOX: 2402, ABU DHABI, U.A.E.
PHONE : + 971 - 2 - 554589
FAX : + 971 - 2 - 554582

Package
PACKAGE - 2

Cluster - 1
PACKAGE - 2A
Clusters - 1, 3 (Villas 51 to 62), 4, 5, 7 (Villas 33 to 41),
8, 9, 10, 11, 12, 13, 14, 15 (Villas 1 to 14) & 16

Drawing Title
**GULF 45-SERIES LOUVER
DOOR ALUMINIUM DETAILS**

Drawn IBRAHIM	Review Eng. Zied	Checked: GUGAN
Scale: 1:1	Date: 13-06-2012	

Drawing No. **PME / JP / AB / LE / ALU / 020A**