


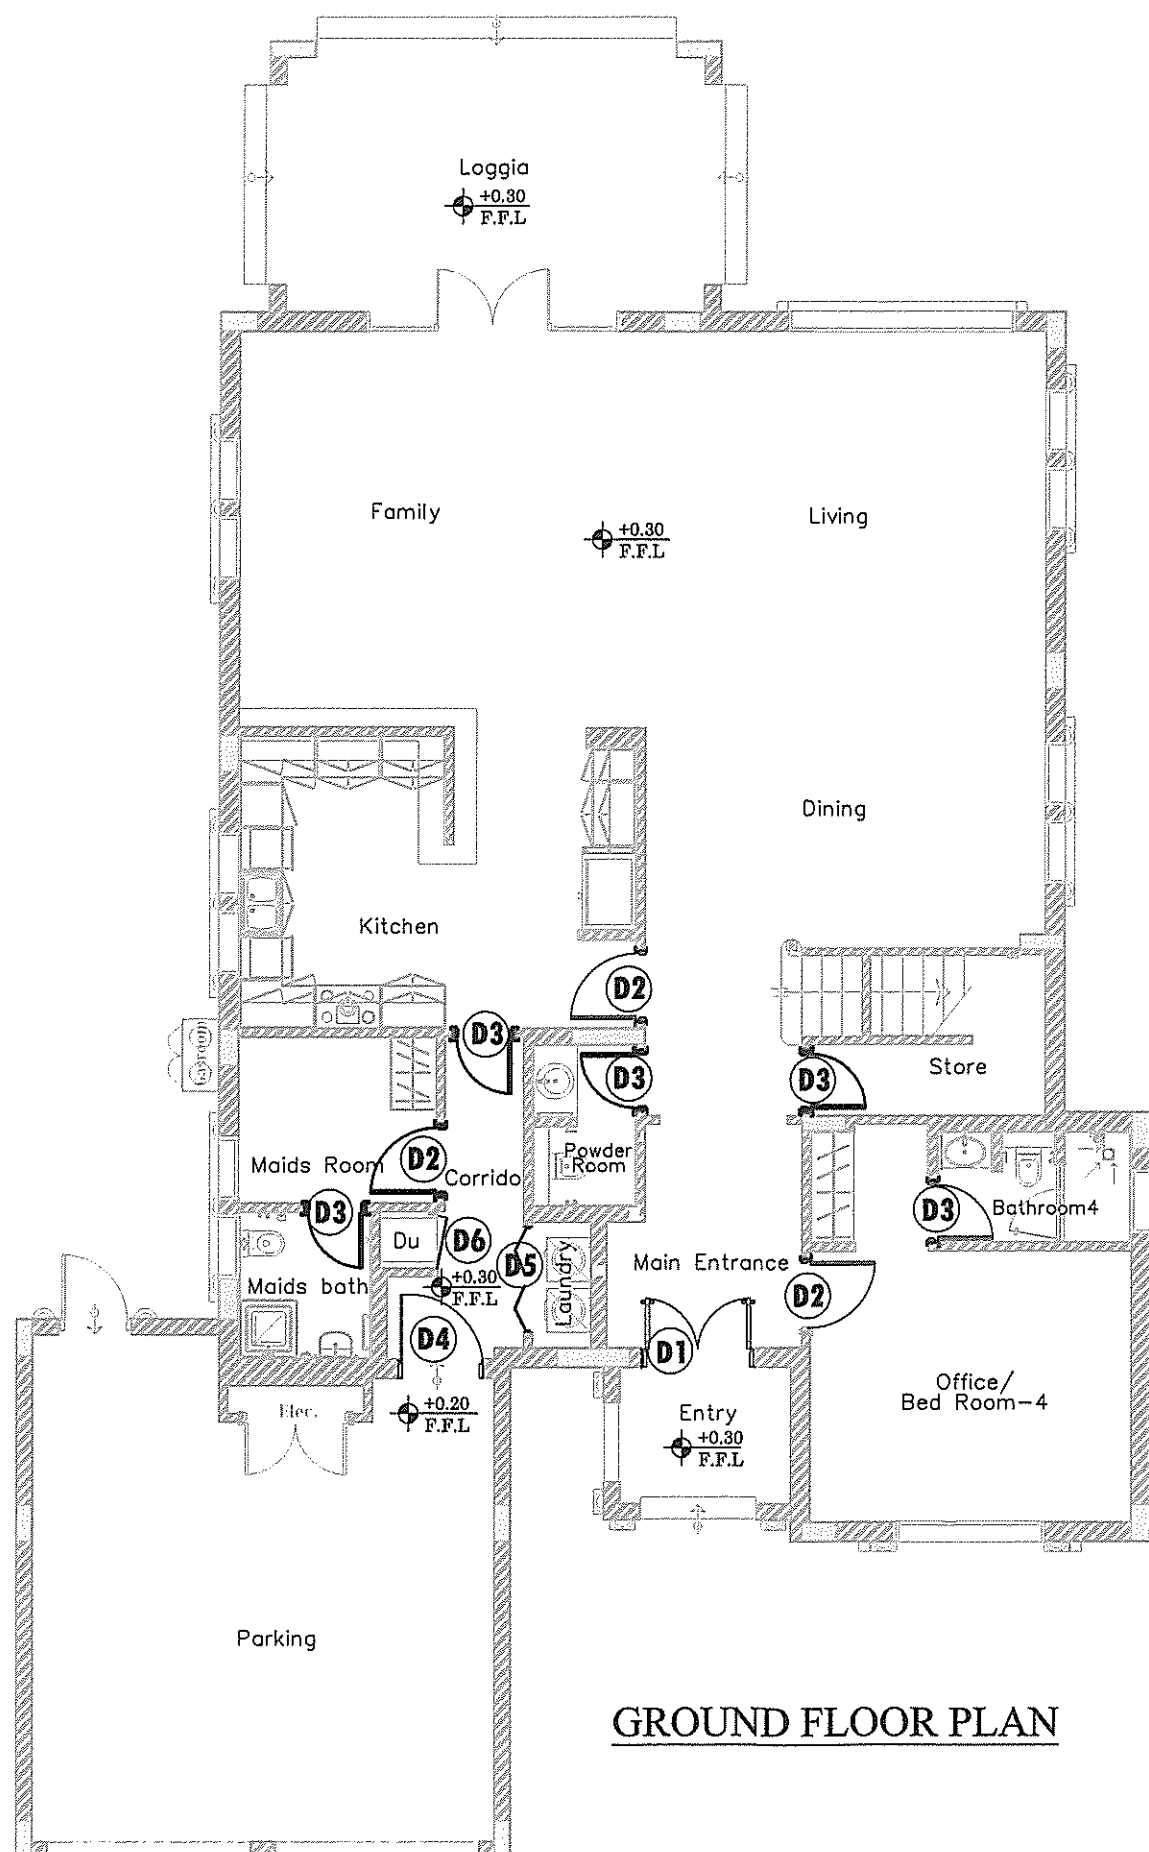

GROUND FLOOR PLAN

- NOTE:**
1. ALL DIMENSIONS ARE IN MILLIMETERS
 2. ALL INTERNAL PLASTER IS 150mm
 3. ALL EXTERNAL PLASTER IS 200mm

dar al-handasah
Shan and Partners

☒ CODE 1 APPROVED

☐ CODE 2 APPROVED AS NOTED
WORK MAY PROCEED SUBJECT TO
INCORPORATION OF ENDORSED
COMMENTS

☐ CODE 3 RESUBMIT FOR APPROVAL
WORK MAY NOT PROCEED

☐ CODE 4 REJECTED

BY: _____ DATE: _____

Approval shall not relieve the contractor of his obligations under the Contract or of his responsibility for any change in Contract Documents or variation to the works. Contractor is responsible for dimensions, quantities and coordination with other trades.



AS BUILT DRAWING

JUMAIRAH PARK

Employer
NAKHEEL
P.O. BOX 11777, DUBAI, U.A.E.
PHONE + 971-4-3303388
FAX + 971-4-3303333
E-MAIL nakheel@nakheel.ae


Consultant
dar al-handasah
shan and partners
P.O. BOX 15054, DUBAI, U.A.E.
PHONE + 971-4-3331102
FAX + 971-4-3331121
E-MAIL daral@daral.ae

Main Contractor
Pauling Middle East
P.O. BOX 48174, JESSALMER, U.A.E.
PHONE + 971-2-4320122
FAX + 971-2-4320122
E-MAIL pauling@pauling.ae

PACKAGE - 2

WOODEN DOORS LAYOUT
GROUND FLOOR
LEGACY TRADITIONAL

Drawn T. Murugan	Review Eng. Zyed	Checked: Eng. Ghassan Zeilouni
Scale:	Date: 07-08-2012	
Drawing No. PME / JP / AB / WD / LT / 001		


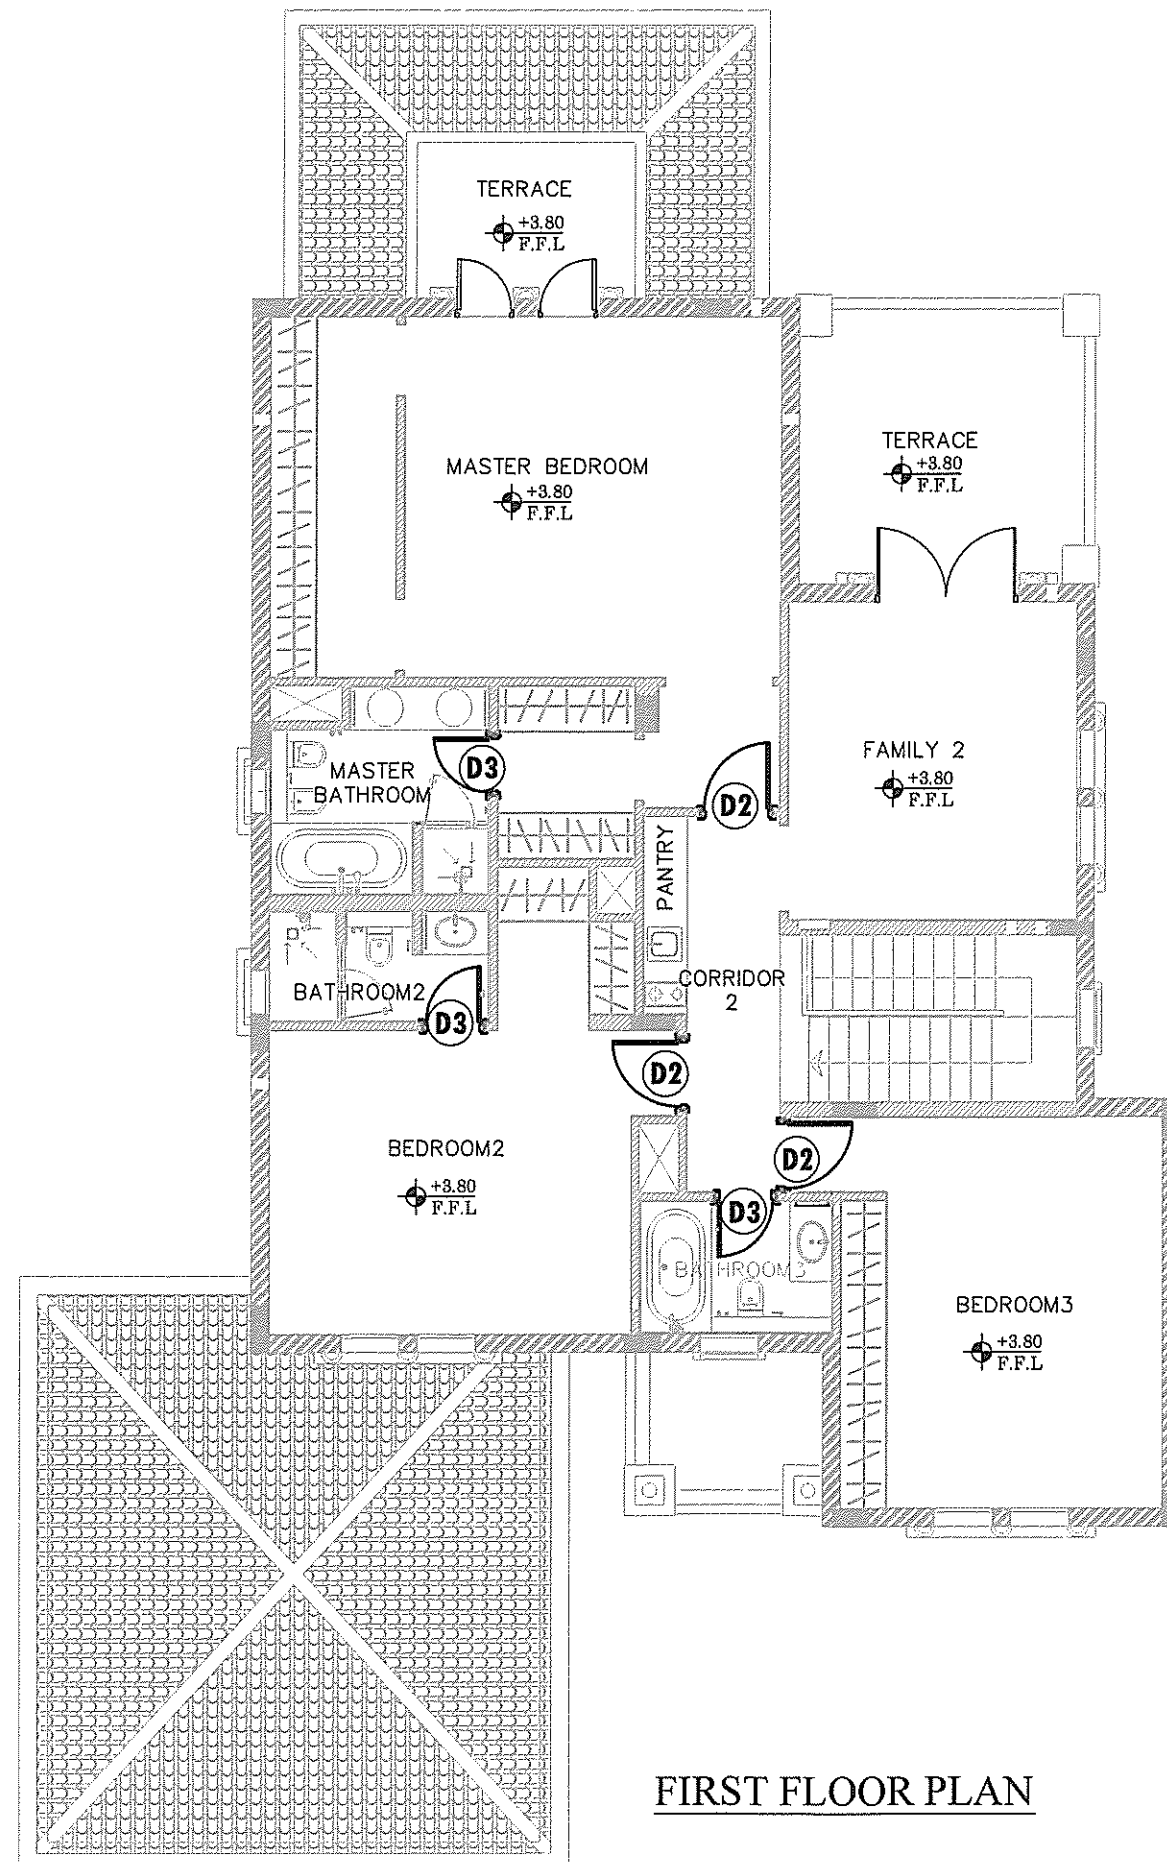


FIRST FLOOR PLAN

NOTE:

1. ALL DIMENSIONS ARE IN MILLIMETERS
2. ALL INTERNAL PLASTER IS 150mm
3. ALL EXTERNAL PLASTER IS 200mm

 dar al-handasah civil and structural	
☒ CODE 1	APPROVED
☐ CODE 2	APPROVED AS NOTED WORK MAY PROCEED SUBJECT TO INCORPORATION OF ENDORSED COMMENTS
☐ CODE 3	RESUBMIT FOR APPROVAL WORK MAY NOT PROCEED
☐ CODE 4	REJECTED
BY: _____ DATE: _____	
Approval shall not relieve the contractor of any of his obligations under the Contract or constitute authorization of any change to Contract Documents or variation to the works. Contractor is responsible for dimensions, quantities and coordination with other trades.	
	
AS BUILT DRAWING	
Project JUMAIRAH PARK	
Employer  NAKHEEL	
Consultant  dar al-handasah civil and structural	
Main Contractor  Pauling Middle East	
Package PACKAGE - 2	
Drawing Title WOODEN DOORS LAYOUT FIRST FLOOR LEGACY TRADITIONAL	
Drawn: T. Murugan Scale: _____ Drawing No. _____	Review: Eng. Ziyd Date: 07-08-2012 Checked: Eng. Ghassan Zeitouni
PME / JP / AB / WD / LT / 002	

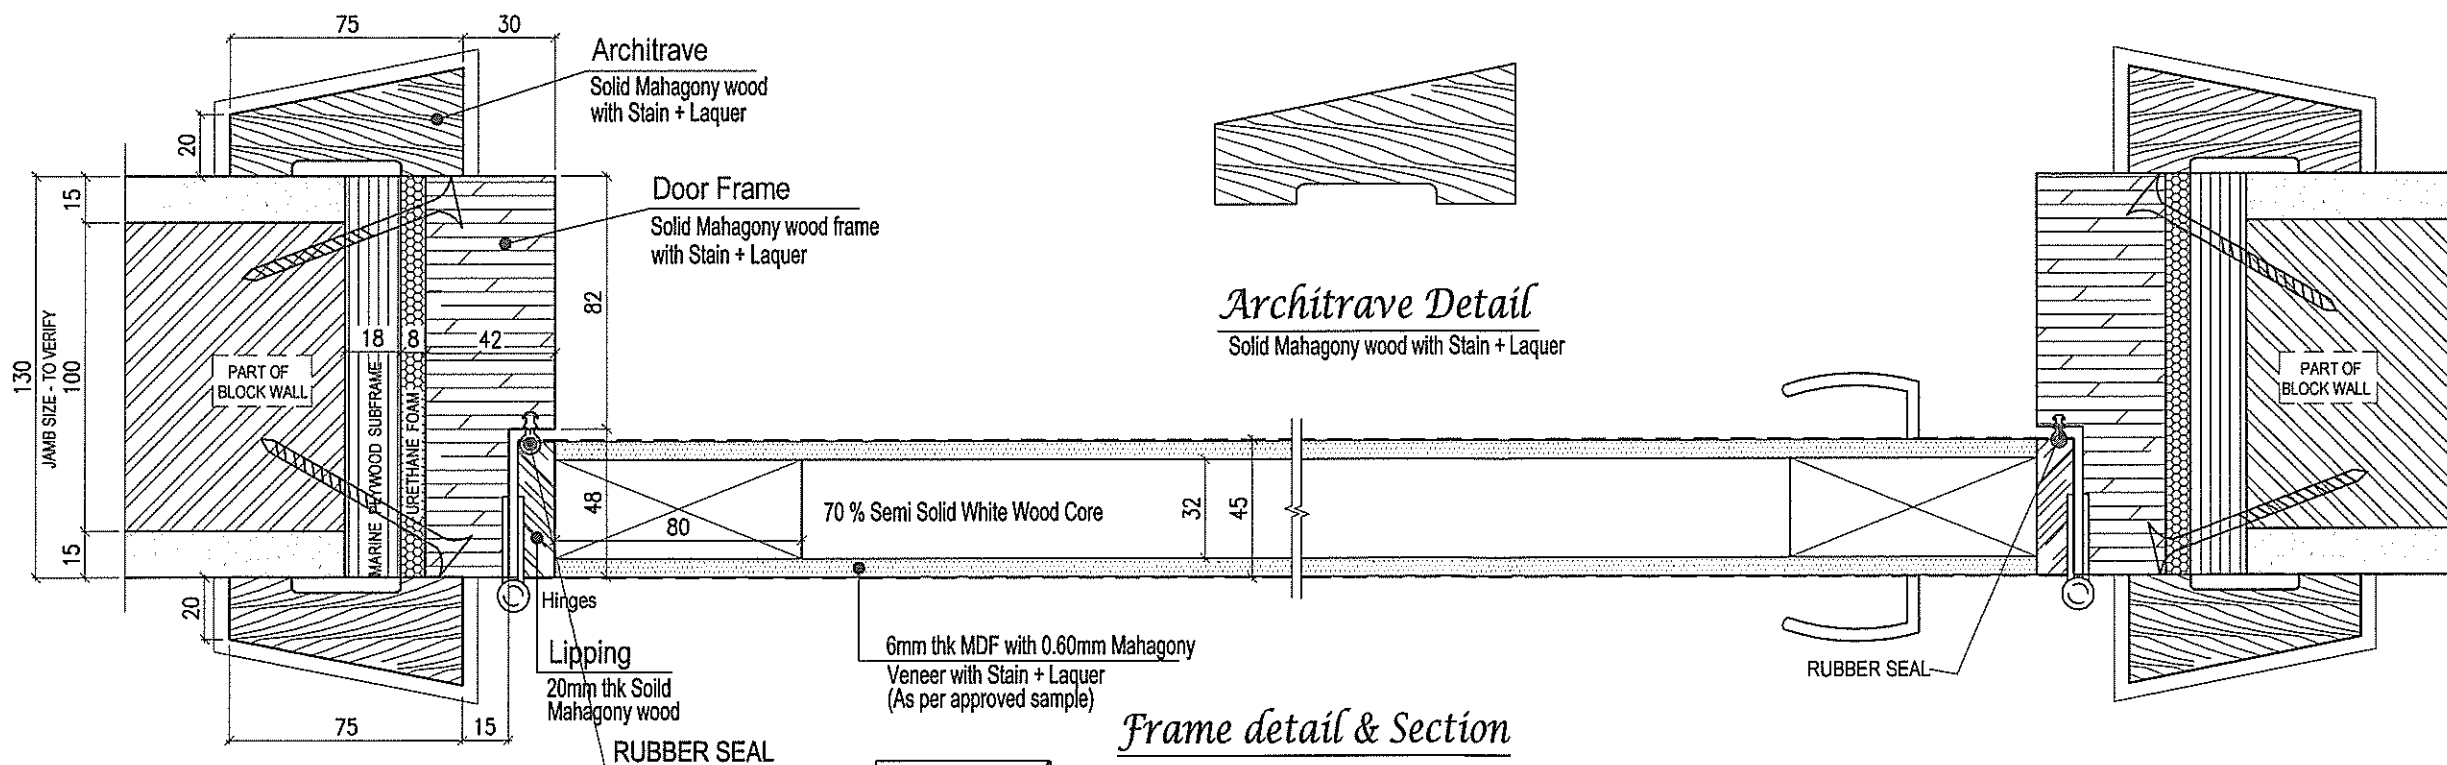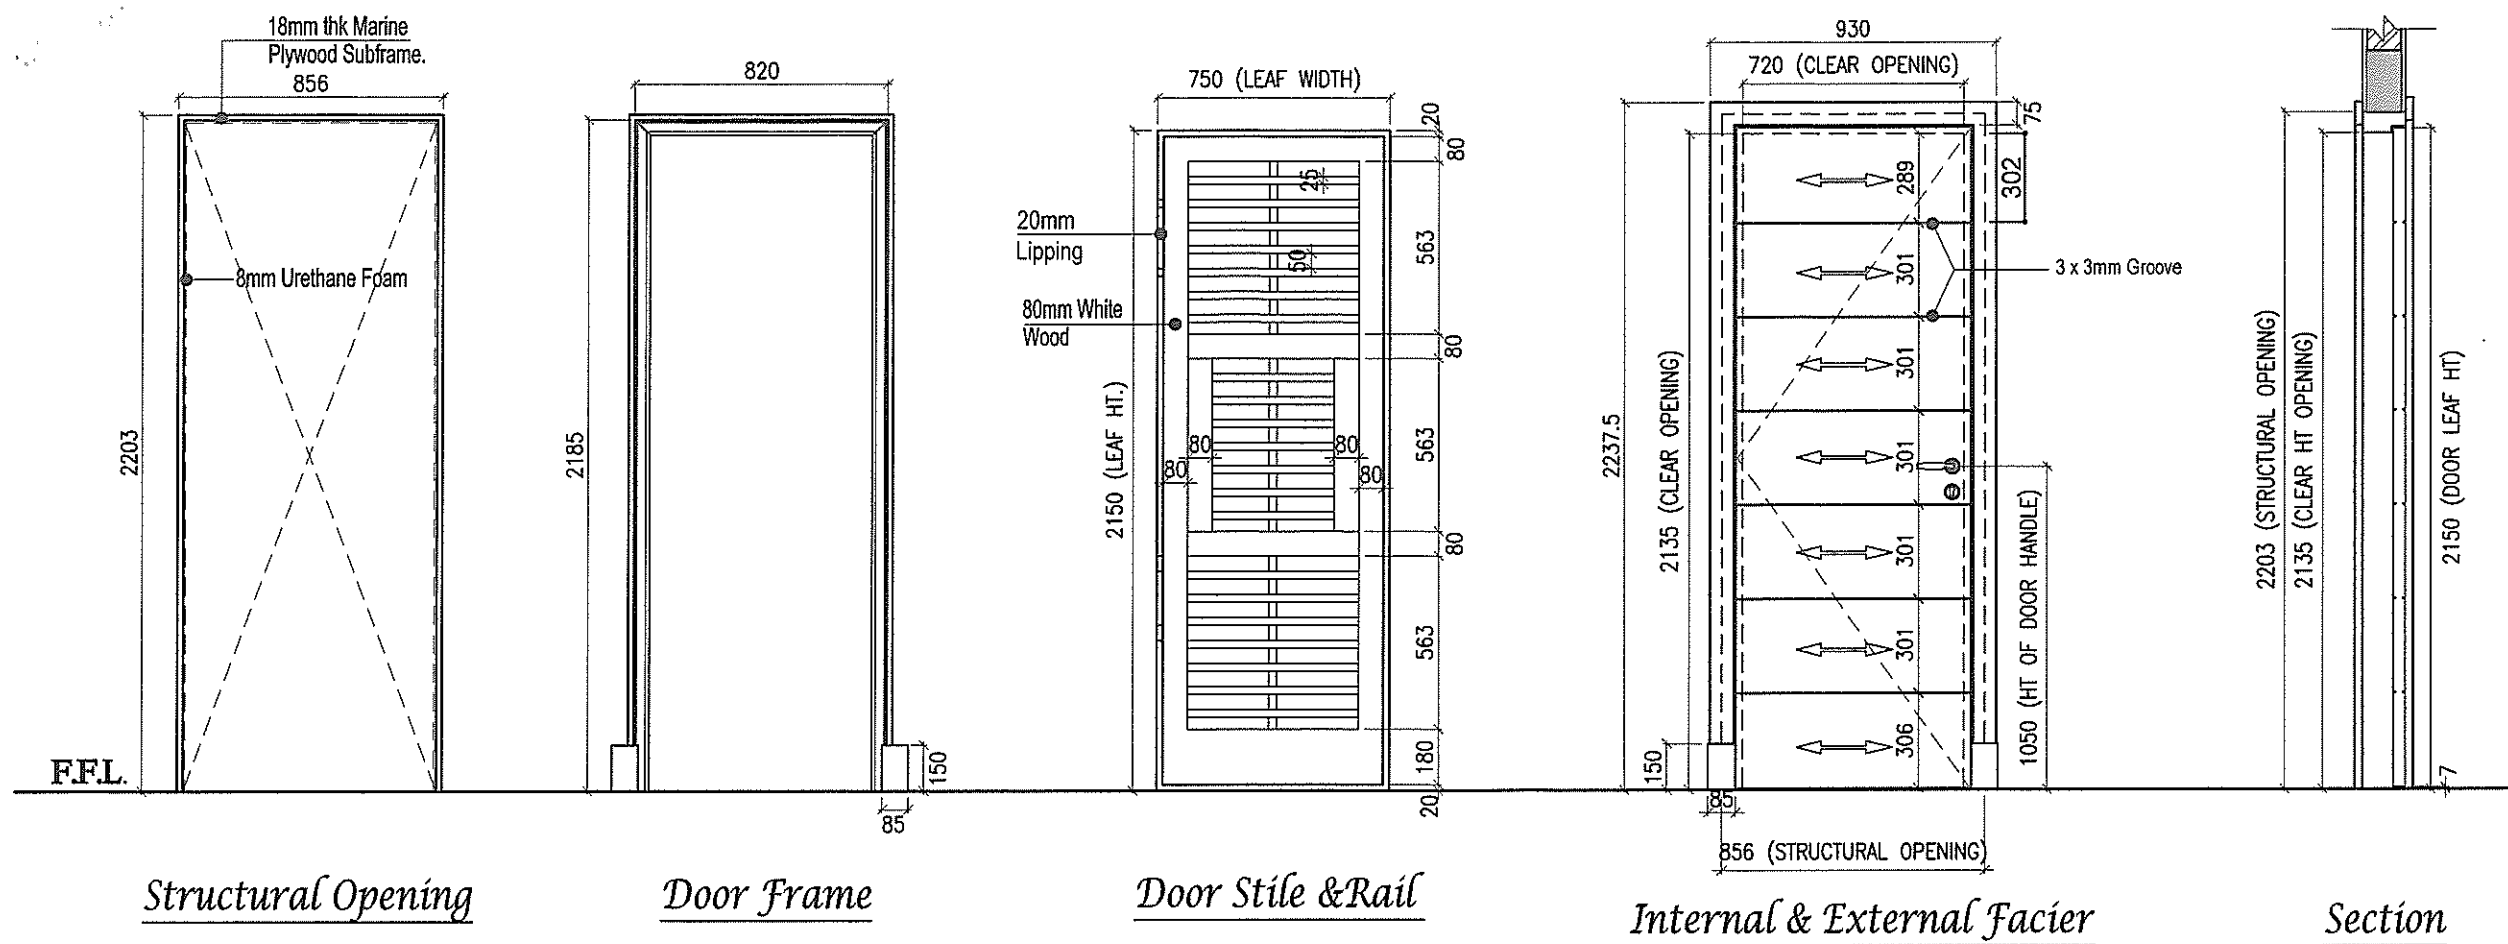

Ironmongeries details for all Bathrooms and Powder room doors

Item Description	Item Code
DOUBLE BALL BEARING BUT HINGES 102X76MM, 3MM CS MARK	89.355.86
FLOOR DOOR STOP	95.171.61
LEVER HANDLE ON ROSE WITH CYLINDER ESC	167.002.61
LEVER HANDLE ON ROSE WITH CYLINDER ESC	167.002.61
MORTISE CYLINDER LOCKCASE 72MM	88.803.86
CYLINDER TURN WITH EMERGENCY RELEASE (FOR ALL BATH ROOMS & POWDER ROOM)	88.503.62.70

Ironmongeries details for store room and corridor 1 doors

Item Description	Item Code
DOUBLE BALL BEARING BUT HINGES 102X76MM, 3MM CS MARK	89.355.86
EURO PROFILE DOUBLE CYLINDER 70MM	88.500.62.70
FLOOR DOOR STOP	95.171.61
LEVER HANDLE ON ROSE WITH CYLINDER ESC	167.002.61
LEVER HANDLE ON ROSE WITH CYLINDER ESC	167.002.61
MORTISE CYLINDER LOCKCASE 72MM	88.803.86

Door Ref.	Door Leaf		Location	Level	Qty per villa
	Type	Size			
D3	W4	750x2150	Bath Room 4	G.F	8 Nos.
			Powder Room	G.F	
			Maid's Bath Room	G.F	
			Master Bath Room	F.F	
			Bath Room 2	F.F	
			Bath Room 3	F.F	
			Corridor 1	G.F	
			Store	G.F	

dar al-handasah
Shair and Partners

☒ CODE 1 APPROVED

☐ CODE 2 APPROVED AS NOTED
WORK MAY PROCEED SUBJECT TO
INCORPORATION OF ENDORSED
COMMENTS

☐ CODE 3 RESUBMIT FOR APPROVAL
WORK MAY NOT PROCEED

☐ CODE 4 REJECTED

BY: DATE:

Approval shall not relieve the contractor of his obligations under the Contract or constitute authorization of any change to Contract Documents or variation to the works. Contractor is responsible for dimensions, quantities and coordination with other trades.

09/08/2012



Note: All dimension in (MM)

AS BUILT DRAWING

JUMAIRAH PARK

NAKHEEL

dar al-handasah
shair and partners

Pauling Middle East


AI Huda Interior Factory

PACKAGE - 2


WOODEN DOOR DETAIL (D3)
LEGACY TRADITIONAL

Drawn: T.MURUGAN Review: Eng. Ziad Checked: Eng. Ghassan Zeitouni


Drawing No. PME / JP / AB / WD / LT / 006

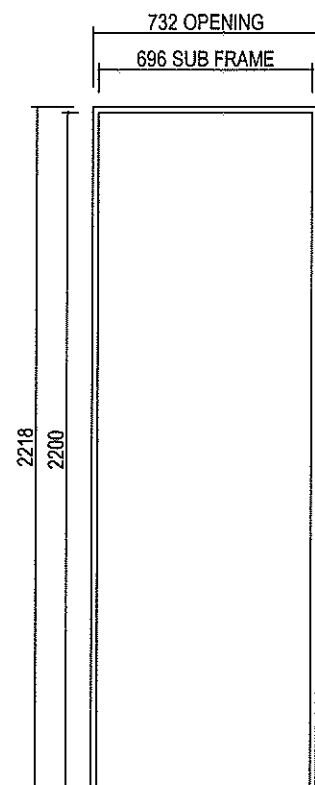


OPENING ELEVATION

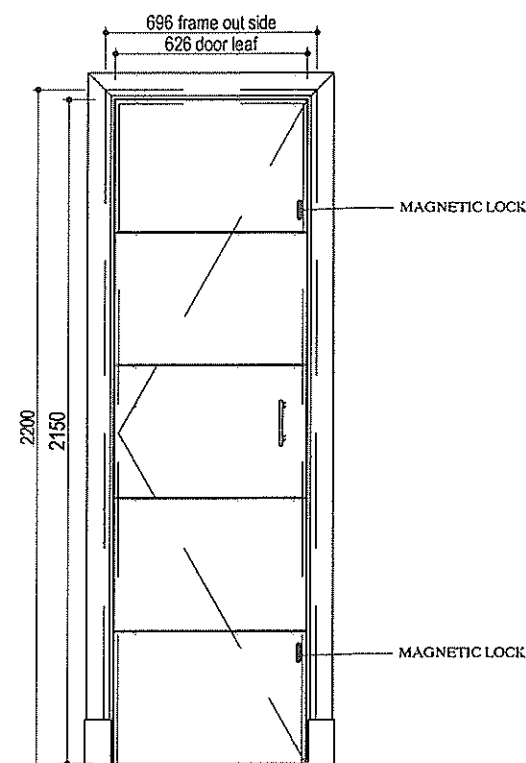


EXTERNAL ELEVATION

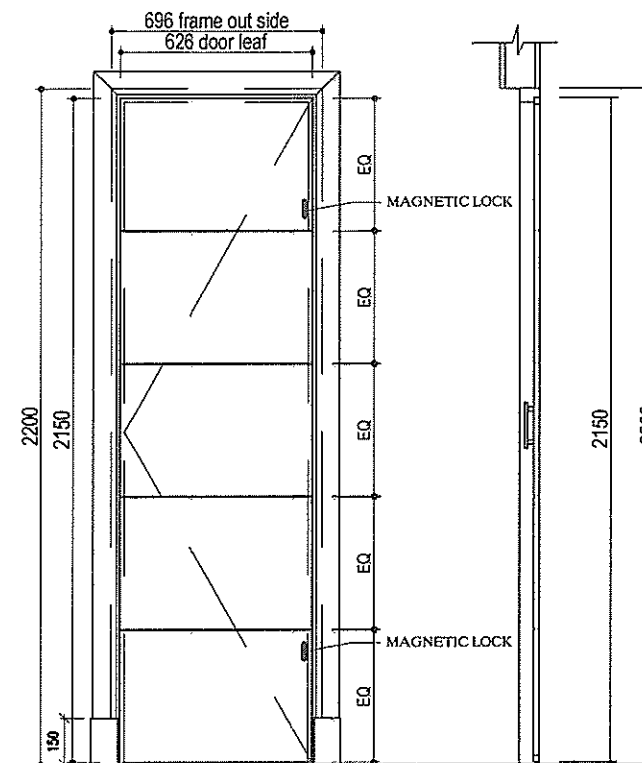

INTERNAL ELEVATION

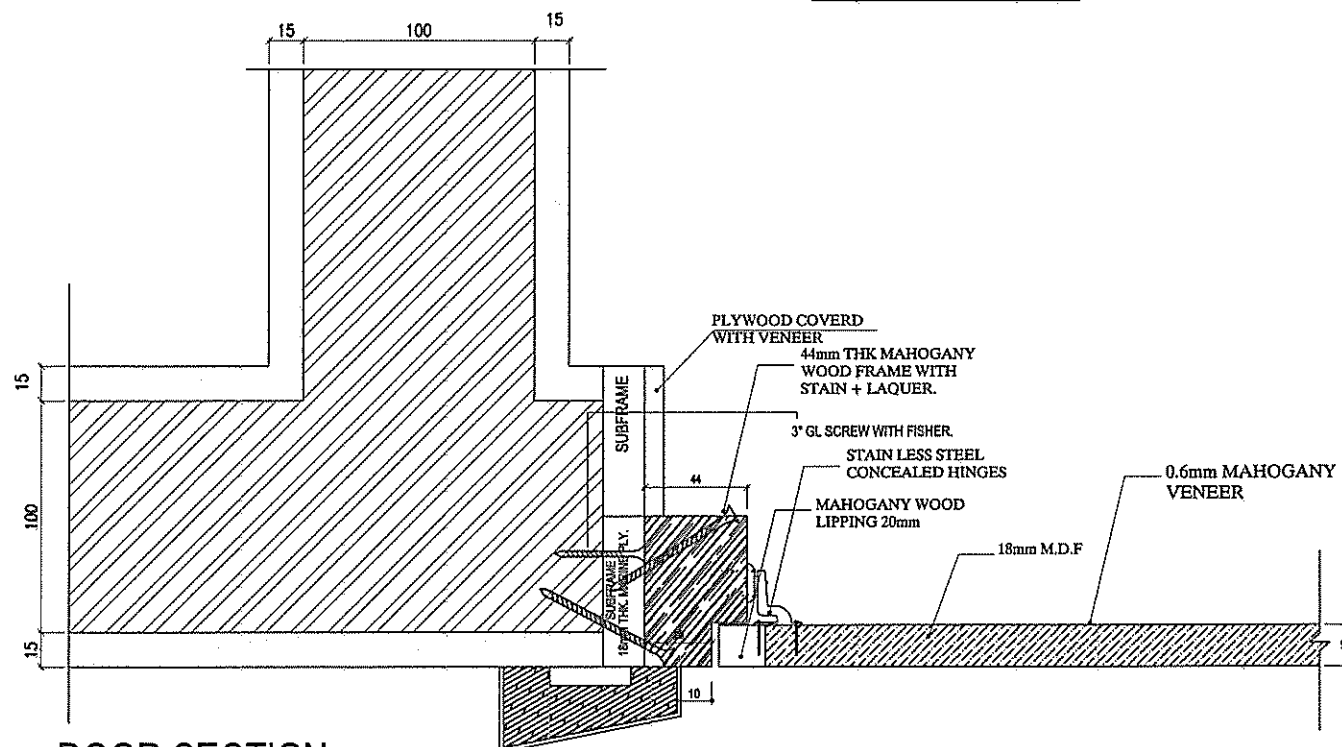

DOOR SECTION
DETAIL -- 2

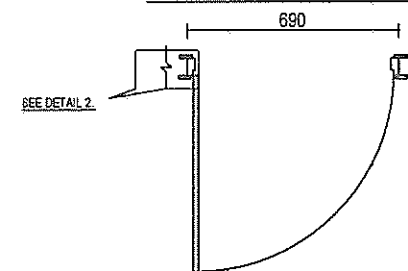

ARCHITRAVE DETAIL

IRONMONGERIES DETAILS

Item Description	Item Code
CLIP ON HINGES 1100DEGREE 52MM (CLUTCH HINGES)	FIT-04003
BAR HANDLE 10MM 160X250 LENGTH	
MAGNETIC LOCK	

Door Ref.	Door Leaf		Location	Level	Qty per villa
	Type	Size			
D6	-	62.60x2150	DU	G.F	1 No.

dar al-handasah
Shair and Partners

☒ CODE 1 APPROVED

☐ CODE 2 APPROVED AS NOTED
WORK MAY PROCEED SUBJECT TO
INCORPORATION OF ENDORSED
COMMENTS

☐ CODE 3 RESUBMIT FOR APPROVAL
WORK MAY NOT PROCEED

☐ CODE 4 REJECTED

BY: _____ DATE: _____

Approval shall not relieve the contractor of any of his obligations under the Contract or constitute authorization of any change to Contract Documents or variation to the works. Contractor is responsible for dimensions, quantities and coordination with other trades.



Note: All dimension in (MM)

AS BUILT DRAWING

JUMAIRAH PARK



AI Huda Interior Factory



PACKAGE - 2

WOODEN DOOR DETAIL (DU ROOM)
LEGACY TRADITIONAL

Drawn: T.MURUGAN Review: Eng. Ziad Checked: Eng. Chassan Zeitouni

Scale: Date: 18-07-2012

Drawing No. PME / JP / AB / WD / LT / 008

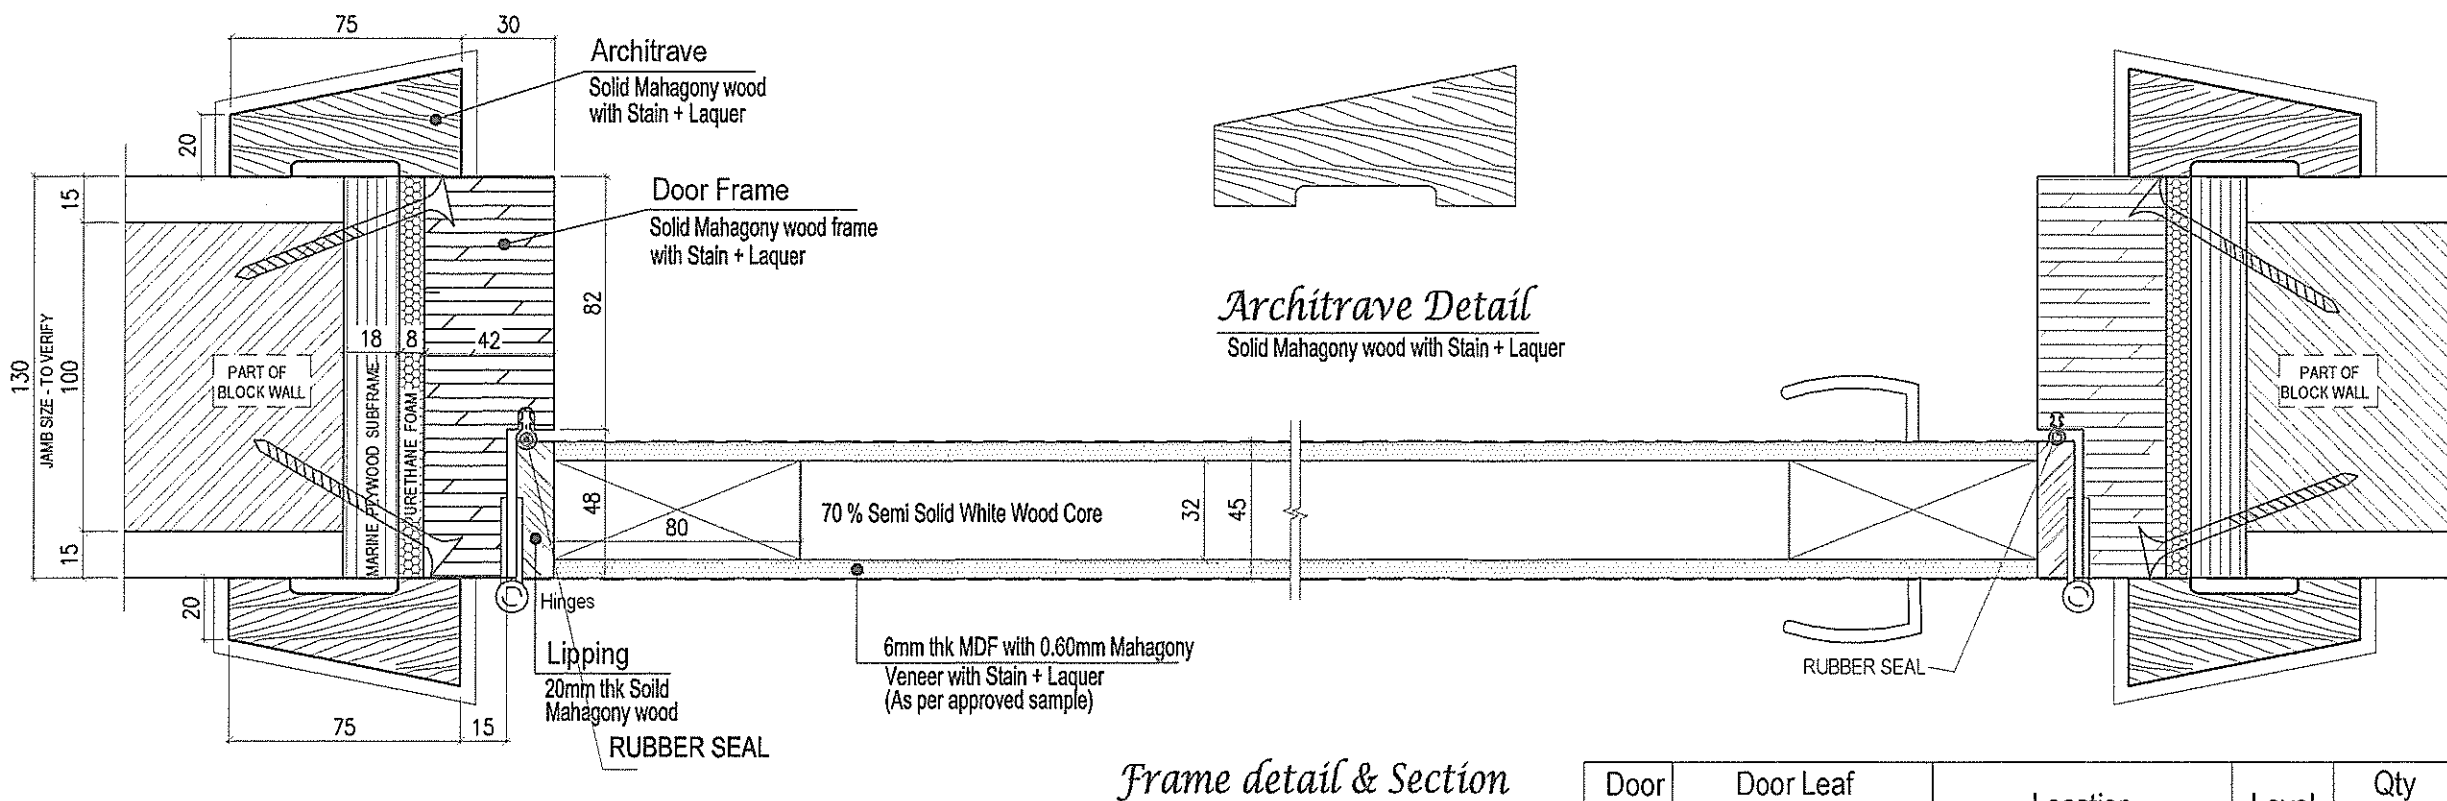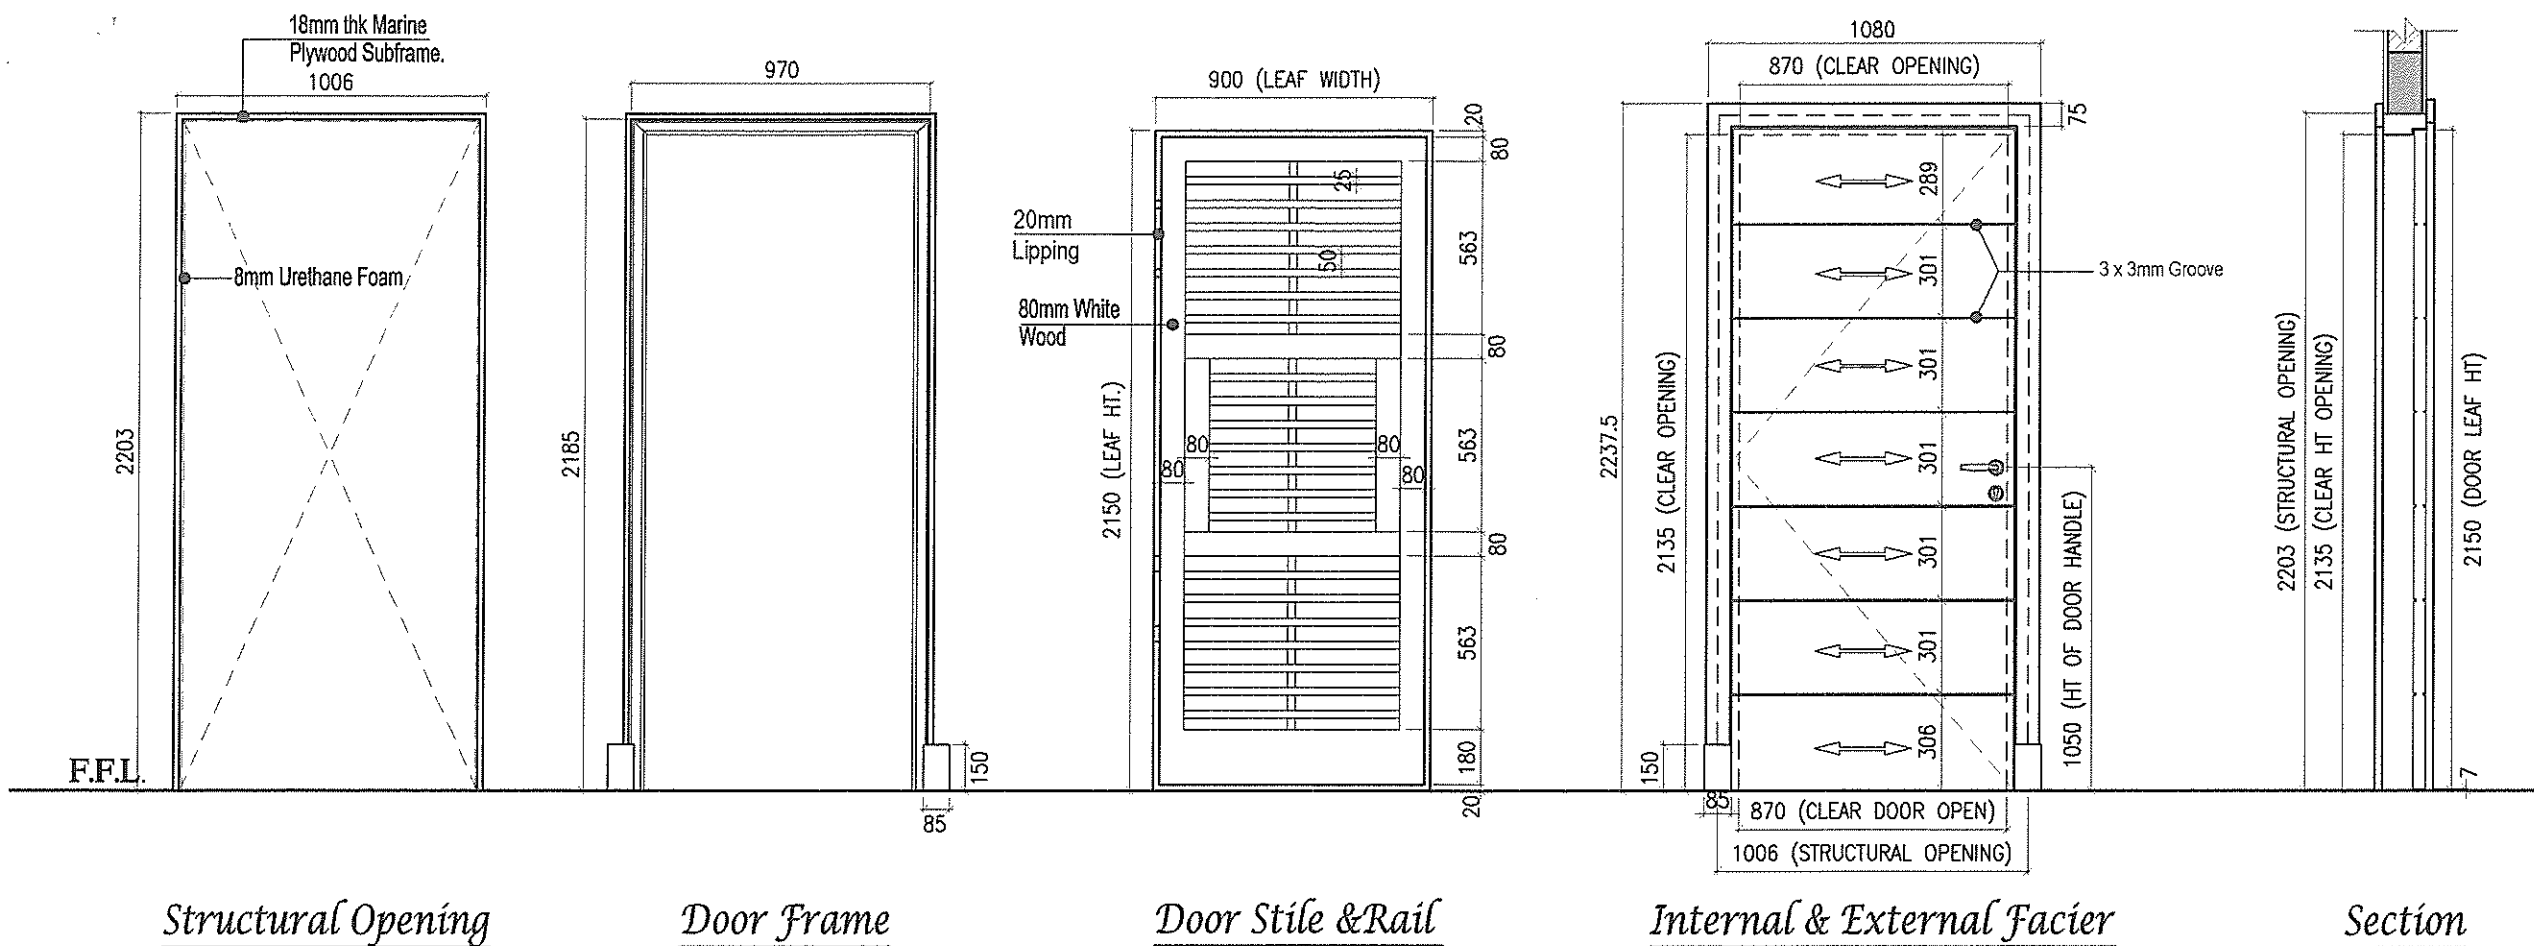

Ironmongeries details

Item Description	Item Code
DOUBLE BALL BEARING BUT HINGES 102X76MM, 3MM CS MARK	89.355.86
EURO PROFILE DOUBLE CYLINDER 70MM	88.500.62.70
FLOOR DOOR STOP	95.171.61
LEVER HANDLE ON ROSE WITH CYLINDER ESC	167.002.61
LEVER HANDLE ON ROSE WITH CYLINDER ESC	167.002.61
MORTISE CYLINDER LOCKCASE 72MM	88.803.86

Door D2

Door Ref.	Door Leaf		Location	Level	Qty per villa
	Type	Size			
D2	W2	900x2150	Office Bed Room 4	G.F	6 Nos.
			Master Bed Room	F.F	
			Bed Room 2	F.F	
			Bed Room 3	F.F	
			Maid Room	G.F	
			Kitchen Room	G.F	

dar al-handasah
Shair and Partners

☒ CODE 1 APPROVED

☐ CODE 2 APPROVED AS NOTED
WORK MAY PROCEED SUBJECT TO
INCORPORATION OF ENDORSED
COMMENTS

☐ CODE 3 RESUBMIT FOR APPROVAL
WORK MAY NOT PROCEED

☐ CODE 4 REJECTED

BY: _____ DATE: _____

Approval shall not relieve the contractor of any of his obligations under the Contract or constitute authorization of any change to Contract Documents or variation to the works. Contractor is responsible for dimensions, quantities and coordination with other trades.



Note: All dimension in (MM)

AS BUILT DRAWING

Project
JUMAIRAH PARK

Employer
NAKHEEL

Consultant
dar al-handasah
shair and partners

Main Contractor
Pauling Middle East


Sub Contractor
Al Huda Interior Factory

PACKAGE - 2

Drawing Title
**WOODEN DOOR DETAIL (D2)
LEGACY TRADITIONAL**

Drawn: T.MURUGAN Review: Eng. Ziad Checked: Eng. Ghassan Zeitouni
Scale: Date: 18-07-2012

Drawing No.
PME / JP / AB / WD / LT / 005

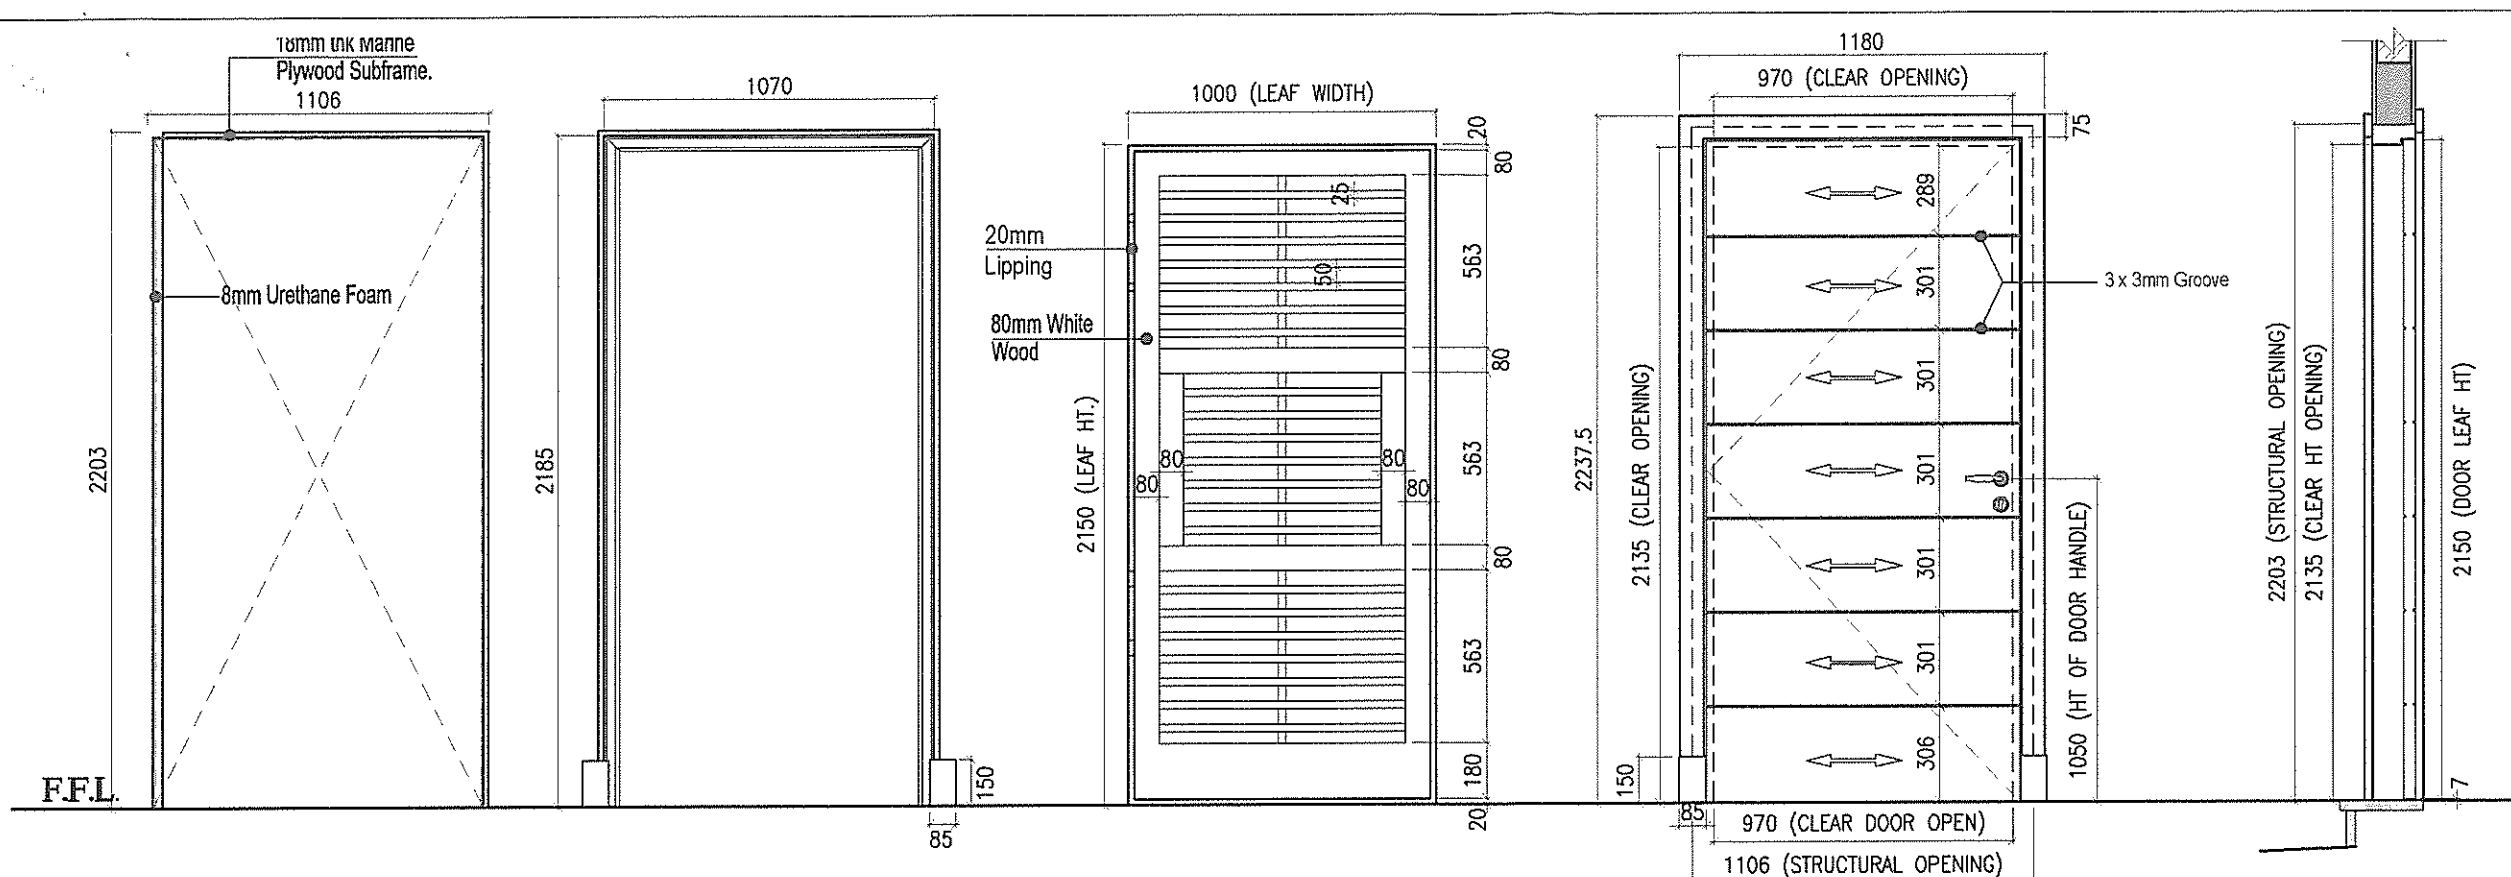


Structural Opening

Door Frame

Door Stile & Rail

Internal & External Facier

Section

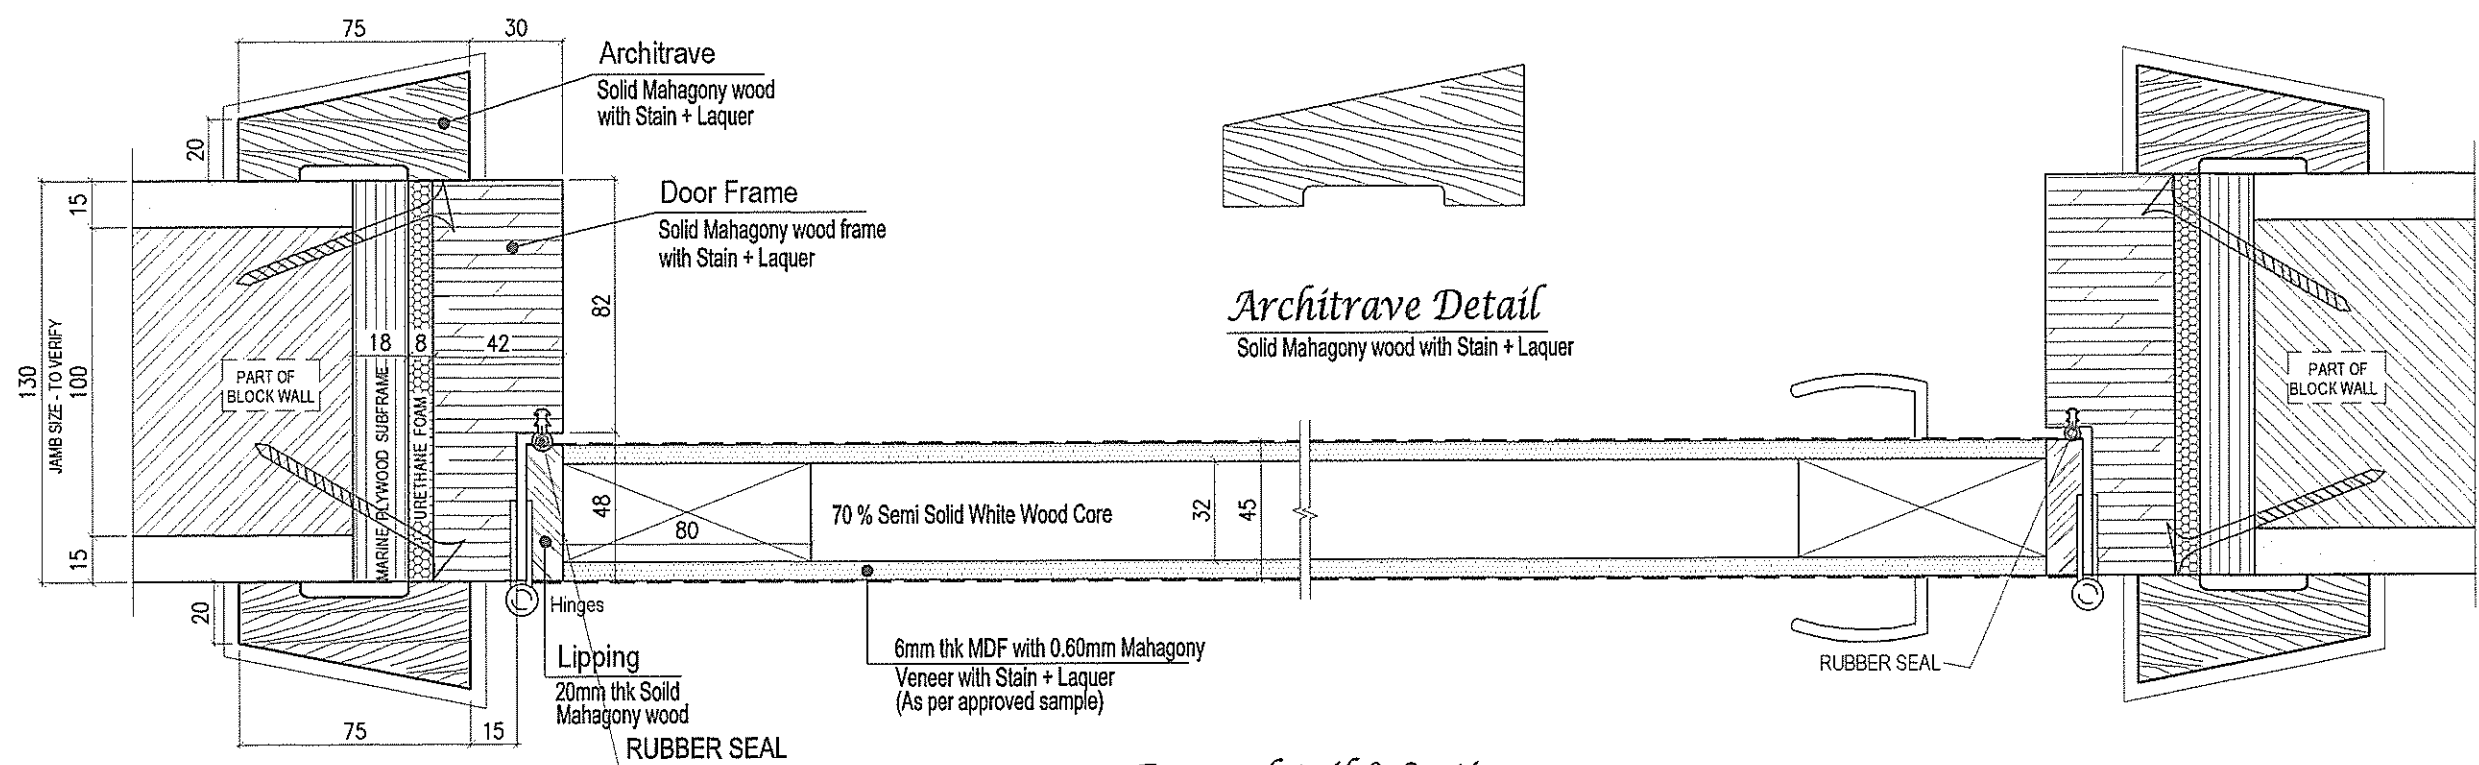

Architrave Detail
Solid Mahogany wood with Stain + Laquer

Frame detail & Section

Ironmongeries details

Item Description	Item Code
DOUBLE BALL BEARING BUT HINGES 102X76MM, 3MM CS MARK	89.355.86
EURO PROFILE DOUBLE CYLINDER 70MM	88.500.62.70
FLOOR DOOR STOP	95.171.61
LEVER HANDLE ON ROSE WITH CYLINDER ESC	167.002.61
LEVER HANDLE ON ROSE WITH CYLINDER ESC	167.002.61
MORTISE CYLINDER LOCKCASE 72MM	88.803.86

Door D4

Door Ref.	Door Leaf		Location	Level	Qty per villa
	Type	Size			
D4	W1'	1000x2150	Corridor 1	G.F	1 No.

dar al-handasah
Shair and Partners

CODE 1 APPROVED
CODE 2 APPROVED AS NOTED
CODE 3 RESUBMIT FOR APPROVAL
CODE 4 REJECTED

BY: DATE:

Approval shall not relieve the contractor of any of his obligations under the Contract or constitute authorization of any change to Contract Documents or variation to the works. Contractor is responsible for dimensions, quantities and coordination with other trades.

5/08/2012



Note: All dimension in (MM)

AS BUILT DRAWING

JUMAIRAH PARK

NAKHEEL

dar al-handasah
shair and partners


Pauling Middle East

Al Huda Interior Factory


PACKAGE - 2

**WOODEN DOOR DETAIL (D4)
LEGACY TRADITIONAL**


Drawn: T.MURUGAN Review: Eng. Ziad Checked: Eng. Ghassan Zeitouni
Scale: Date: 18-07-2012
Drawing No. PME / JP / AB / WD / LT / 007

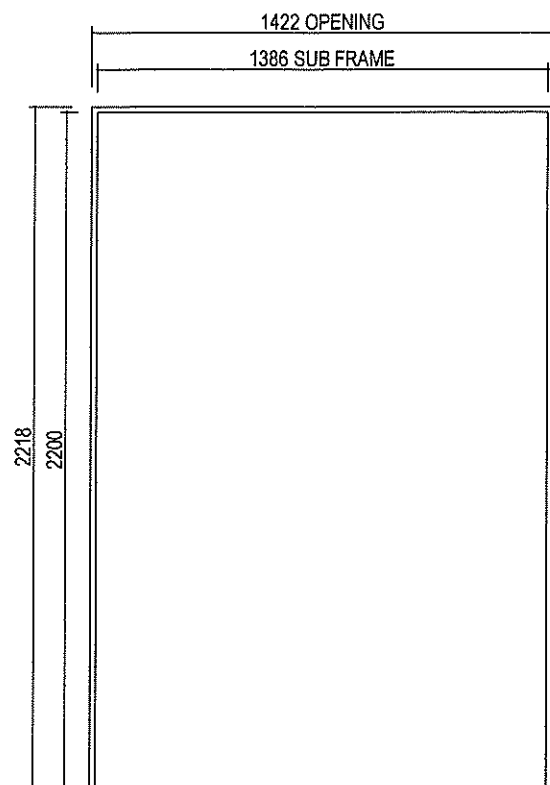




OPENING ELEVATION

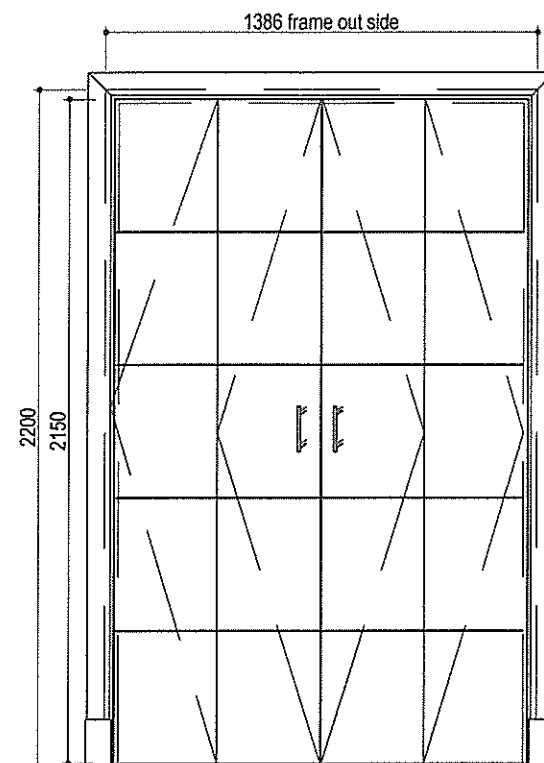

EXTERNAL ELEVATION

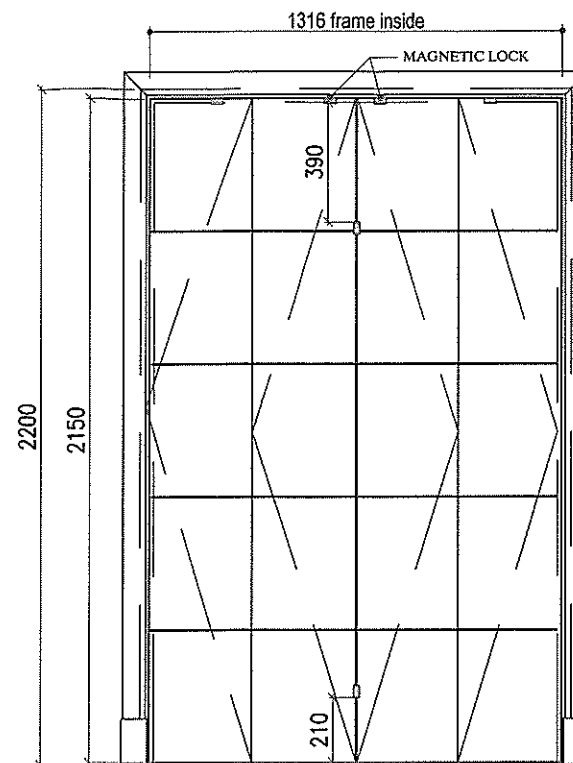

INTERNAL ELEVATION

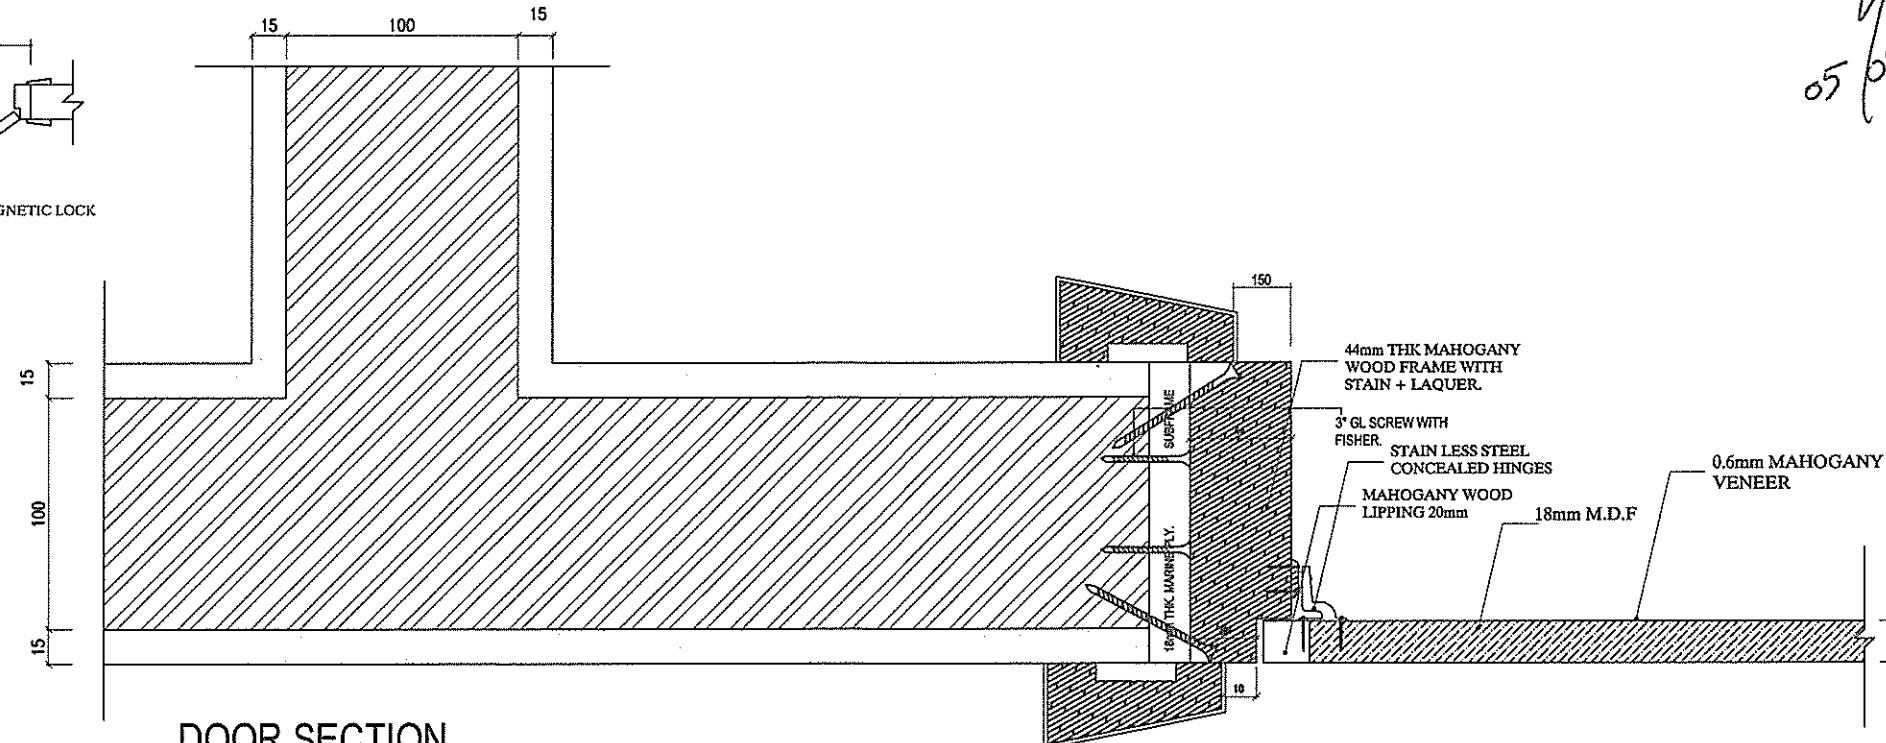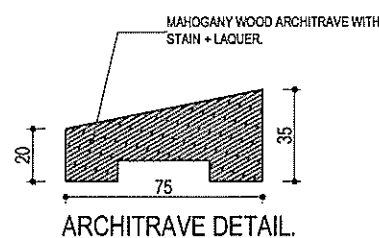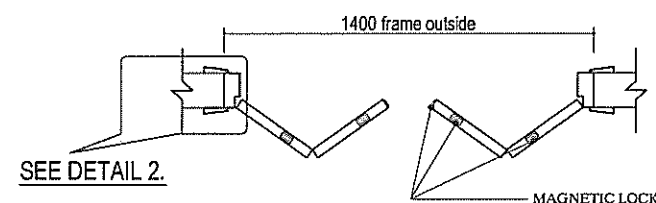

DOOR SECTION
DETAIL -- 2

IRONMONGERIES DETAILS

Item Description	Item Code
CLIP ON HINGES 1100DEGREE 52MM (CLUTCH HINGES)	FIT-04003
BAR HANDLE 10MM 160X250 LENGTH	
FLOOR DOOR STOP	95.171.61
MAGNETIC LOCK	

Door Ref.	Door Leaf		Location	Level	Qty per villa
	Type	Size			
D5	-	1316x2150	LAUNDRY	G.F	1 No.

dar al-handasah
Sheir and Partners

☐ CODE 1 APPROVED

☐ CODE 2 APPROVED AS NOTED
WORK MAY PROCEED SUBJECT TO
INCORPORATION OF ENDORSED
COMMENTS

☐ CODE 3 RESUBMIT FOR APPROVAL
WORK MAY NOT PROCEED

☐ CODE 4 REJECTED

BY: DATE:


Approval shall not relieve the contractor of any of his obligations under the Contract or constitute authorization of any change to Contract Documents or variation to the works. Contractor is responsible for dimensions, quantities and coordination with other trades.



Note: All dimension in (MM)

AS BUILT DRAWING

JUMAIRAH PARK

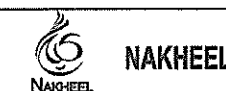

AI Huda Interior Factory

PACKAGE - 2

WOODEN DOOR DETAIL (LAUNDRY ROOM)
LEGACY TRADITIONAL

Drawn: T.MURUGAN, Review: Eng. Ziad, Checked: Eng. Ghassan Zeitouni
Scale: Date: 18-07-2012

Drawing No. PME / JP / AB / WD / LT / 009