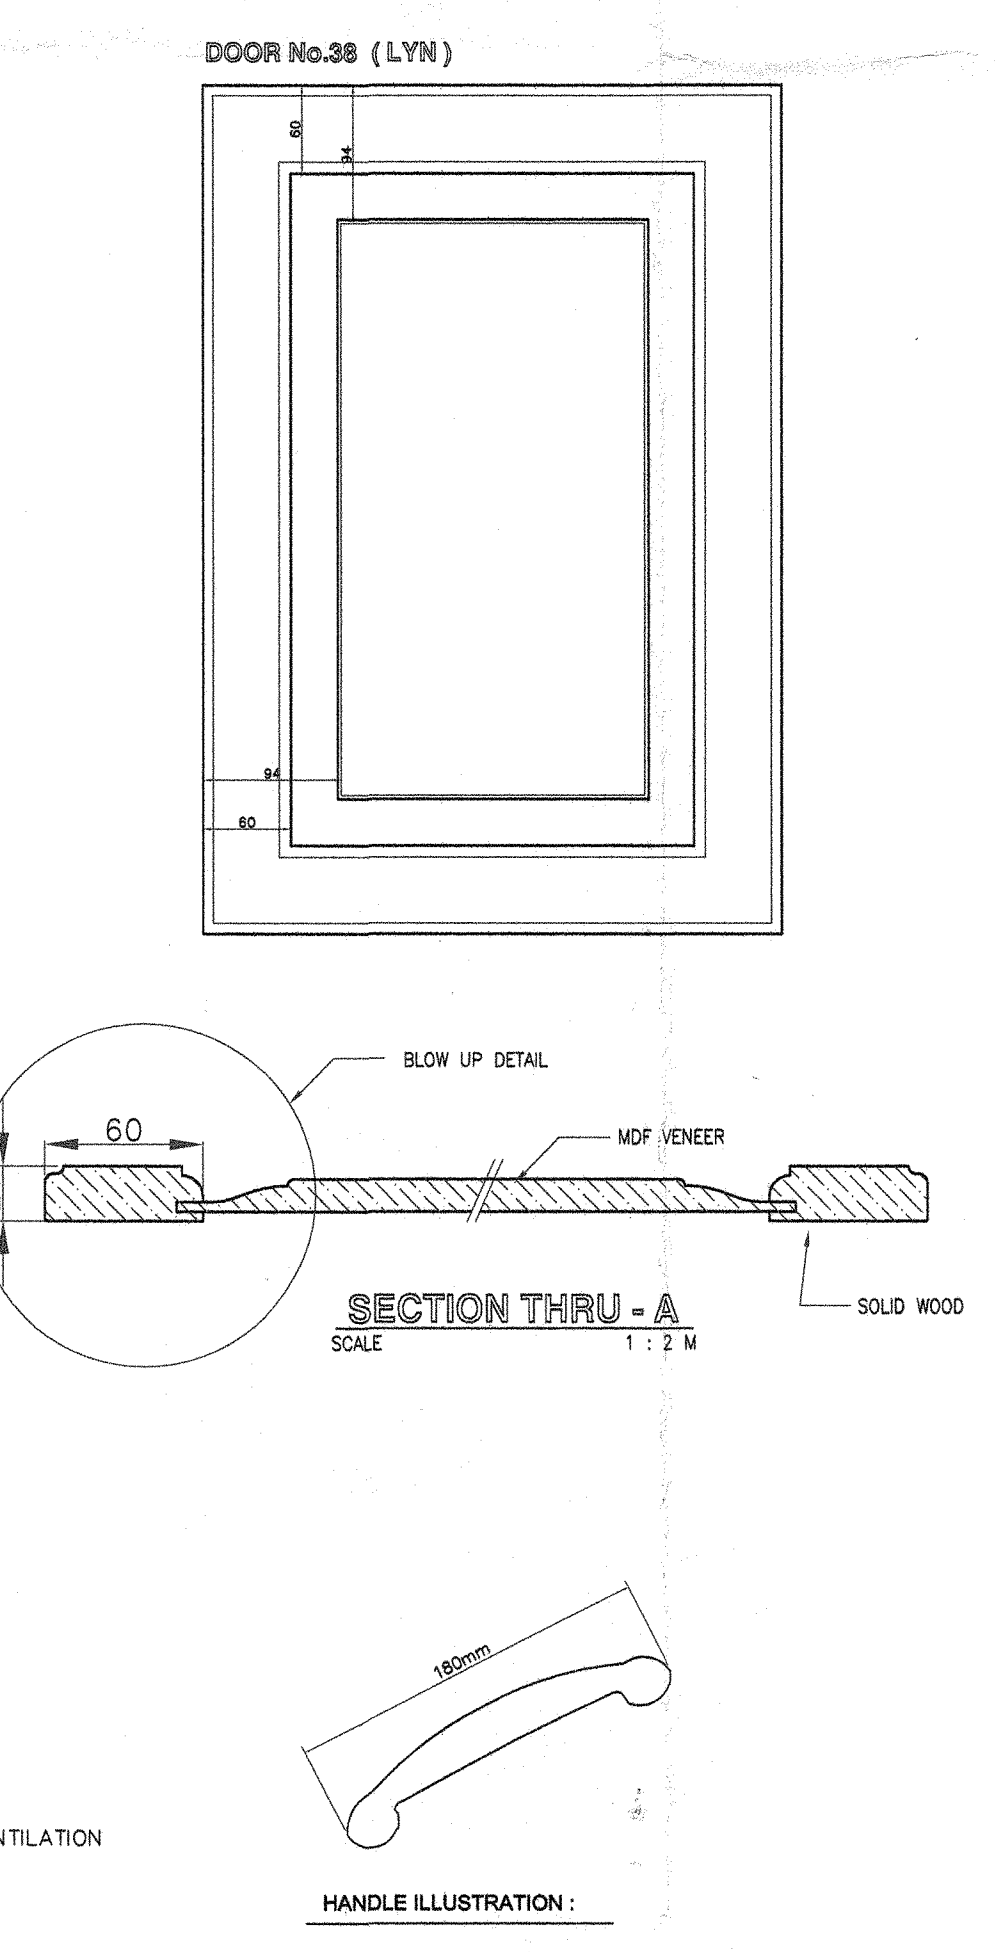
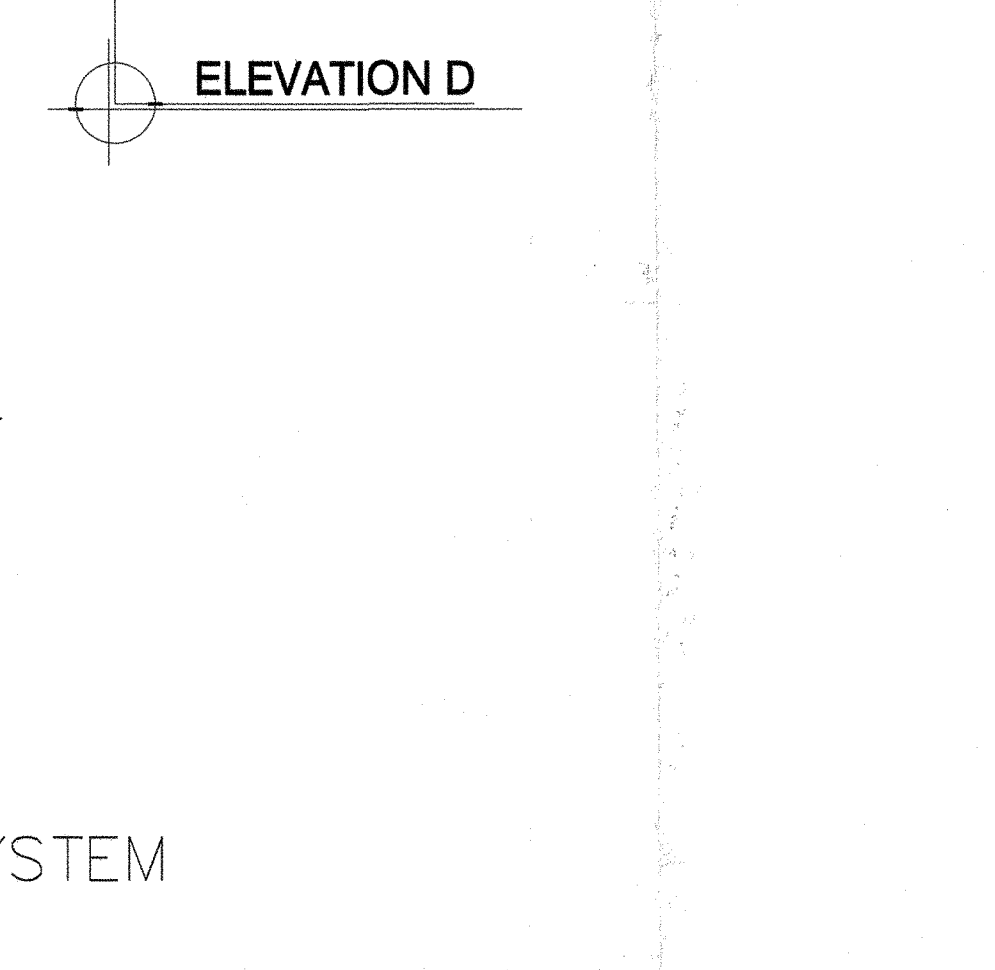
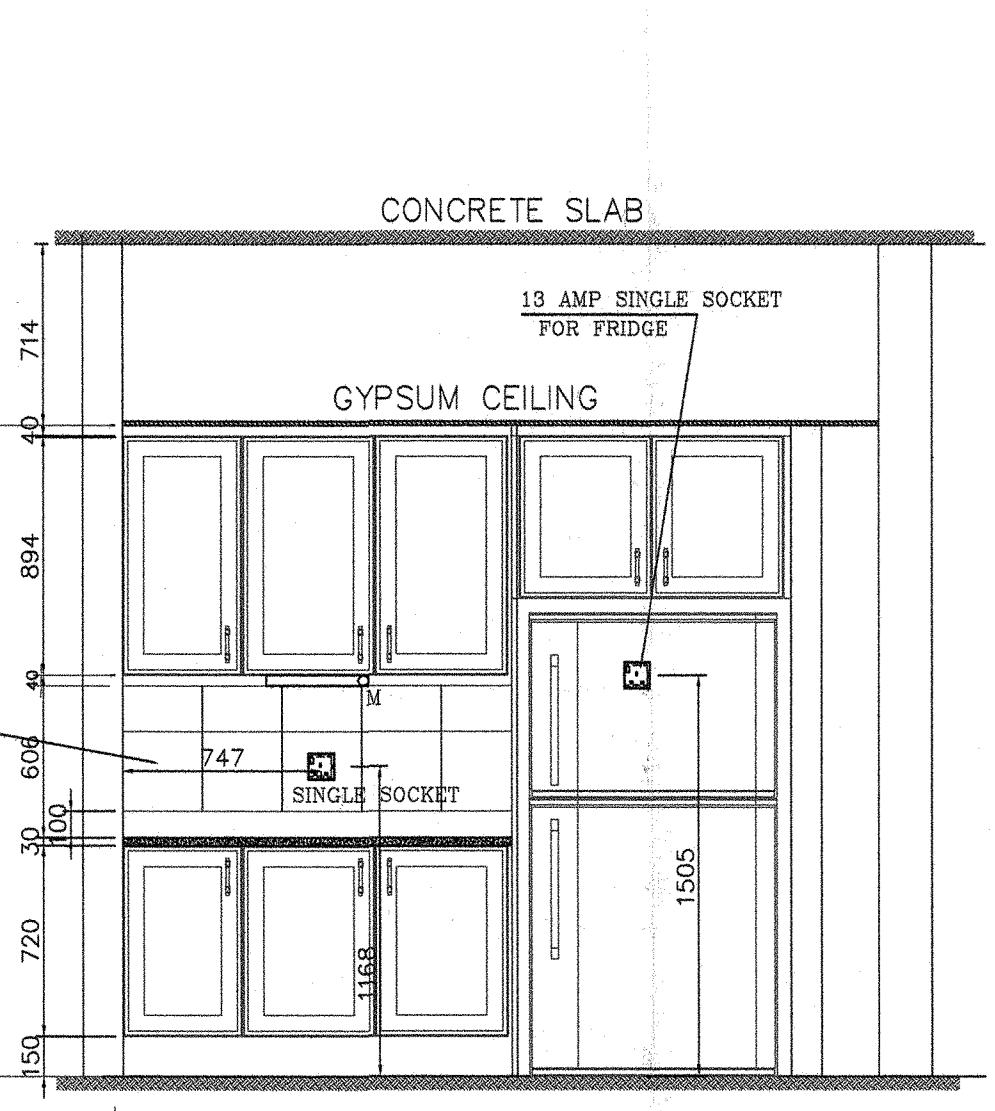


SYMBOL	DESCRIPTION
	1A SINGLE SWITCH SOCKET FOR HOOD FAN
	1A TWIN SWITCH SOCKET
	2A 25 SWITCH-175V INDICATOR FOR 1A
	DOUBLE POLE SWITCH WITH NON-INTERCHANGEABLE, OUTLET FOR ELECTRIC COOKER-45A, TYPE 520
	ONE-WAY SWITCHES
	DOUBLE POLE SWITCH
	VARIABLE SWITCH FOR EXHAUST FAN
	ONE-WAY/TWO GANG SWITCHES
	TWO-WAY SWITCHES
	TWO-WAY/TWO GANG SWITCHES
	1/4W OUTLET SINGLE
	1/4W OUTLET DUAL
	1/2W OUTLET FOR DISH WASHER
	1/2W OUTLET FOR DISH WASHER
	1/2W OUTLET FOR SINK
	1/2W OUTLET FOR SINK
	THERMOSTAT ELECTRIC
	SURFACE MOUNTED FLUORESCENCE HOUSING, 120W FLUORESCENT LAMP, LPD
	EMERGENCY SHUTOFF SWITCH FOR LPG
	KITCHEN GAS DETECTOR ALARM 220 V
	AUTOMATIC SHUTOFF VALVE FOR LPG
	SECURITY PANEL FOR e-Home Security

 dar al-handasah Civil and Petroleum	
☒ CODE 1 ☐ CODE 2 ☐ CODE 3 ☐ CODE 4	APPROVED APPROVED AS NOTED WORK MAY PROCEED SUBJECT TO INCORPORATION OF ENDSOED COMMENTS RESUBMIT FOR APPROVAL WORK MAY NOT PROCEED REJECTED
BY:	DATE:
Approval shall not relieve the contractor of any of his obligations under the Contract or constitute authorization of any change to Contract Documents or variation to the works. Contractor is responsible for dimensions, quantities and coordination with other trades.	

Handwritten: 22/08/2012
 Arch.: Code 01/11/2012

AS BUILT DRAWING

PROJECT **JUMEIRAH PARK**

EMPLOYER



NAKHEEL
EMIRATES TOWERS
19th LEVEL
P.O.BOX - 17777
DUBAI - UAE
TEL : 04-3903388
FAX : 04-3903335



CONSULTANT



dar al-handasah
shair and partners

DUBAI - BEIRUT - CAIRO
دبي - بيروت - القاهرة

MAIN CONTRACTOR



Pauling Middle East Co. L.L.C.

P.O. BOX: 51611, Dubai, U.A.E.
PHONE: + 971 - 4 - 4270340
FAX: + 971 - 4 - 4270341

SUB CONTRACTOR

AL MEERA KITCHEN L.L.C.

PHONE : + 971 - 4 - 3330722
FAX : + 971 - 4 - 3330018
Dubai, U.A.E.

PACKAGE

PACKAGE - 2 & 2A

DRAWING TITLE			
KITCHEN CABINET MEP - LEFT HANDED (LEGACY TRADITIONAL)			
SCALE	DATE	DRAWN BY	CHECKED BY

SCALE	DATE	DRAWN BY	CHECKED BY
1:50	21.08.2012	SIJAN	AHMED
JOB NO.	DRAWING NO		
V81	PME / JP / AB / MEP / KC - 002		