

Finishes Legend					
Reference	TRADITIONAL		Dimension (mm)	Application	Area
	Brand Name	Model			
CT-003	Pamesa	Saturani Beige	50 x 50	Splash Back and Breakfast bar Mosaic	Pantry
ST-001	Rosa Porinho			Work Top	Pantry

WALLNUT

CABINET HANGER ILLUSTRATION

2 WAY ADJUSTABLE

WALL NUT

SUSPENSION BRACKET

BACKBOARD

- 1.> CARCASE - 340mm Deep x 720mm ht. x 18mm thk. M.D.F. Fantasy MR
 - SIDE - Front edge 2mm P.V.C Lipping
 - 3 sides 0.5mm P.V.C Lipping
 - BOTTOM - Front Edge 2mm P.V.C. Lipping

- 3.> BACK BOARD - 6 mm THK. Standard

- 6.> DOOR - Solid Wood Colour Natural Oak Almeera Lyn 38
 - See attached plan

- 7.> HINGES - Clip-on 110° With silent Damper

- Loading capacity 55kg / pc.

- 8.> CABINET HANGER - Fixed on the side of the cabinet

- 9.> HANDLE - HND-02113 see attached plan

- 10.> LAMP - 21 watts flourescent lamp

BASE UNIT

- 1.> CARCASE - 560mm Deep x 720 ht. 18mm THK M.D.F. MR
 - SIDE - Front Edge 2mm P.V.C. Lipping
 - other 3 sides 0.4mm P.V.C. Lipping
 - BOTTOM - Front Edge 2mm P.V.C. Lipping

- 2.> GRANITE - Worktop MISTY YELLOW

- 2.> TOPWOOD - Front edge 2mm P.V.C. Lipping

GRANITE WORKTOP

- 4.> BACK BOARD - 6 mm THK Standard.

- 5.> CABINET LEGS - 150mm ht. Adjustable

- 6.> BASEBOARD - 150mm ht. hard P.V.C movable


CERAMIC TILES

RUBBER



SECTION A-A

sim nts. f 3JA32


DOOR No.38 (LYN)

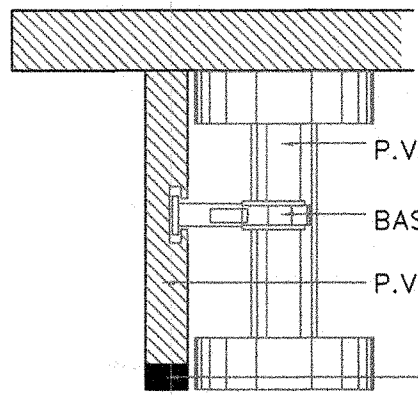

BASEBOARD ILLUSTRATION

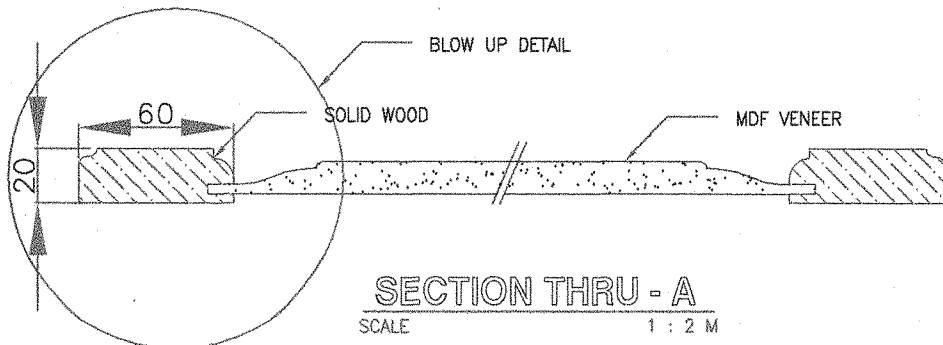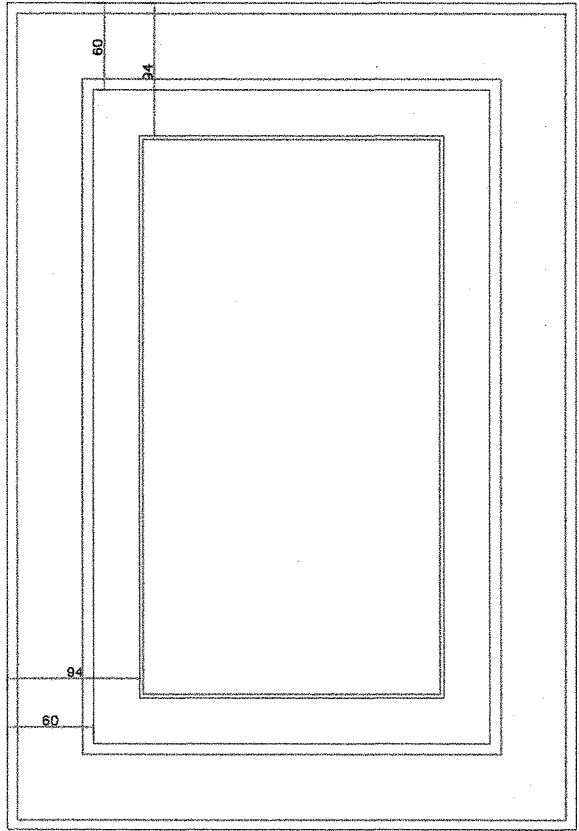

SECTION THRU - A
SCALE 1 : 2 M

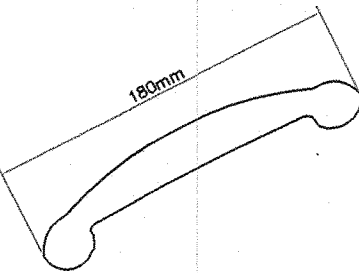

HANDLE ILLUSTRATION :
KITCHEN HANDLE TRADITIONAL

dar al-handasah

Shair and Partners

CODE 1

APPROVED

CODE 2

APPROVED AS NOTED

WORK MAY PROCEED SUBJECT TO

INCORPORATION OF ENDORSED

COMMENTS

CODE 3

RESUBMIT FOR APPROVAL

WORK MAY NOT PROCEED

CODE 4

REJECTED

BY:

DATE:

Approval shall not relieve the contractor of any of his


obligations under the Contract or constitute authorization of

any change to Contract Documents or variation to the works.

Contractor is responsible for dimensions, quantities and

coordination with other trades.

Key plan

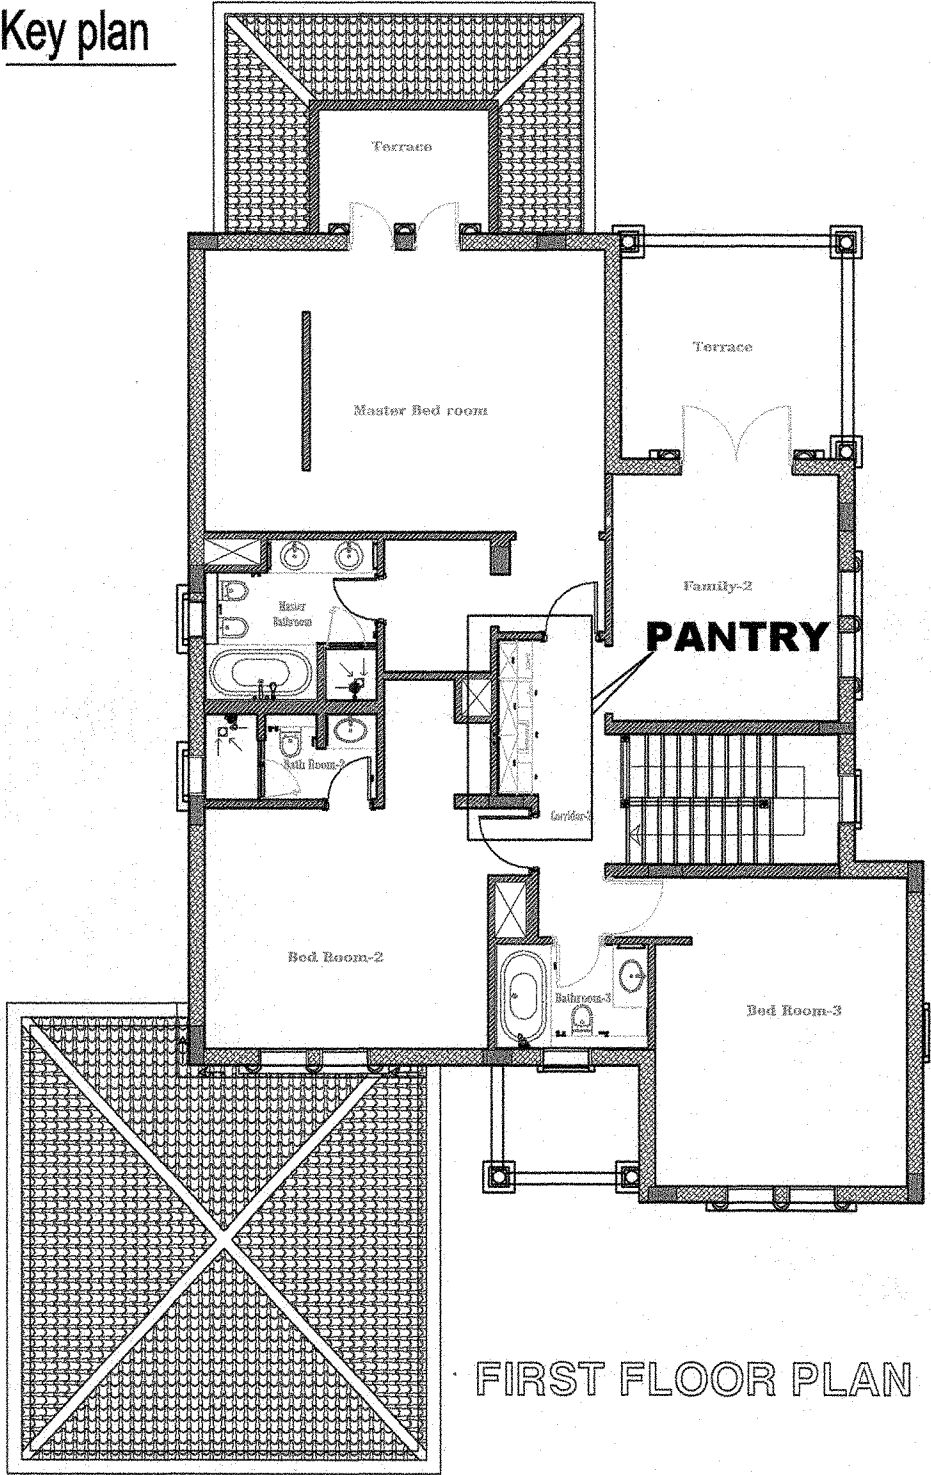

FIRST FLOOR PLAN

LEGEND:-

CLUSTER # 3 (P2)
VILLA # 5

AS BUILT DRAWING

PROJECT
JUMEIRAH PARK

EMPLOYER



NAKHEEL

EMIRATES TOWERS


19th LEVEL

P.O. BOX - 17777

DUBAI - UAE

TEL : 04-3903388

FAX : 04-3903335

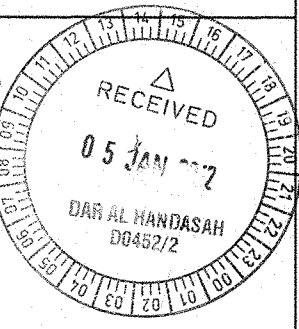

CONSULTANT



dar al-handasah

shair and partners

DUBAI - BEIRUT - CAIRO

دبي - بيروت - القاهرة

MAIN CONTRACTOR



Pauling Middle East Co. L.L.C.

P.O. BOX 51811, Dubai, U.A.E.

PHONE : + 971 - 4 - 4270000

FAX : + 971 - 4 - 4270000

E-MAIL : pauling@emirates.net.ae

PACKAGE

PACKAGE - 2 & 2A

CONTRACTOR

AL MEERA



KITCHENS L.L.C.

THE REAL KITCHEN

DRAWING TITLE

**PANTRY DETAILS LEFT HANDED
TRADITIONAL**

SCALE	1:50	DATE	03.01.2012	DRAWN BY	SIJAN	CHECKED BY	AHMED
JOB NO.	V81	DRAWING NO					
REV	0						

PME / JP / AB / PA / TLH - 002

AB
020
R.1