


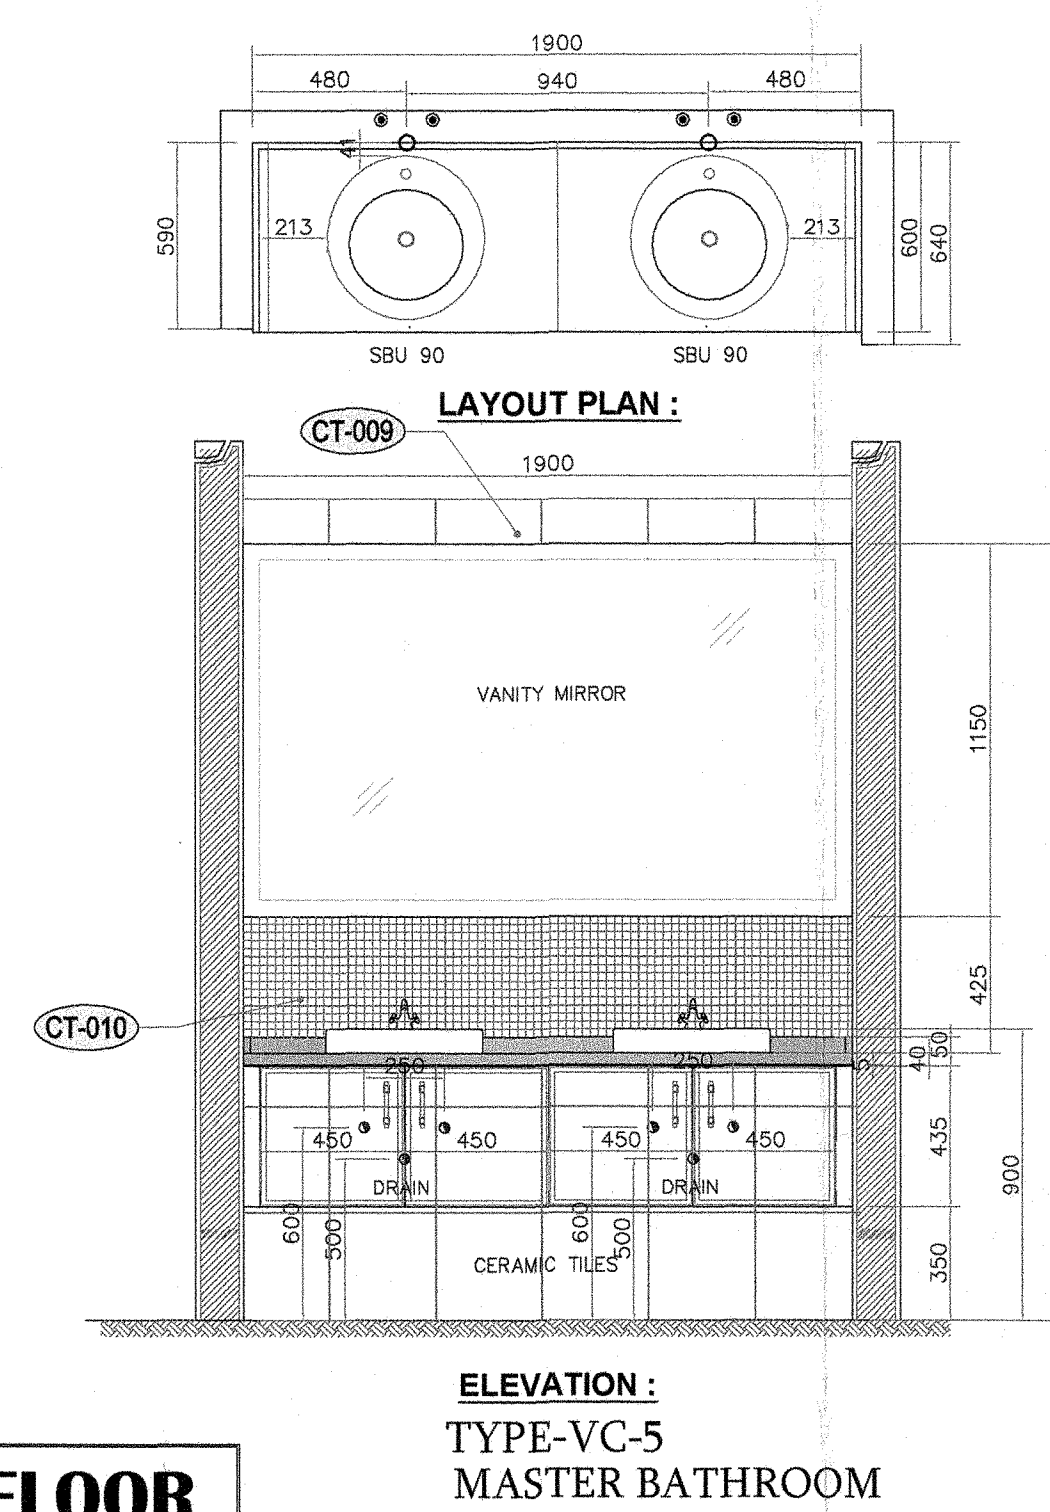
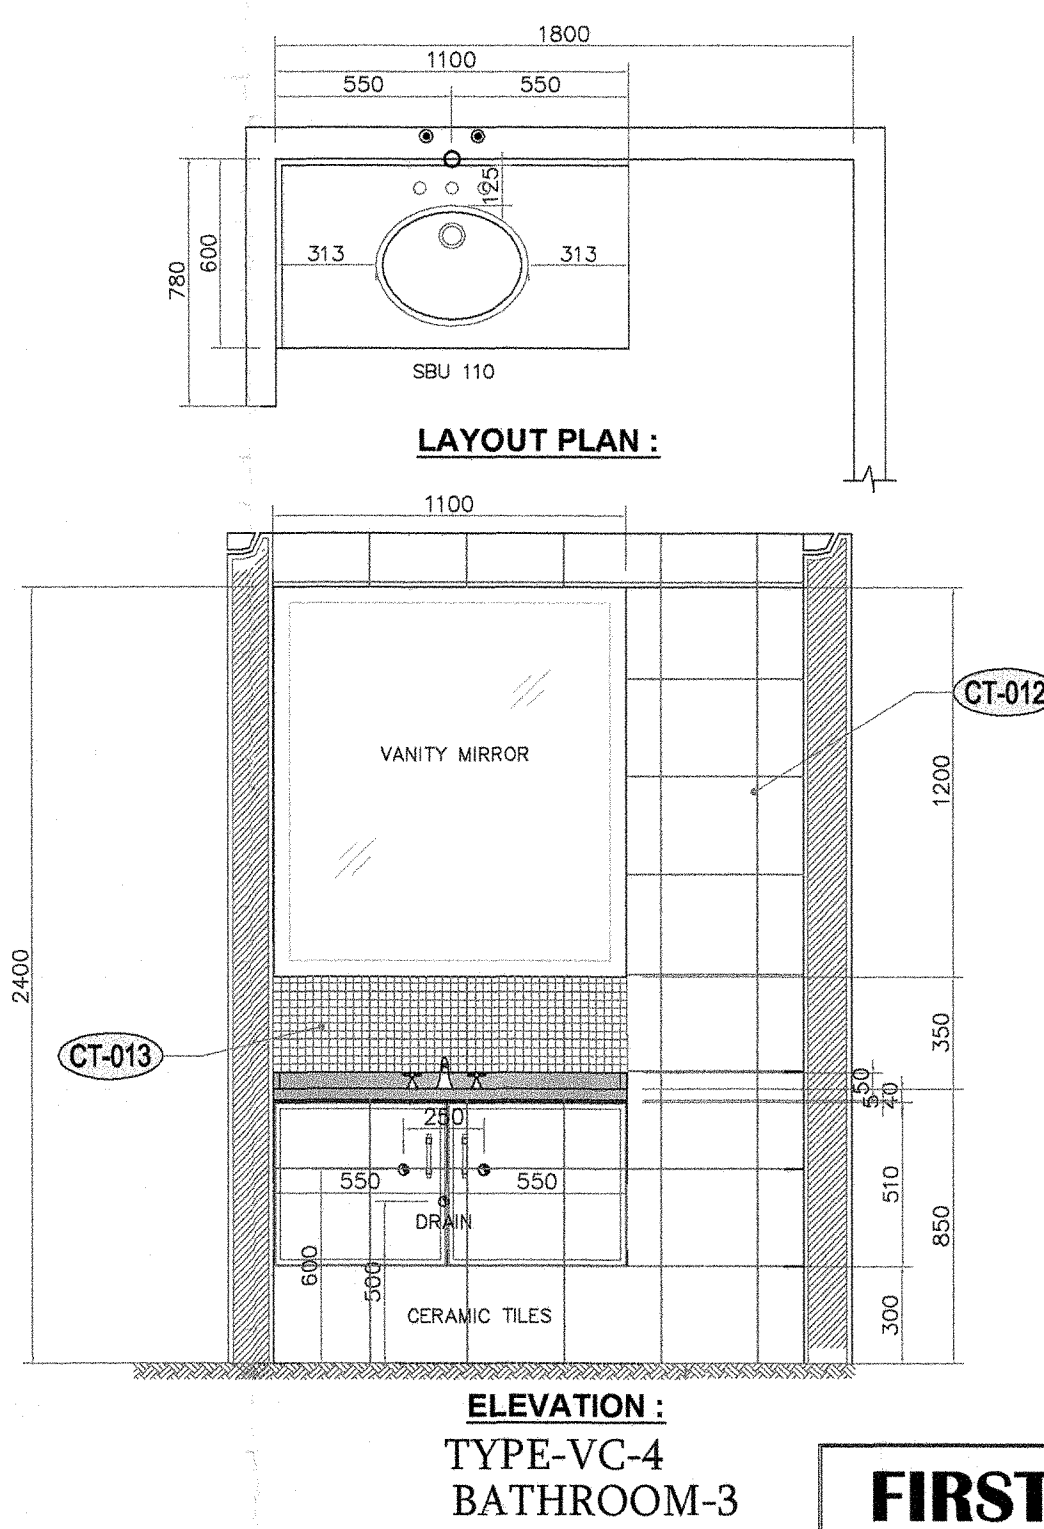
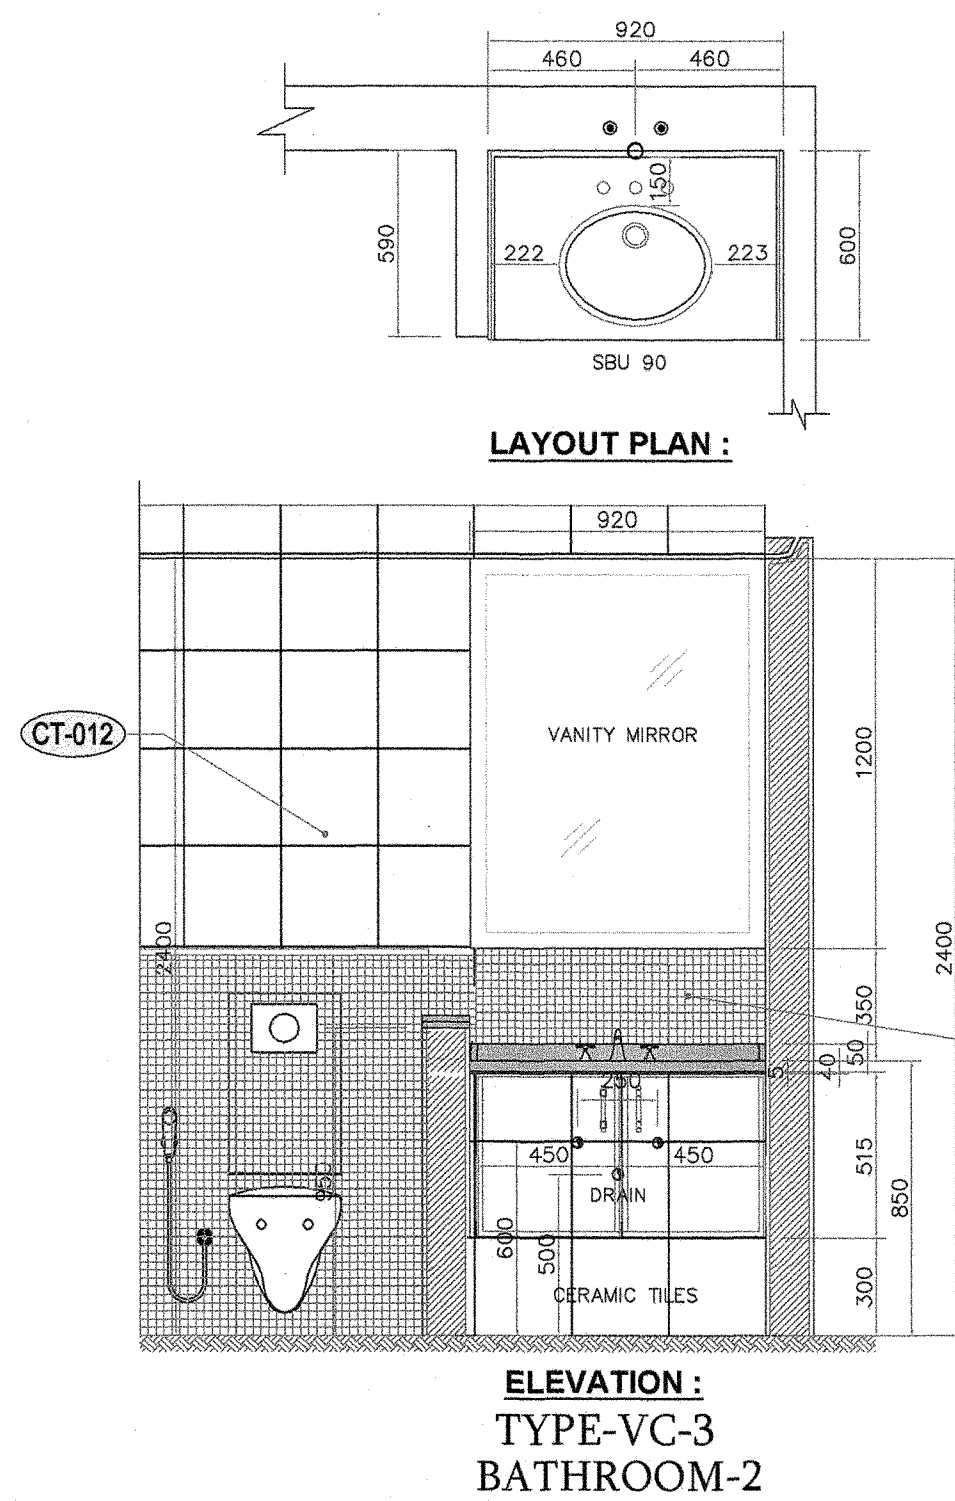
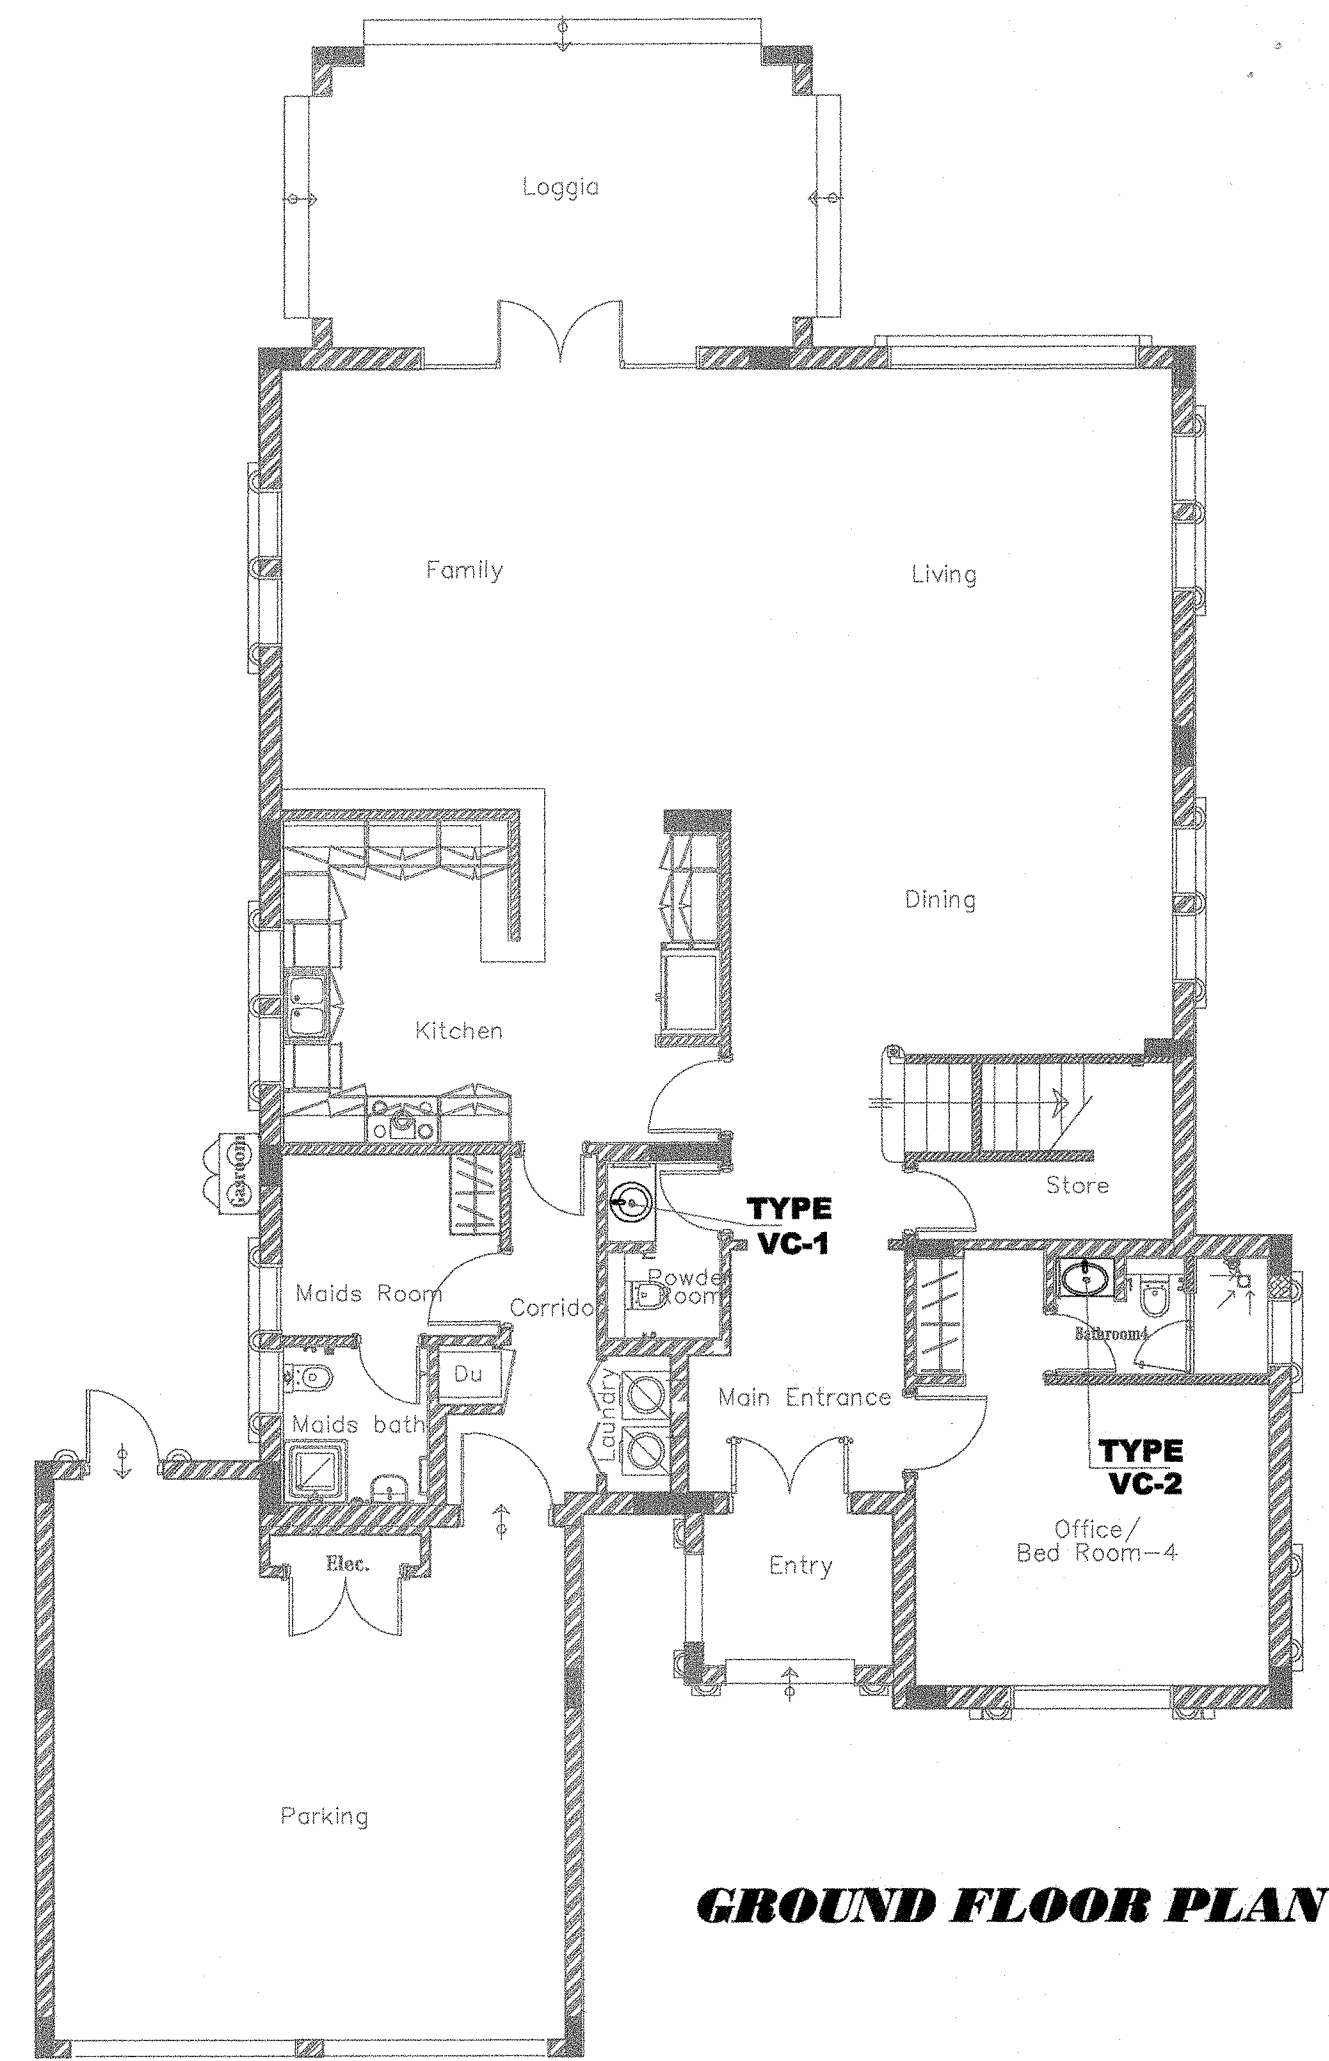
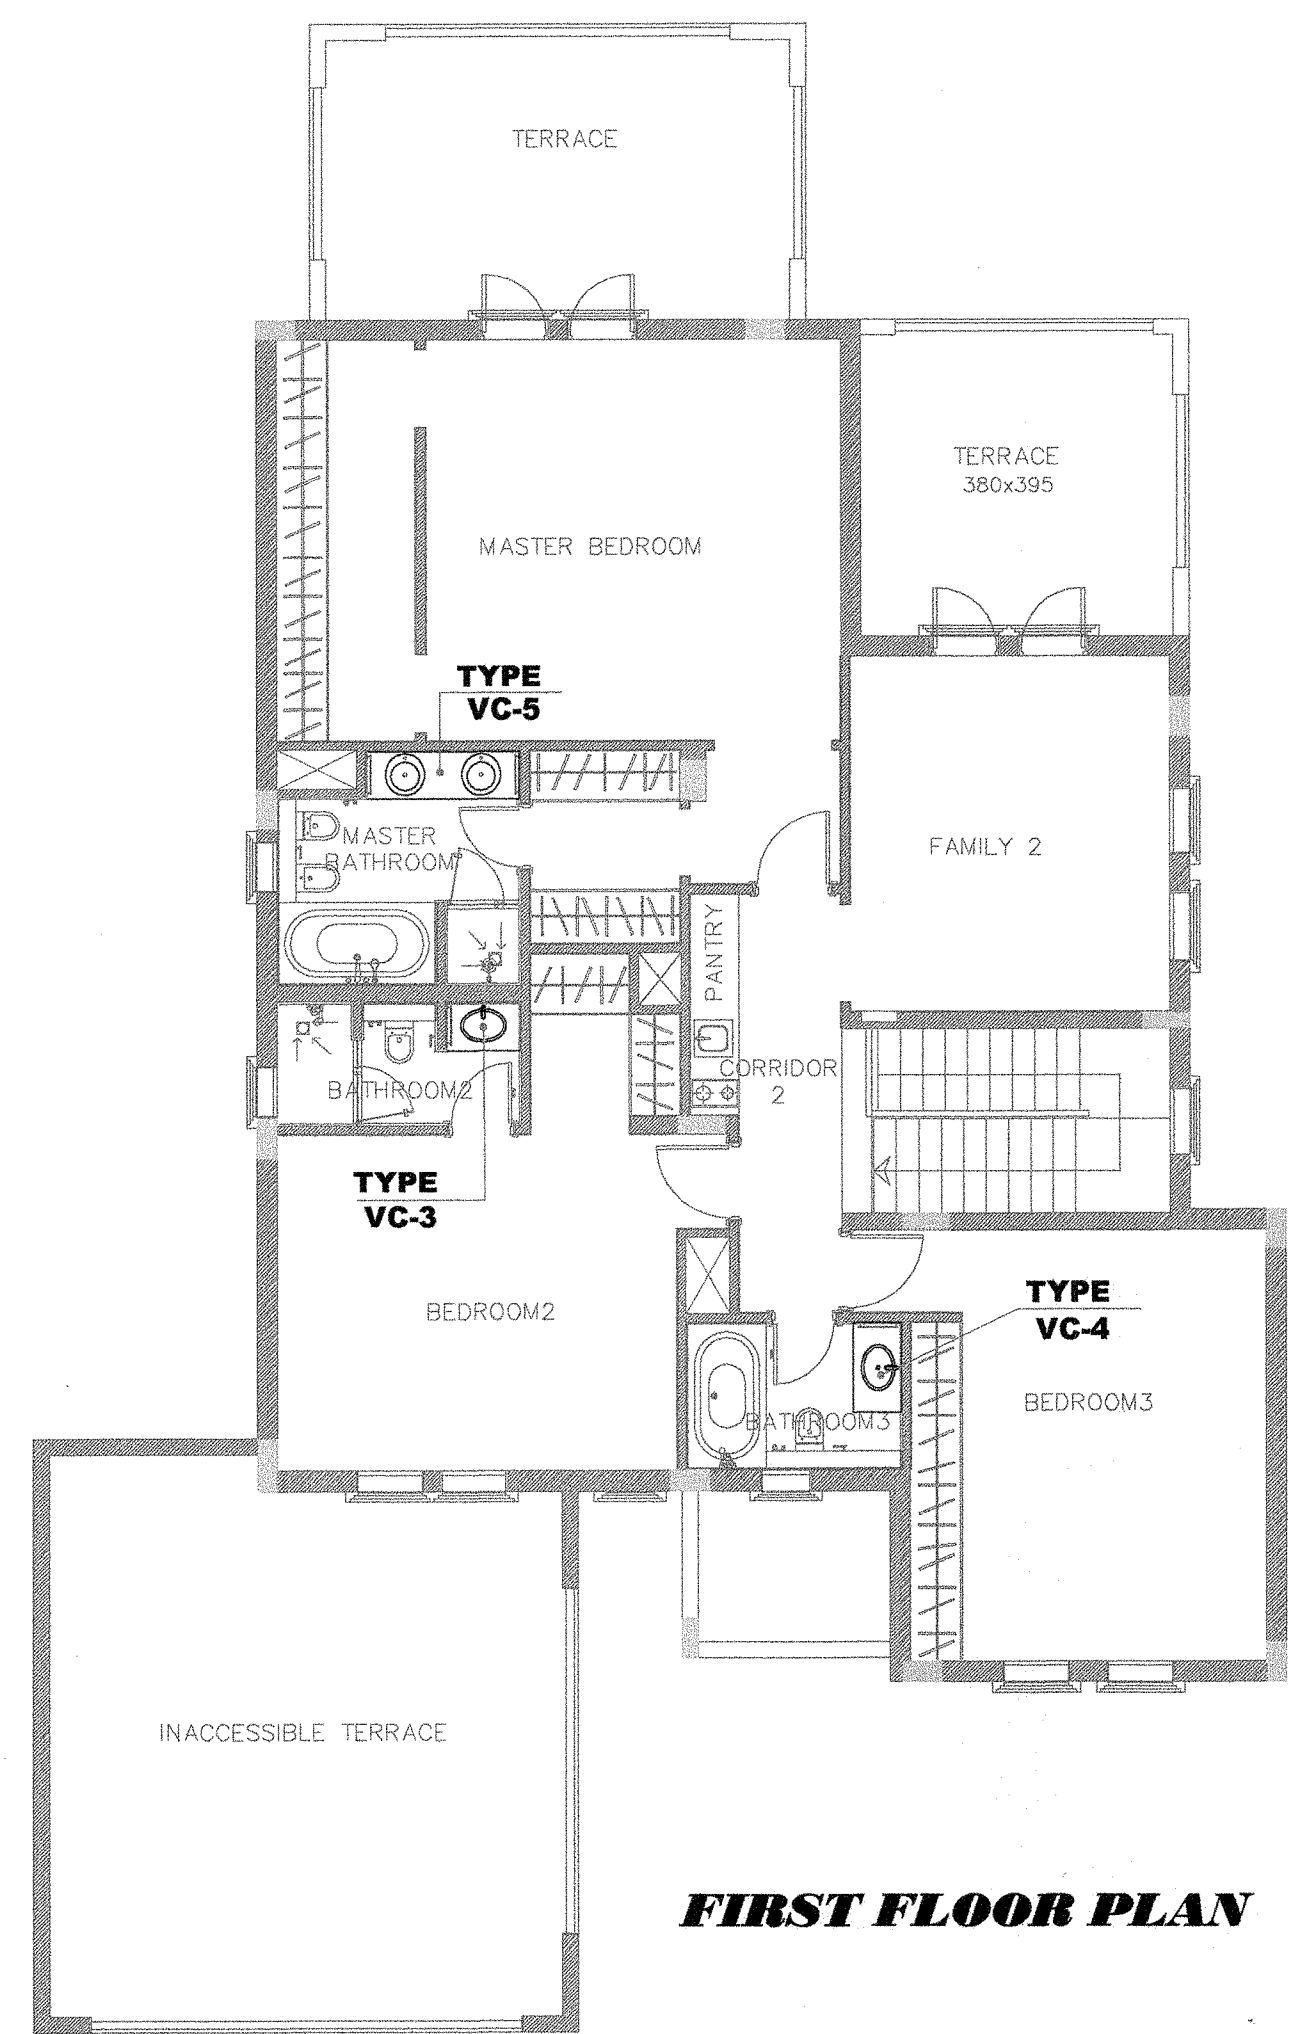


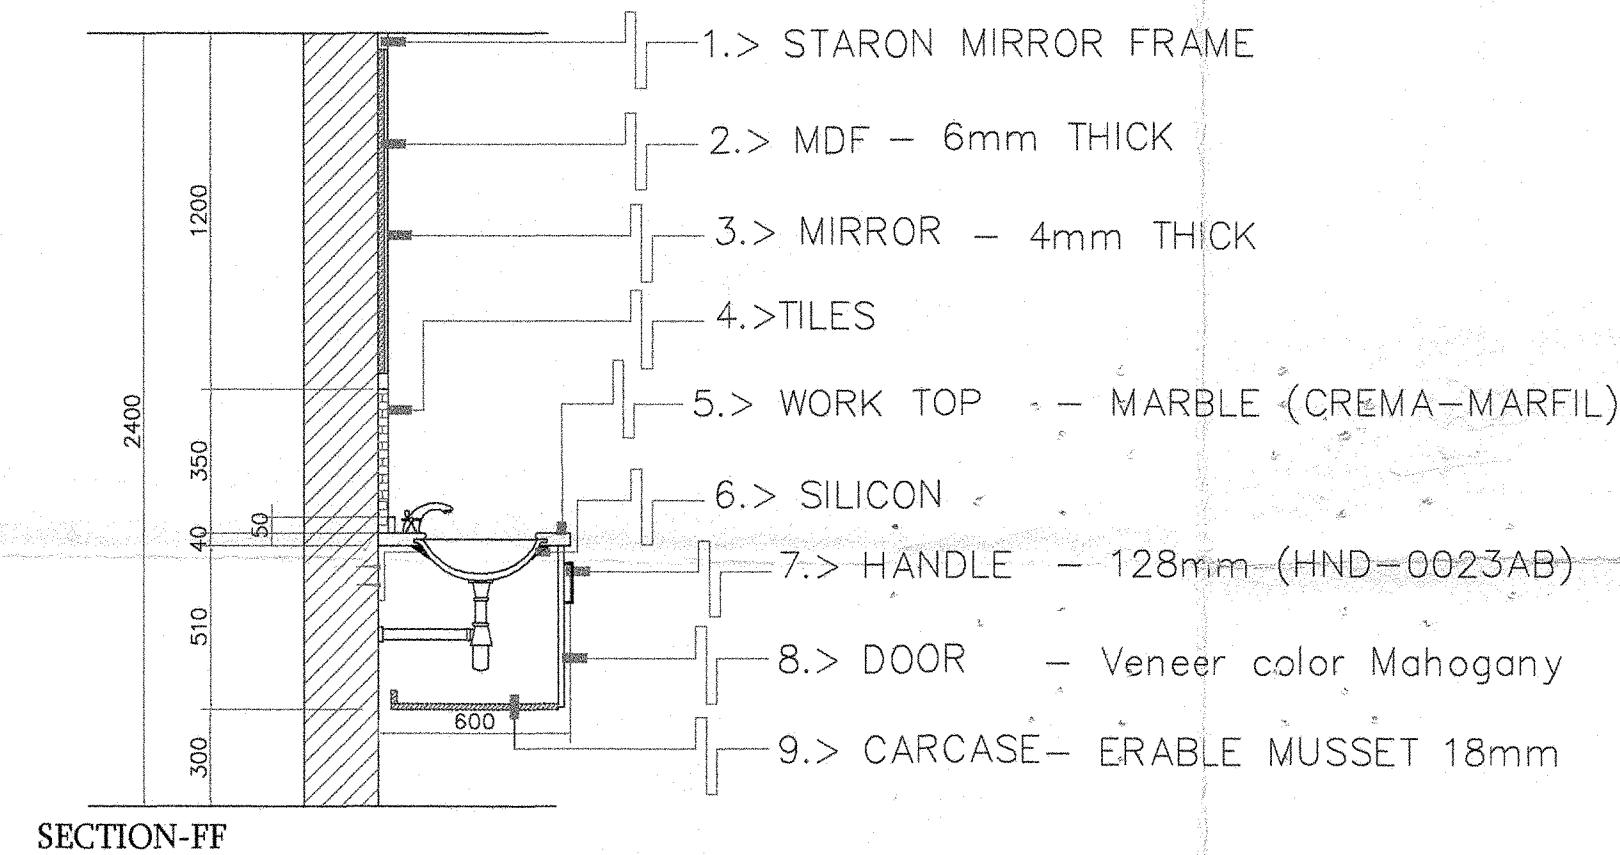


## FIRST FLOOR

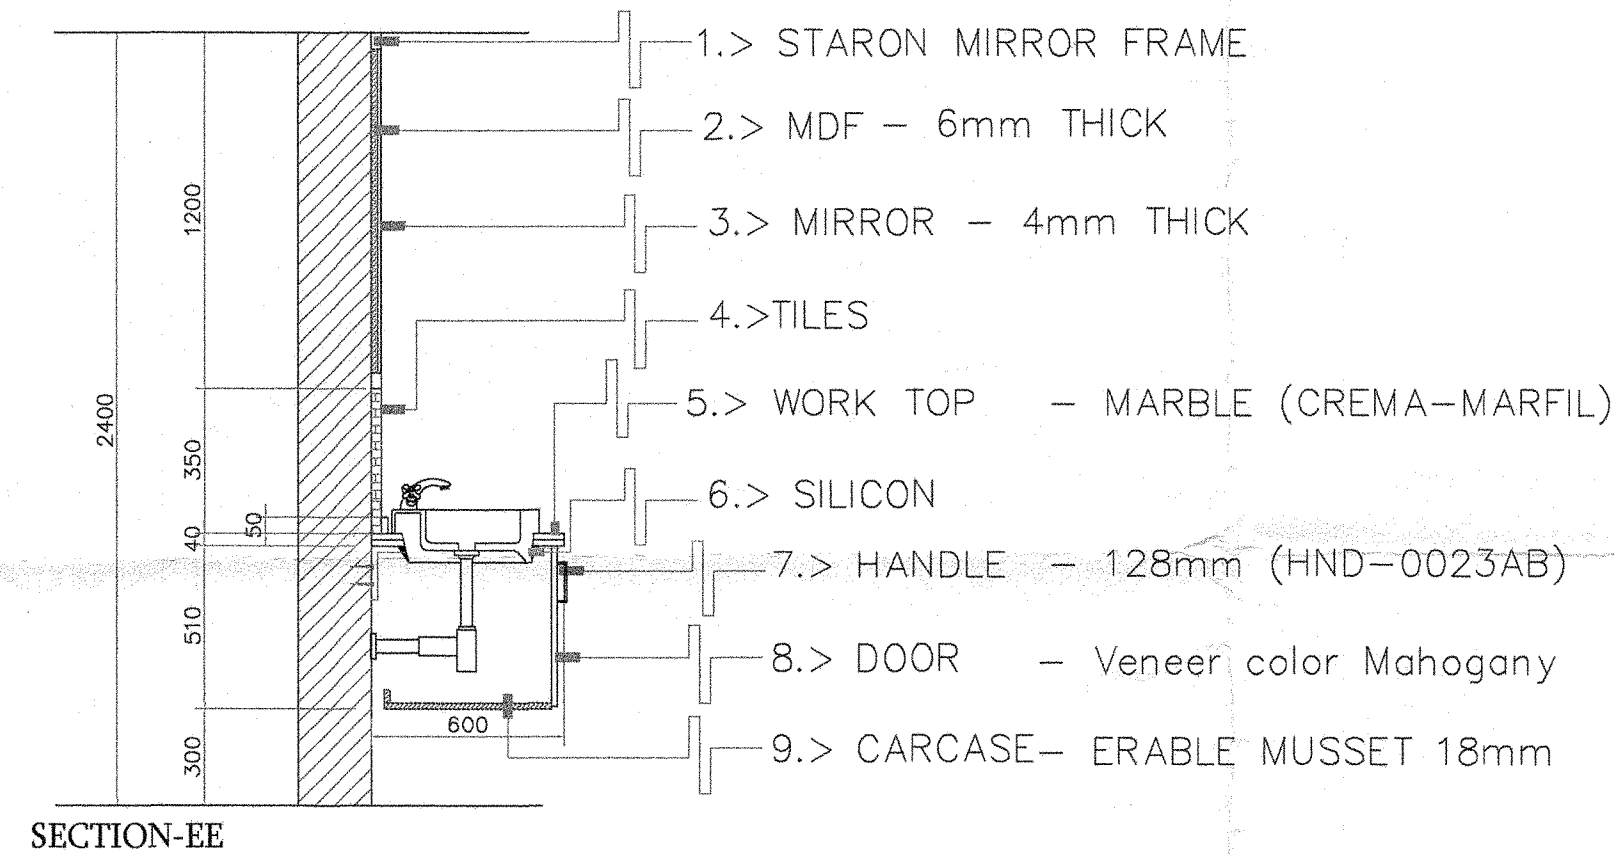


## DETAIL OF DOOR

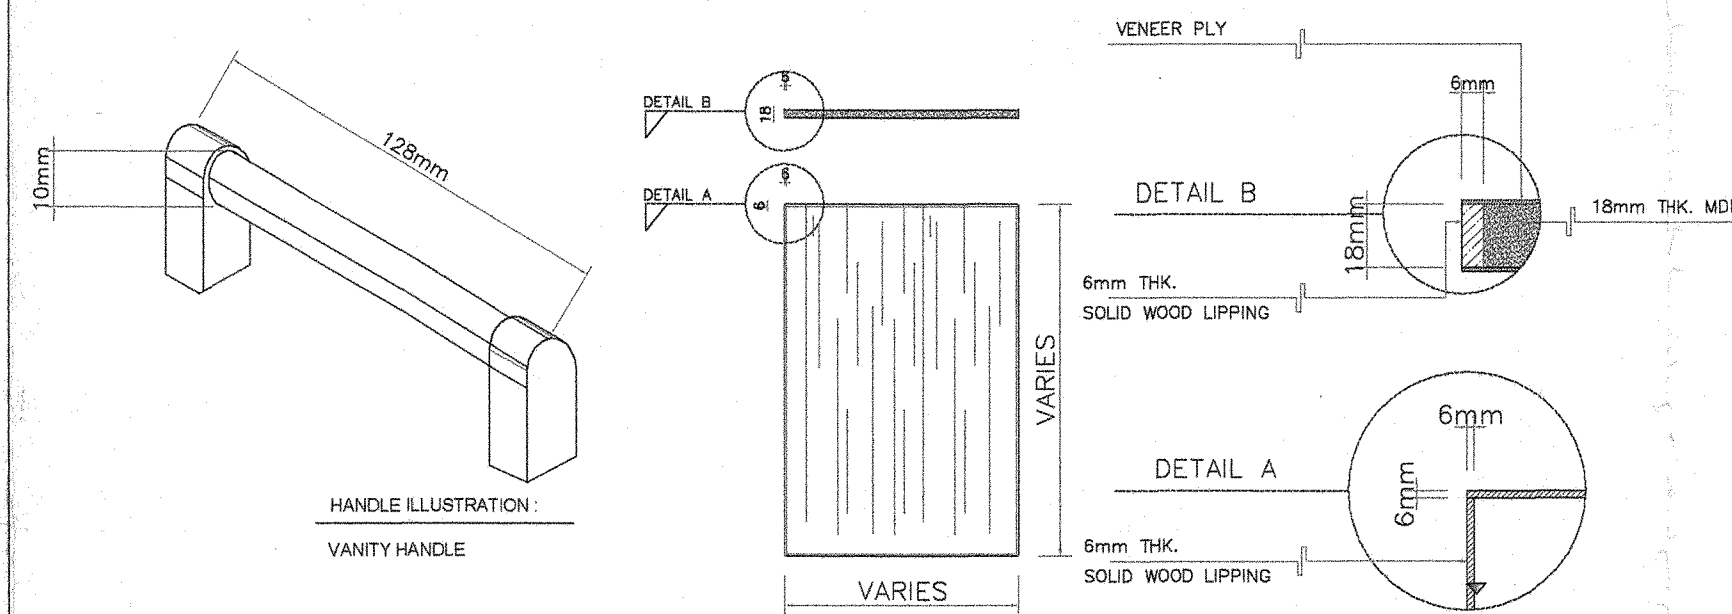

## SECTION FOR MIRROR WITH 90° WALL AND MIRROR WITH TILES

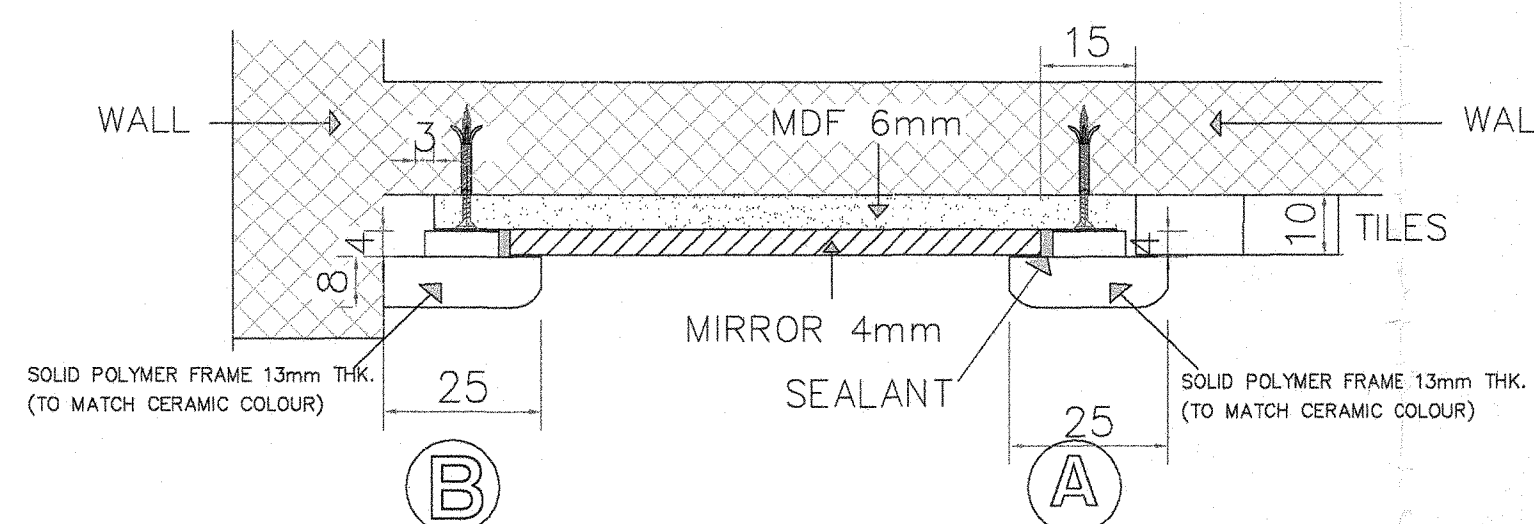

| Finishes Legend |             |              |                     |             |                           |
|-----------------|-------------|--------------|---------------------|-------------|---------------------------|
| Reference       | Traditional |              | Dimension<br>( mm ) | Application | Area                      |
|                 | Brand Name  | Model        |                     |             |                           |
| CT-009          | Azulbur     | JV 302       | 330 x 330           | Walls       | Master Bath & Powder Room |
| CT-010          | Azulbur     | JV 302       | 25 x 25             | Wall Mosaic | Master Bath & Powder Room |
| CT-012          | Pamesa      | Ikoni Bianco | 300 x 300           | Walls       | General Bathroom 2, 3 & 4 |
| CT-013          | Pamesa      | Tibet Marfil | 25 x 25             | Wall Mosaic | General Bathroom 2, 3 & 4 |

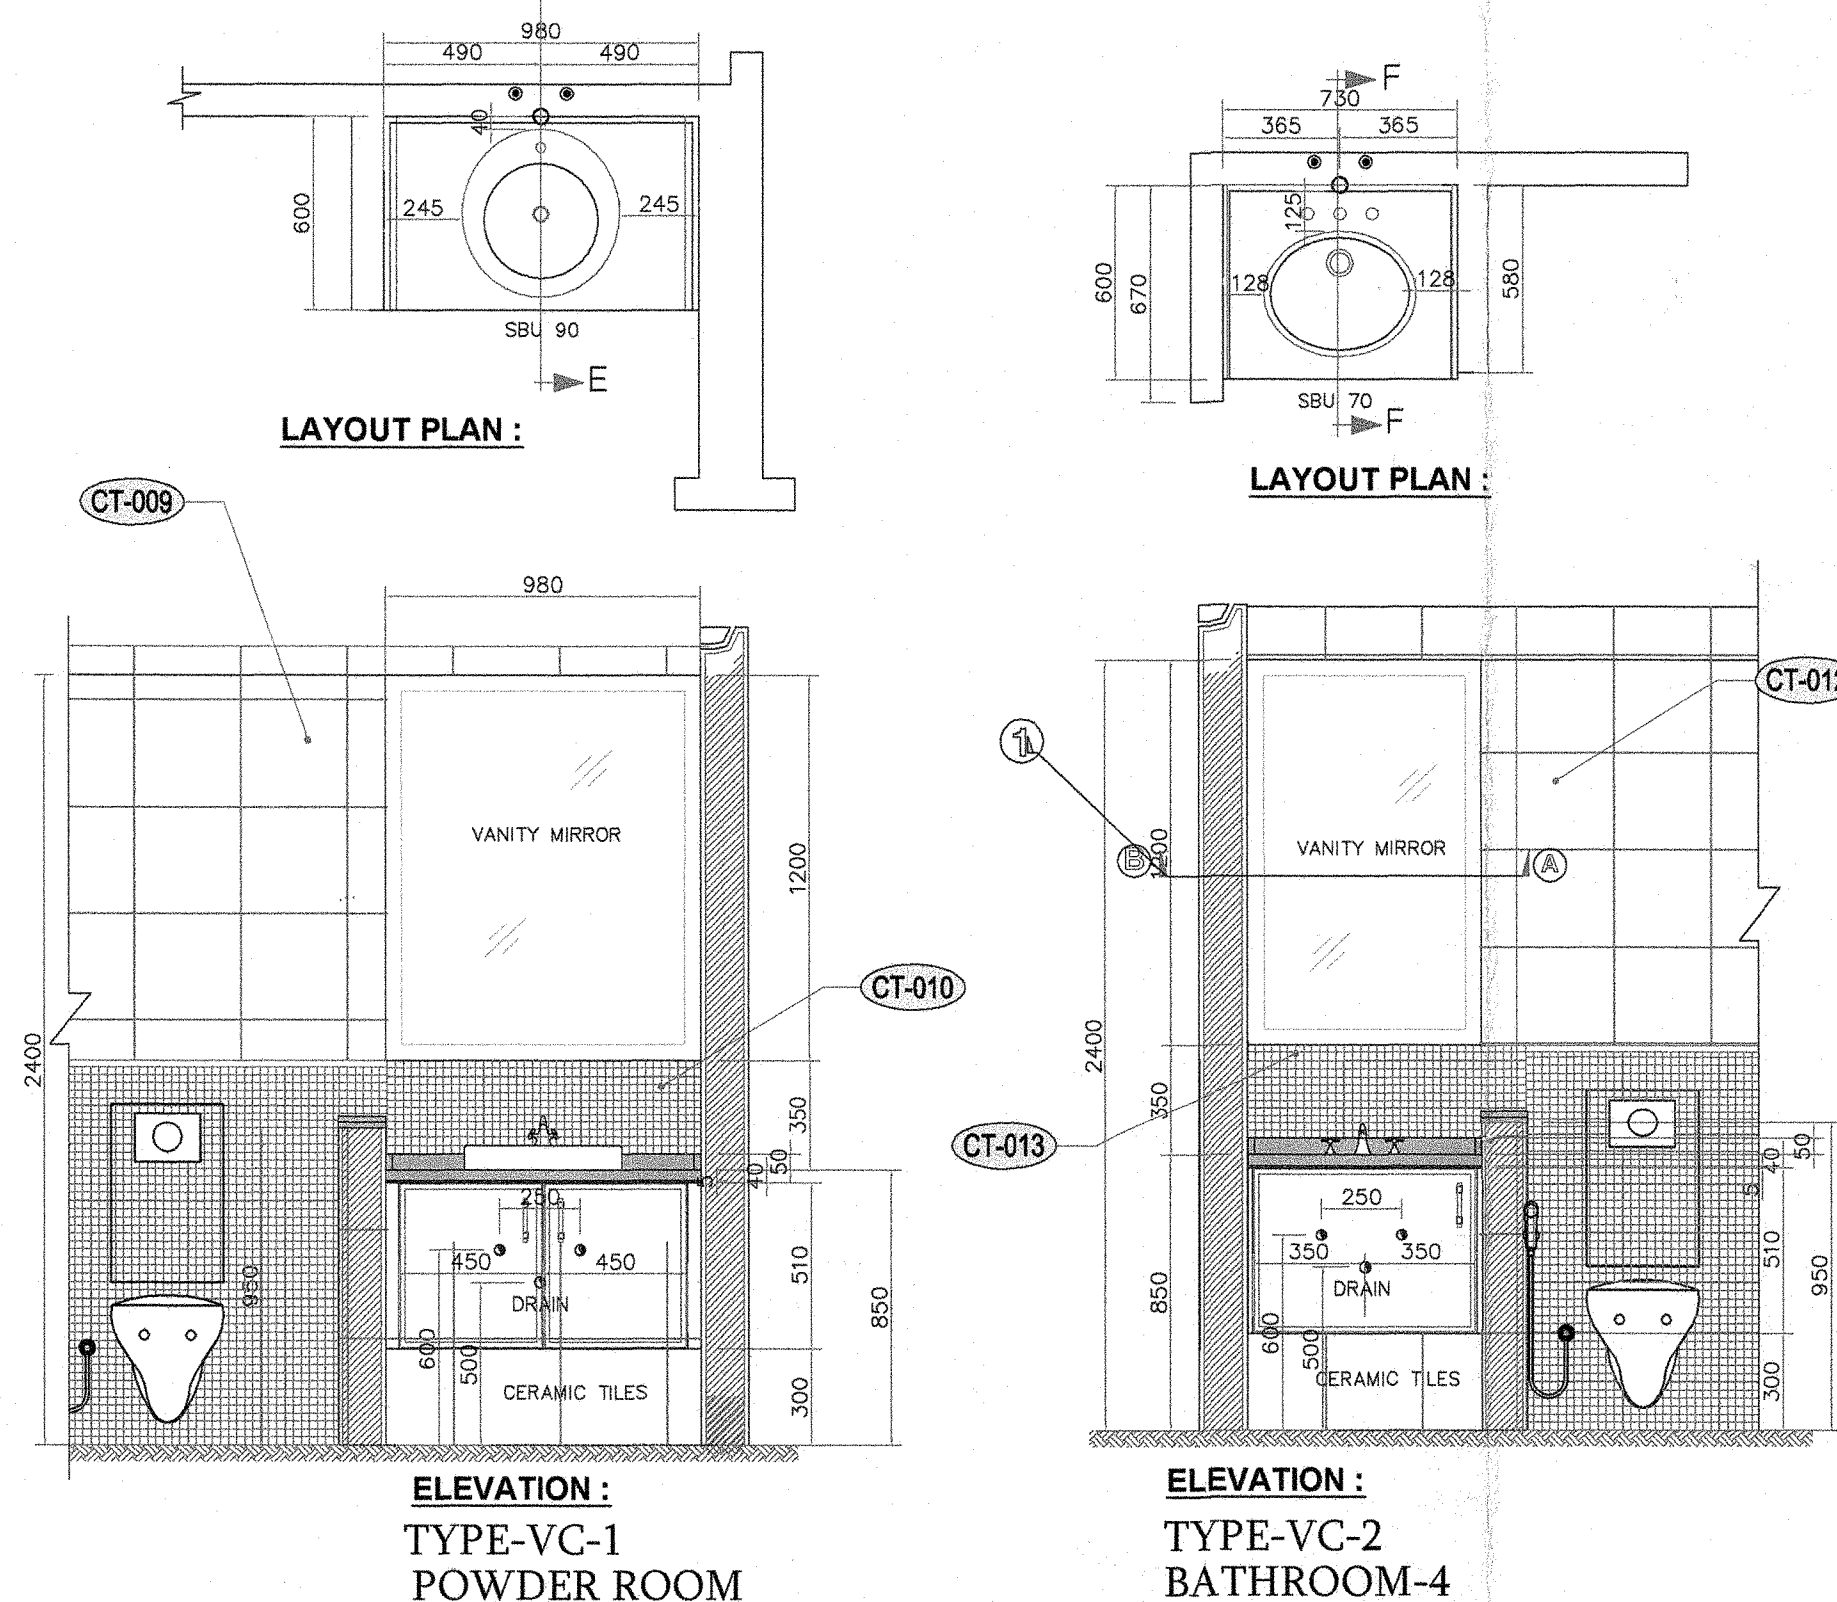

## GROUND FLOOR

## CLUSTER #3 (P2) VILLA #7

## LEGEND:-

dar al-handasah  
Shair and Partners

CODE 1 APPROVED  
CODE 2 APPROVED AS NOTED  
CODE 3 RESUBMIT FOR APPROVAL  
CODE 4 REJECTED

BY: DATE:

Approval shall not relieve the contractor of any of his obligations under the Contract or constitute authorization of any change to Contract Documents or variation to the works. Contractor is responsible for dimensions, quantities and coordination with other trades.

5/6/2012

## AS BUILT DRAWING

PROJECT **JUMEIRAH PARK**

EMPLOYER **NAKHEEL**  
EMIRATES TOWERS  
19th LEVEL  
P.O. BOX - 17777  
DUBAI - UAE  
TEL : 04-3903388  
FAX : 04-3903335

CONSULTANT **dar al-handasah**  
shair and partners  
DUBAI - BEIRUT - CAIRO  
الهندسة - بيروت - القاهرة

MAIN CONTRACTOR **Pauling Middle East Co. L.L.C.**  
P.O. BOX: 15411, DUBAI, U.A.E.  
PHONE: F: 971-4-4270600  
PAX: F: 971-4-427060  
E-MAIL: pauling@pauling-llc.com

PACKAGE **PACKAGE - 2 & 2A**

CONTRACTOR **AL MEERA**  
KITCHENS L.L.C.  
THE REAL KITCHEN  
e-mail: almeera@almeera.ae

DRAWING TITLE **VANITY COUNTER DETAILS LEFT HANDED TRADITIONAL**

SCALE 1:20 DATE 20.03.2012 DRAWN BY dj@m CHECKED BY OSAMA

PME / JP / AB / VC / TLH - 002