

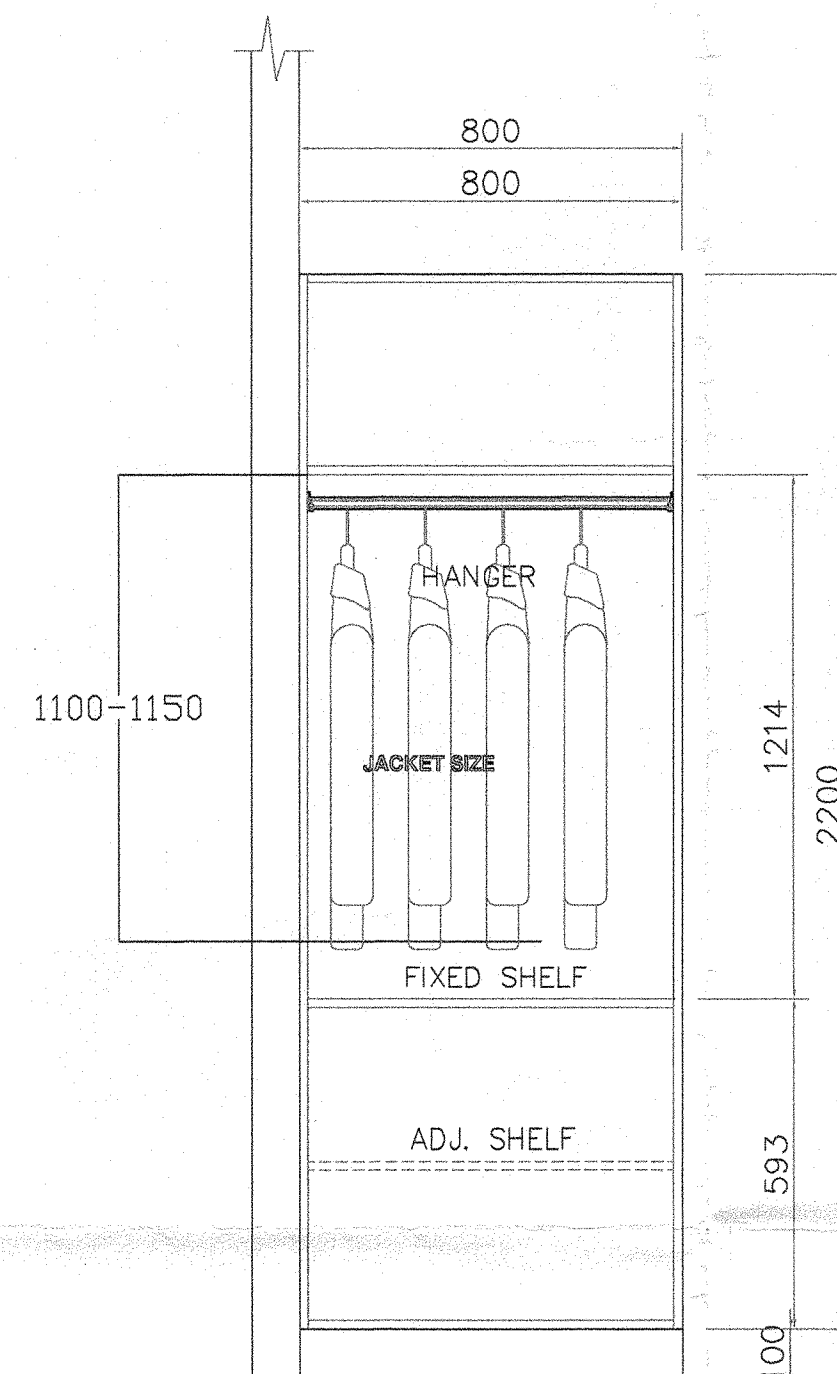
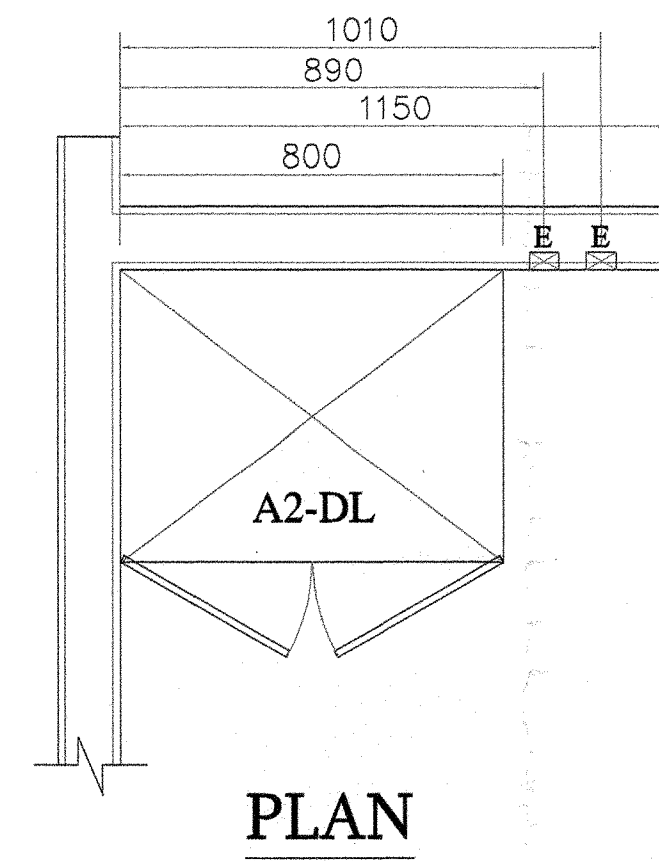
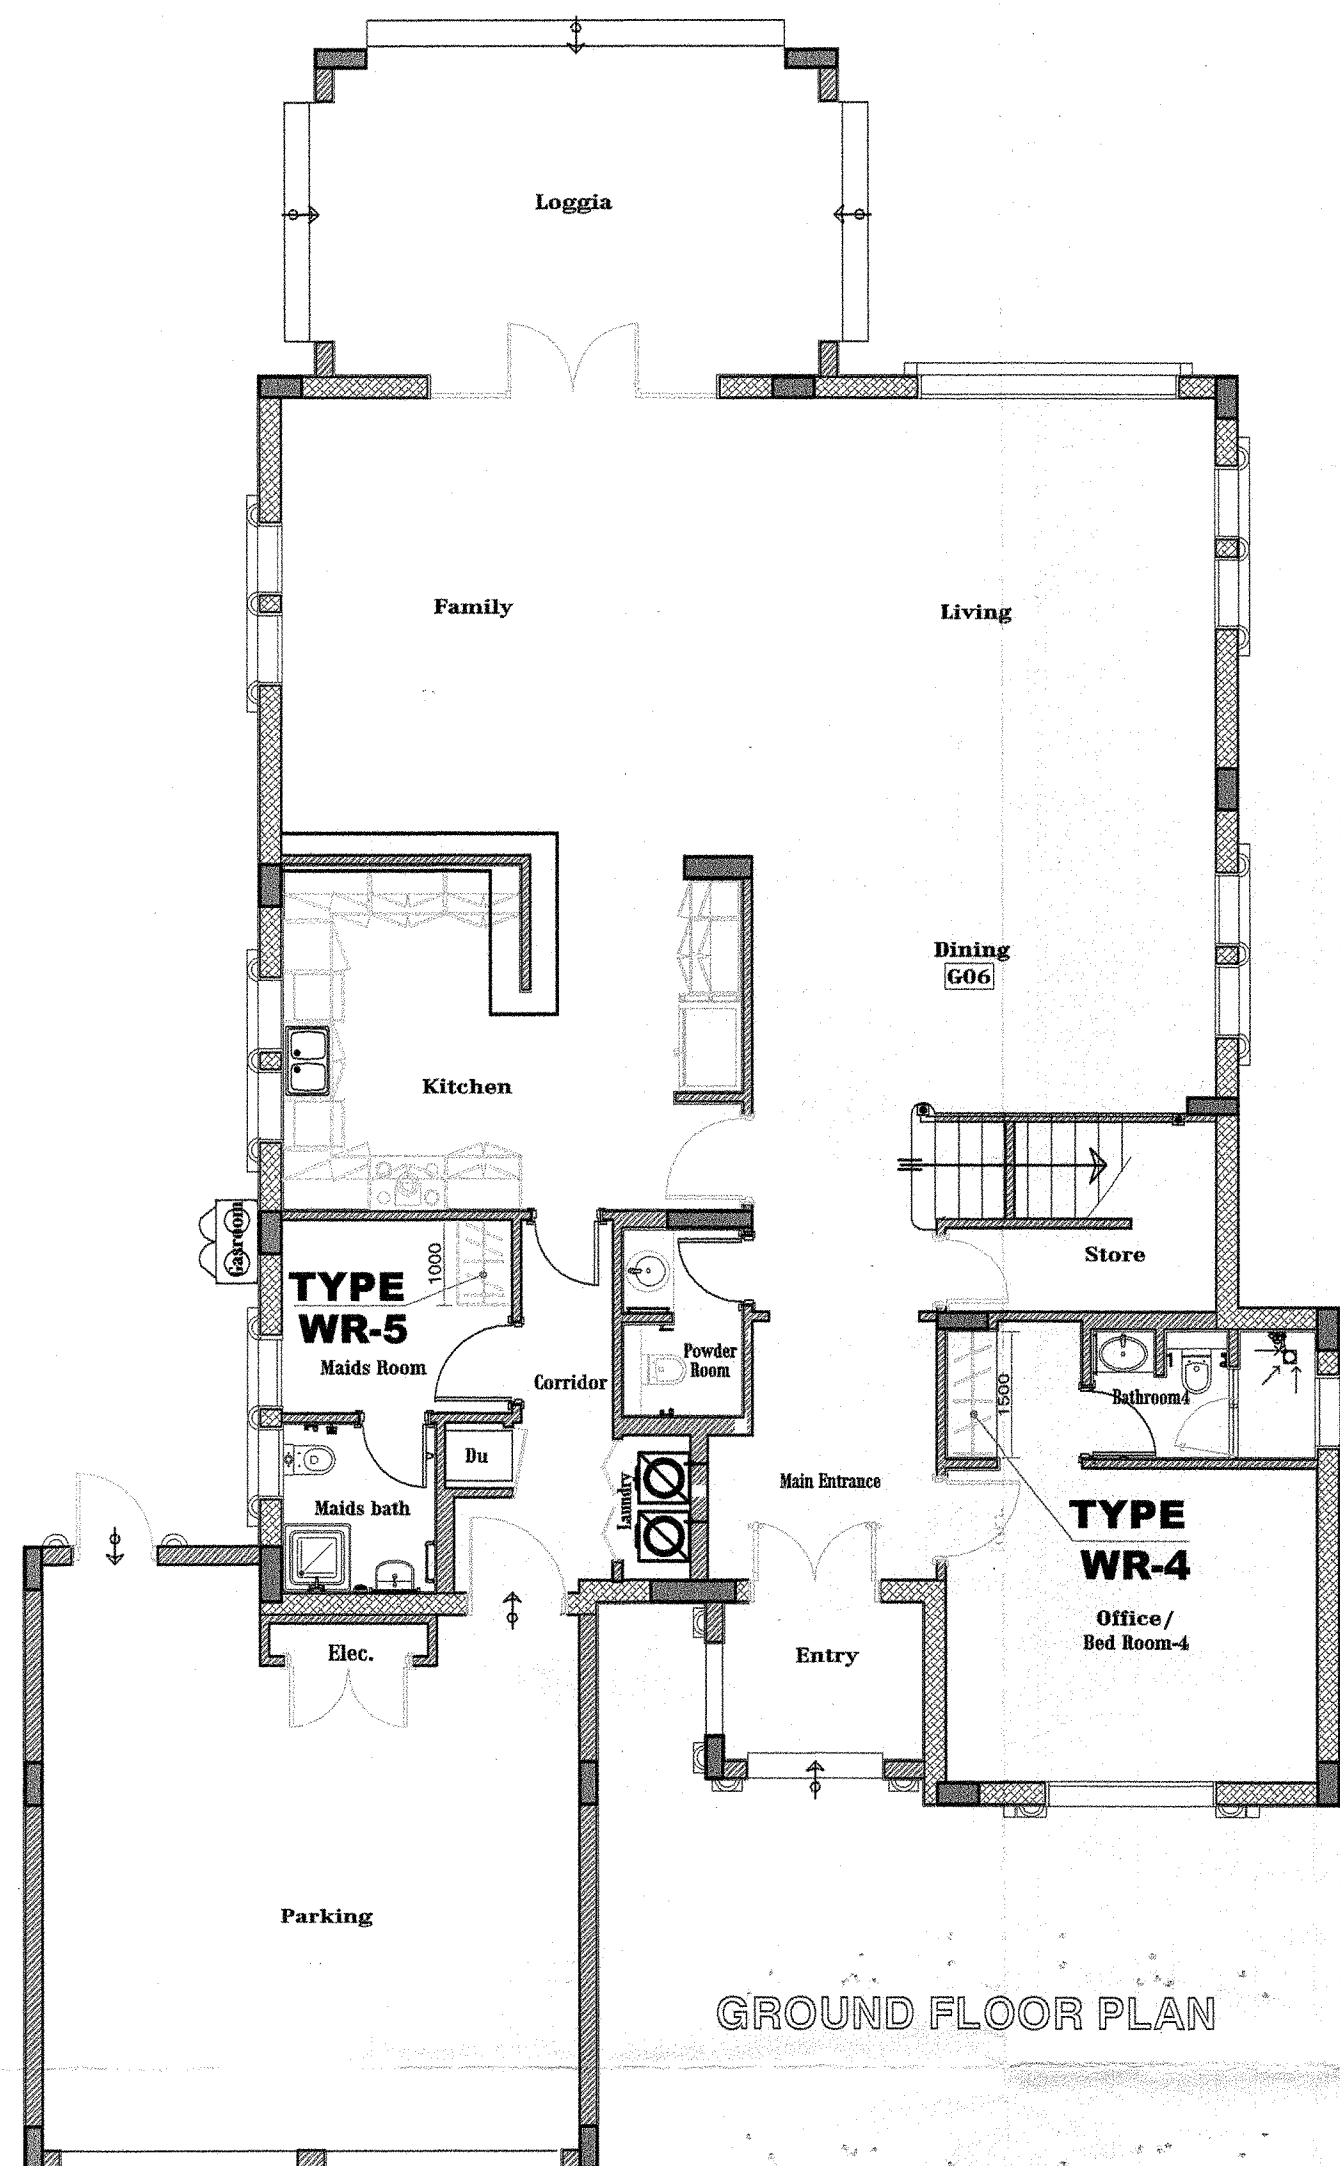



Key plan

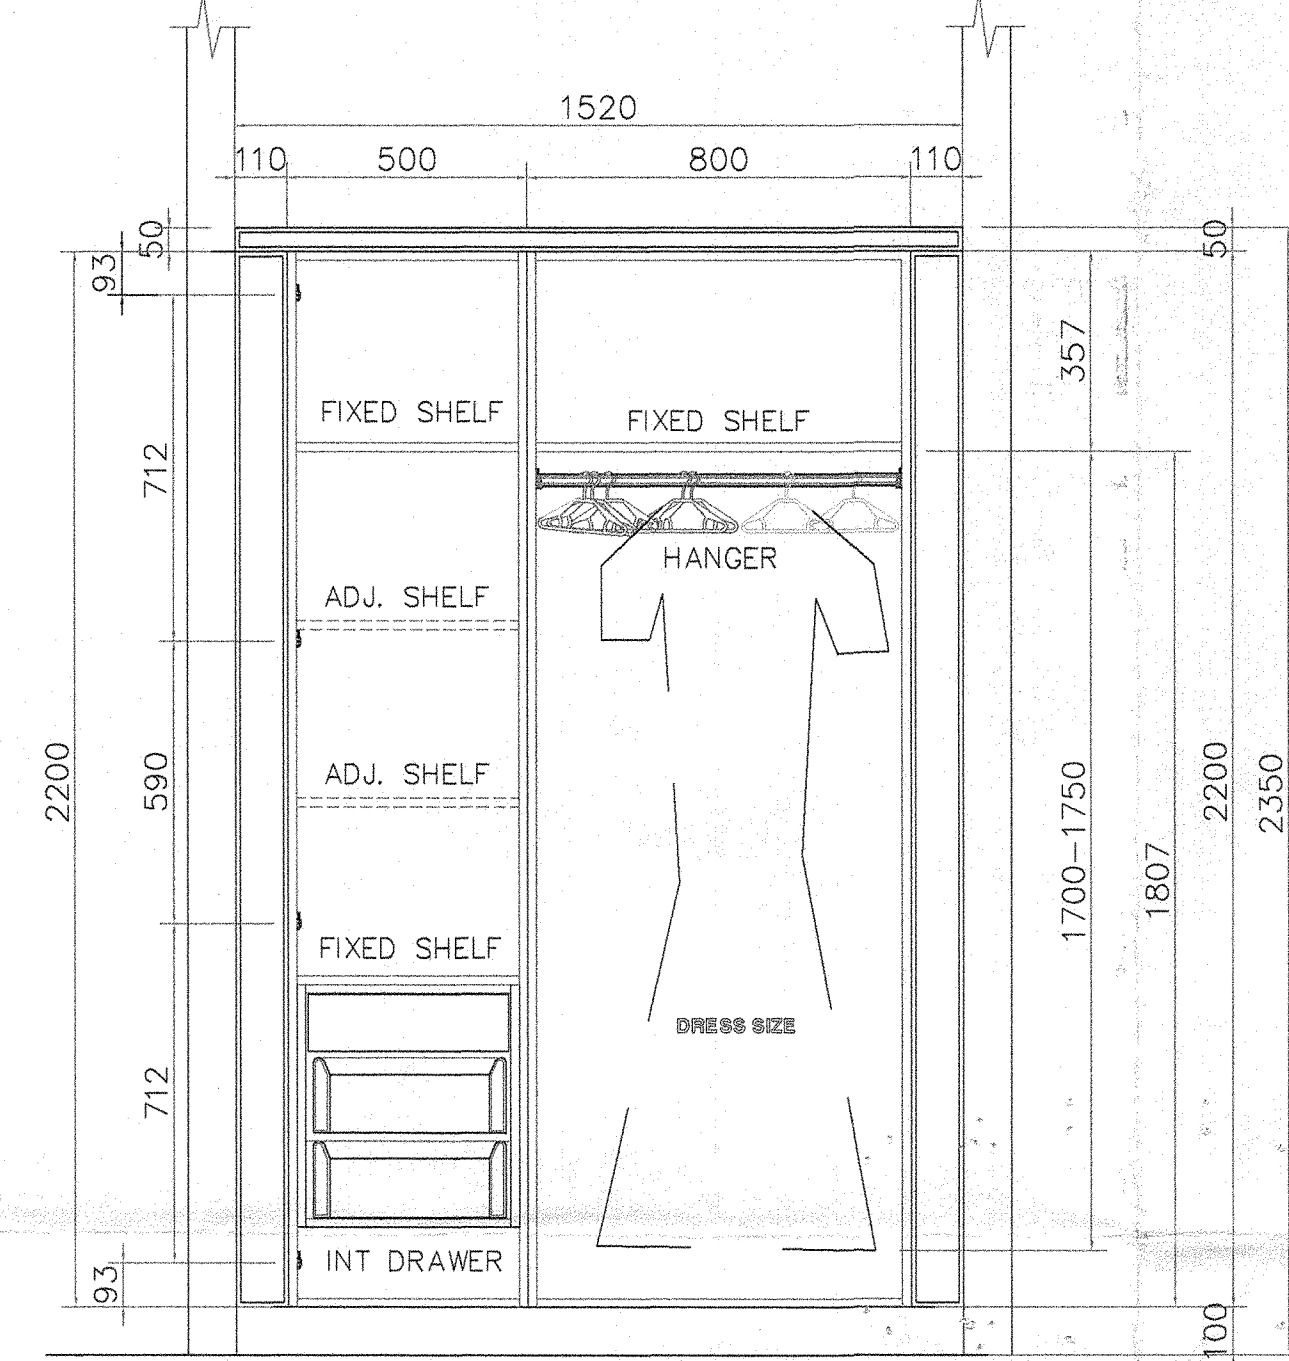


INTERNAL ELEVATION

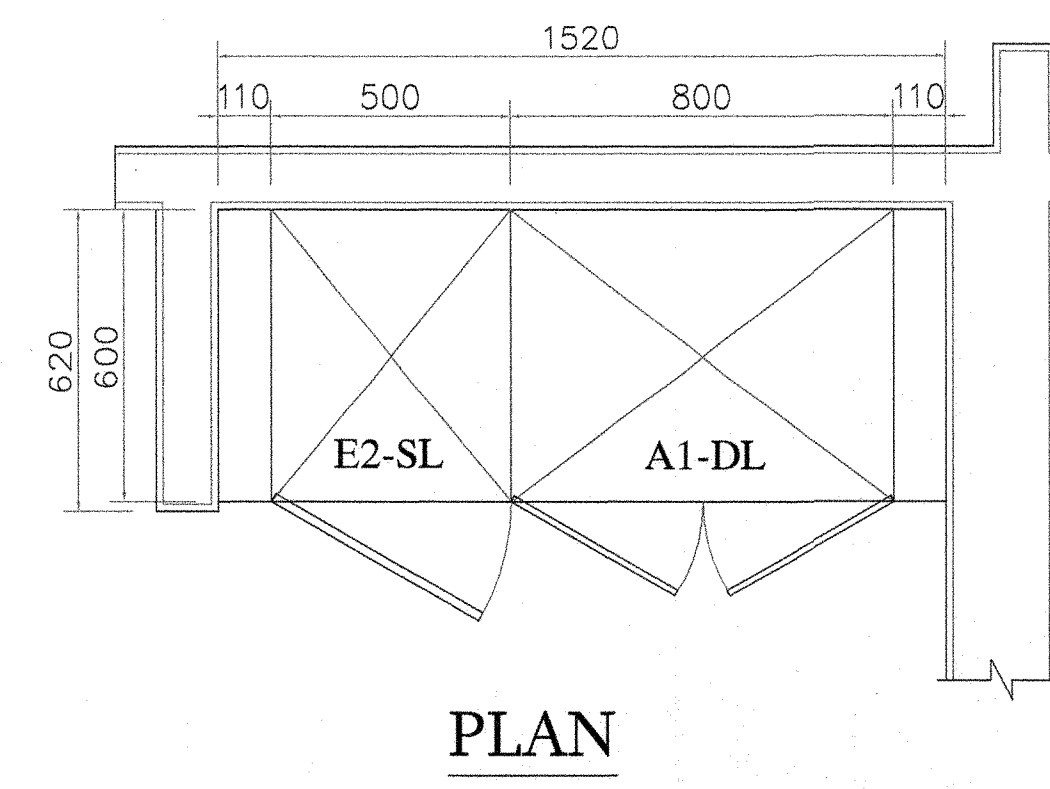


INTERNAL ELEVATION

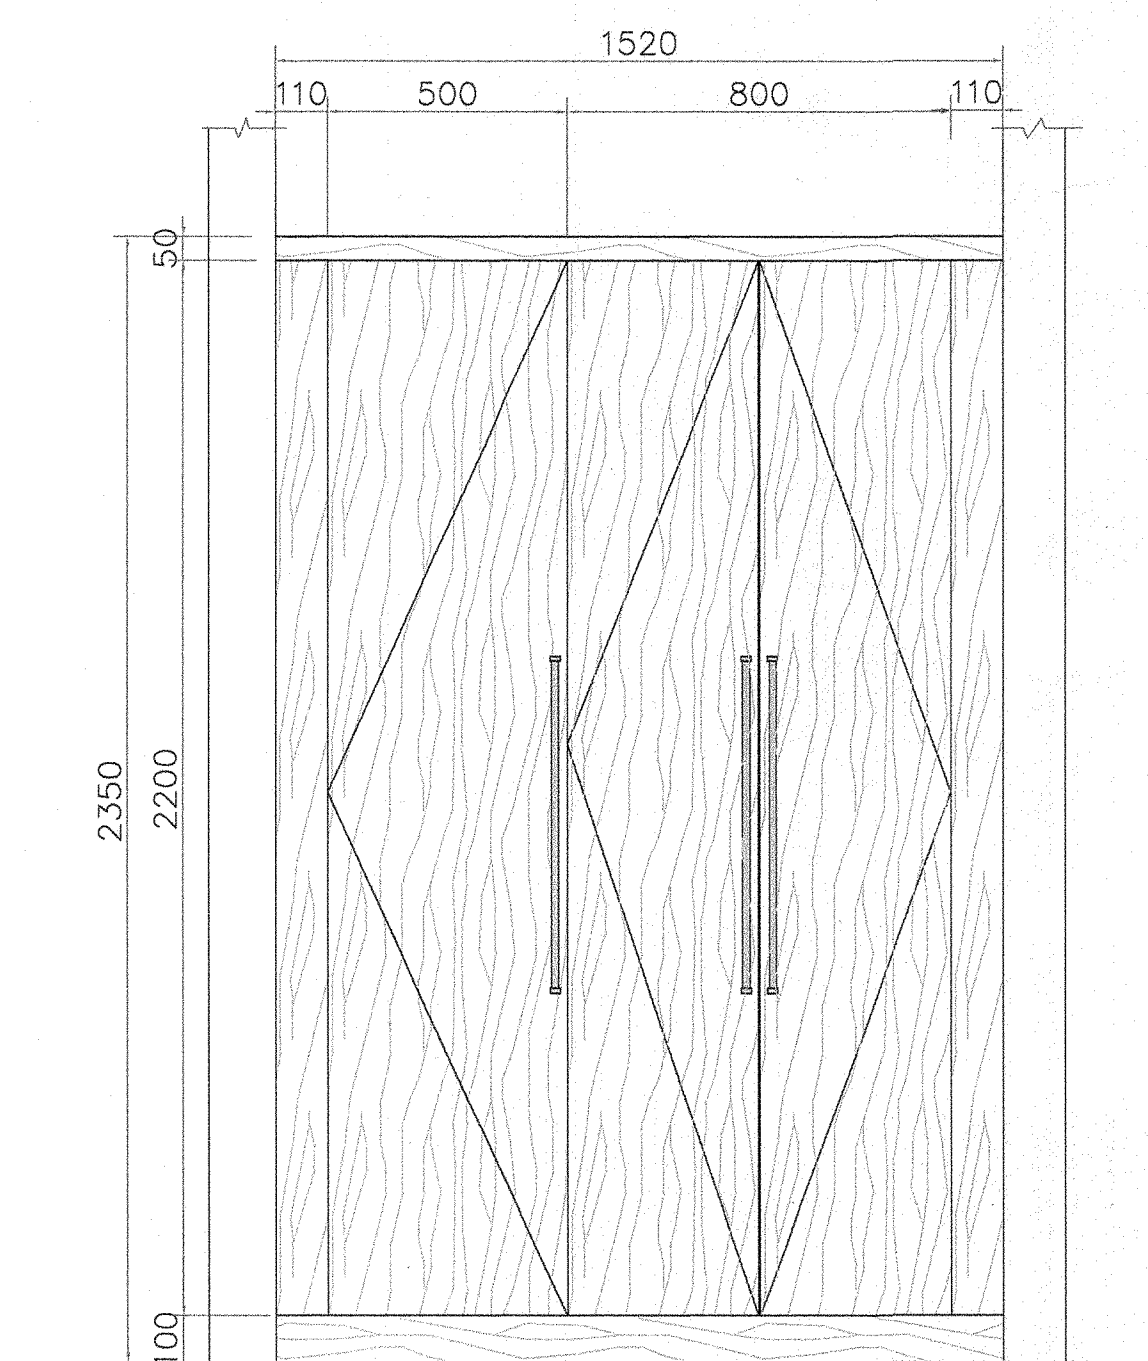

ELEVATION
Type-WR4
BEDROOM-4
No-1

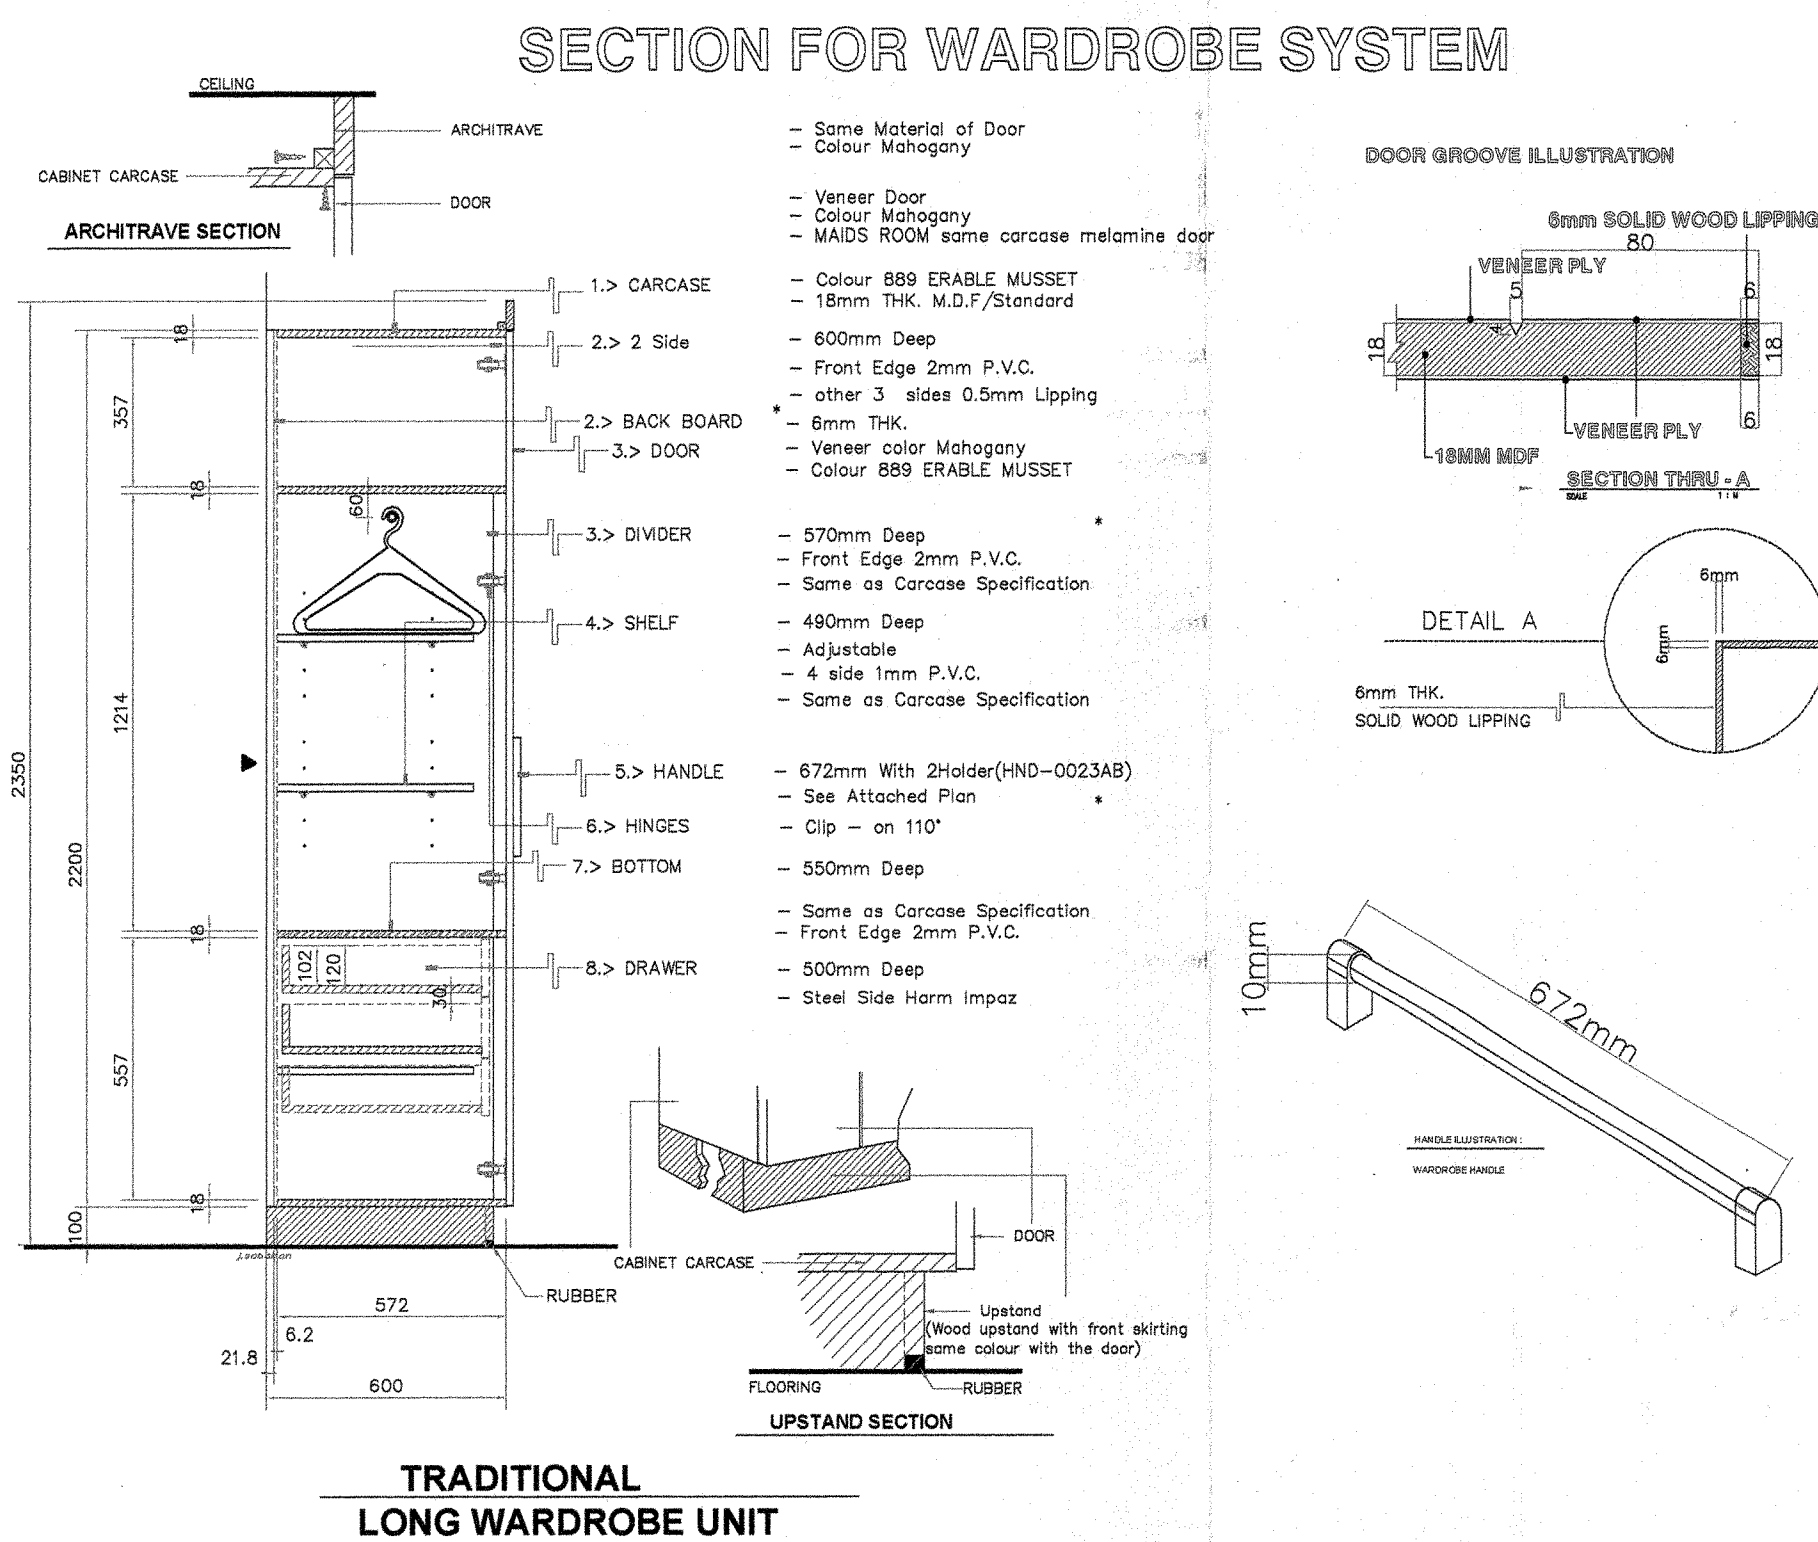

ELEVATION
Type-WR5
MAIDS ROOM
Melamine door
No-1

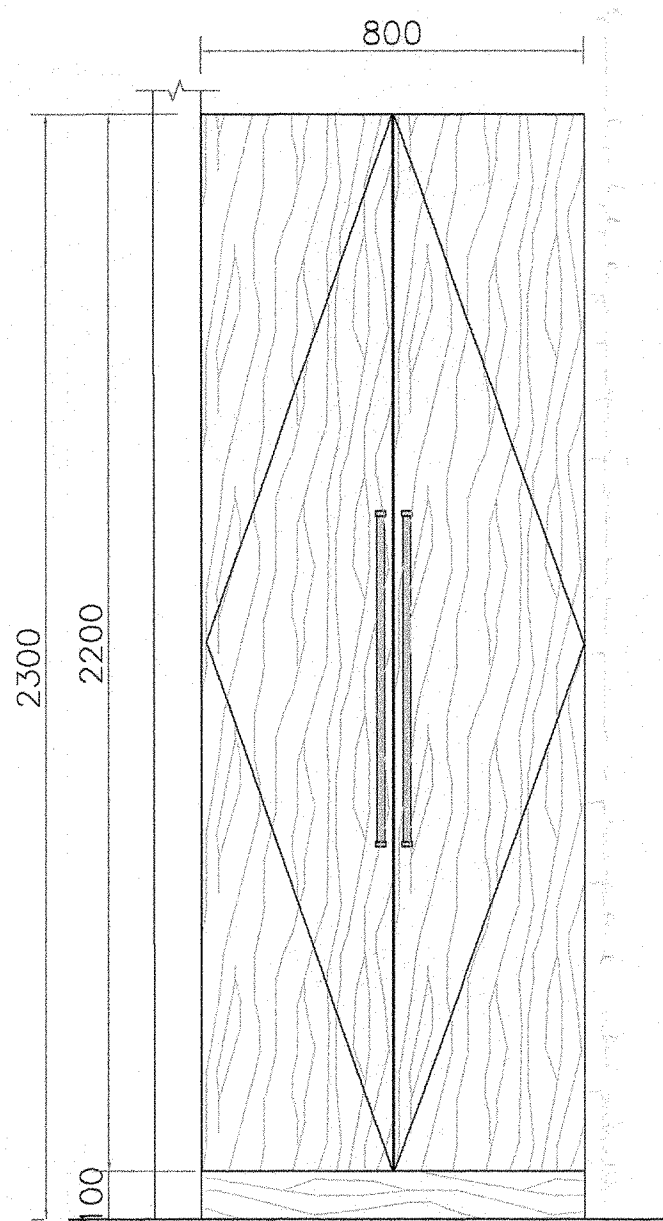

ELEVATION
Type-WR5
MAIDS ROOM
Melamine door
No-1

 dar al-handasah Shafr and Partners	
☒	CODE 1 APPROVED
☐	CODE 2 APPROVED AS NOTED WORK MAY PROCEED SUBJECT TO INCORPORATION OF ENDORSED COMMENTS
☐	CODE 3 RESUBMIT FOR APPROVAL WORK MAY NOT PROCEED
☐	CODE 4 REJECTED
BY: _____ DATE: _____	
Approval shall not relieve the contractor of any of his obligations under the Contract or constitute authorization of any change to Contract Documents or variation to the works. Contractor is responsible for dimensions, quantities and coordination with other trades.	

AS BUILT DRAWING


PROJECT

JUMEIRAH PARK

EMPLOYER



NAKHEEL
EMIRATES TOWERS
19th LEVEL
P.O.BOX - 17777
DUBAI - UAE
TEL : 04-3903388
FAX : 04-3903335

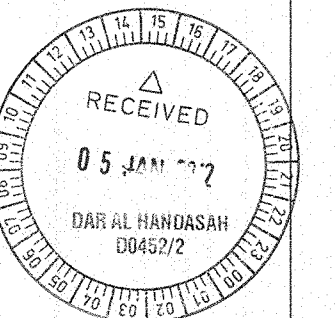

CONSULTANT



dar al-handasah
shair and partners
DUBAI - BEIRUT - CAIRO
دبي - بيروت - القاهرة

MAIN CONTRACTOR



Pauling Middle East Co. L.L.C.

P.O. BOX : 31611, Dubai, U.A.E.
PHONE : + 971 - 4 - 4270360
FAX : + 971 - 4 - 4270361
E-MAIL : paulingl@emirates.net.ae

PACKAGE

PACKAGE - 2 & 2A

CONTRACTOR

AL MEERA




KITCHENS L.L.C
THE REAL KITCHEN
e-mail: almeers@almeers.ae




DRAWING TITLE
WARDROBE DETAILS LEFT HANDED.
TRADITIONAL 1 OF 2

SCALE N.T.S	DATE 02-01-2012	DRAWN BY SIJAN	CHECKED BY AHMED
JOB NO. V81	DRAWING NO PME / JP / AB / WR/ LH- 001		

AR
017
2.1

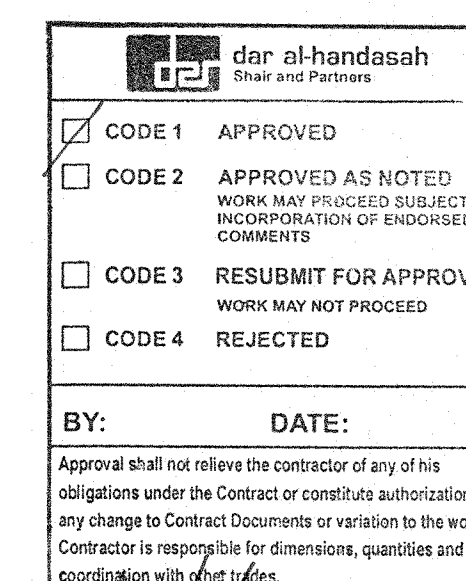

Key plan

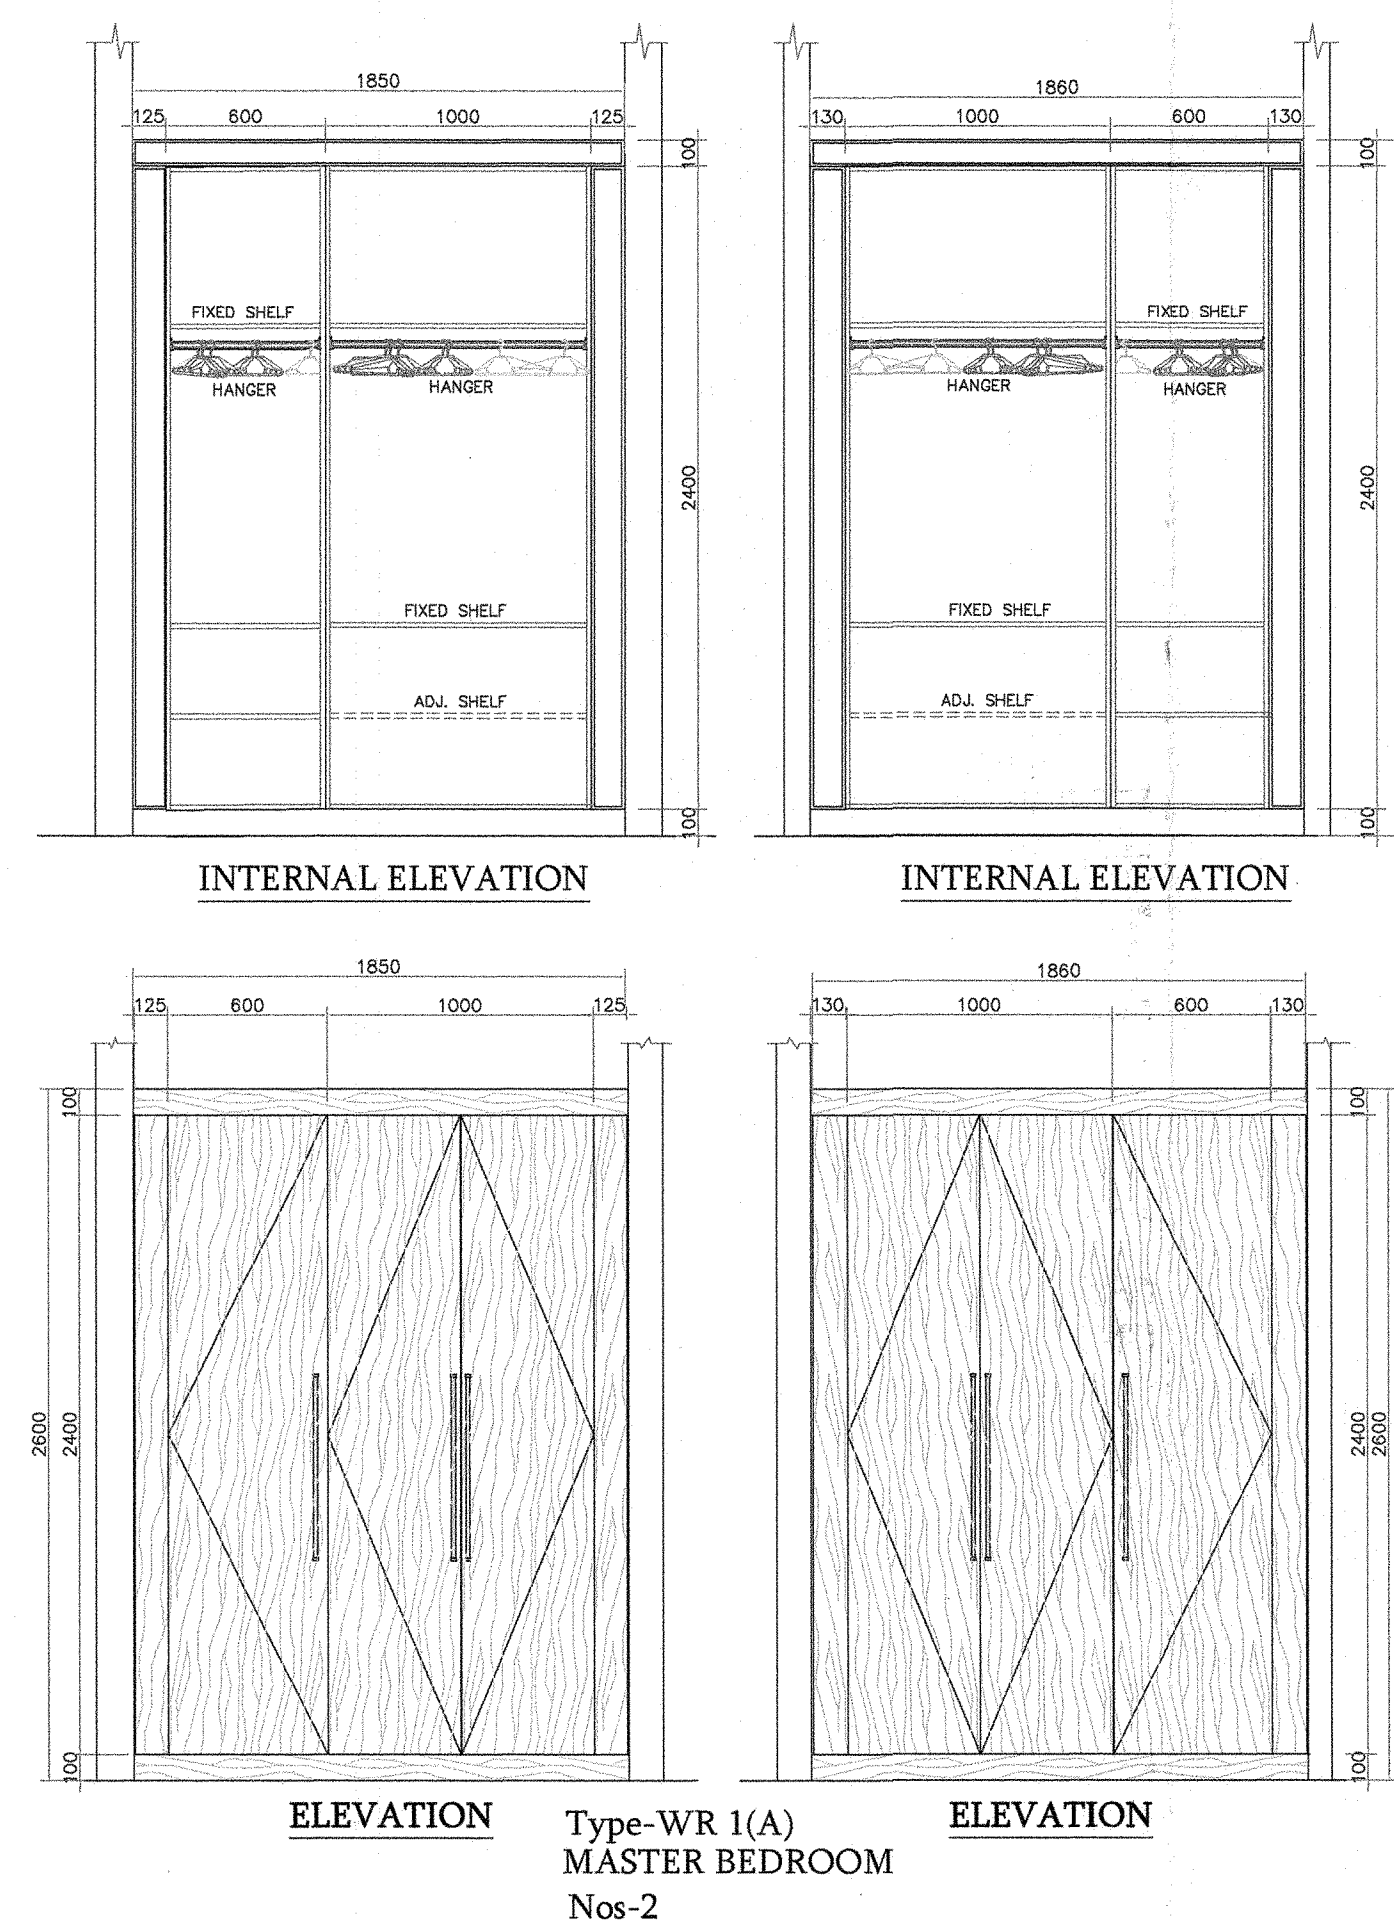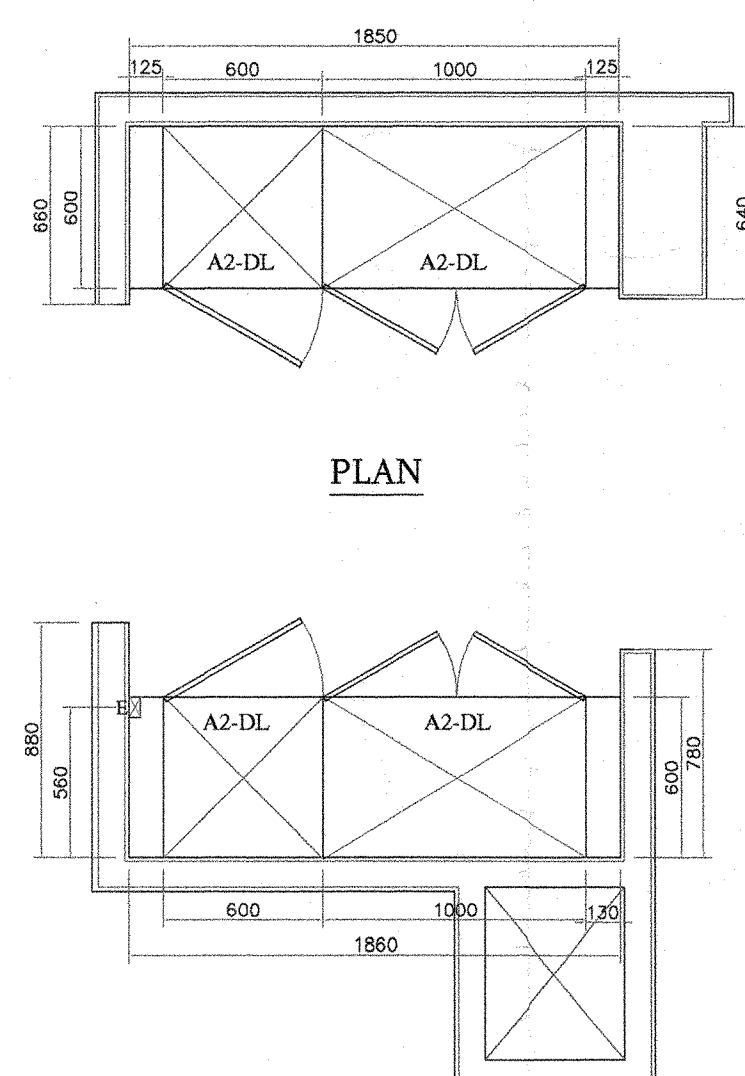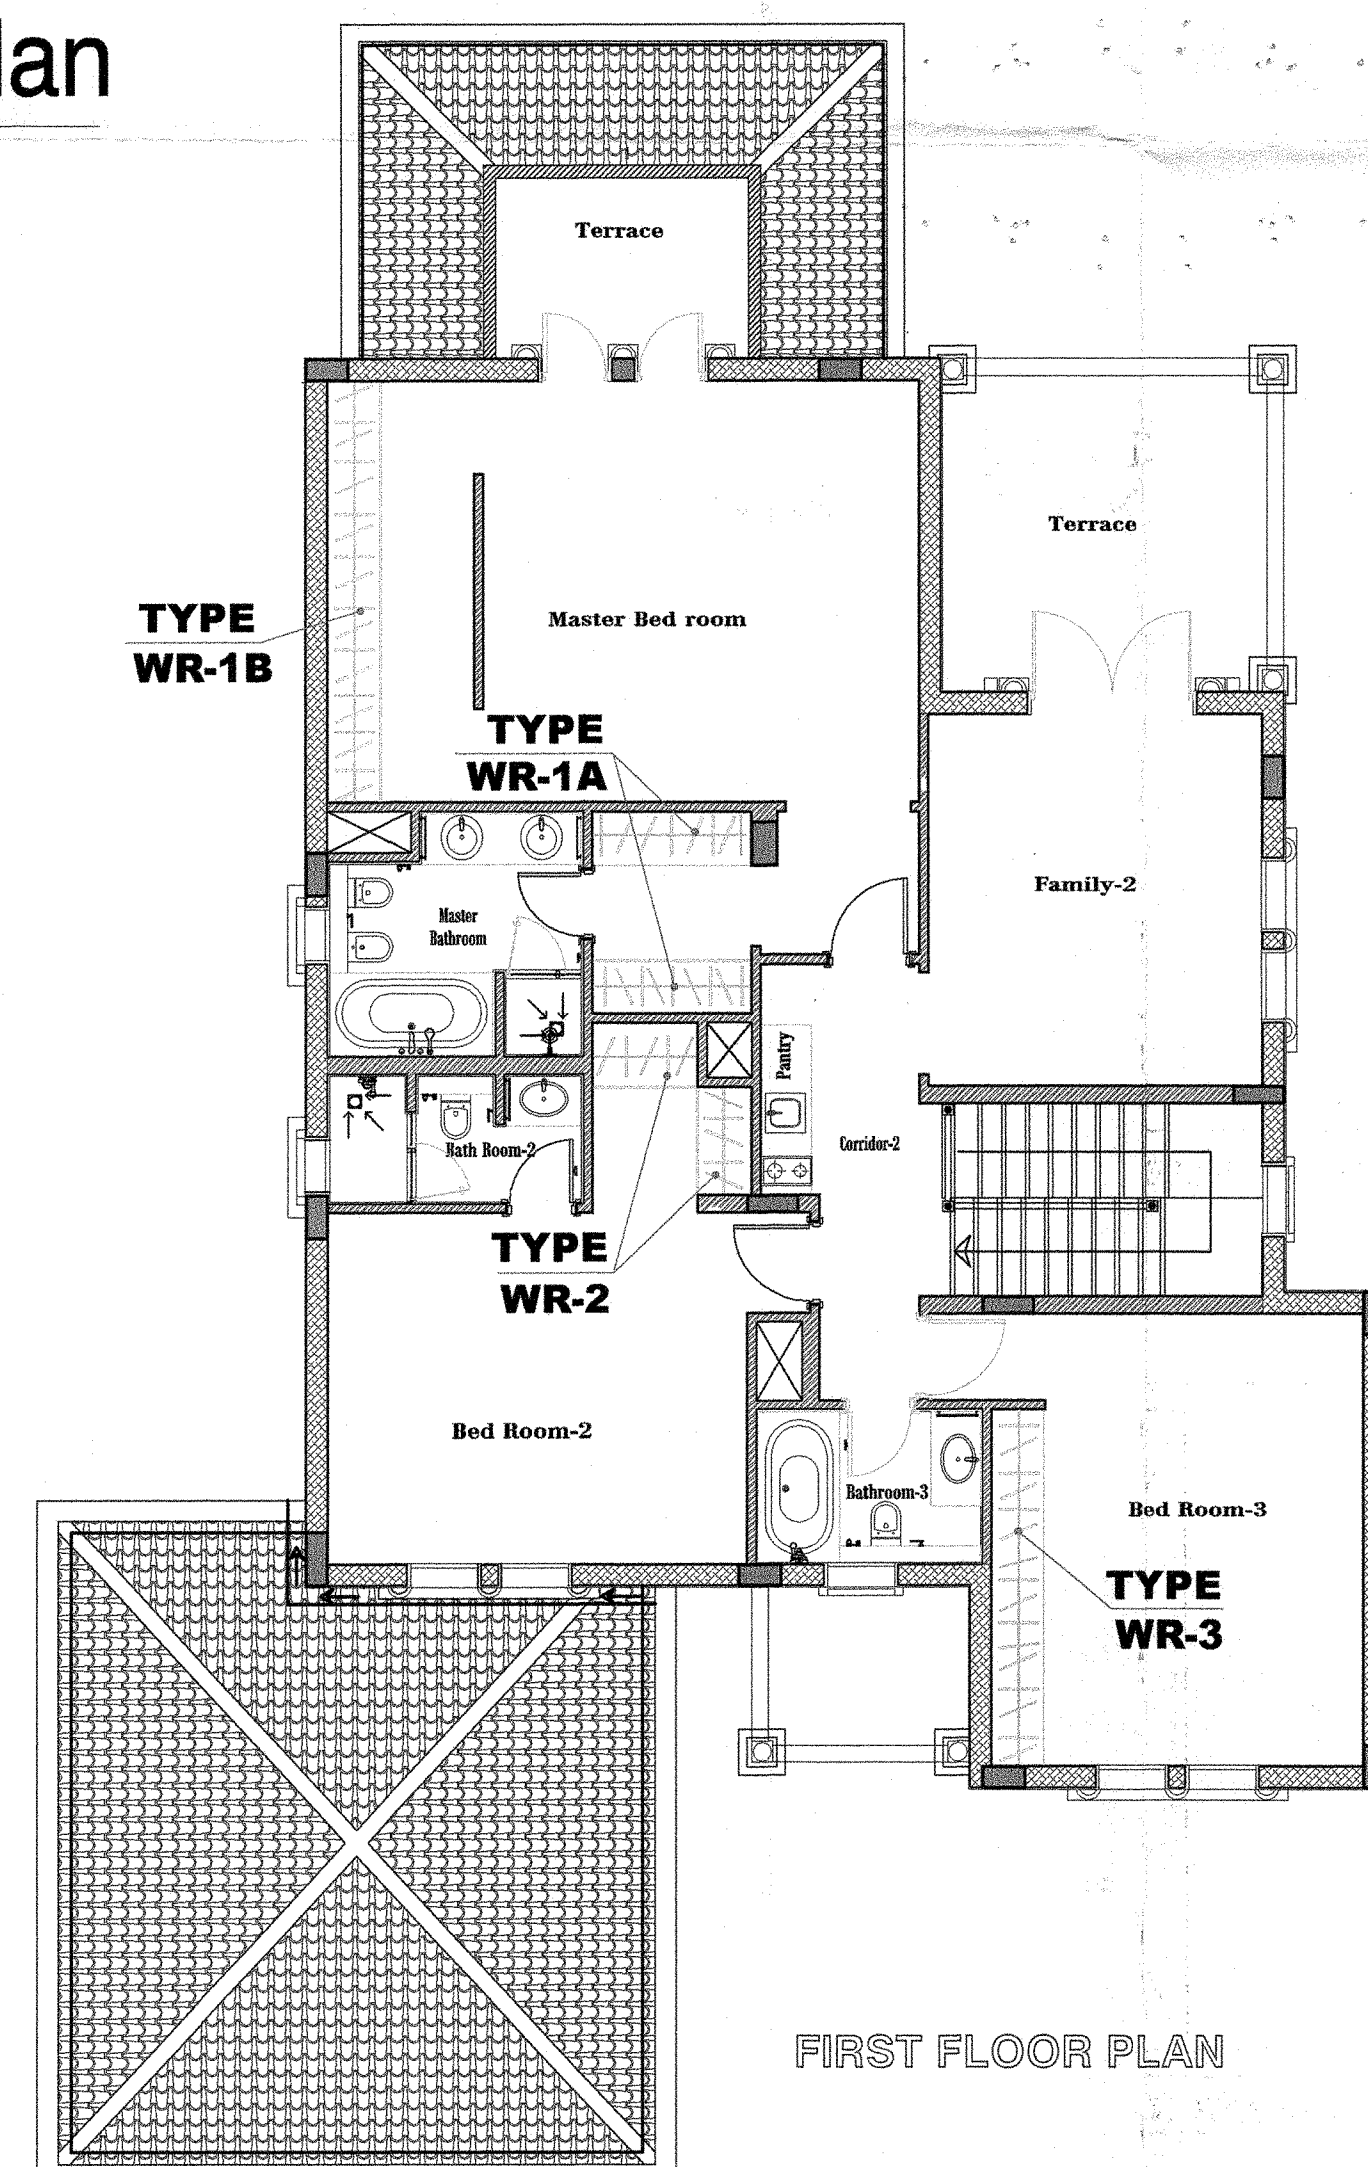


AS BUILT DRAWING

PROJECT **JUMEIRAH PARK**

EMPLOYER



NAKHEEL
EMIRATES TOWERS
19th LEVEL
P.O. BOX - 17777
DUBAI - UAE
TEL : 04-3903388
FAX : 04-3903335

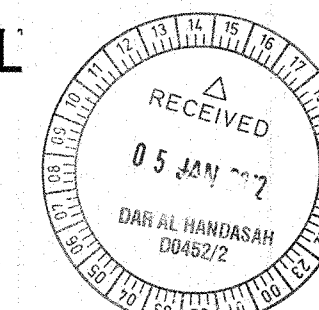

CONSULTANT



dar al-handasah
shair and partners
DUBAI - BEIRUT - CAIRO
البحرين - بيروت - القاهرة

MAIN CONTRACTOR


Pauling Middle East Co. L.L.C.

P.O. BOX : 31631, Dubai, U.A.E.
PHONE : + 971 - 4 - 4270366
FAX : + 971 - 4 - 4270361
E-MAIL : nashid1@emirates.net

PACKAGE

PACKAGE - 2 & 2A

CONTRACTOR

AL MEERA

KITCHENS L.L.C.
THE REAL KITCHEN

DRAWING TITLE
WARDROBE DETAILS LEFT HANDED
TRADITIONAL 2 OF 2

SCALE	DATE	DRAWN BY	CHECKED BY
1:50	02-01-2012	SIJAN	AHMED
JOB NO.	DRAWING NO		
V81	PME / JP / AB / WR/LH - 001		

MOH