



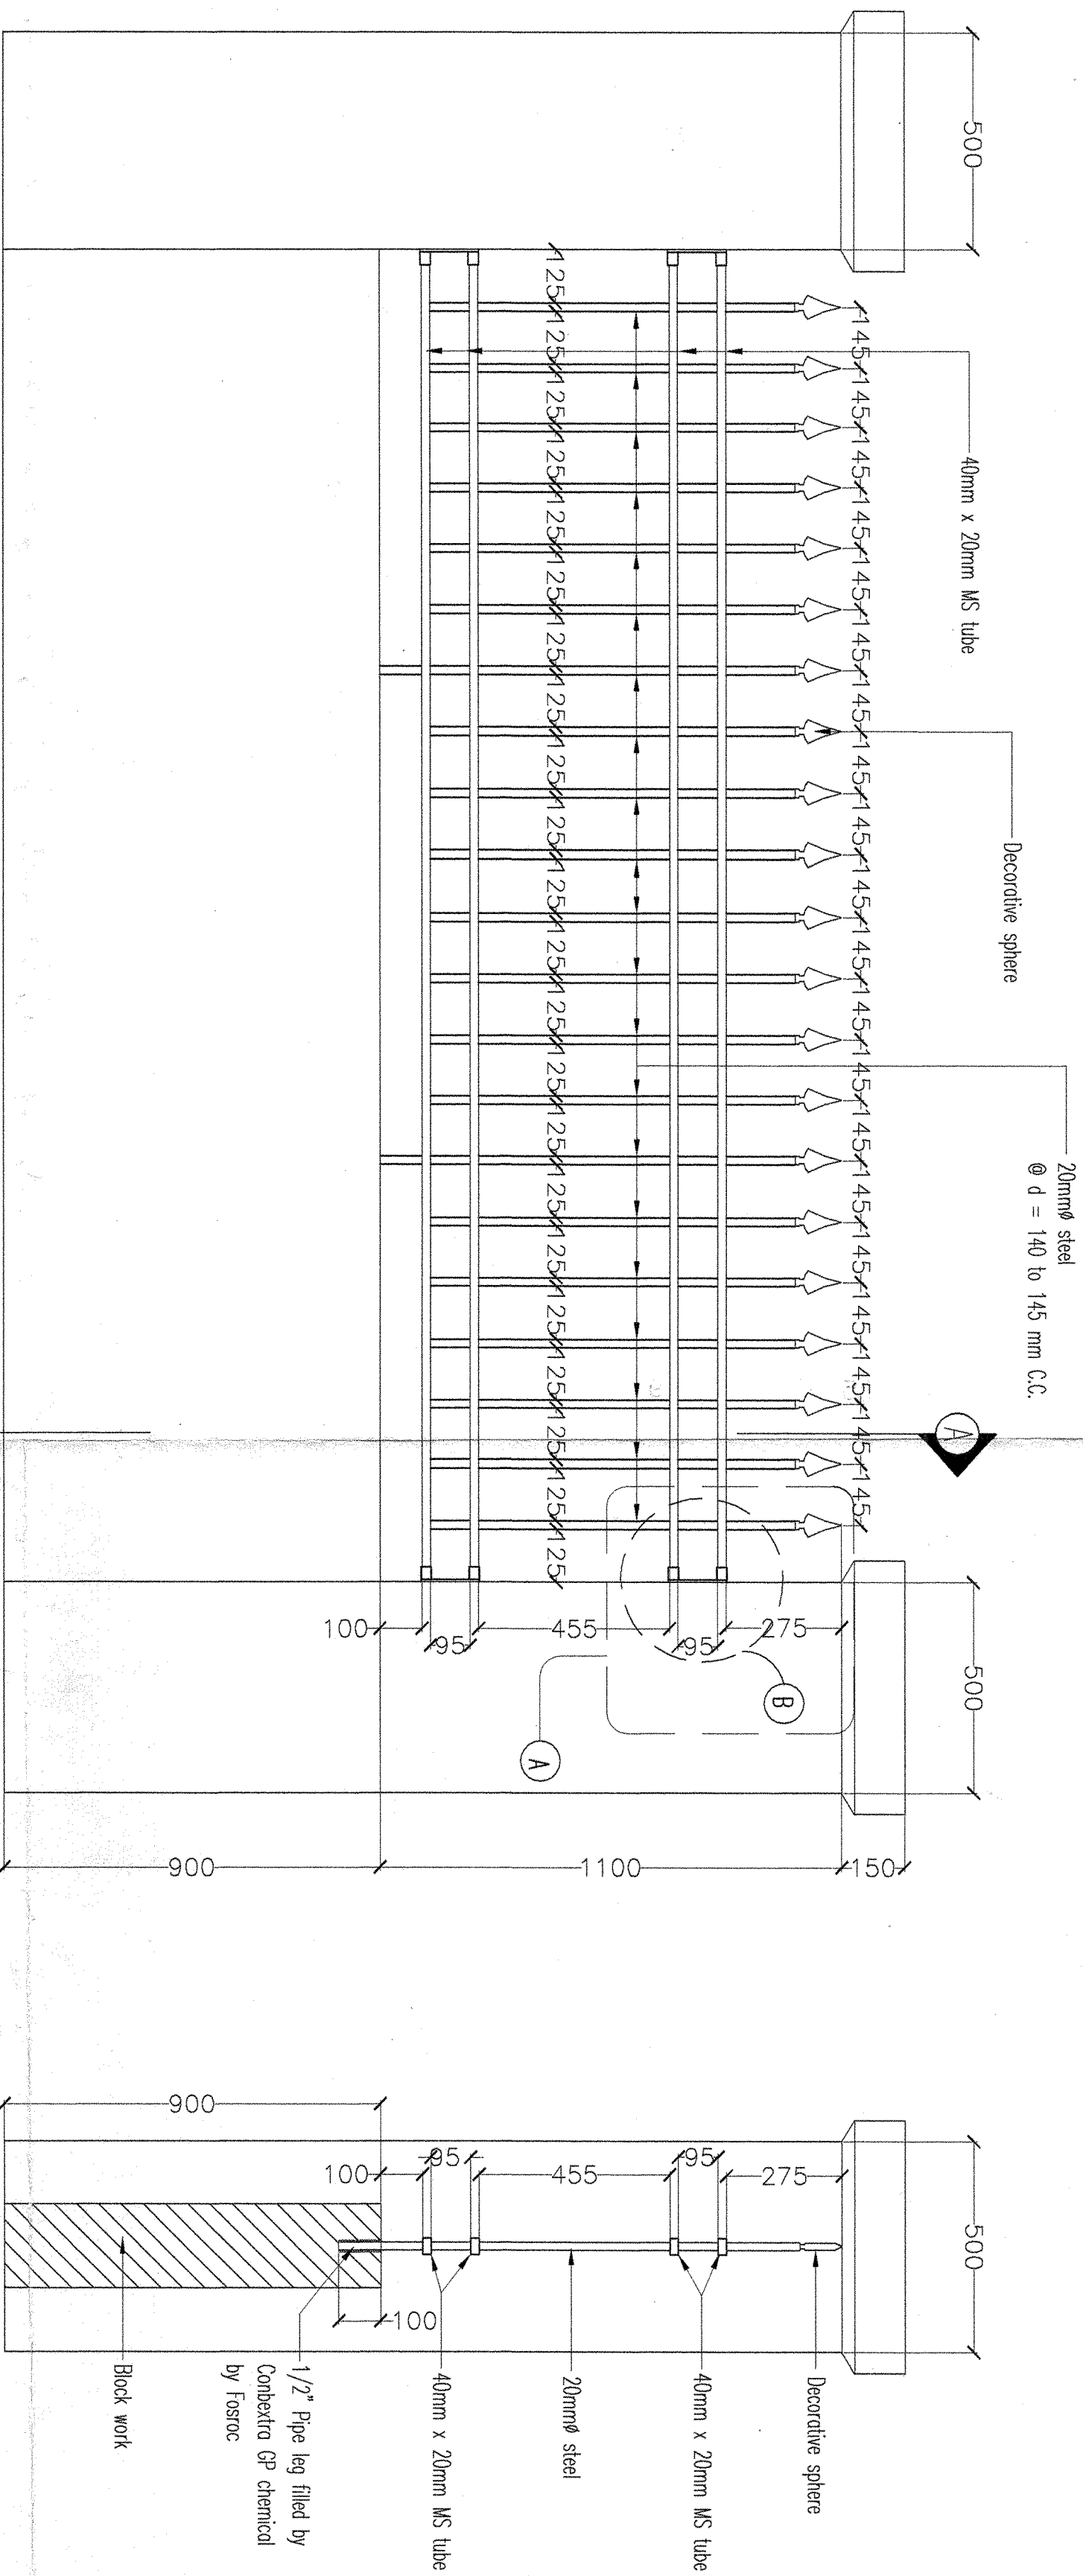


FENCE ELEVATION PLAN


SECTION A-A

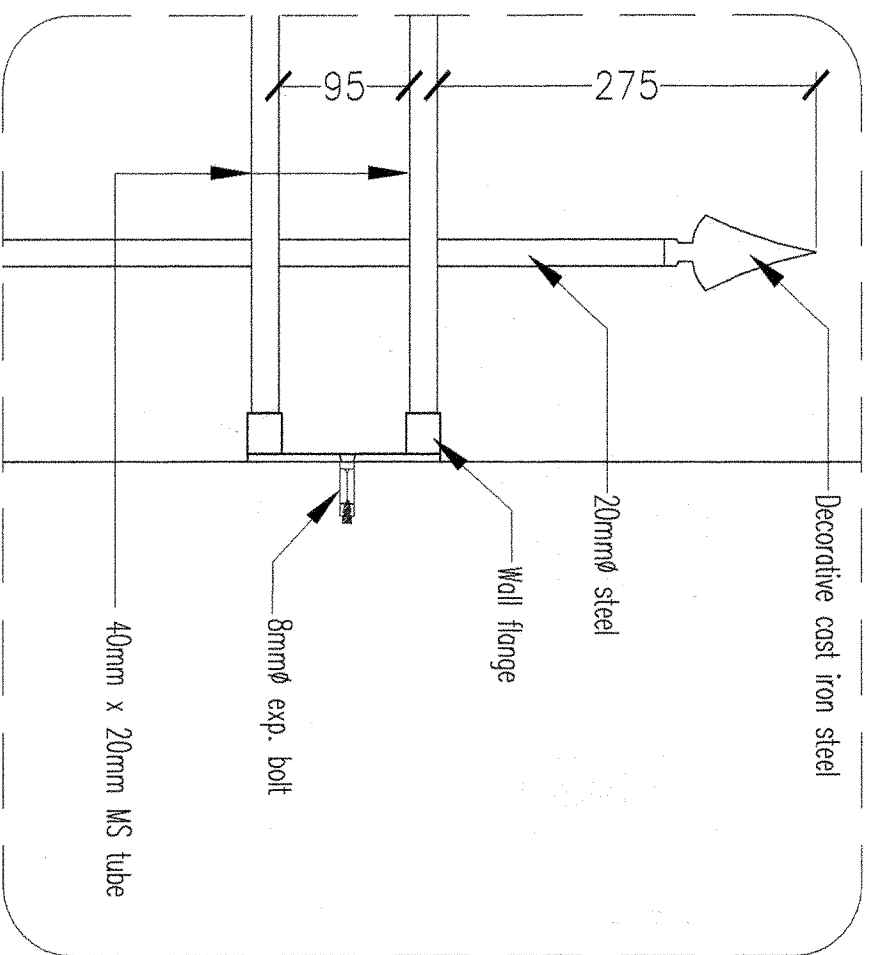

A FIXING DETAIL

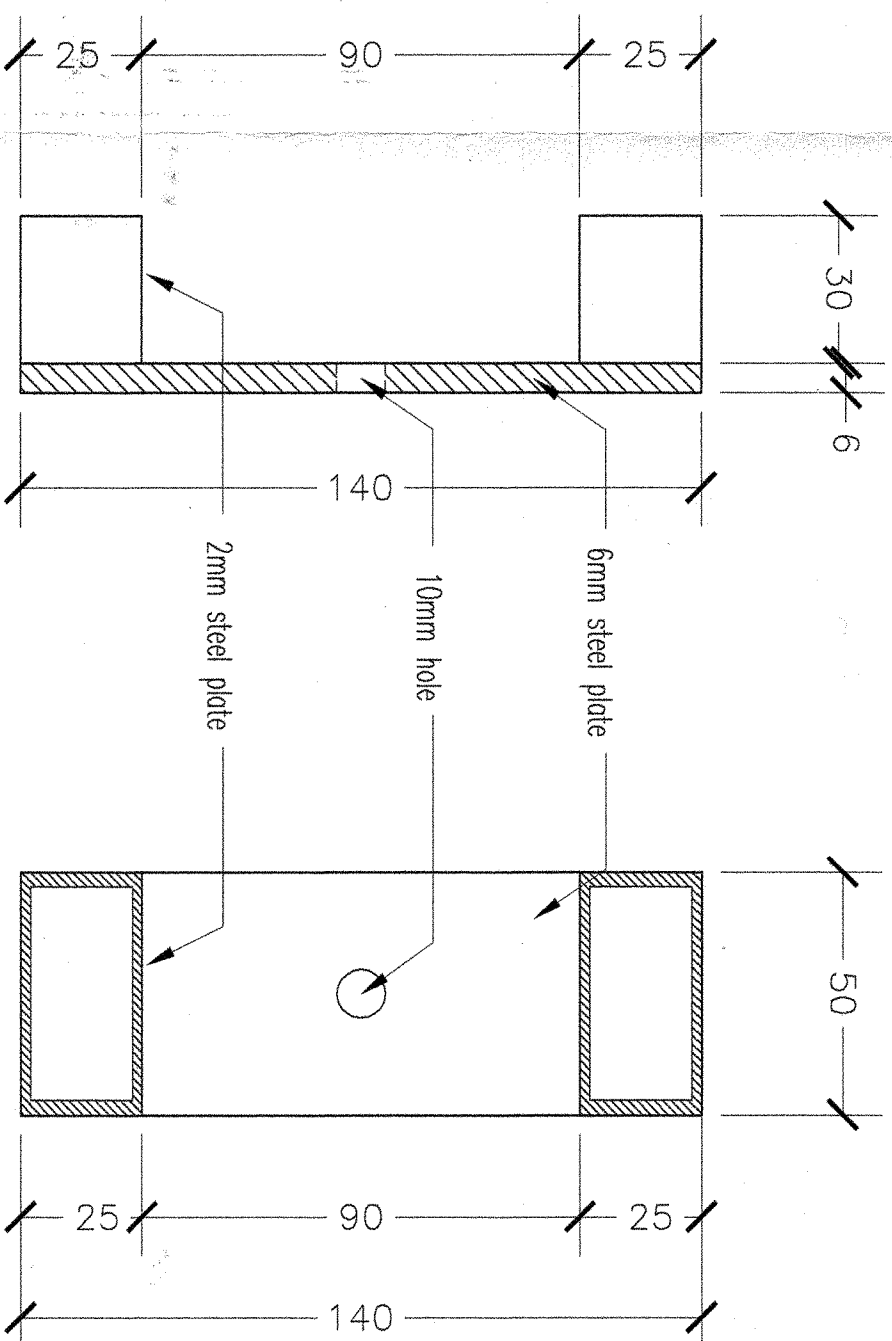

B WALL FLANGE

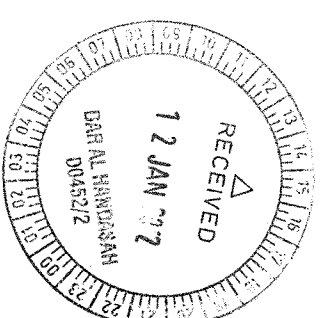

☒ CODE 1 ☐ CODE 2 ☐ CODE 3 ☐ CODE 4	APPROVED APPROVED AS NOTED WORK MAY PROCEED SUBJECT TO COMMENTS RESUBMIT FOR APPROVAL WORK MAY NOT PROCEED REJECTED
BY:	DATE:
Approval shall not relieve the contractor of any of his obligations under the Contract or constitute authorization of any change to Contract Documents or variation to the work. Contractor is responsible for dimensions, quantities and coordination with other trades.	

AS BUILT DRAWING

525 VILLAS @ JUMEIRAH PARK
PACKAGE 2 AND 2A
JUMEIRAH, DUBAI

NAKHEEL
EMIRATES TOWERS
19th LEVEL
P.O. BOX - 17777
DUBAI - UAE
TEL : 04-3903388
FAX : 04-3903335



dar al-handasah
civil and partners
Architects - Engineers - Planners

PAULING MIDDLE EAST
P.O. BOX 55624 ABU DHABI
PHONE : + 971-2-6329022
FAX : + 971-2-6325553

AL JAZEERAH
METALLIC INDUSTRIES
P.O. BOX 554408
TELEPHONE : + 971-2-6329022
FAX NO. 04 5441409

GATE AND FENCE
DETAILS

SCALE	EMIRATE	LOCATION	CHECKED
N.T.S	DUBAI	JUMEIRAH PARK	Eng.Ziyad

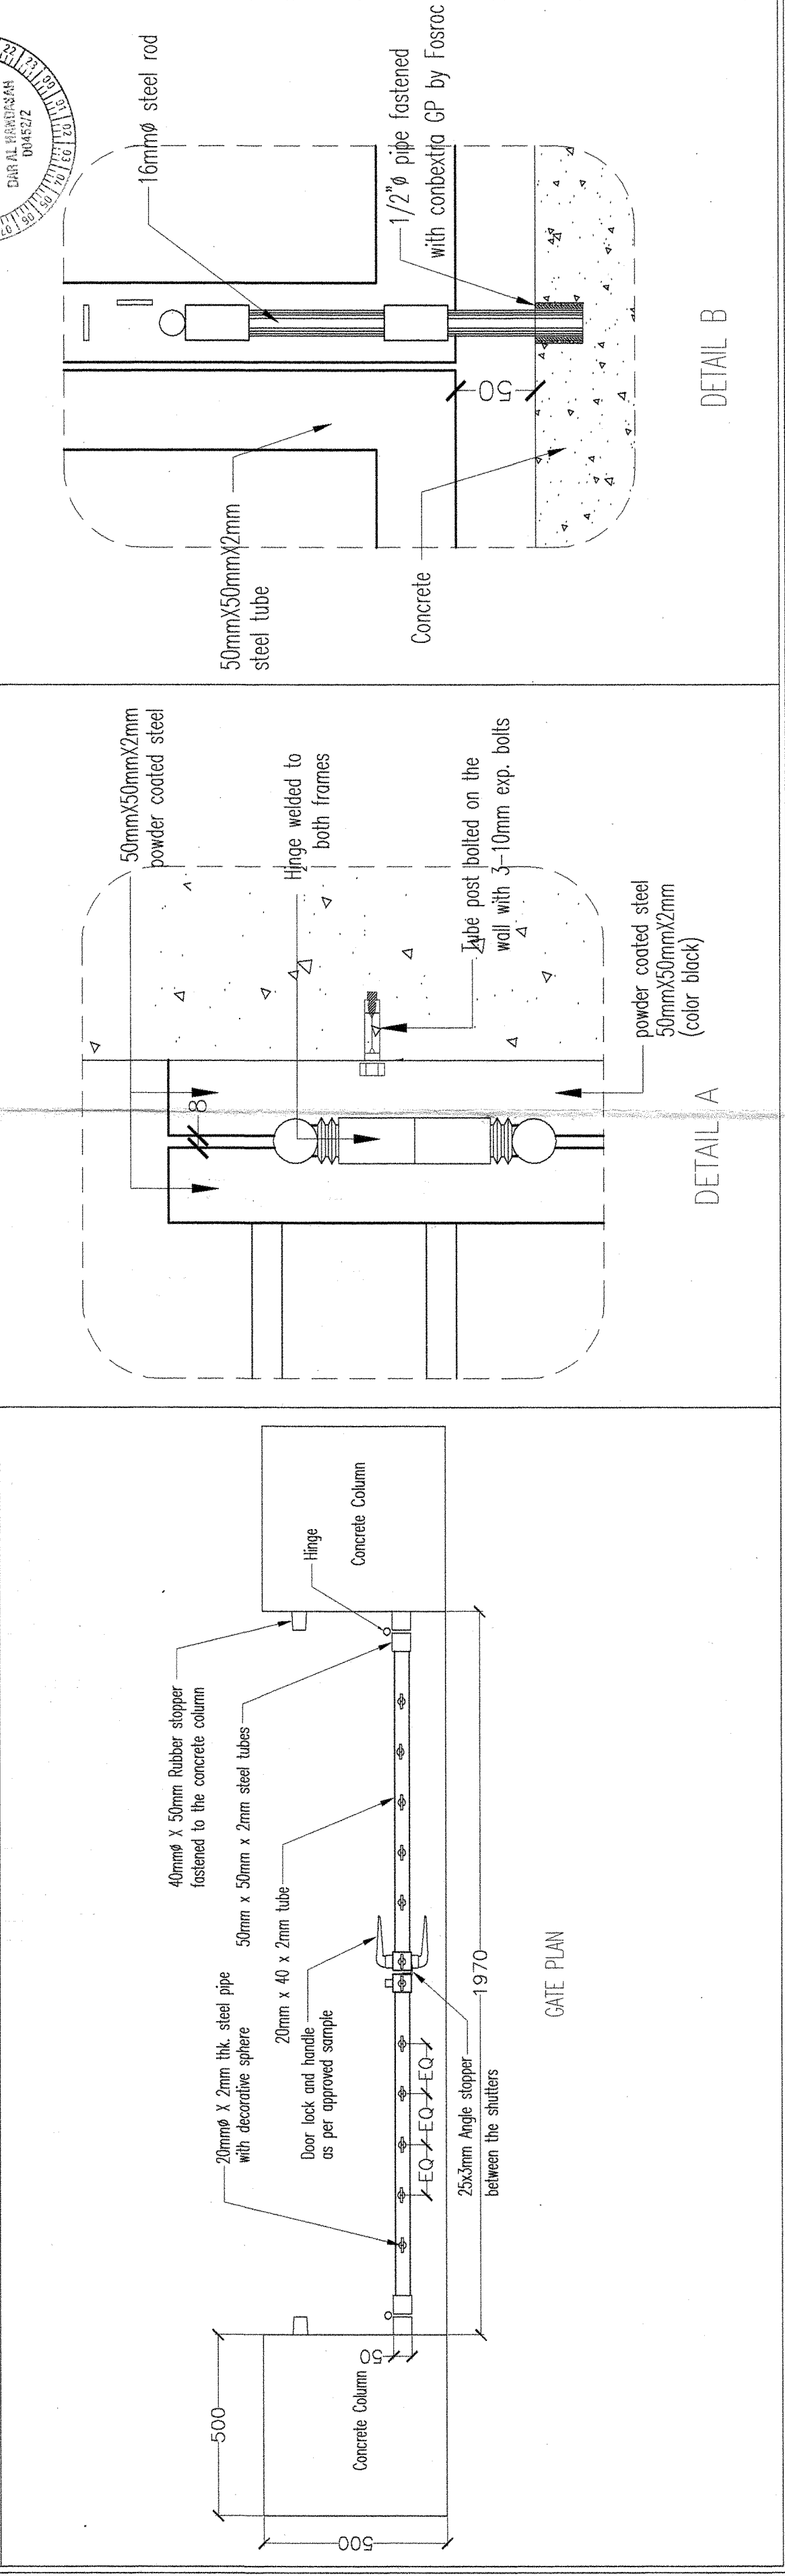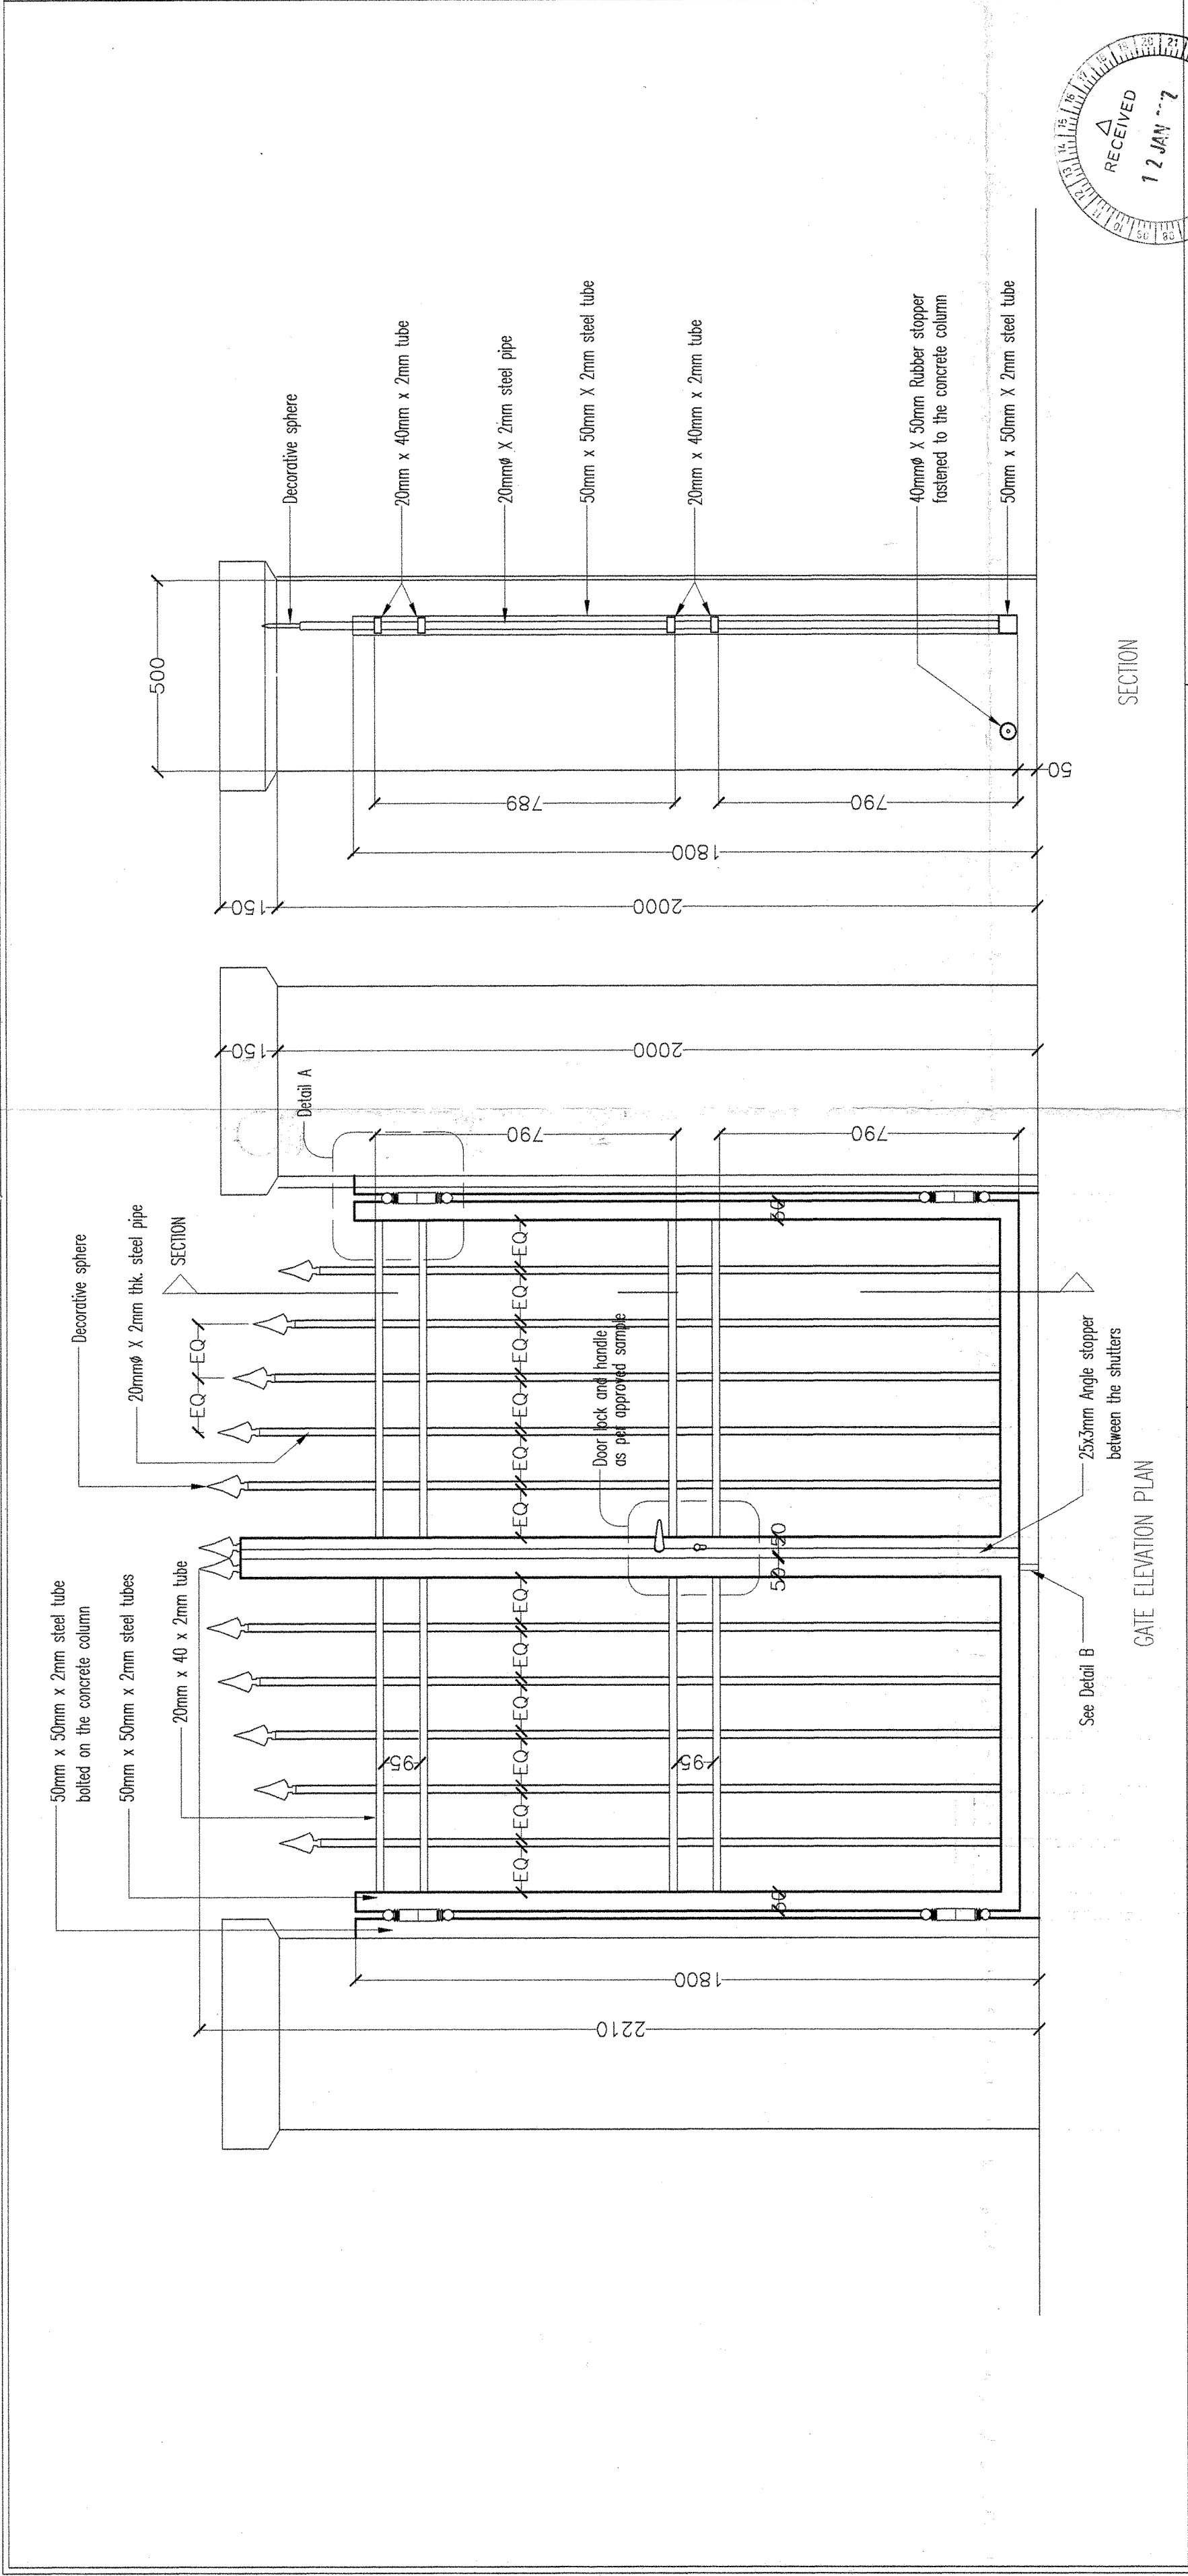

der al-handasah
Shale and Partners

☒ CODE 1 APPROVED

☐ CODE 2 APPROVED AS NOTED
WORK MAY PROCEED SUBJECT TO
INCORPORATION OF ENDORSED
COMMENTS

☐ CODE 3 RESUBMIT FOR APPROVAL
WORK MAY NOT PROCEED

☐ CODE 4 REJECTED

BY: _____ DATE: _____

Approval shall not relieve the contractor of any of his obligations under the Contract or constitute authorization of any change in Contract Documents or variation to the works. Contractor is responsible for dimensions, quantities and coordination with other trades.

AS BUILT DRAWING

525 VILLAS @ JUMEIRAH PARK
PACKAGE 2 AND 2A
JUMEIRAH, DUBAI

NAKHEEL
EMIRATES TOWERS
19th LEVEL
P.O. BOX - 17777
DUBAI - UAE
TEL : 04-3903388
FAX : 04-3903335

der al-handasah
Shale and Partners
DUBAI - UAE
P.O. BOX - 17777
TEL : 04-3903388
FAX : 04-3903335

PAULING MIDDLE EAST
P.O. BOX 55624 ABU DHABI
PHONE : + 971-2-6329922
FAX : + 971-2-6325553

AL JAZERAH
METALLIC INDUSTRIES
P.O. BOX : 95404
TEL. NO. 04 5441408
FAX NO. 04 5441409

GATE AND FENCE
PLAN AND DETAILS

SCALE	EMIRATE	LOCATION	CHECKED
N.T.S	DUBAI	JUMEIRAH PARK	Eng. Zyed
Drawing No. _____			

AB A2
R.2