

|                                     |        |                                                                                              |
|-------------------------------------|--------|----------------------------------------------------------------------------------------------|
| <input checked="" type="checkbox"/> | CODE 1 | APPROVED                                                                                     |
| <input type="checkbox"/>            | CODE 2 | APPROVED, A.S. NOTED<br>WORK MAY PROCEED SUBJECT TO<br>INCORPORATION OF ENDORSED<br>COMMENTS |
| <input type="checkbox"/>            | CODE 3 | RESUBMIT FOR APPROVAL<br>WORK MAY NOT PROCEED                                                |
| <input type="checkbox"/>            | CODE 4 | REJECTED                                                                                     |

BY: \_\_\_\_\_ DATE: \_\_\_\_\_

## AS BUILT DRAWING

**525 VILLAS @ JUMEIRAH PARK**  
PACKAGE 2 AND 2A  
JUMEIRAH, DUBAI



**NAKHEEL**  
EMIRATES TOWERS  
19th LEVEL  
P.O. BOX - 17777  
DUBAI - UAE  
TEL : 04-3903388  
FAX : 04-3903335

**dar al-handasah**  
**shair and partners**  
DUBAI - DERRUT - CAIRO  
مصر - بيروت - دبي

**PAULING MIDDLE EAST**

P.O. BOX 55624 ABU DHABI  
PHONE : + 971-2-6329922  
FAX : + 971-2-6325553


**AL JAZEERAH**  
METALLIC INDUSTRIES  
P.O. BOX : 95404  
TEL. NO. 04 5441408  
FAX NO. 04 5441409

## STAIRCASE HANDRAIL PLAN AND DETAILS


**1 of 2**

|                |         |               |       |
|----------------|---------|---------------|-------|
| SCALE<br>N.T.S | EMIRATE | LOCATION      | CHE   |
|                | DUBAI   | JUMEIRAH PARK | Eng.2 |



Drawing no.   
PME/J/P/AB/STARCASE HANDRAIL-002

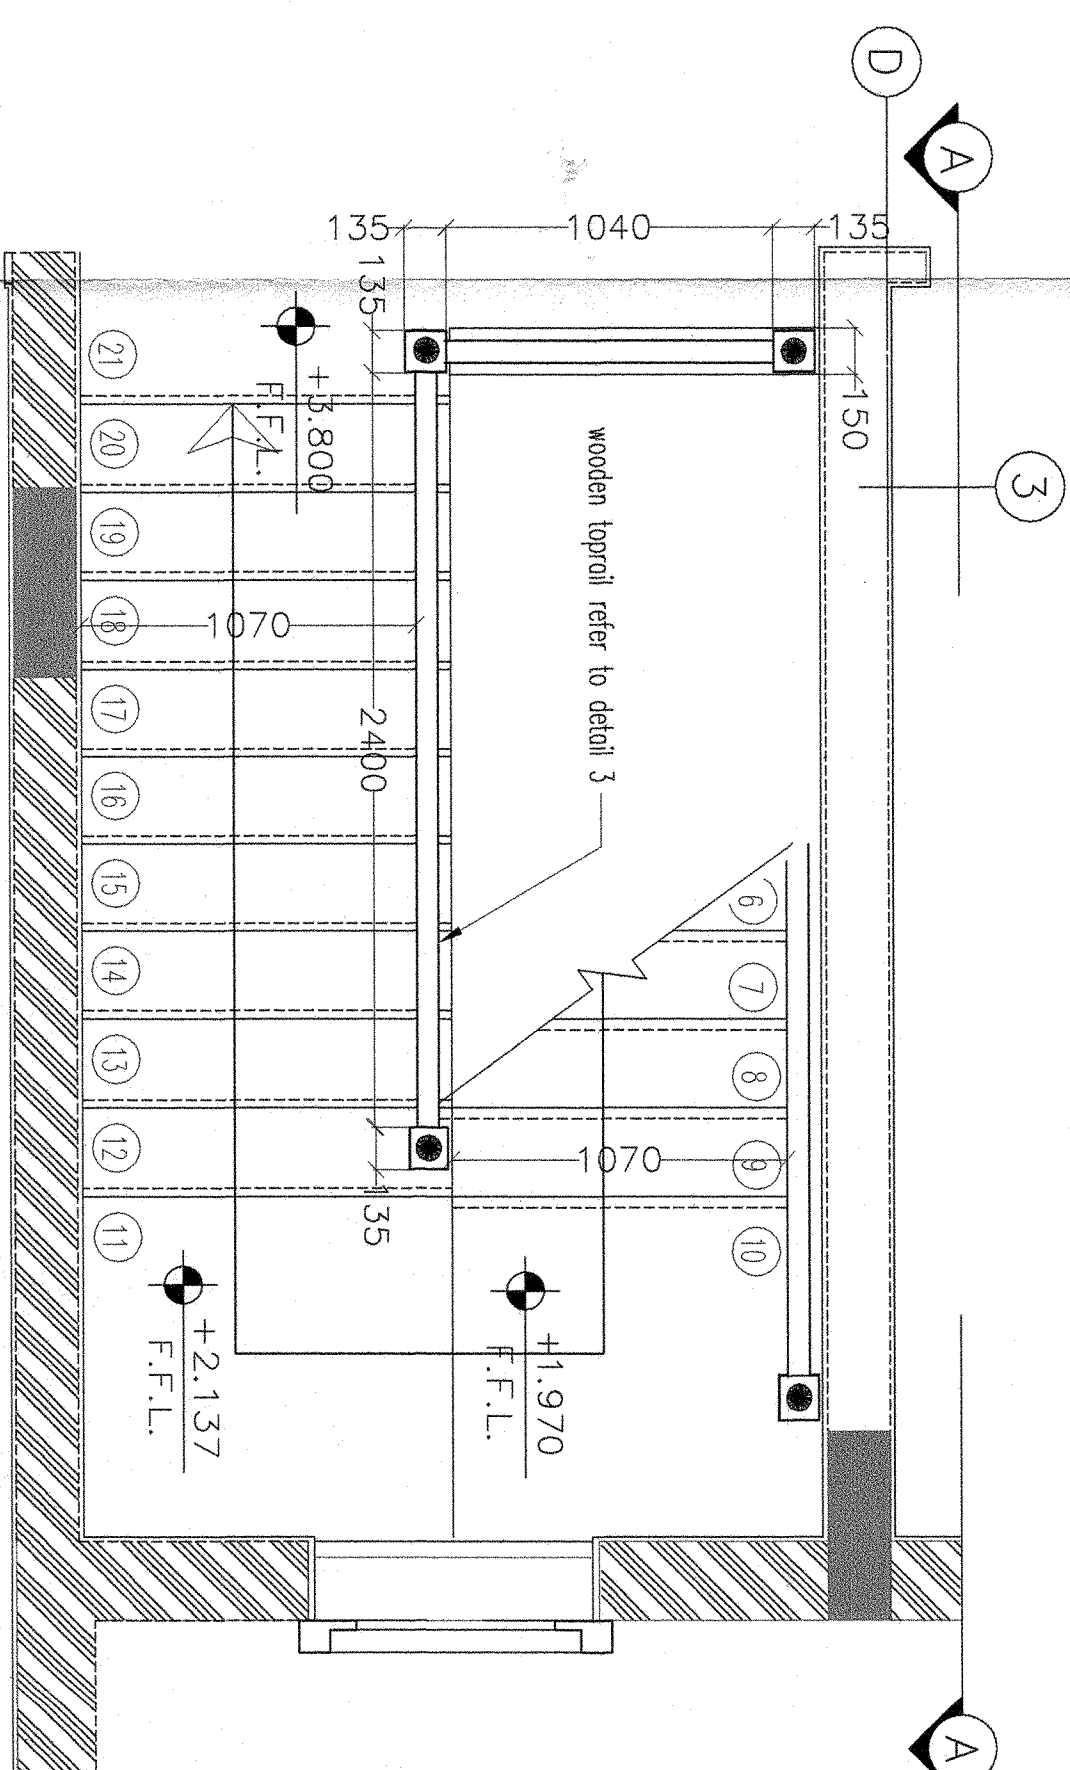


FIRST FLOOR

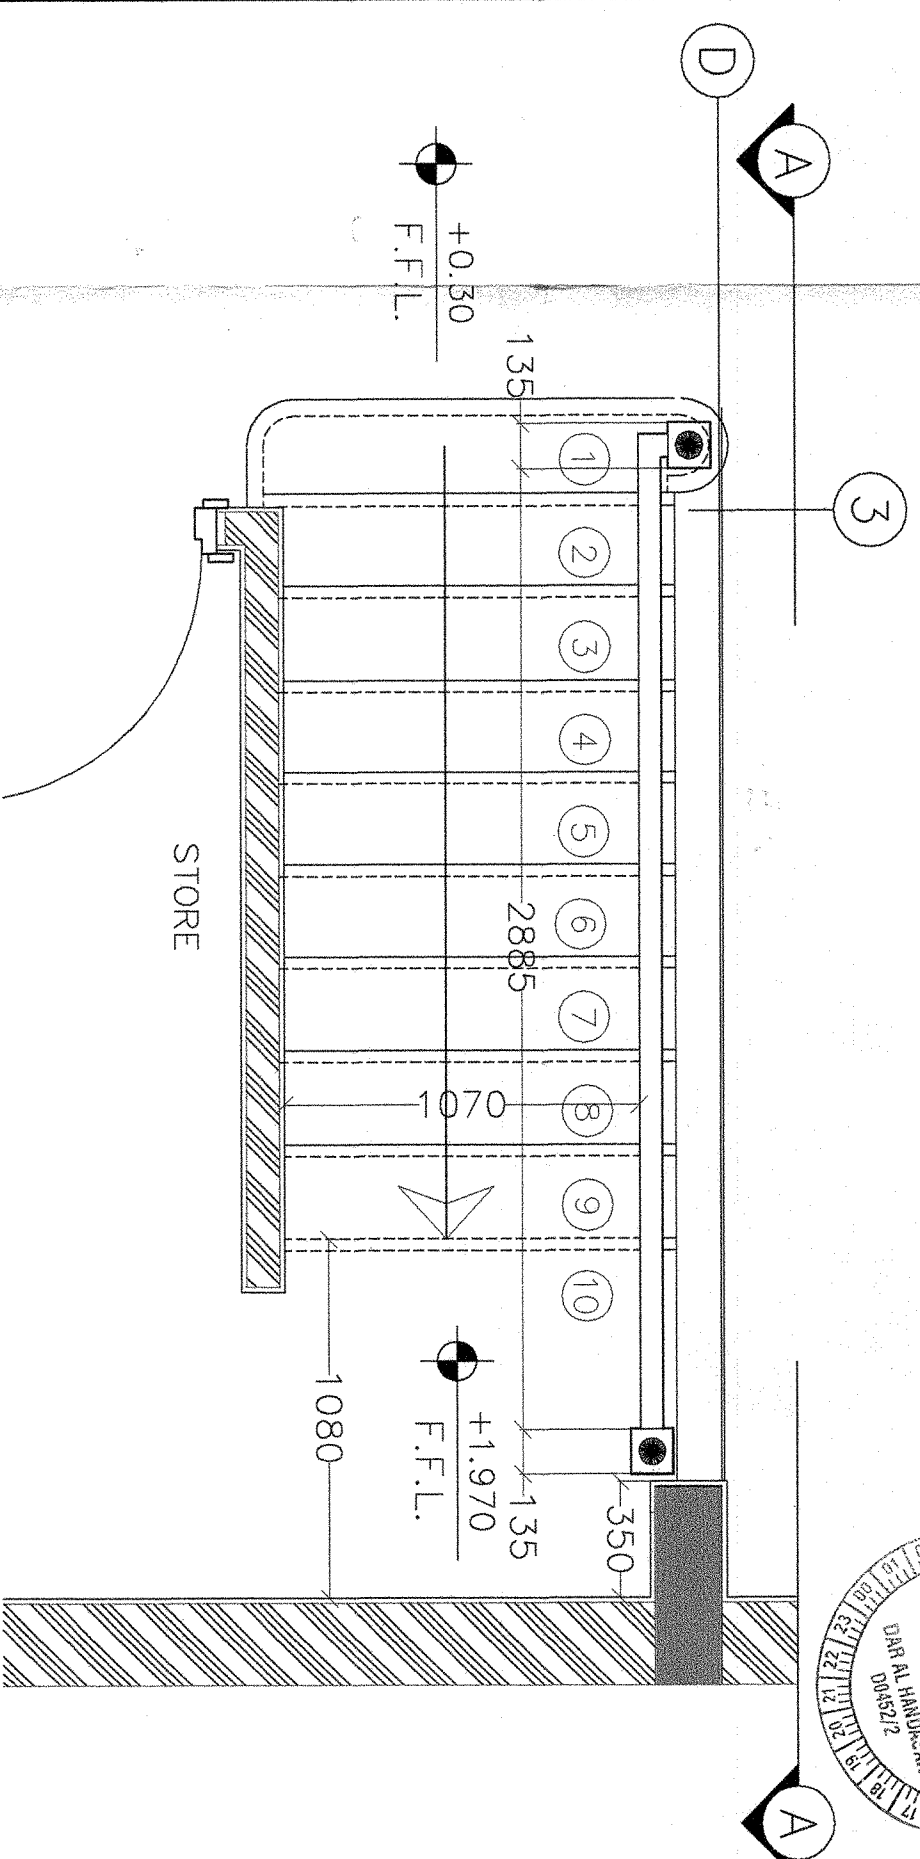


ELEVATION SECTION A-A

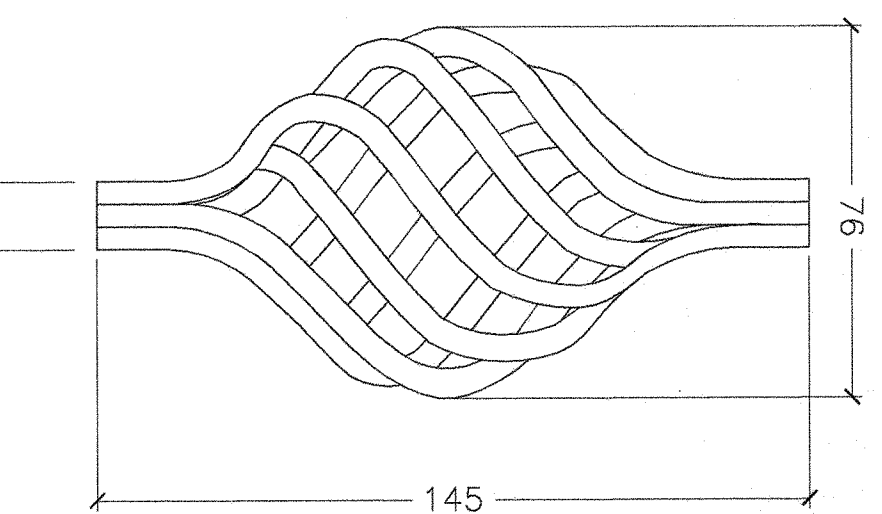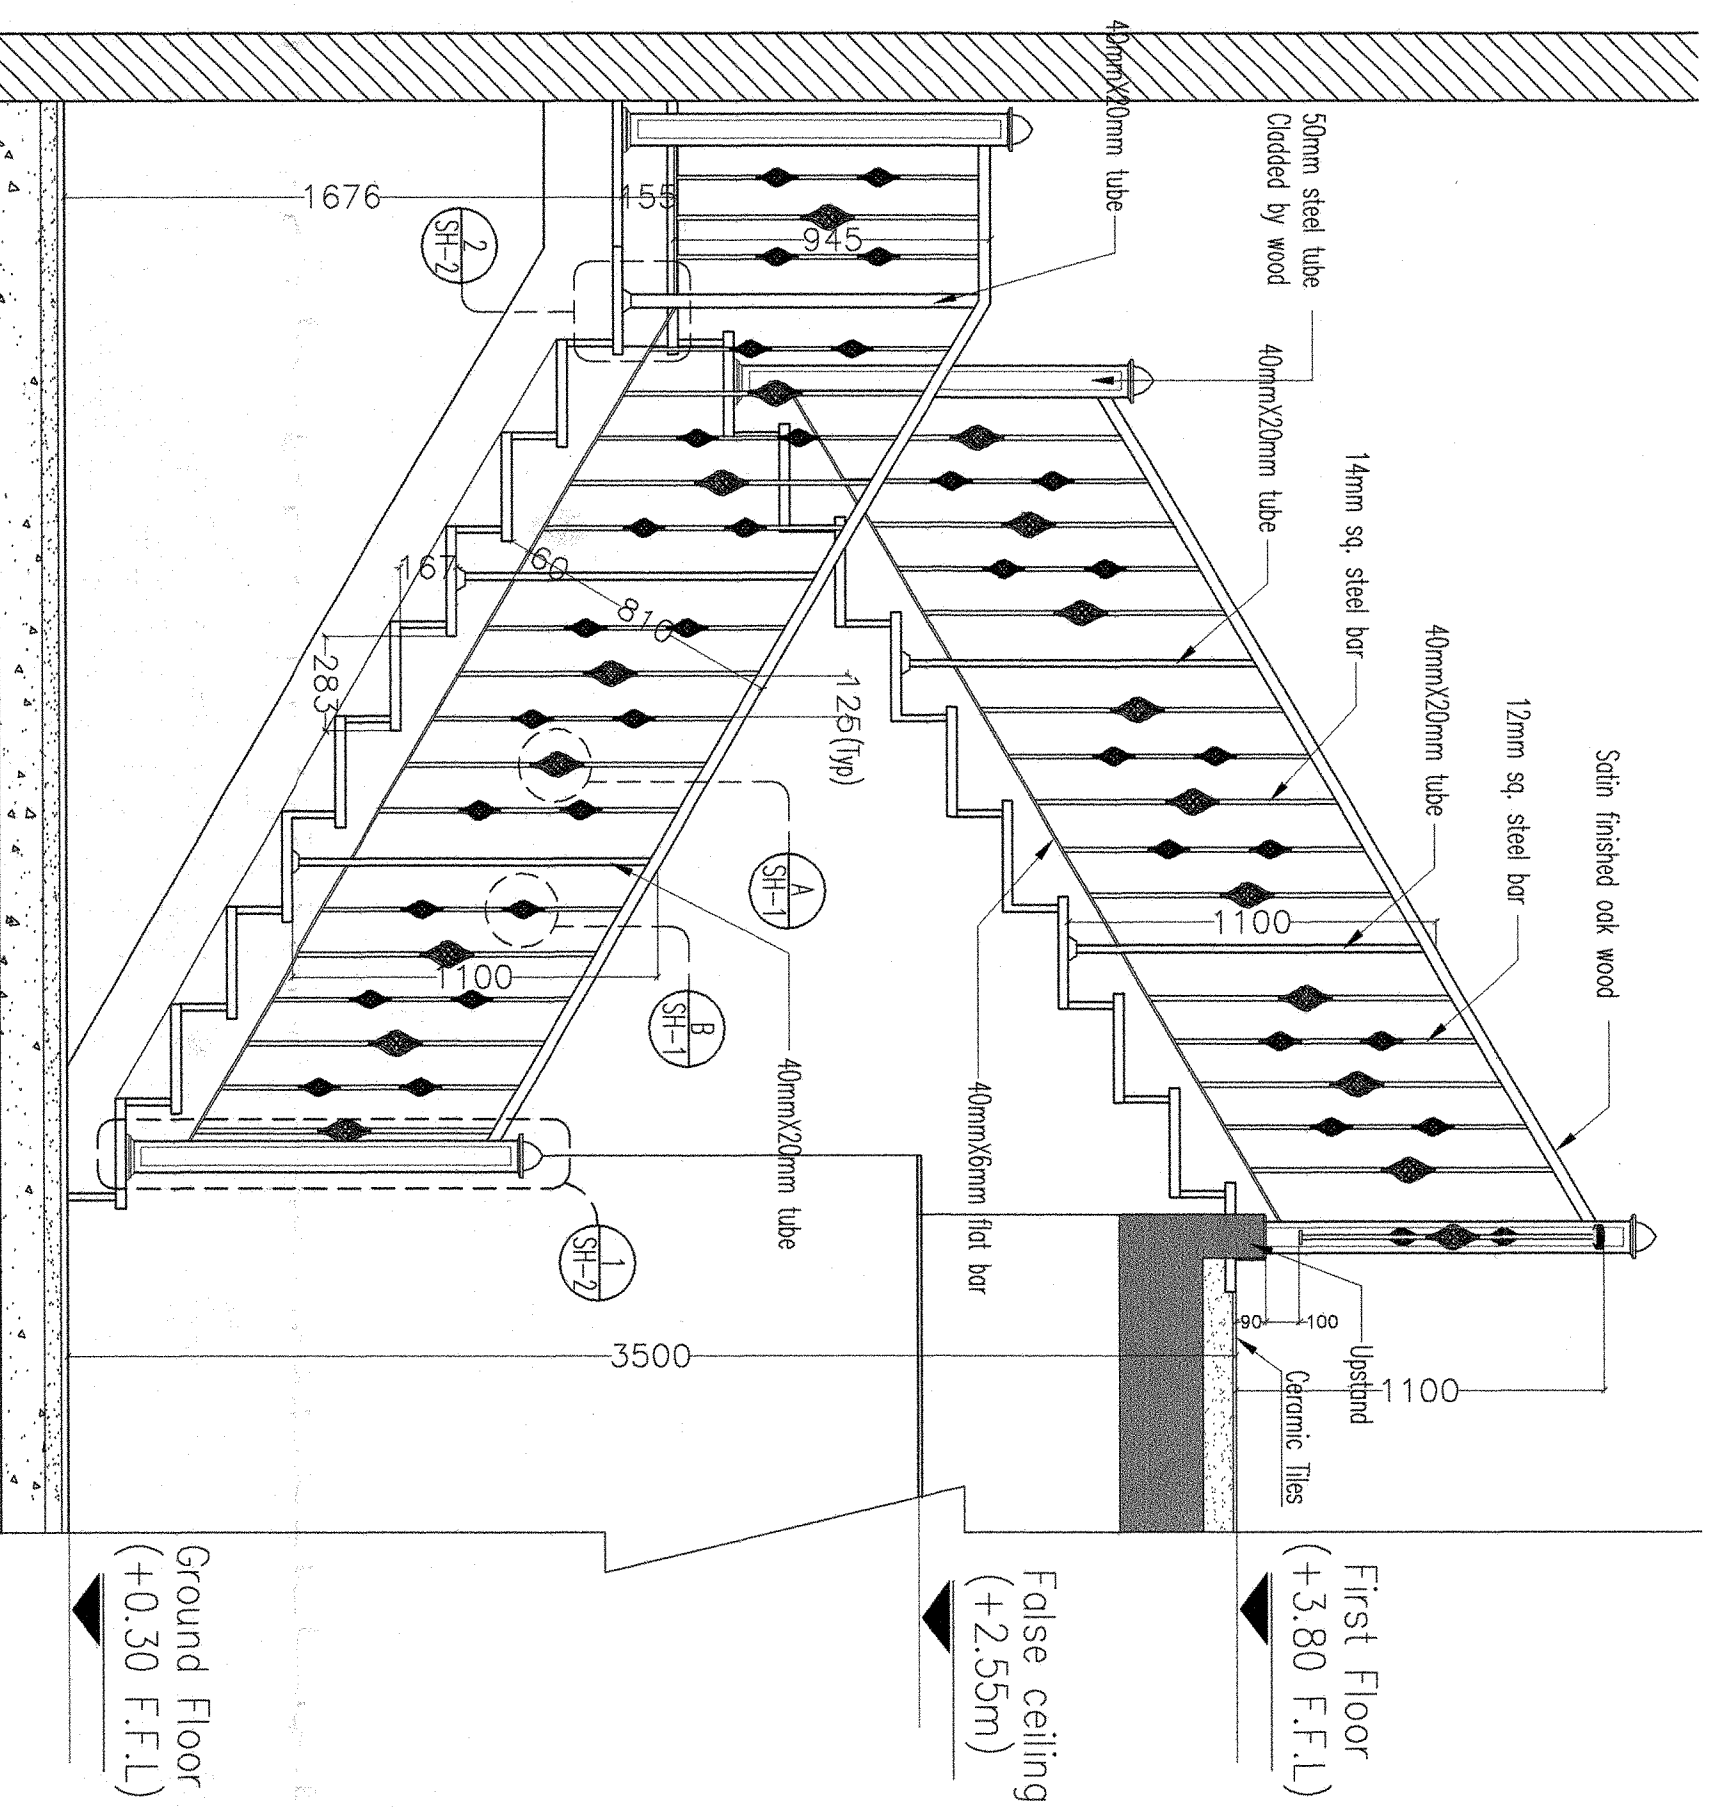


A DECORATIVE MODULE

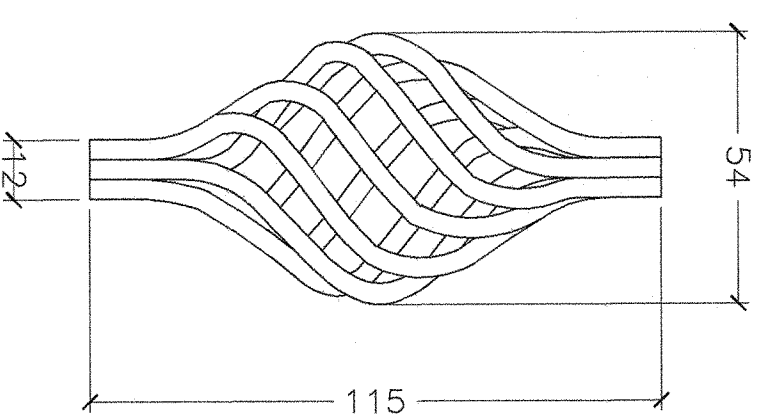


③ DECORATIVE MODULE

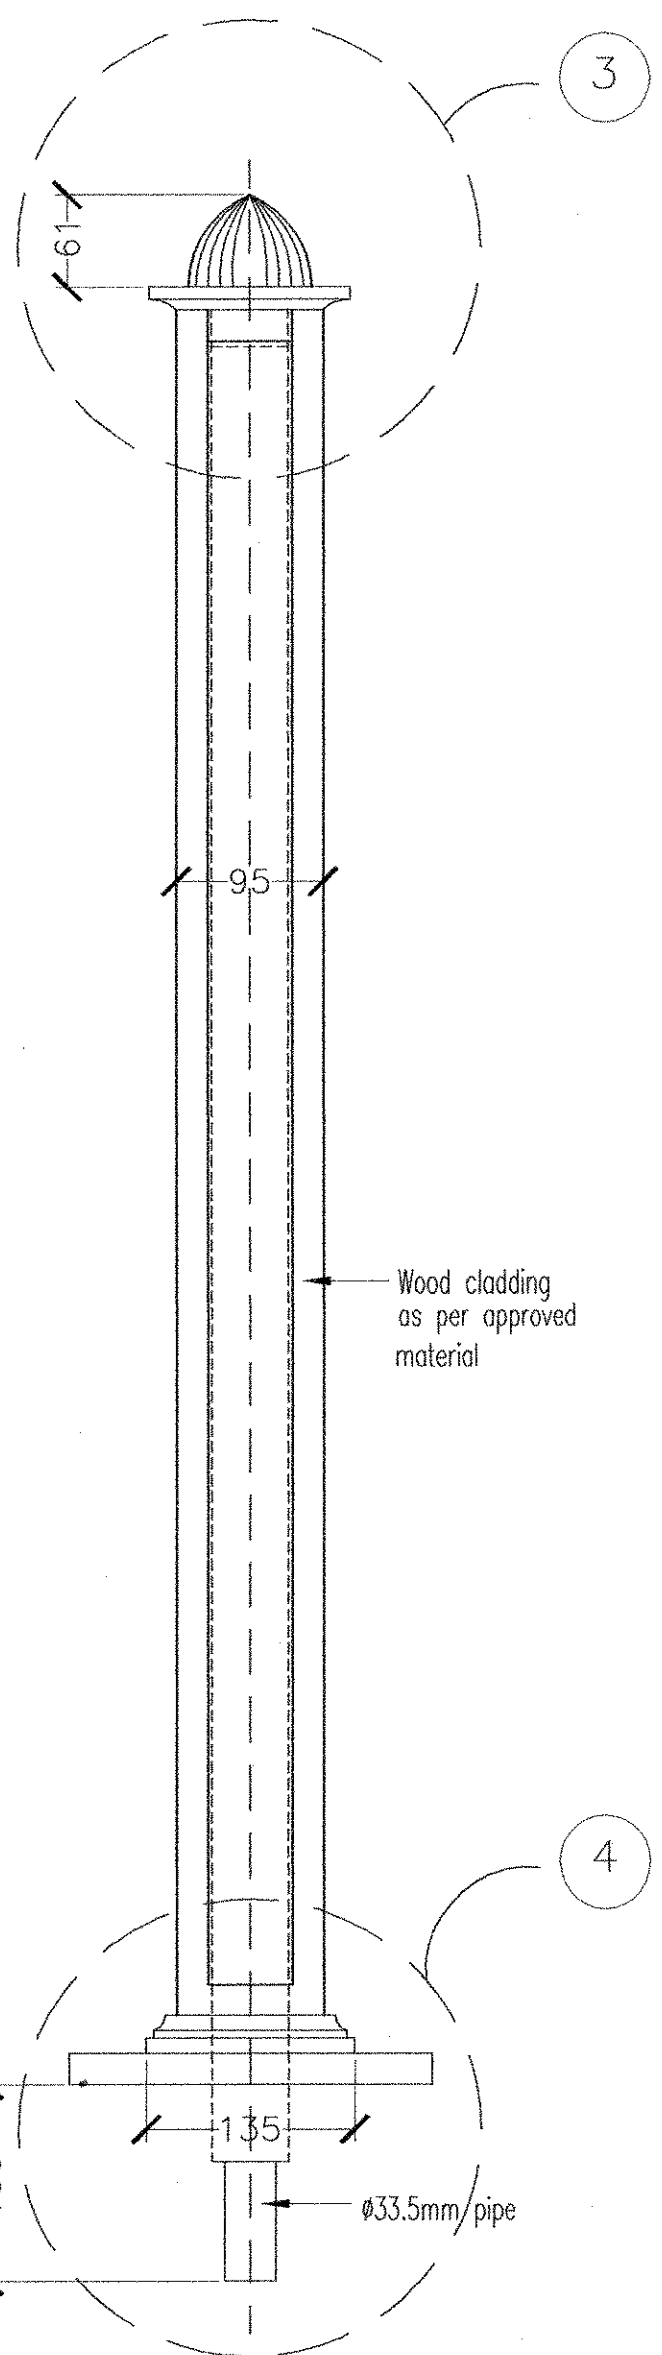


1 TYPICAL POST DETAIL

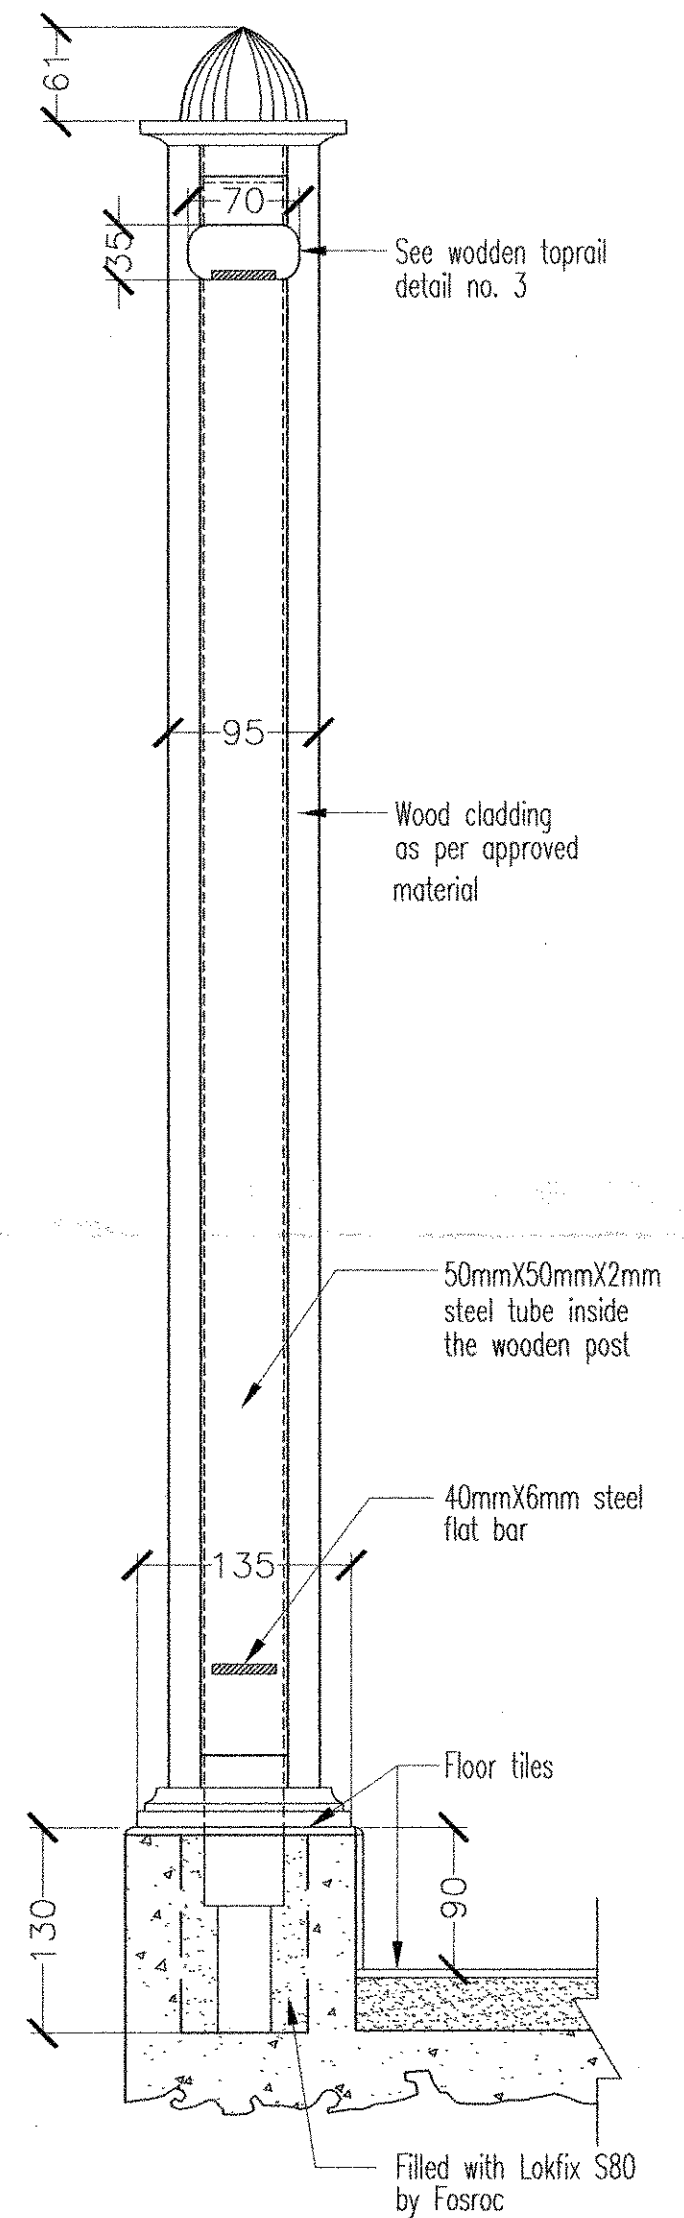


POST DETAIL ON TOP OF THE UPSTAND

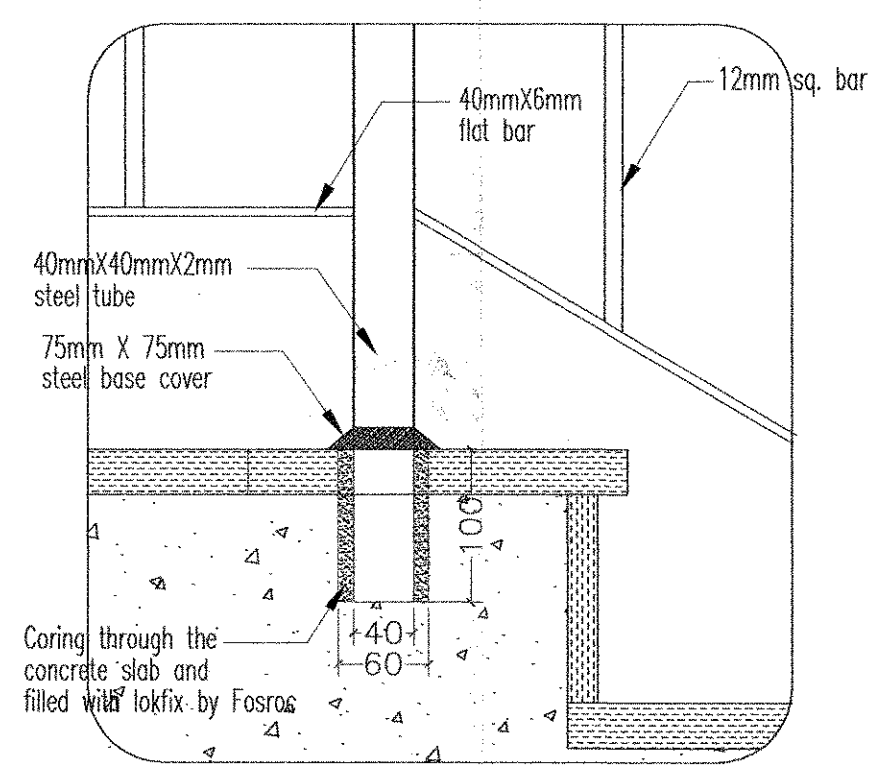


2 FIXING DETAIL

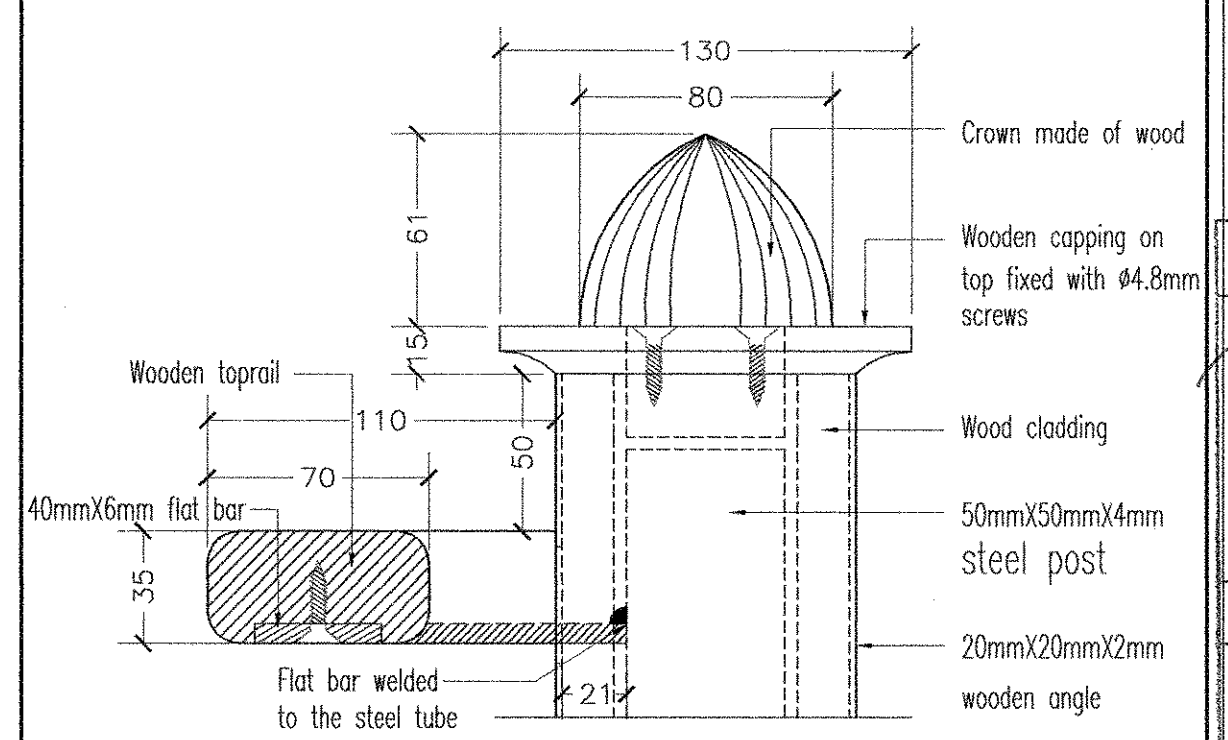

3 DETAIL OF WOODEN POST AND TOPRAIL

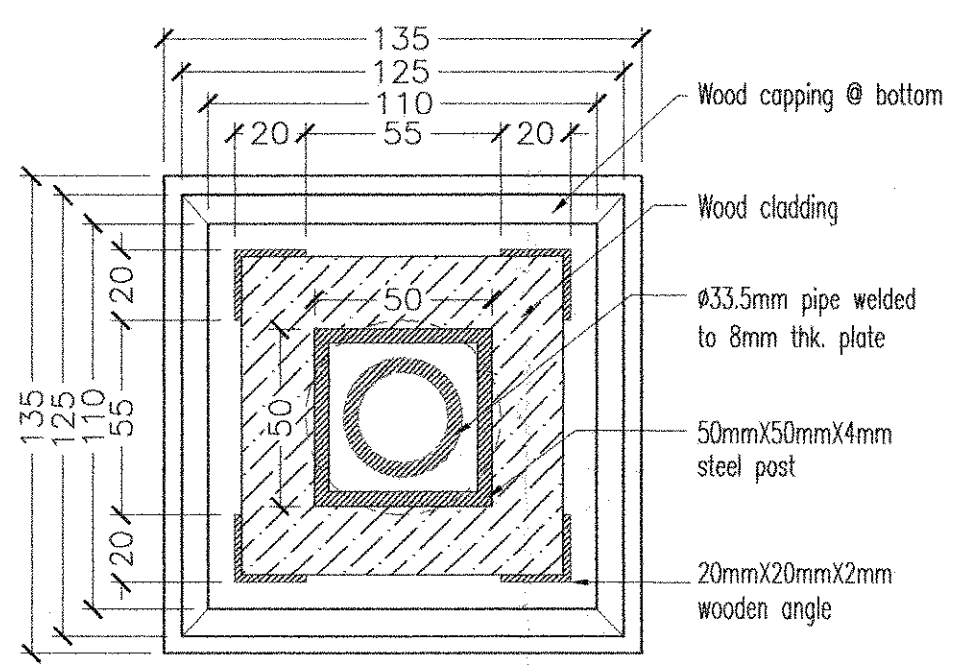

PLAN/SECTION B-B @ THE BASE OF THE POST

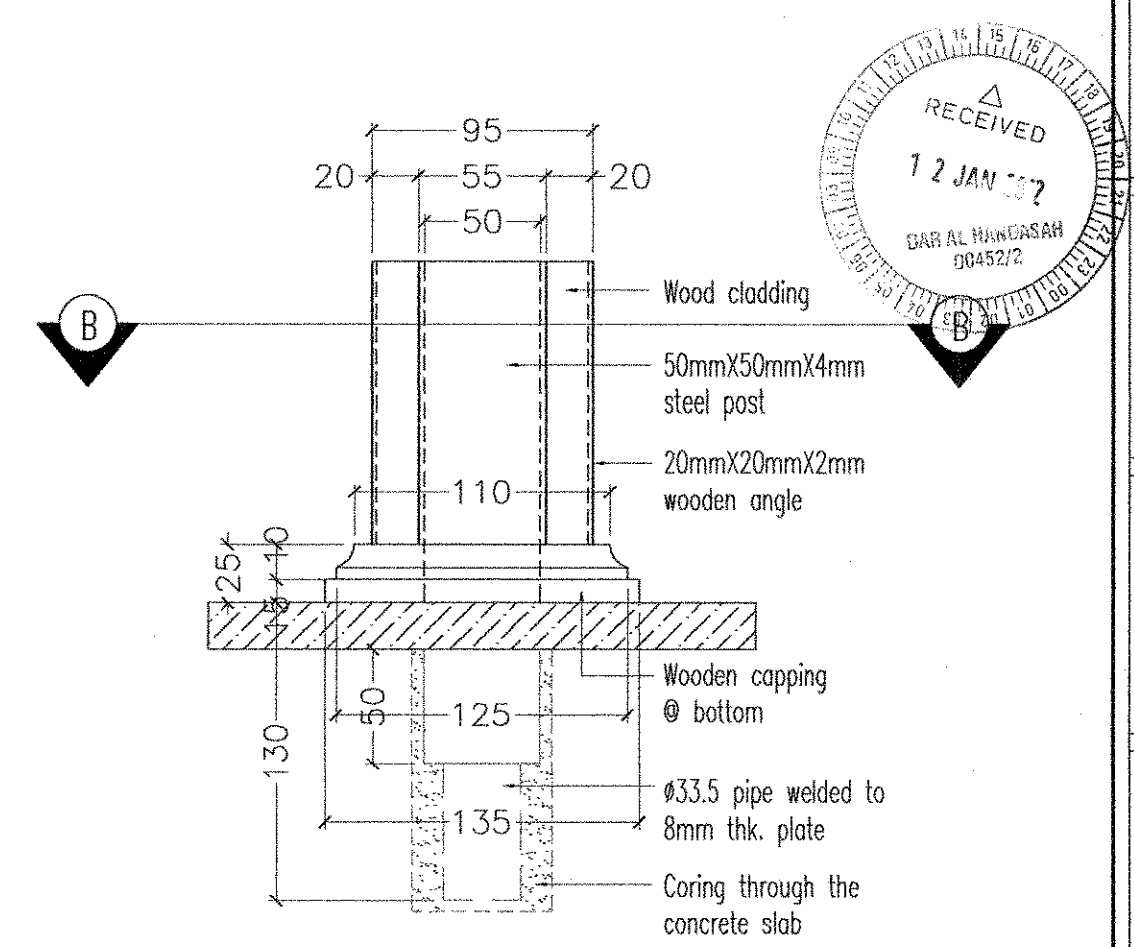

4 DETAIL OF WOODEN POST AT THE BOTTOM

dar al-handasah  
Shair and Partners

☒ CODE 1 APPROVED

☐ CODE 2 APPROVED AS NOTED  
WORK MAY PROCEED SUBJECT TO  
INCORPORATION OF ENDORSED  
COMMENTS

☐ CODE 3 RESUBMIT FOR APPROVAL  
WORK MAY NOT PROCEED

☐ CODE 4 REJECTED

BY: DATE:

Approval shall not relieve the contractor of any of his  
obligations under the Contract or constitute authorization of  
any change to Contract Documents or variation to the works.  
Contractor is responsible for dimensions, quantities and  
coordination with other trades.

AS BUILT DRAWING

PROJECT

**525 VILLAS @ JUMEIRAH PARK**  
PACKAGE 2 AND 2A  
JUMEIRAH, DUBAI

CLIENT

**NAKHEEL**  
EMIRATES TOWERS  
19th LEVEL  
P.O. BOX - 17777  
DUBAI - UAE  
TEL : 04-3903388  
FAX : 04-3903335

CONSULTANT

**dar al-handasah**  
shair and partners  
DUBAI - EGYPT - CAIRO

MAIN CONTRACTOR

**PAULING MIDDLE EAST**  
P.O. BOX 55624 ABU DHABI  
PHONE : + 971-2-6329922  
FAX : + 971-2-6325553

SUBCONTRACTOR

**AL JAZEERAH**  
METALLIC INDUSTRIES  
P.O. BOX : 95404  
TEL. NO. 04 5441408  
FAX NO. 04 5441409

TITLE

**STAIRCASE HANDRAIL**  
PLAN AND DETAILS

2 of 2

| SCALE | EMIRATE | LOCATION      | CHECKED   |
|-------|---------|---------------|-----------|
| N.T.S | DUBAI   | JUMEIRAH PARK | Eng.Ziyad |

Drawing no.  
PME/JF/AB/STAIRCASE HANDRAIL-002