




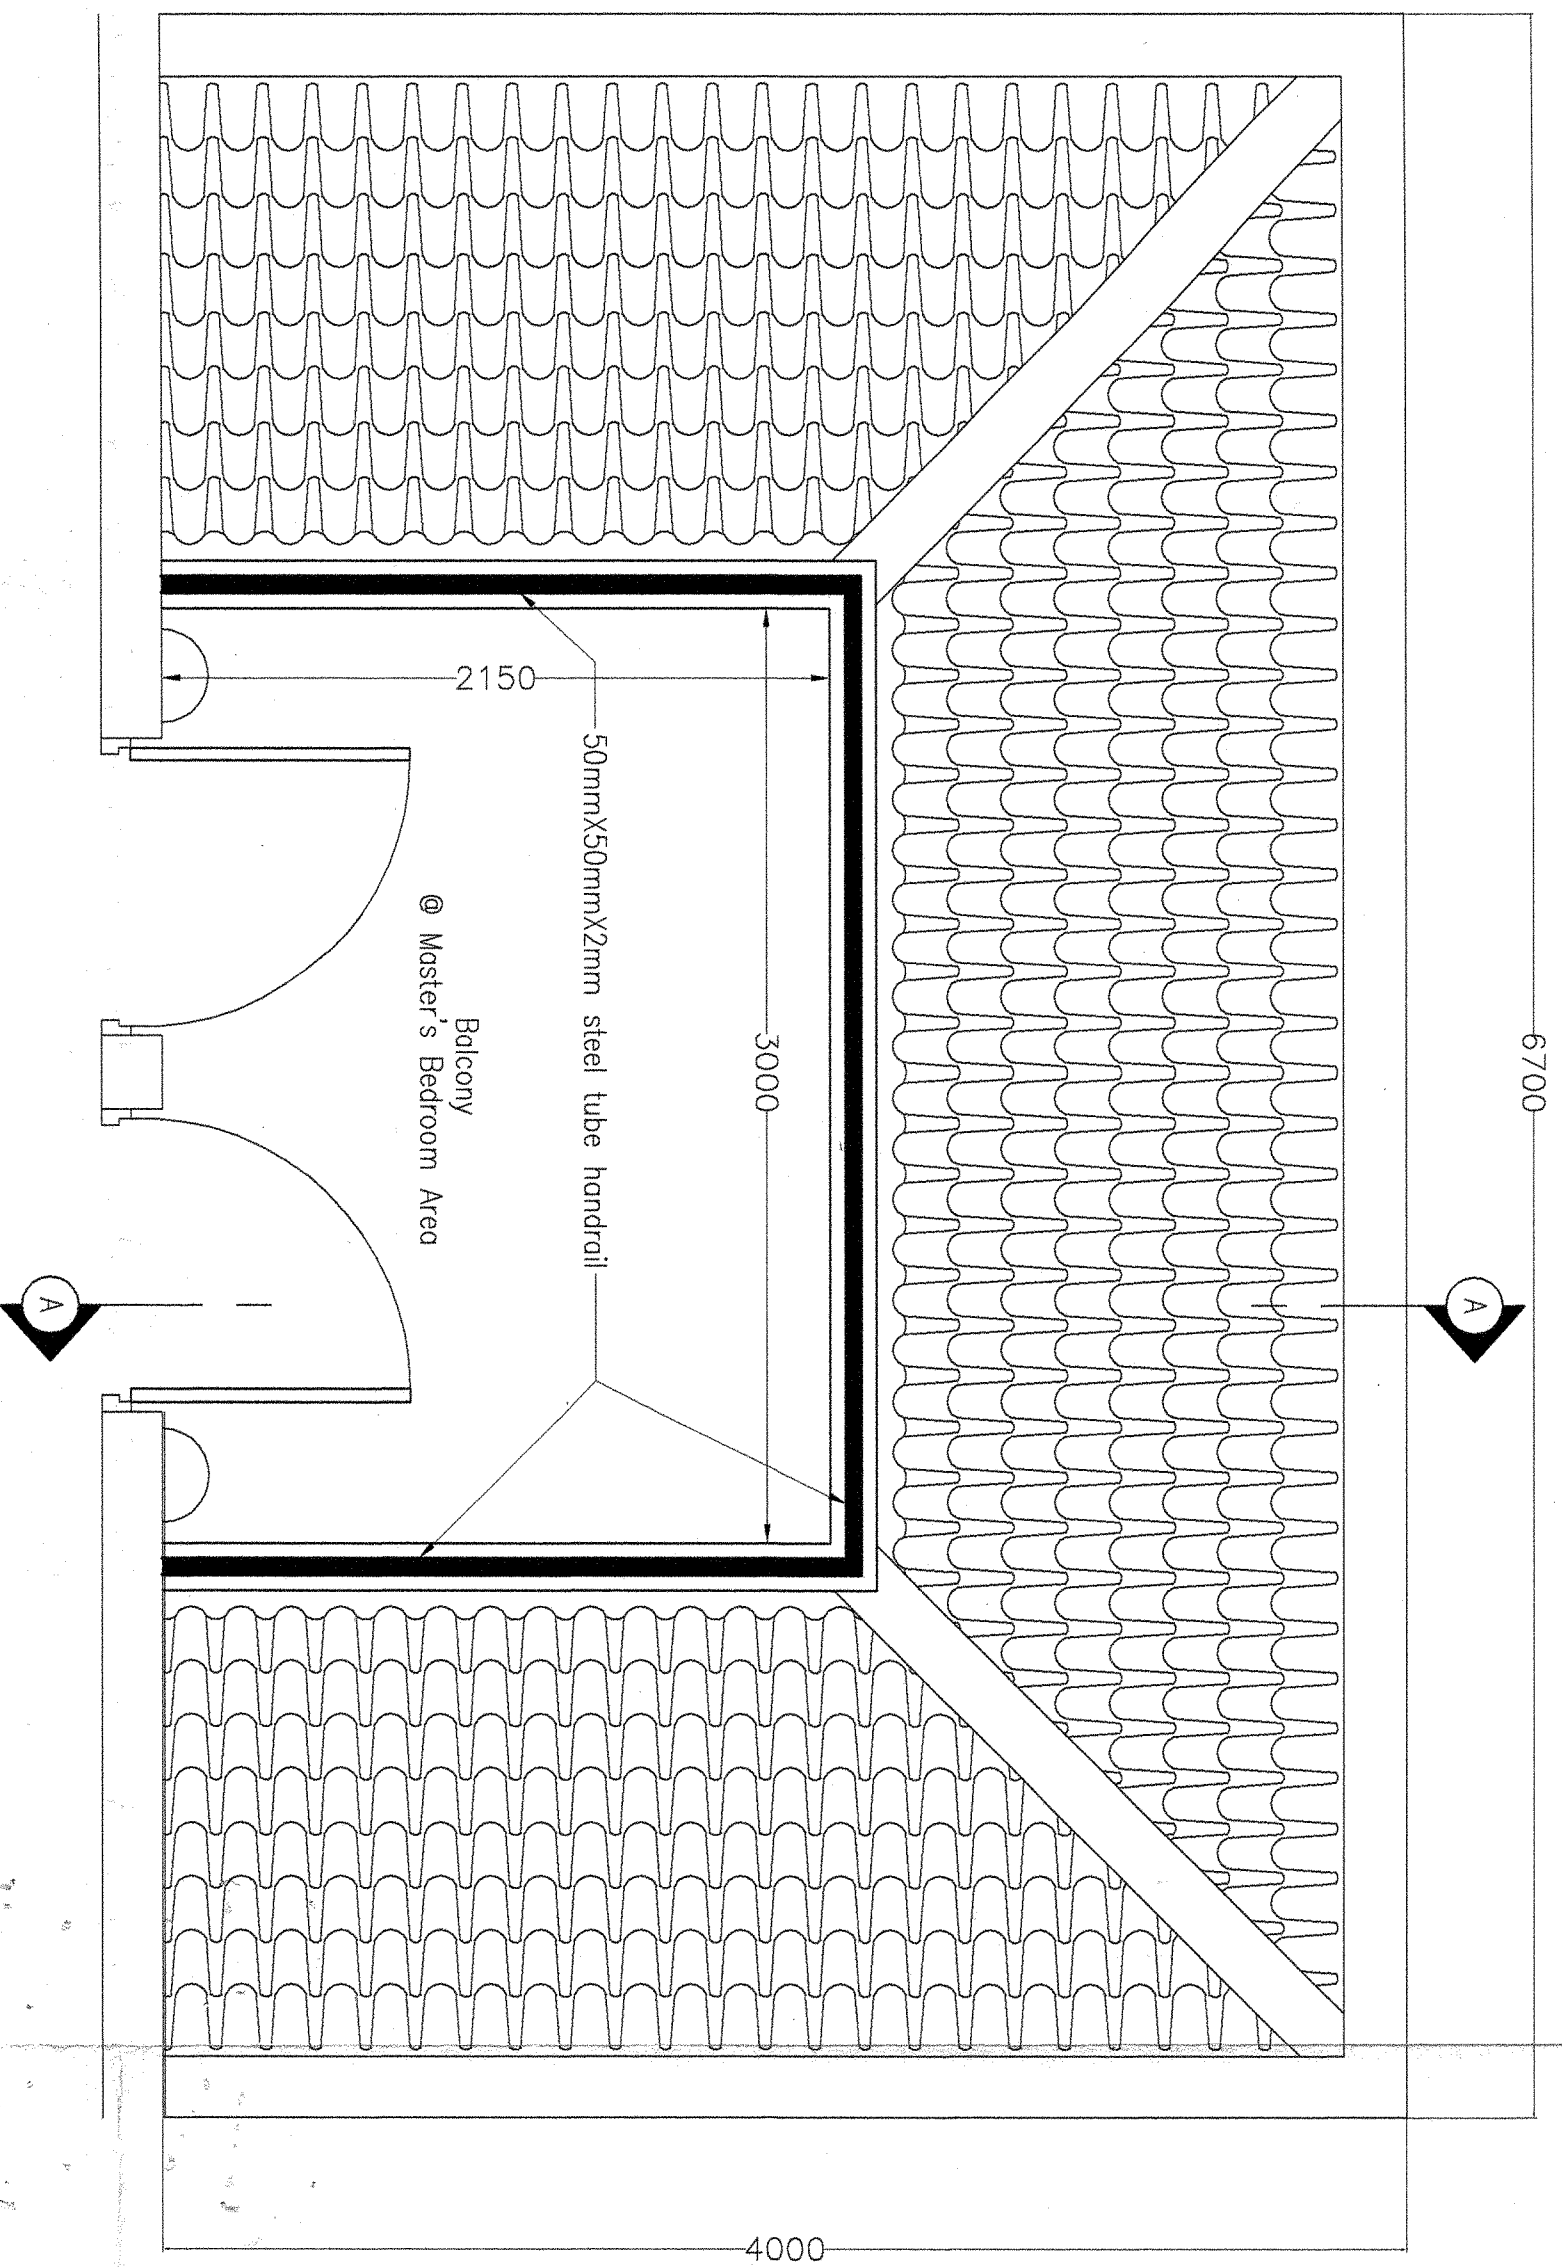


PLAN

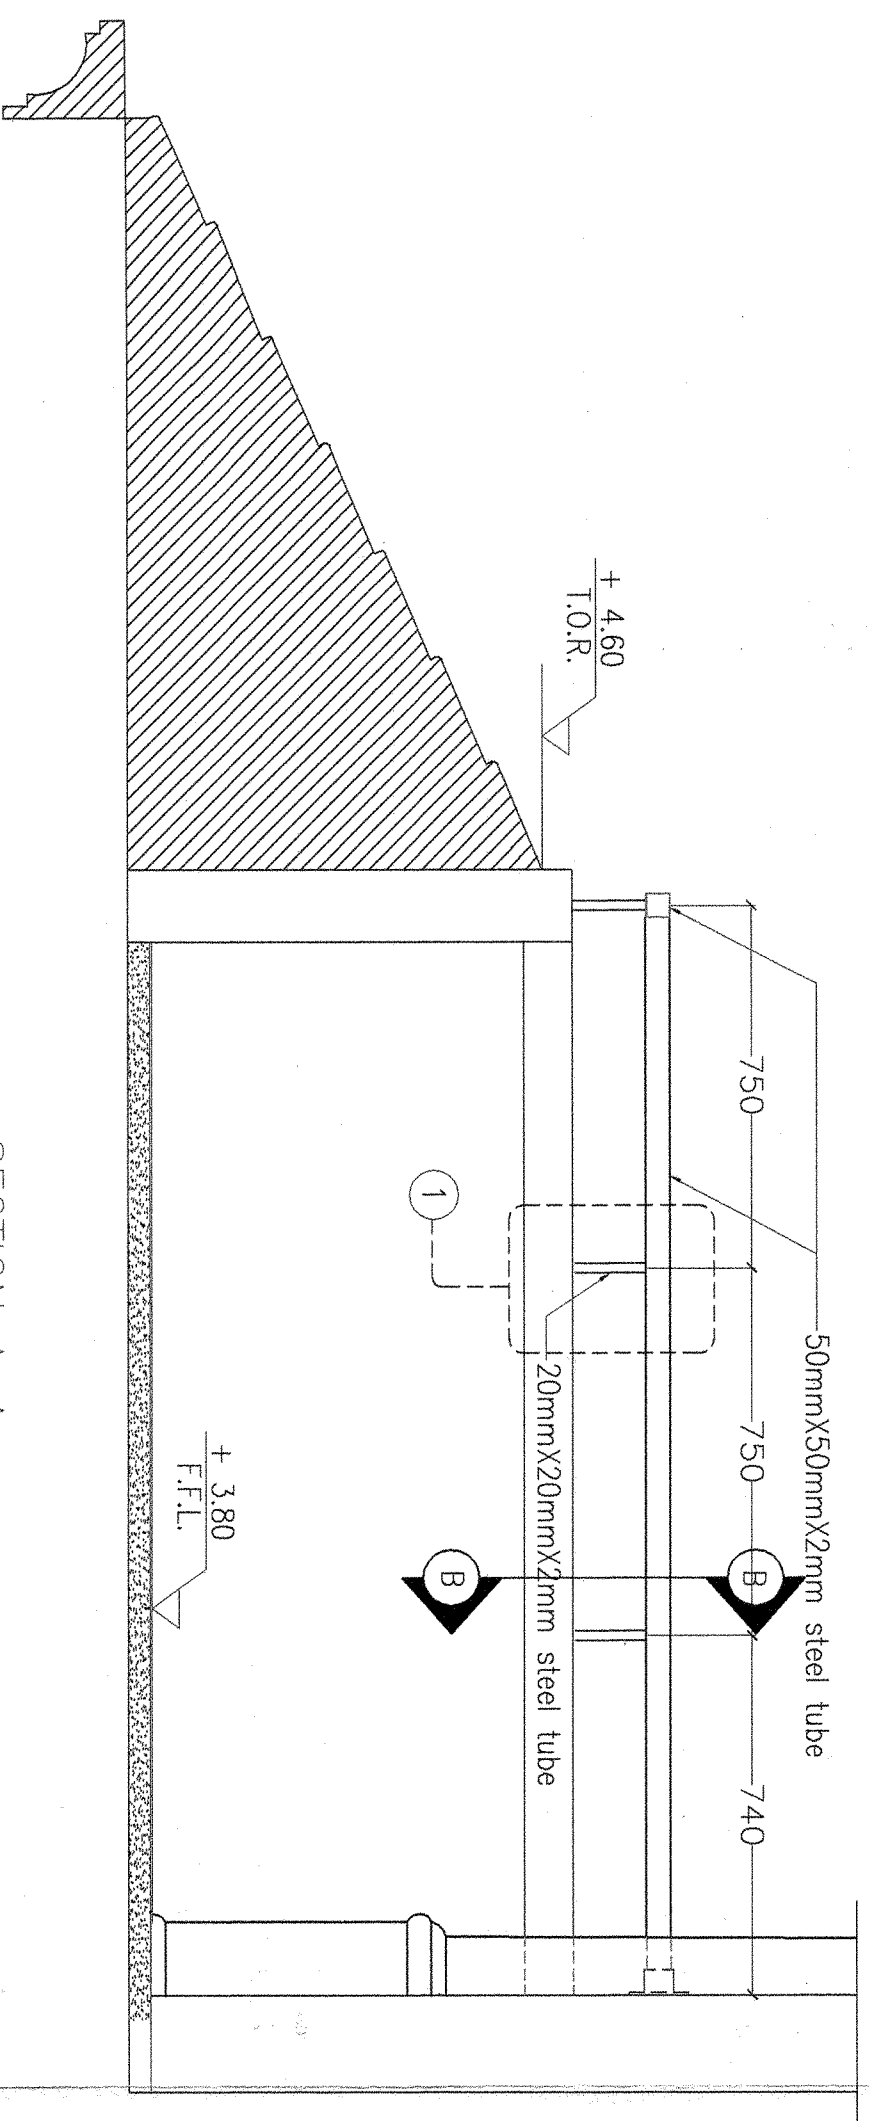


SECTION A-A

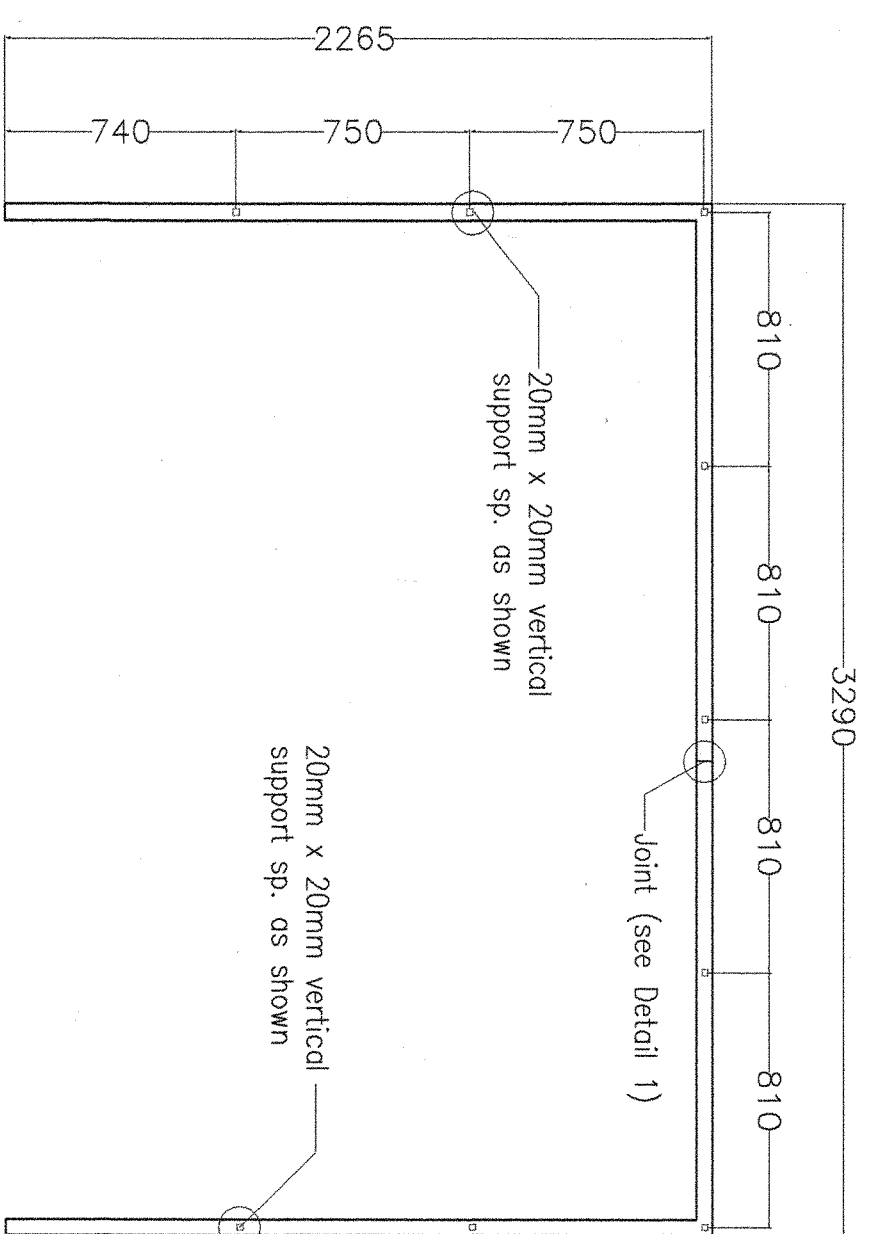


VERTICAL SUPPORT LAYOUT PLAN

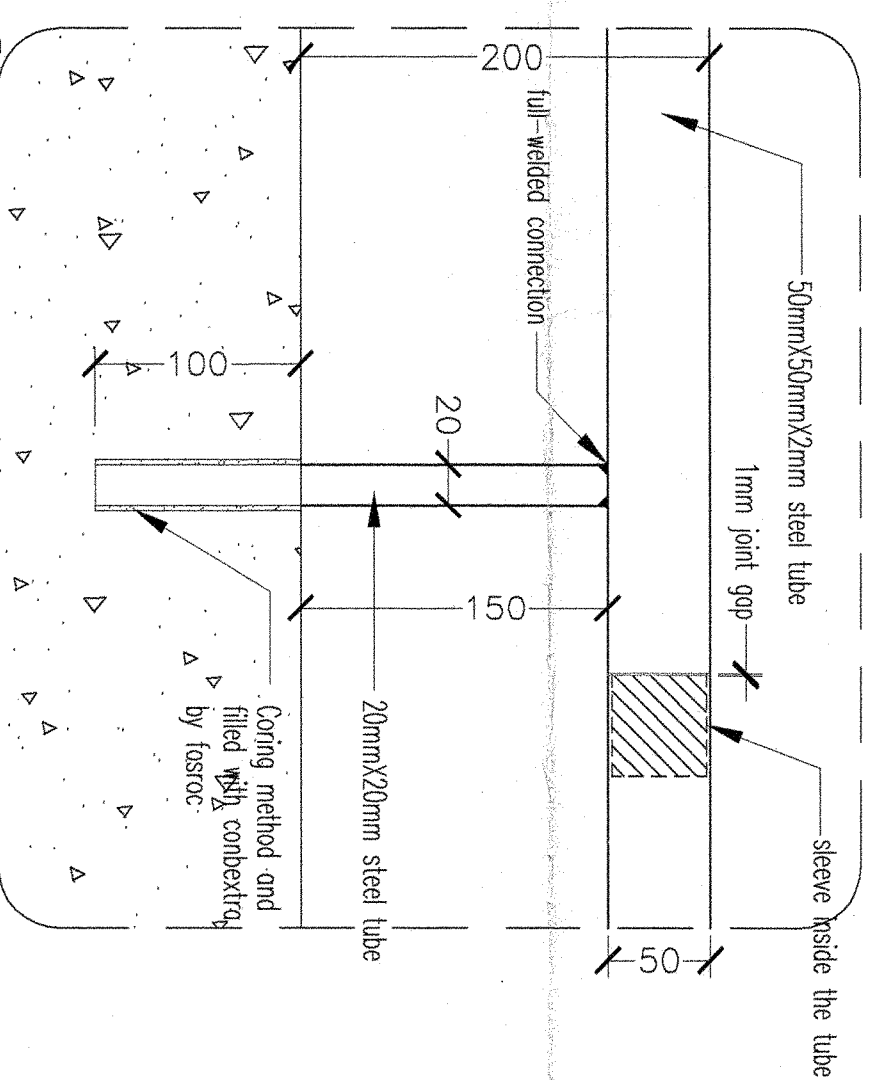

DETAIL 1

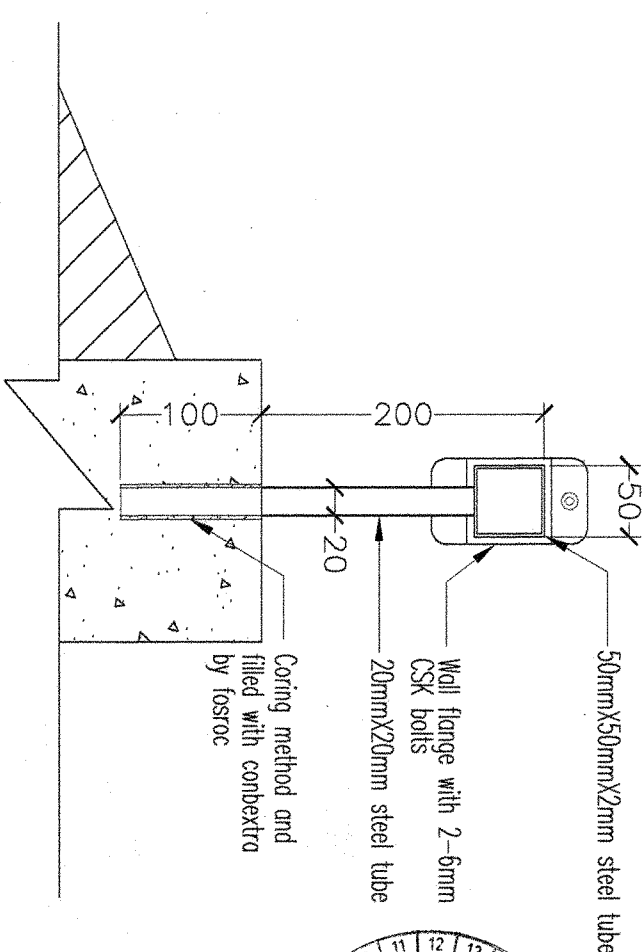

SECTION B-B

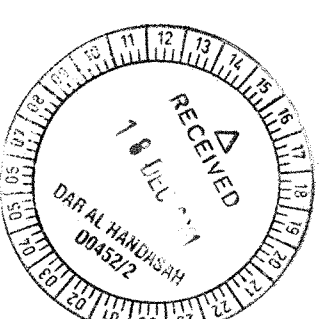

AS BUILT DRAWING

dar al-handasah Structural and Partners	
☒ CODE 1 APPROVED	☐ CODE 2 APPROVED AS NOTED INCORPORATION OF COMMENTS RESUBMIT FOR APPROVAL WORK MAY NOT PROCEED
☐ CODE 3 RESUBMIT FOR APPROVAL WORK MAY NOT PROCEED	☐ CODE 4 REJECTED
BY: _____ DATE: _____	

21/11/2011

525 VILLAS @ JUMEIRAH PARK
PACKAGE 2 AND 2A
JUMEIRAH, DUBAI

NAKHEEL
EMIRATES TOWERS
19th LEVEL
P.O. BOX - 17777
DUBAI - UAE
TEL : 04-3903388
FAX : 04-3903335

dar al-handasah
Structural and Partners
DUBAI - UAE
TEL : 04-3903388
FAX : 04-3903335

PAULING MIDDLE EAST
P.O. BOX 55624 ABU DHABI
PHONE : + 971-2-6329822
FAX : + 971-2-6329855

AL JAZEBRAH
METALLIC INDUSTRIES
P.O. BOX : 95408
TEL NO. 04 5441408
FAX NO. 04 5441408

TERRACE RAILING PLAN AND DETAILS

SCALE	EMIRATE	LOCATION	CHECKED
N.T.S	DUBAI	JUMEIRAH PARK	Eng Zyod

Drawing no. PNE/JP/AB/TERRACE RAILING-004