

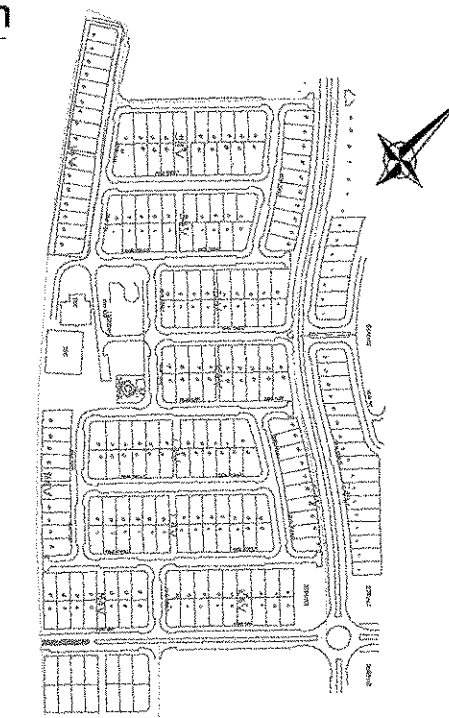


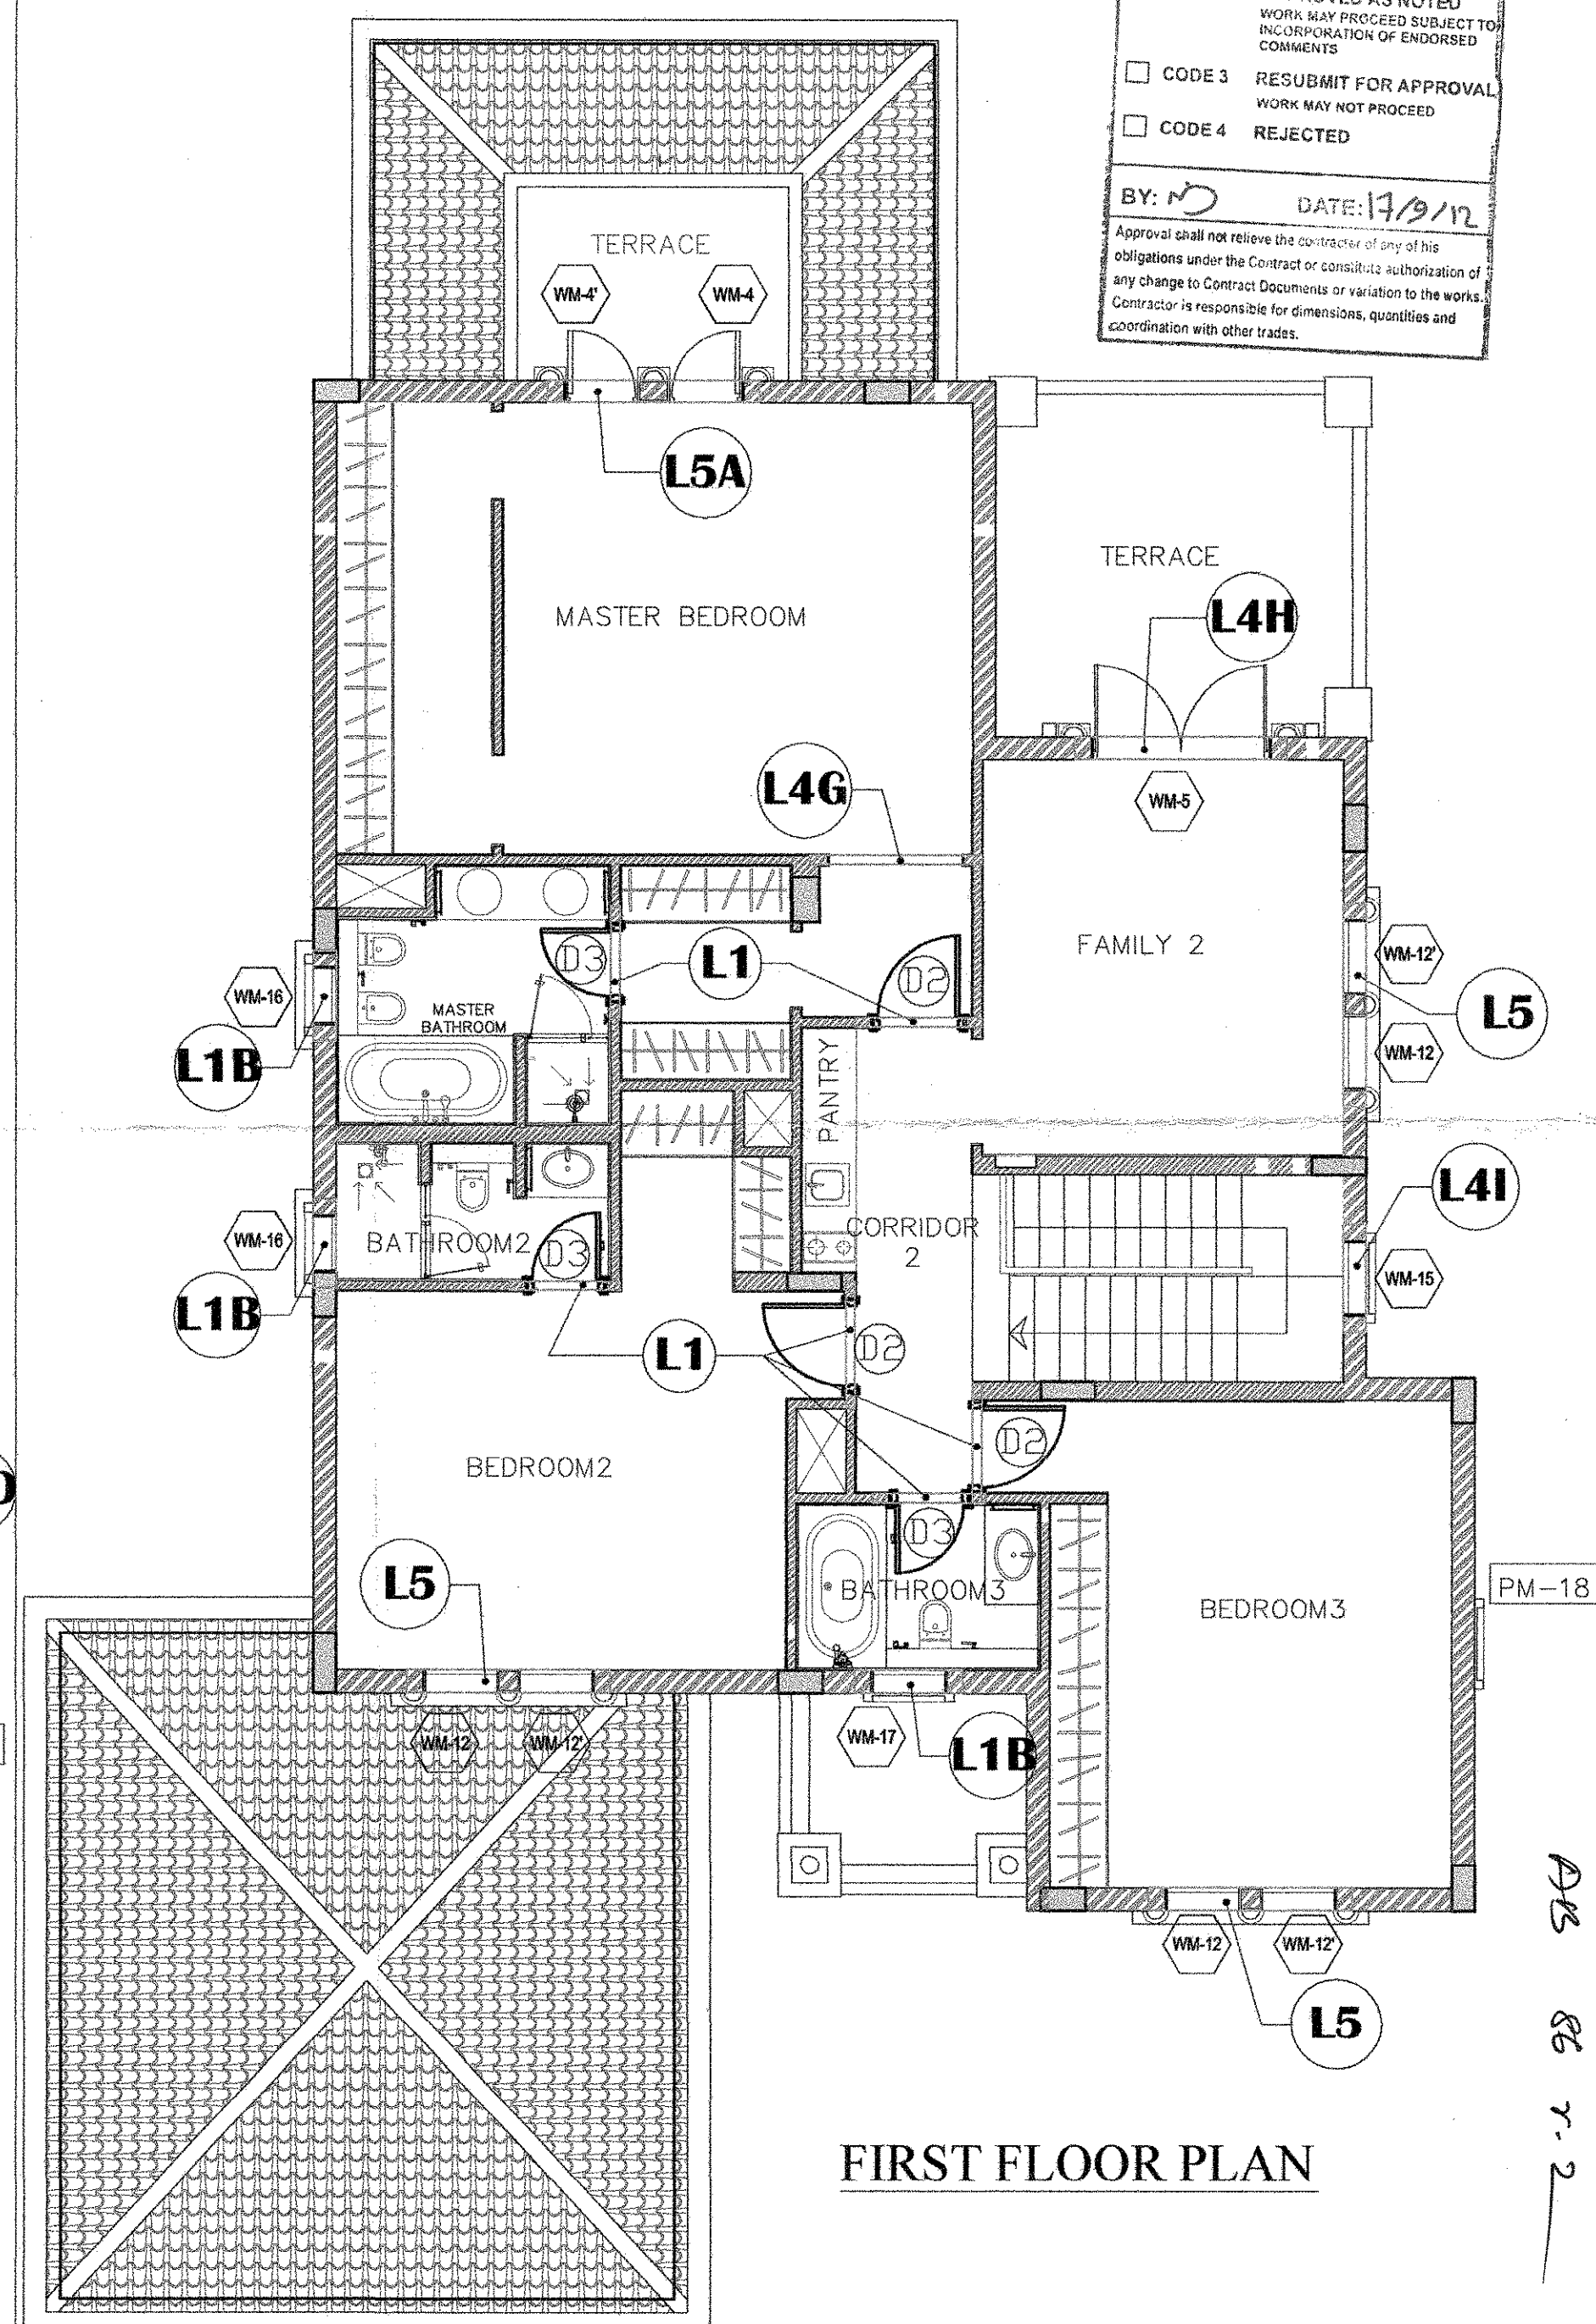

 dar al-handasah Shair and Partners	
☒ CODE 1	APPROVED
☐ CODE 2	APPROVED AS NOTED WORK MAY PROCEED SUBJECT INCORPORATION OF ENDORSED COMMENTS
☐ CODE 3	RESUBMIT FOR APPROVAL WORK MAY NOT PROCEED
☐ CODE 4	REJECTED
BY: <u>MD</u> DATE: <u>17/9/12</u>	
Approval shall not relieve the contractor of any of his obligations under the Contract or constitute authorization of any change to Contract Documents or variation to the works. Contractor is responsible for dimensions, quantities and coordination with other trades.	

NOTES:-

- 1) ALL DIMENSIONS ARE IN MM AND LEVELS ARE METERS UNLESS NOTED OTHERWISE.
- 2) ALL REINFORCEMENT EXCEPT TIES & STIRRUPS UNLESS OTHERWISE INDICATED TO BE HIGH TENSILE STEEL TO BS. 4449 HAVING A MINIMUM YIELD STRESS $f_y = 420 \text{ MPa}$ (DESIGNATED BY Φ)
- 3) ALL REINFORCED CONCRETE SHOULD HAVE A MINIMUM CRUSHING STRENGTH ON CYLINDER AT 28 DAYS: $f'_c = 35 \text{ MPa}$
- 4) ALL SPLICES OF REINFORCEMENT SHOULD BE MIN. 60 BAR DIAMETER
- 5) UNLESS OTHERWISE NOTED , THE FOLLOWING NOMINAL CONCRETE COVER TO ALL REINFORCING BARS SHALL BE ADOPTED:
 - a - FOR SLABS AND WALLS NOT EXPOSED TO EARTH OR WEATHER : 30mm.
 - b - FOR BASEMENT WALLS : 50mm.
 - c - FOR DROP BEAMS AND COLUMNS : 40mm.
 - d - FOR FOUNDATIONS : 75mm.
 - e - FOR ALL SURFACES IN CONTACT WITH WATER OR VAPOUR : 50mm.

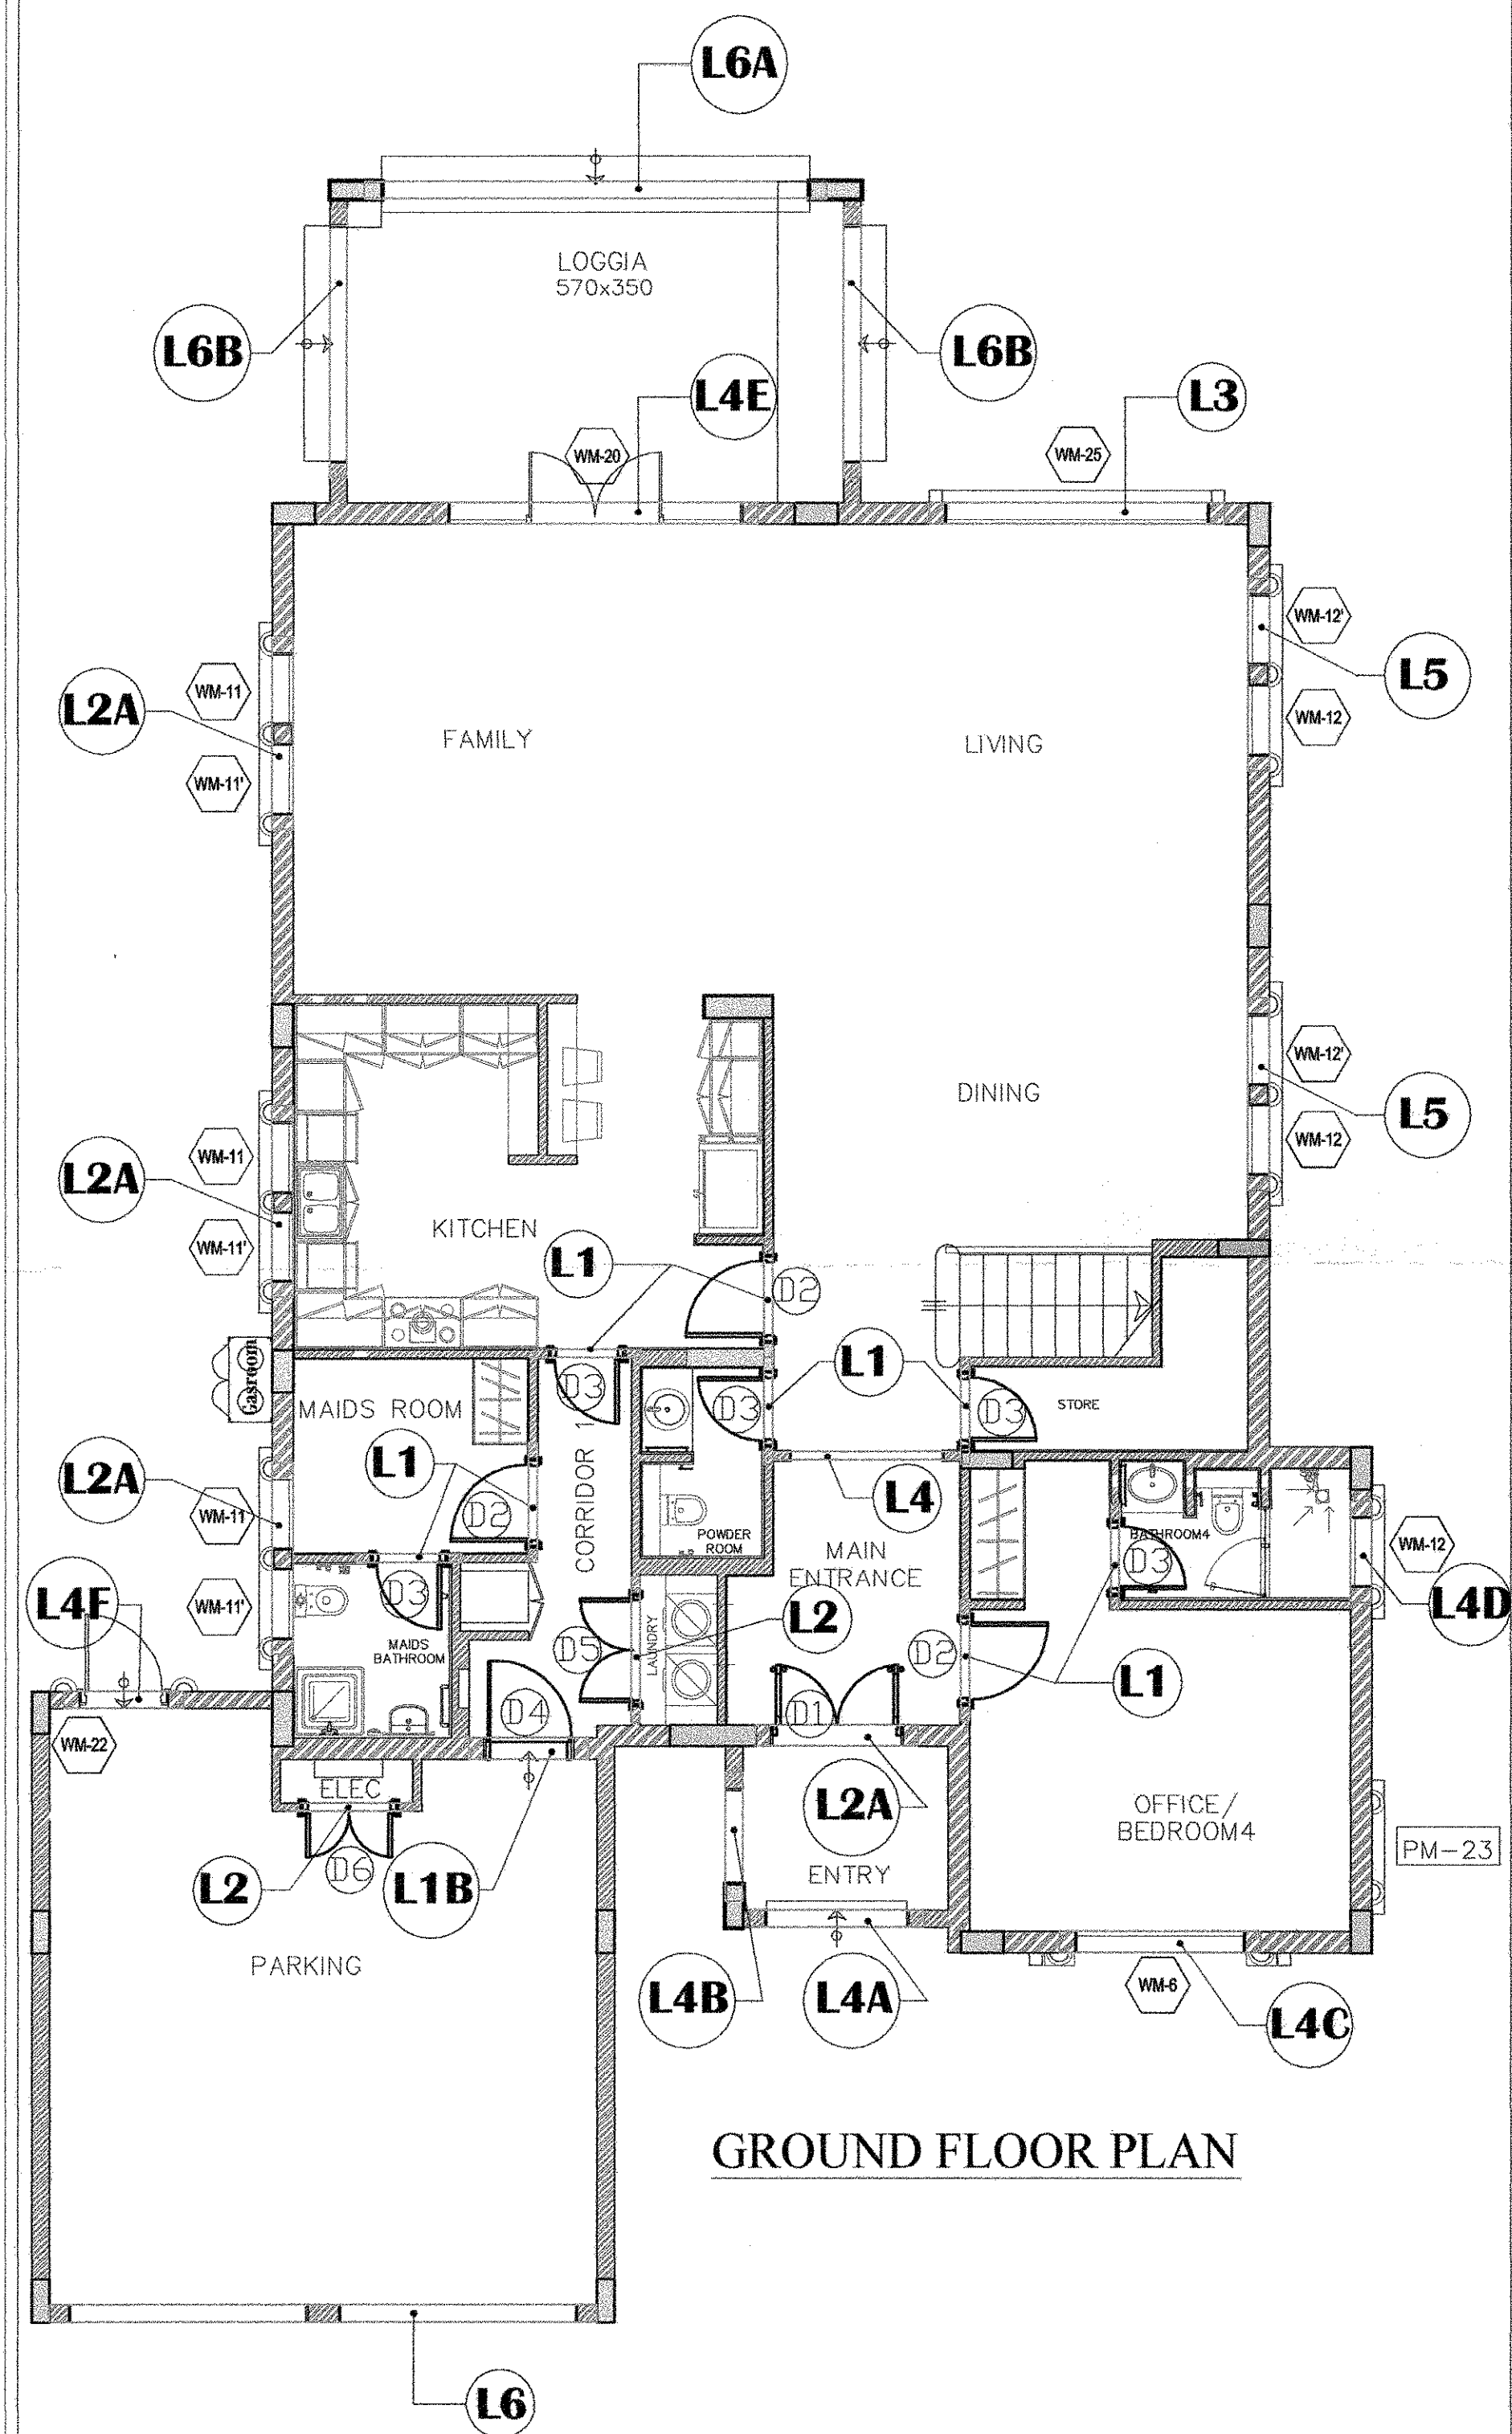

AS BUILT DRAWING

Project

JUMAIRAH PARK

Employer



NAKHEEL

P.O. BOX : 17777, DUBAI, U.A.E.
PHONE : + 971 -4 -390388
FAX : + 971 -4 -390335
WebSite : www.mskbed.ae
E-MAIL : info@mskbed.ae

Consultant



P.O. BOX: 55634, INDIANAPOLIS, IN 46206
PHONE : + 971-4-335502
FAX : + 971-4-3355122
www.dargroup.com

www.dargroup.com



Pauling Middle East

P.O. BOX: 45176, ABUDHABI, U.A.E
PHONE : + 971-2-6329922
FAX : + 971-2-6325553
E-MAIL : pauling1@emirates.net.ae

Package

PACKAGE - 2


Drawing Title

Lintel Details
Type : Legacy


Drawn	Review	Checked:
-------	--------	----------

Thirumurugan	Eng. Ziad	Eng. Ghassan Zeitou
Scale:	Date: 15.02.2016	


Score: 1 : 50	Date: 15.09.2012
---------------	------------------

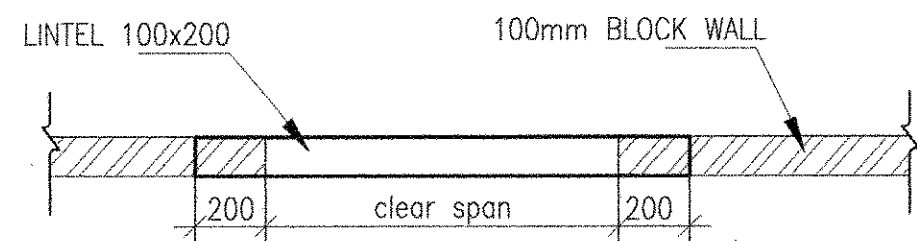


100mm WALL PLAN (L1)
CLEAR SPAN UP TO 1.00m

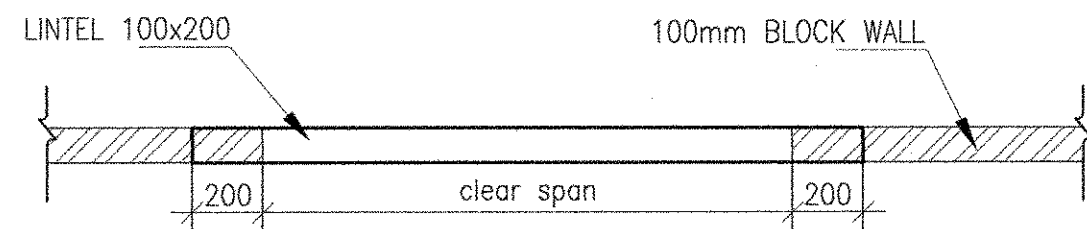


100mm WALL PLAN (L2)
CLEAR SPAN FROM 1.01m TO 2.00m

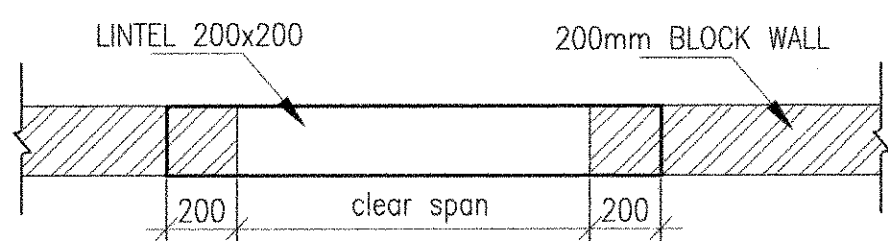


200mm WALL PLAN (L1A)
CLEAR SPAN UP TO 1.00m

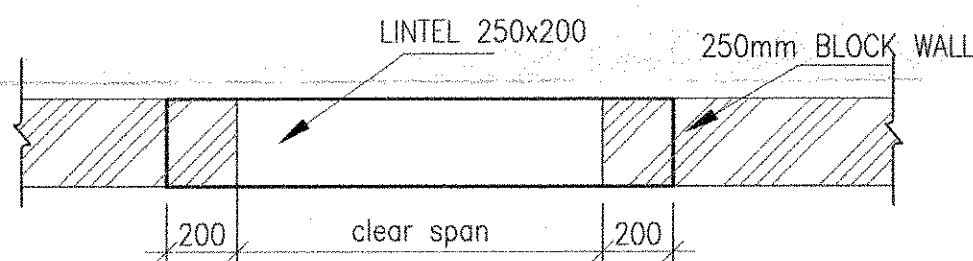


250mm WALL PLAN (L1B)
CLEAR SPAN UP TO 1.00m

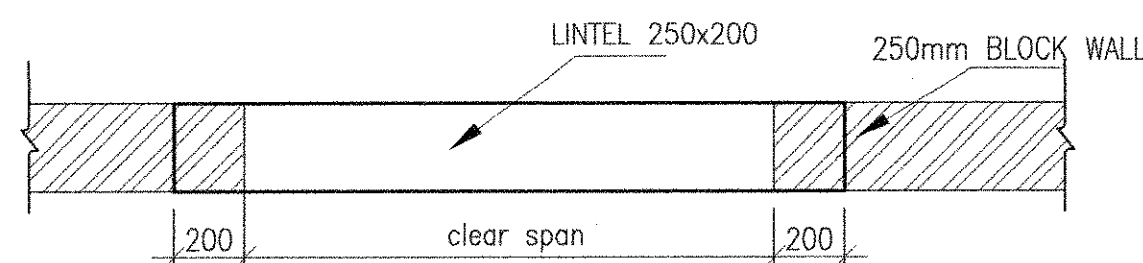


250mm WALL PLAN (L2A)
CLEAR SPAN FROM 1.01m TO 2.00m

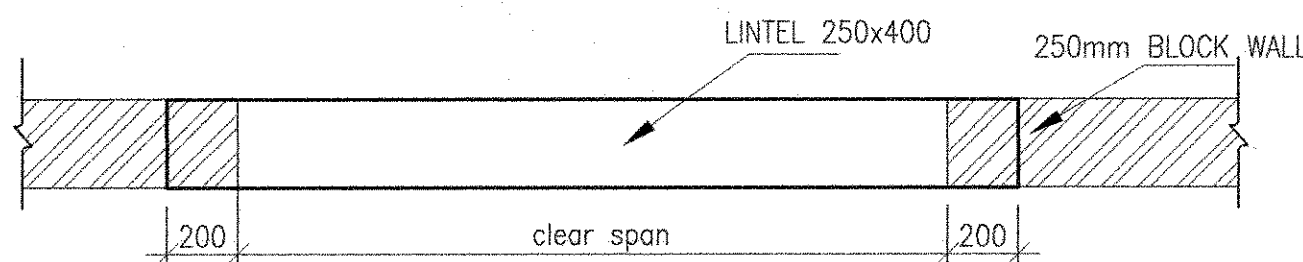


250mm WALL PLAN (L3)
CLEAR SPAN FROM 2.01m TO 4.00m

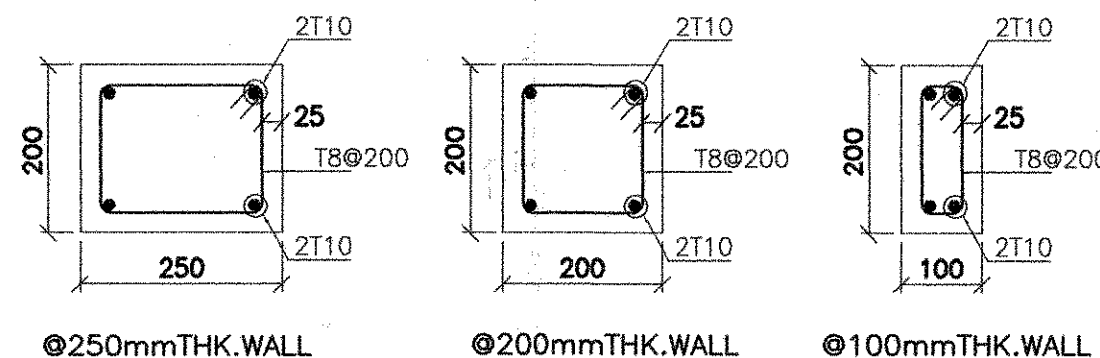


Section A-A

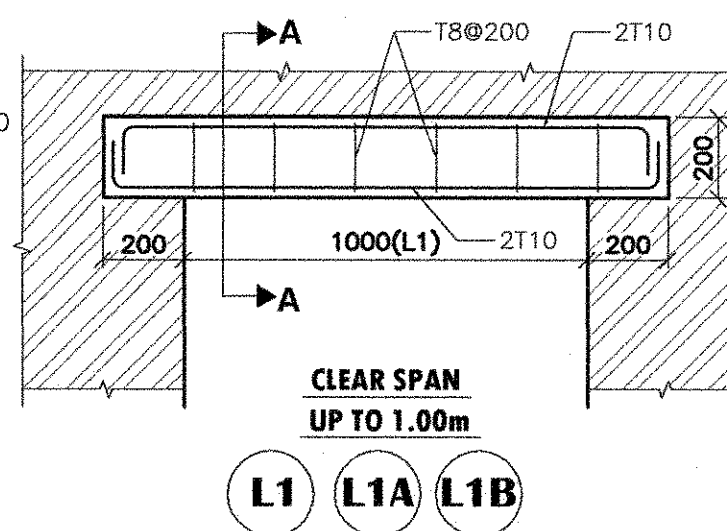

L1 L1A L1B

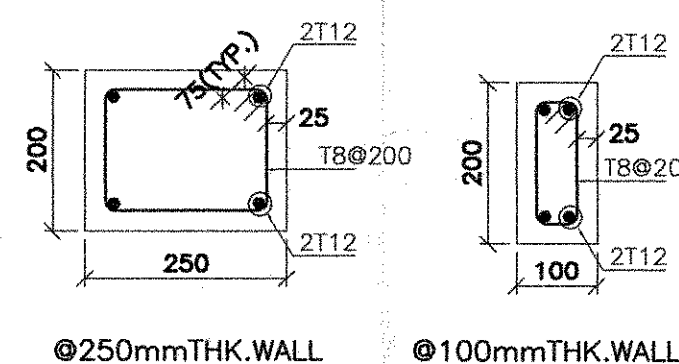

Section B-B

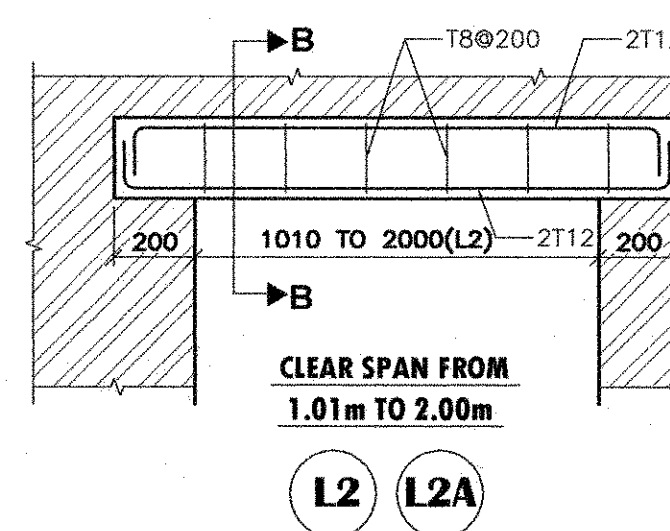


L2 L2A


	dar al-handasah Shair and Partners
CODE 1	APPROVED
CODE 2	APPROVED AS NOTED WORK MAY PROCEED SUBJECT TO INCORPORATION OF ENDORSED COMMENTS
CODE 3	RESUBMIT FOR APPROVAL WORK MAY NOT PROCEED
CODE 4	REJECTED
DATE	28/3/12

NOTES:-


- ALL DIMENSIONS ARE IN MM AND LEVELS ARE METERS UNLESS NOTED OTHERWISE.
- ALL REINFORCEMENT EXCEPT TIES & STIRRUPS UNLESS OTHERWISE INDICATED TO BE HIGH TENSILE STEEL TO BS 4449 HAVING A MINIMUM YIELD STRESS ($f_y = 420$ MPa) (DESIGNATED BY Φ)
- ALL REINFORCED CONCRETE SHOULD HAVE A MINIMUM CRUSHING STRENGTH ON CYLINDER AT 28 DAYS: $f_c = 35$ MPa
- ALL SPLICES OF REINFORCEMENT SHOULD BE MIN. 60 BAR DIAMETER
- UNLESS OTHERWISE NOTED, THE FOLLOWING NOMINAL CONCRETE COVER TO ALL REINFORCING BARS SHALL BE ADOPTED:
 - FOR SLABS AND WALLS NOT EXPOSED TO EARTH OR WEATHER: 30mm.
 - FOR BASEMENT WALLS: 50mm.
 - FOR DROP BEAMS AND COLUMNS: 40mm.
 - FOR FOUNDATIONS: 75mm.
 - FOR ALL SURFACES IN CONTACT WITH WATER OR VAPOUR: 50mm.

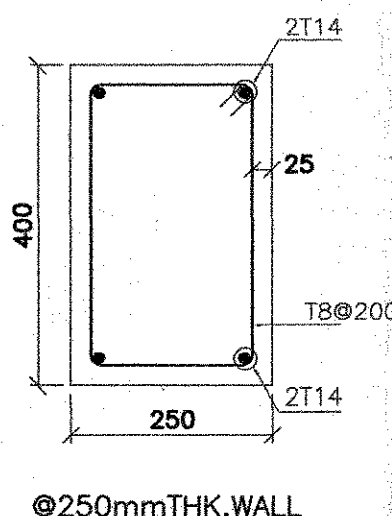


Section C-C

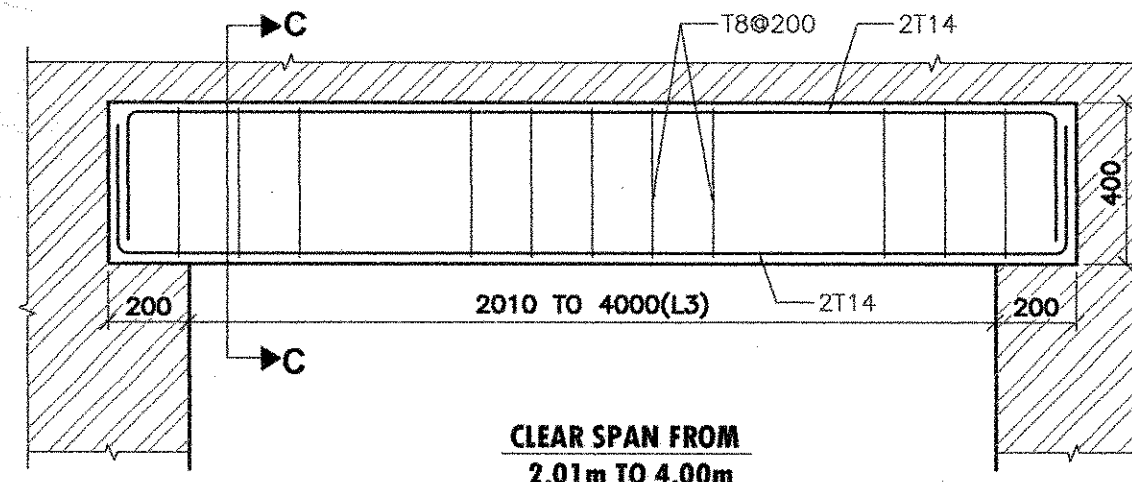

L3

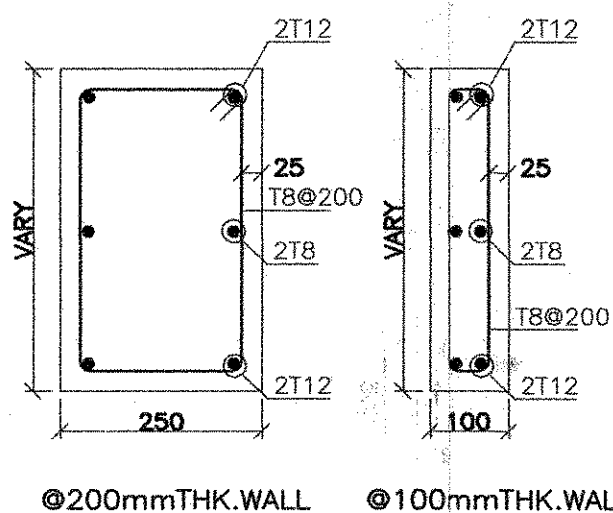


Section D-D

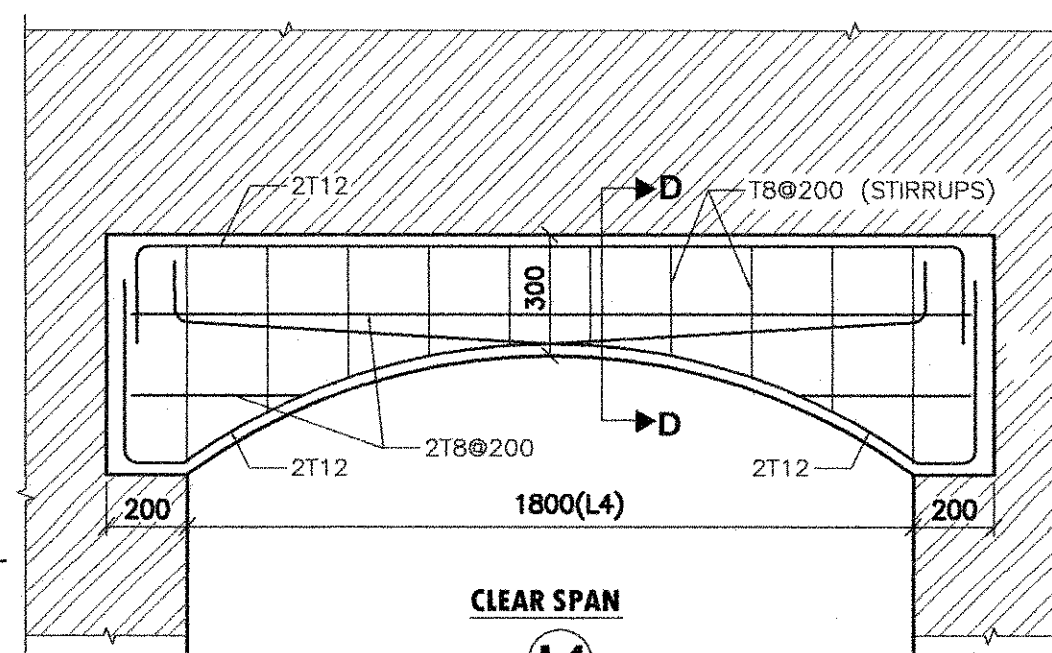

L4

Key plan

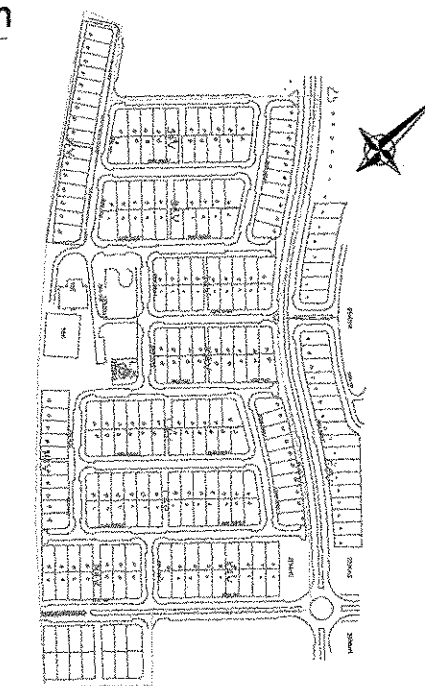

AS BUILT DRAWING

JUMAIRAH PARK



NAKHEEL



dar al-handasah
shair and partners




Pauling Middle East

PACKAGE - 2


Lintel Details
Type : Legacy

(Sheet 2 of 4)


Drawn Thirumurugan	Review Eng. Ziad	Checked Eng. Ghassan Zeitouni
Scale -	Date 10.03.2012	
Drawing No. PME / JP / AB / LIN - 001		

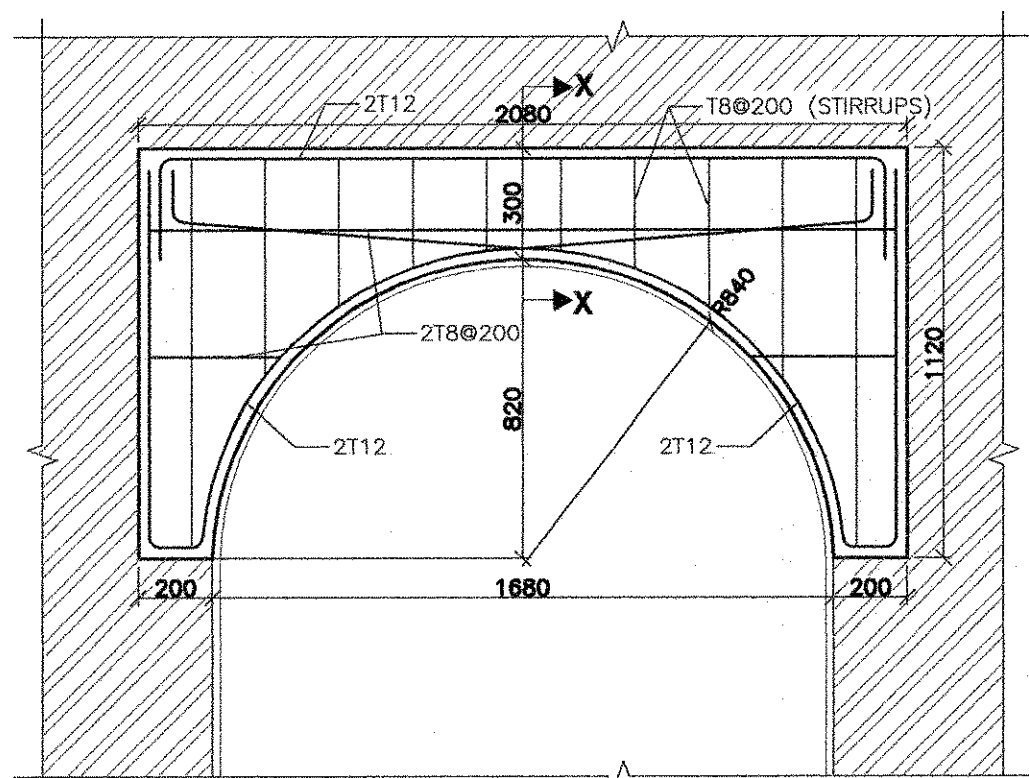


OPENING @ ENTRY L4A

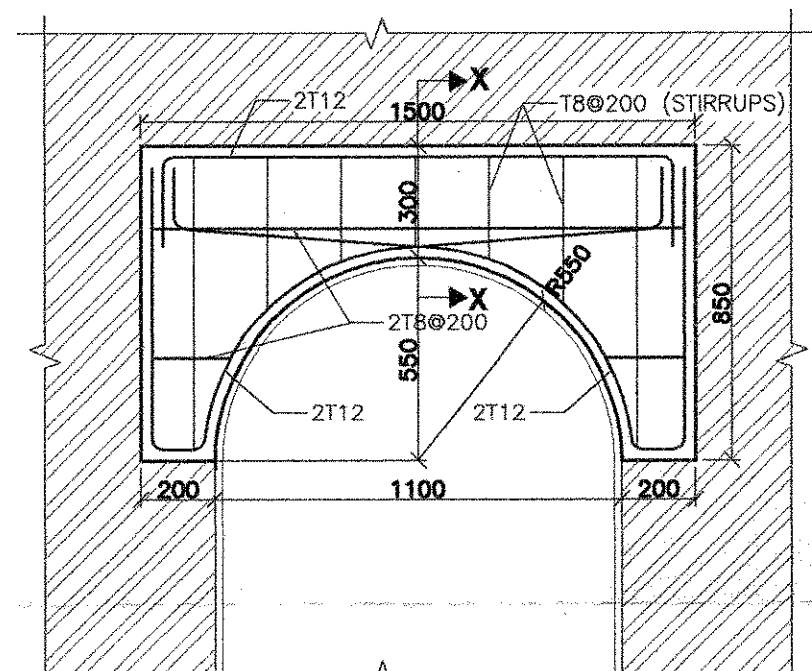


OPENING @ ENTRY L4B

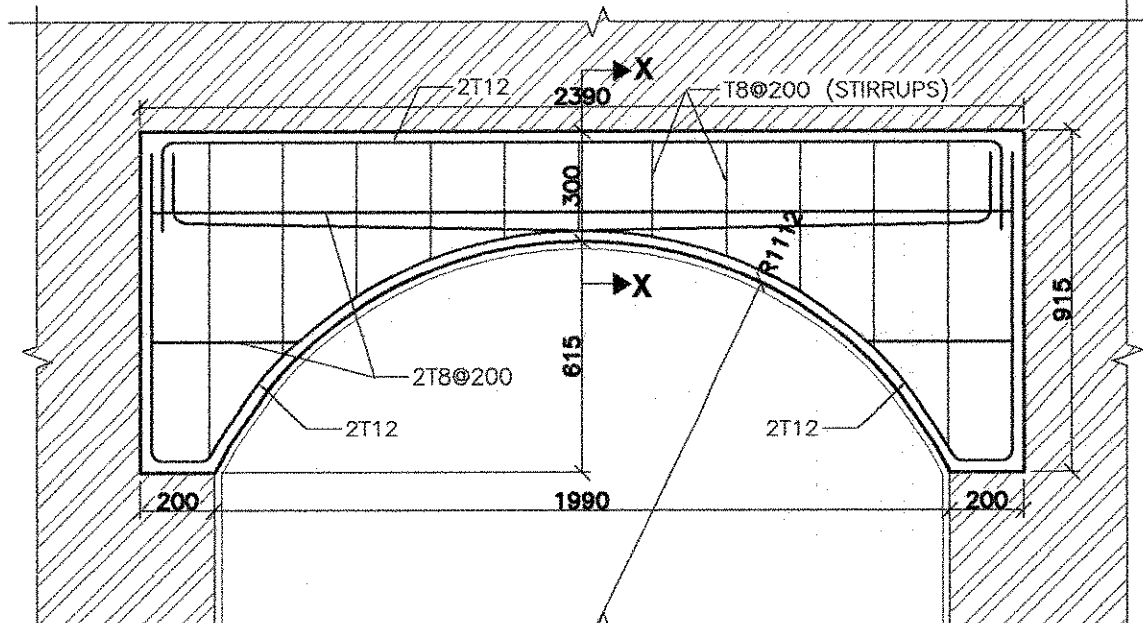


WM 6 L4C

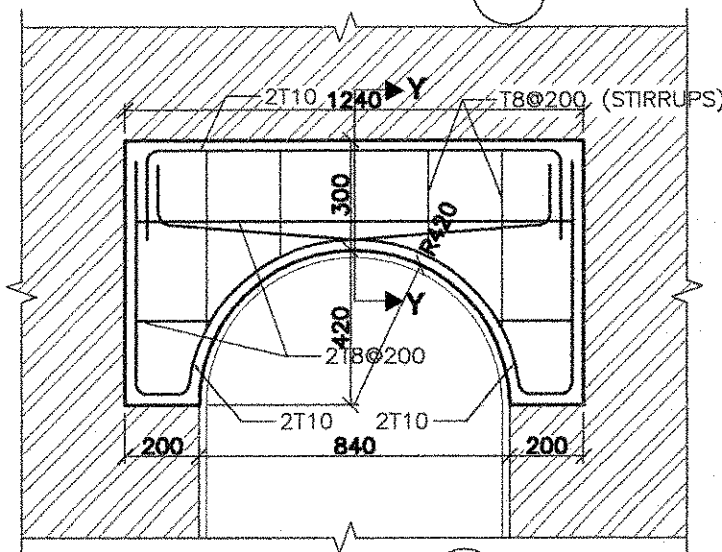


WM 12 L4D

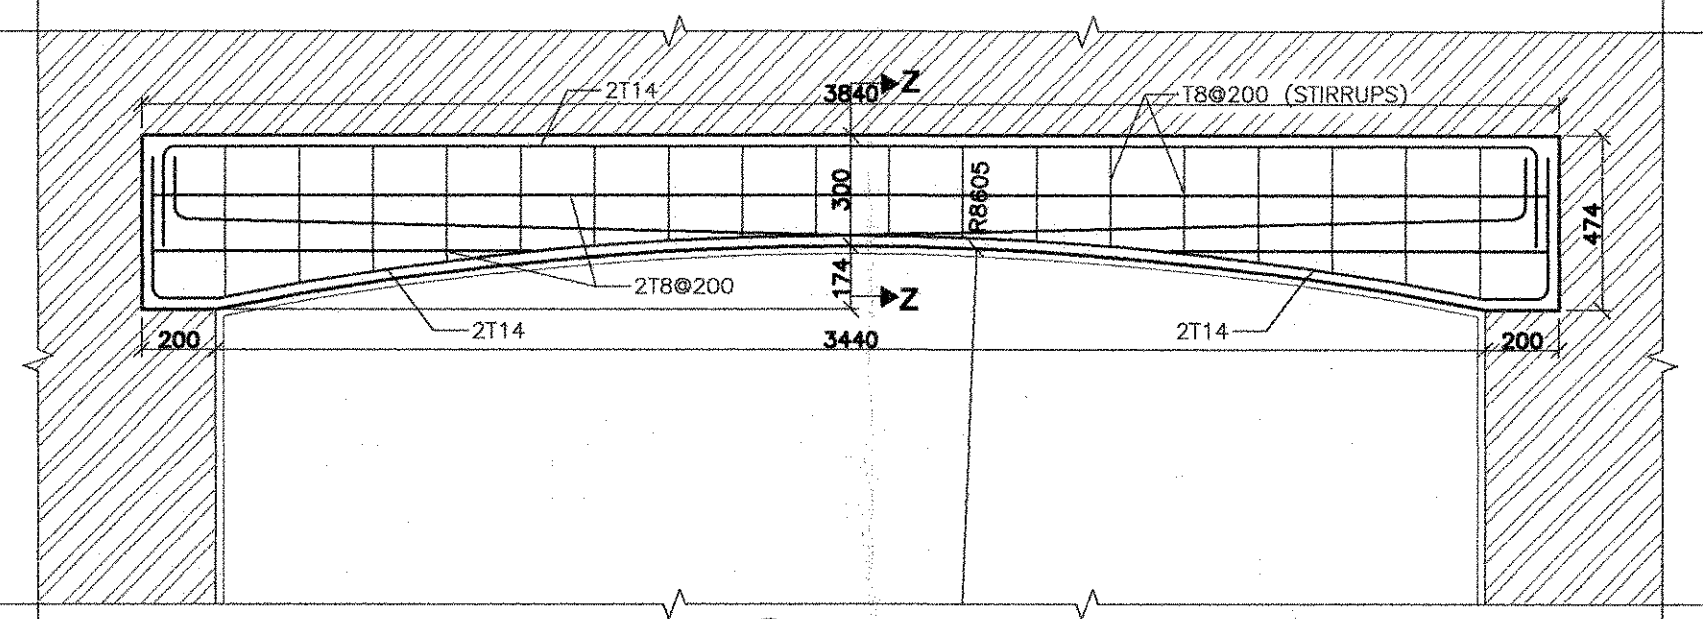


L4E WM 20

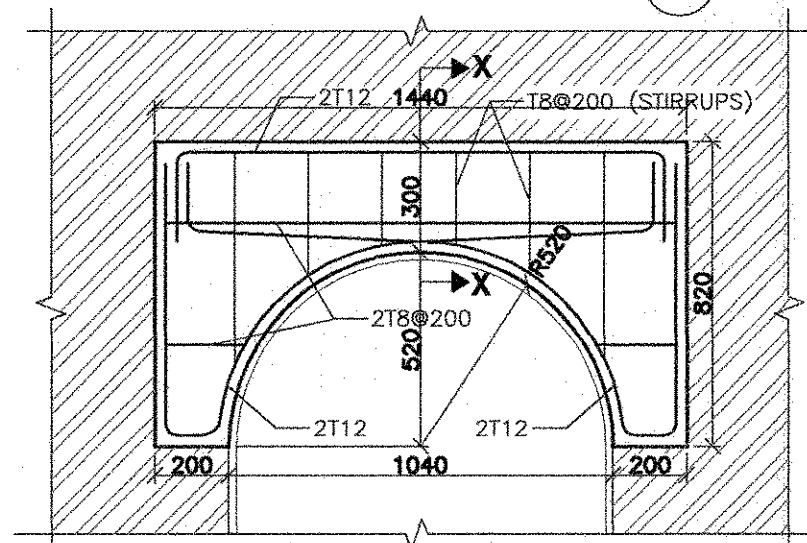


L4F WM 22

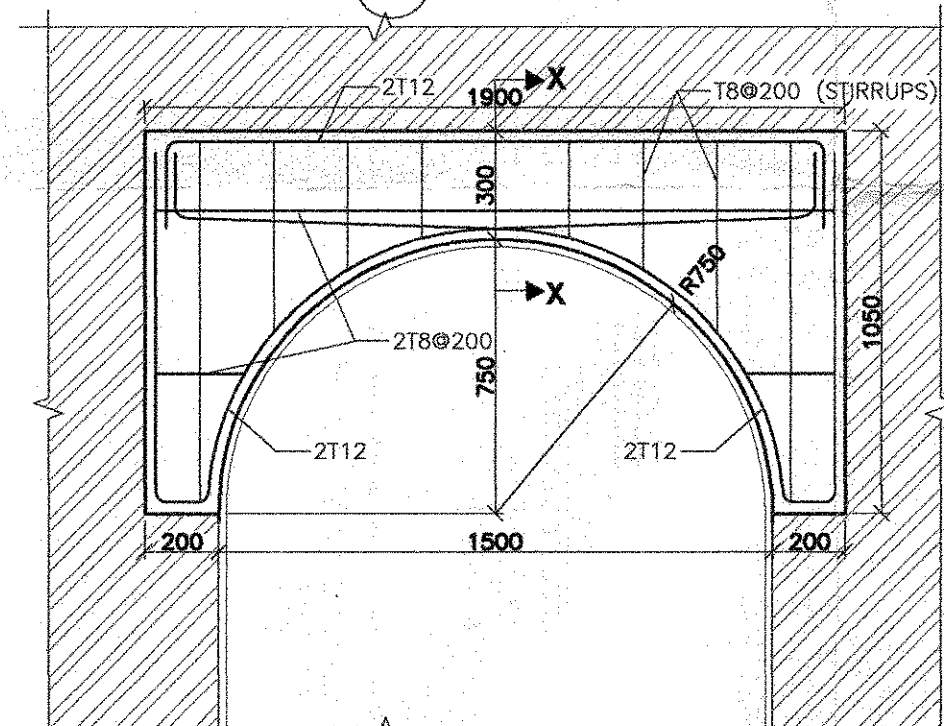


OPENING @ ENTRY L4G

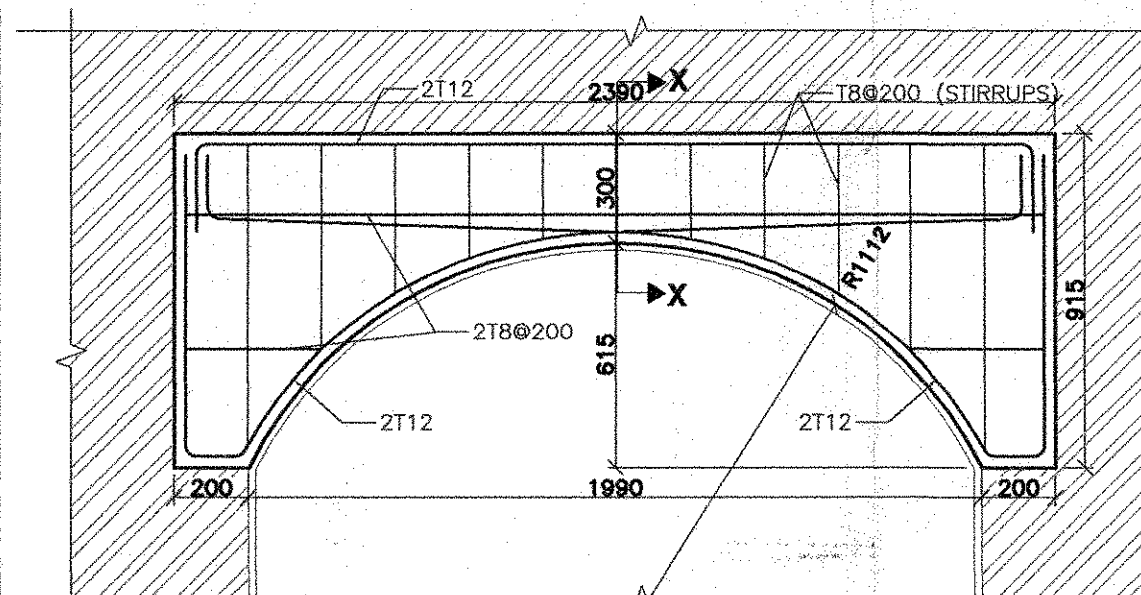


L4H WM 5

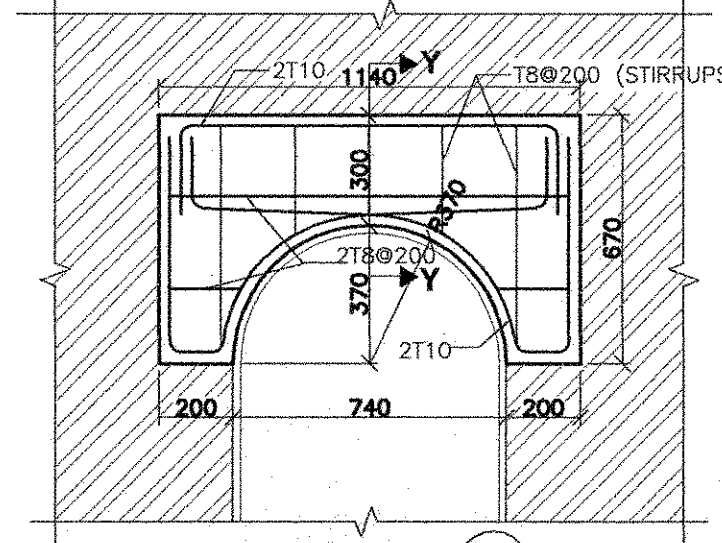

WM 15 L4I

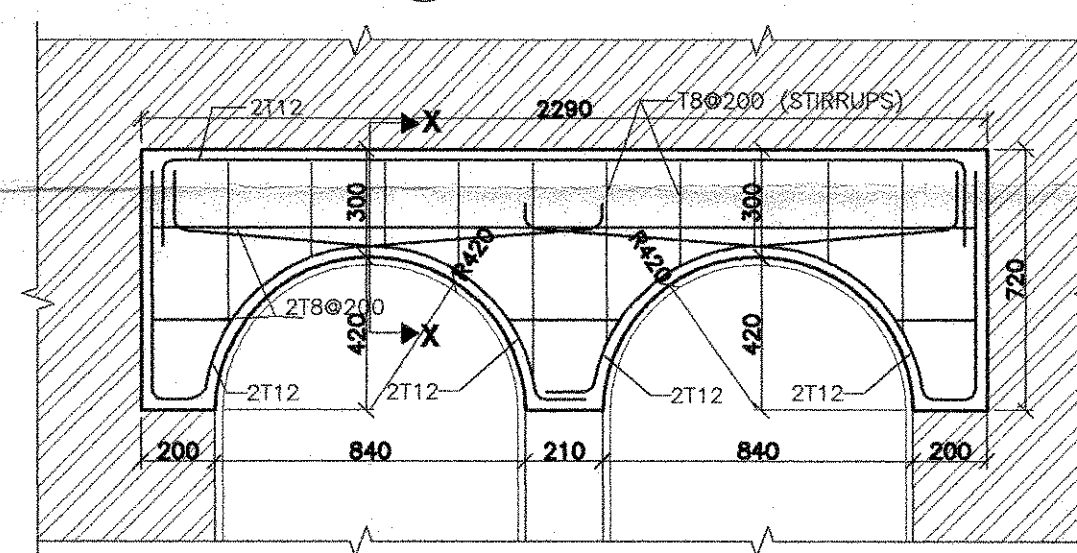

WM 12 & 12' L5

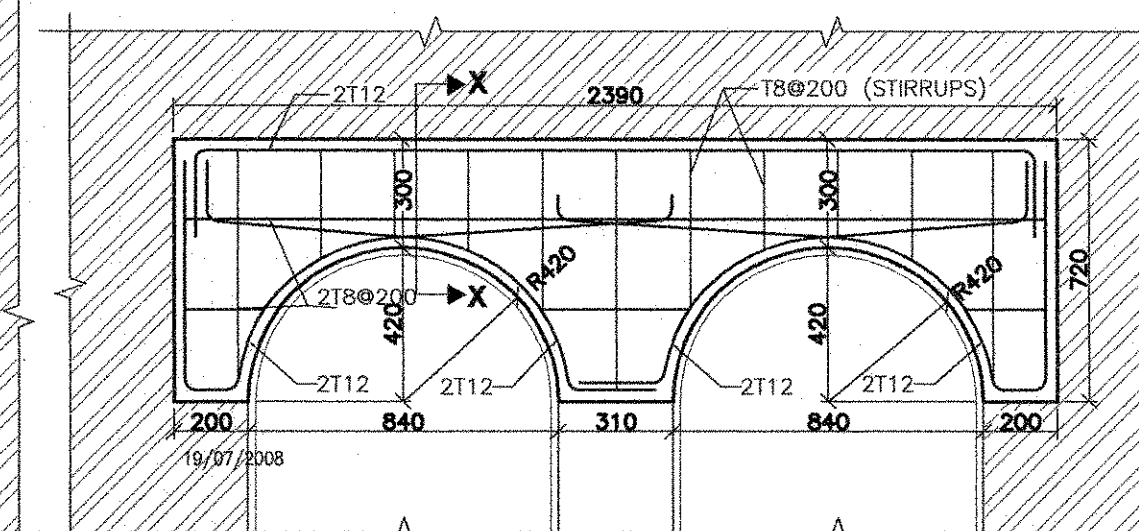


L5A WM 4 & 4'

Typical Section X-X

Typical Section Y-Y

Key plan

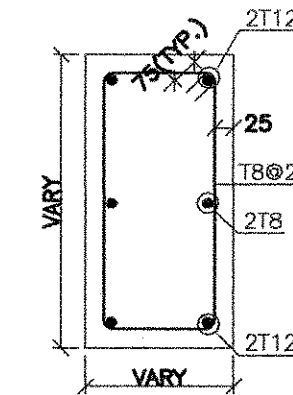

dar al-handasah
Sheik and Partners

☒ CODE 1 APPROVED
☐ CODE 2 APPROVED AS NOTED
☐ CODE 3 RESUBMIT FOR APPROVAL
☐ CODE 4 REJECTED

BY: *[Signature]* DATE: 28/3/12

Approval shall not relieve the contractor of any of his obligations under the Contract or constitute authorization of any change to Contract Documents or variation to the work. Contractor is responsible for dimensions, quantities and coordination with other trades.

NOTES:-

- 1) ALL DIMENSIONS ARE IN MM AND LEVELS ARE METERS UNLESS NOTED OTHERWISE.
- 2) ALL REINFORCEMENT EXCEPT TIES & STIRRUPS UNLESS OTHERWISE INDICATED TO BE HIGH TENSILE STEEL TO BS 4449 HAVING A MINIMUM YIELD STRESS $f_y = 420$ MPa (DESIGNATED BY Φ).
- 3) ALL REINFORCED CONCRETE SHOULD HAVE A MINIMUM CRUSHING STRENGTH ON CYLINDER AT 28 DAYS: $f_c = 35$ MPa.
- 4) ALL SPLICES OF REINFORCEMENT SHOULD BE MIN. 60 BAR DIAMETER.
- 5) UNLESS OTHERWISE NOTED, THE FOLLOWING NOMINAL CONCRETE COVER TO ALL REINFORCING BARS SHALL BE ADOPTED:
 - a - FOR SLABS AND WALLS NOT EXPOSED TO EARTH OR WEATHER : 30mm.
 - b - FOR BASEMENT WALLS : 50mm.
 - c - FOR DROP BEAMS AND COLUMNS : 40mm.
 - d - FOR FOUNDATIONS : 75mm.
 - e - FOR ALL SURFACES IN CONTACT WITH WATER OR VAPOUR : 50mm.





AS BUILT DRAWING

Project	JUMAIRAH PARK
Employer	NAKHEEL
Consultant	dar al-handasah sheik and partners
Main Contractor	Pauling Middle East
Package	

PACKAGE - 2

Drawing Title	Lintel Details
Type	Legacy (Sheet 3 of 4)
Drawn	Thirumurugan
Reviewed	Eng. Ziad
Checked	Eng. Ghassan Zeitouni
Scale	10.03.2012
Drawing No.	PME / JP / AB / LIN - 001

AB 086

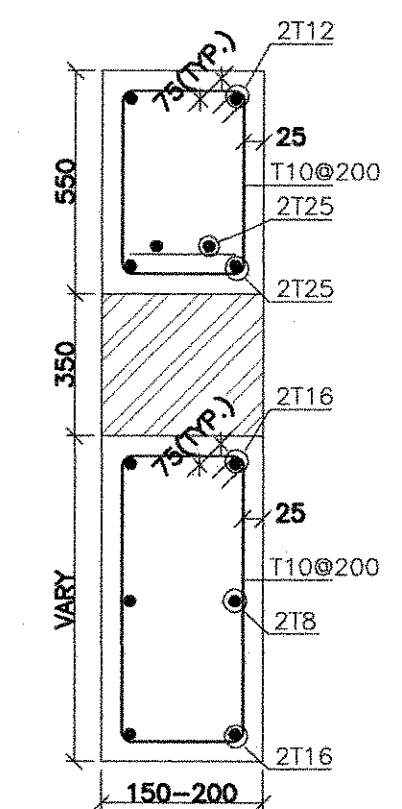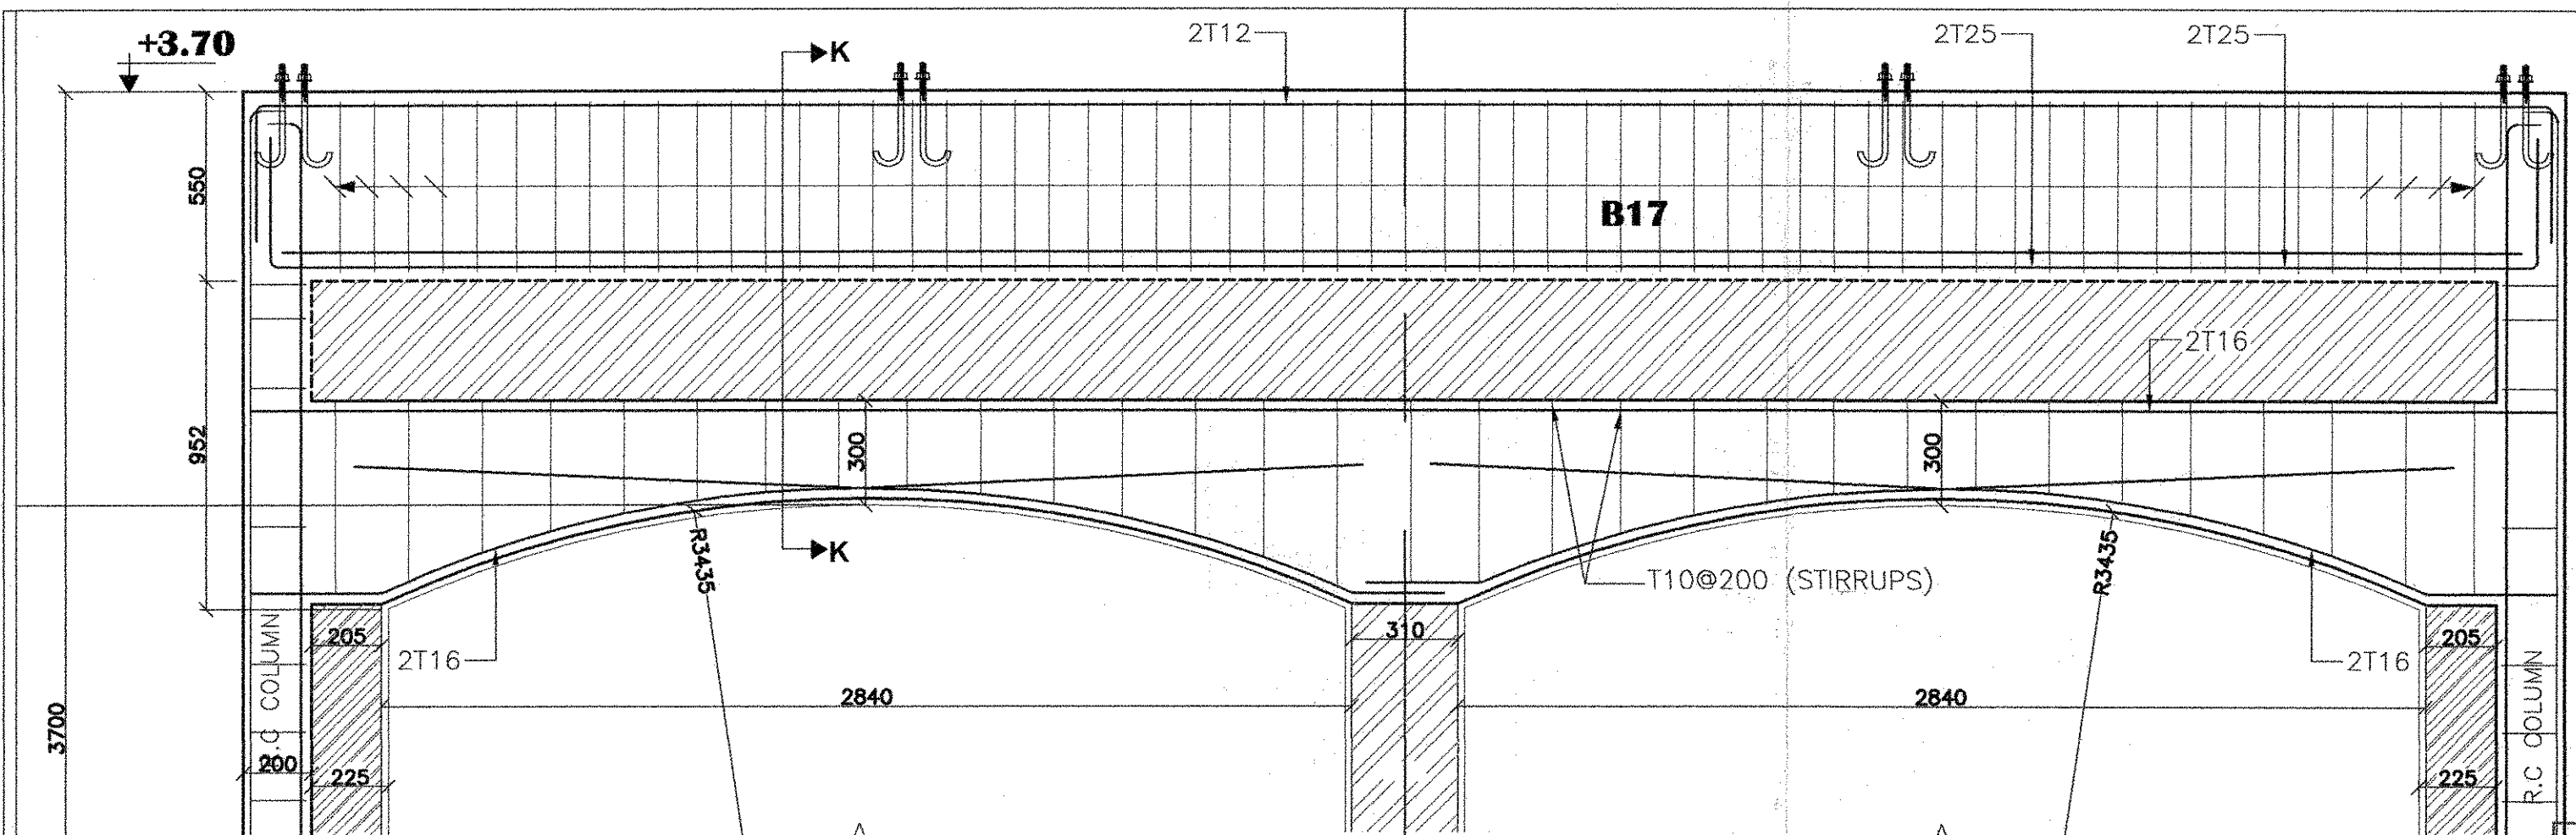

Typical Section K-K


dar al-handasah
Sheir and Partners

☒ CODE 1 APPROVED
☐ CODE 2 APPROVED AS NOTED
 WORK MAY PROCEED SUBJECT TO
 INCORPORATION OF ENDORSED
 COMMENTS
☐ CODE 3 RESUBMIT FOR APPROVAL
 WORK MAY NOT PROCEED
☐ CODE 4 REJECTED

BY: DATE: 28/3/12


I hereby shall not relieve the contractor of any of his
 obligations under the Contract or constitute authorization of
 any change to Contract Documents or variation to the works.
 Contractor is responsible for dimensions, quantities and
 materials.

Key plan

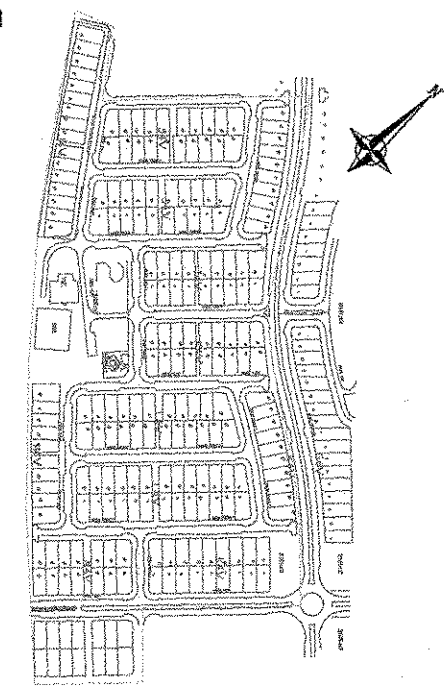


NOTES:-


- 1) ALL DIMENSIONS ARE IN MM AND LEVELS ARE METERS
UNLESS NOTED OTHERWISE.
- 2) ALL REINFORCEMENT EXCEPT TIES & STIRRUPS UNLESS OTHERWISE
INDICATED TO BE HIGH TENSILE STEEL TO BS 4449 HAVING A
MINIMUM YIELD STRESS $f_y = 420 \text{ MPa}$ (DESIGNATED BY Φ)
- 3) ALL REINFORCED CONCRETE SHOULD HAVE A MINIMUM
CRUSHING STRENGTH ON CYLINDER AT 28 DAYS: $f_c = 35 \text{ MPa}$
- 4) ALL SPLICES OF REINFORCEMENT SHOULD BE MIN. 60 BAR DIAMETER
- 5) UNLESS OTHERWISE NOTED, THE FOLLOWING NOMINAL
CONCRETE COVER TO ALL REINFORCING BARS
SHALL BE ADOPTED:
 - a - FOR SLABS AND WALLS NOT EXPOSED TO EARTH OR WEATHER : 30mm.
 - b - FOR BASEMENT WALLS : 50mm.
 - c - FOR DROP BEAMS AND COLUMNS : 40mm.
 - d - FOR FOUNDATIONS : 75mm.
 - e - FOR ALL SURFACES IN CONTACT WITH WATER OR VAPOUR : 50mm.

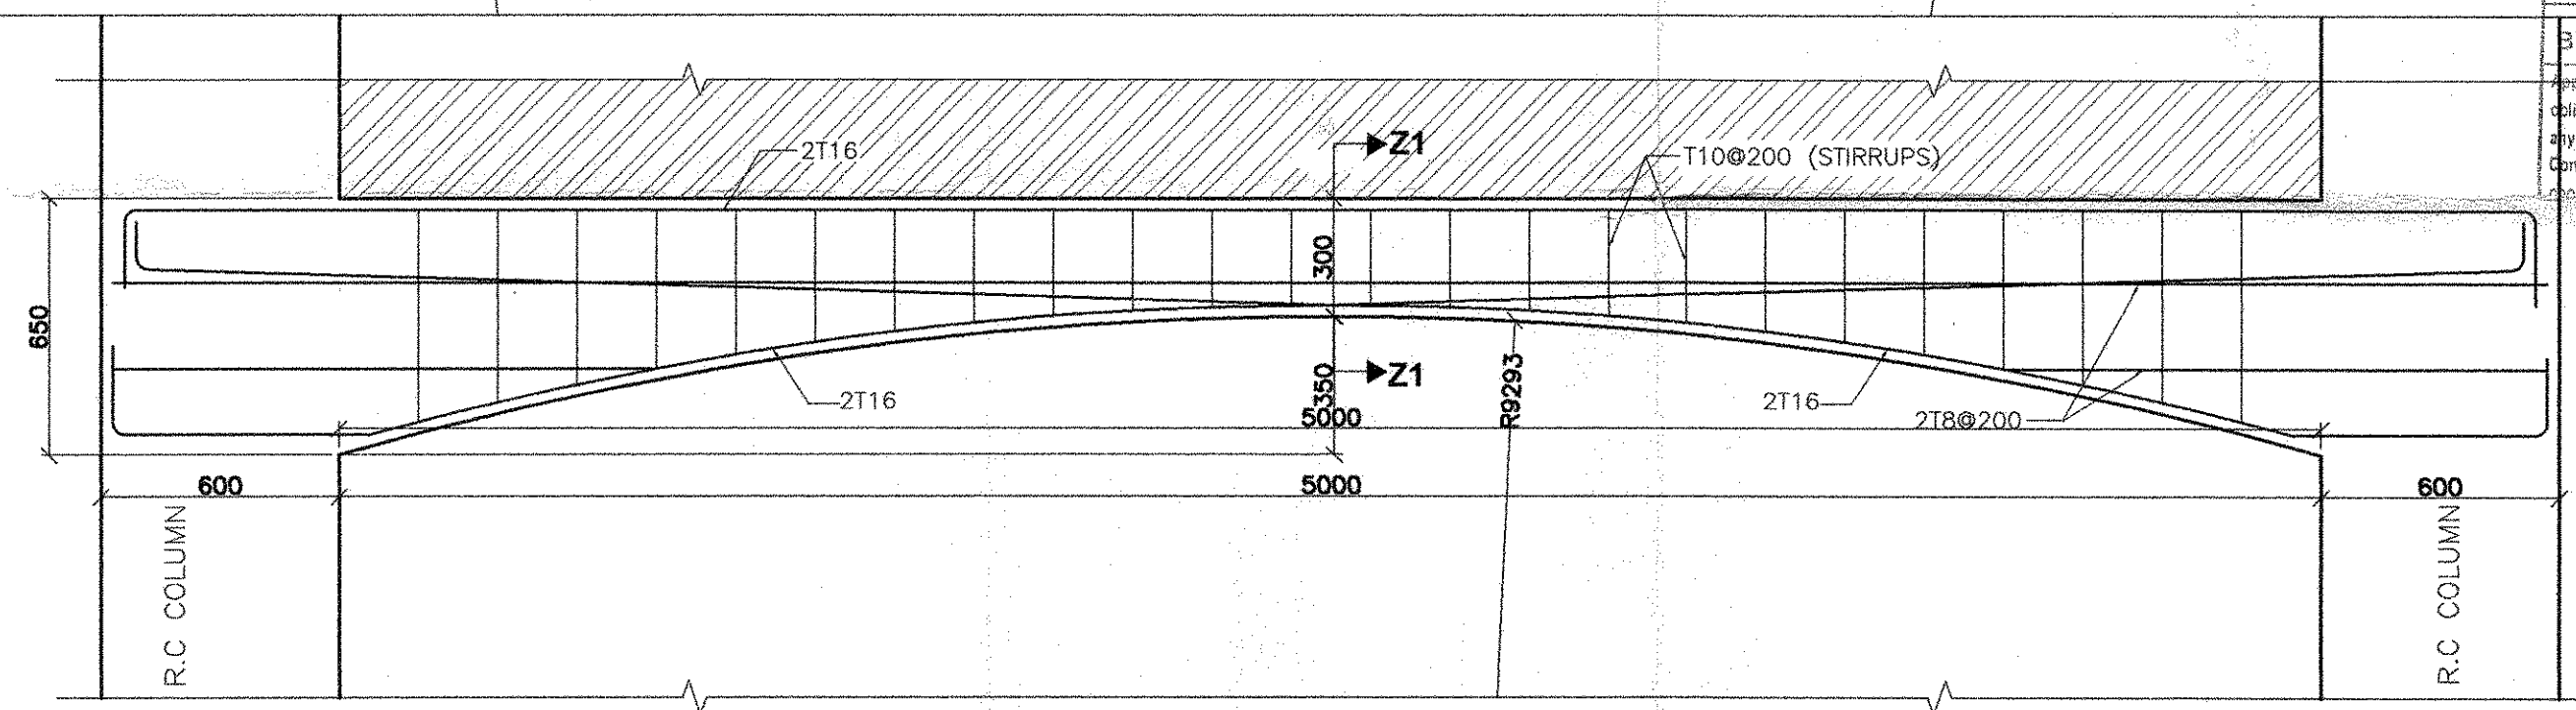

L6A OPENING @ BACK SIDE

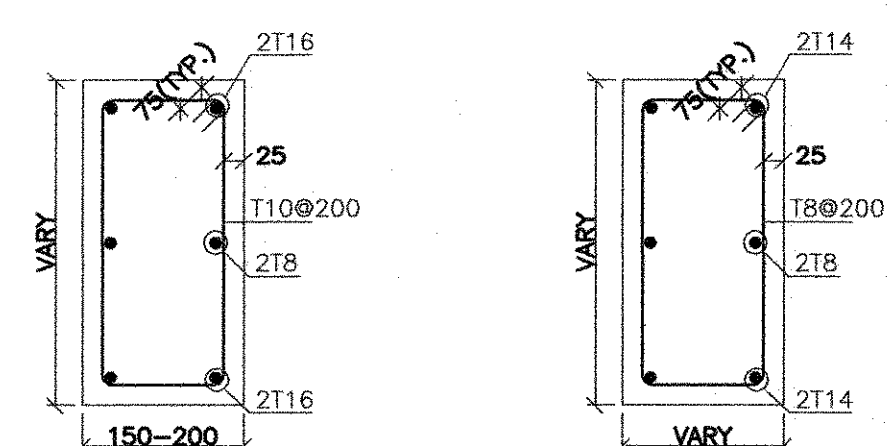

Typical Section Z1-Z1 Typical Section Z-Z

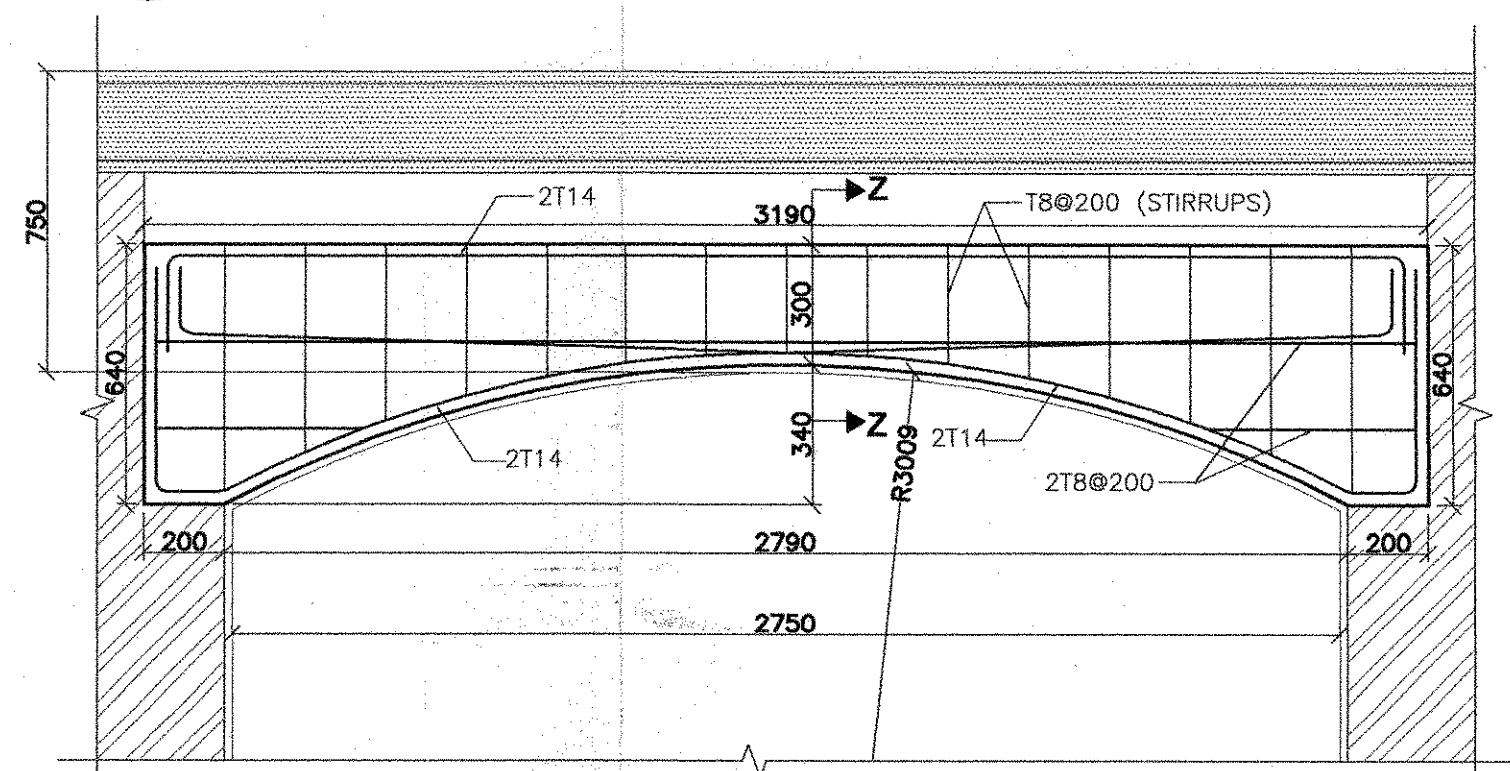

L6B OPENING @ SIDE VIEW

AS BUILT DRAWING

Project
JUMAIRAH PARK

Employer
NAKHEEL

Consultant
dar al-handasah
sheir and partners

Main Contractor
Pauling Middle East

Package
PACKAGE - 2

Drawing Title
Lintel Details
Type : Legacy (Sheet 4 of 4)

Drawn: Thirumurugan
Review: Eng. Ziad
Scale: 10.03.2012
Checked: Eng. Ghassan Zeitouni

Drawing No.
PME / JP / AB / LIN - 001

