



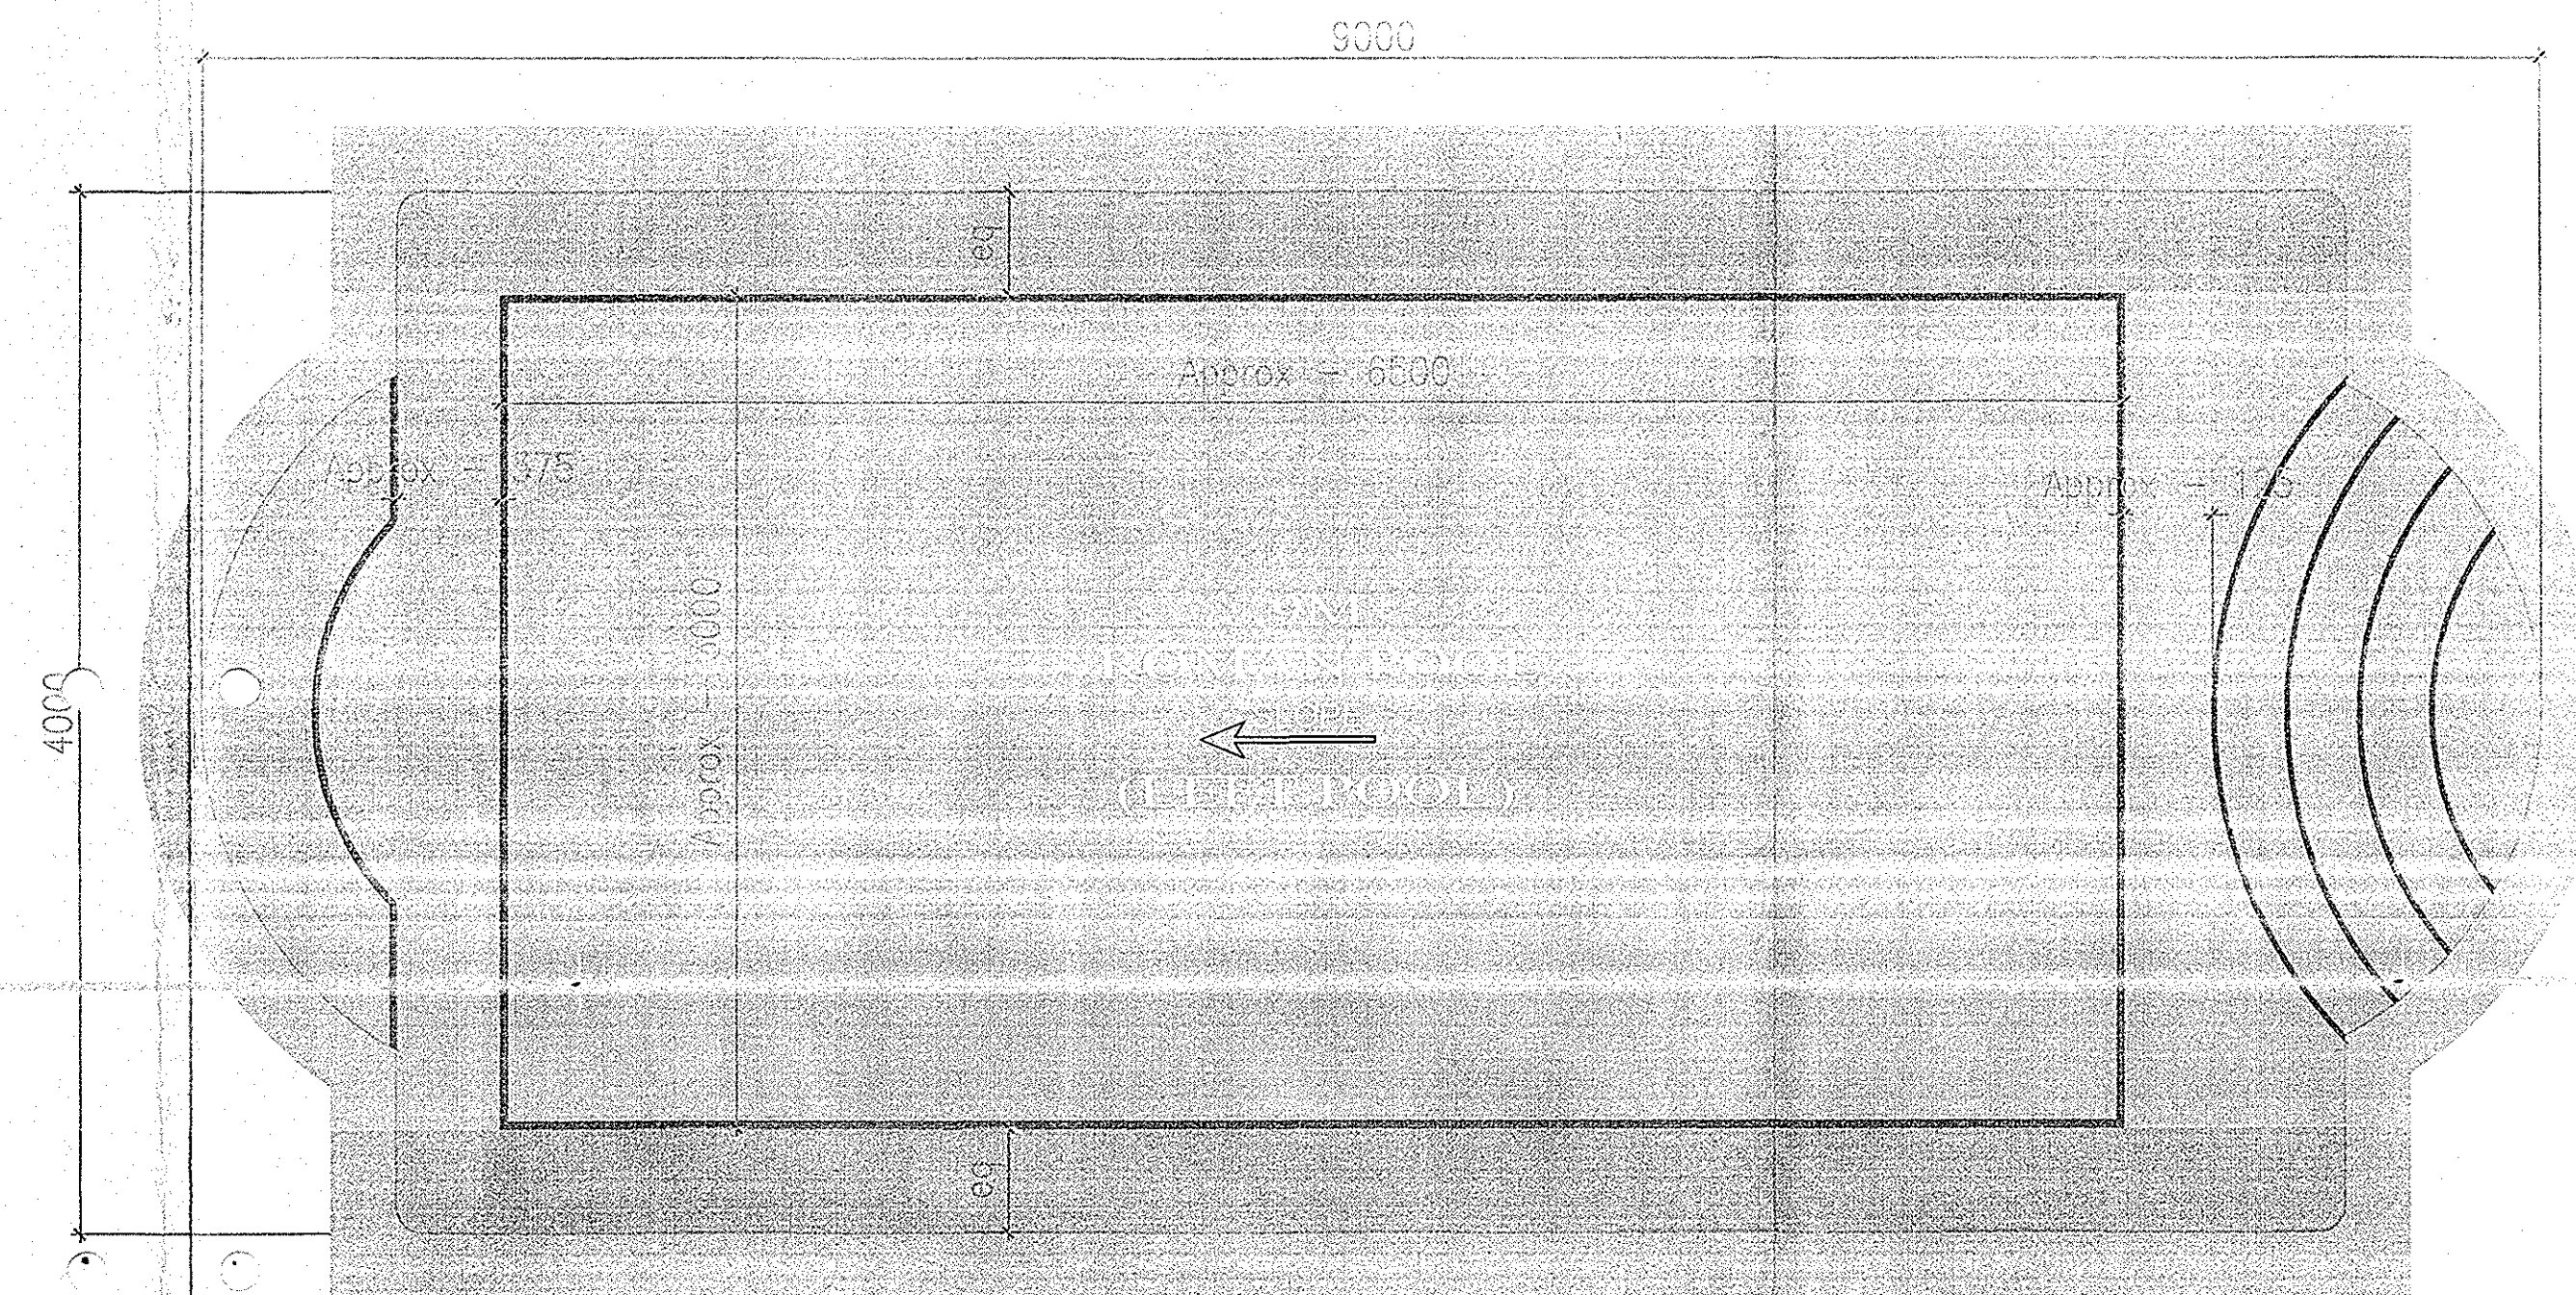

ROMAN POOL

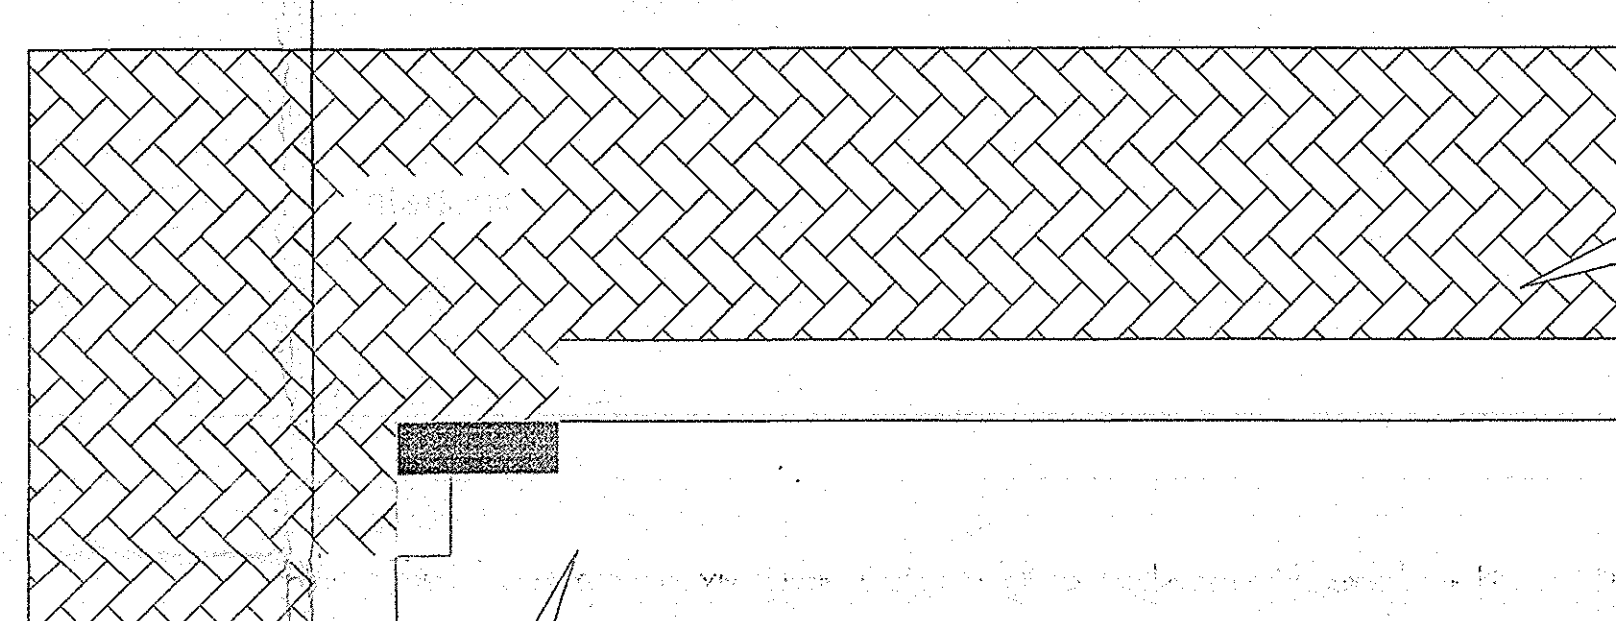

Package-2 (Left Side pool)

Swimming pool location cluster - 2 (P2)			
Sl.No.	Block ID	Cluster	Villa No.
1	J4V	C02	26
2	J4V	C02	27
3	J4V	C02	28
4	J4V	C02	29
5	J4V	C02	30
6	J4V	C02	36
7	J4V	C02	37
8	J4V	C02	38
9	J4V	C02	39
10	J4V	C02	40
Swimming pool location cluster - 3 (P2)			
1	J4V	C03	6
2	J4V	C03	7
3	J4V	C03	8
4	J4V	C03	9
5	J4V	C03	10
6	J4V	C03	16
7	J4V	C03	17
8	J4V	C03	18
9	J4V	C03	19
10	J4V	C03	20
Swimming pool location cluster - 5 (P2)			
1	I4V	C05	5
2	I4V	C05	6
3	I4V	C05	7
4	I4V	C05	8
5	I4V	C05	9
6	I4V	C05	15
7	I4V	C05	16
8	I4V	C05	17
9	I4V	C05	18

Swimming pool location cluster - 6 (P2)			
1	K4V	C06	29
2	K4V	C06	30
3	K4V	C06	31
4	K4V	C06	32
5	K4V	C06	33
6	K4V	C06	38
7	K4V	C06	39
8	K4V	C06	40
9	K4V	C06	41
Swimming pool location cluster - 7 (P2)			
1	K4V	C07	19
2	K4V	C07	20
3	K4V	C07	21
4	K4V	C07	22
5	K4V	C07	23
6	K4V	C07	24
7	K4V	C07	25
8	K4V	C07	26
9	K4V	C07	27
10	K4V	C07	28
Swimming pool location cluster - 8 (P2)			
1	L4V	C08	33
2	L4V	C08	34
3	L4V	C08	35
4	L4V	C08	36
5	L4V	C08	37
6	L4V	C08	38
7	L4V	C08	44
8	L4V	C08	45
9	L4V	C08	46
10	L4V	C08	47
11	L4V	C08	48
12	L4V	C08	49

Swimming pool location cluster - 9 (P2)			
1	M4V	C09	34
2	M4V	C09	35
3	M4V	C09	36
4	M4V	C09	37
5	M4V	C09	38
Swimming pool location cluster - 10 (P2)			
1	L4V	C10	7
2	L4V	C10	8
	L4V	C10	9
4	L4V	C10	10
5	L4V	C10	11
6	L4V	C10	12
7	L4V	C10	13
8	L4V	C10	21
9	L4V	C10	22
10	L4V	C10	23
11	L4V	C10	24
12	L4V	C10	25
13	L4V	C10	26

Swimming pool location cluster - 11 (P2)			
1	K4V	C11	10
2	K4V	C11	11
3	K4V	C11	12
4	K4V	C11	13
5	K4V	C11	14
6	K4V	C11	15
7	K4V	C11	16
8	K4V	C11	17
9	K4V	C11	18
Swimming pool location cluster - 12 (P2)			
1	M4V	C12	19
2	M4V	C12	20
3	M4V	C12	21
4	M4V	C12	25
5	M4V	C12	26
6	M4V	C12	27
7	M4V	C12	28
Swimming pool location cluster - 13 (P2)			
1	M4V	C13	5
2	M4V	C13	6
3	M4V	C13	7
4	M4V	C13	11
5	M4V	C13	12
6	M4V	C13	13
7	M4V	C13	14

Swimming pool location cluster - 1 (P2A)			
Sl.No.	Block ID	Cluster	Villa No.
1	F4V	C01	7
2	F4V	C01	8
3	F4V	C01	9
4	F4V	C01	10
5	F4V	C01	11
6	F4V	C01	12
7	F4V	C01	13
8	F4V	C01	14
9	F4V	C01	23
10	F4V	C01	24
11	F4V	C01	25
12	F4V	C01	26
13	F4V	C01	27
14	F4V	C01	28
Swimming pool location cluster - 2 (P2A)			
1	A4V	C02	1
2	A4V	C02	2
3	A4V	C02	6
4	A4V	C02	7
5	A4V	C02	8
6	A4V	C02	9
7	A4V	C02	10
8	A4V	C02	11
Swimming pool location cluster - 3 (P2A)			
1	E4V	C03	51
2	E4V	C03	52
3	E4V	C03	53
4	E4V	C03	54
5	E4V	C03	55
6	E4V	C03	56
7	E4V	C03	57
8	E4V	C03	58
9	E4V	C03	59
10	E4V	C03	60
11	E4V	C03	61
12	E4V	C03	62
Swimming pool location cluster - 4 (P2A)			
1	E4V	C04	27
2	E4V	C04	28
3	E4V	C04	29
4	E4V	C04	30
5	E4V	C04	31
6	E4V	C04	32
7	E4V	C04	33
8	E4V	C04	34
9	E4V	C04	35
10	E4V	C04	36
11	E4V	C04	37

Package-2A (Left Side pool)

Swimming pool location cluster - 6 (P2A)			
1	E4V	C06	1
2	E4V	C06	2
3	E4V	C06	3
4	E4V	C06	4
5	E4V	C06	5
6	E4V	C06	9
7	E4V	C06	10
8	E4V	C06	11
9	E4V	C06	12
Swimming pool location cluster - 7 (P2A)			
1	D4V	C07	42
2	D4V	C07	43
3	D4V	C07	44
4	D4V	C07	45
5	D4V	C07	46
6	D4V	C07	47
7	D4V	C07	48
8	D4V	C07	49
9	D4V	C07	50
Swimming pool location cluster - 8 (P2A)			
1	D4V	C08	26
2	D4V	C08	27
3	D4V	C08	28
4	D4V	C08	29
5	D4V	C08	30
6	D4V	C08	31
7	D4V	C08	32
Swimming pool location cluster - 9 (P2A)			
1	A4V	C09	12
2	A4V	C09	13
3	A4V	C09	14
4	A4V	C09	15
5	A4V	C09	16
6	A4V	C09	17
7	A4V	C09	18
8	A4V	C09	19
9	A4V	C09	20
10	A4V	C09	21
11	A4V	C09	22
12	A4V	C09	23
13	A4V	C09	24
14	A4V	C09	25
15	A4V	C09	26
16	A4V	C09	27
17	A4V	C09	28
18	A4V	C09	29

Swimming pool location cluster - 10 (P2A)			
1	A4V	C10	30
2	A4V	C10	31
3	A4V	C10	32
4	A4V	C10	33
5	A4V	C10	34
6	A4V	C10	35
7	A4V	C10	36
8	A4V	C10	37
9	A4V	C10	38

Swimming pool location cluster - 11 (P2A)			
1	D4V	C11	10
2	D4V	C11	11
3	D4V	C11	12
4	D4V	C11	13
5	D4V	C11	14
6	D4V	C11	15
7	D4V	C11	16
8	D4V	C11	17
9	D4V	C11	18

Swimming pool location cluster - 12 (P2A)			
1	C4V	C12	51
2	C4V	C12	52
3	C4V	C12	53
4	C4V	C12	54
5	C4V	C12	59
6	C4V	C12	60
7	C4V	C12	61
8	C4V	C12	62

Swimming pool location cluster - 13 (P2A)			
1	C4V	C13	1
2	C4V	C13	2
3	C4V	C13	3
4	C4V	C13	4
5	C4V	C13	5
6	C4V	C13	6
7	C4V	C13	7
8	C4V	C13	8
9	C4V	C13	9
10	C4V	C13	10
11	C4V	C13	11
12	C4V	C13	12
13	C4V	C13	13

Swimming pool location cluster - 14 (P2A)			
1	C4V	C14	26
2	C4V	C14	27
3	C4V	C14	28
4	C4V	C14	29
5	C4V	C14	30
6	C4V	C14	31
7	C4V	C14	32
8	C4V	C14	33
9	C4V	C14	34
10	C4V	C14	35
Swimming pool location cluster - 15 (P2A)			
1	B4V	C15	8
2	B4V	C15	9
3	B4V	C15	10
4	B4V	C15	11
5	B4V	C15	12
6	B4V	C15	13
7	B4V	C15	14
8	B4V	C15	22
9	B4V	C15	23
10	B4V	C15	24
11	B4V	C15	25
12	B4V	C15	26
13	B4V	C15	27
14	B4V	C15	28
Swimming pool location cluster - 16 (P2A)			
1	G4V	C16	1
2	G4V	C16	2
3	G4V	C16	3
4	G4V	C16	4
5	G4V	C16	5
6	G4V	C16	6
7	G4V	C16	7
8	G4V	C16	8
9	G4V	C16	9
10	G4V	C16	10
11	G4V	C16	11
12	G4V	C16	12
13	G4V	C16	13
14	G4V	C16	14
15	G4V	C16	15
16	G4V	C16	16
17	G4V	C16	17


dar al-handasah
Share and Partners

☐ CODE 1 APPROVED
☐ CODE 2 APPROVED AS NOTED
WORK MAY PROCEED SUBJECT TO
INCORPORATION OF ENGINEER'S
COMMENTS
☐ CODE 3 REQUEST FOR APPROVAL
WORK MAY NOT PROCEED
☐ CODE 4 REJECTED

DATE: _____

Signature: _____

Package-2A

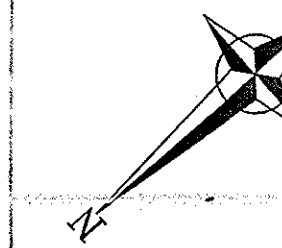

KEY PLAN

NOTES:-

- 1) ALL DIMENSIONS ARE IN MM.
- 2) FOR SETTING OUT PLAN OF SW. POOL PLANT ROOM
PL.REF. DWG. NO. AP/PME/J/PM/26A-26J FOR PACKAGE-2A, CLUSTER-2, VILLA # A4V - 03
Ref. Drg.No. AP/PME/J/AB/RM/SK-07
- 3) FOR SETTING OUT PLAN OF POOL SIZE:- 9x4x1.1m-1.5
@ PACKAGE - 2A, CLUSTER-2, VILLA # A4V - 03
Ref. Drg.No. AP/PME/J/AB/RM/SK-07
- 4) FOR SETTING OUT PLAN OF POOL SIZE:- 8x4x1.1m-1.5
@ PACKAGE - 2A, CLUSTER-2, VILLA # A4V - 04&05
Ref. Drg.No. AP/PME/J/AB/RM/SK-03 & 05
- 5) FOR SETTING OUT PLAN OF POOL SIZE:- 6.25x4x1.1m-1.5
@ PACKAGE - 2A, CLUSTER-10, VILLA # 40 - 44
Ref. Drg.No. AP/PME/J/AB/RM/SK-10

AS2	25.06.12	ISSUED FOR APPROVAL	GS
AB1	22.02.12	ISSUED FOR APPROVAL	GS
AB	12.01.12	ISSUED FOR APPROVAL	GS
Rev.	Date	Description	Draw

AS BUILT DRAWING

RECEIVED
DAR AL HANDASAH
07 JUL 2012
PKG 2 & 2A
JUMAIRAH PARK

NAKHEEL
NAKHEEL

dar al-handasah
Share and Partners

Pauling Middle East

PACKAGE - 2 & 2A

absolute pools
"The pool for the home owner"

P.O. BOX 45890, DUBAI, U.A.E.
TEL: +971 4 3393155
FAX: +971 4 3393573
e-mail: info@absolute-pools.com

ROMAN POOL - LEFT SIDE

Size:- 9m x 4m x 1.1m - 1.5m Deep

Scale: 1:60
Date: 10-01-2012
Drawing No.

Drg. No.: AP/PME/J/AB/RM/01A