



LEGEND	POOL FITTINGS	QTY
	WALL INLET (WHITE ABS) (Certikin)	2
	SKIMMER (WHITE ABS) (Certikin)	1
	WALL DRAIN (WHITE ABS) (Water Ways)	2
	300w/12v UNDER WATER LIGHT (WHITE ABS) (Certikin)	1
	BALL VALVE (Ceepex)	
	ELBOW 90° (Ceepex)	
	UNION (Ceepex)	
	LADDER (S.S 316) (CM3S)-Certikin	1
	Deck.Box (White ABS)	1

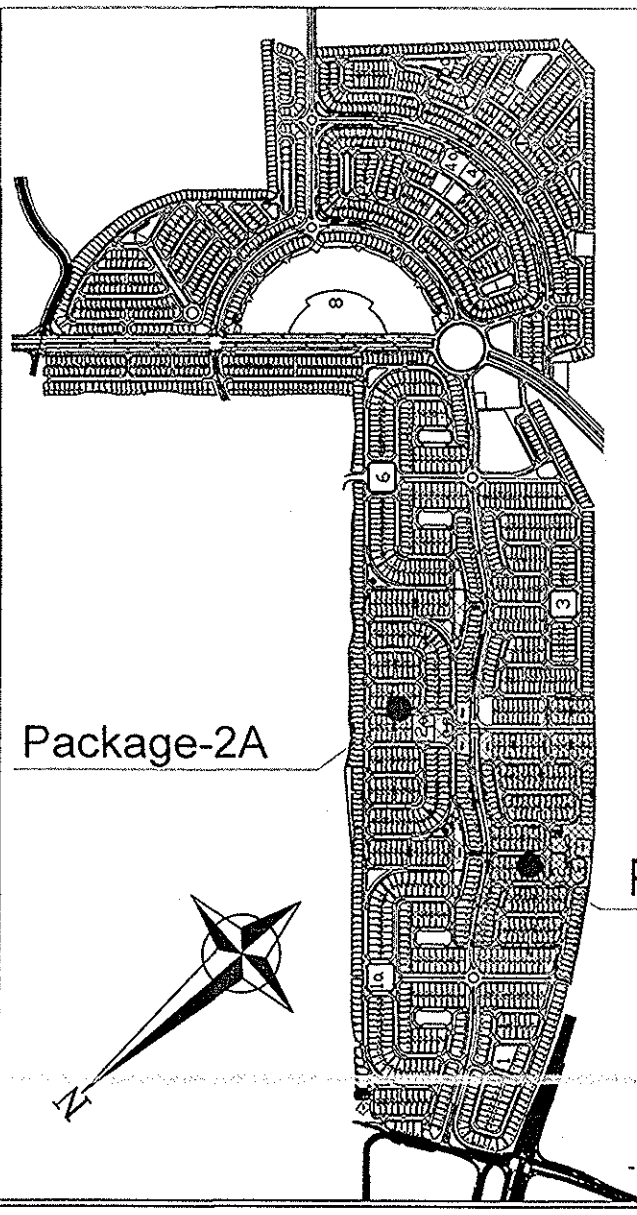

NOTES:-

- 1) ALL DIMENSIONS ARE IN MM .
- 2) FOR SETTING OUT PLAN OF SW. POOL ,PLANT ROOM PL.REF. DWG. NO. AP/PME/JP/RM/26J FOR PACKAGE-2A, CLUSTER-2,VILLA # A4V - 03 Ref. Drg.No. AP/PME/JP/AB/RM/SK-07
- 3) FOR SETTING OUT PLAN OF POOL SIZE:- 9x4x1.1m-1.5 @ PACKAGE - 2A, CLUSTER-2,VILLA # A4V - 03 Ref. Drg.No. AP/PME/JP/AB/RM/SK-07
- 4) FOR SETTING OUT PLAN OF POOL SIZE:- 8x4x1.1m-1.5 @ PACKAGE - 2A, CLUSTER-2,VILLA # A4V - 04&05 Ref.Drg.No.AP/PME/JP/AB/RM/SK-03 & 05
- 5) FOR SETTING OUT PLAN OF POOL SIZE:- 6.25x4x1.1m @ PACKAGE - 2A, CLUSTER-10,VILLA # 40 - 44 Ref. Drg.No. AP/PME/JP/AB/RM/SK-10

dar al-handasah Sheir and Partners	
☐ CODE 1 APPROVED	Approval shall be the contractor's responsibility for any change to Contract Documents or variation to the works. Contractor is responsible for dimensions, quantities and coordination with other trades.
☐ CODE 2 APPROVED AS NOTED WORK MAY PROCEED SUBJECT TO INCORPORATION OF ENDORSED COMMENTS	
☐ CODE 3 RESUBMIT FOR APPROVAL WORK MAY NOT PROCEED	
☐ CODE 4 REJECTED	
BY: _____	DATE: _____

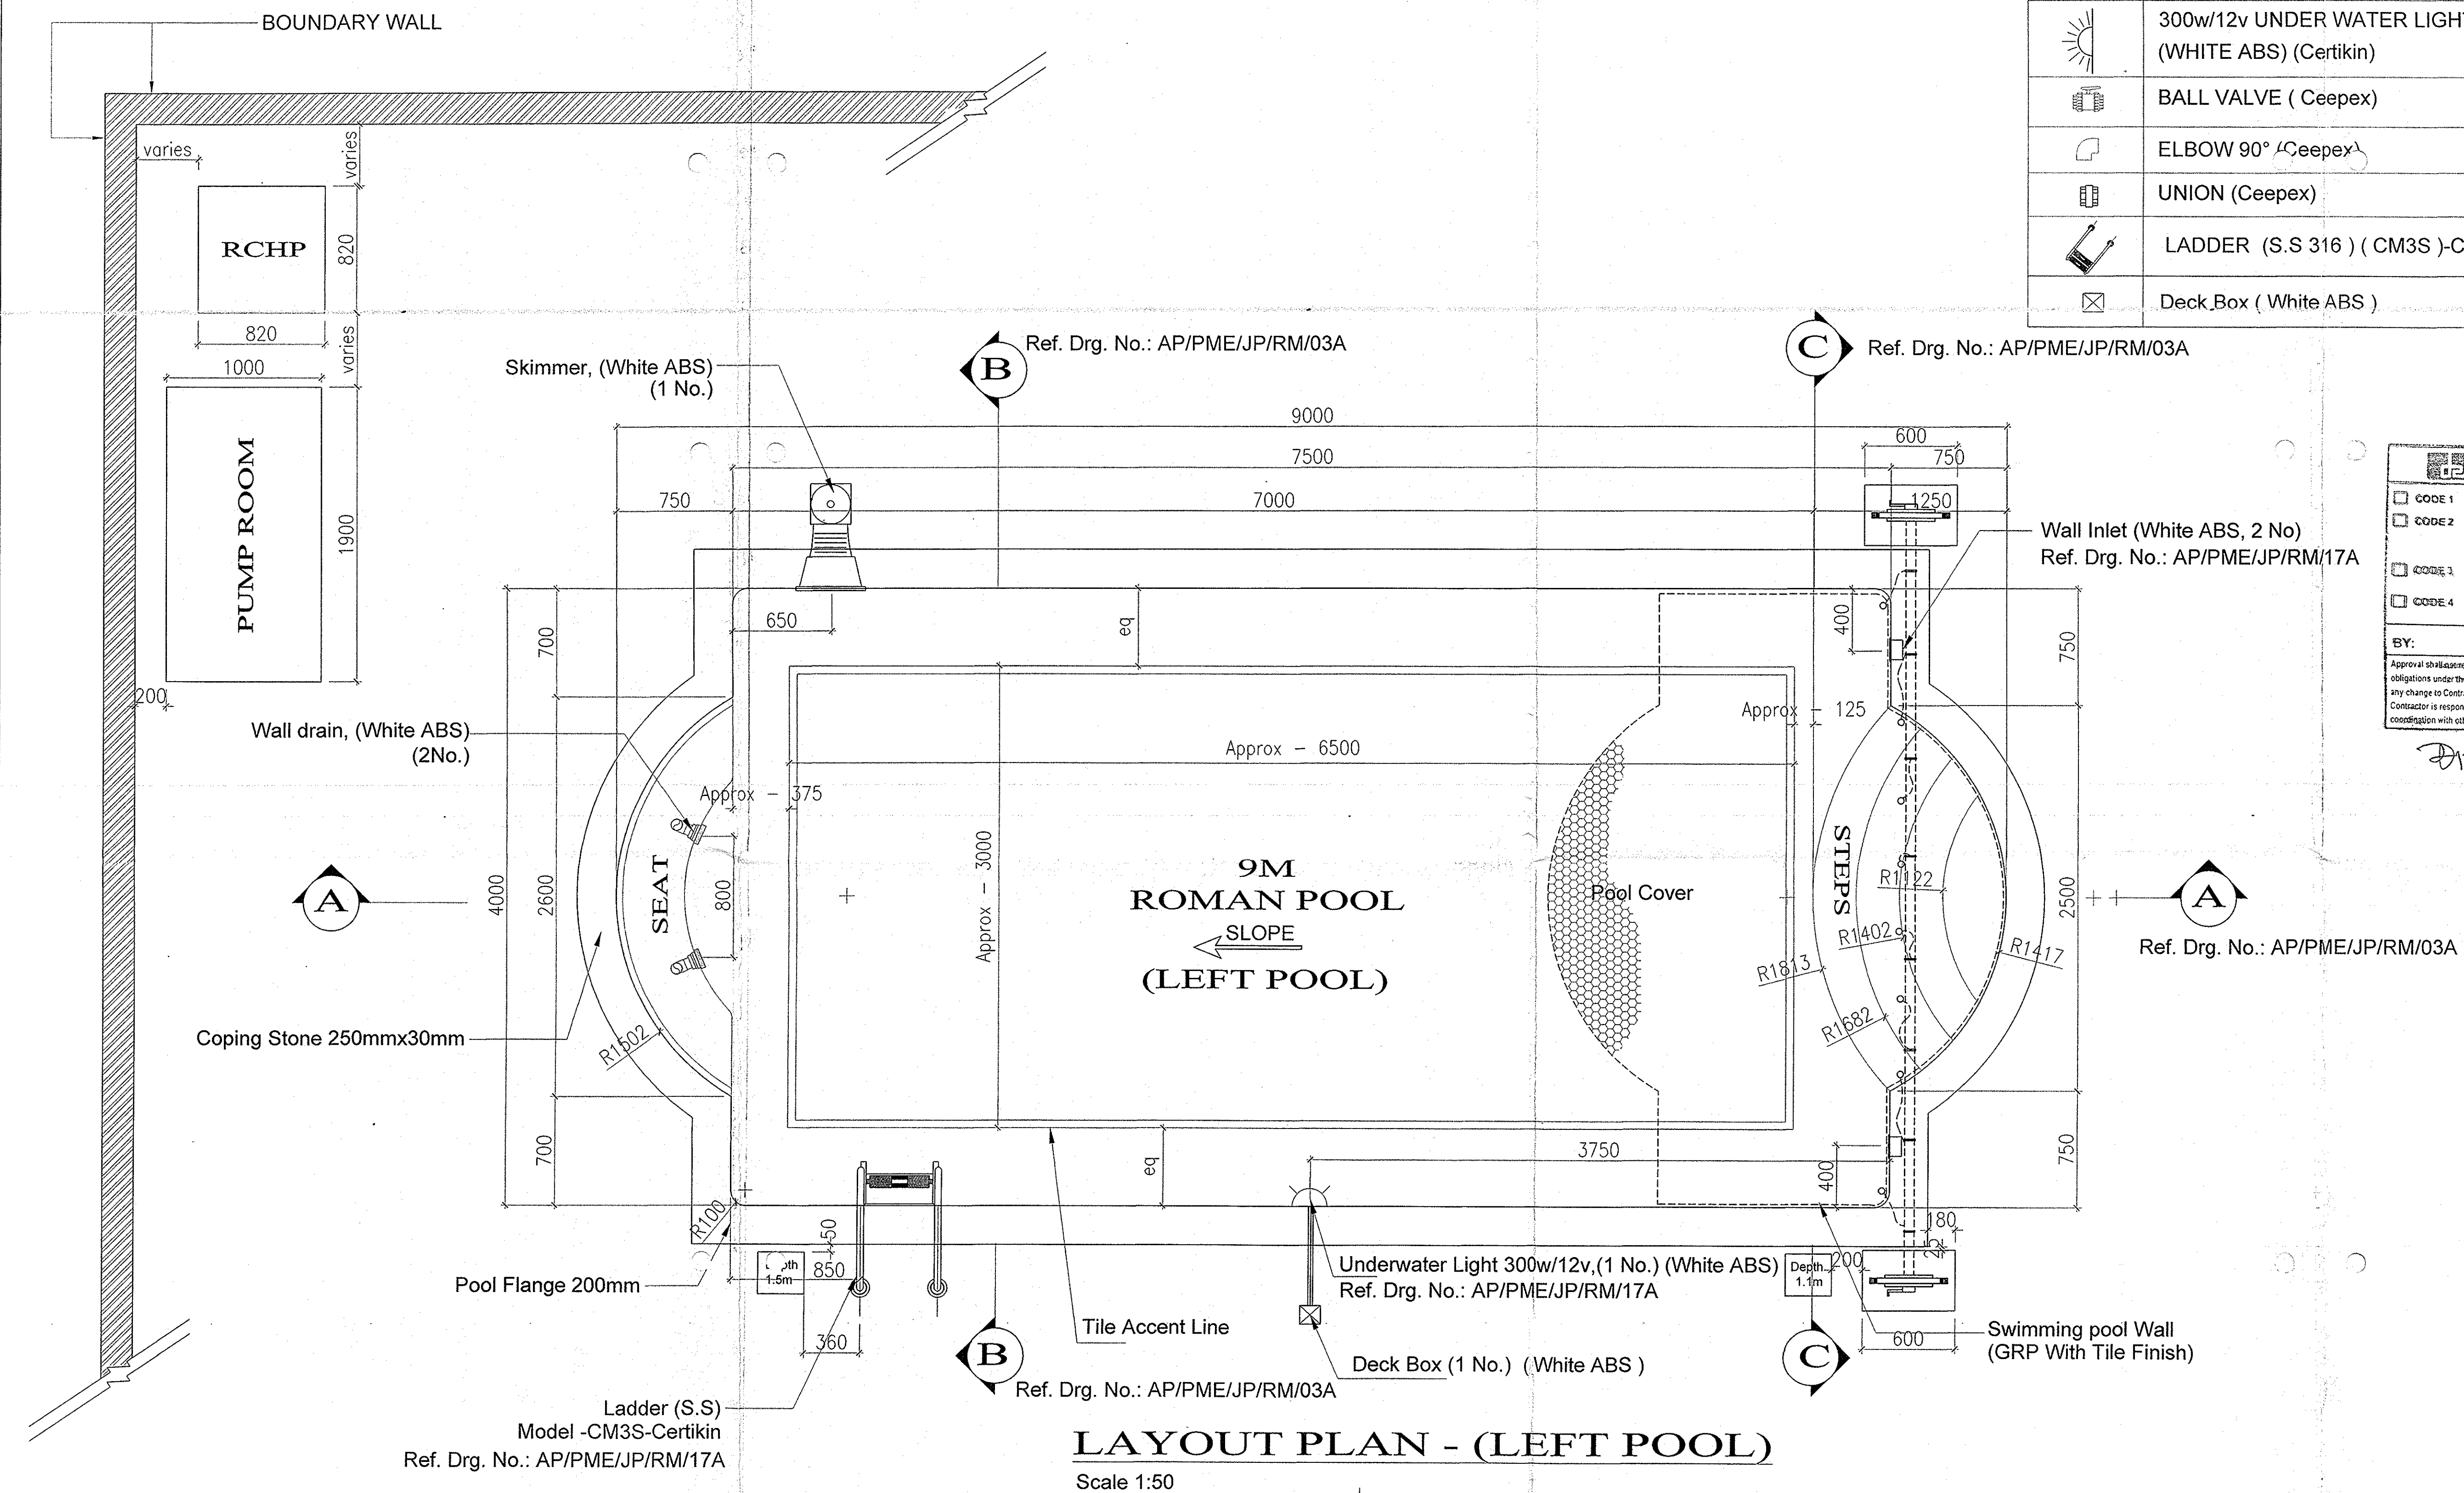


AS BUILT DRAWING

JUMAIRAH PARK



PACKAGE - 2 & 2A

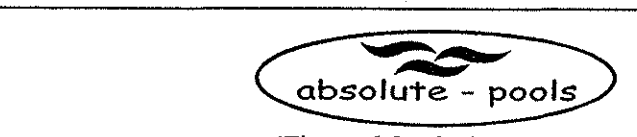

P.O. BOX 48990, DUBAI, U.A.E.
TEL: +971 4 3393155
FAX: +971 4 3395973
e-mail: info@absolute-pools.com

ROMAN POOL LAYOUT PLAN LEFT SIDE

Drawn: GS	Revised: RDL	Check: FM/
Scale: 1:50	Date: 10-01-2012	Approved:

Drawing No.

Drg. No.: AP/PME/JP/AB/RM/02A