



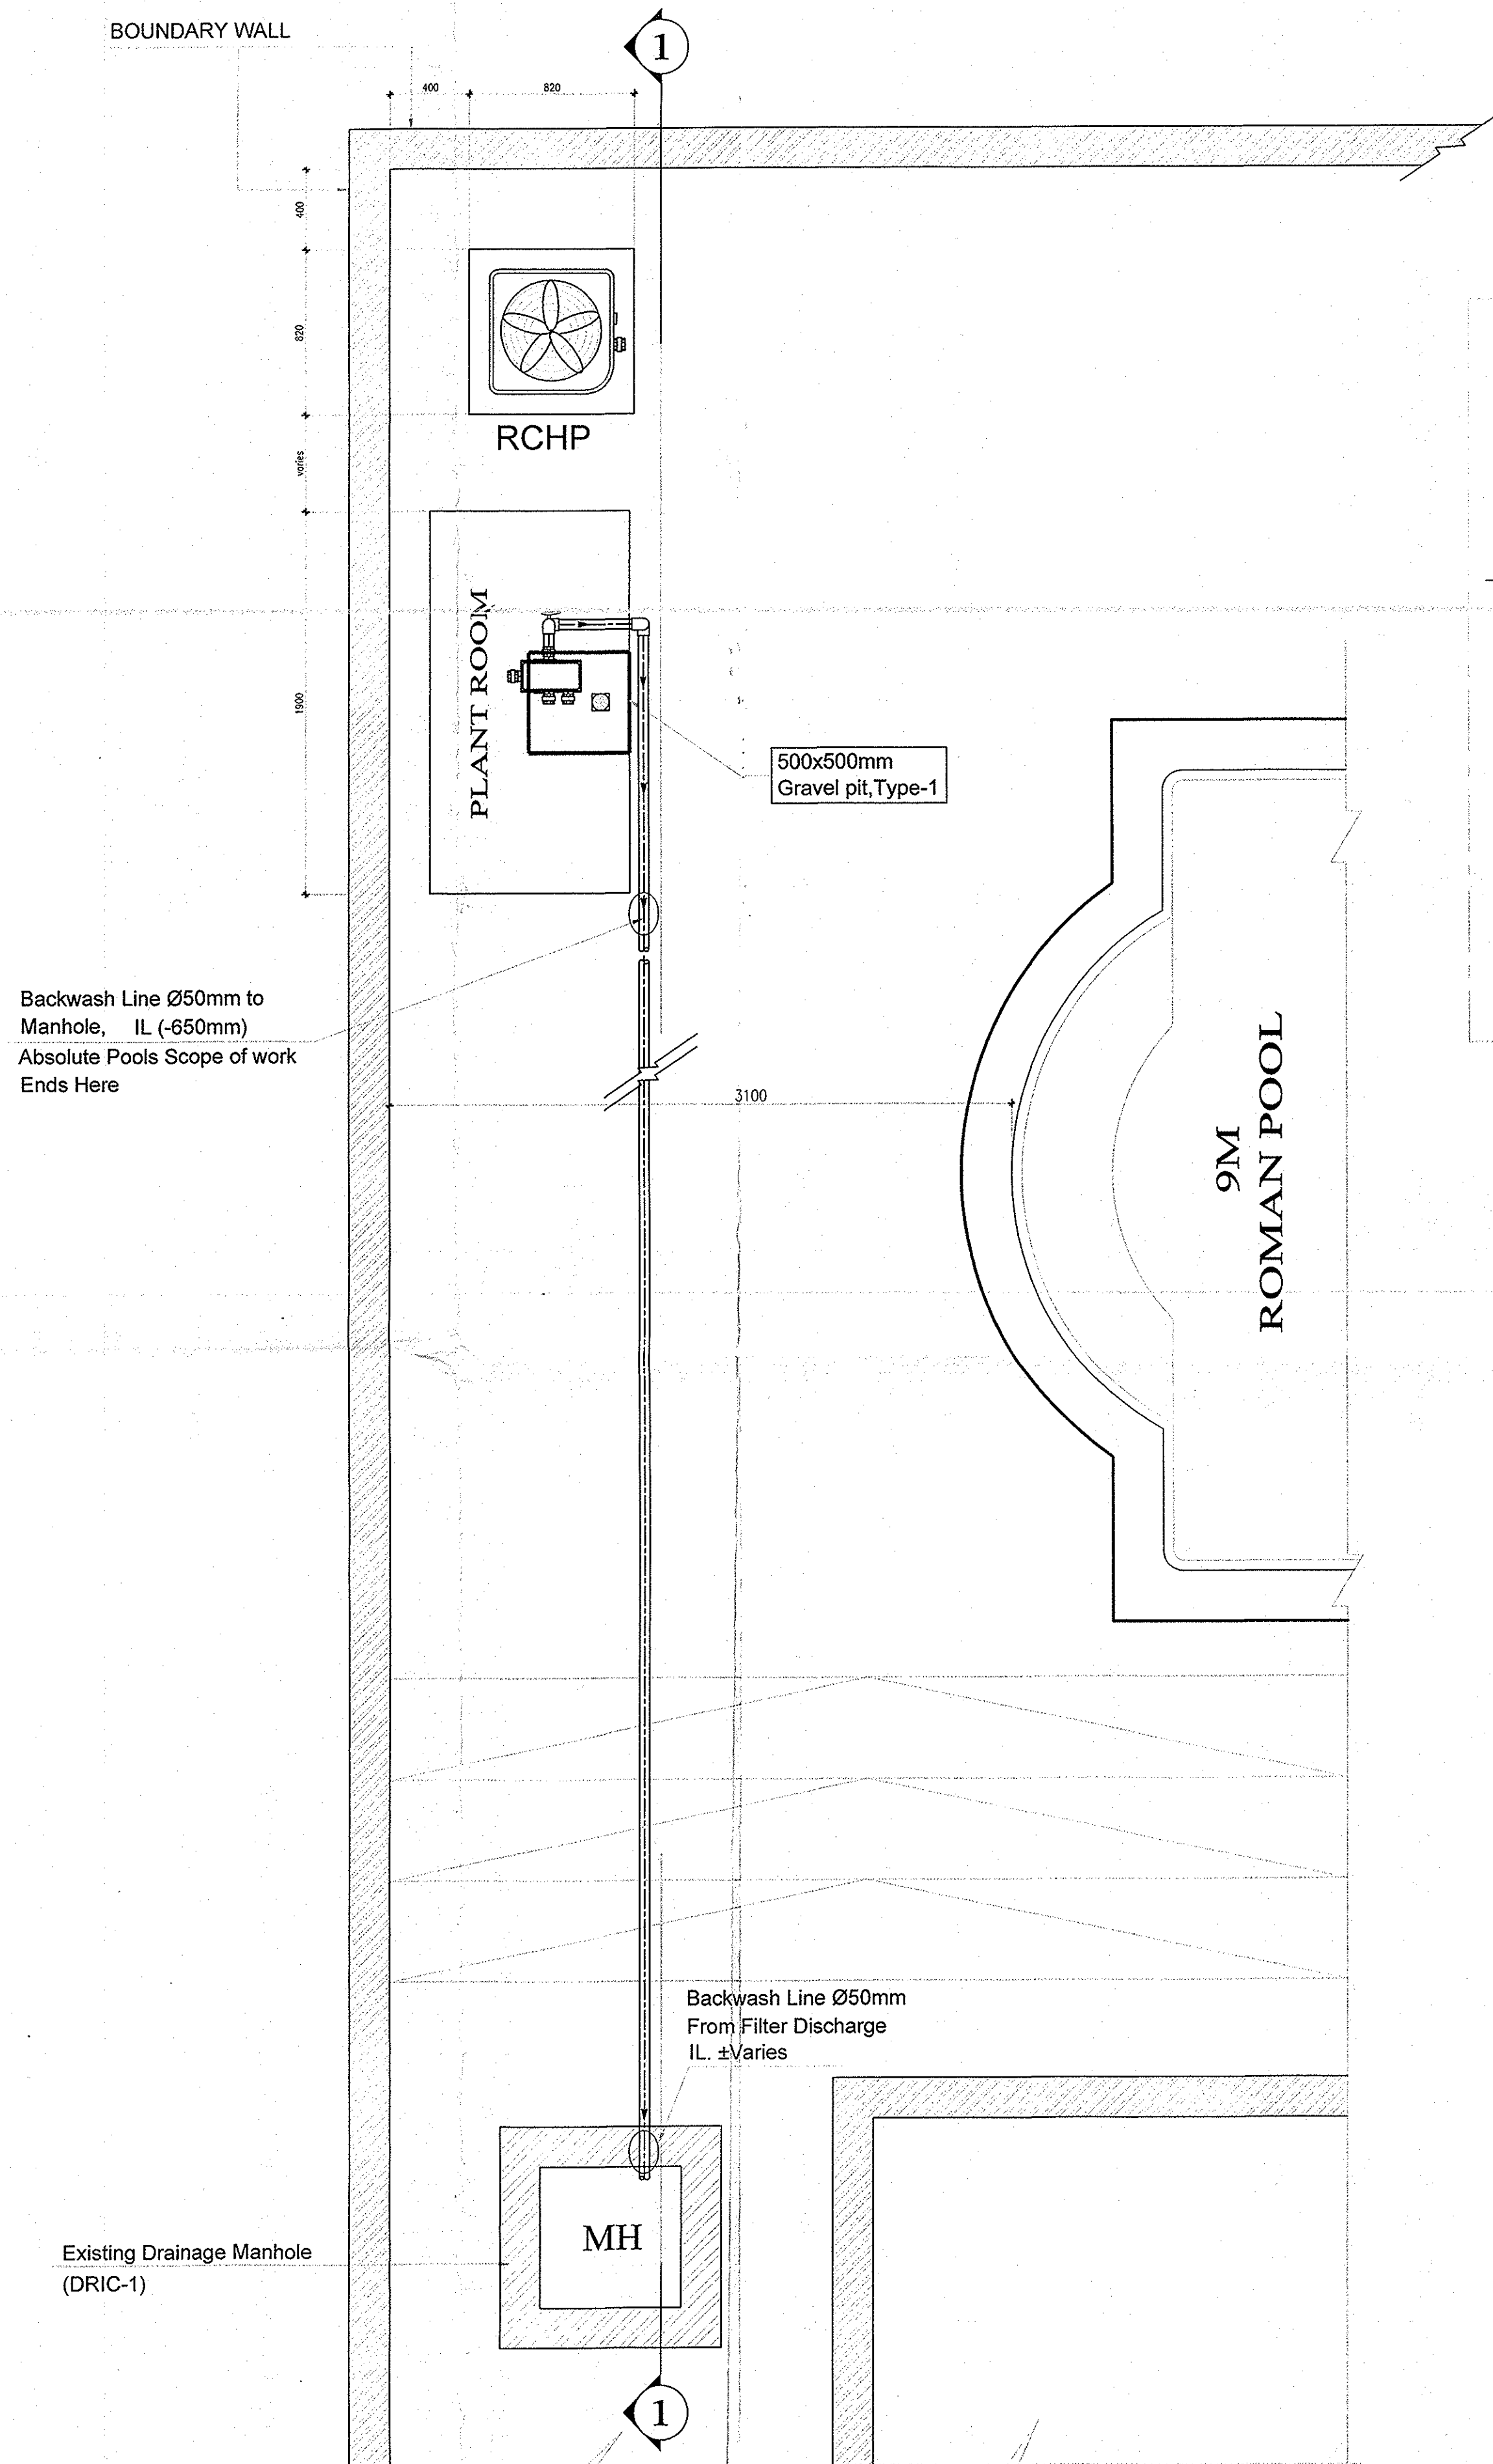


PLANT ROOM DRAIN & BACKWASH CONNECTION DETAIL - (LEFT POOL)
Scale 1:50
(TYPE -A)

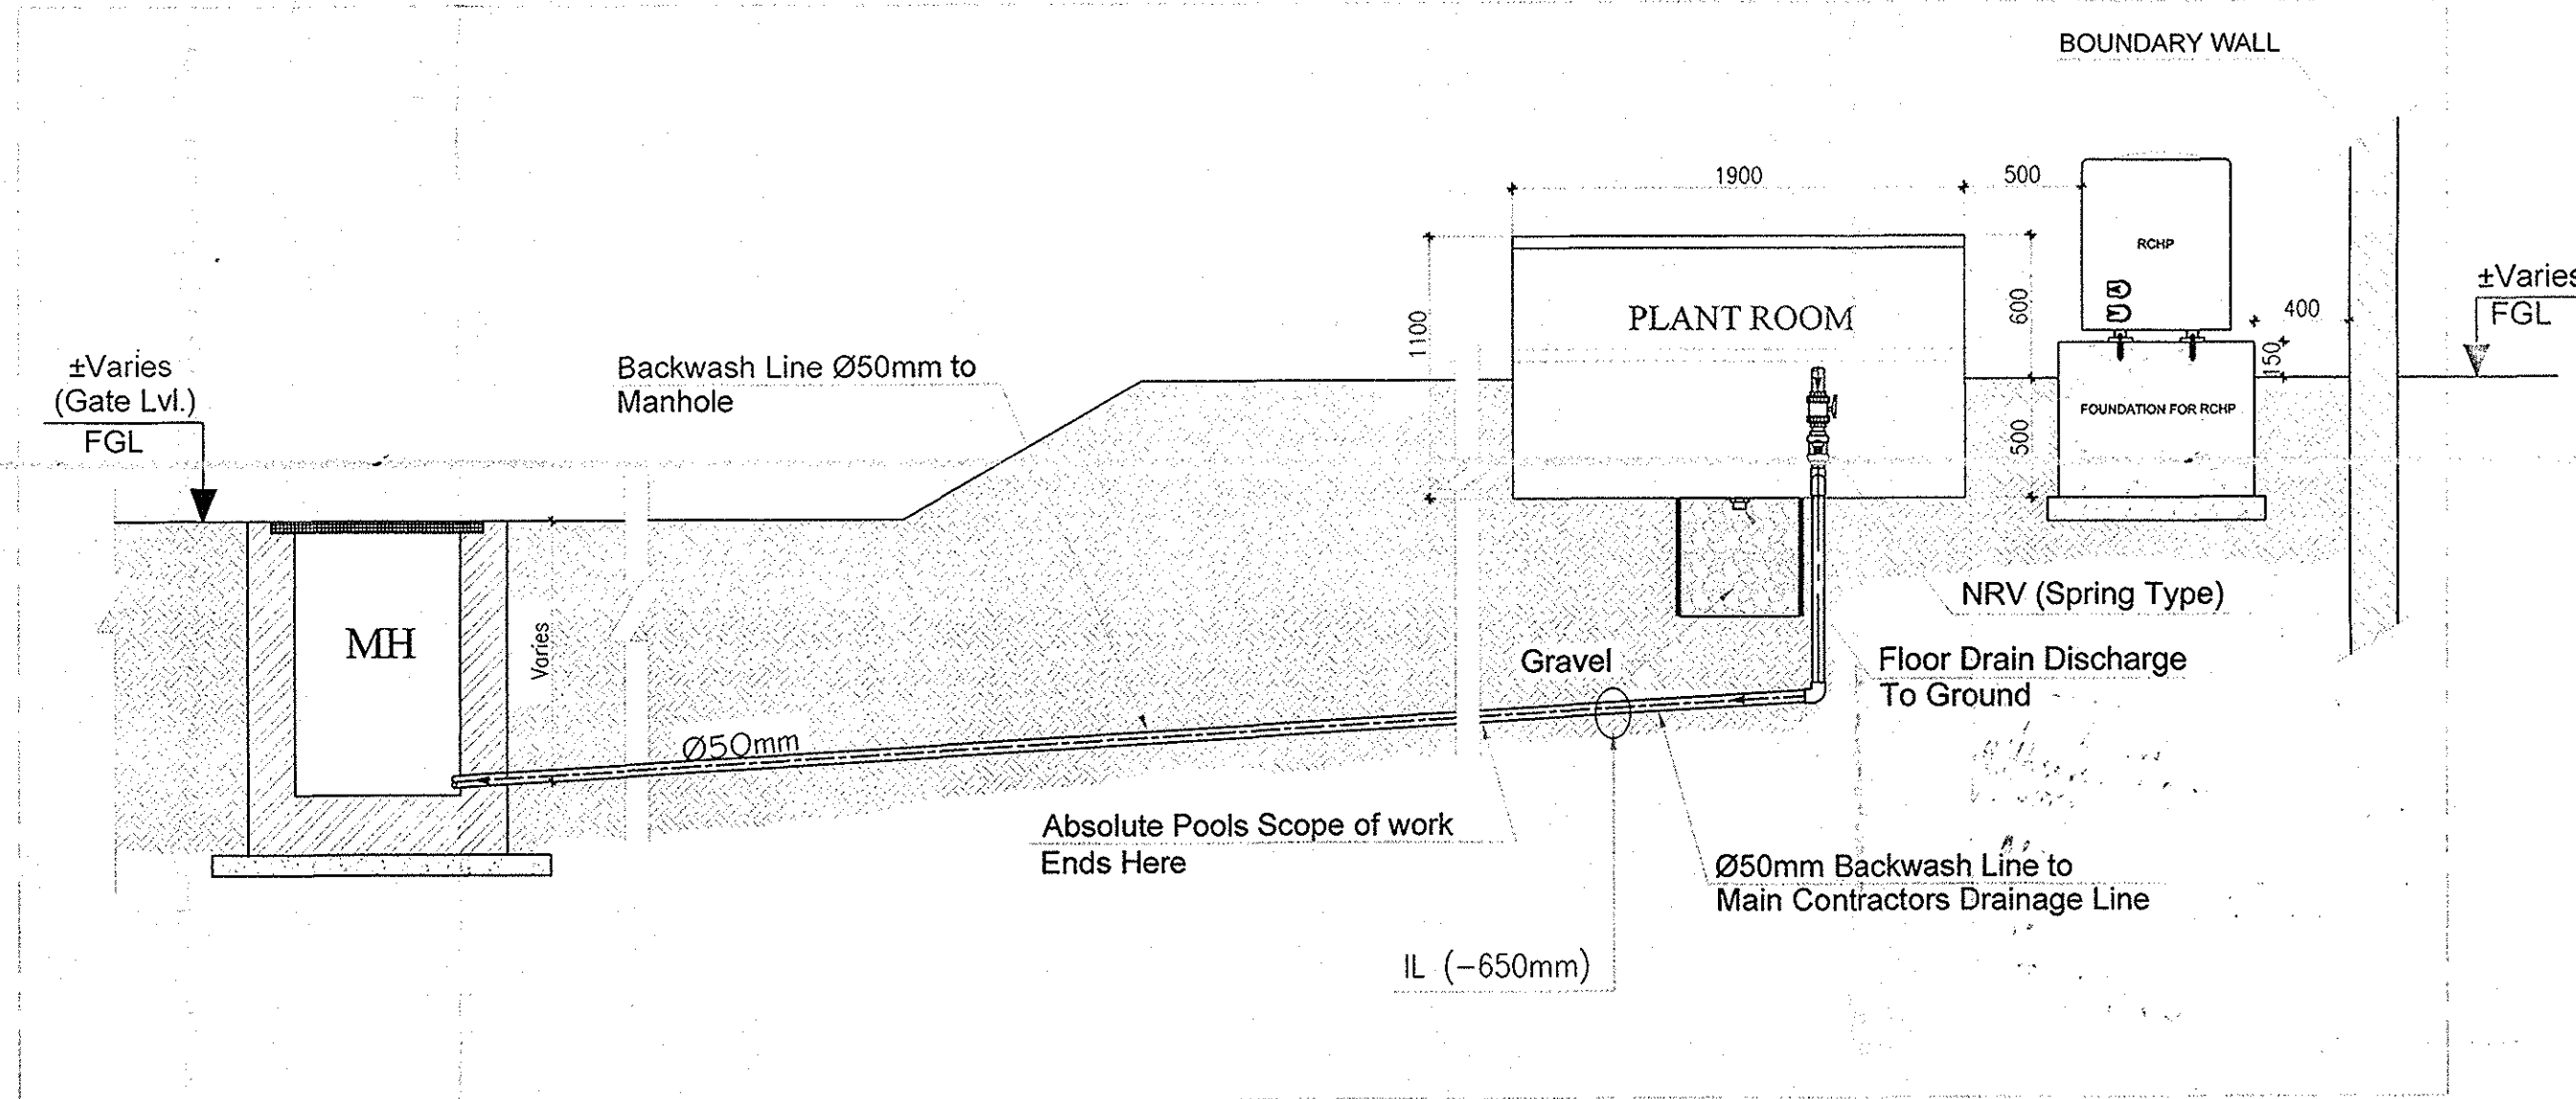

SECTION @ - '1-1'
DRAIN PIPE & BACKWASH LINE DETAIL
Scale 1:75

GRAVEL PIT SCHEDULE FOR PLANT/PUMP ROOM DRAIN				
PACKAGES	CLUSTERS	VILLAS	TYPE-1	TYPE-2
PACKAGES-2	2	31 - 40		✓
PACKAGES-2	4	20 - 28		✓
PACKAGES-2	8	27 & 49		✓
PACKAGES-2	REST ALL CLUSTERS IN VILLAS		✓	
PACKAGES-2A	ALL VILLAS		✓	

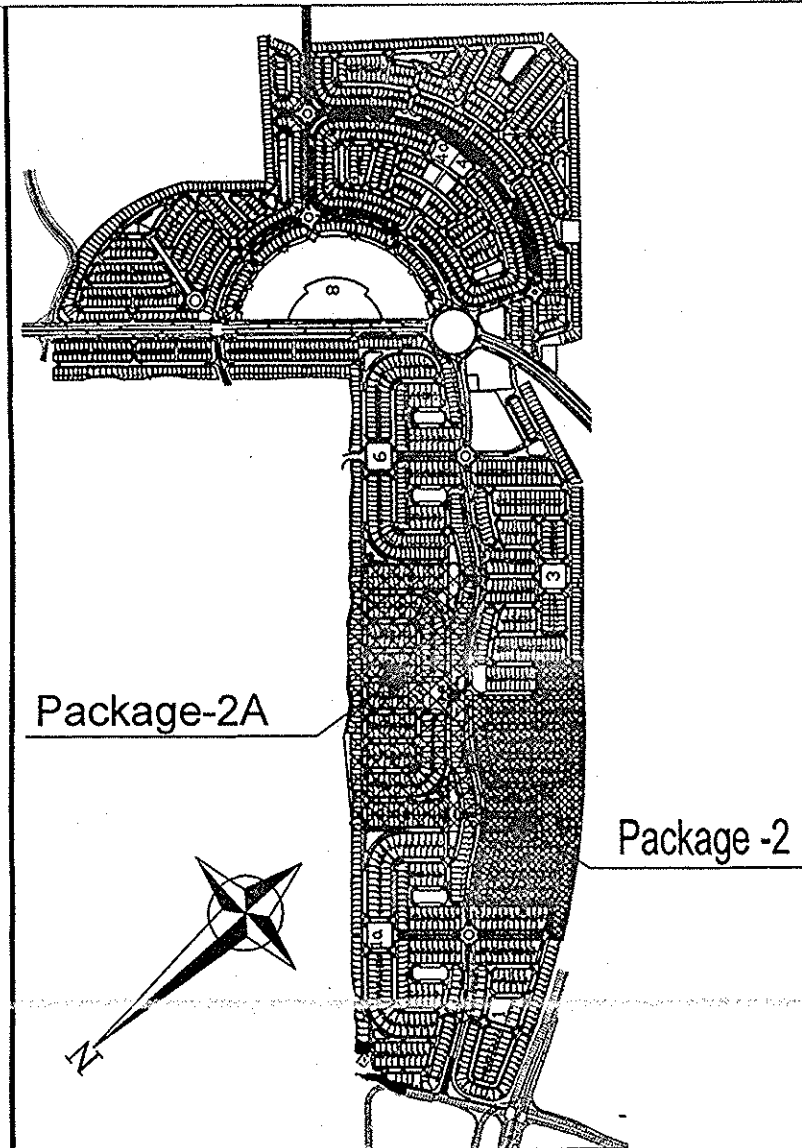

KEY PLAN

NOTES:-

- 1) ALL DIMENSIONS ARE IN MM AND LEVELS ARE METERS UNLESS NOTED OTHERWISE.
- 2) FOR SETTING OUT PLAN OF SW, POOL, PLANT ROOM & RCHP, PL REF. DWG. NO. AP/PME/JP/RM/26A-26J FOR PACKAGE-2A PL REF. DWG. NO. AP/PME/JP/RM/21A-21F FOR PACKAGE-2.
- 3) THIS DWG. IS NOT APPLICABLE FOR PACKAGE-2A, CLUSTER-2, VILLAS 3,4&5 AND PACKAGE-2A, CL-10, VILLAS 40-44. (FOR THE ABOVE PACKAGES VILLA DWGS. PL. REF. DWG. NO. AP/PME/JP/AB/RM/SK-03,05&07 / AP/PME/JP/AB/RM/SK-10.)

Rev.	Date	Description	Drawn	Check
AB3	25.07.12	ISSUED FOR APPROVAL	VJ	RDL
AB2	25.06.12	ISSUED FOR APPROVAL	GS	RDL
AB1	22.02.12	ISSUED FOR APPROVAL	GS	RDL
AB	12.01.12	ISSUED FOR APPROVAL	GS	RDL

AS BUILT DRAWING

Project

JUMAIRAH PARK

Employer
NAKHEEL
P.O. BOX: 17771, DUBAI, U.A.E.
PHONE : + 971 4 360338
FAX : + 971 4 360335
Website : www.nakheel.ae

Consultant
dar al-handasah
sheir and partners
P.O. BOX: 55894, DUBAI, U.A.E.
PHONE : + 971 4 3339155
FAX: + 971 4 3339151
www.daralhandasah.ae

Main Contractor
Pauling Middle East
P.O. BOX: 40705, ABU DHABI, U.A.E.
PHONE : + 971 2 422092
FAX : + 971 2 422093
E-MAIL : paulingmiddleeast.ae

Package

Sub Contractor
absolute - pools
"The pool for the home owner"
P.O. BOX: 48890, DUBAI, U.A.E.
TEL: +971 4 3393155
FAX: +971 4 3393173
e-mail: info@absolute-pools.com

Drawing Title
DETAILS OF BACKWASH LINE & PLANT ROOM DRAIN LINE CONNECTION DETAILS (Type -A)

Drawn	GS	Review	RDL	Check	FM/PJ
Scale:	1:50	Date:	10-01-2012	Approved:	

Drawing No.
Drg. No.:AP/PME/JP/AB/RM/11A

REV
AB3