


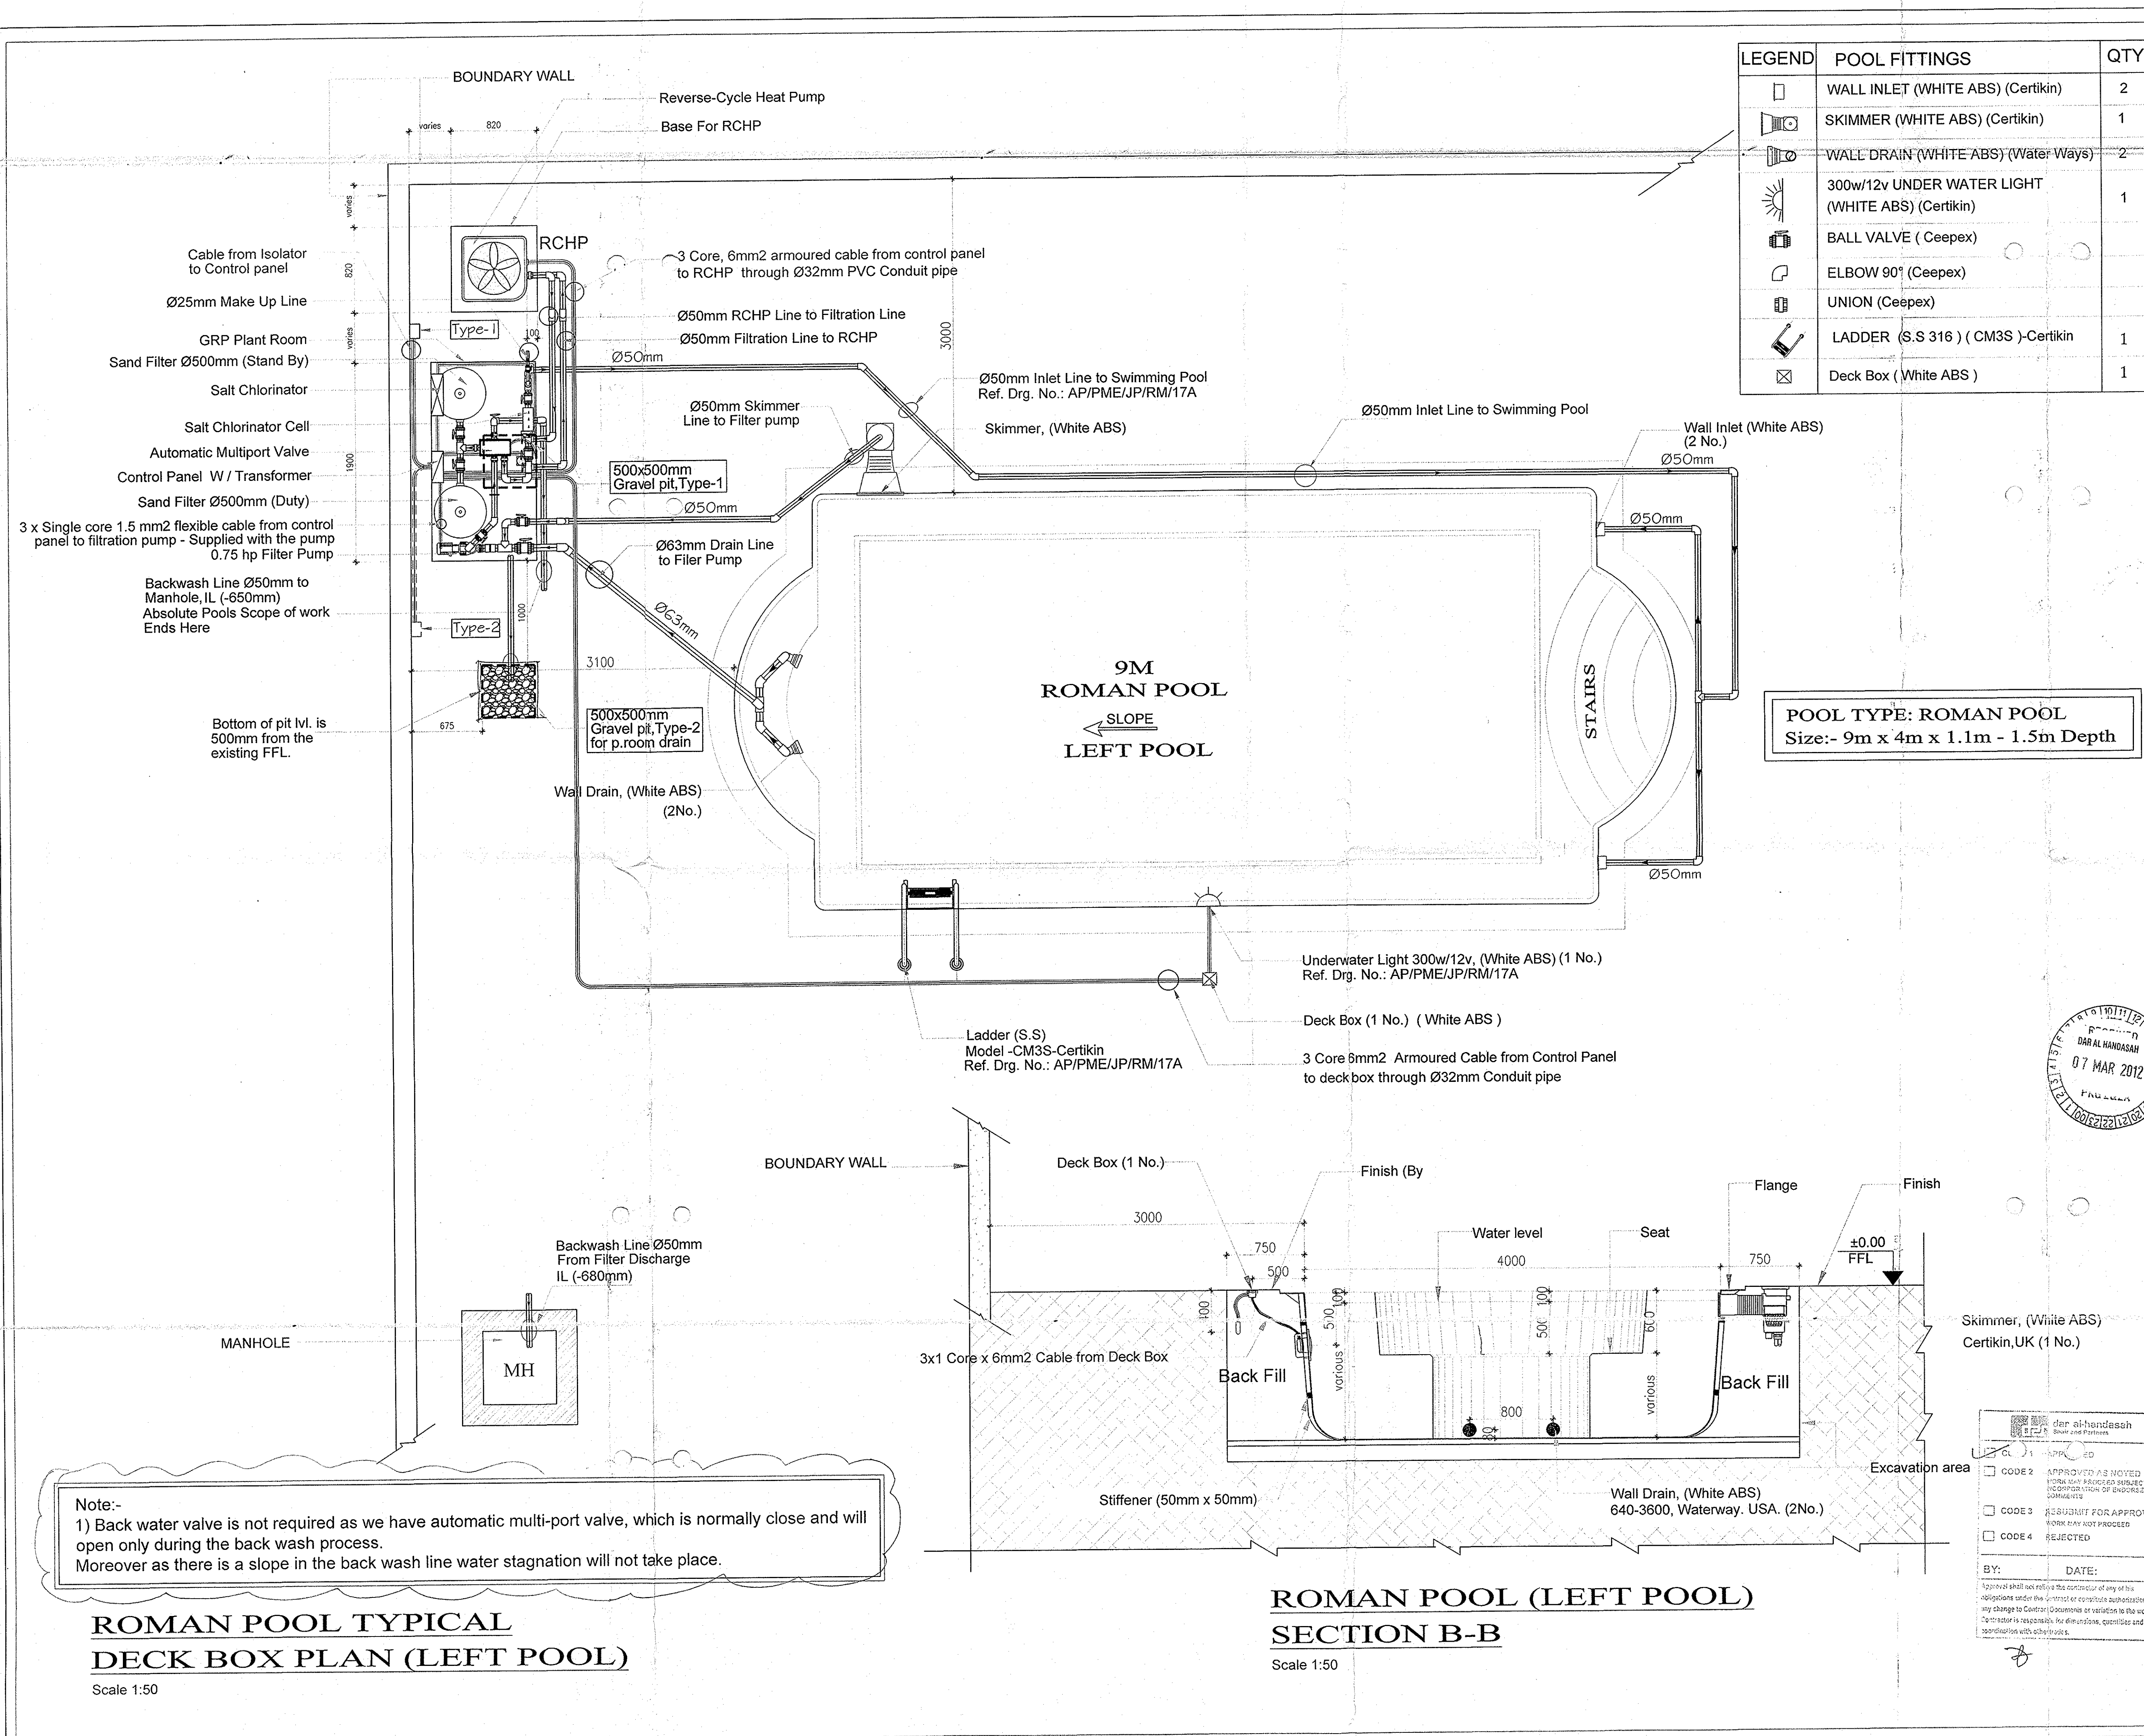

Package-2A

Package -2

KEY PLAN

NOTES:-

- ALL DIMENSIONS ARE IN MM AND LEVELS ARE METERS UNLESS NOTED OTHERWISE.
- THIS DWG. IS NOT APPLICABLE FOR PACKAGE-2A, CLUSTER-2, VILLAS 3,4&5 AND PACKAGE-2A, CL-10, VILLAS 40-44.
- FOR POOL, PLANT ROOM & RCHP, SETTING OUT PLAN PL.REF. DWG. NO. AP/PME/J/P/RM/26A-26J FOR PACKAGE-2A PL.REF. DWG. NO. AP/PME/J/P/RM/21A-21F FOR PACKAGE-2.

Rev.	Date	Description	Drawn	Check
AB	22.02.12	ISSUED FOR APPROVAL	GS	RDL
AB	12.01.12	ISSUED FOR APPROVAL	GS	RDL

AS BUILT DRAWING

Project: **JUMAIRAH PARK**

Employer: **NAKHEEL**

Consultant: **dar al-handasah sheir and partners**

Main Contractor: **Pauling Middle East**

Package: **PACKAGE - 2 & 2A**

Sub Contractor: **absolute - pools**

Drawing Title: **ROMAN POOL TYPICAL DECK BOX PLAN & UNDER WATER LIGHT ,CONDUIT,CABLES - DETAILS**
Size:- 9m x 4m x 1.1m-1.5m Depth

Drawn	GS	Revise	RDL	Check	FM/PJ
Scale	1:50	Date	10-01-2012	Approved	

Drawing No. **REV**
Drg. No.:AP/PME/J/P/AB/RM/13A
AB

Stamp: 07 MAR 2012

Stamp: dar al-handasah

Stamp: APPROVED AS NOTED

Stamp: APPROVED FOR APPROVAL

Stamp: REJECTED

Stamp: BY: DATE:

Stamp: APPROVAL SHEET