




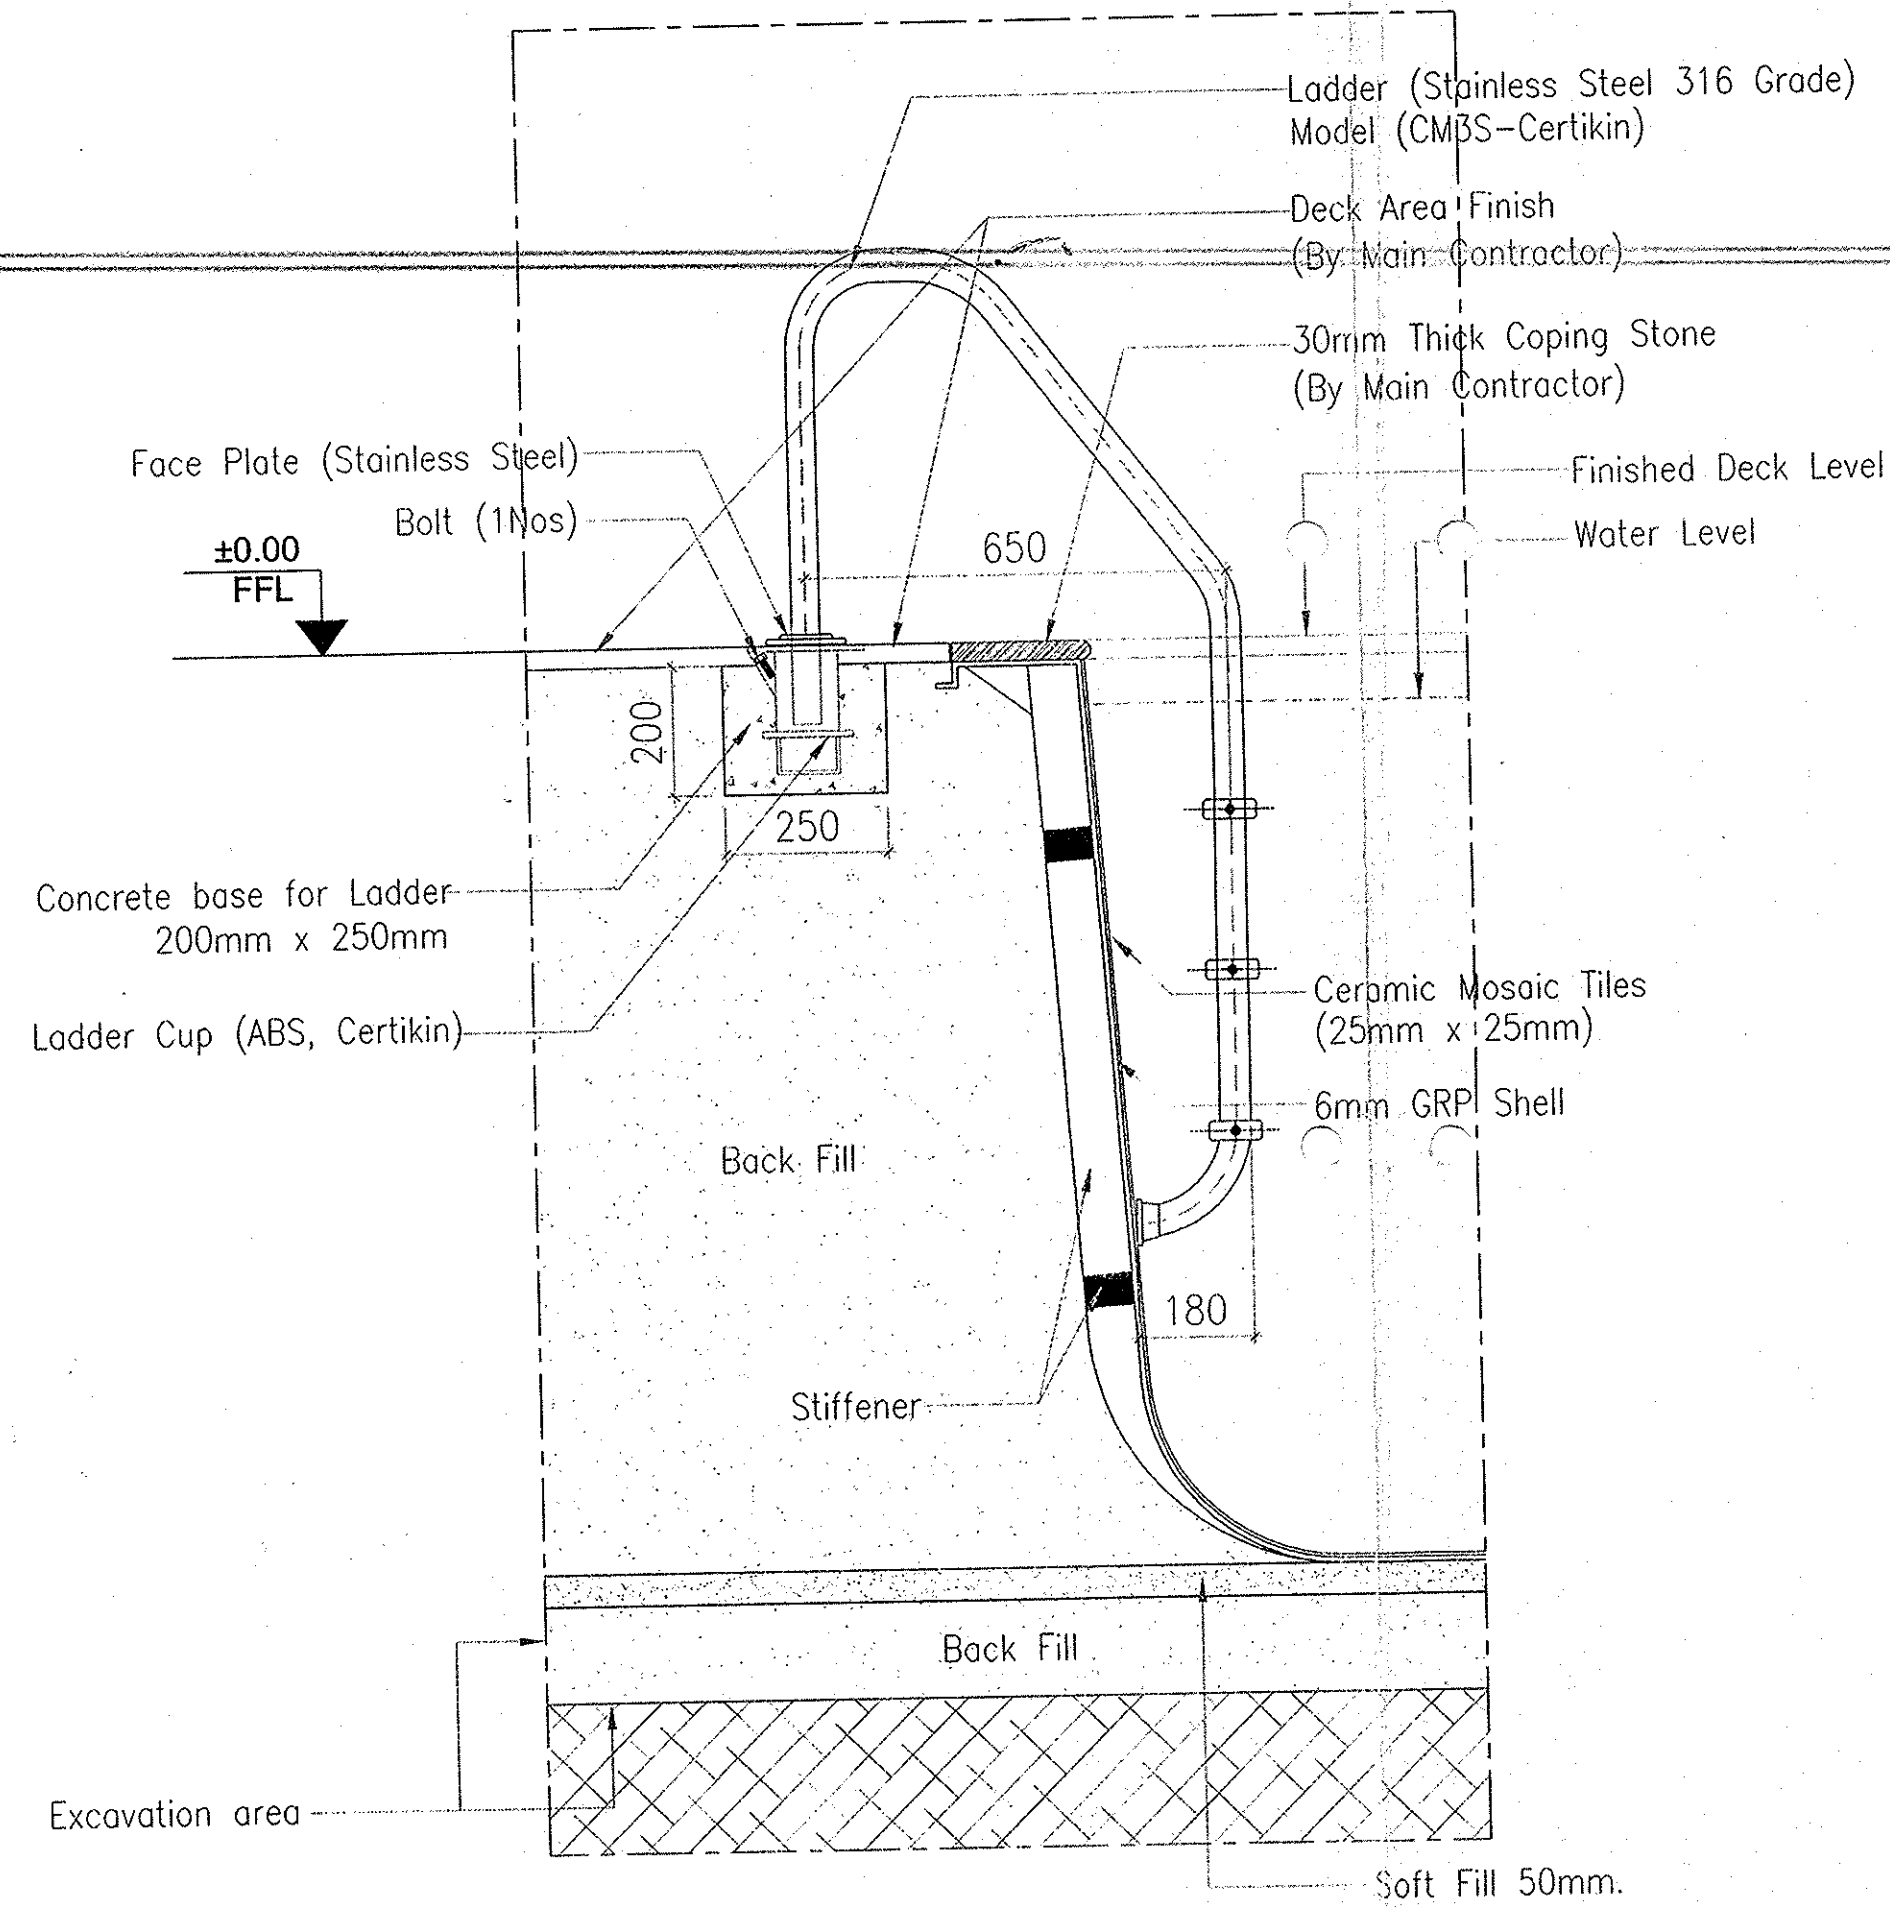


LADDER FIXING DETAIL
Scale : 1:2.5

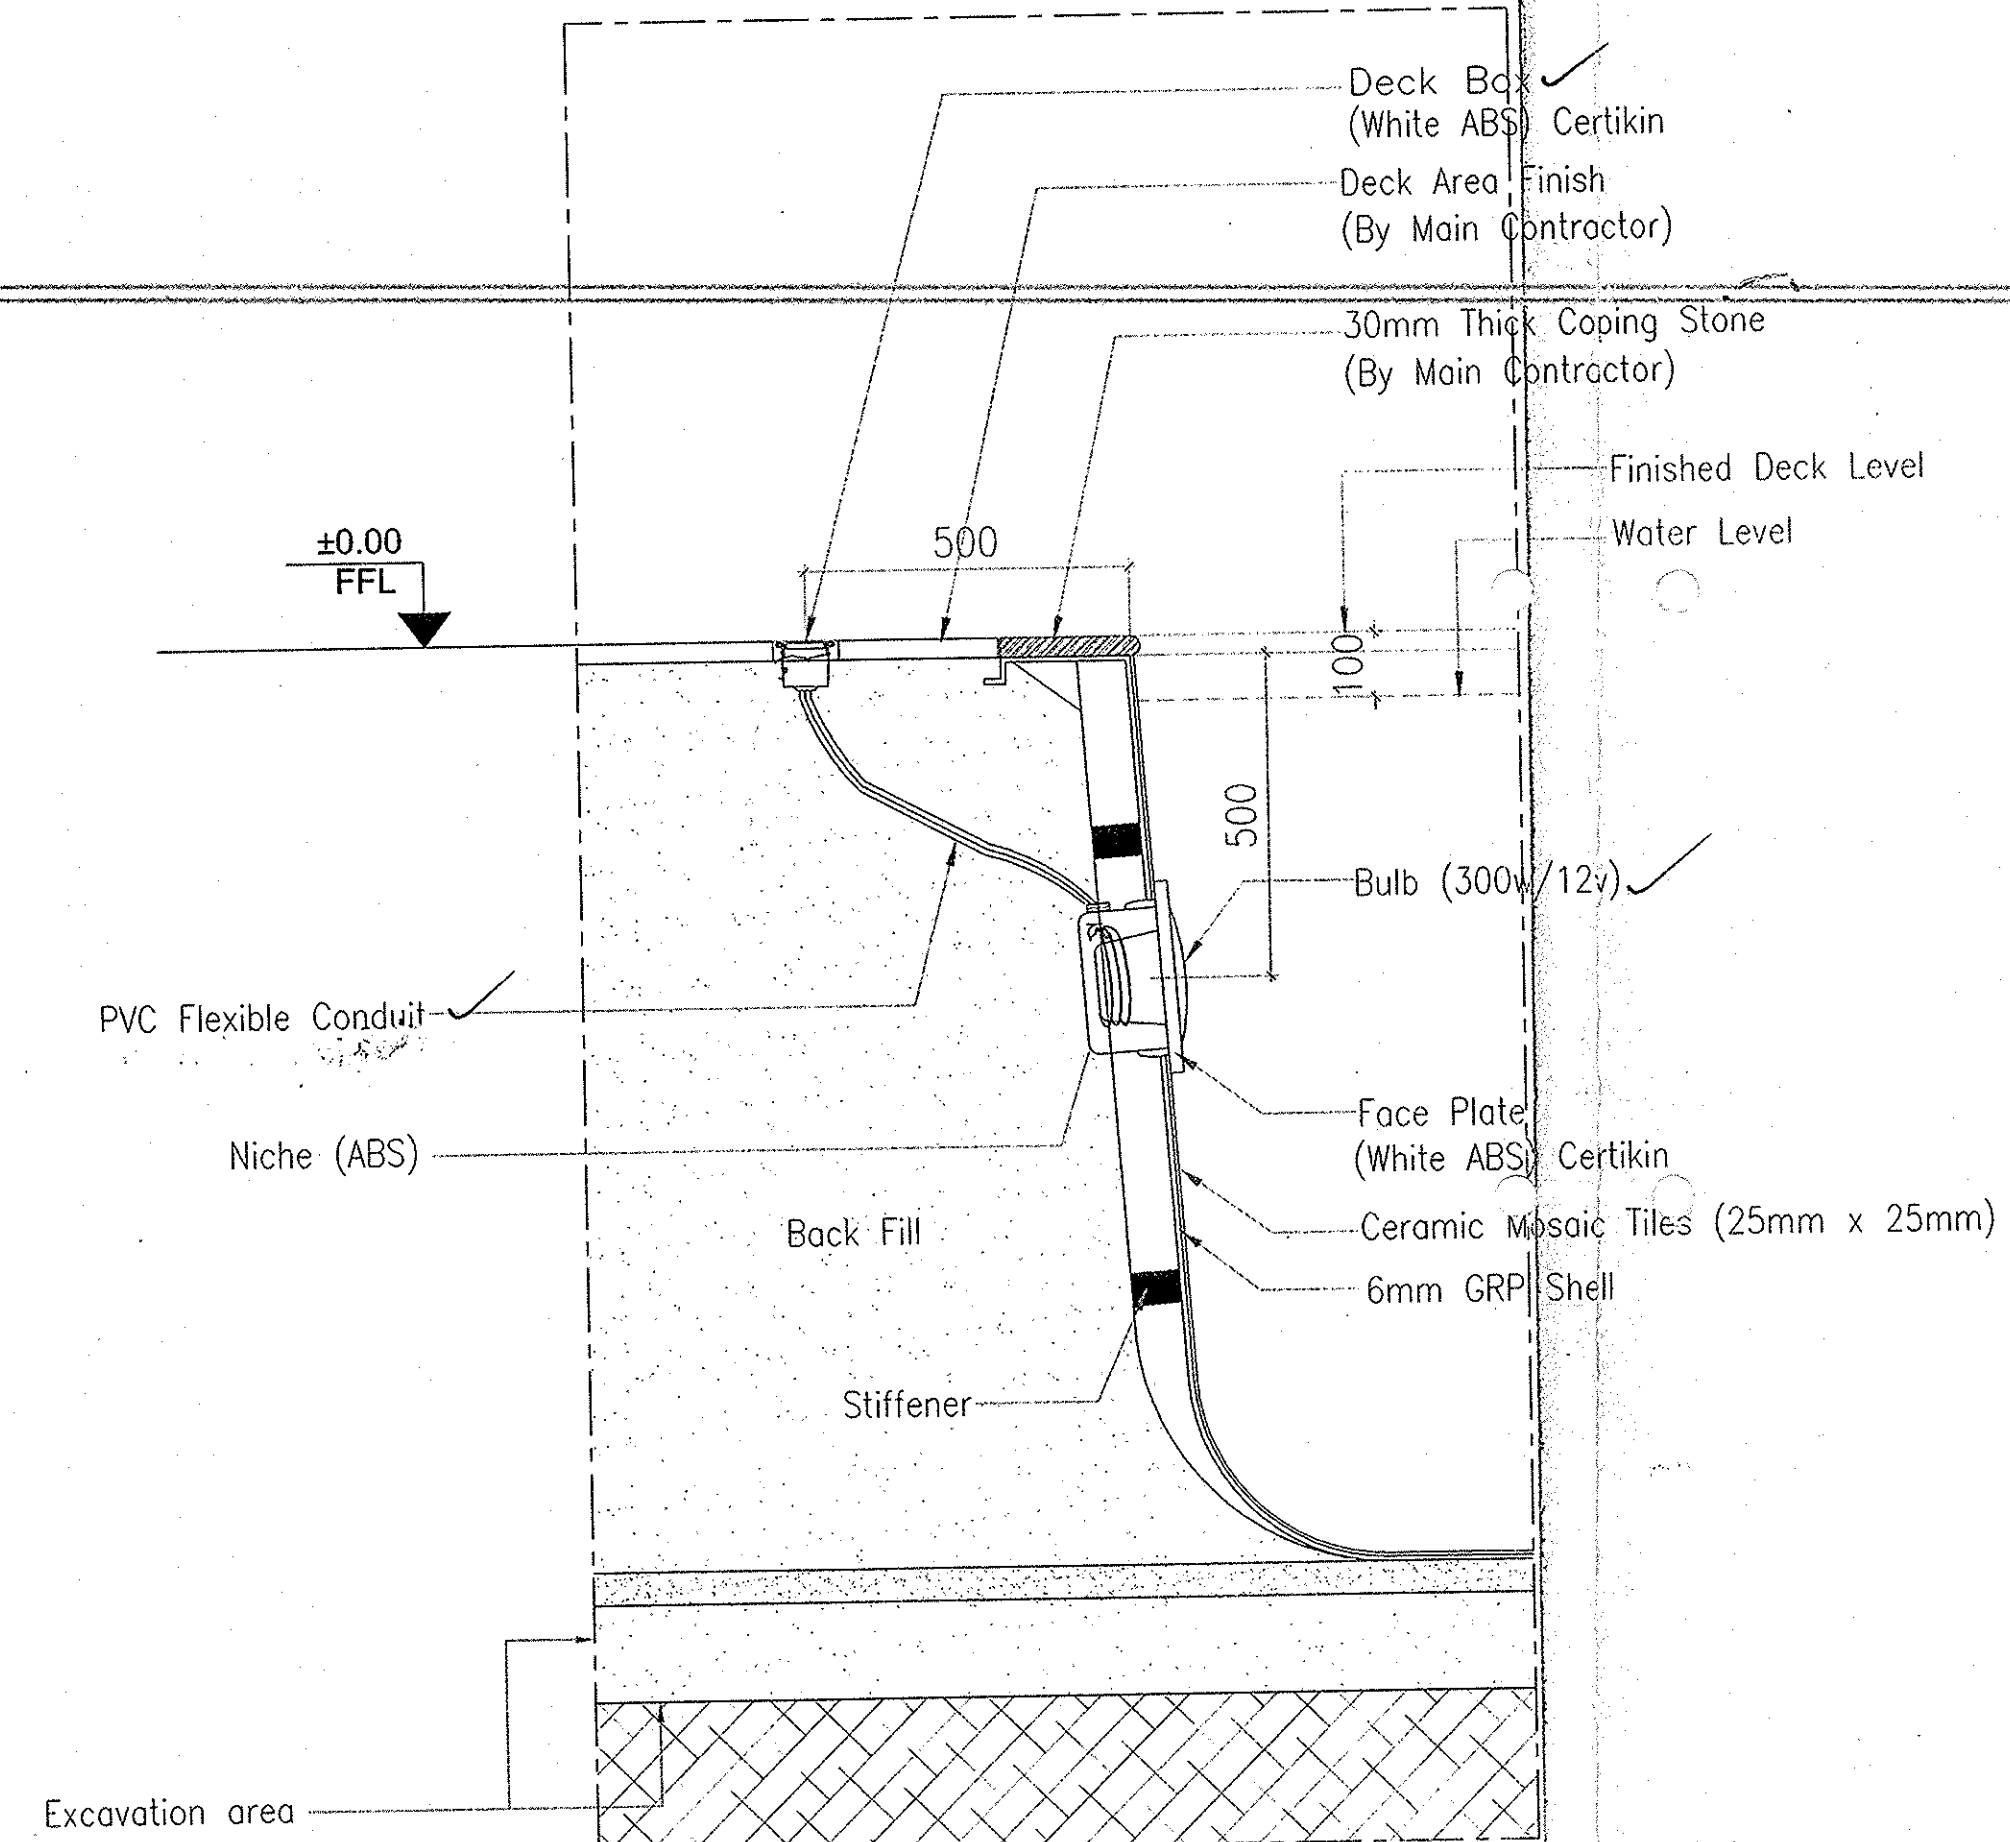


UNDER WATER LIGHT FIXING DETAIL
Scale : 1:2.5

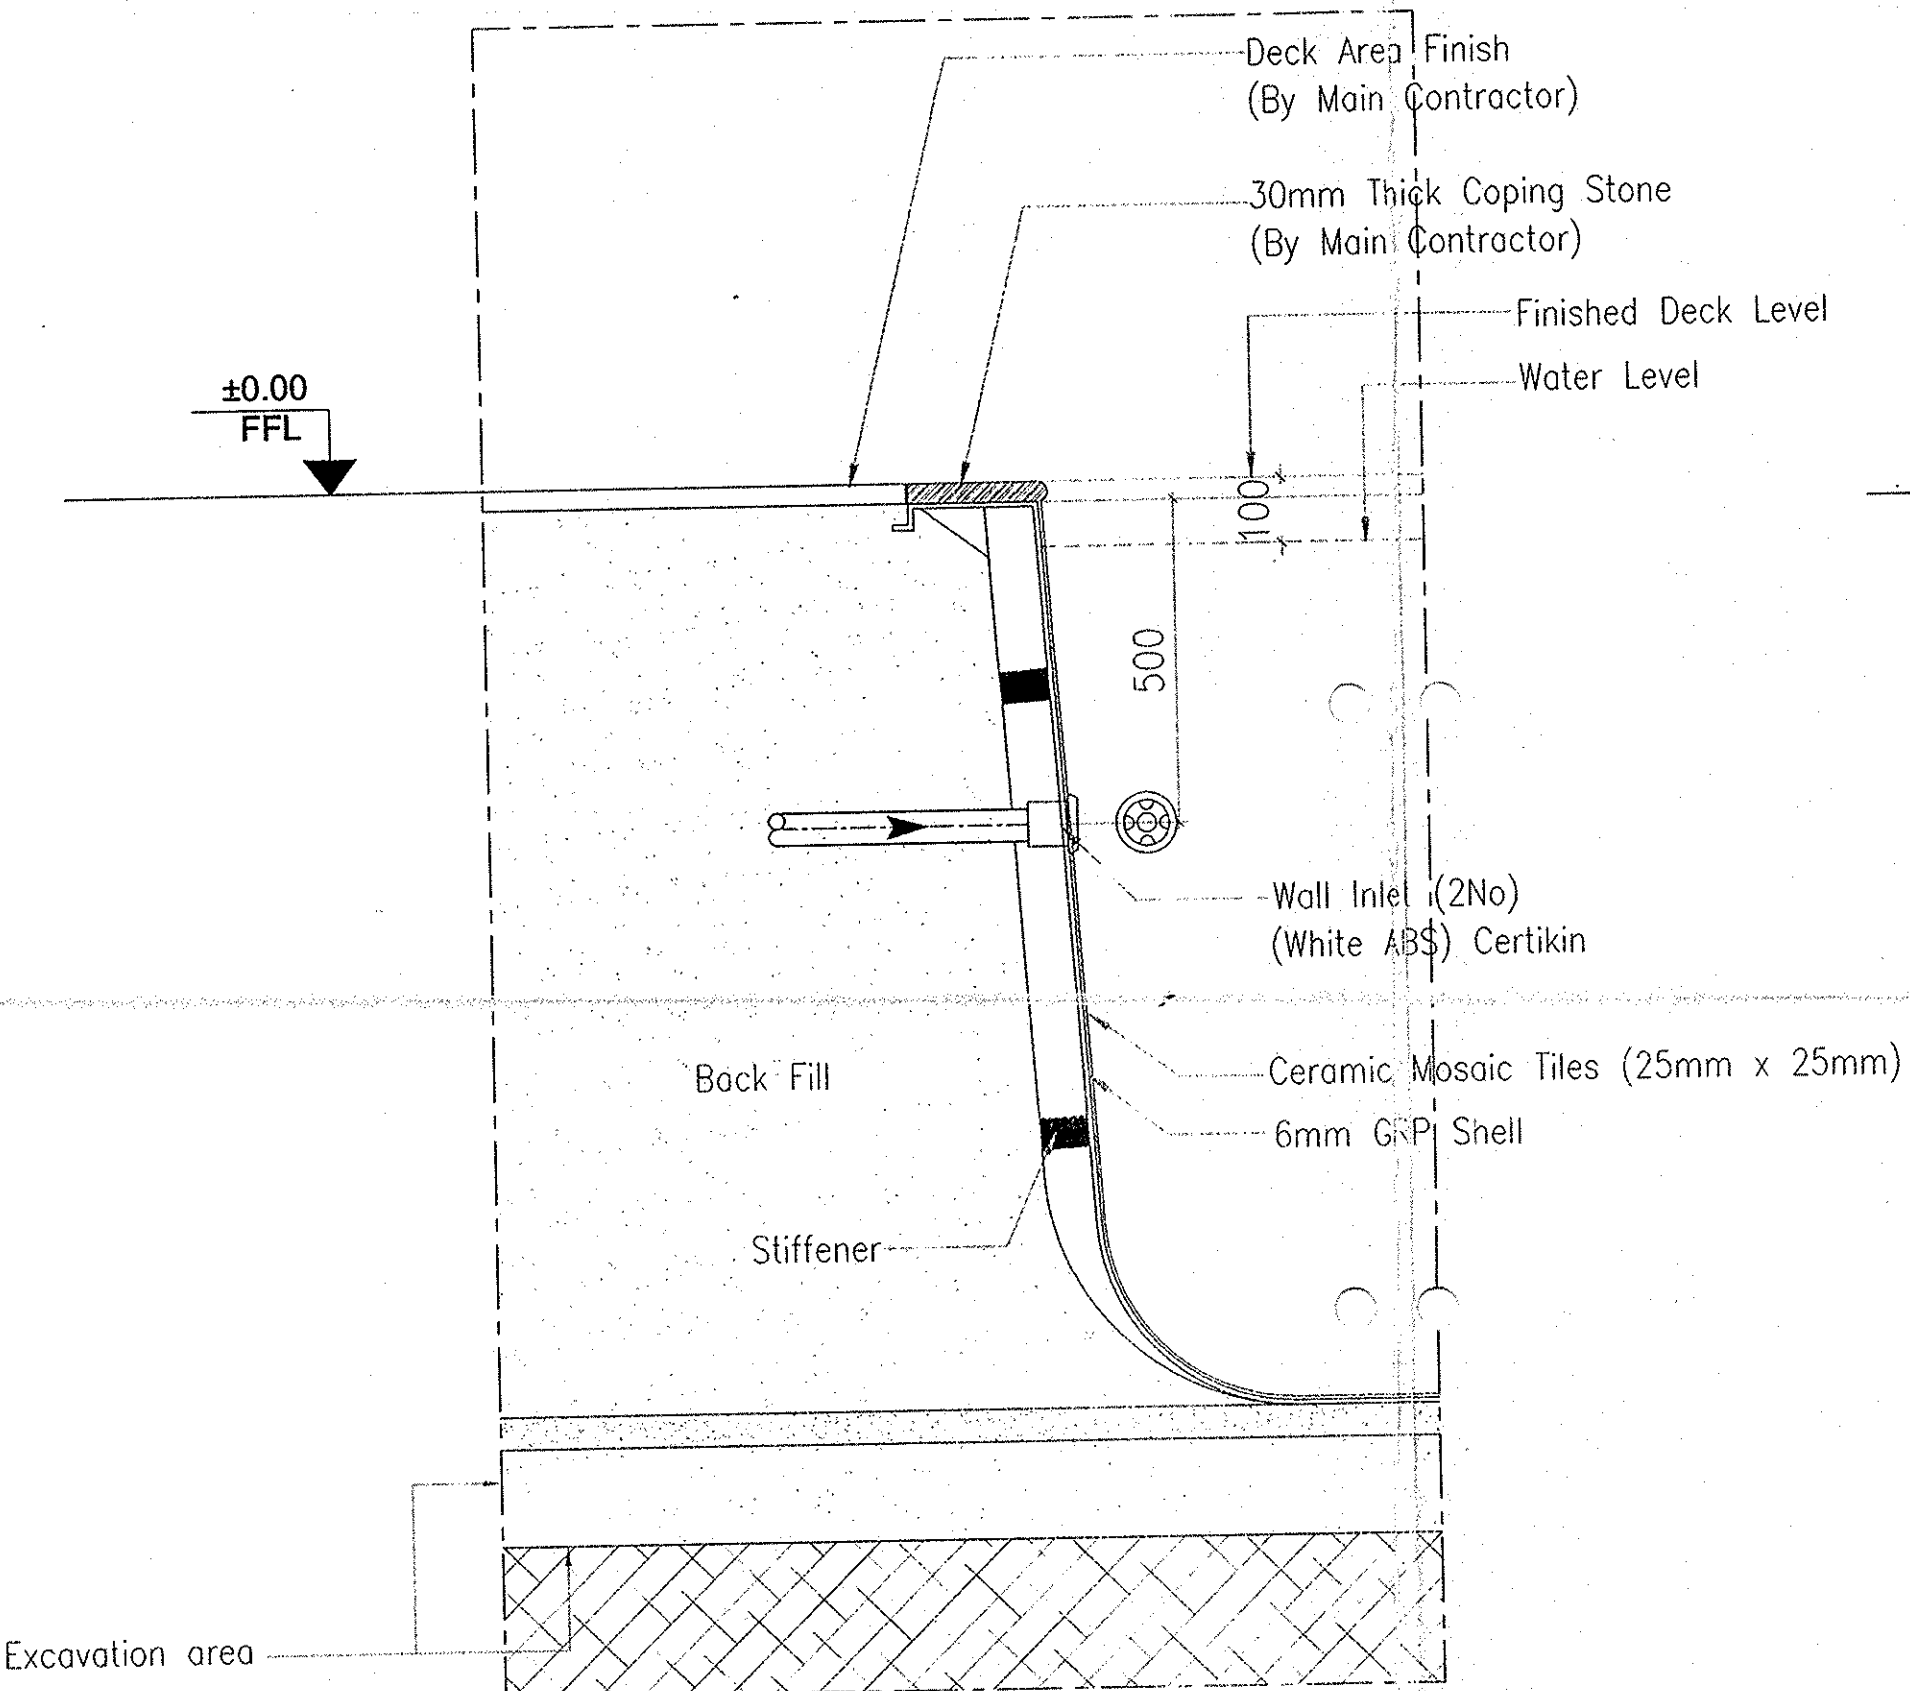


INLET FIXING DETAIL
Scale : 1:2.5

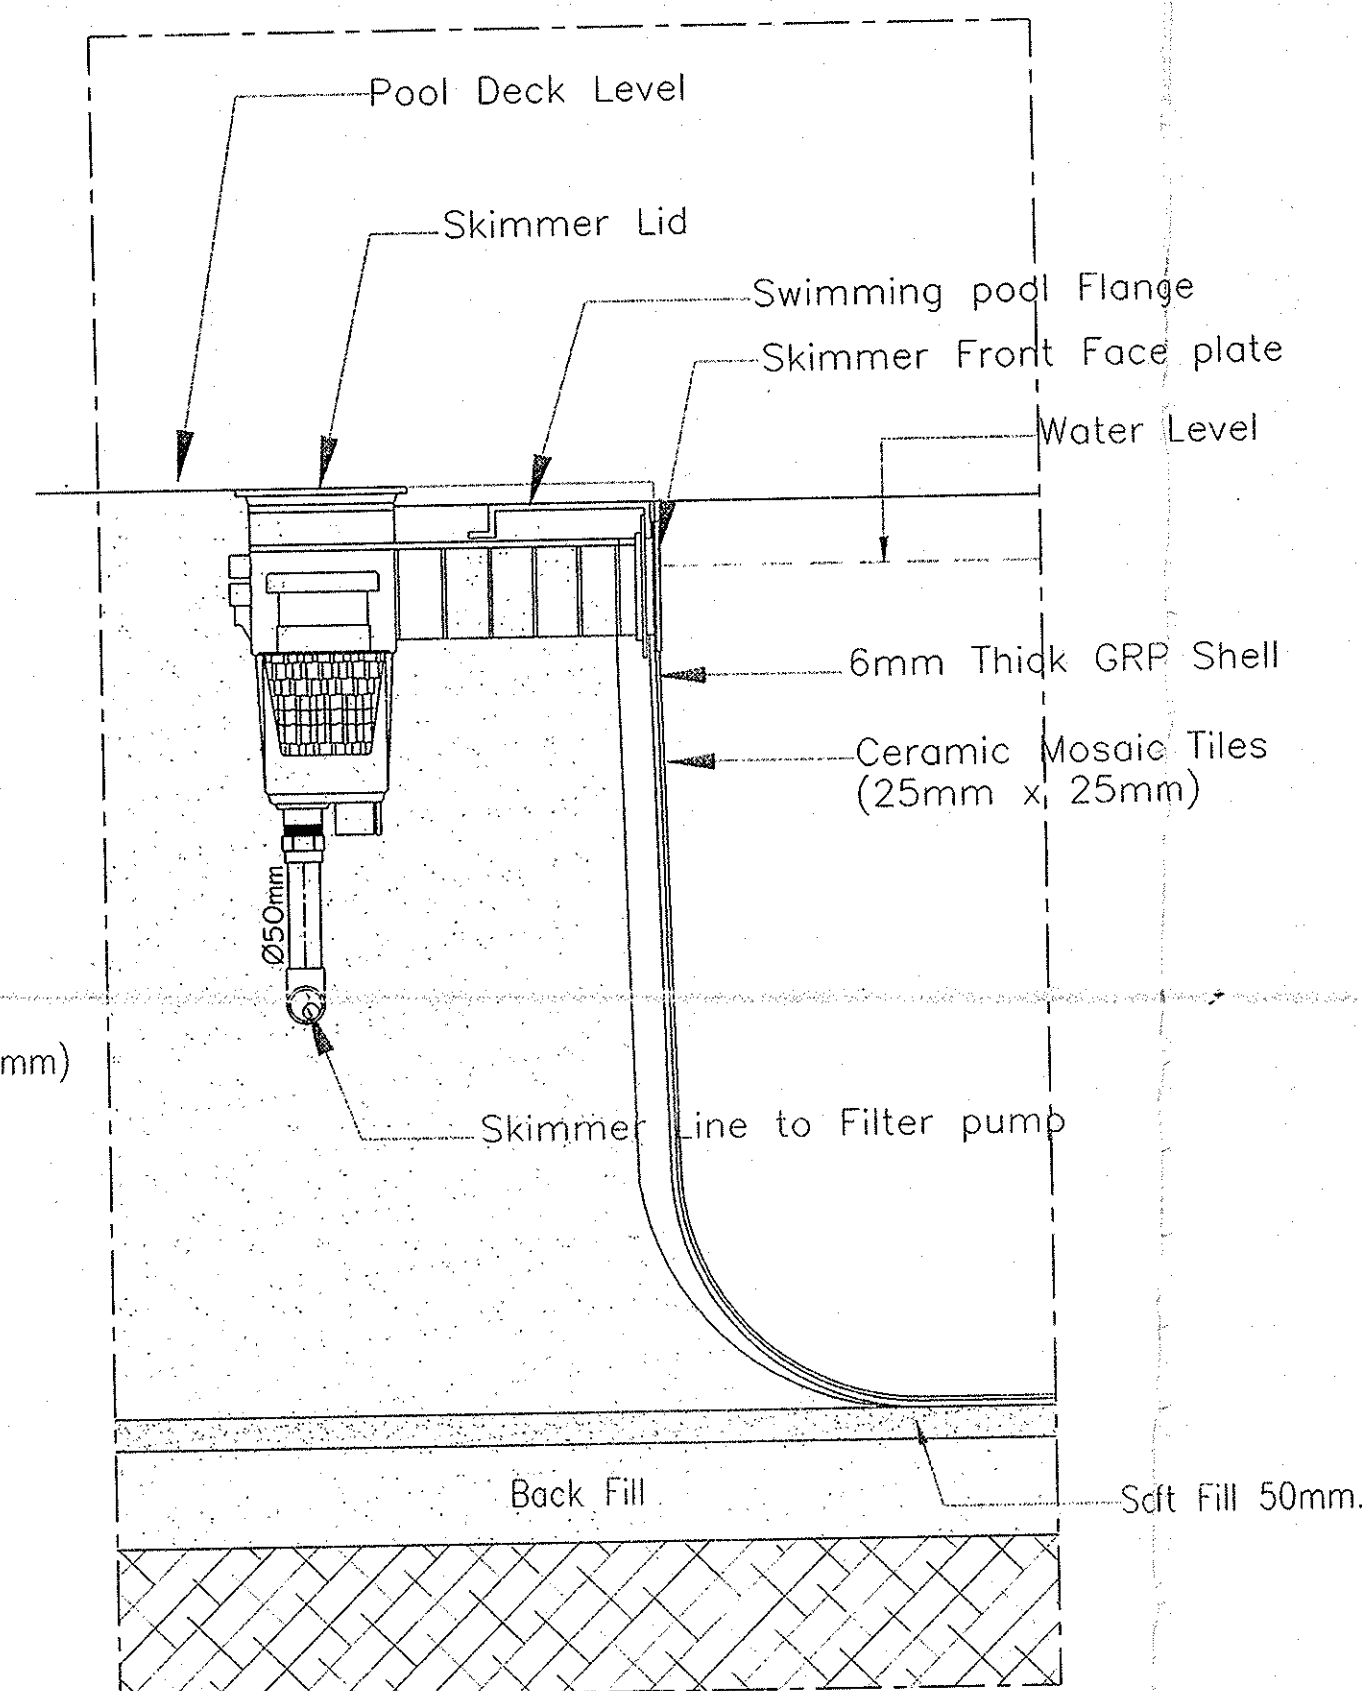

SKIMMER FIXING DETAIL
Scale : 1:2.5

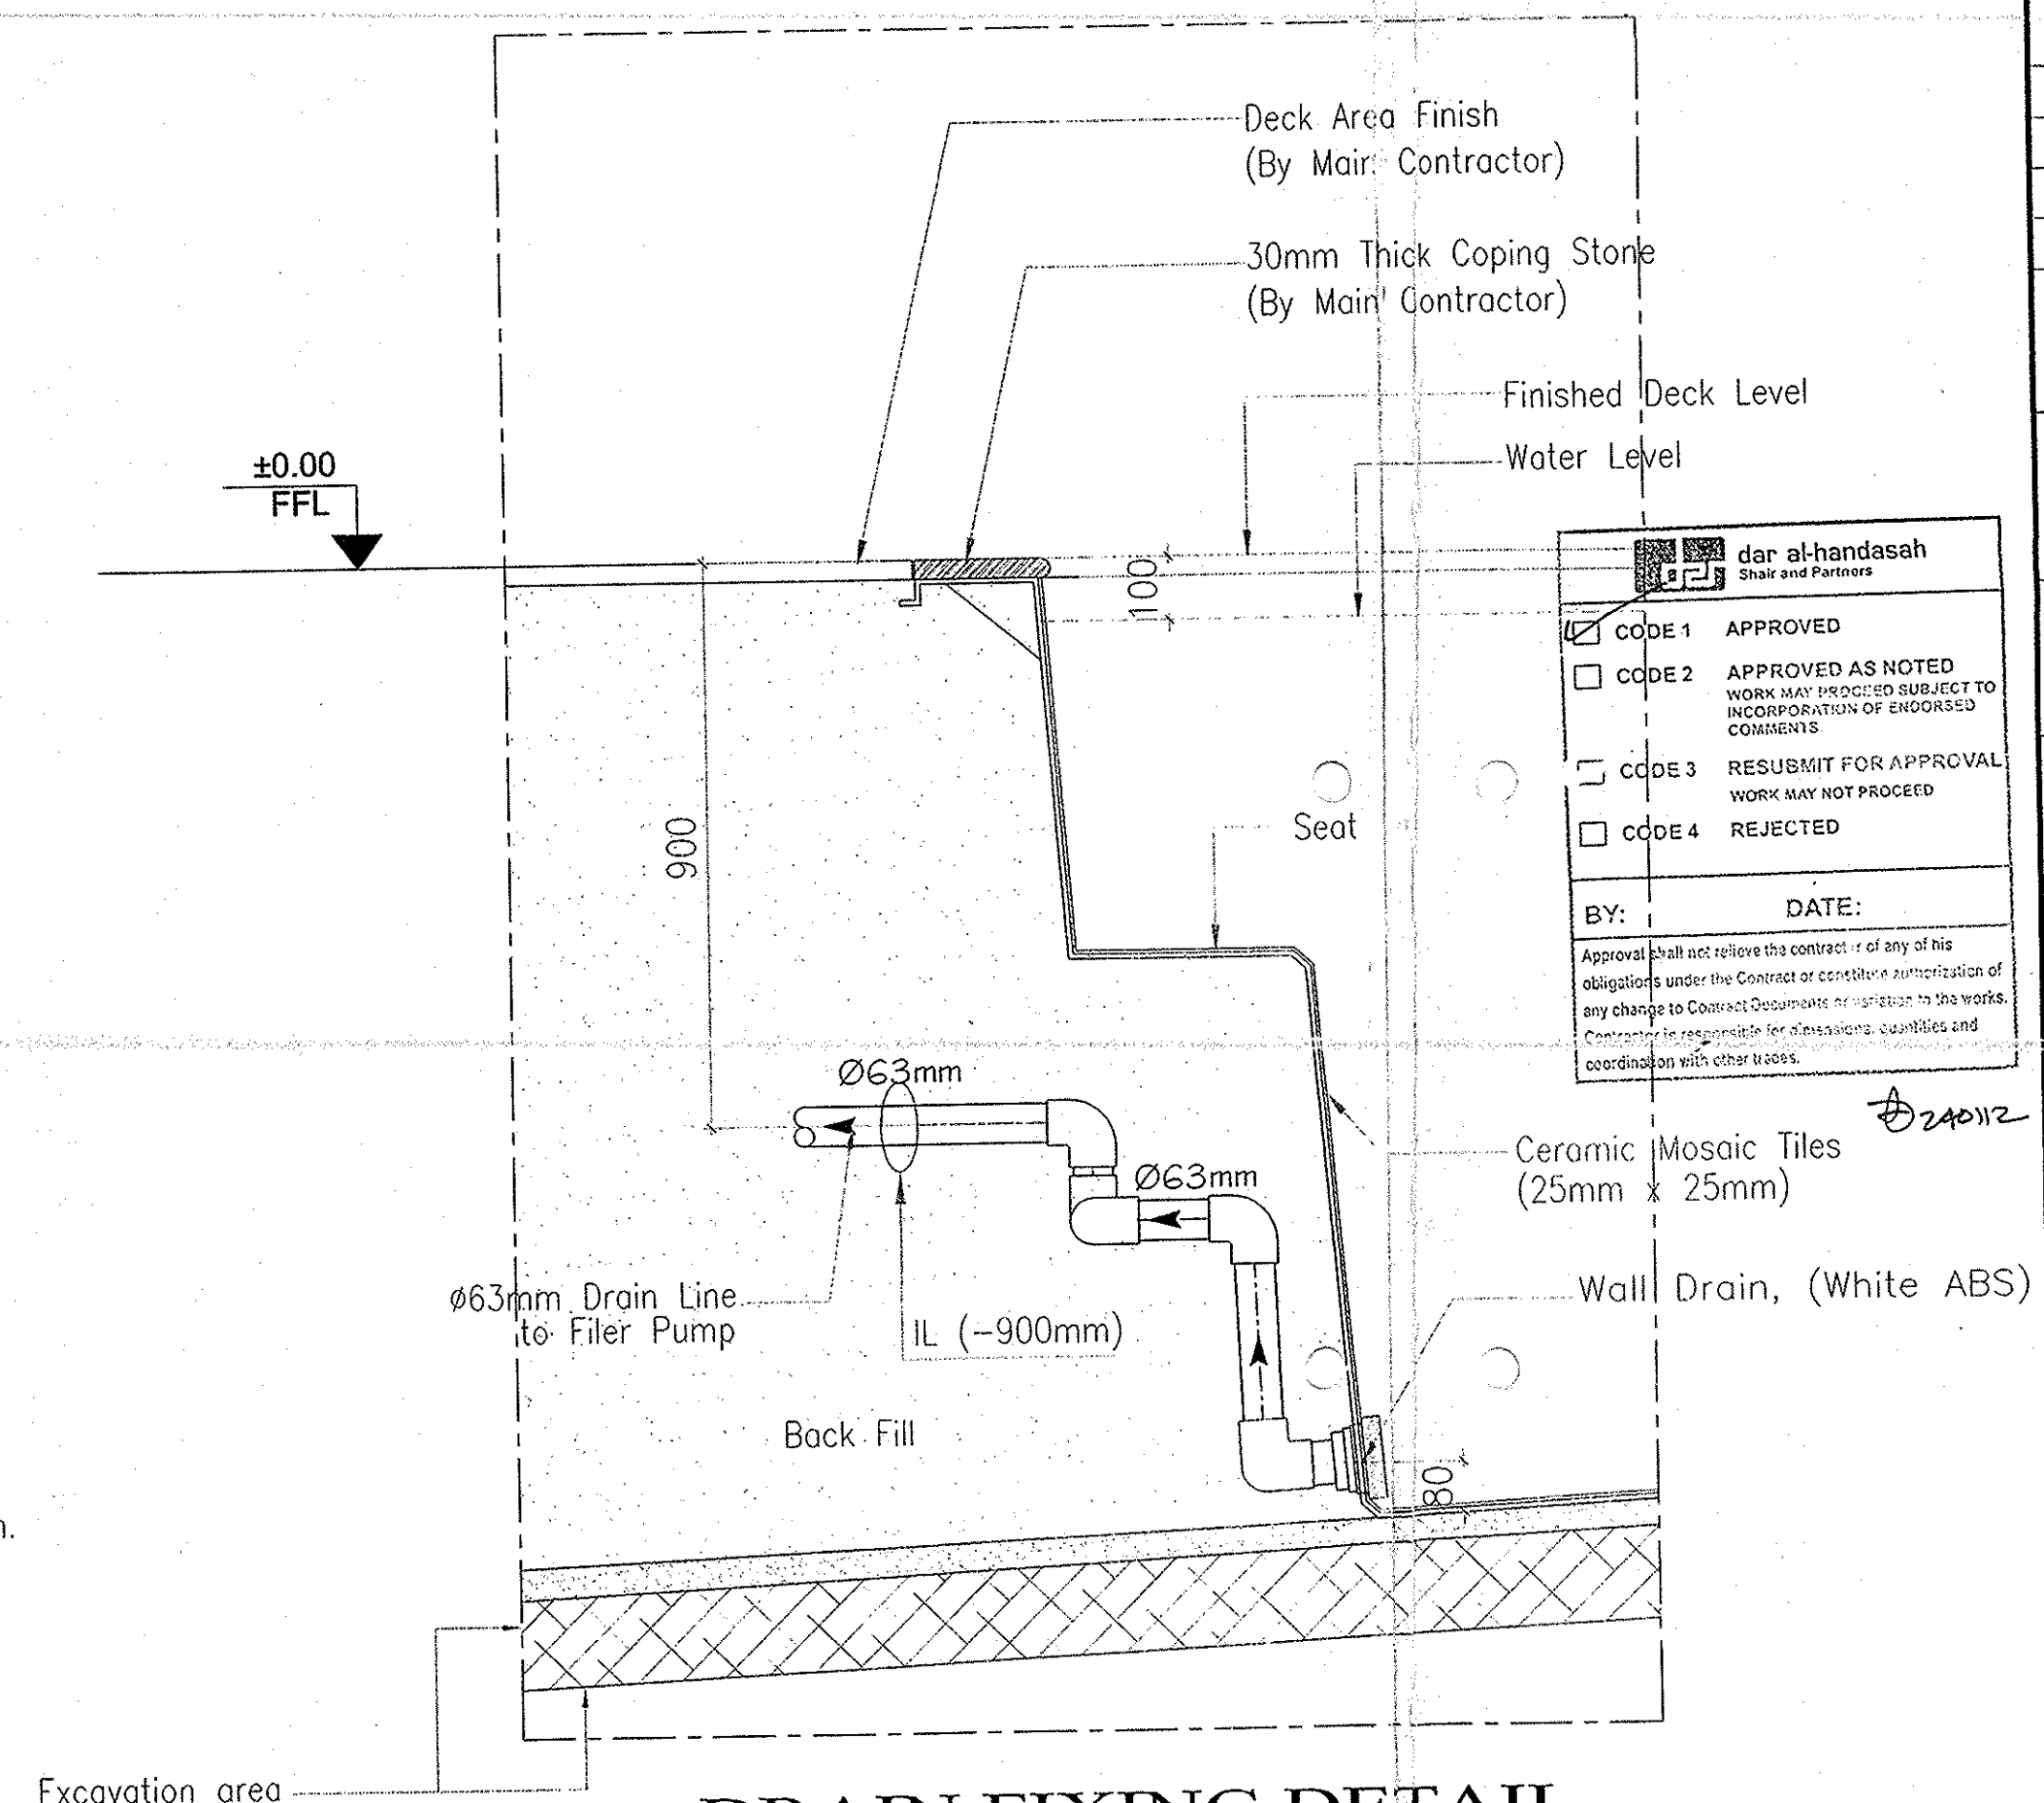

DRAIN FIXING DETAIL
Scale : 1:2.5

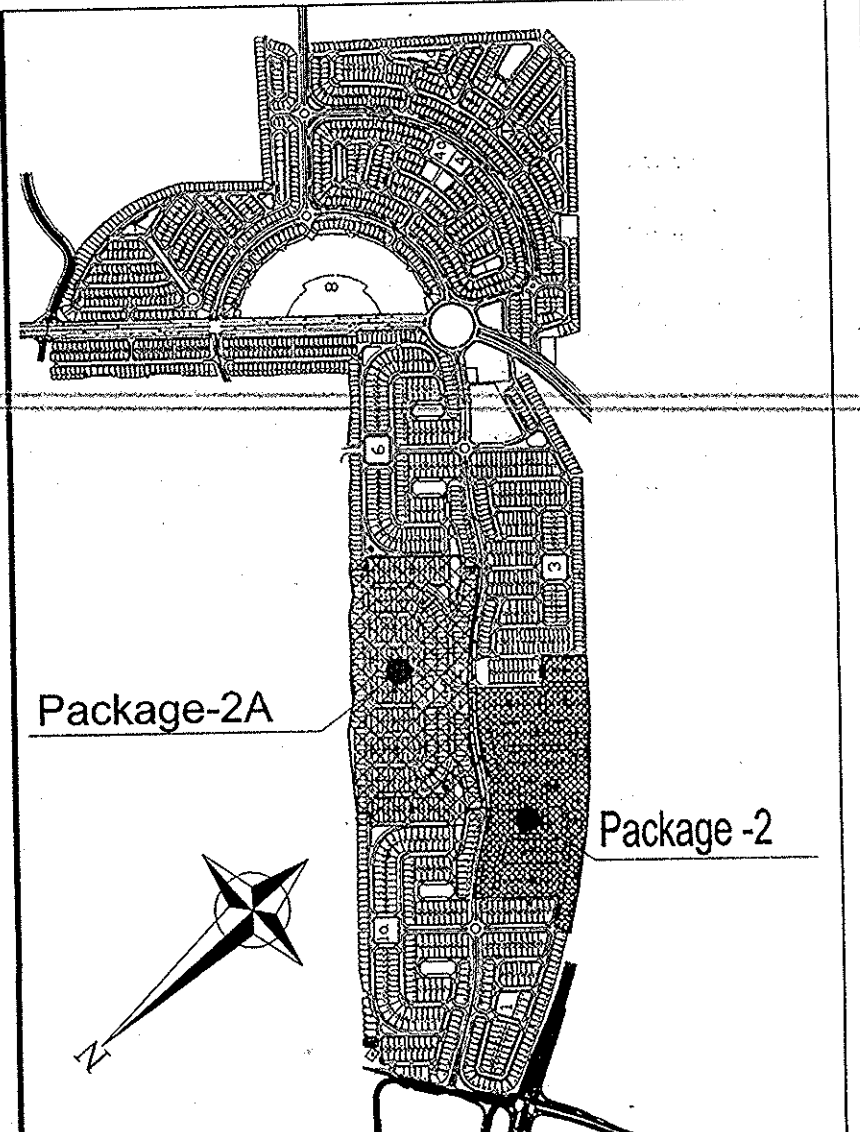

KEY PLAN

NOTES:-

- 1) ALL DIMENSIONS ARE IN MM AND LEVELS ARE METERS UNLESS NOTED OTHERWISE.
- 2) WEATHER PROOF GLANDS RECOMMENDED BY MANUFACTURER HAS BEEN USED TO CONNECT CONTROL PANEL.

Rev.	Date	Description	Drawn	Check
AB	12-01-2012	ISSUED FOR APPROVAL	HAJIRAH	FM/PJ

AS BUILT DRAWING

Project	JUMAIRAH PARK
Employer	NAKHEEL
Consultant	dar al-handasah chair and partners
Main Contractor	Pauling Middle East
Sub Contractor	absolute - pools
Drawing Title	ROMAN POOL / PLANT ROOM SECTION AA, BB & CC Size:- 9m x 4m x 1.1m-1.5m Depth
Drawn	GS
Scale	1:2.5
Date	10-01-2012
Drawing No.	
Rev	AB