


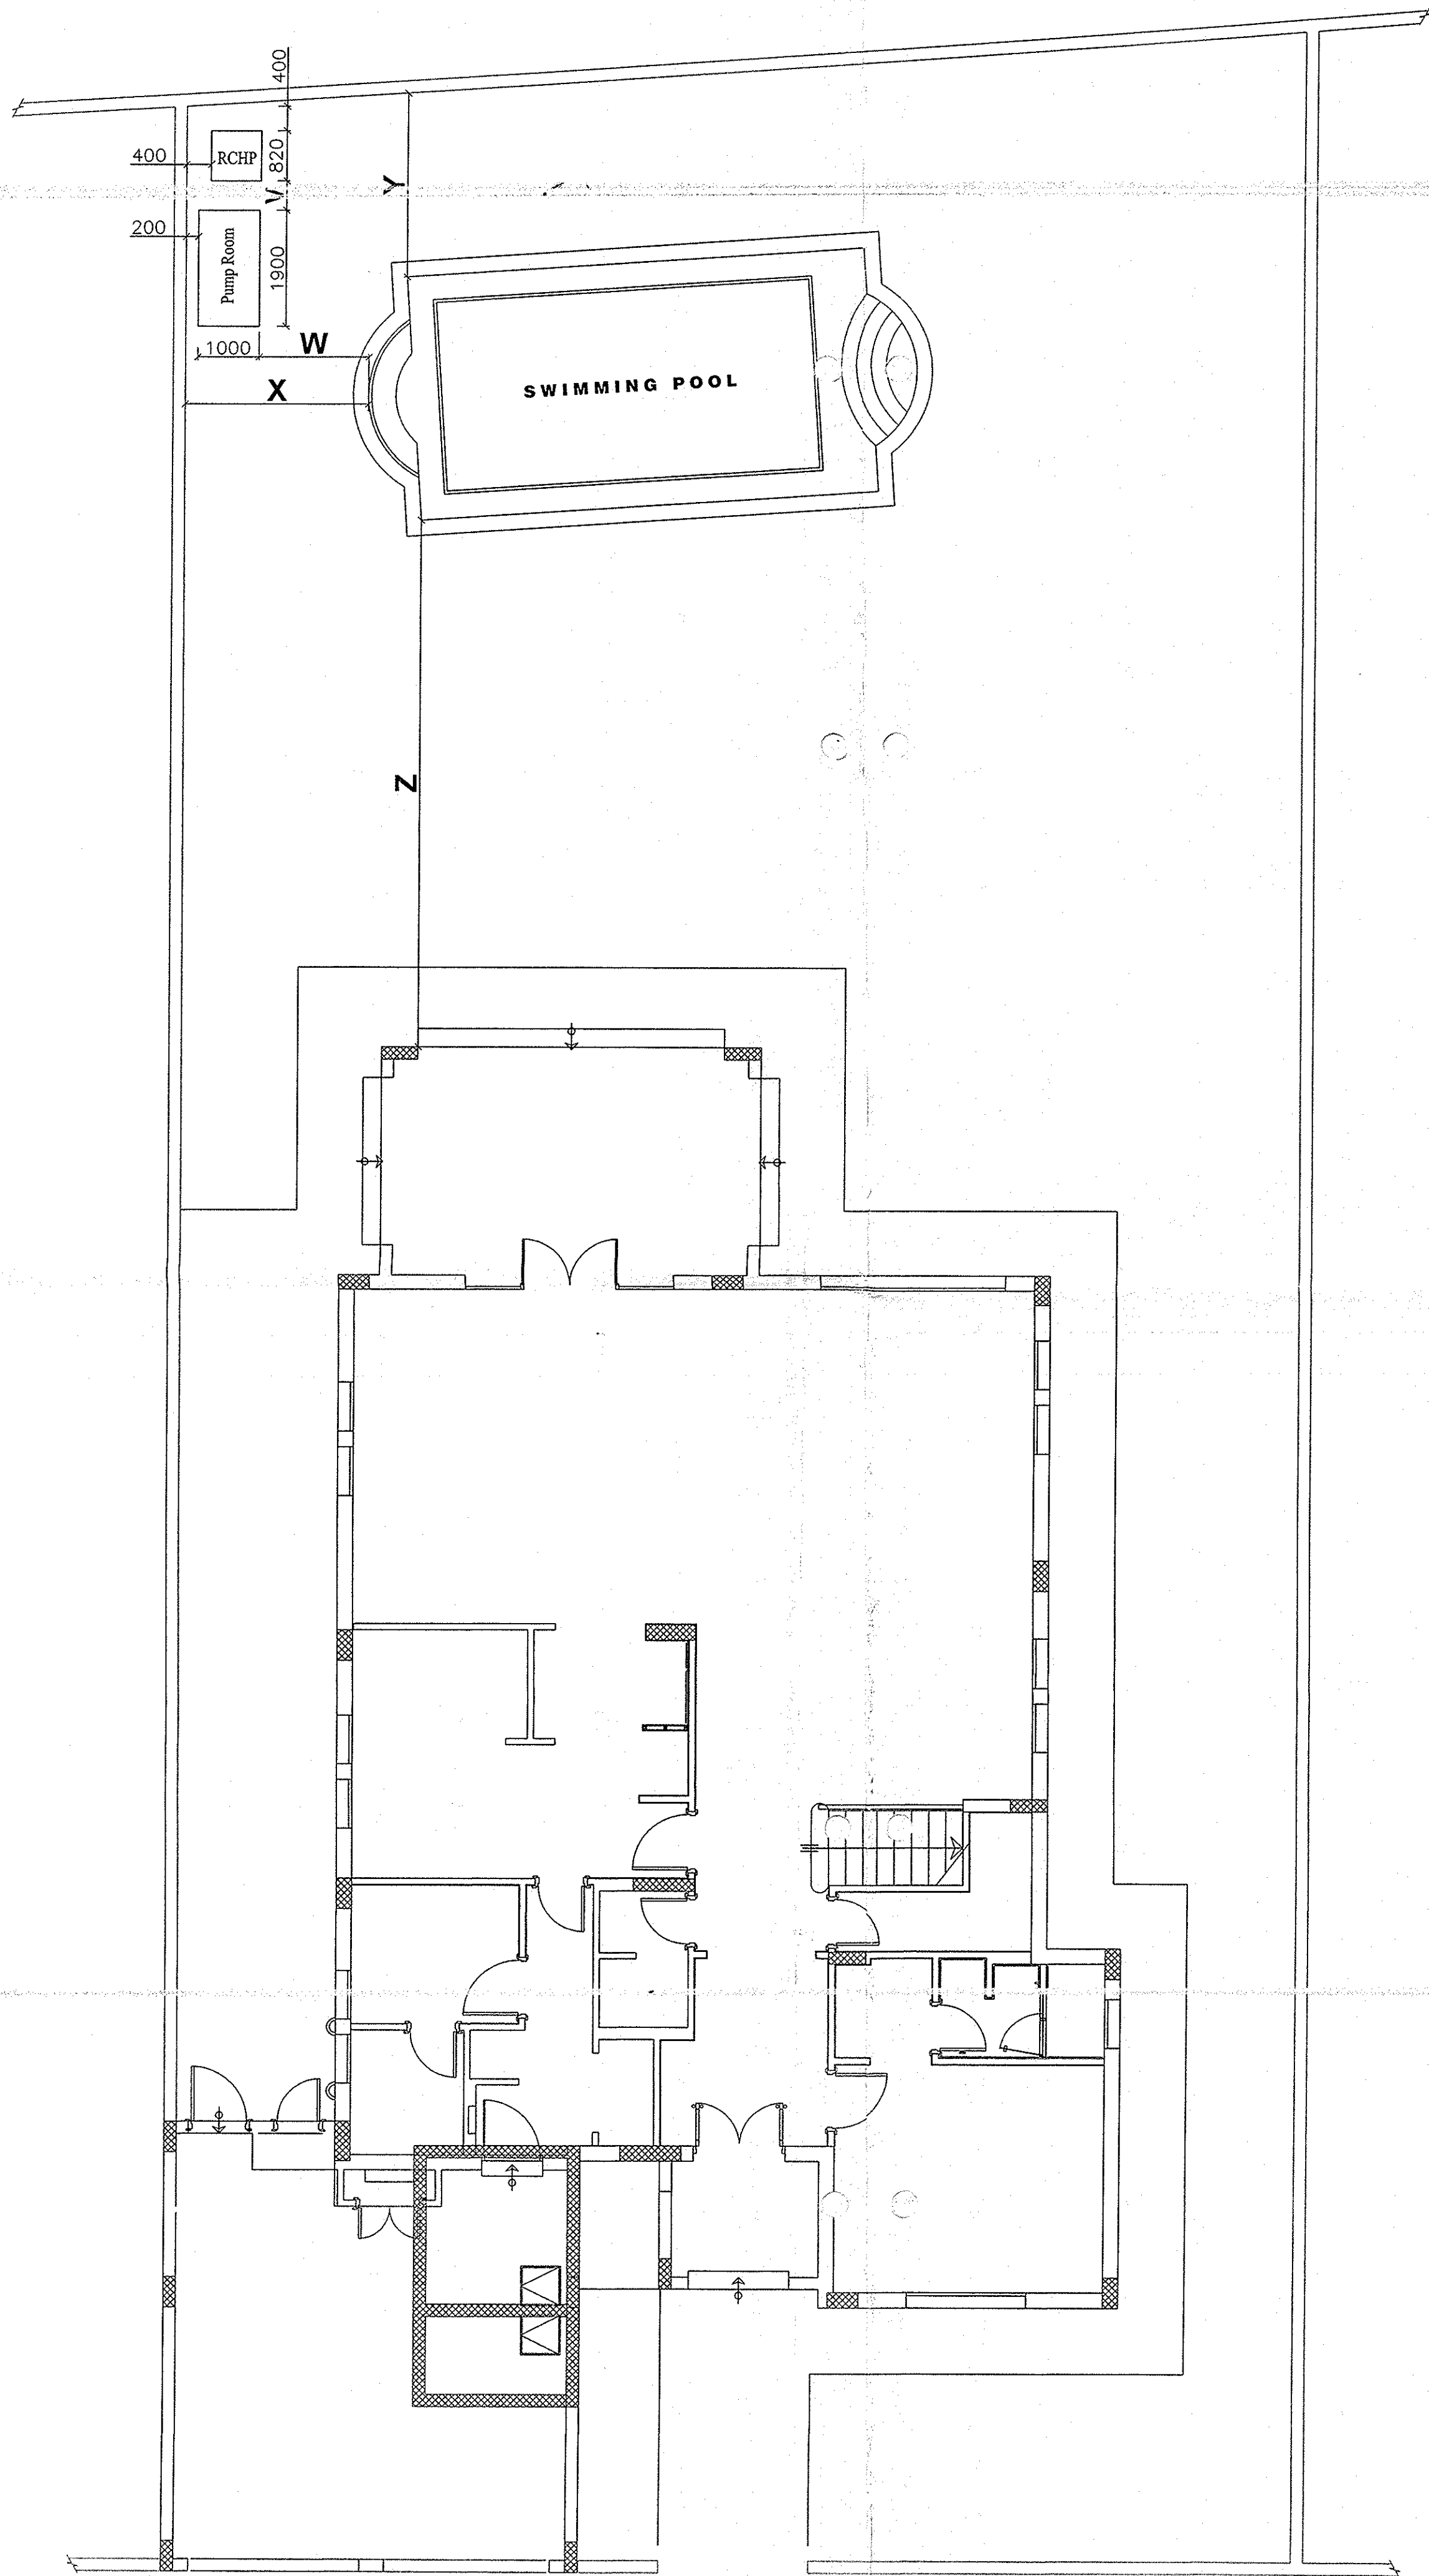

TYPE - 08

Swimming Pool Location Type-8						
Sl.No	Cluster	Villa No.	Length (V)	Length (W)	Length (X)	Length (Y)
1	A4V	1	480	1800	3000	3000
2	A4V	2	480	1800	3000	3000
3	A4V	3	480	1800	1200	1200
4	A4V	6	480	1800	3000	2000
5	A4V	7	480	1800	3000	3000
6	A4V	8	480	1800	3000	3000
7	A4V	9	480	1800	3000	3000
8	A4V	10	480	1800	3000	3000
9	A4V	11	480	1800	3000	3000
10	A4V	12	480	1800	3000	3000
11	A4V	13	480	1800	3000	3000
12	A4V	14	480	1800	3000	3000
13	A4V	15	480	1800	3000	3000
14	A4V	16	480	1800	3000	3000
15	A4V	17	480	1800	3000	3000
16	A4V	18	480	1800	3000	3000
17	A4V	19	480	1800	3000	3000
18	A4V	20	480	1800	3000	3000
19	A4V	21	480	1800	3000	3000
20	A4V	22	480	1800	3000	3000
21	A4V	23	480	1800	3000	3000
22	A4V	24	480	1800	3000	3000
23	A4V	25	480	1800	3000	3000
24	A4V	26	480	1800	3000	3000
25	A4V	27	480	1800	3000	3000
26	A4V	28			3000	3000
27	A4V	29	480	1800	3000	3000
28	A4V	30	480	1800	3000	3000
29	A4V	31	480	1800	3000	3000
30	A4V	32	480	1800	3000	3000
31	A4V	33	480	1800	3000	3000
32	A4V	34	480	1800	3000	3000
33	A4V	35	480	1800	3000	3000
34	A4V	36	480	1800	3000	3000
35	A4V	37	480	1800	3000	3000
36	A4V	38	480	1800	3000	3000
37	A4V	39	480	3900	3000	3000
38	G4V	1	480	1800	3000	3000
39	G4V	2	480	1800	3000	3000
40	G4V	3	480	1800	3000	3000
41	G4V	4	480	1800	3000	3000
42	G4V	5	480	1800	3000	3000
43	G4V	6	480	1800	3000	3000
44	G4V	7	480	1800	3000	3000
45	G4V	8	480	1800	3000	3000
46	G4V	9	480	1800	3000	3000
47	G4V	10	480	1800	3000	3000
48	G4V	11	480	1800	3000	3000
49	G4V	12	480	1800	3000	3000
50	G4V	13	480	1800	3000	3000
51	G4V	14	480	1800	3000	3000
52	G4V	15	480	1800	3000	3000
53	G4V	16	480	1800	3000	3000
54	G4V	17	480	1800	3000	3000


Built up Area as per Original Building Permit = 471.00 M²
Added Built up Area for Swimming Pool as per the Amended B.P = 40.30 M²
TOTAL BUILT UP AREA = 511.30 M²

AREA DETAILS	
BUILT UP AREA OF VILLA	= 431.51 M ²
BUILT UP AREA OF UNDER GROUND WATER TANK	= 10.49 M ²
BUILT UP AREA OF SWIMMING POOL	= 40.30 M ²
BUILT UP AREA OF PLANT ROOM (G.R.P)	= 1.90 M ²
BUILT UP AREA OF RCHP	= 0.67 M ²
Heat / Cool Pump Over 65cm Concrete Base)	
TOTAL BUILT UP AREA	= 484.87 M ²



CODE 1	APPROVED
CODE 2	APPROVED AS NOTED
CODE 3	REQUIREMENT FOR APPROVAL
CODE 4	REJECTED

BY: DATE: 15/3/2012

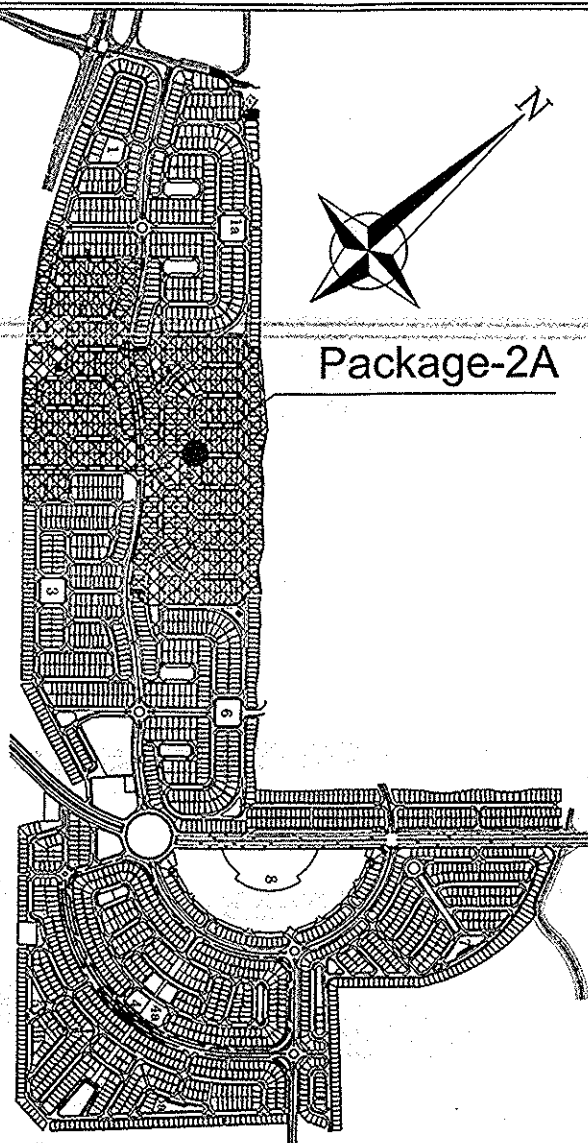

Package-2A

KEY PLAN

☐	A	APPROVED
☐	B	APPROVED AS NOTED
☐	C	NOT APPROVED
☐	D	INFORMATION


Name & Position	Signature	Date
-----------------	-----------	------

Disclaimer:
This approval does not release the contractor from his responsibility on the content of this drawing

NOTES:-
1) ALL DIMENSIONS ARE IN MM AND LEVELS ARE METERS UNLESS NOTED OTHERWISE.

AB	23.02.2012	ISSUED FOR APPROVAL	GS	RDL
Rev.	Date	Description	Drawn	Check

AS BUILT DRAWING

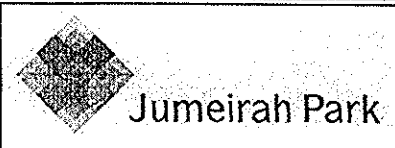

Project



NAKHEEL

Employer

P.O. BOX: 13777, DUBAI, U.A.E.
PHONE: +971 4 3363333
FAX: +971 4 3363333
Website: www.nakheel.ae
E-MAIL: info@nakheel.ae



dar al-handasah
shair and partners

Consultant

P.O. BOX: 35424, DUBAI, U.A.E.
PHONE: +971 4 3333333
FAX: +971 4 3333333
Website: www.daralhandasah.com



Pauling Middle East

Main Contractor

P.O. BOX: 45176, ABU DHABI, U.A.E.
PHONE: +971 2 4555555
FAX: +971 2 4555555
E-MAIL: pauling@pauling.ae

PACKAGE - 2A

absolute - pools

Sub Contractor

"The pool for the home owner"

P.O. BOX: 46880, DUBAI, U.A.E.
TEL: +971 4 3393155
FAX: +971 4 3395973
e-mail: info@absolute-pools.com

Drawing Title

ROMAN POOL- SWIMMING POOL
SETTING OUT FOR ALL VILLAS
Size:- 9m x 4m x 1.1m - 1.5m Depth

Drawn: MF	Revise: RDL	Check: FM/PJ
Scale: 1:50@A0	Date: 29.01.2012	Approved:

Drg. No.:AP/PME/JP/RM/26-H

REV

AB