
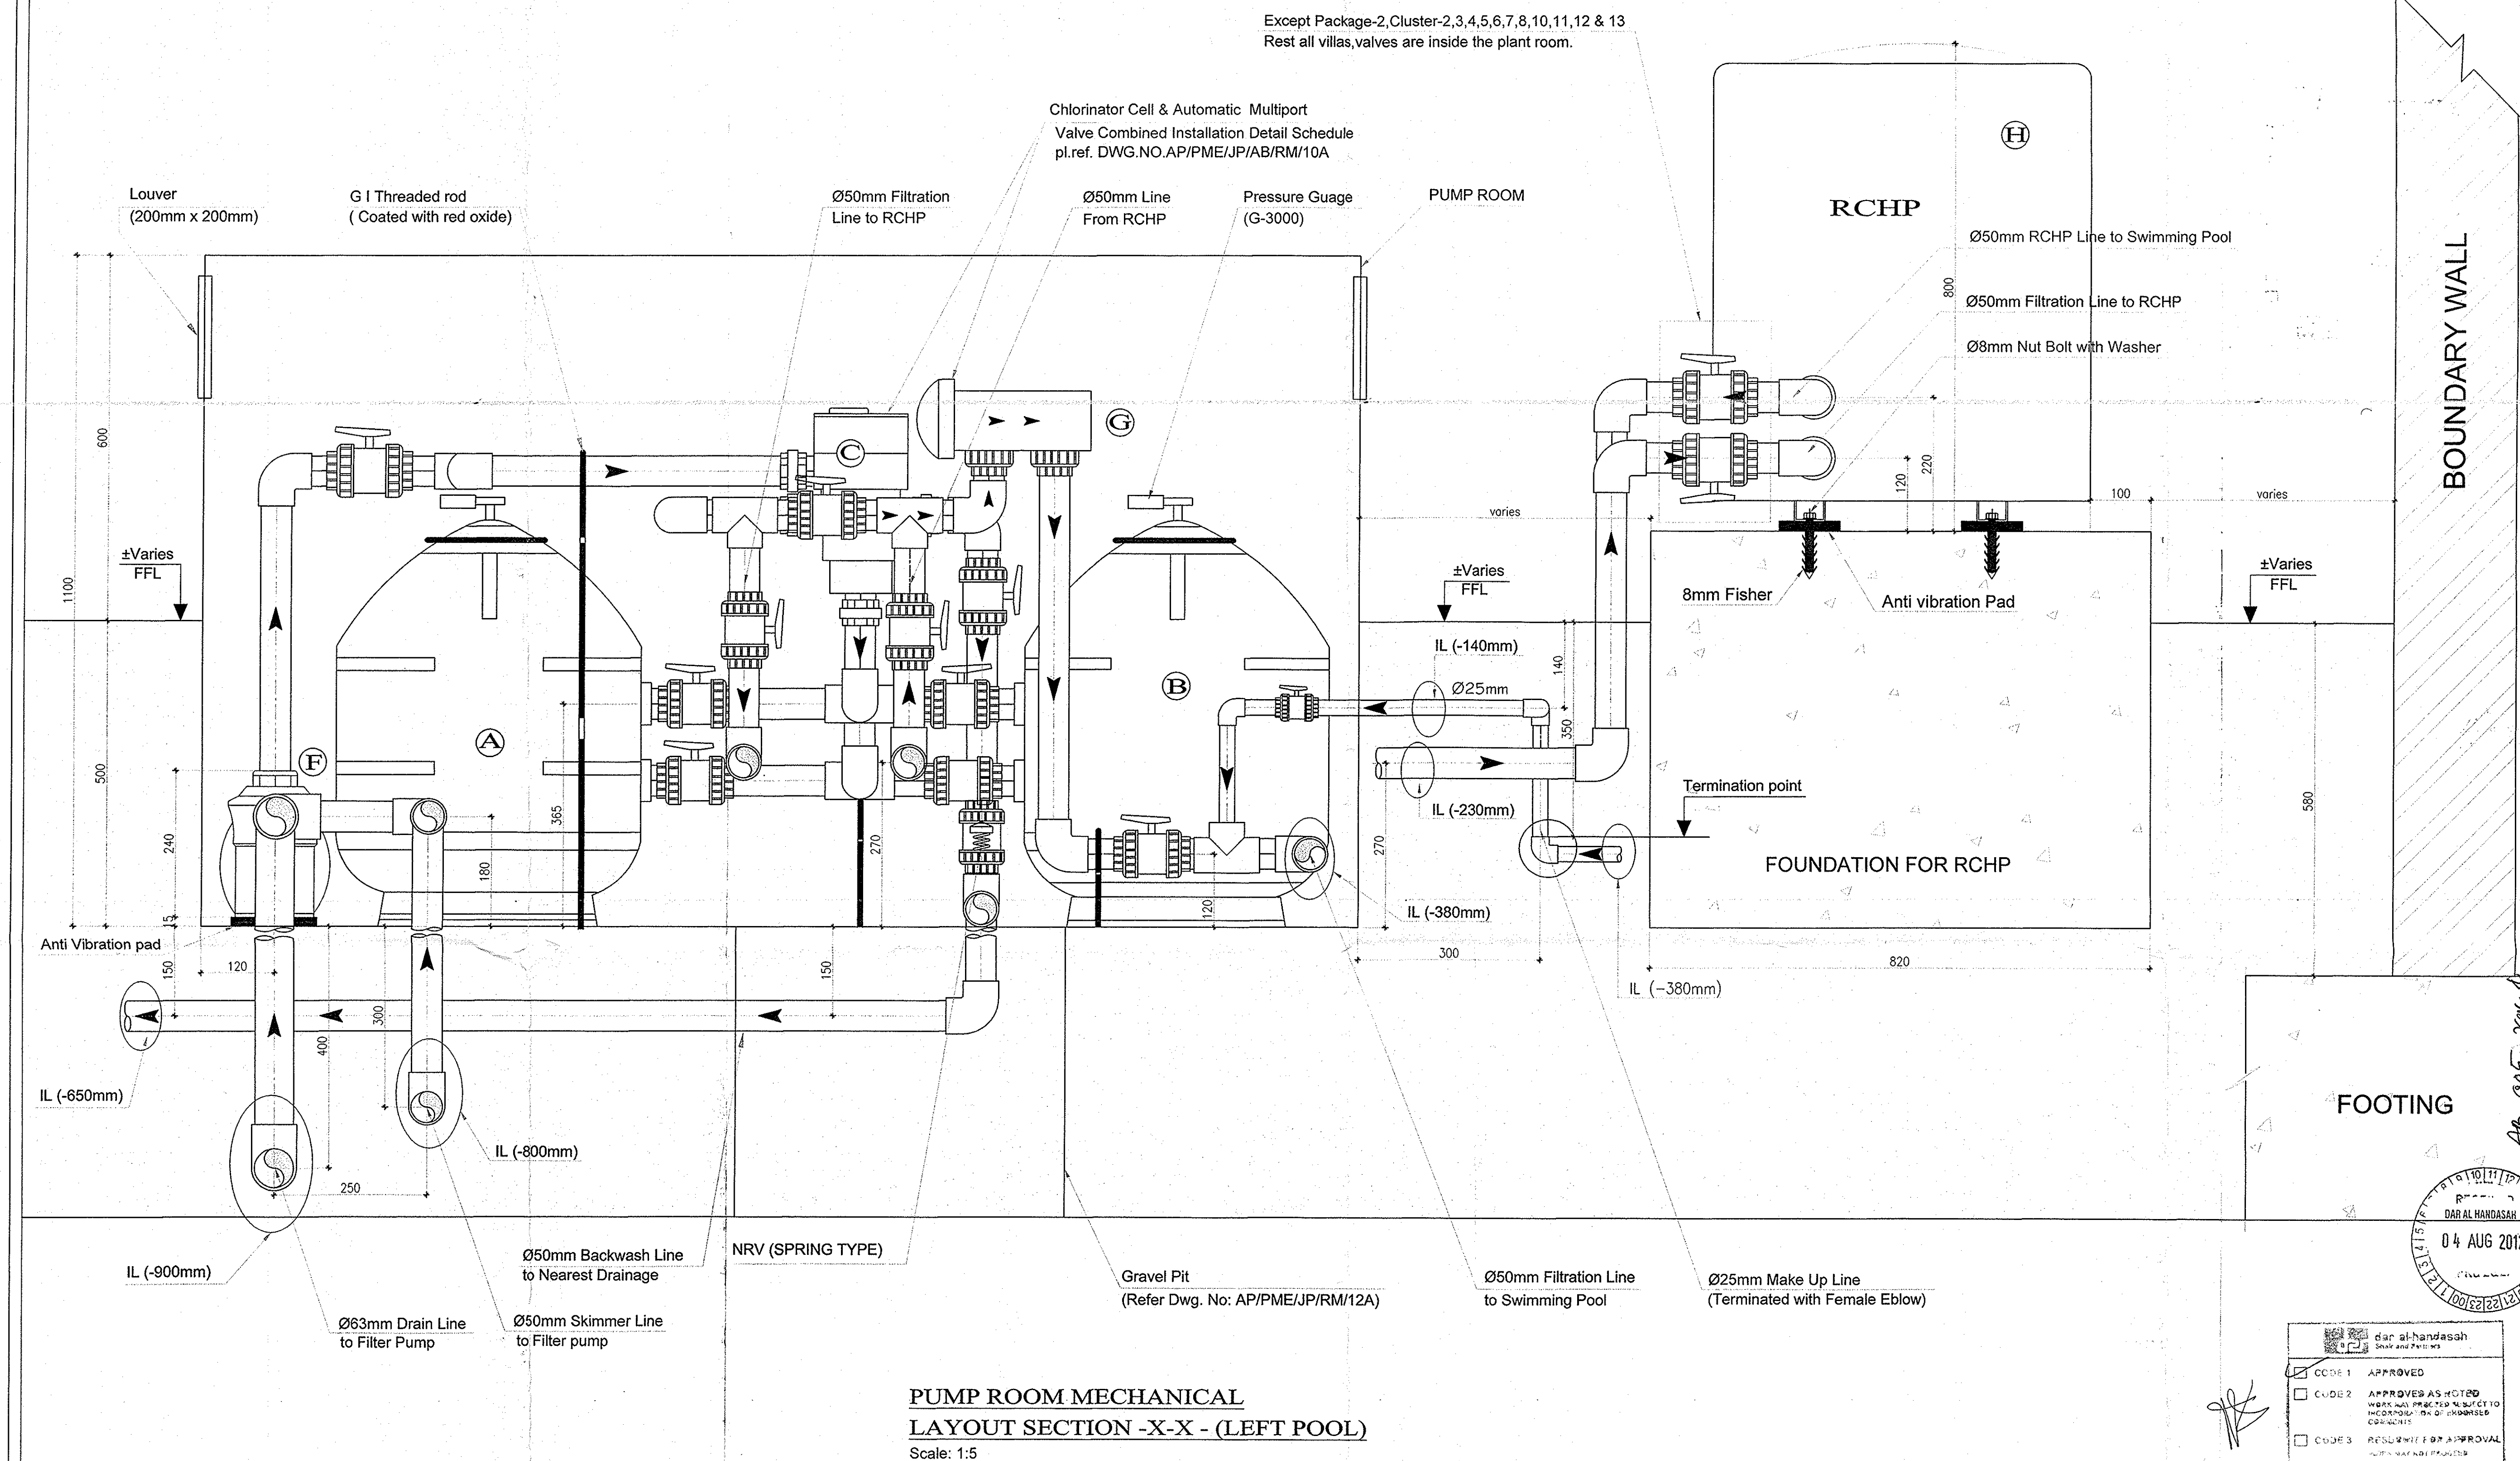


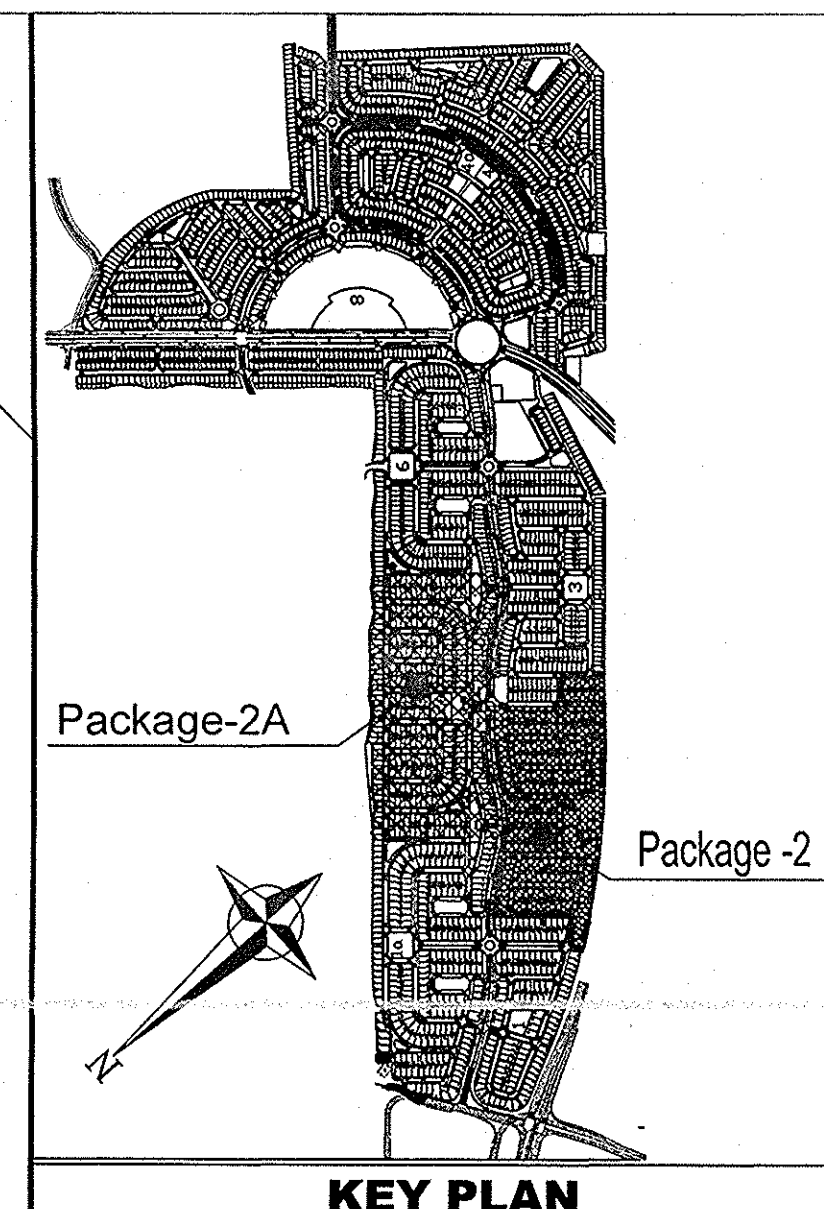

LEGEND	EQUIPMENT	QTY	MAKE/MODEL
A	SAND FILTER Ø500mm (DUTY) W/ Pressure Gauge	1	CERTIKIN (ZZFBS500), (G-3000)
B	SAND FILTER Ø500mm (STAND BY) W/ Pressure Gauge	1	CERTIKIN (ZZFBS500), (G-3000)
C	AUTOMATIC MULTI PORT VALVE (Two types)	1	PRAHAR AQUASTAR easy 1000) / MPVA/15
D	SALT CHLORINATOR (Control Unit)	1	CERTIKIN (SALT EXPERT - 46051)

LEGEND	EQUIPMENT	QTY	MAKE/MODEL
E	CONTROL PANEL W/ TRANSFORMER	1	CP-33PS-CERTIKIN
F	0.75 HP DUTY FILTER PUMP	1	CERTIKIN HKV071
G	CHLORINATOR CELL (Two types)	1	CERTIKIN (SALT EXPERT - 46051) With 4 Electrode Plates
H	FLOOR DRAIN	1	PVC (White ABS) Approved
I	Reverse Cycle Heat Pump (RCHP)	1	SBM 600C (Certikin) BTU/H - 43000 (Two capacities) BTU/H - 47000

AB3	25.07.12	ISSUED FOR APPROVAL	VJ	RDL
AB2	25.06.12	ISSUED FOR APPROVAL	GS	RDL
AB1	22.02.12	ISSUED FOR APPROVAL	GS	RDL
AB	12.01.12	ISSUED FOR APPROVAL	GS	RDL
Rev.	Date	Description	Drawn	Check