
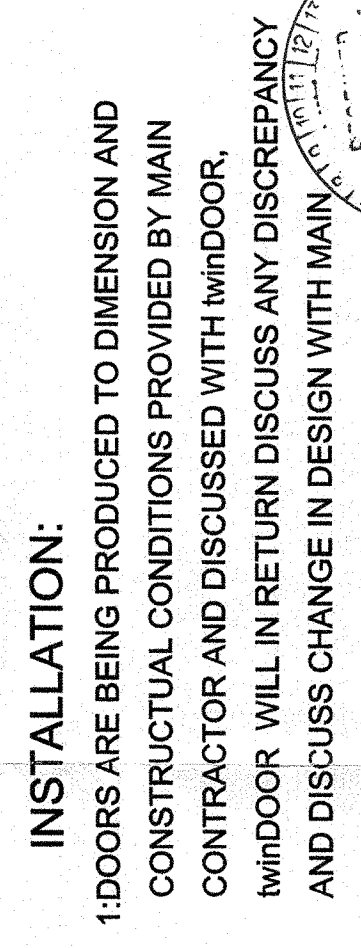
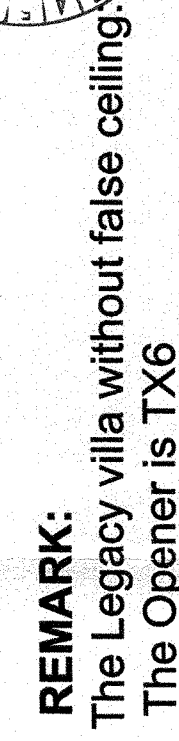
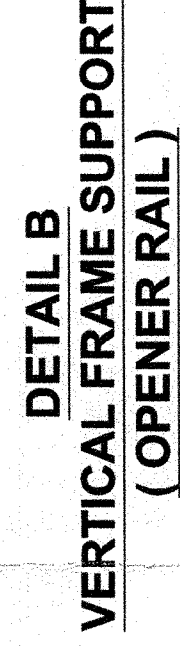
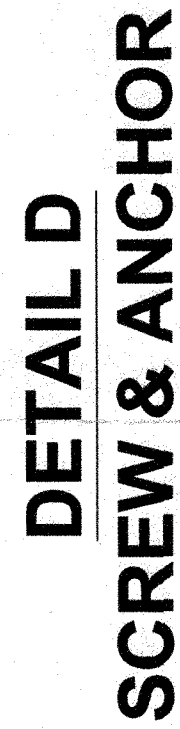
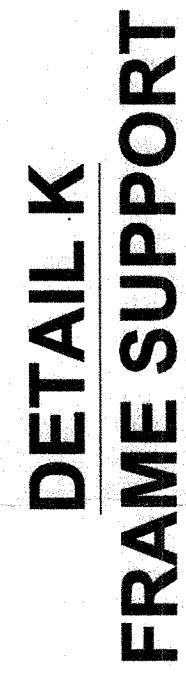
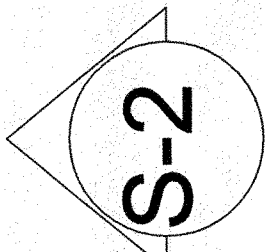
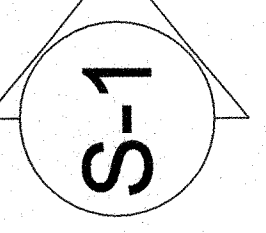


AS BUILT DRAWING

1	rev.4	14 /08 /2012
S/N.	DESCRIPTION/ISSUE	DATE
PROJECT		

JUMEIRAH PARK 2 & 2A

CLIENT

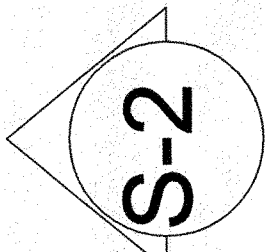

NAKHEEL

P.O. BOX : 17777, DUBAI, U.A.E.
PHONE : + 971 - 4 - 3903388
FAX : + 971 - 4 - 3903335
WebSite : www.nakheel.ae
E - MAIL : info@nakheel.ae


CONSULTANT



dar al-handasah
shair and partners


P.O. BOX : 55624, DUBAI, U.A.E.
PHONE : + 971 - 4 - 335502
FAX : + 971 - 4 - 33353121
www.darcgroup.com

MAIN CONTRACTOR

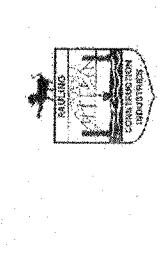

PAULING MIDDLE EAST CO. L.L.C.

SUB CONTRACTOR

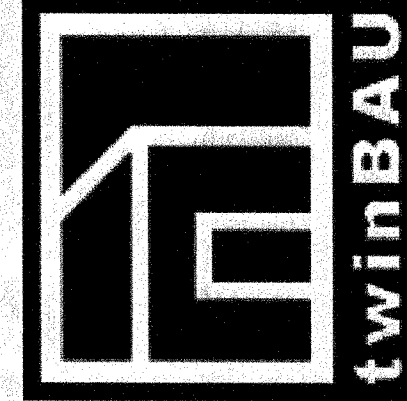

**twinBAU Building
Materials Trading**

PHONE : + 971 - 4 - 3415898
FAX : + 971 - 4 - 3415899
E-MAIL : twinbau@twindoor.eu

DRAWING TITLE
SECTIONAL OVERHEAD GARAGE DOOR
(LEGACY VILLAS WHTOUT FALSE CEILING)

AS FLEX LINK 1
THE OPENER IS TX6)

DRAWN

DRAWN

REV.

REV.

DRAWING NO.

PME/JP/AB/
80170002 2800/2

DOOR SUPPLIER
8017000Z-Z300/Z300

