




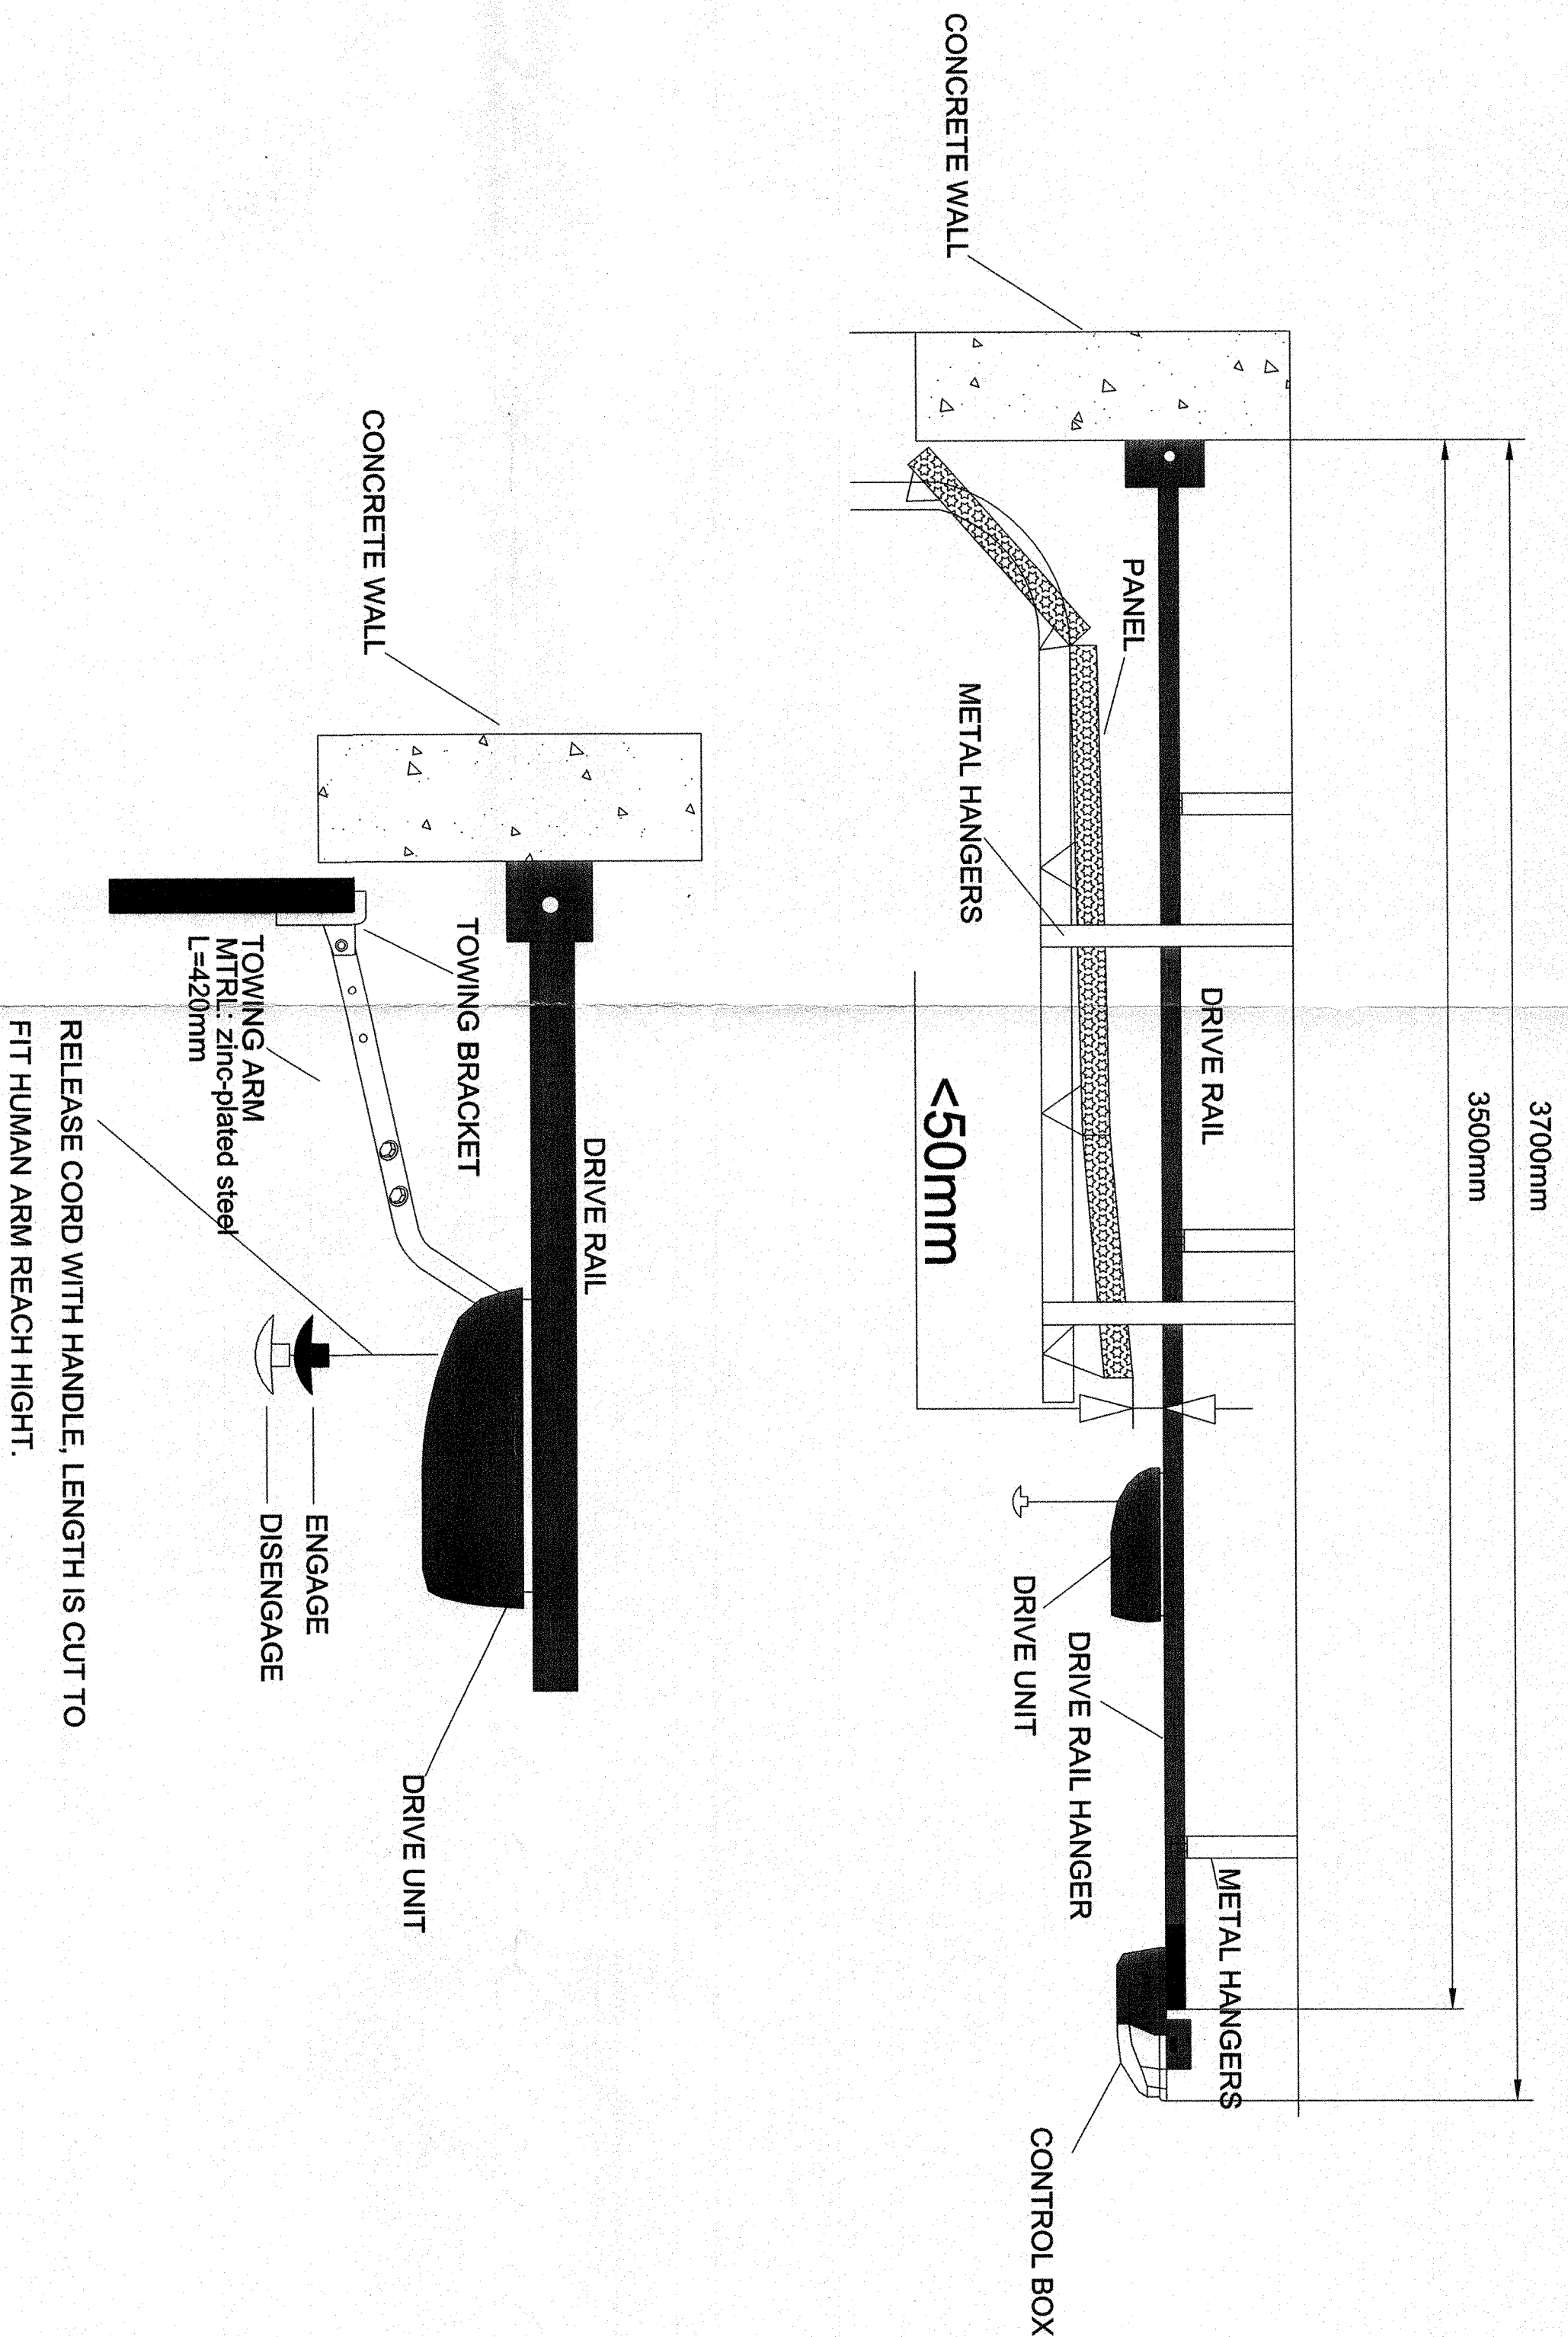


DETAIL F
DOOR ARM & HANDLE

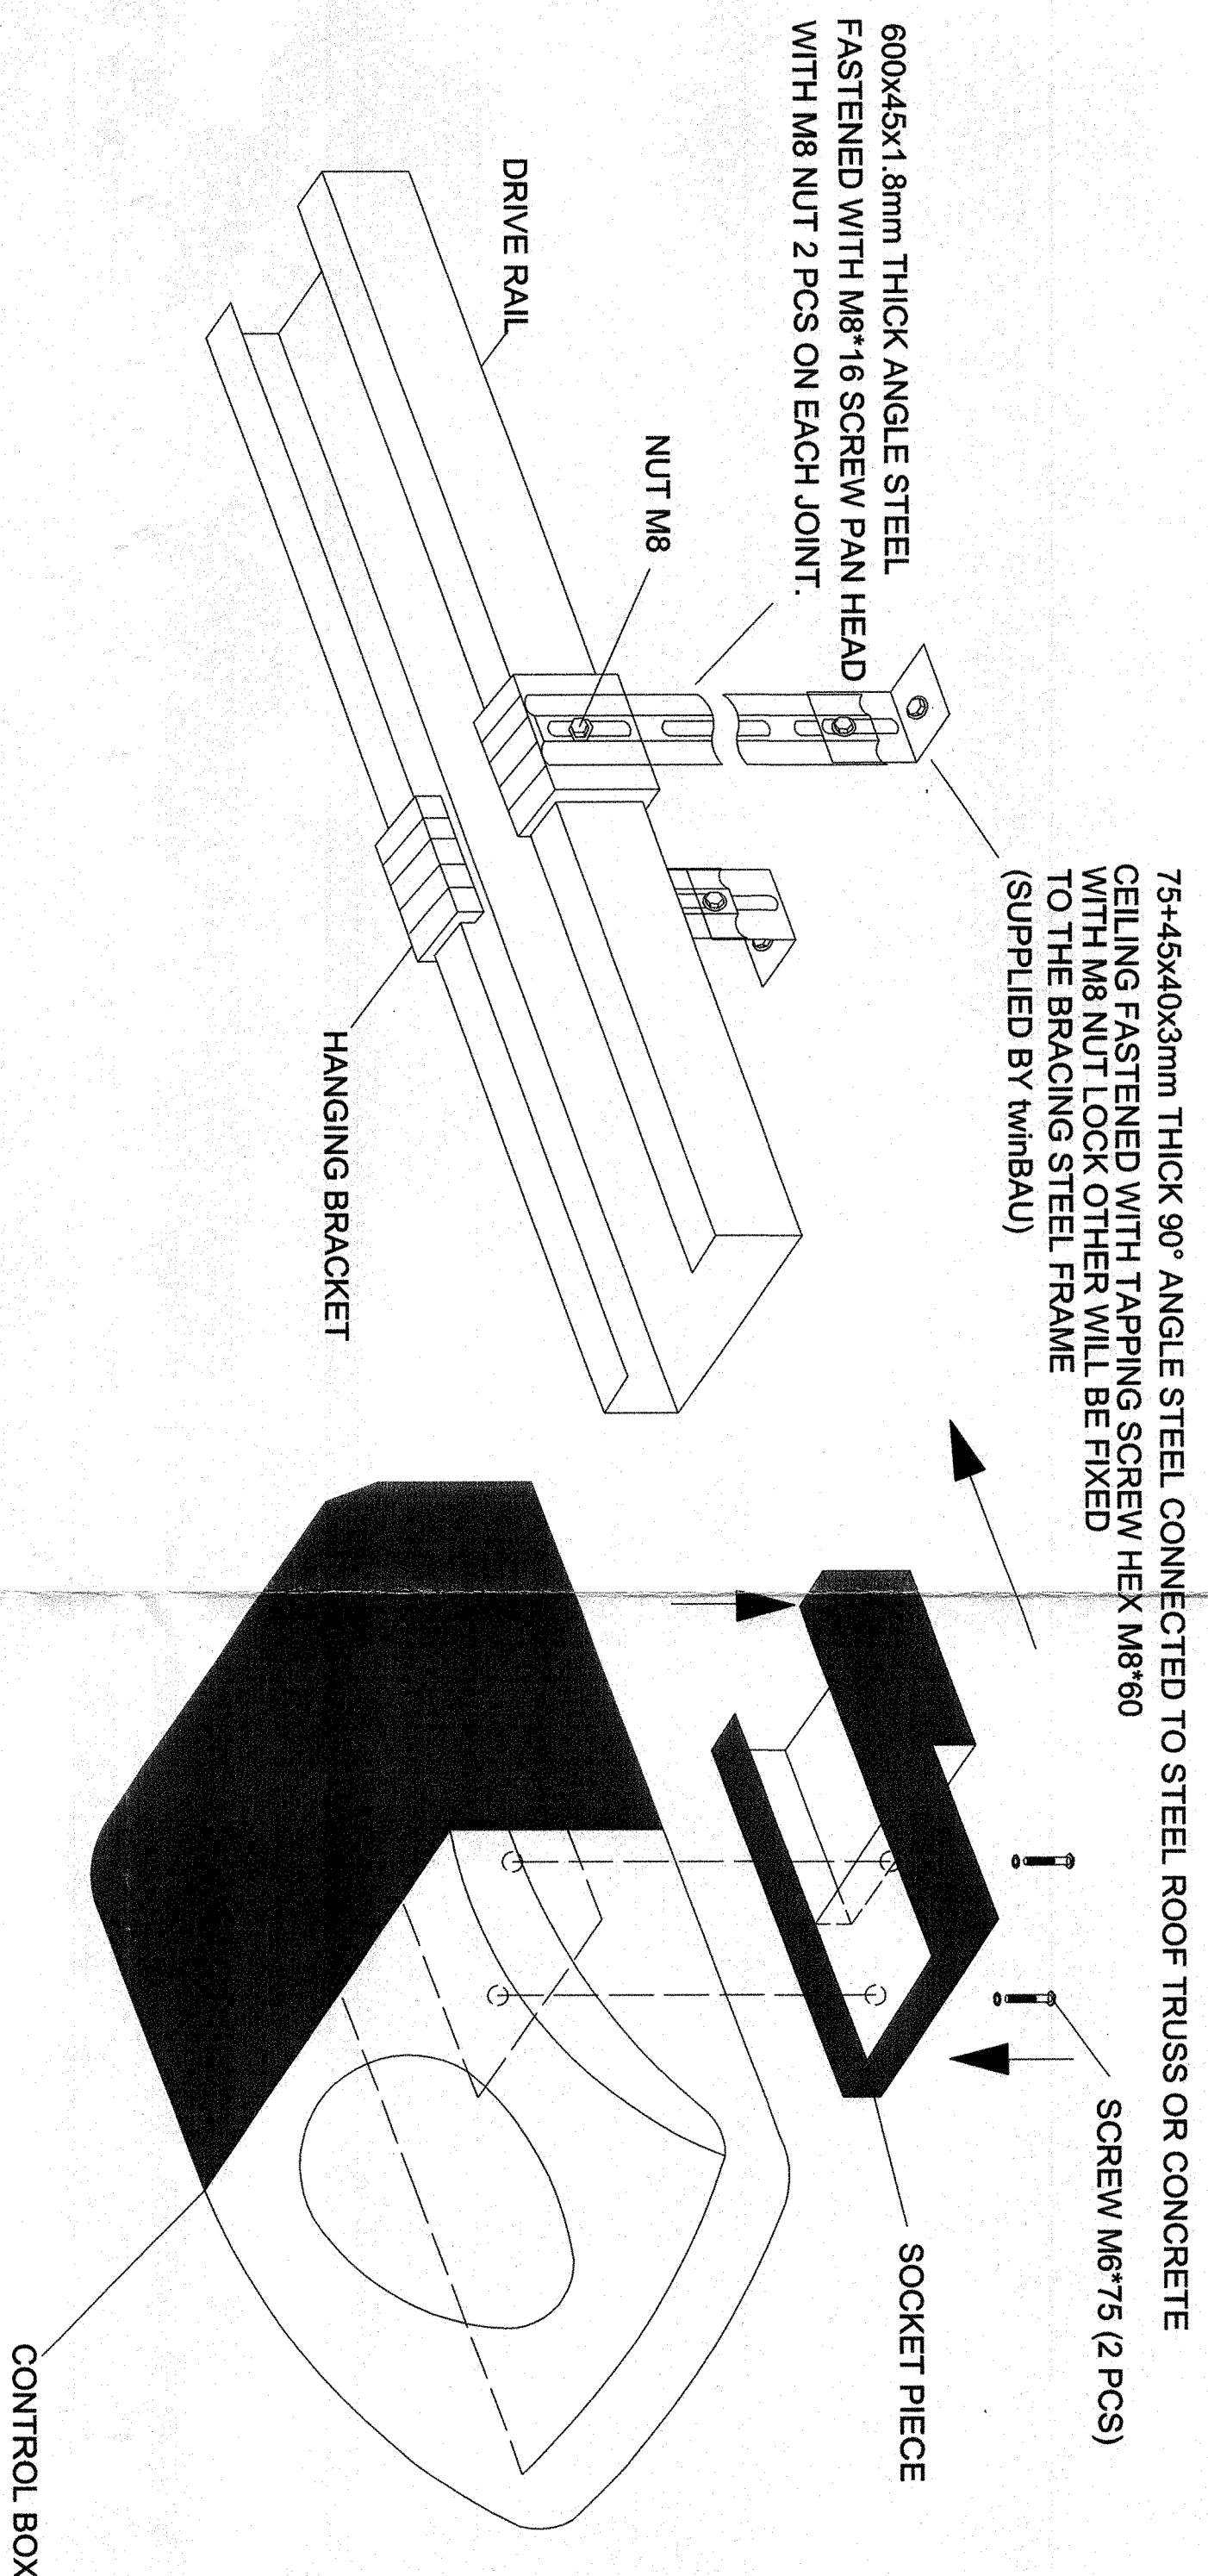

DETAIL E
TX6 OPENER HEAD HANGER

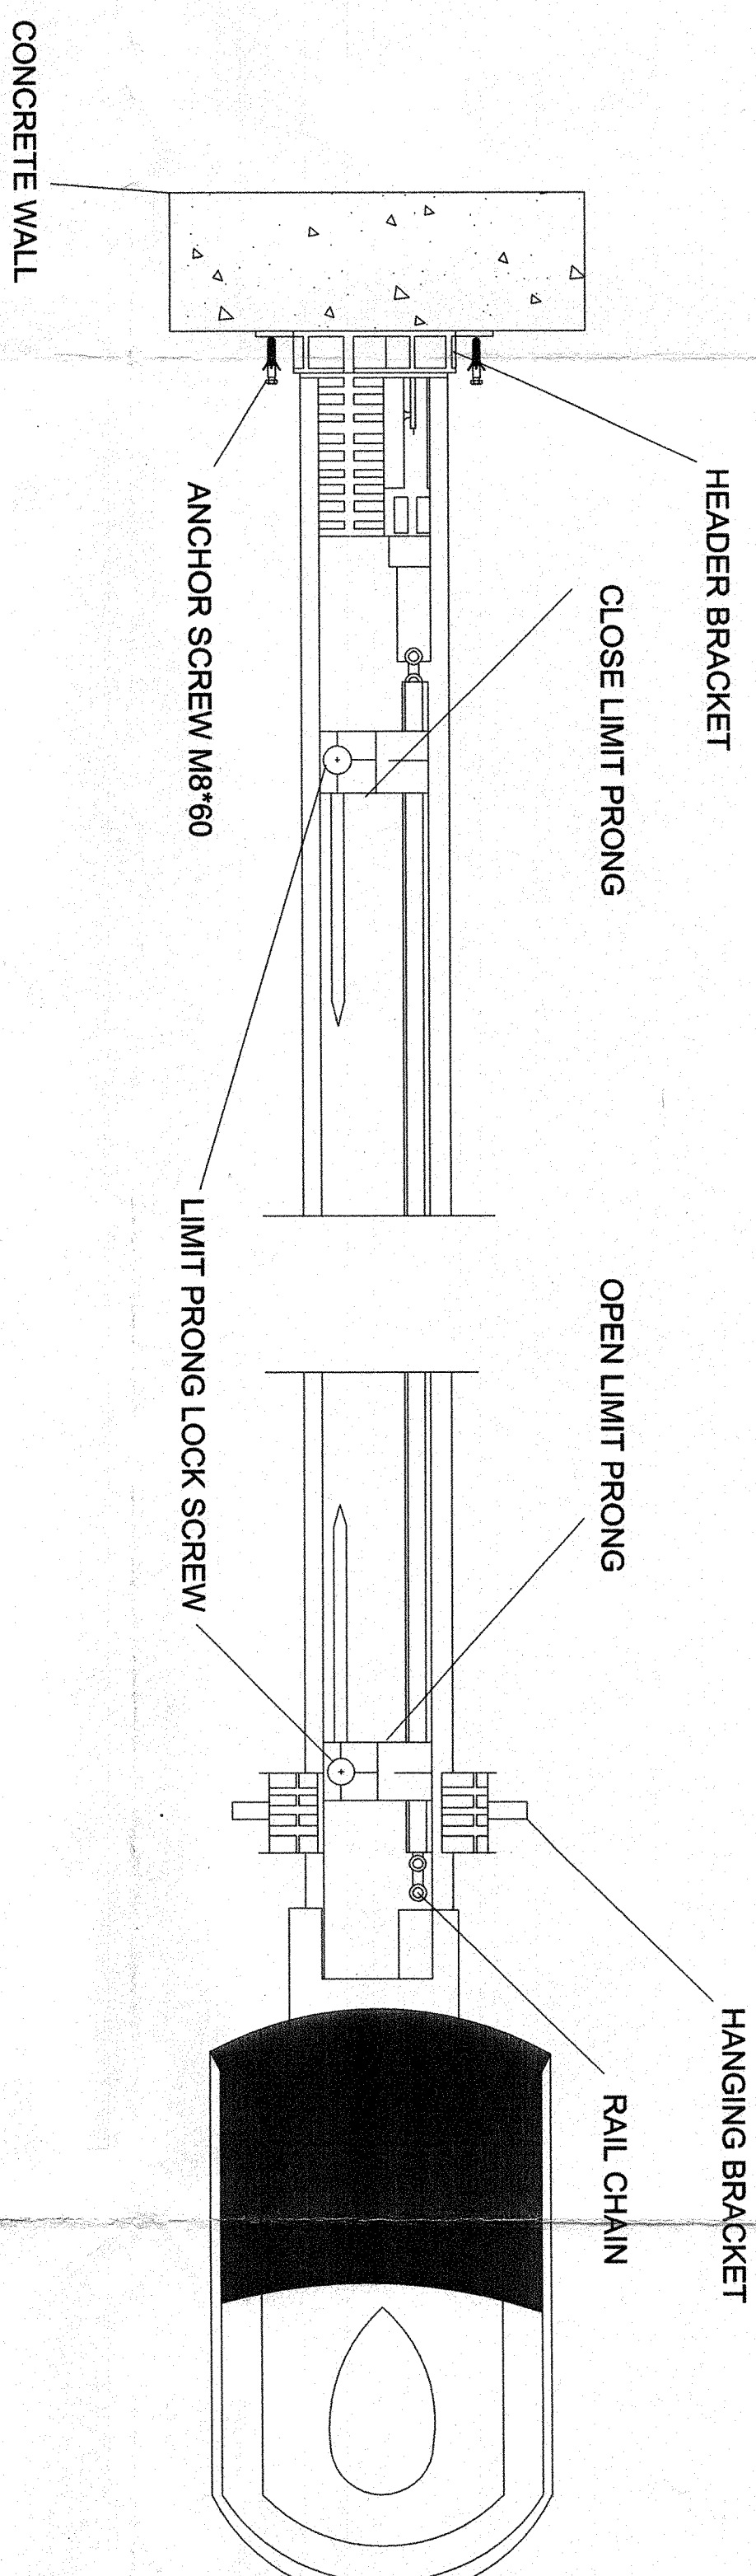

DETAIL G
DOOR TRAVEL ADJUSTMENT

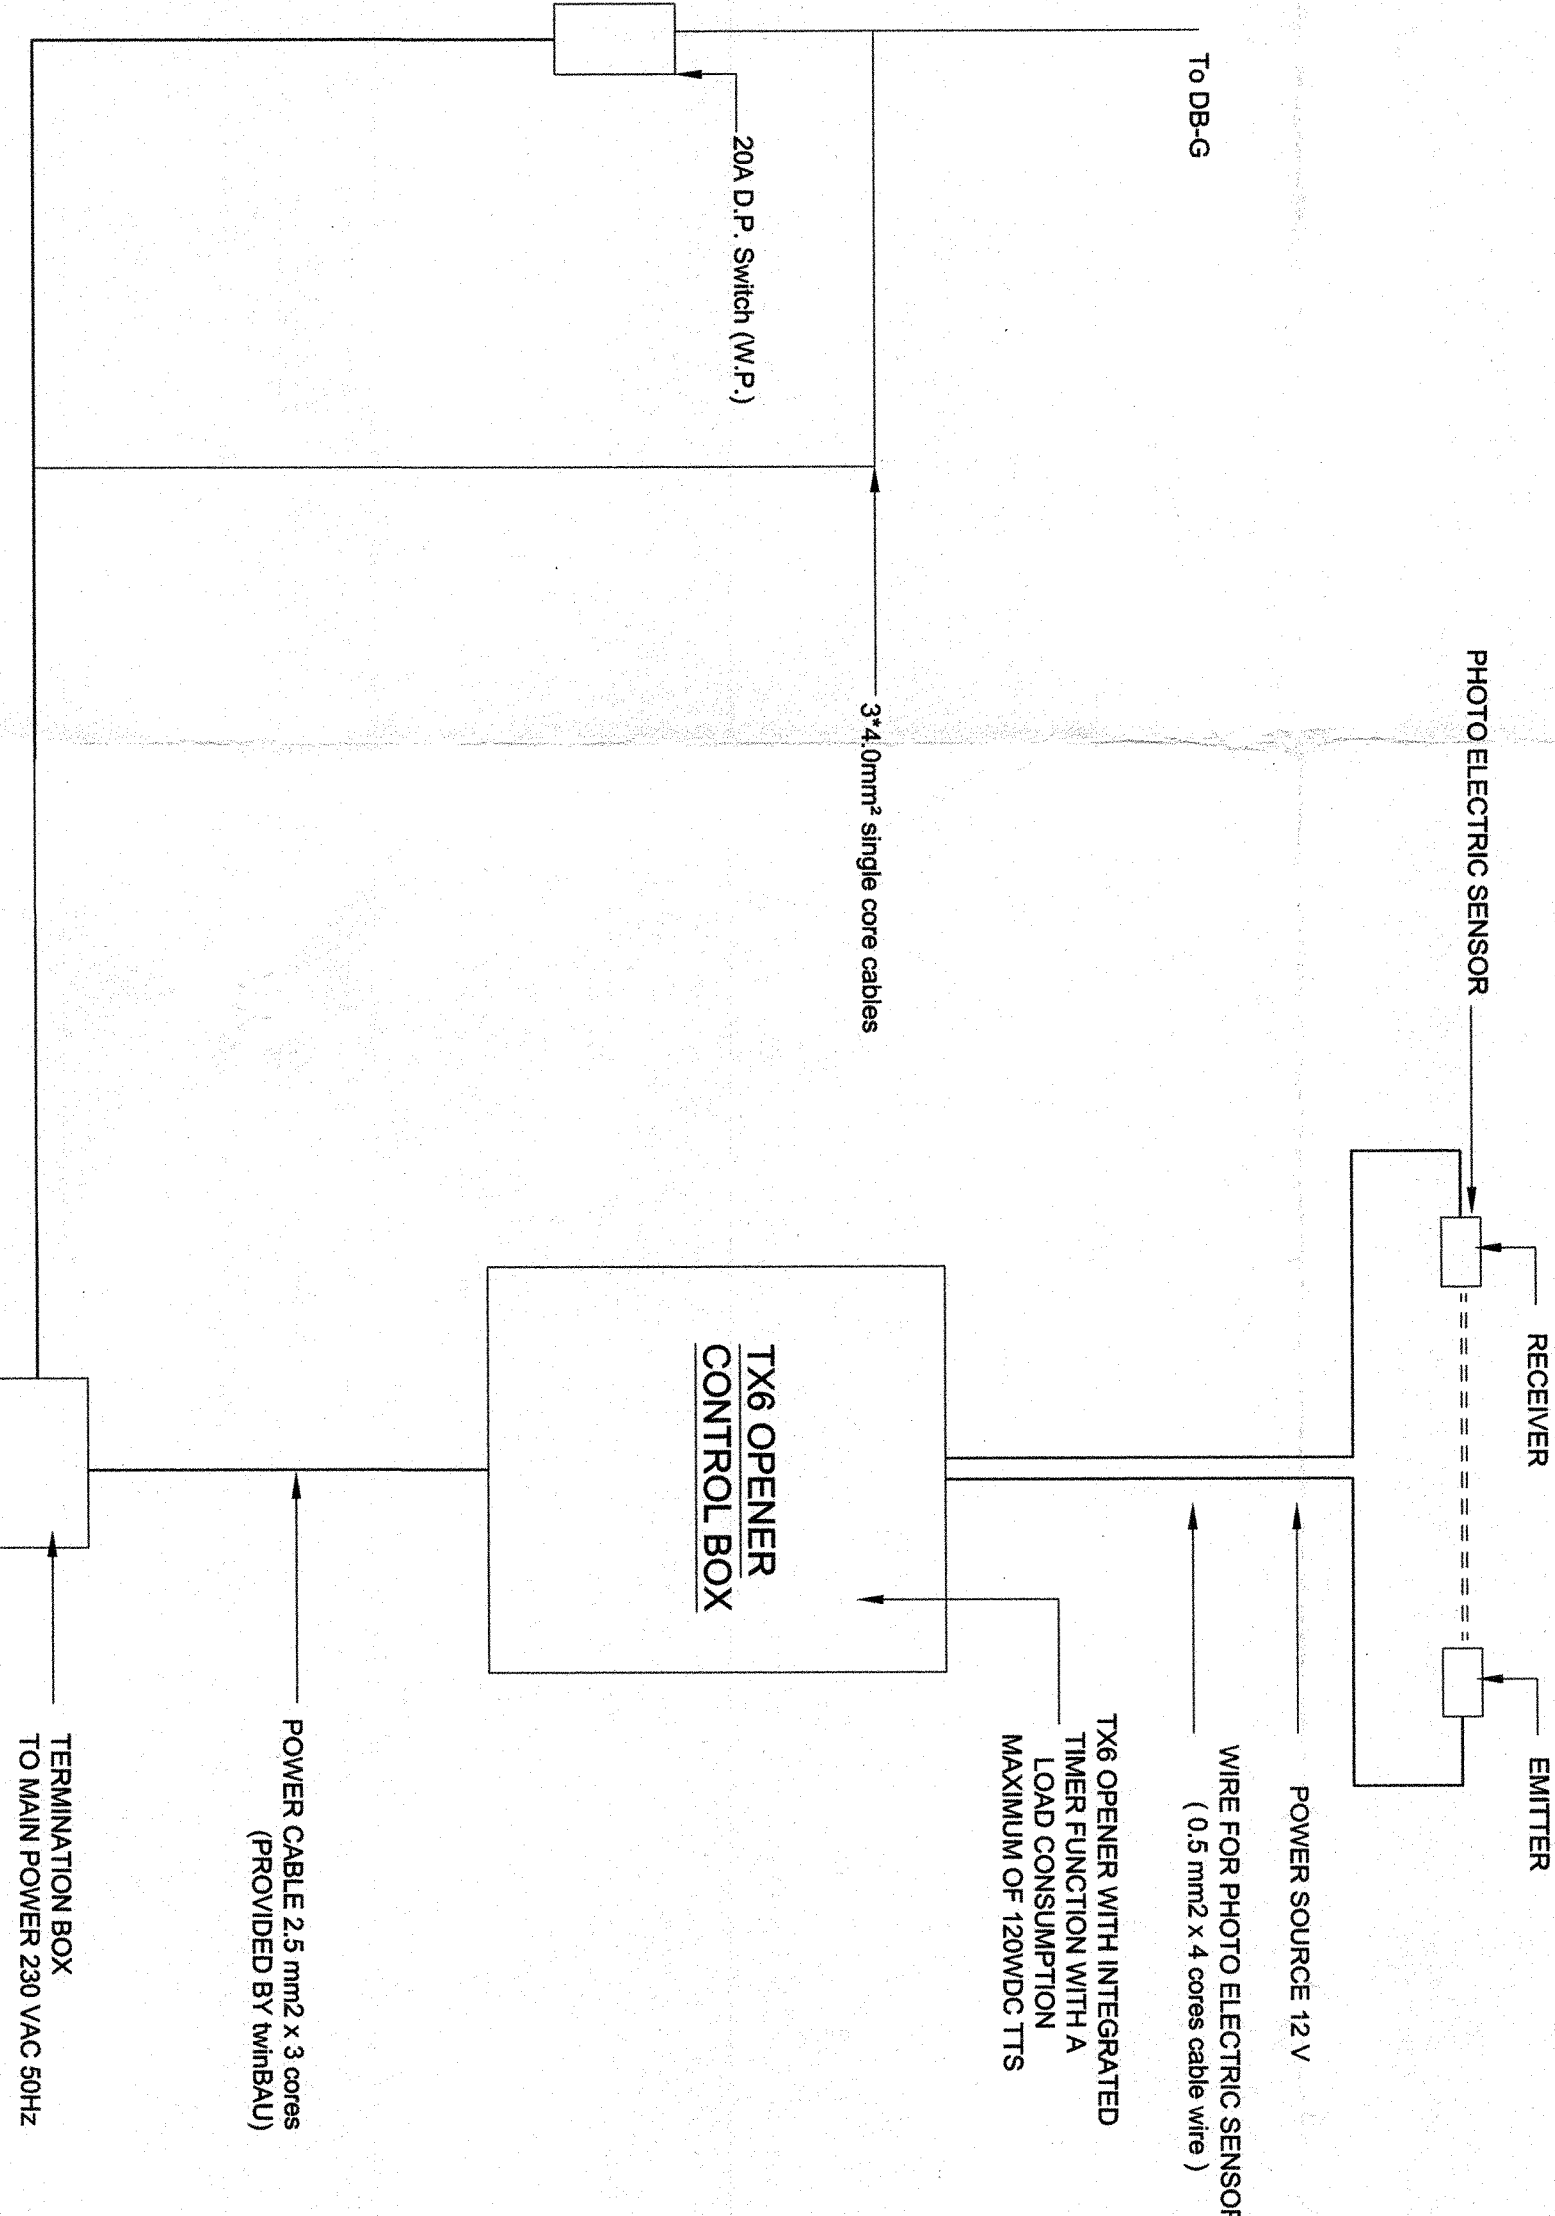

DETAIL H
TX6 OPENER WIRE DIAGRAM

TECHNICAL EXPLANATIONS:
REQUIREMENTS OF CUSTOMER:
1. ALL FIXATION, INSTALLATION INCLUDING NECESSARY SUPPORT-FIXTURES ARE PART OF THIS OFFER
2. CEILING FIXATION-SUPPORT PROVIDED BY WINDOOR ACCORDING EACH GARAGE'S FINAL DIMENSIONS (WITH REFERENCE TO MAIN CONTRACTORS DRAWINGS)

INSTALLATION:
1. DOORS ARE BEING PRODUCED TO DIMENSION AND CONSTRUCTIONAL CONDITIONS PROVIDED BY MAIN CONTRACTOR AND DISCUSSED WITH WINDOOR
2. CEILING FIXATION-SUPPORT PROVIDED BY WINDOOR CONTRACTOR
AND DISCUSS CHANGE IN DESIGN WITH MAIN CONTRACTOR

REMARK:
The villas using TX6 motor:

TX6 MOTOR	
Villa No.	
AAV	1-44
BAV	1-28
CAV	14-35
DAV	47-62
EAV	1-60
FAV	1-28
GAU	1-17
HAV	1-17
LAV	41-56
MAV	1-28
MAV	1-38

SPECIFICATION:

HINGES: CATAPOLYSIS HINGES

SPRING SYSTEM: EXTENSION SPRINGS VERTICAL
TWO SPRINGS AT BOTH SIDES WITH COLOR CODING.
RED EXTENSION SPRING (600mm)
YELLOW EXTENSION SPRING (750mm)


HARDWARE: WINDOOR WD-2000 B HARDWARE
OPERATOR: WND TX6 (1000N)

UNITS:

ALL LENGTH-UNITS IN (mm)

GARAGE DOOR

GROUND FLOOR PLAN

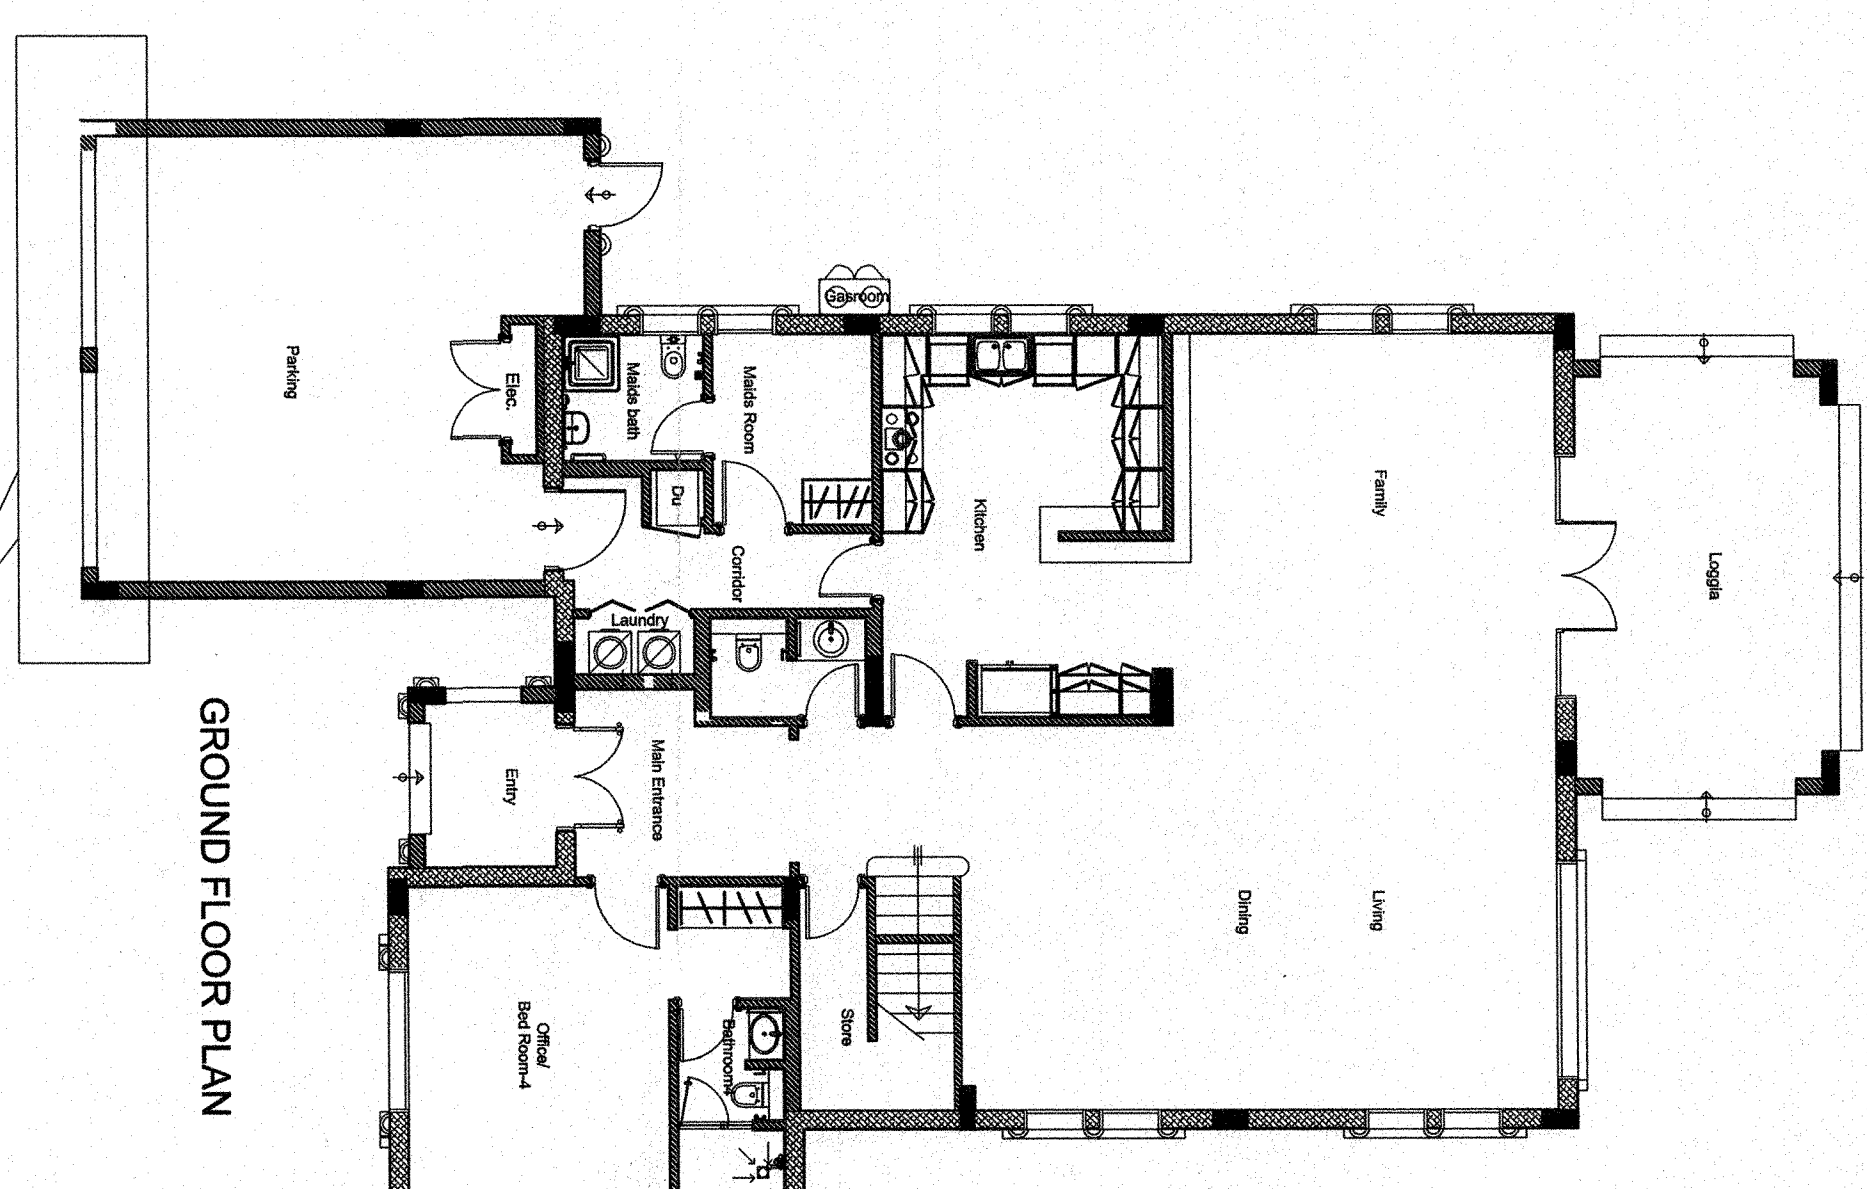

S/N.	DESCRIPTION/ISSUE	DATE
1	REV 4	14 /08 /2012

AS BUILT DRAWING

PROJECT

JUMEIRAH PARK 2 & 2A

CLIENT
NAKHEEL

CONSULTANT

dar al-handasah
shair and partners

P.O. BOX: 5824, DUBAI, U.A.E.
PHONE: + 971 - 4 - 3353535
FAX: + 971 - 4 - 3353535
E-MAIL: info@darhandasah.com


MAIN CONTRACTOR

PAULING MIDDLE EAST CO. L.L.C.

P.O. BOX: 45176, JEBEL DHAN, U.A.E.
PHONE: + 971 - 4 - 3353535
FAX: + 971 - 2 - 6535553
E-MAIL: pauling@pauling.com and .ae

SUB CONTRACTOR

twinBAU Building
Materials Trading

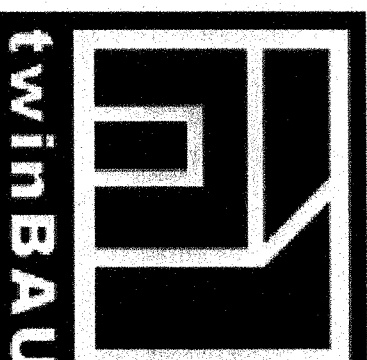

PHONE: + 971 - 4 - 3418888
E-MAIL: info@twinbau.com

DRAWING TITLE
SECTIONAL OVERHEAD GARAGE DOOR
(WIRING DIAGRAM & DOOR STRUCTURE DETAILS
FOR TX6 MOTOR)

DRAWN	CHECKED	SCALE	APPROVED
DZ	AL	NOT IN SCALE	

REV. 4
SHEETS 7 OF 8

DRAWING NO.
PME/J/P/AB/
80170002-2800/2500
DOOR SUPPLIER

