



DETAIL -1			
VILLAS ARE WITH EXHAUST FAN IN PANTRY			
PACKAGE	CLUSTER #	FLOT #	TOTAL # OF VILLAS
2	2	JA001 to JA040	20
	3	JA001 to JA020	20
	4	JA001 to JA020	10
	5	JA001 to JA018	18
	6	KA001 to KA004	13
	8	KA001 to KA006	1
TOTAL VILLAS			82




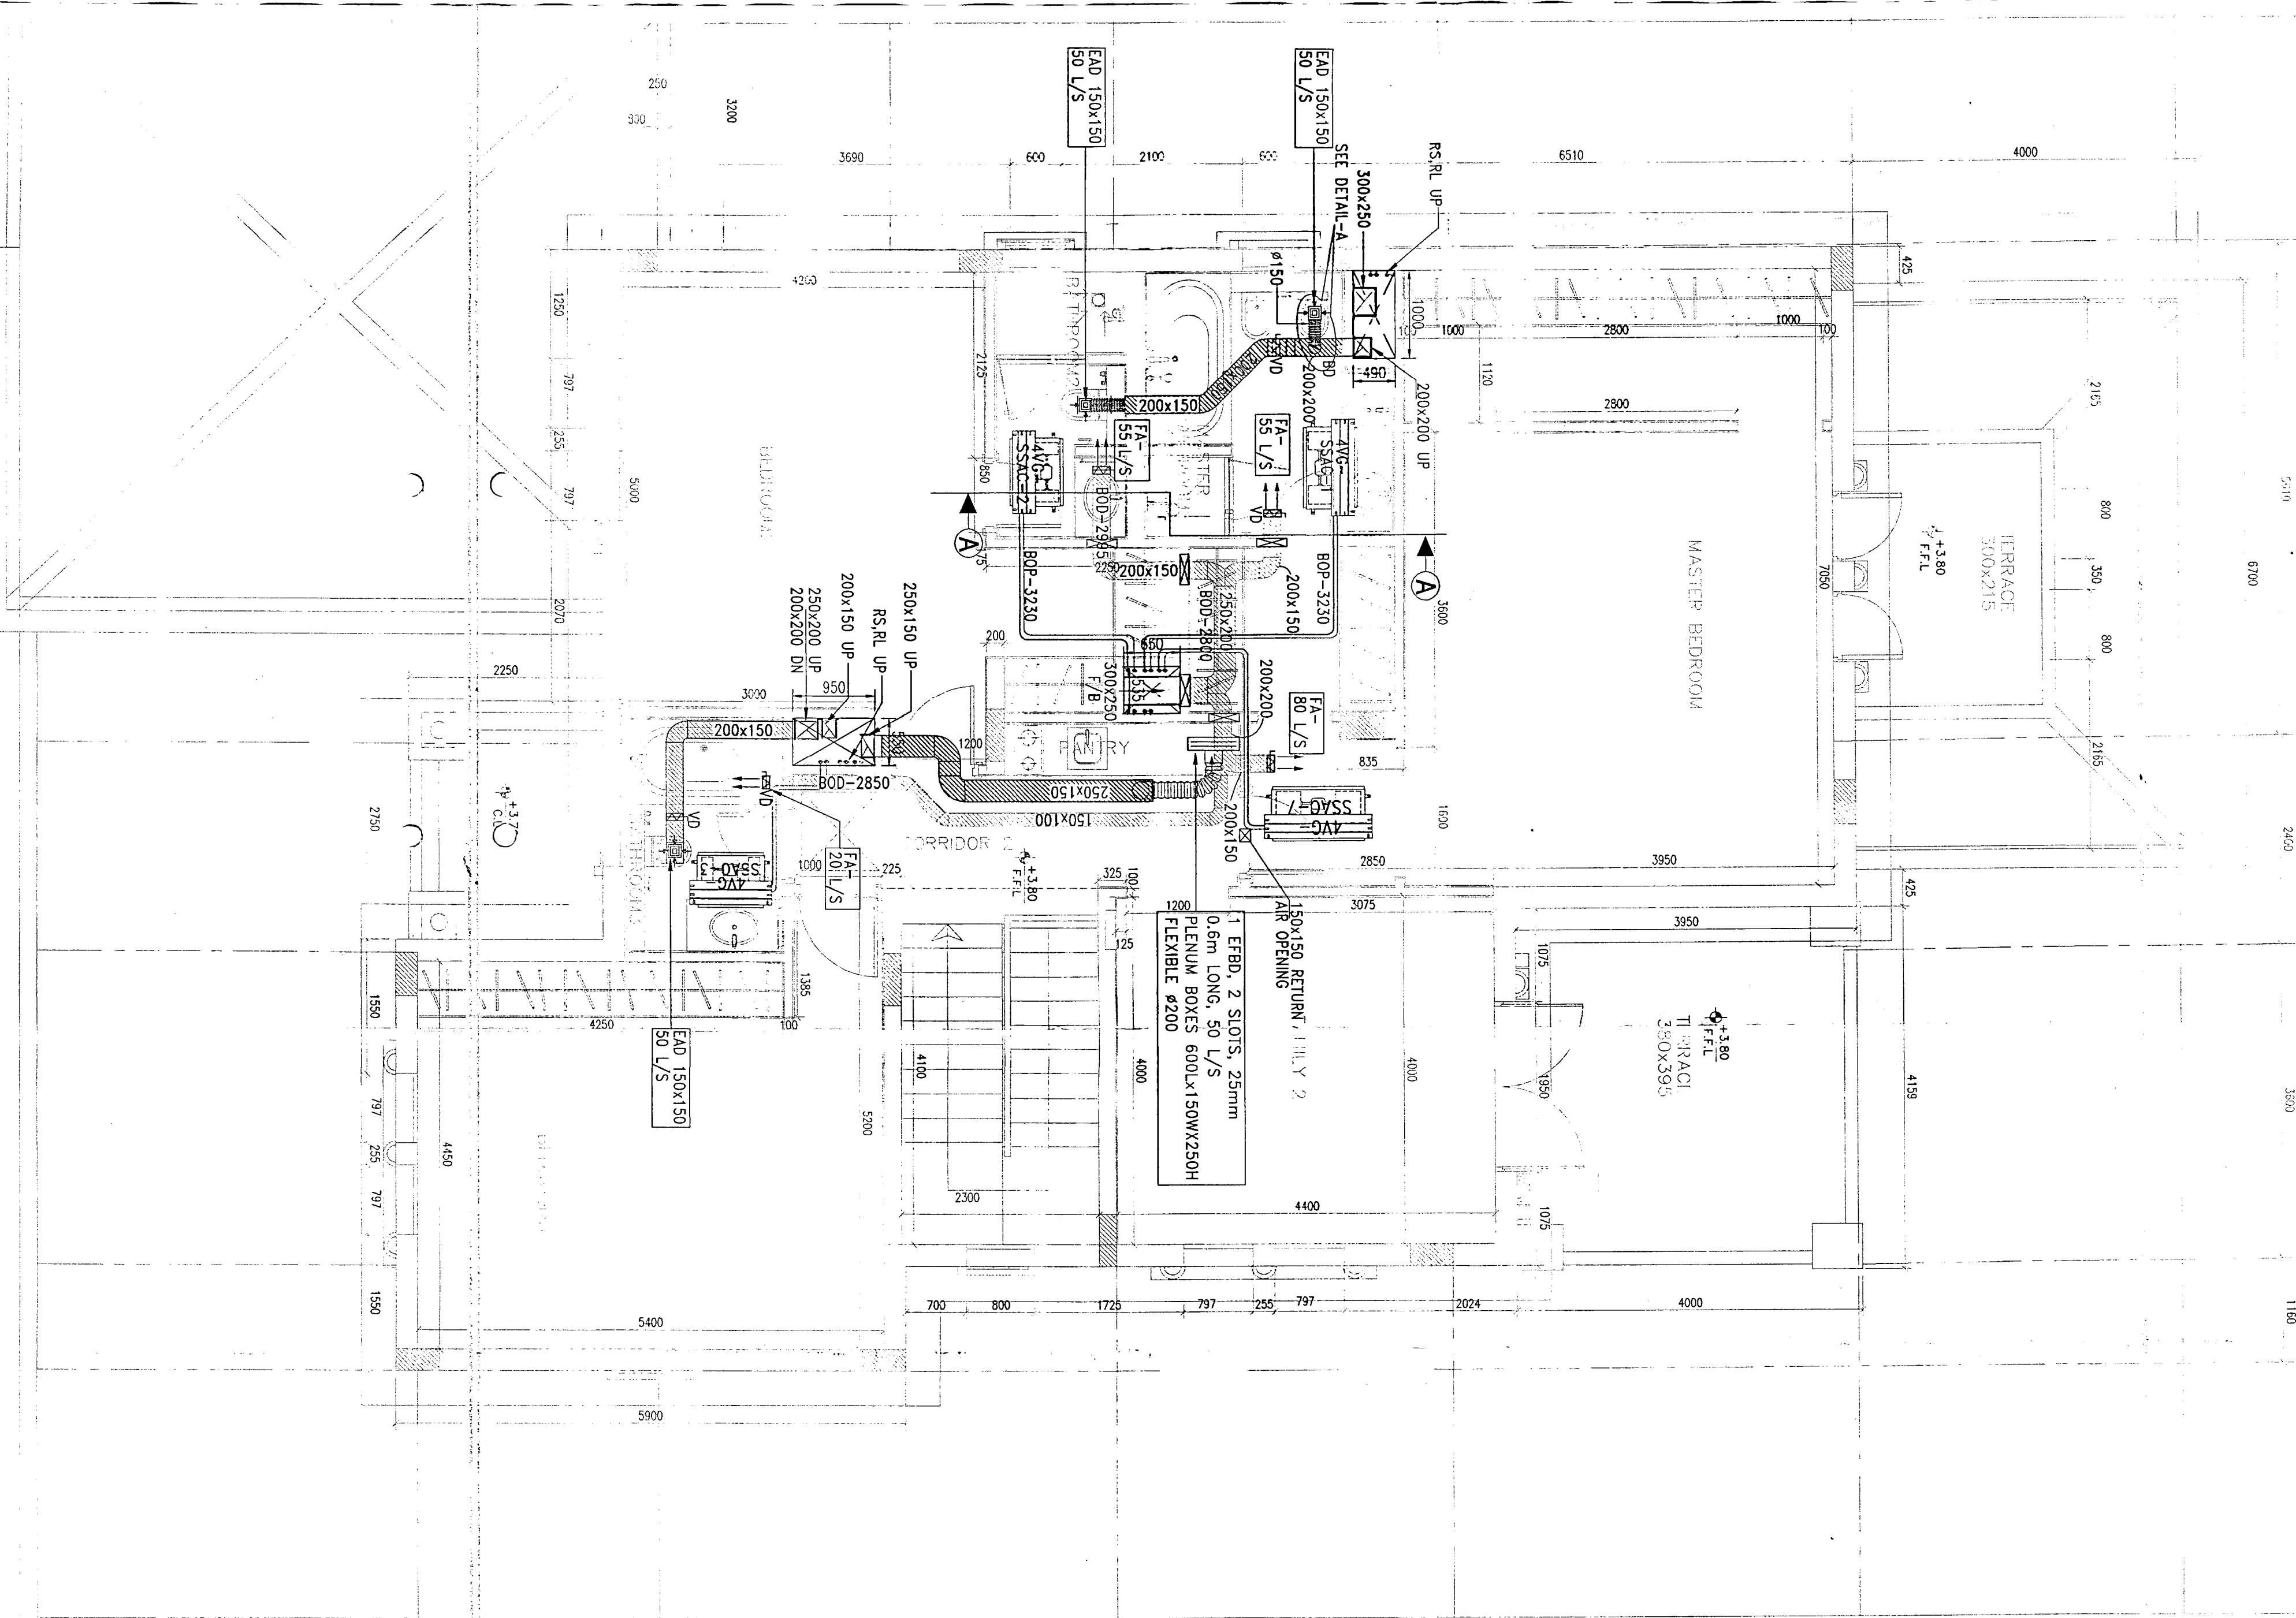


FIRST FLOOR PLAN
VENTILATION DETAILS


DETAIL -2			
VILLAS ARE WITHOUT EXHAUST FAN IN PANTRY			
PACKAGE	CLUSTER #	FLOT #	TOTAL # OF VILLAS
2A	13	MA001 to MA014	14
	1	JA001 to JA006	16
	9	MA001 to MA008	10
	10	MA001 to MA008	26
	11	MA001 to MA008	18
	12	MA001 to MA008	14
	6	KA001 to KA008	5
	7	KA001 to KA008	10
	8	JA001 to JA008	22
	1	FA001 to FA008	26
	2	JA001 to JA001	11
	3	EA001 to EA002	12
	4	EA001 to EA006	10
	5	EA001 to EA006	24
	6	EA001 to EA006	16
	7	DA001 to DA006	18
	8	DA001 to DA006	14
	9	JA001 to JA008	15
	10	JA001 to JA004	18
	11	DA001 to DA006	16
	12	CA001 to CA006	16
	13	CA001 to CA006	13
	14	CA001 to CA006	11
	15	BA001 to BA004	22
	16	BA001 to BA004	26
	17	GA001 to GA007	17
TOTAL VILLAS			443

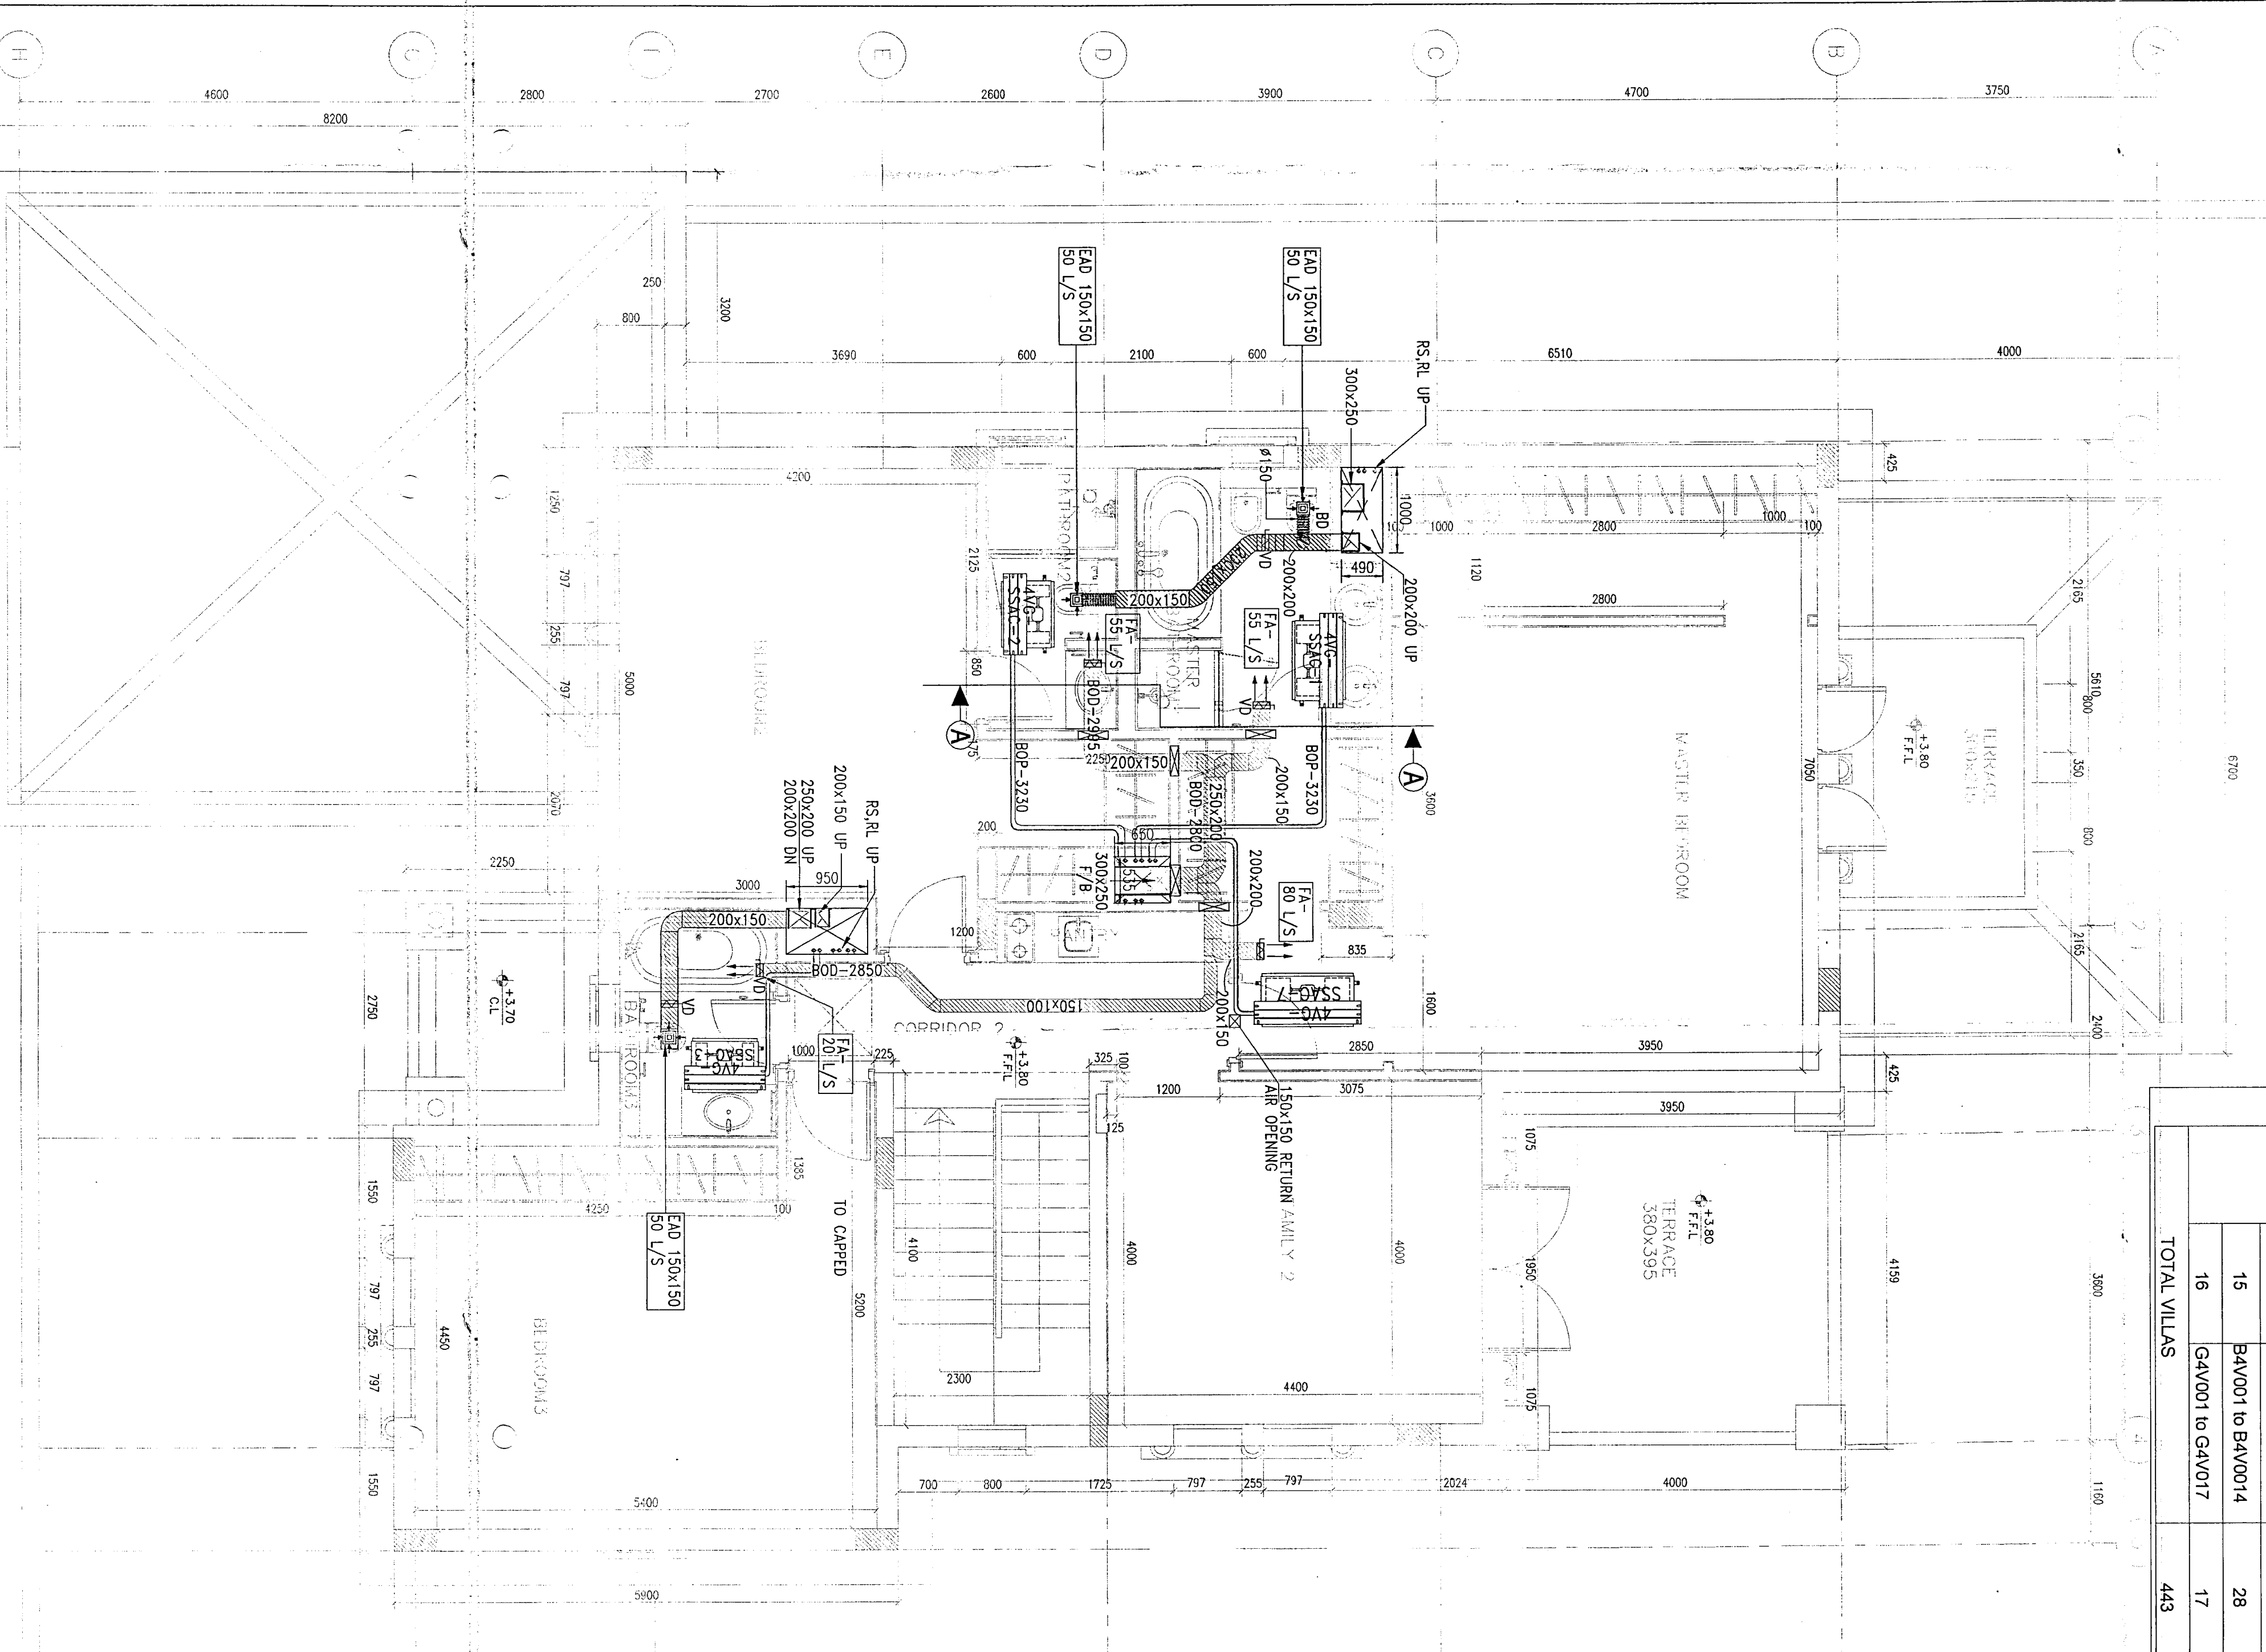

FIRST FLOOR PLAN
VENTILATION DETAILS

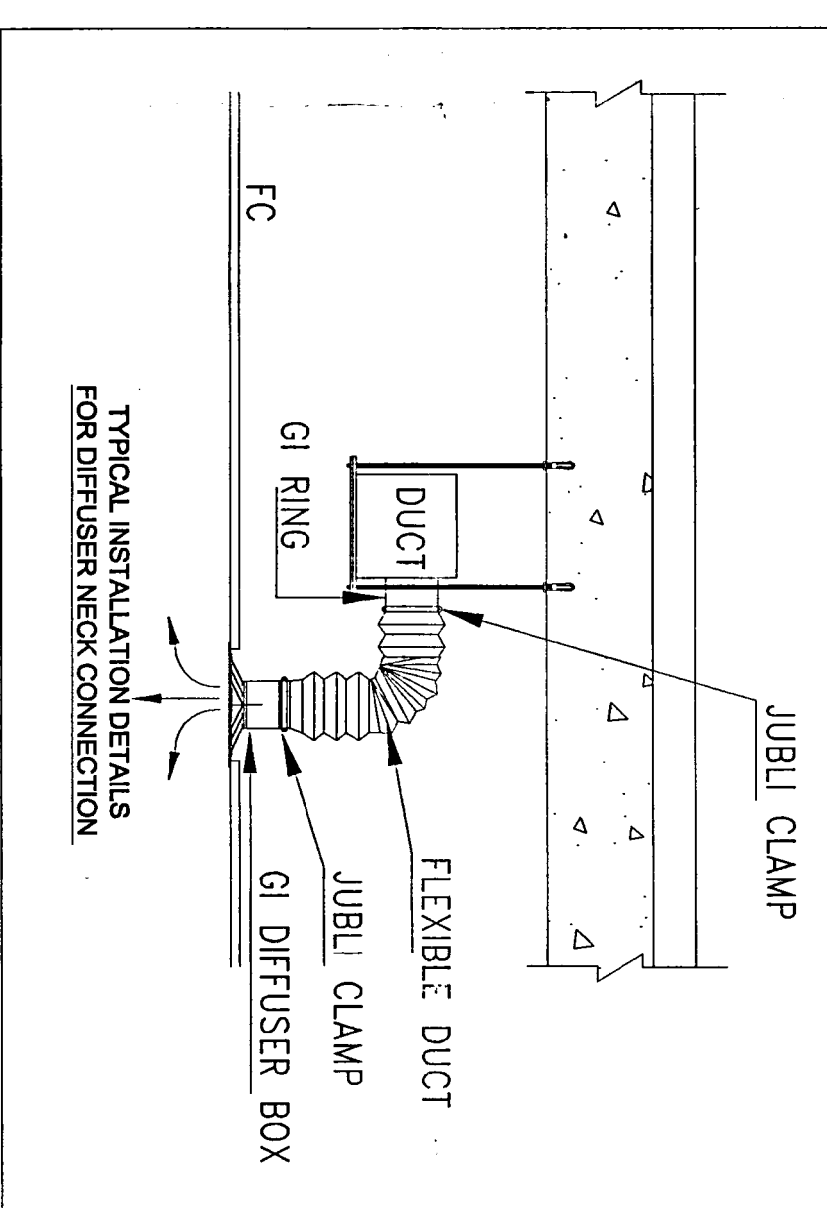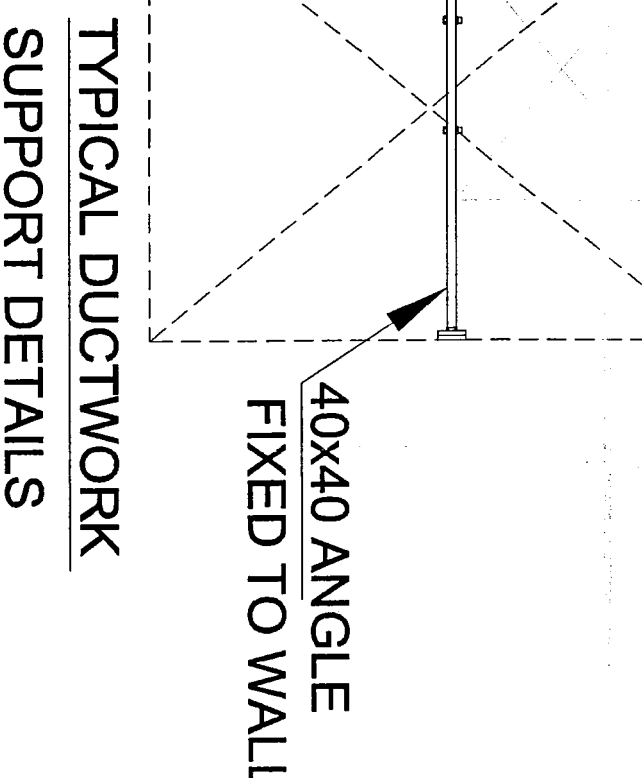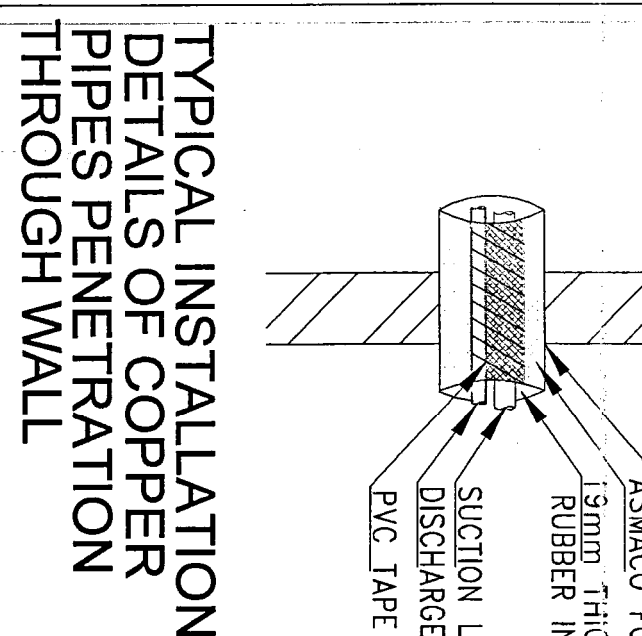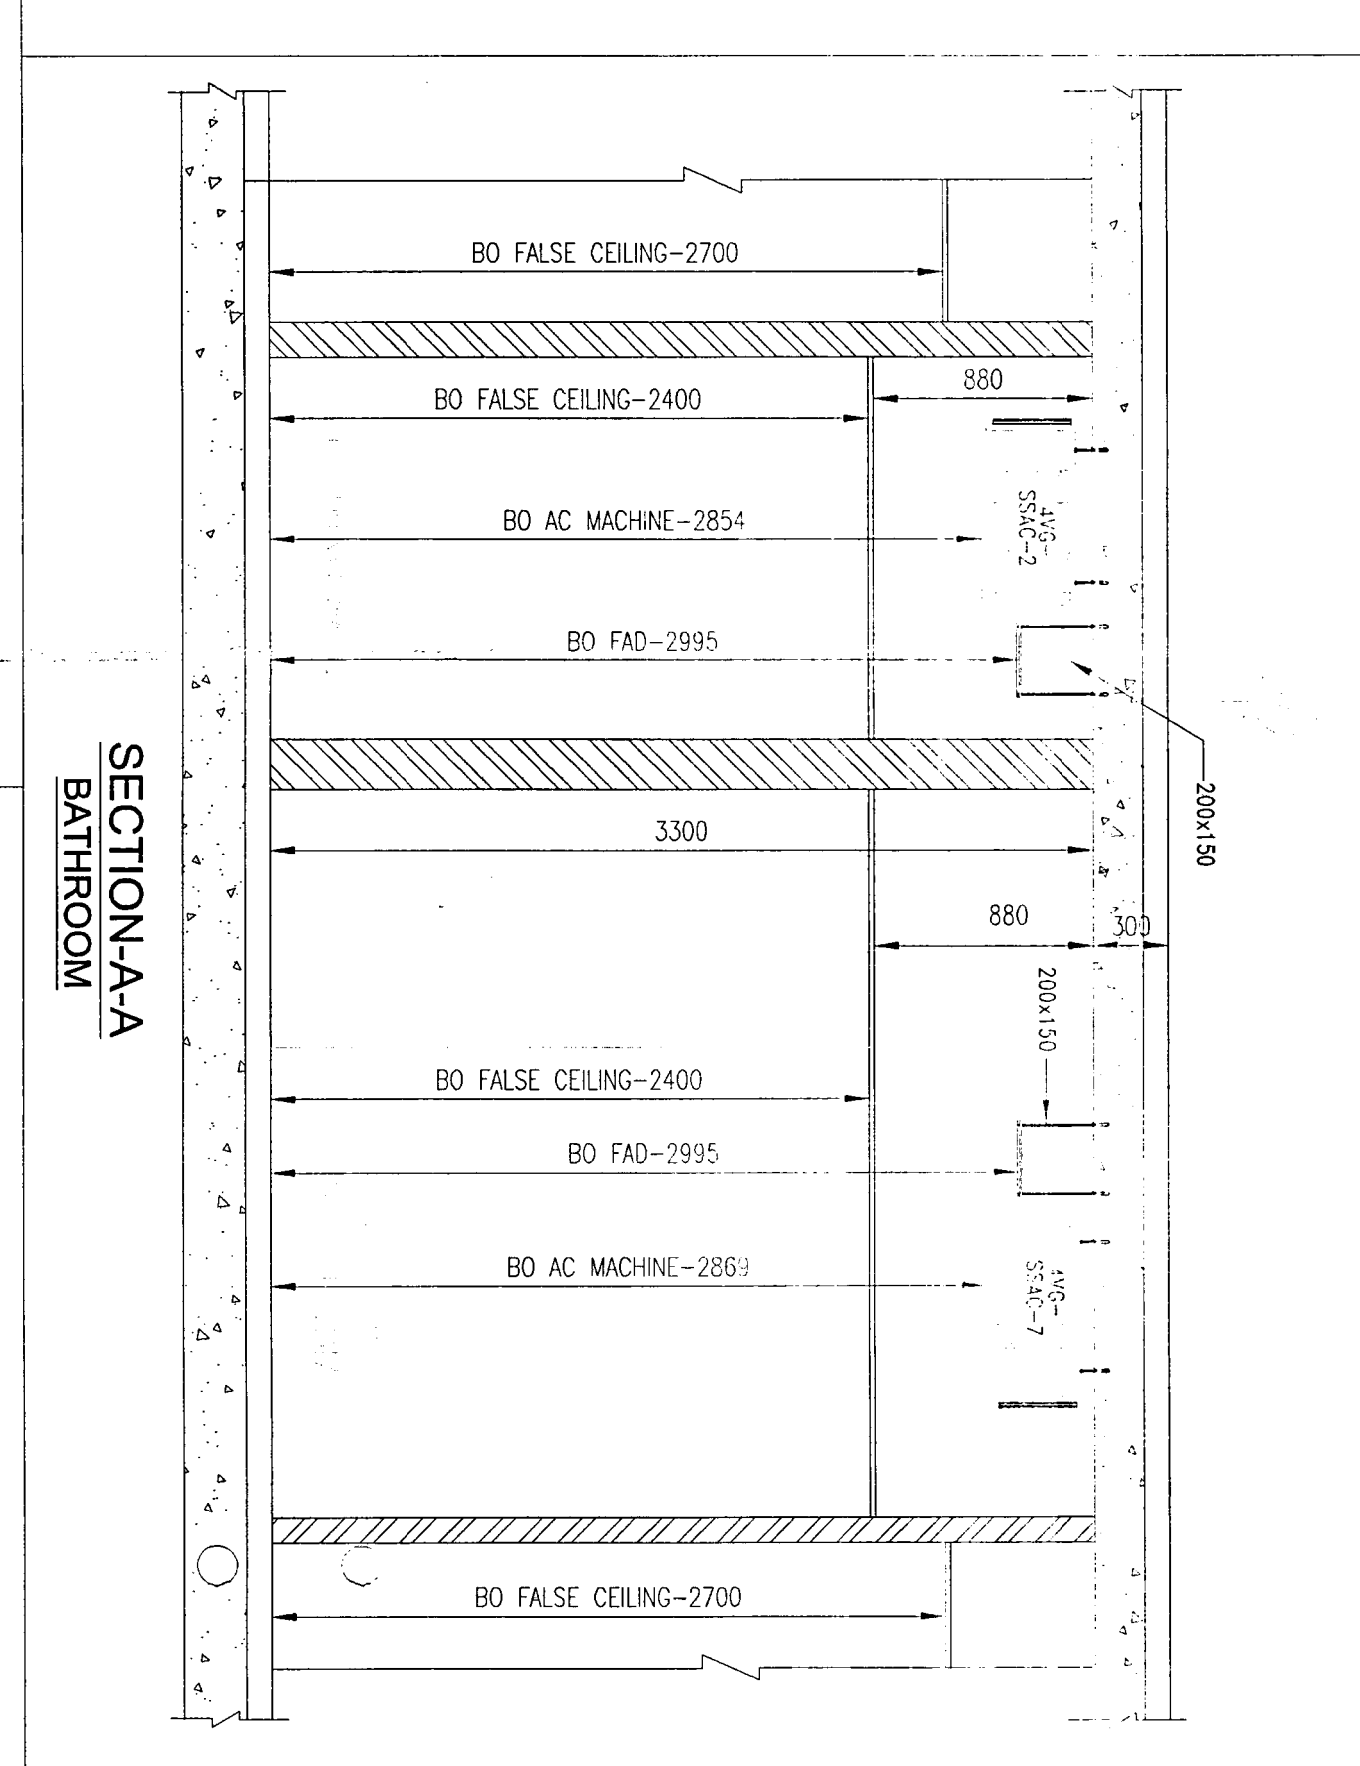

SCHEDULE OF VOLUME CONTROL DAMPERS				
S.L.NO	UNIT REFERENCE	LOCATION	DIMENSION	QTY/NTY
1.	AVG-SSAC-10	MASTER BATHROOM-2	200x150	1
2.	(FAHU)	MASTER BEDROOM	200x150	1
3.	(FAHU)	BATHROOM-3	150x100	1
4.	AVG-FF-2	MASTER BATHROOM	200x150	1
5.	(TOILET EXTRACT FAN)	MASTER BATHROOM	Ø150	1
6.	(FAN)	BATHROOM-3	200x150	1

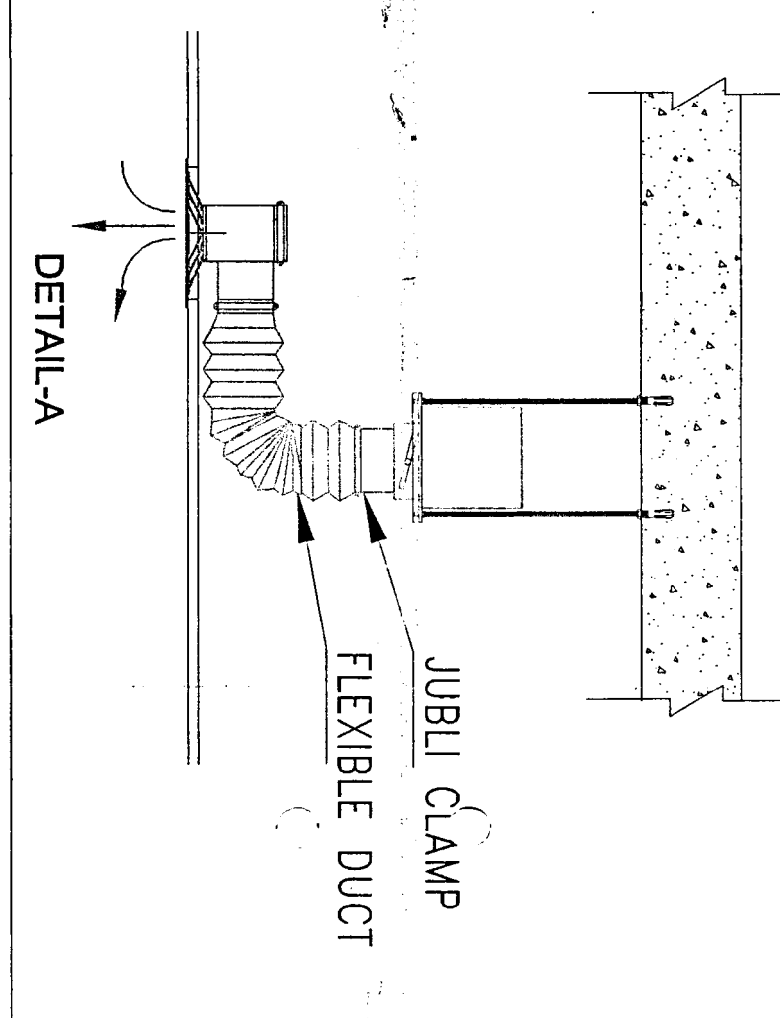

S.L.NO	DESCRIPTION	ANCHOR TYPE
1.	FOR DUCT AND COPPER PIPE	M8 UNIFIX AND 8mm THREADED ROD
2.	FOR FCU AND FAHU	M10 UNIFIX AND 10mm THREADED ROD

- NOTES:-
1. ALL DIMENSIONS ARE IN MILLIMETERS.
 2. ABOVE FALSE CEILING IS USED AS RETURN PLenum CHAMBERS.
 3. FRESH AIR DUCT INSULATION IS 25mm THICKNESS AND DENSITY 15kg/m³.
 4. FRESH AIR DUCT INSULATION IS 25mm THICKNESS AND DENSITY 15kg/m³.
 5. DUCT WALL PENETRATION WITH GI SLEEVES.
 6. AIR OUTLET LOCATION IS ACCORDING TO APPROVED REFLECTED CEILING PLAN LAYOUT DWG-PM/PS/01/02/03/2041/2042