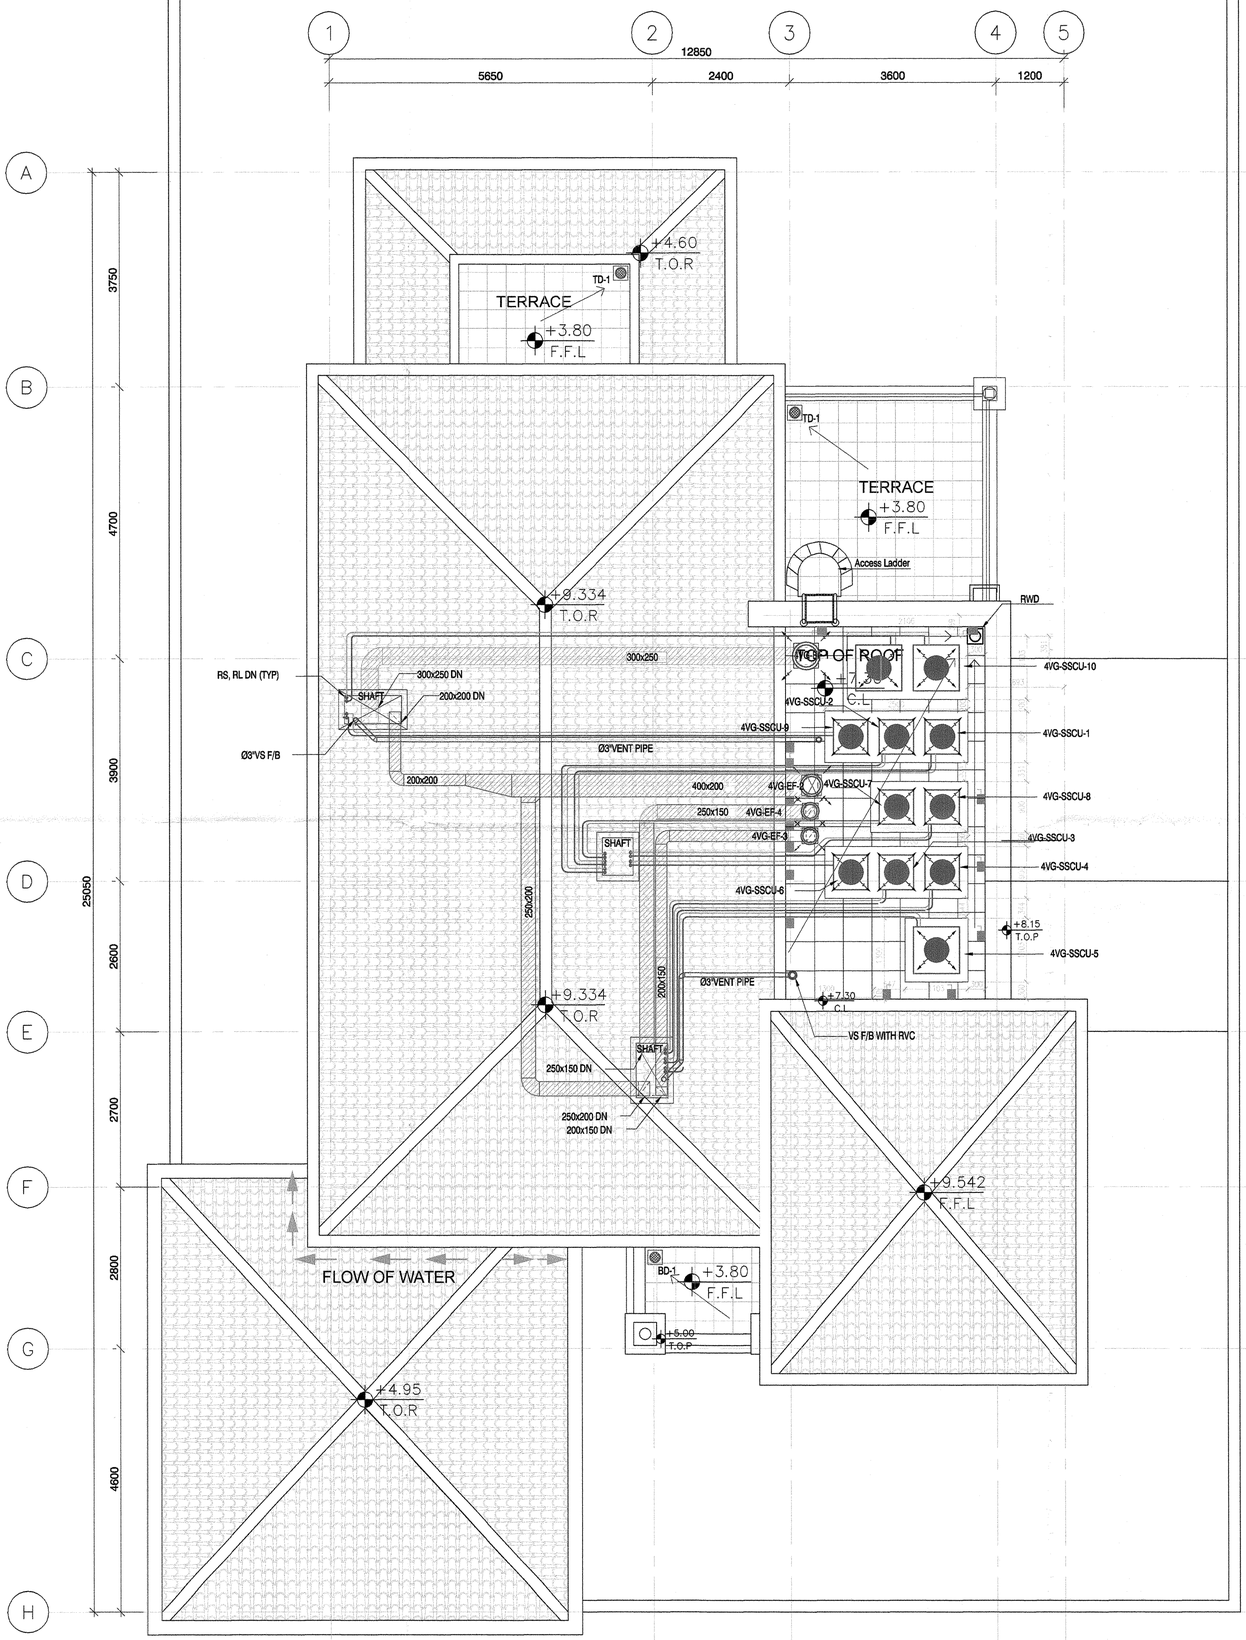

NOTE:

1. ALL DIMENSIONS ARE IN MILLIMETERS AND LEVELS ARE IN METERS
2. FOR THE EXACT DUCTING LOCATION / DIMNESIONS REFER TO MECHANICAL DRAWINGS

LEGEND:-

F/A - FROM ABOVE
F/B - FROM BELOW
T/A - TO ABOVE
T/B - TO BELOW
B.D - BALCONY DRAIN
T.D - TERRACE DRAIN
R.W - RAIN WATER
V.S - VENT STACK
V.P - VENT PIPE
SSCU - SPLIT SYSTEM CONDENSING UNIT
CWS - COLD WATER SUPPLY
I.V. - ISOLATING VALVE

RAIN WATER PIPE
VENT PIPE
FLOOR DRAIN
EXHAUST AIR DUCT
KITCHEN EXHAUST AIR DUCT
REFRIGERANT LIQUID
REFRIGERANT SUCTION
COLD WATER SUPPLY
DRAINAGE PIPE
WEATHER PROOF ISOLATOR

Arch: Code ① 11/09/2012

dar al-handasah Shair and Partners

- CODE 1 APPROVED
- CODE 2 APPROVED AS NOTED — WORK MAY PROCEED SUBJECT TO INCORPORATION OF ENDORSED COMMENTS
- CODE 3 RESUBMIT FOR APPROVAL — WORK MAY NOT PROCEED
- CODE 4 REJECTED

BY: DATE:

Approval shall not relieve the contractor of any of his obligations under the Contract or constitute authorization of any change to Contract Documents or variation to the works. Contractor is responsible for dimensions, quantities and coordination with other trades.

This Drawing is Applicable for the Below Listed Villas			
Package	Cluster #	Plot #	Total # of Villas
2A	1	F4V002 to F4V015	26
		F4V017 to F4V028	
	3	E4V051 to E4V062	12
	5	H4V001 to H4V014	16
		H4V016 & H4V017	
	7	D4V033 to D4V041	9
	9	A4V012 to A4V029	18
	10	A4V030 to A4V044	15
Total Villas			96 Villas

163 r-1

RECEIVED DAR AL HANDASAH 11 AUG 2012 PKG 2&2A

AS BUILT DWG

Project
JUMAIRAH PARK

Employer
NAKHEEL
P.O. BOX : 17777 , DUBAI , U.A.E.
PHONE : + 971 - 4 - 3903388
FAX : + 971 - 4 - 3903335
Website : www.nakheel.ae
E - MAIL : info@nakheel.ae

Consultant
dar al-handasah shair and partners
P.O. BOX : 55624 , DUBAI , U.A.E.
PHONE : + 971 - 4 - 335502
FAX : + 971 - 4 - 33353121
www.dargroup.com

Main Contractor
Pauling Middle East
P.O. BOX : 45176 , ABU DHABI , U.A.E.
PHONE : + 971 - 2 - 6329922
FAX : + 971 - 2 - 6325535
E - MAIL : pauling1@emirates.net.ae

Package
PACKAGE - 2 & 2A

Drawing Title
LEGACY - TRADITIONAL ROOF PLAN 1 of 3

Drawn: Thirumurugan	Review: Eng. Ziad	Checked: Eng.Gassan Zeitouni
Scale: 1 : 50	Date: 05.08.2012	

Drawing No. **PME / JP / AB / LT / RP / 002**