


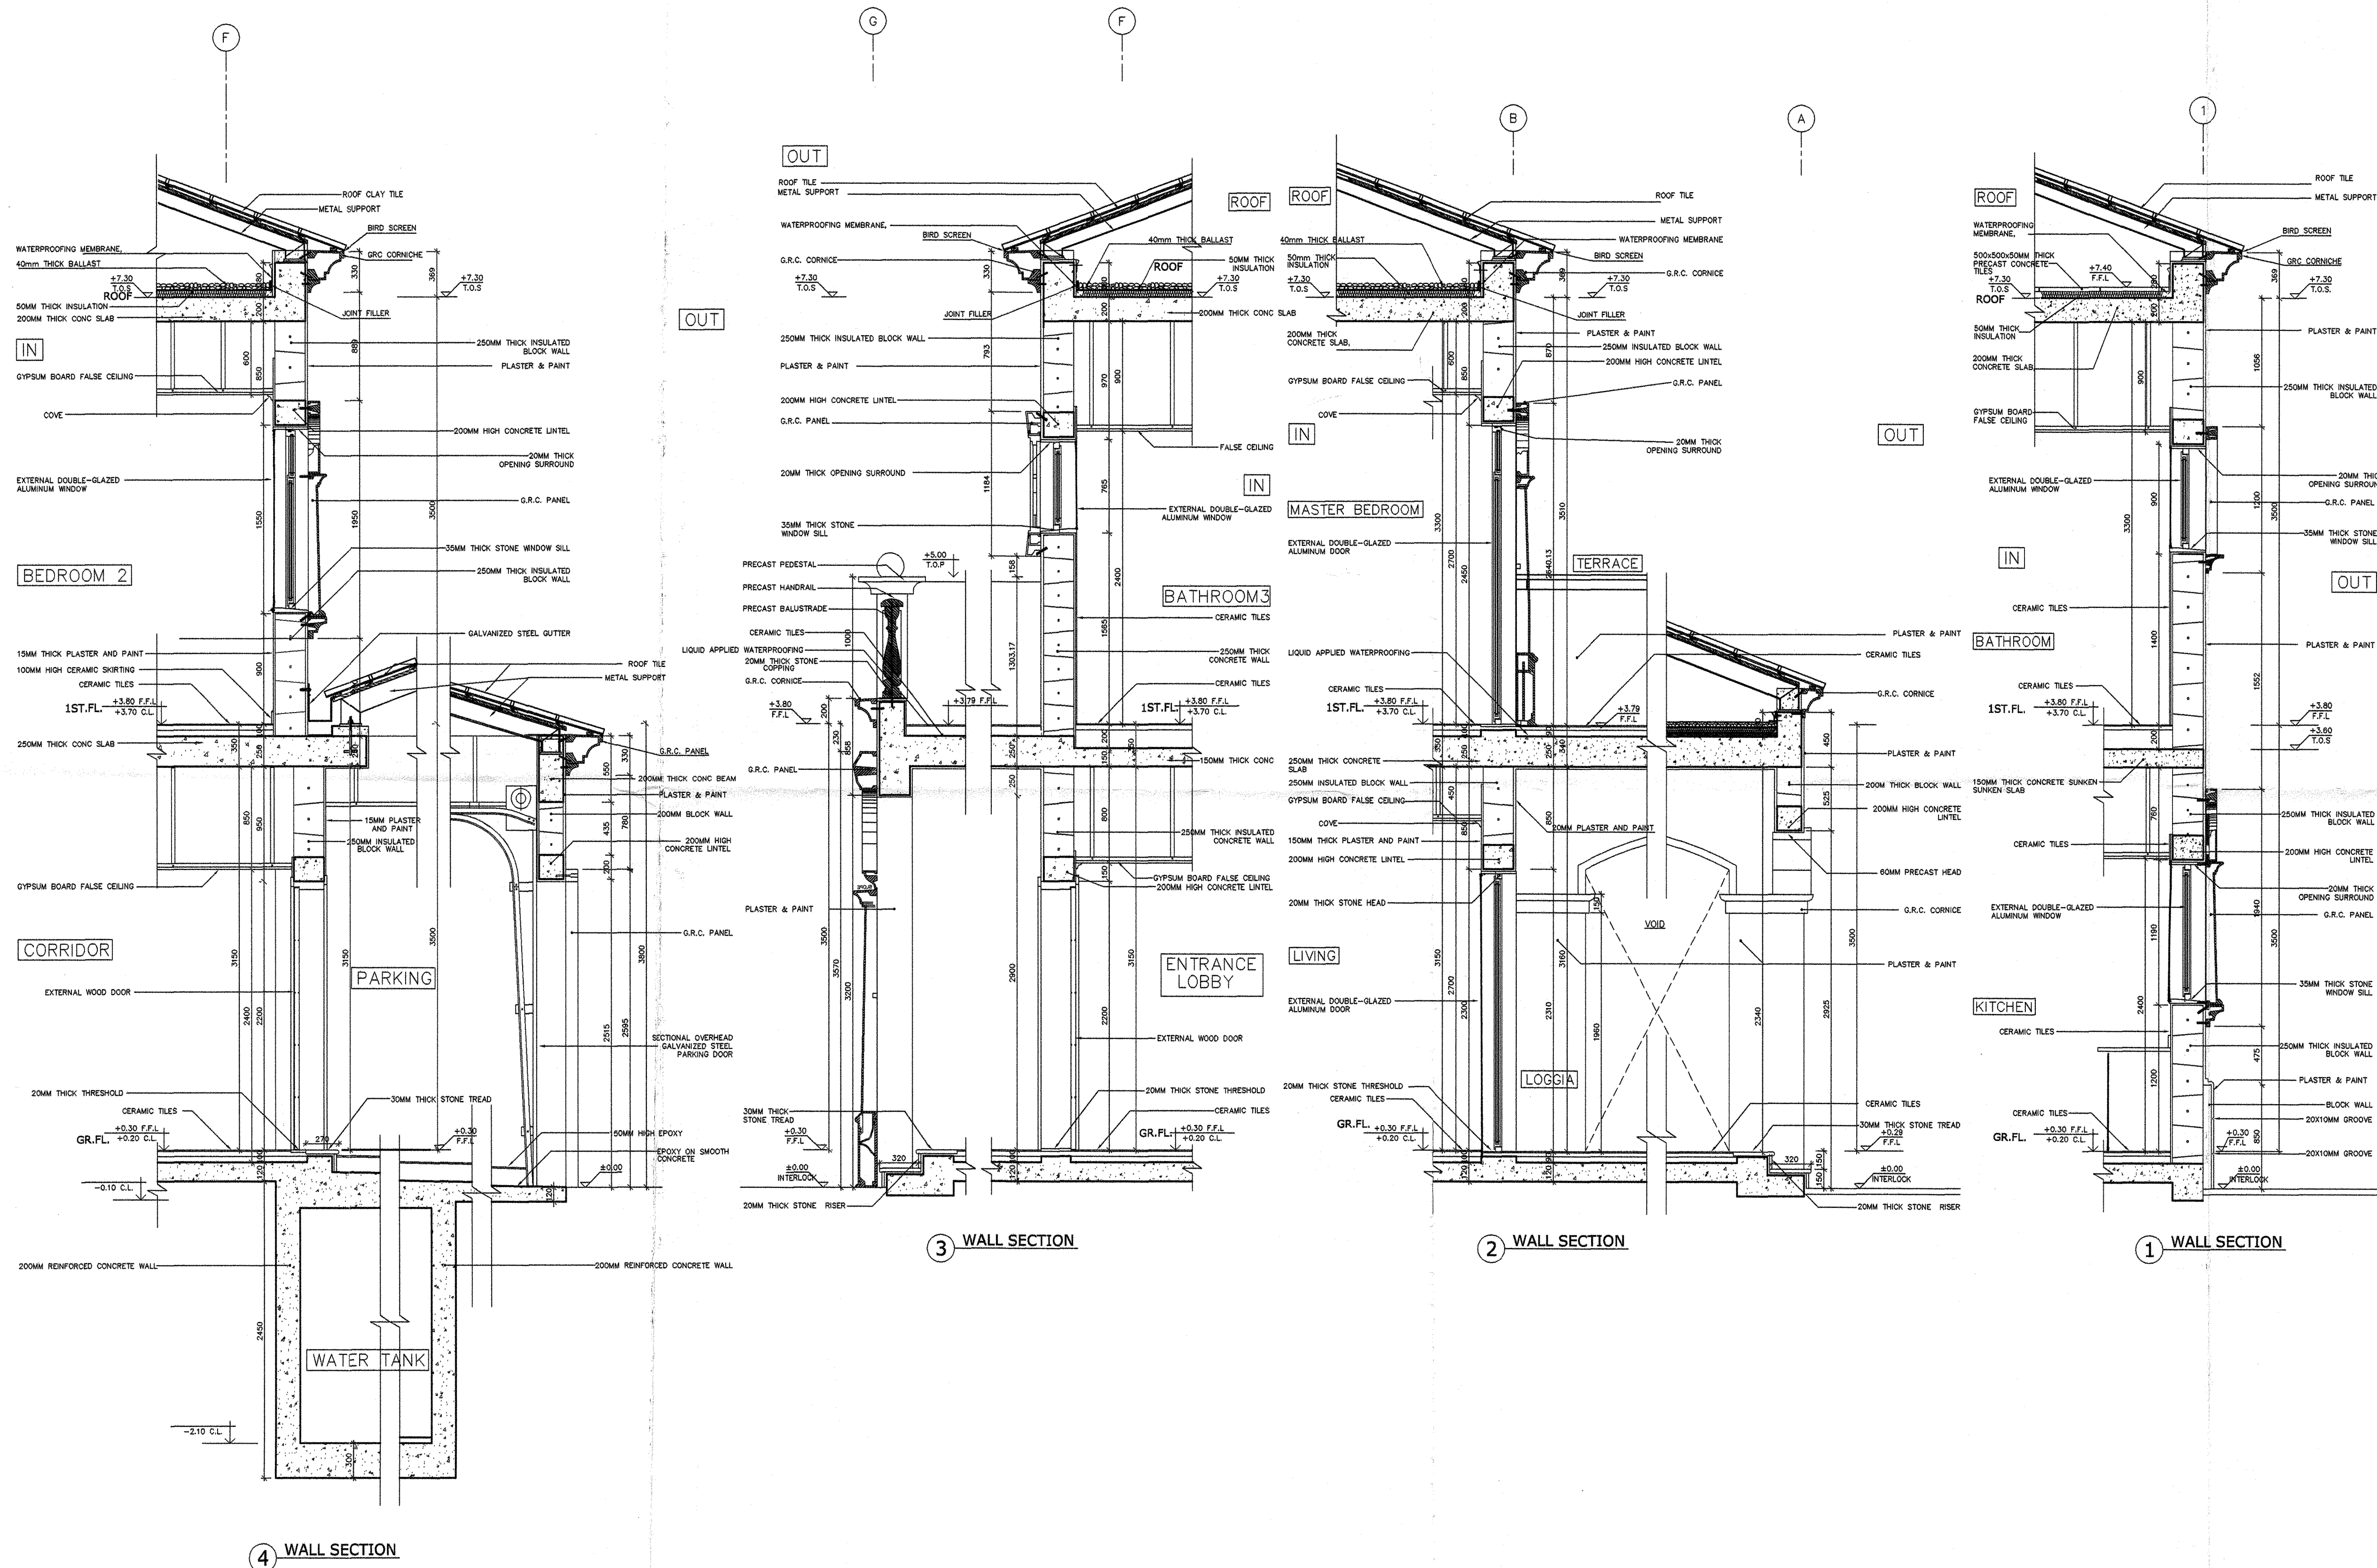

dar al-handasah
Shair and Partners

☒ CODE 1 APPROVED

☐ CODE 2 APPROVED AS NOTED
WORK MAY PROCEED SUBJECT TO
PROVISION OF ENDORSED
COMMENTS

☐ CODE 3 RESUBMIT FOR APPROVAL
WORK MAY NOT PROCEED

☐ CODE 4 REJECTED

BY: _____ DATE: _____

Approval shall not relieve the contractor of any of his
obligations under the Contract or constitute authorization of
any change to Contract Documents or variation to the work.
Contractor is responsible for dimensions, quantities and
coordination with other trades.

13/08/2012



AS BUILT DRAWING

Project

JUMAIRAH PARK

Employer



NAKHEEL

P.O. BOX: 17777, DUBAI, U.A.E.
PHONE: + 971 - 4 - 3903388
FAX: + 971 - 4 - 3903335
Website: www.nakheel.ae
E-MAIL: info@nakheel.ae



dar al-handasah
shair and partners

Consultant

P.O. BOX: 55624, DUBAI, U.A.E.
PHONE: + 971 - 4 - 3335302
FAX: + 971 - 4 - 3335312
www.dar-as.com



Pauling Middle East

Main Contractor

P.O. BOX: 45176, ABU DHABI, U.A.E.
PHONE: + 971 - 2 - 6300922
FAX: + 971 - 2 - 6325553
E-MAIL: pauling@middleeast.ae

Package

PACKAGE - 2 & 2A

SECTIONS & WALL SECTIONS
LEGACY TRADITIONAL

Drawing Title

Drawn: T.Murugan Review: Eng. Ziad Checked: Eng.Ghassan Zeitouni

Scale: - Date: 08-08-2012

Drawing No.

PME / JP / AB / LT / SEC- 002

139 r. 2