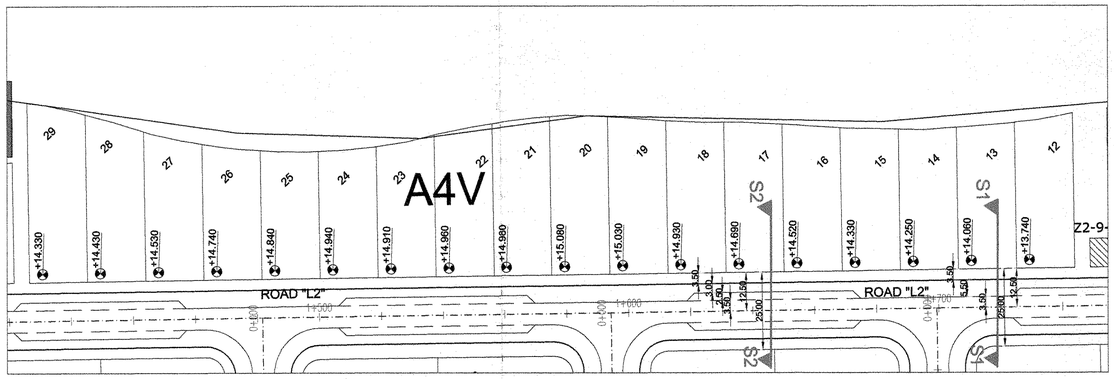
A4V
29
28
27
26
25
24
23
22
21
20
19
18
17
16
15
14
13
12
+14.330
+14.430
+14.530
+14.740
+14.840
+14.940
+14.910
+14.960
+14.990
+15.080
+15.030
+14.930
+14.690
+14.520
+14.330
+14.250
+14.060
+13.740
S2
S1
Z2-9-
ROAD "L2"
ROAD "L2"
0+400
0+500
1+000
0+400
0+700
3.50
5.00
5.50
3.50
3.50
3