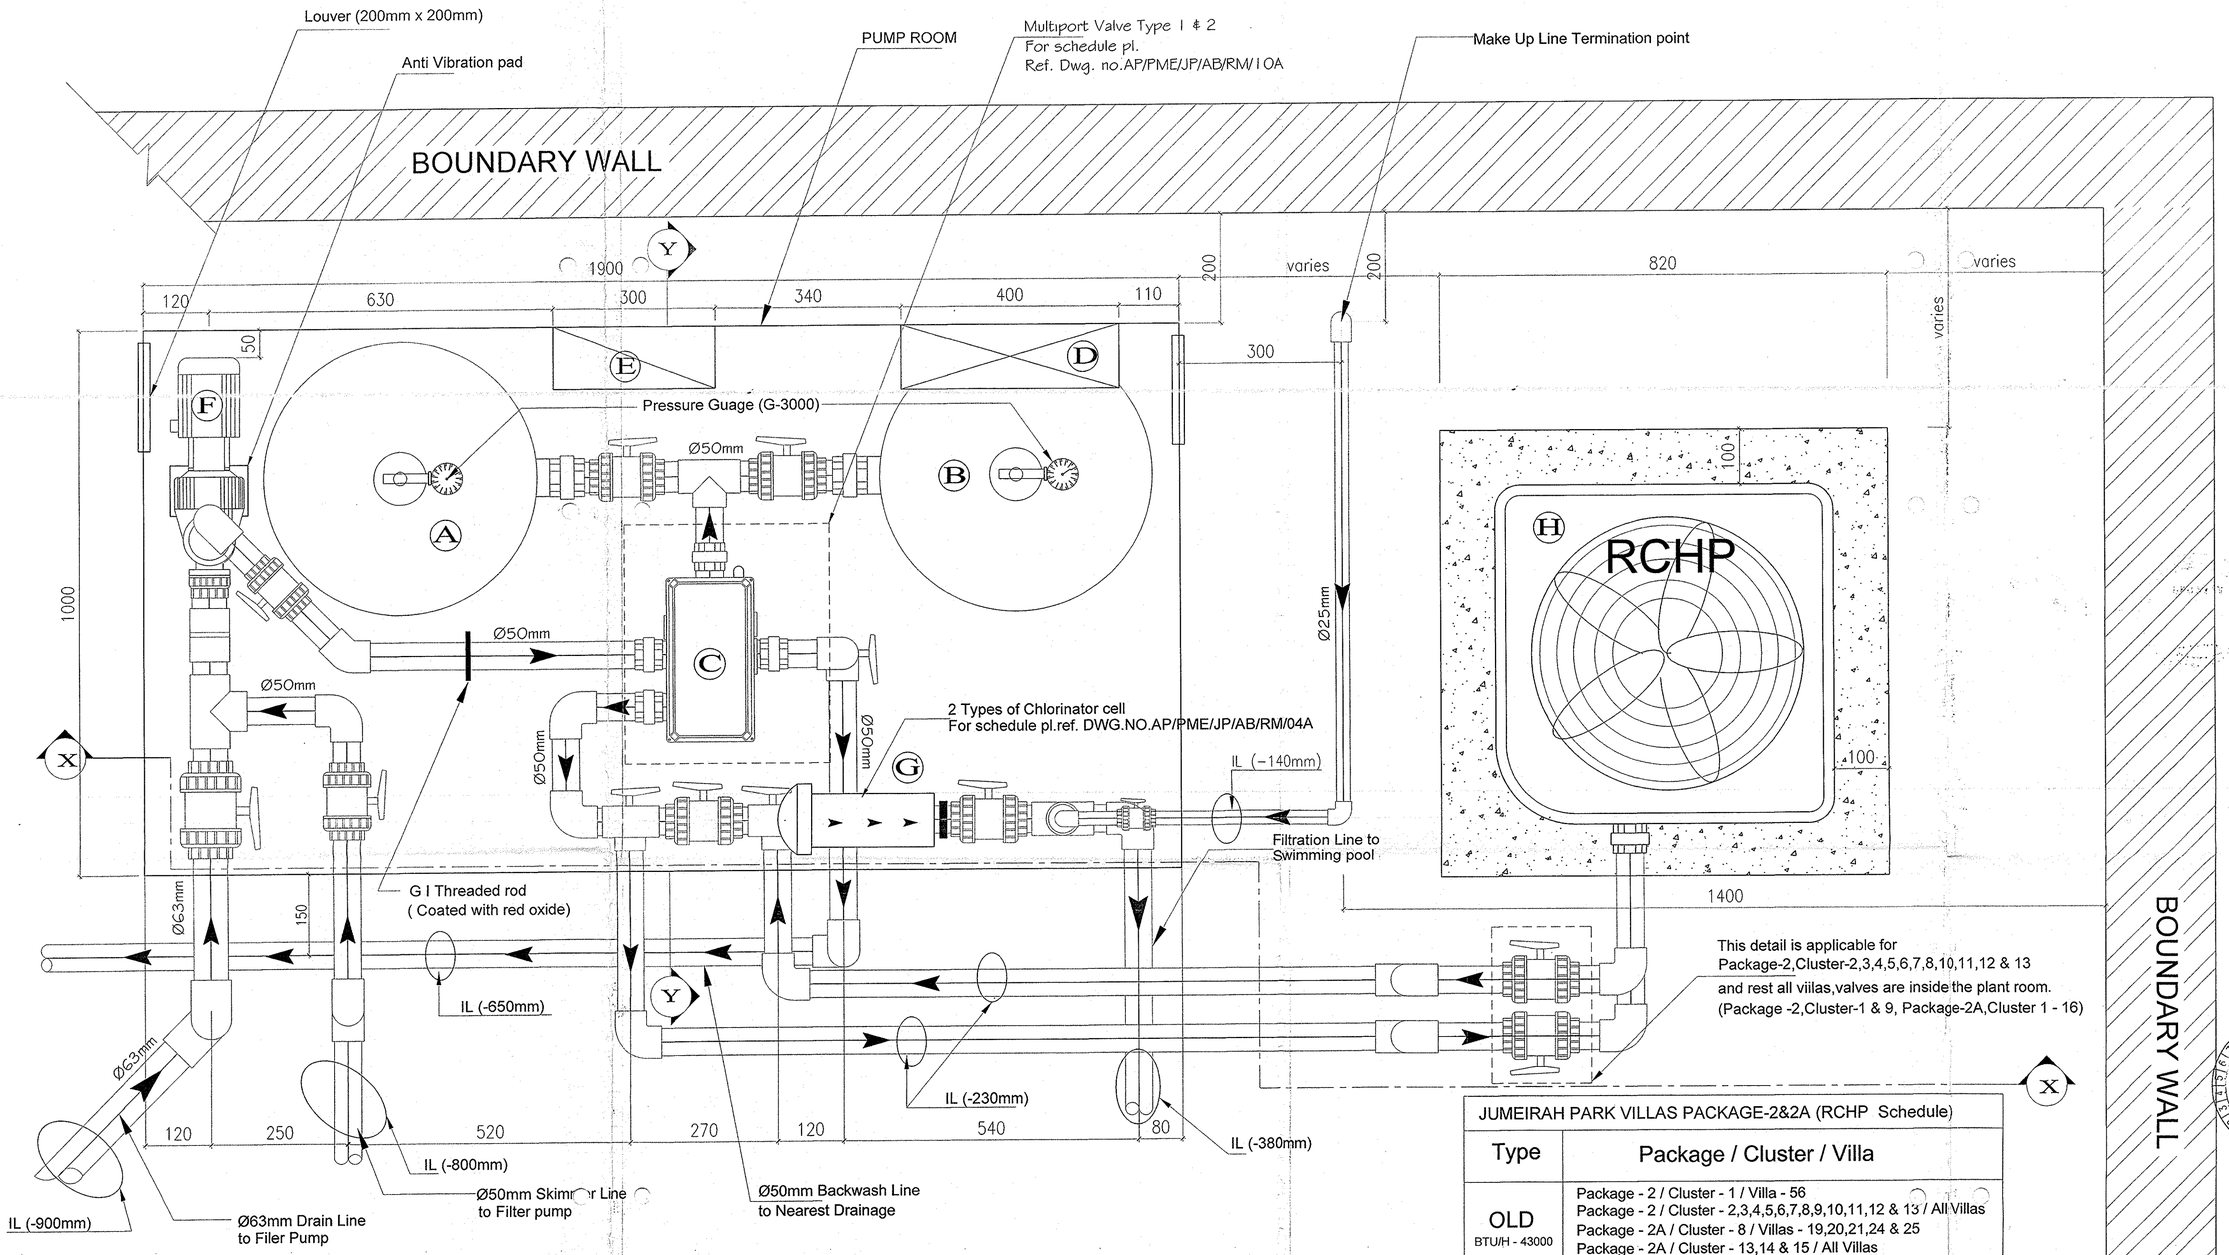

PUMP ROOM MECHANICAL LAYOUT PLAN - (LEFT POOL)

Scale: 1:5

JUMEIRAH PARK VILLAS PACKAGE-2&2A (RCHP Schedule)	
Type	Package / Cluster / Villa
OLD BTU/H - 43000	Package - 2 / Cluster - 1 / Villa - 56 Package - 2 / Cluster - 2,3,4,5,6,7,8,9,10,11,12 & 13 / All Villas Package - 2A / Cluster - 8 / Villas - 19,20,21,24 & 25 Package - 2A / Cluster - 13,14 & 15 / All Villas Package - 2A / Cluster - 16 / Villas 1 - 11
NEW BTU/H - 47000	Package - 2 / Cluster - 1 / Villas 41 - 55 Package - 2A / Cluster - 1,2,3,4,5,6,7,9,10,11 & 12 / All Villas Package - 2A / Cluster - 8 / Villas 22,23,26 - 32 Package - 2A / Cluster - 16 / Villas 12 - 17

LEGEND	EQUIPMENT	QTY	MAKE/MODEL
A	SAND FILTER Ø500mm (DUTY) W/ Pressure Gauge	1	CERTIKIN (ZZFBS500), (G-3000)
B	SAND FILTER Ø500mm (STAND BY) W/ Pressure Gauge	1	CERTIKIN (ZZFBS500), (G-3000)
C	AUTOMATIC MULTIPORT VALVE (Two types)	1	PRAHAR AQUASTAReasy 1000) / MPVA/15
D	SALT CHLORINATOR (Control Unit)	1	CERTIKIN (SALT EXPERT - 46051)

LEGEND	EQUIPMENT	QTY	MAKE/MODEL
E	CONTROL PANEL W/ TRANSFORMER	1	CP-33PS-CERTIKIN
F	0.75 HP DUTY FILTER PUMP	1	CERTIKIN HKV071
G	CHLORINATOR CELL (Two types)	1	CERTIKIN (SALT EXPERT - 46051) With 4 Electrode Plates
H	FLOOR DRAIN	1	PVC (White ABS) Approved
I	Reverse Cycle Heat Pump (RCHP)	1	SBM 600C (Certikin) BTU/H - 43000 (Two capacities) BTU/H - 47000

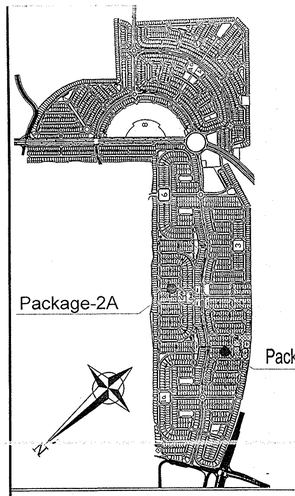

dar al-handasah
Shair and Partners

- CODE 1 APPROVED
- CODE 2 APPROVED AS NOTED — WORK MAY PROCEED SUBJECT TO INCORPORATION OF ENDORSED COMMENTS
- CODE 3 RESUBMIT FOR APPROVAL — WORK MAY NOT PROCEED
- CODE 4 REJECTED

BY: DATE:

Approval shall not relieve the contractor of any of his obligations under the contract or constitute authorization of any change to Contract Documents or waive any rights of Contractor's responsibility for dimensions, specifications and coordination with materials.

Rev.	Date	Description	Dra
AB2	25.06.12	ISSUED FOR APPROVAL	G
AB1	22.02.12	ISSUED FOR APPROVAL	G
AB	12.01.12	ISSUED FOR APPROVAL	G

AS BUILT DRAWING

RECEIVED DAR AL HANDASAH 07 JUL 2012 PKG 2&2A

JUMAIRAH PARK

NAKHEEL

dar al-handasah shair and partners

Pauling Middle East

PACKAGE - 2 & 2A

absolute - pools
'The pool for the home owner'
P.O.BOX 46890, DUBAI, U.A.E
TEL: +971 4 3393155
FAX: +971 4 3395973
e-mail : info@absolute-pools.com

PUMP ROOM MECHANICAL LAYOUT PLAN

Drawn	GS	Review	RDL	Check :	FM/P
Scale:	1:5	Date:	10-01-2012	Approved:	

Drawing No.

Drg. No.:AP/PME/JP/AB/RM/8A