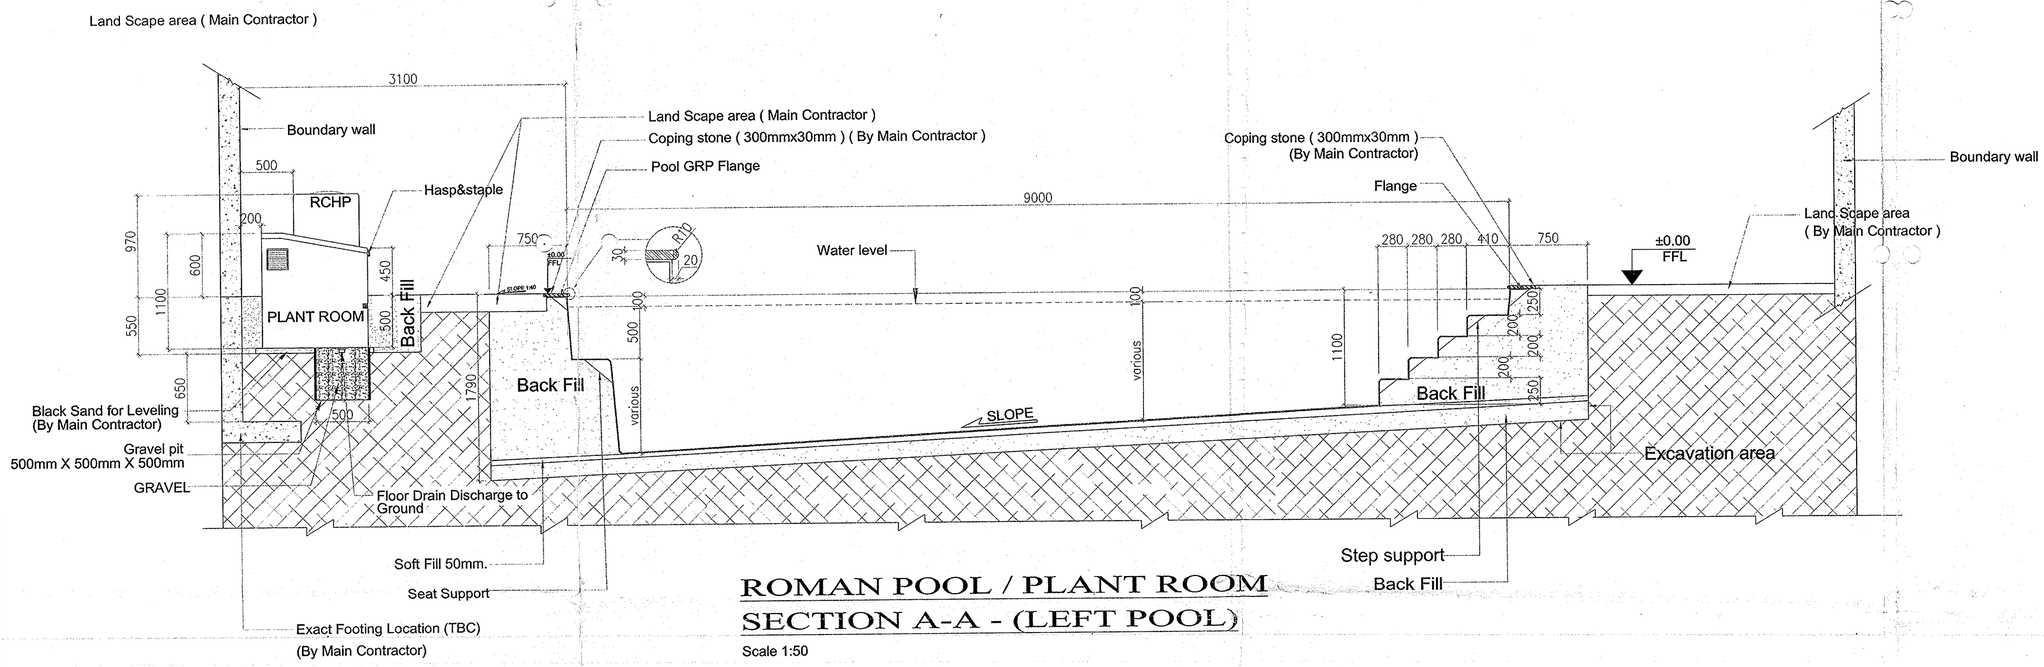

ROMAN POOL / PLANT ROOM
SECTION A-A - (LEFT POOL)

Scale 1:50

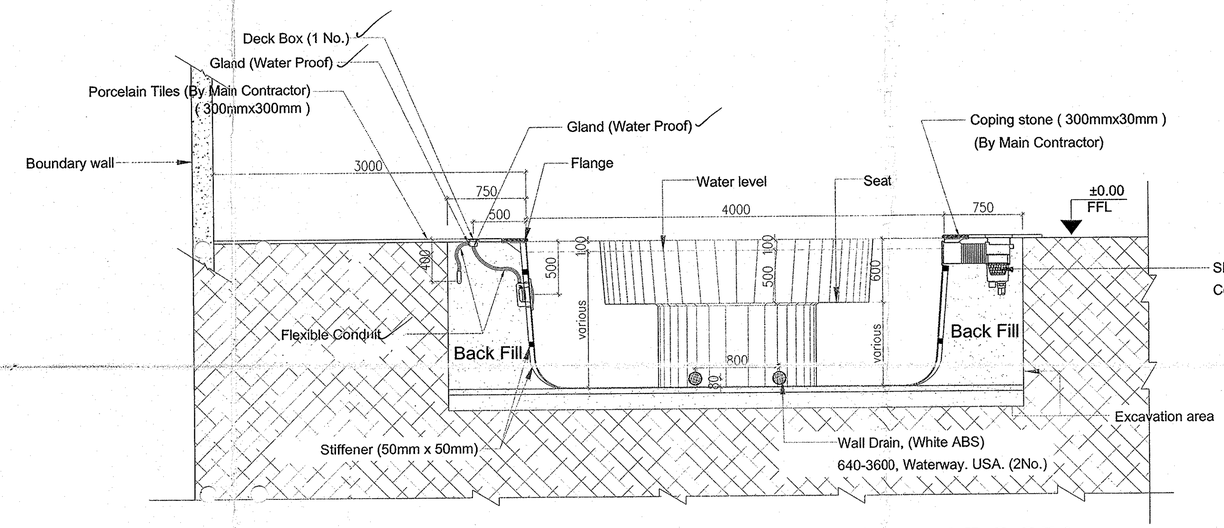

ROMAN POOL - (LEFT POOL)
SECTION B-B

Scale 1:50

LEGEND	POOL FITTINGS	QTY
	WALL INLET (WHITE ABS) (Certikin)	2
	SKIMMER (WHITE ABS) (Certikin)	1
	WALL DRAIN (WHITE ABS) (Water Ways)	2
	300w/12v UNDER WATER LIGHT (WHITE ABS) (Certikin)	1
	BALL VALVE (Ceepex)	
	ELBOW 90° (Ceepex)	
	UNION (Ceepex)	

POOL TYPE: ROMAN POOL
Size:- 9m x 4m x 1.1m-1.5m Depth

dar al-handasah
Shair and Partners

- CODE 1 APPROVED
- CODE 2 APPROVED AS NOTED — WORK MAY PROCEED SUBJECT TO INCORPORATION OF ENDORSED COMMENTS
- CODE 3 RESUBMIT FOR APPROVAL — WORK MAY NOT PROCEED
- CODE 4 REJECTED

BY: DATE:

Approval shall not relieve the contractor of any of his obligations under the Contract or constitute authorization of any change to Contract Documents or variation to the works. Contractor is responsible for dimensions, quantities and coordination with other trades.

24012

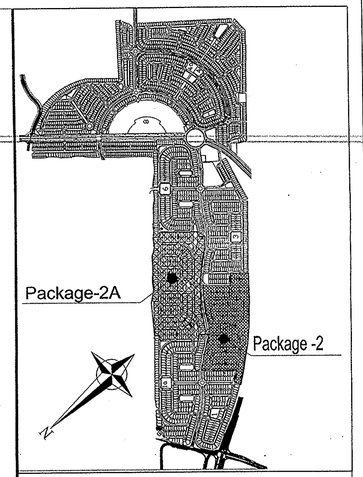

KEY PLAN

NOTES:-
1) ALL DIMENSIONS ARE IN MM AND LEVELS ARE METERS UNLESS NOTED OTHERWISE.

RECEIVED 19 JAN 2013 DAR AL HANDASAH 5965/2

Rev.	Date	Description	Drawn	Check
AB	12-01-2012	ISSUED FOR APPROVAL	A.M	FM/PJ

AS BUILT DRAWING

Project
JUMAIRAH PARK

Employer
NAKHEEL
P.O. BOX : 17777 , DUBAI , U.A.E.
PHONE : + 971 -4 - 2903388
FAX : + 971 - 4 - 3903555
Website : www.nakheel.com
E - MAIL : info@nakheel.ae

Consultant
dar al-handasah shair and partners
P.O. BOX : 35624 , DUBAI , U.A.E.
PHONE : + 971 - 4 - 3315500
FAX : + 971 - 4 - 33303331
www.dargroup.com

Main Contractor
Pauling Middle East
P.O. BOX : 45176 , ABU DHABI , U.A.E.
PHONE : + 971 - 2 - 6320992
FAX : + 971 - 2 - 6320333
E - MAIL : pauling@emirates.net.ae

Package
PACKAGE - 2 & 2A

Sub Contractor
absolute - pools
'The pool for the home owner'
P.O.BOX 48890, DUBAI, U.A.E
TEL: +971 4 3393155
FAX: +971 4 3396973
e-mail : info@absolute-pools.com

Drawing Title
ROMAN POOL LAYOUT
SECTION AA, BB
FOR COPING & PAVING

Drawn	Review	Check
GS	RDL	FM/PJ
Scale: 1:50	Date: 10-01-2012	Approved:

Drawing No.
Drg. No.:AP/PME/JP/AB/RM/14A

REV
AB